FED. RD. DIVISION	STATE	FUNDING	
2	OHIO		

121
526

CUYAHOGA COUNTY

CUY-480-8.00
CUY-17-7.39

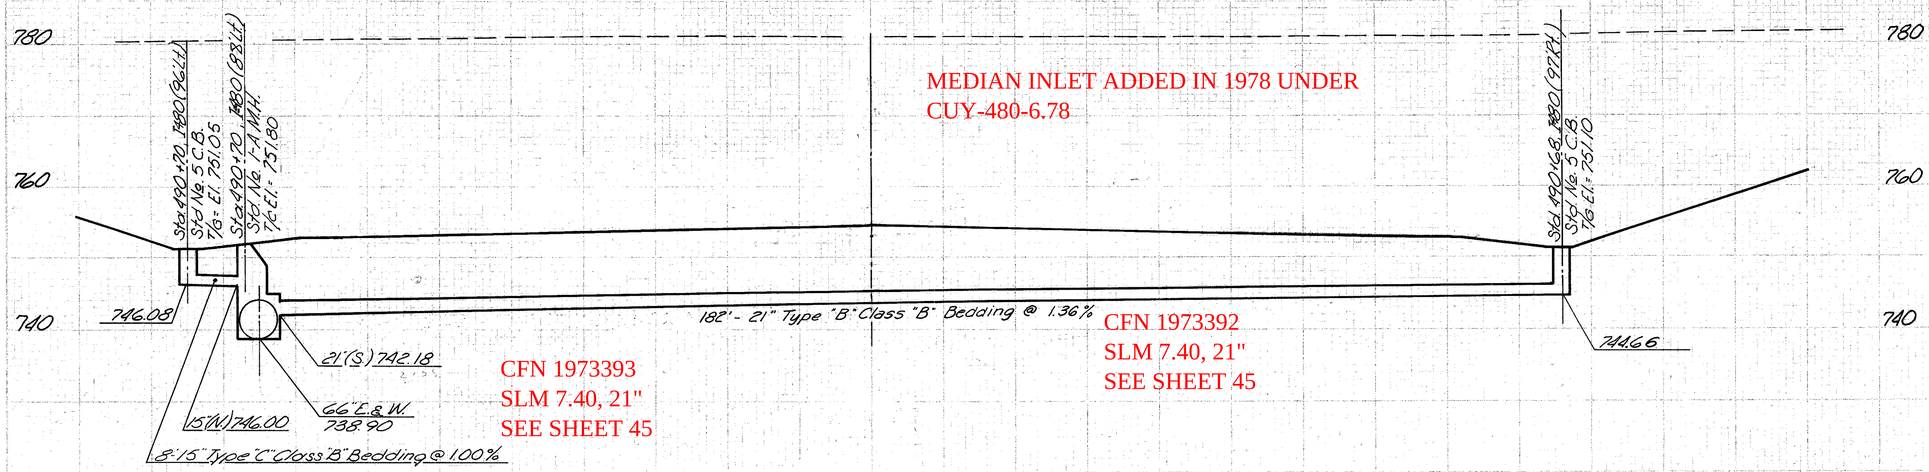

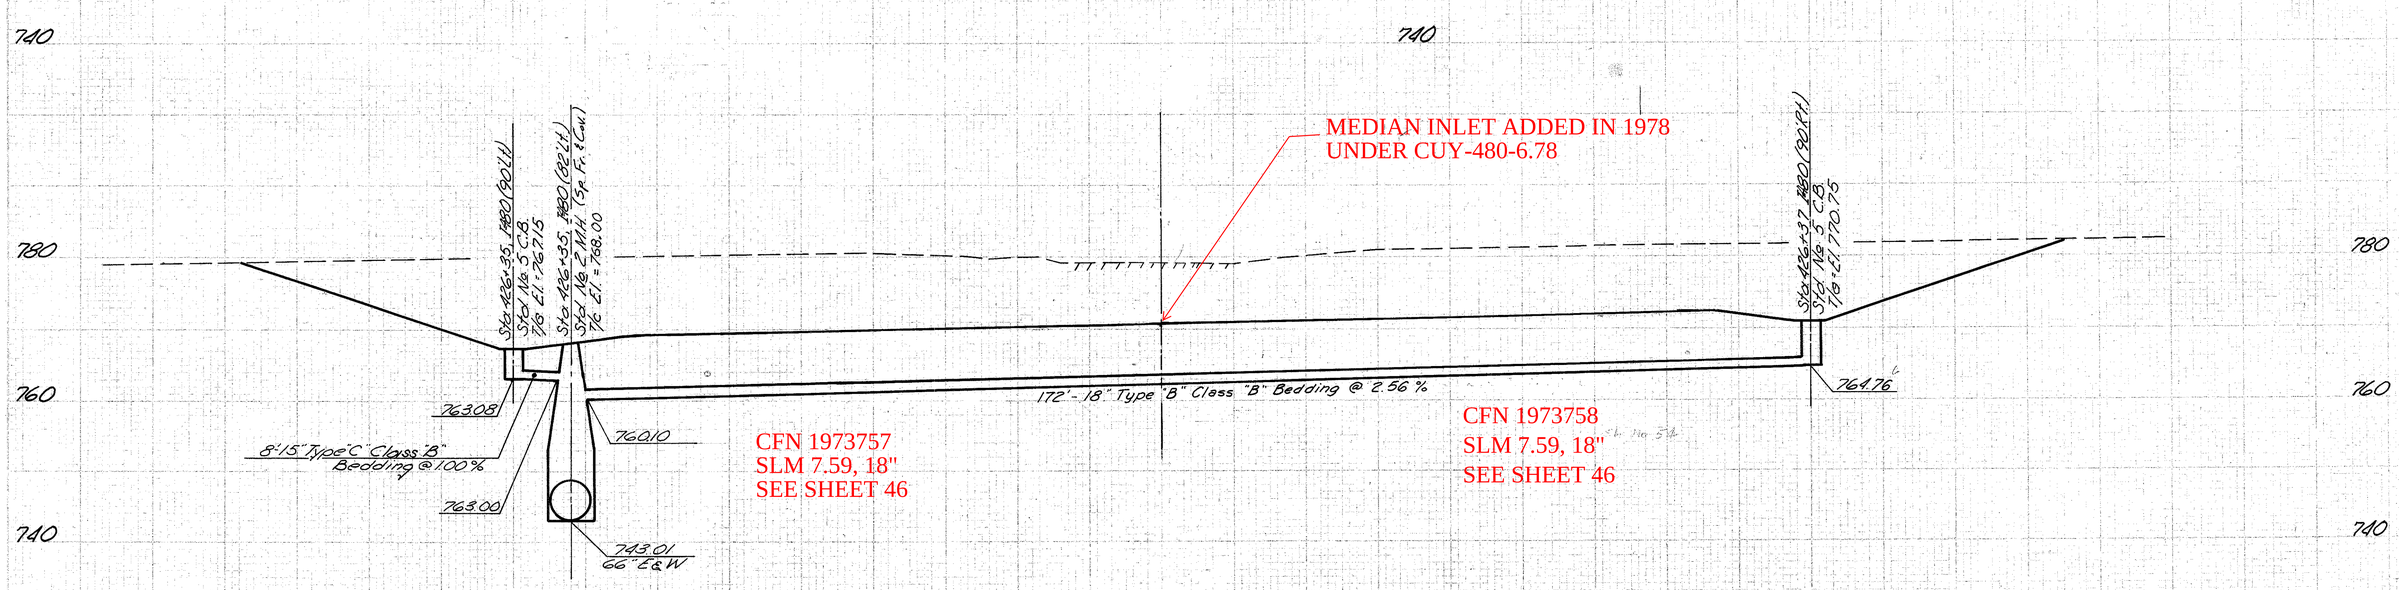

STORM SEWER PROFILES