


Quantity Calculations  
 Made By JEN Date 6-72  
 Checked By IM Date 6-72

FED. RD. DIVISION	STATE	PROJECT
2	OHIO	

130  
390

CUYAHOGA COUNTY  
 CUY 480-21.40

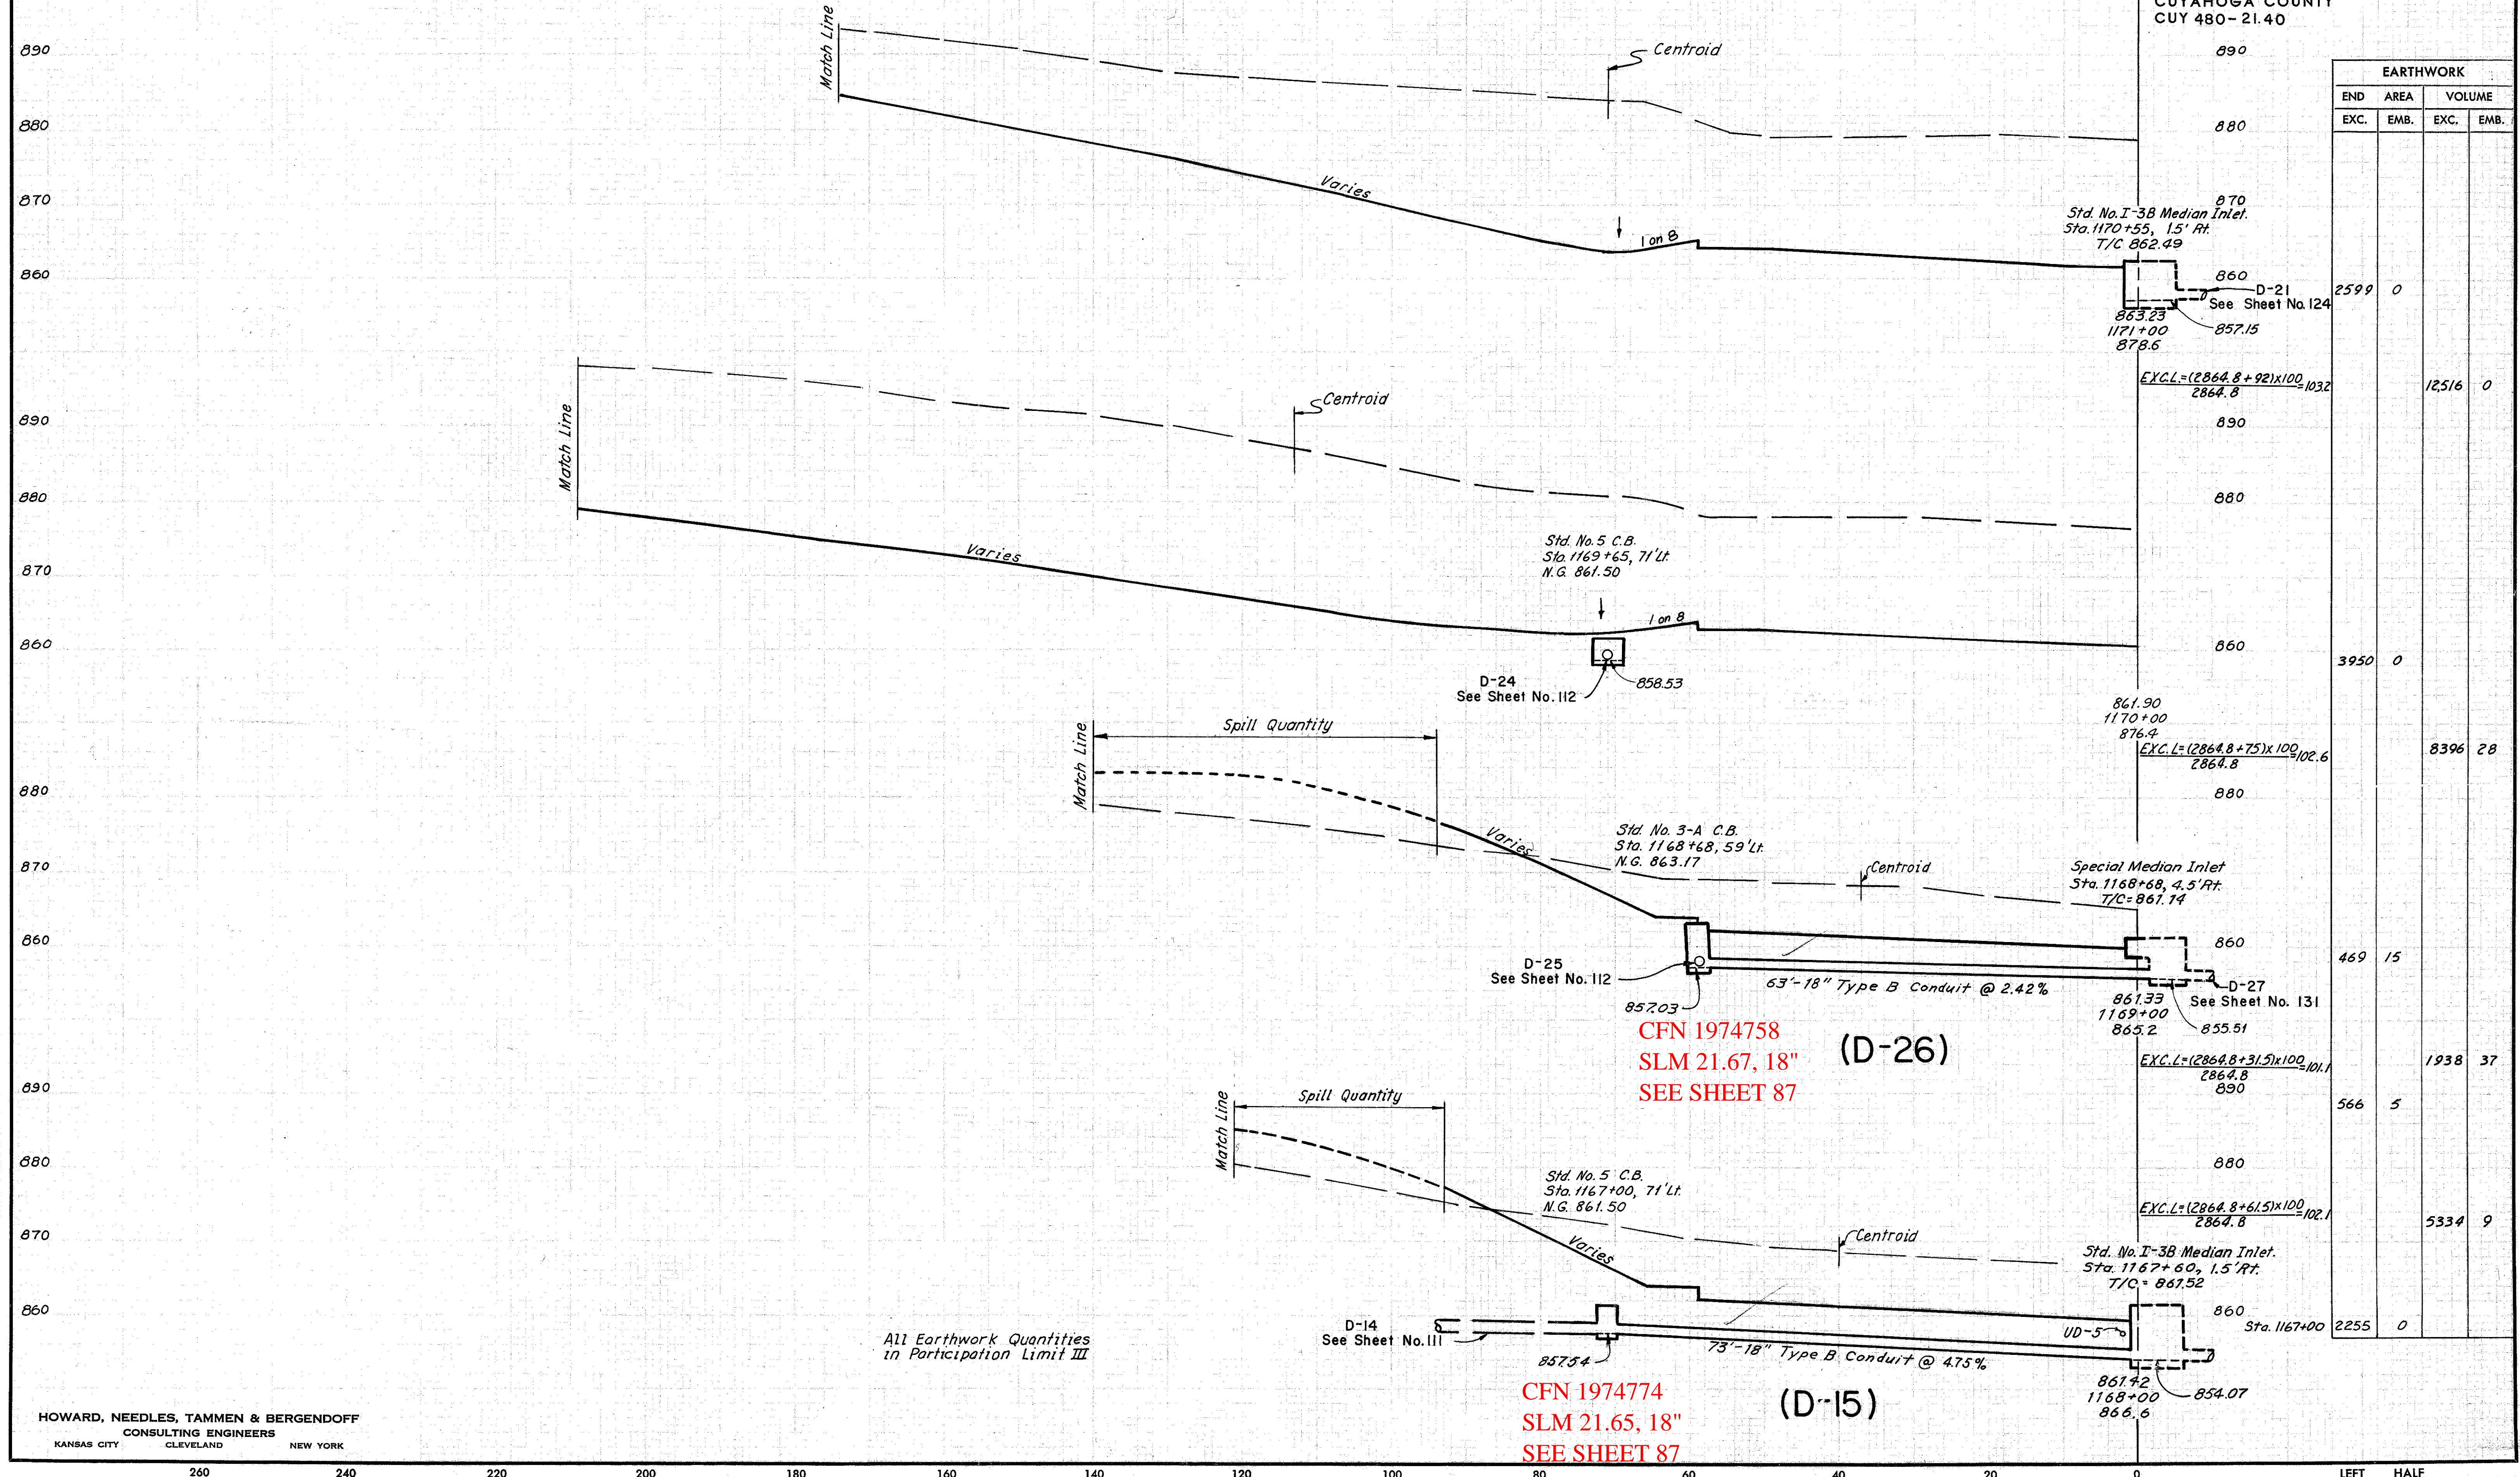

EARTHWORK			
END	AREA	VOLUME	
EXC.	EMB.	EXC.	EMB.
		2599	0
		12516	0
		3950	0
		8396	28
		469	15
		1938	37
		566	5
		5334	9
		2255	0

All Earthwork Quantities  
 in Participation Limit III

CFN 1974758  
 SLM 21.67, 18" (D-26)  
 SEE SHEET 87

CFN 1974774  
 SLM 21.65, 18" (D-15)  
 SEE SHEET 87

8-67  
 9-67  
 6-72  
 6-72  
 R.F.T.  
 W.L.L.  
 J.E.N.  
 I.M.