


DATE	DESIGN	PROJECT
10-75	CHD	

CUYAHOGA COUNTY
CUI-480-6.78

CALL BY: E.J.R. DATE: 10-75
CHKD. BY: H.J.H. DATE: 11-75

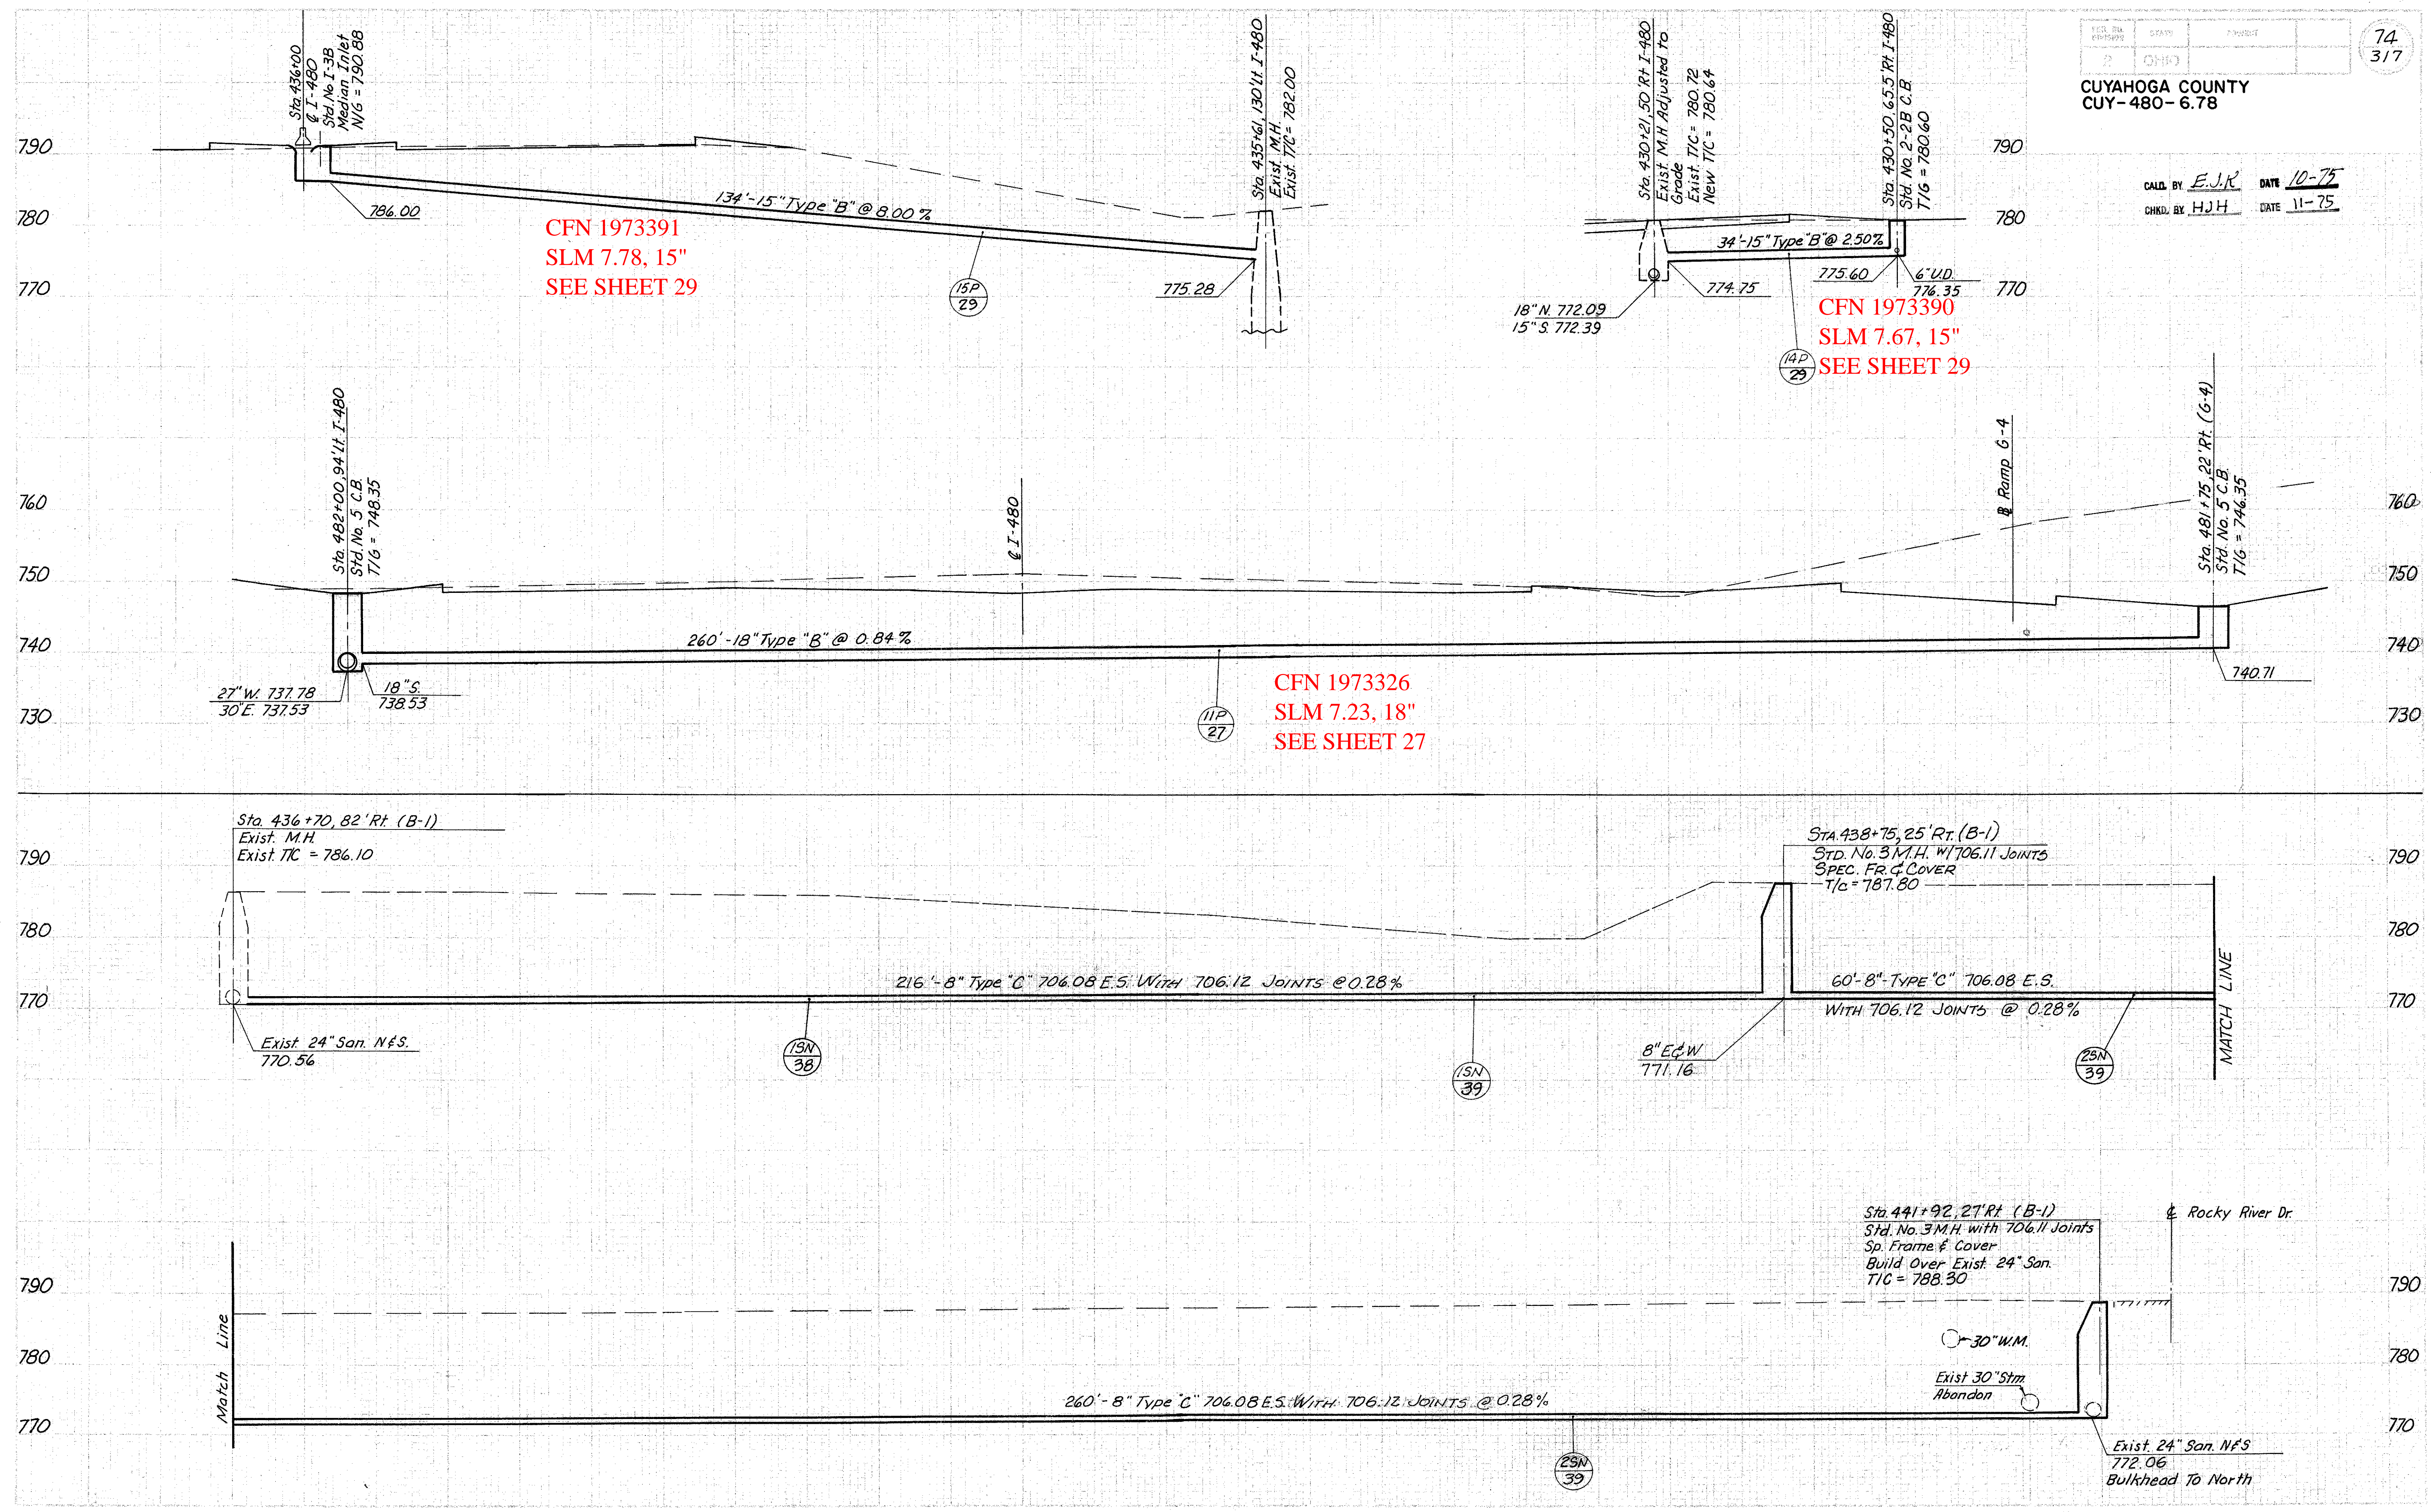

STORM & SANITARY SEWER PROFILES