


CALC. BY K.M. DATE 12-77
 CHKD. BY T.R.B. DATE 12-77

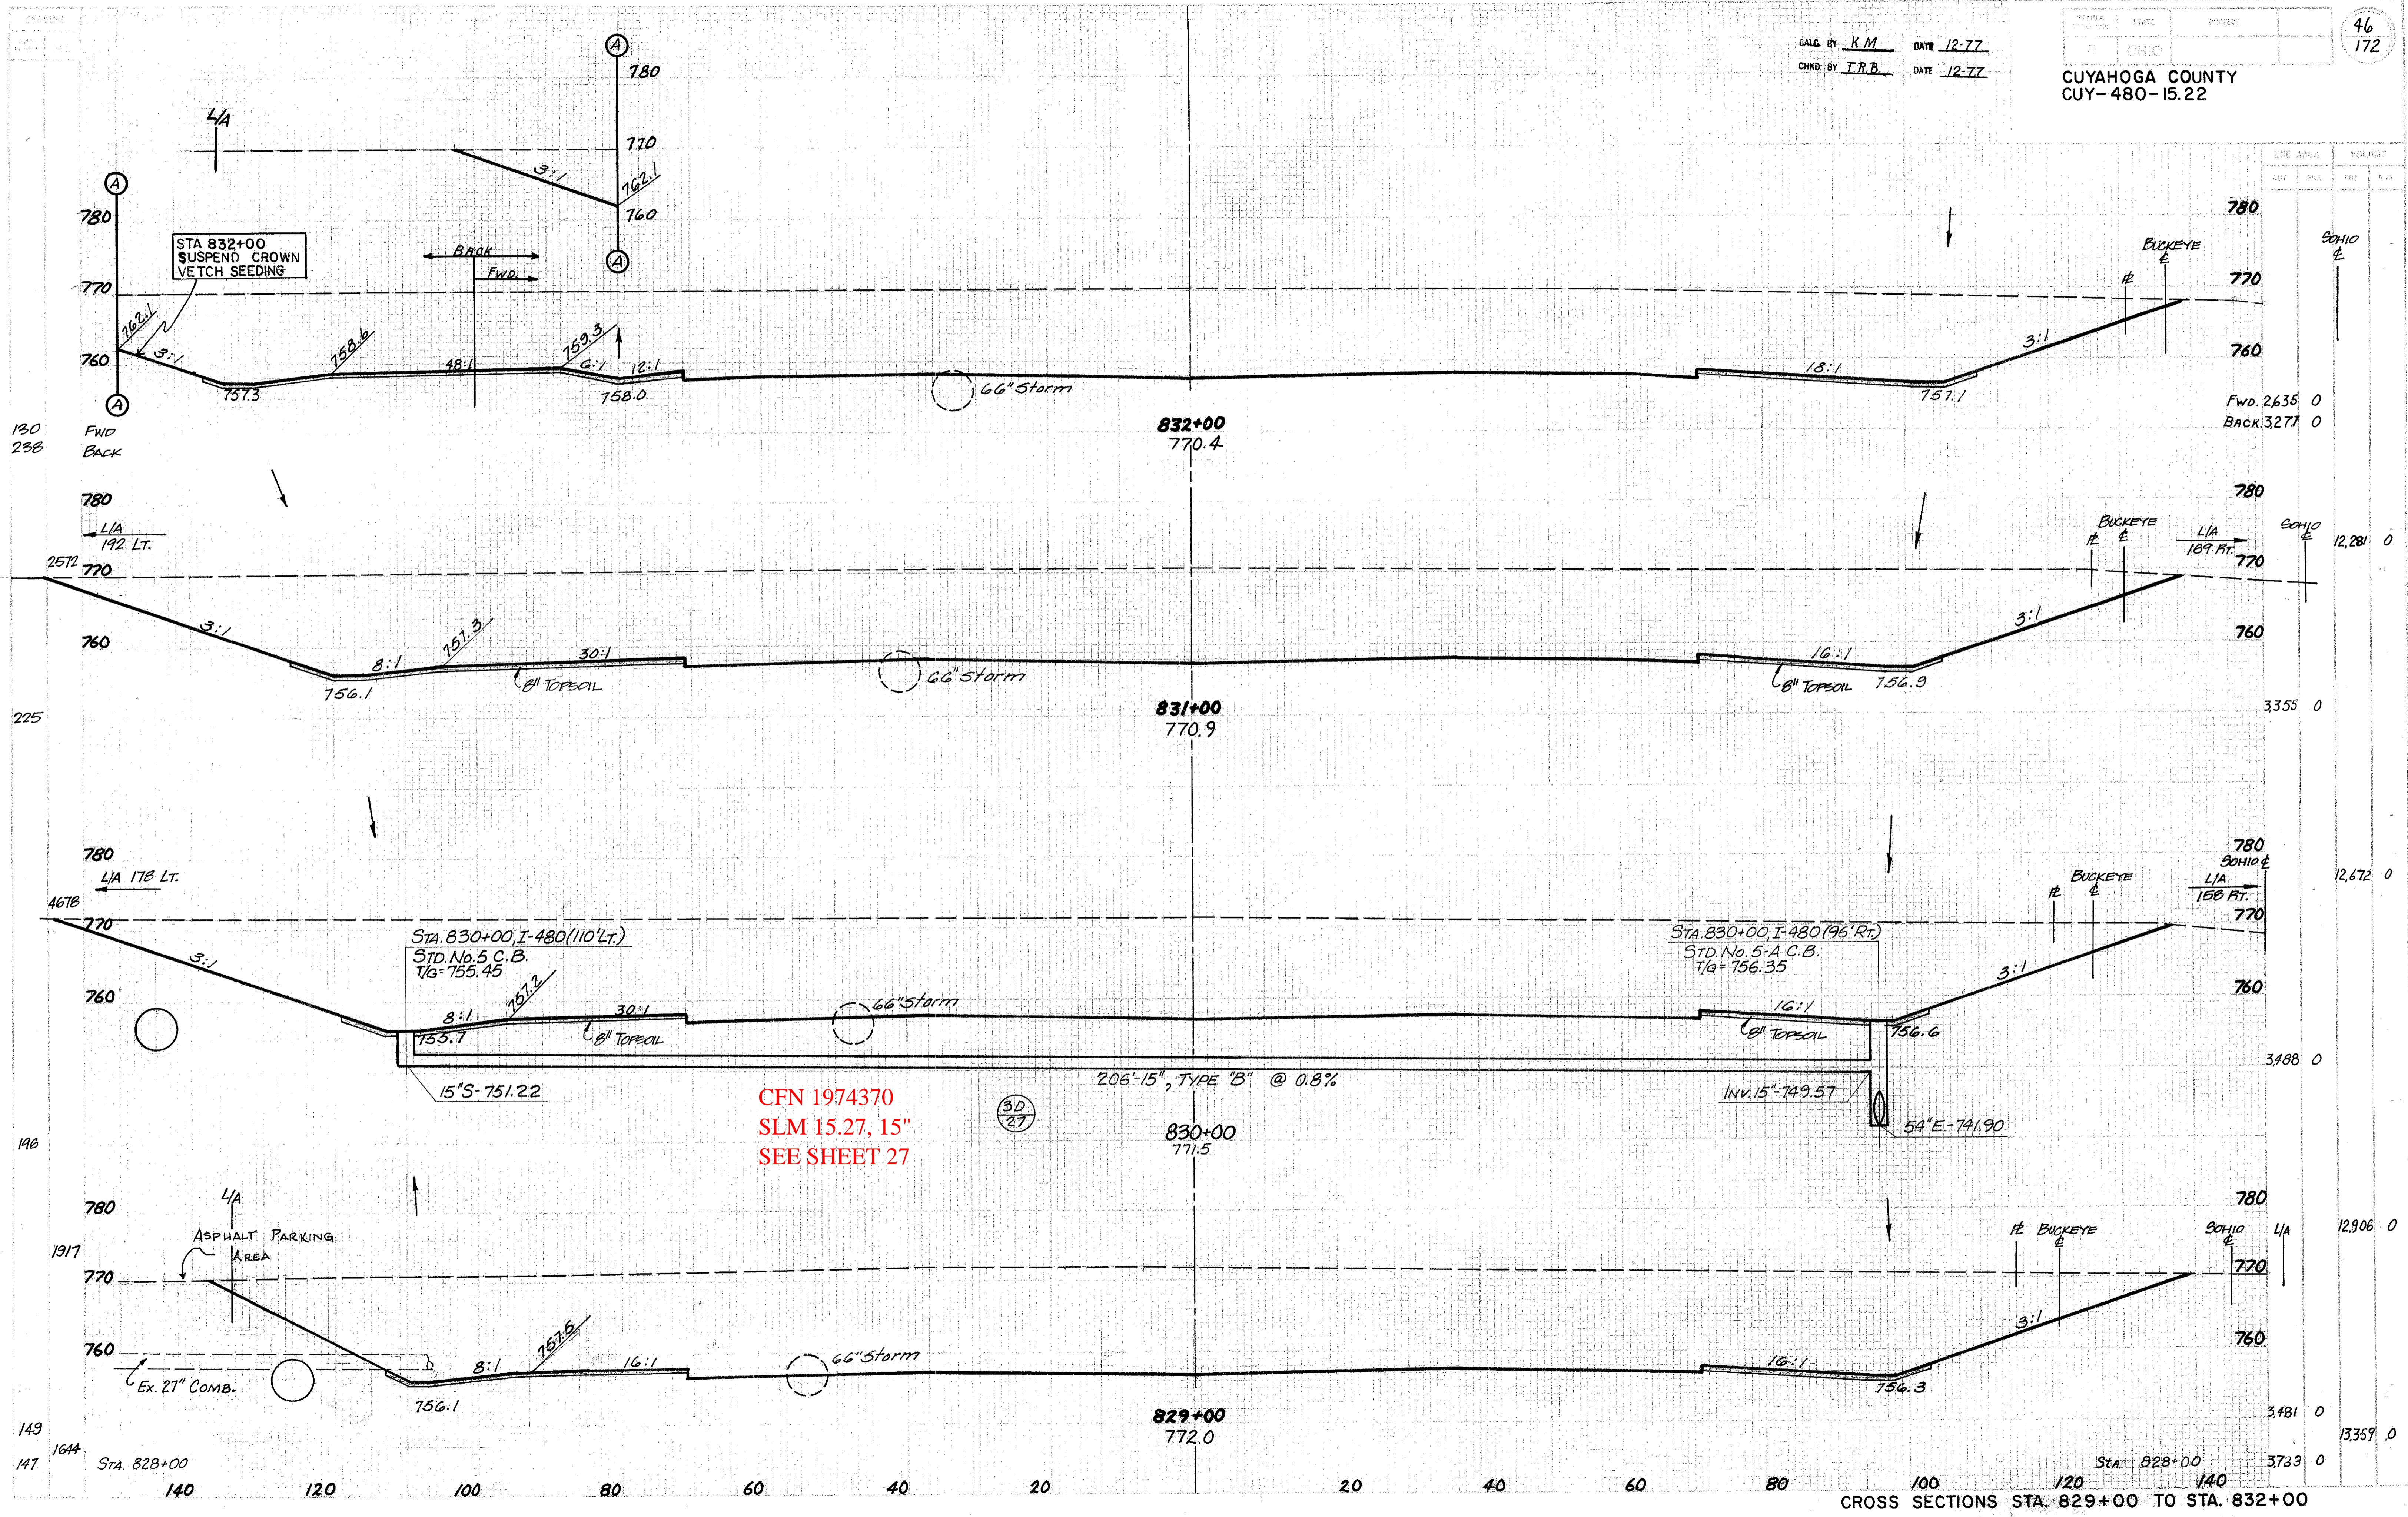

STA 832+00
 SUSPEND CROWN
 VETCH SEEDING

STA. 830+00, I-480 (110' LT.)
 STD. No. 5 C.B.
 T/g = 755.45

STA. 830+00, I-480 (96' RT.)
 STD. No. 5-A C.B.
 T/g = 756.35

CFN 1974370
 SLM 15.27, 15"
 SEE SHEET 27

206'-15", TYPE "B" @ 0.8%

Inv. 15'-749.57
 54"E-741.90

CROSS SECTIONS STA. 829+00 TO STA. 832+00