

CALC. BY WAM DATE 3/75
CHKD. BY EJK DATE 3/75

CROSS REFERENCE	
Sht. No.	Item
88	Ramp F1 Pavement Detail
42	Superelevation Table
105	Culvert
102	Access Road
104	Detention Basin

old CFN 184801104
new CFN 1870455
SLM 11.05, 72"
SEE SHEET 105

CFN 1974288
SLM 11.04, 15"
SEE SHEET 95

SLM 11.04, 36"
SEE BELOW

SLM 11.07, 36"
SEE BELOW

SLM 11.13, 15"
SEE SHEET 102

SLM 11.13, 42"
SEE BELOW


SLM 11.19, 42"
SEE BELOW

SLM 11.26, 42"
SEE BELOW

CFN 1974282
SLM 11.23, 15"
SEE SHEET 95

SLM 11.07, 15"
SEE SHEET 127

SLM 11.05, 15"
SEE SHEET 126

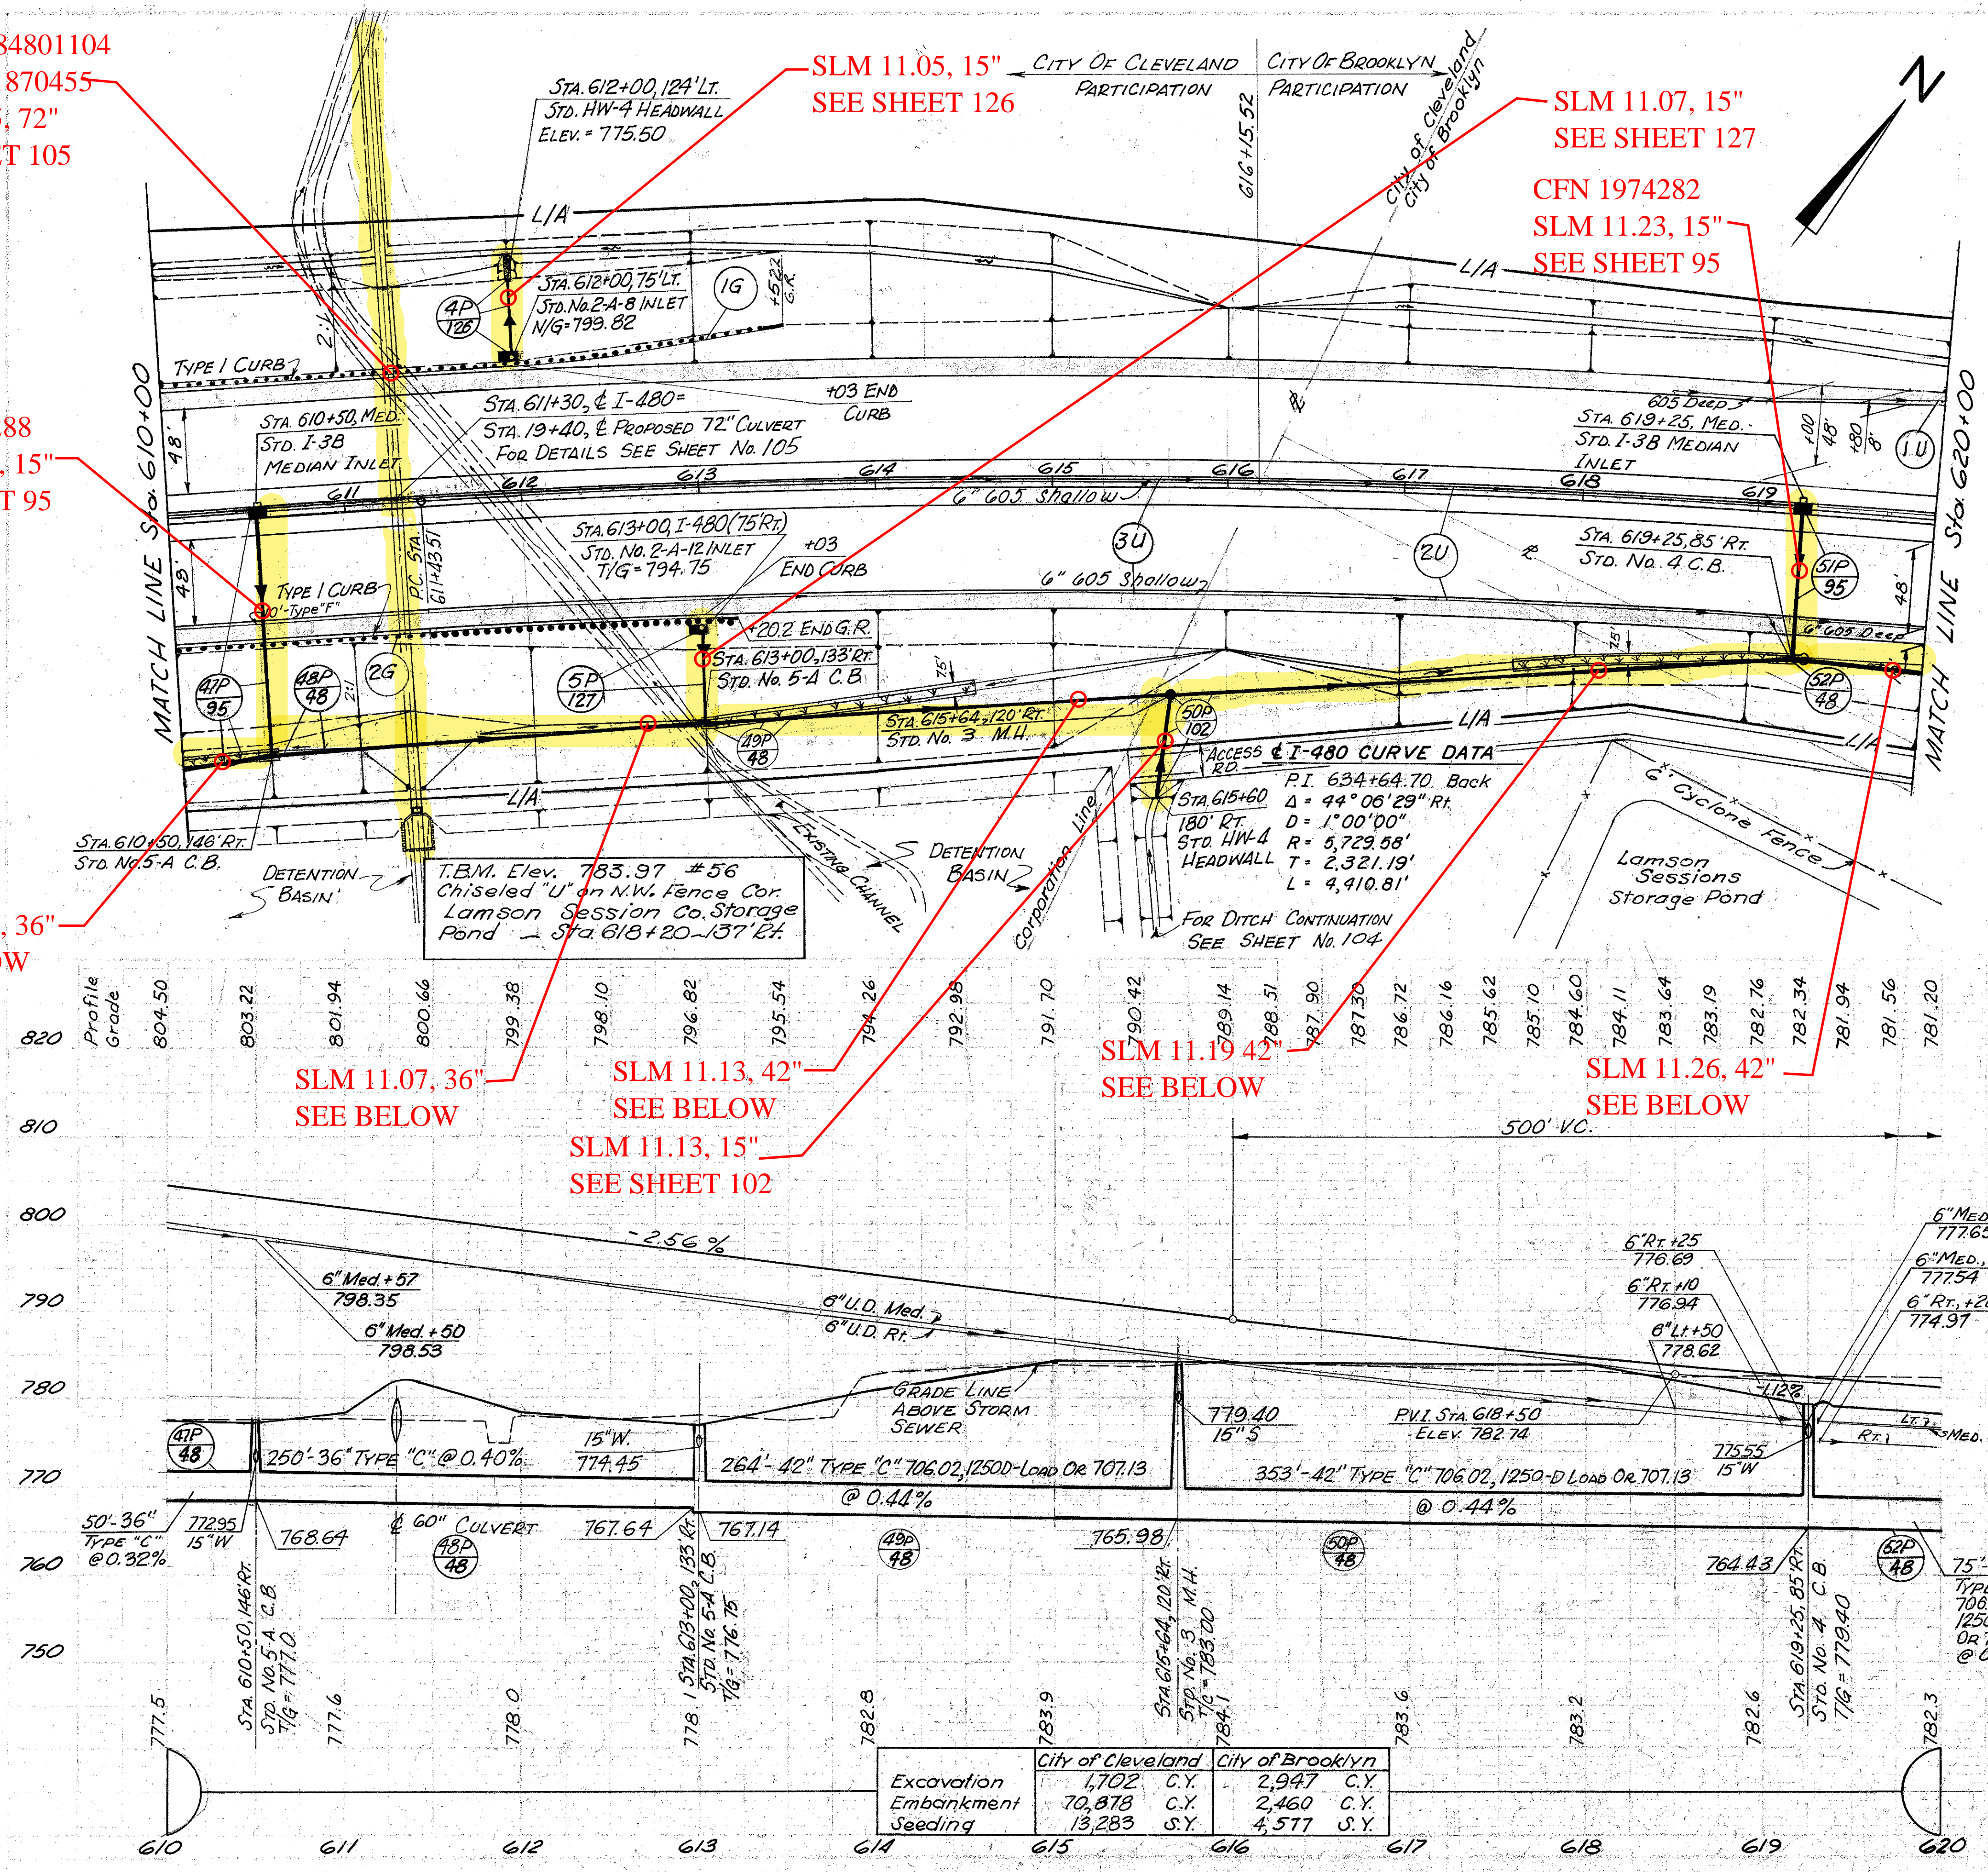

TREE REMOVAL 610+00 TO 620+00	
Size	N ^o
18"	0

ROADWAY	ITEM	EA.	LF	EA.	LF	EA.	LF	EA.	LF
606	ANCHOR ASSEMBLY TYPE "A"	1							
	ANCHOR ASSEMBLY TYPE "T"	1							
	Guard Rail								
660	SODDING								
	SHALLOW								
605	Bends & Branches								
	Deep								
604	STD. No. 2-A-12 INLET								
	STD. No. 2-A-8 INLET								
	STD. No. 5-A C.B.								
603	STD. No. 3 M.H.								
	STD. No. 4 C.B.								
602	Std. No. I-3B Median Inlet								
	CONCRETE MASONRY								
603	Type "C" 706.02 1250-D-Load Or 707.13								
	Type "C"								
603	Type "C"								
	Type "B"								
603	Type "F" 707.05								
	Type "F"								
603	Excavation								
	Embankment								
603	Seeding								
	Seeding								

	City of Cleveland	City of Brooklyn
Excavation	1,702 C.Y.	2,947 C.Y.
Embankment	70,878 C.Y.	2,460 C.Y.
Seeding	13,283 S.Y.	4,577 S.Y.