


CUYAHOGA COUNTY
CUY-480-10.39

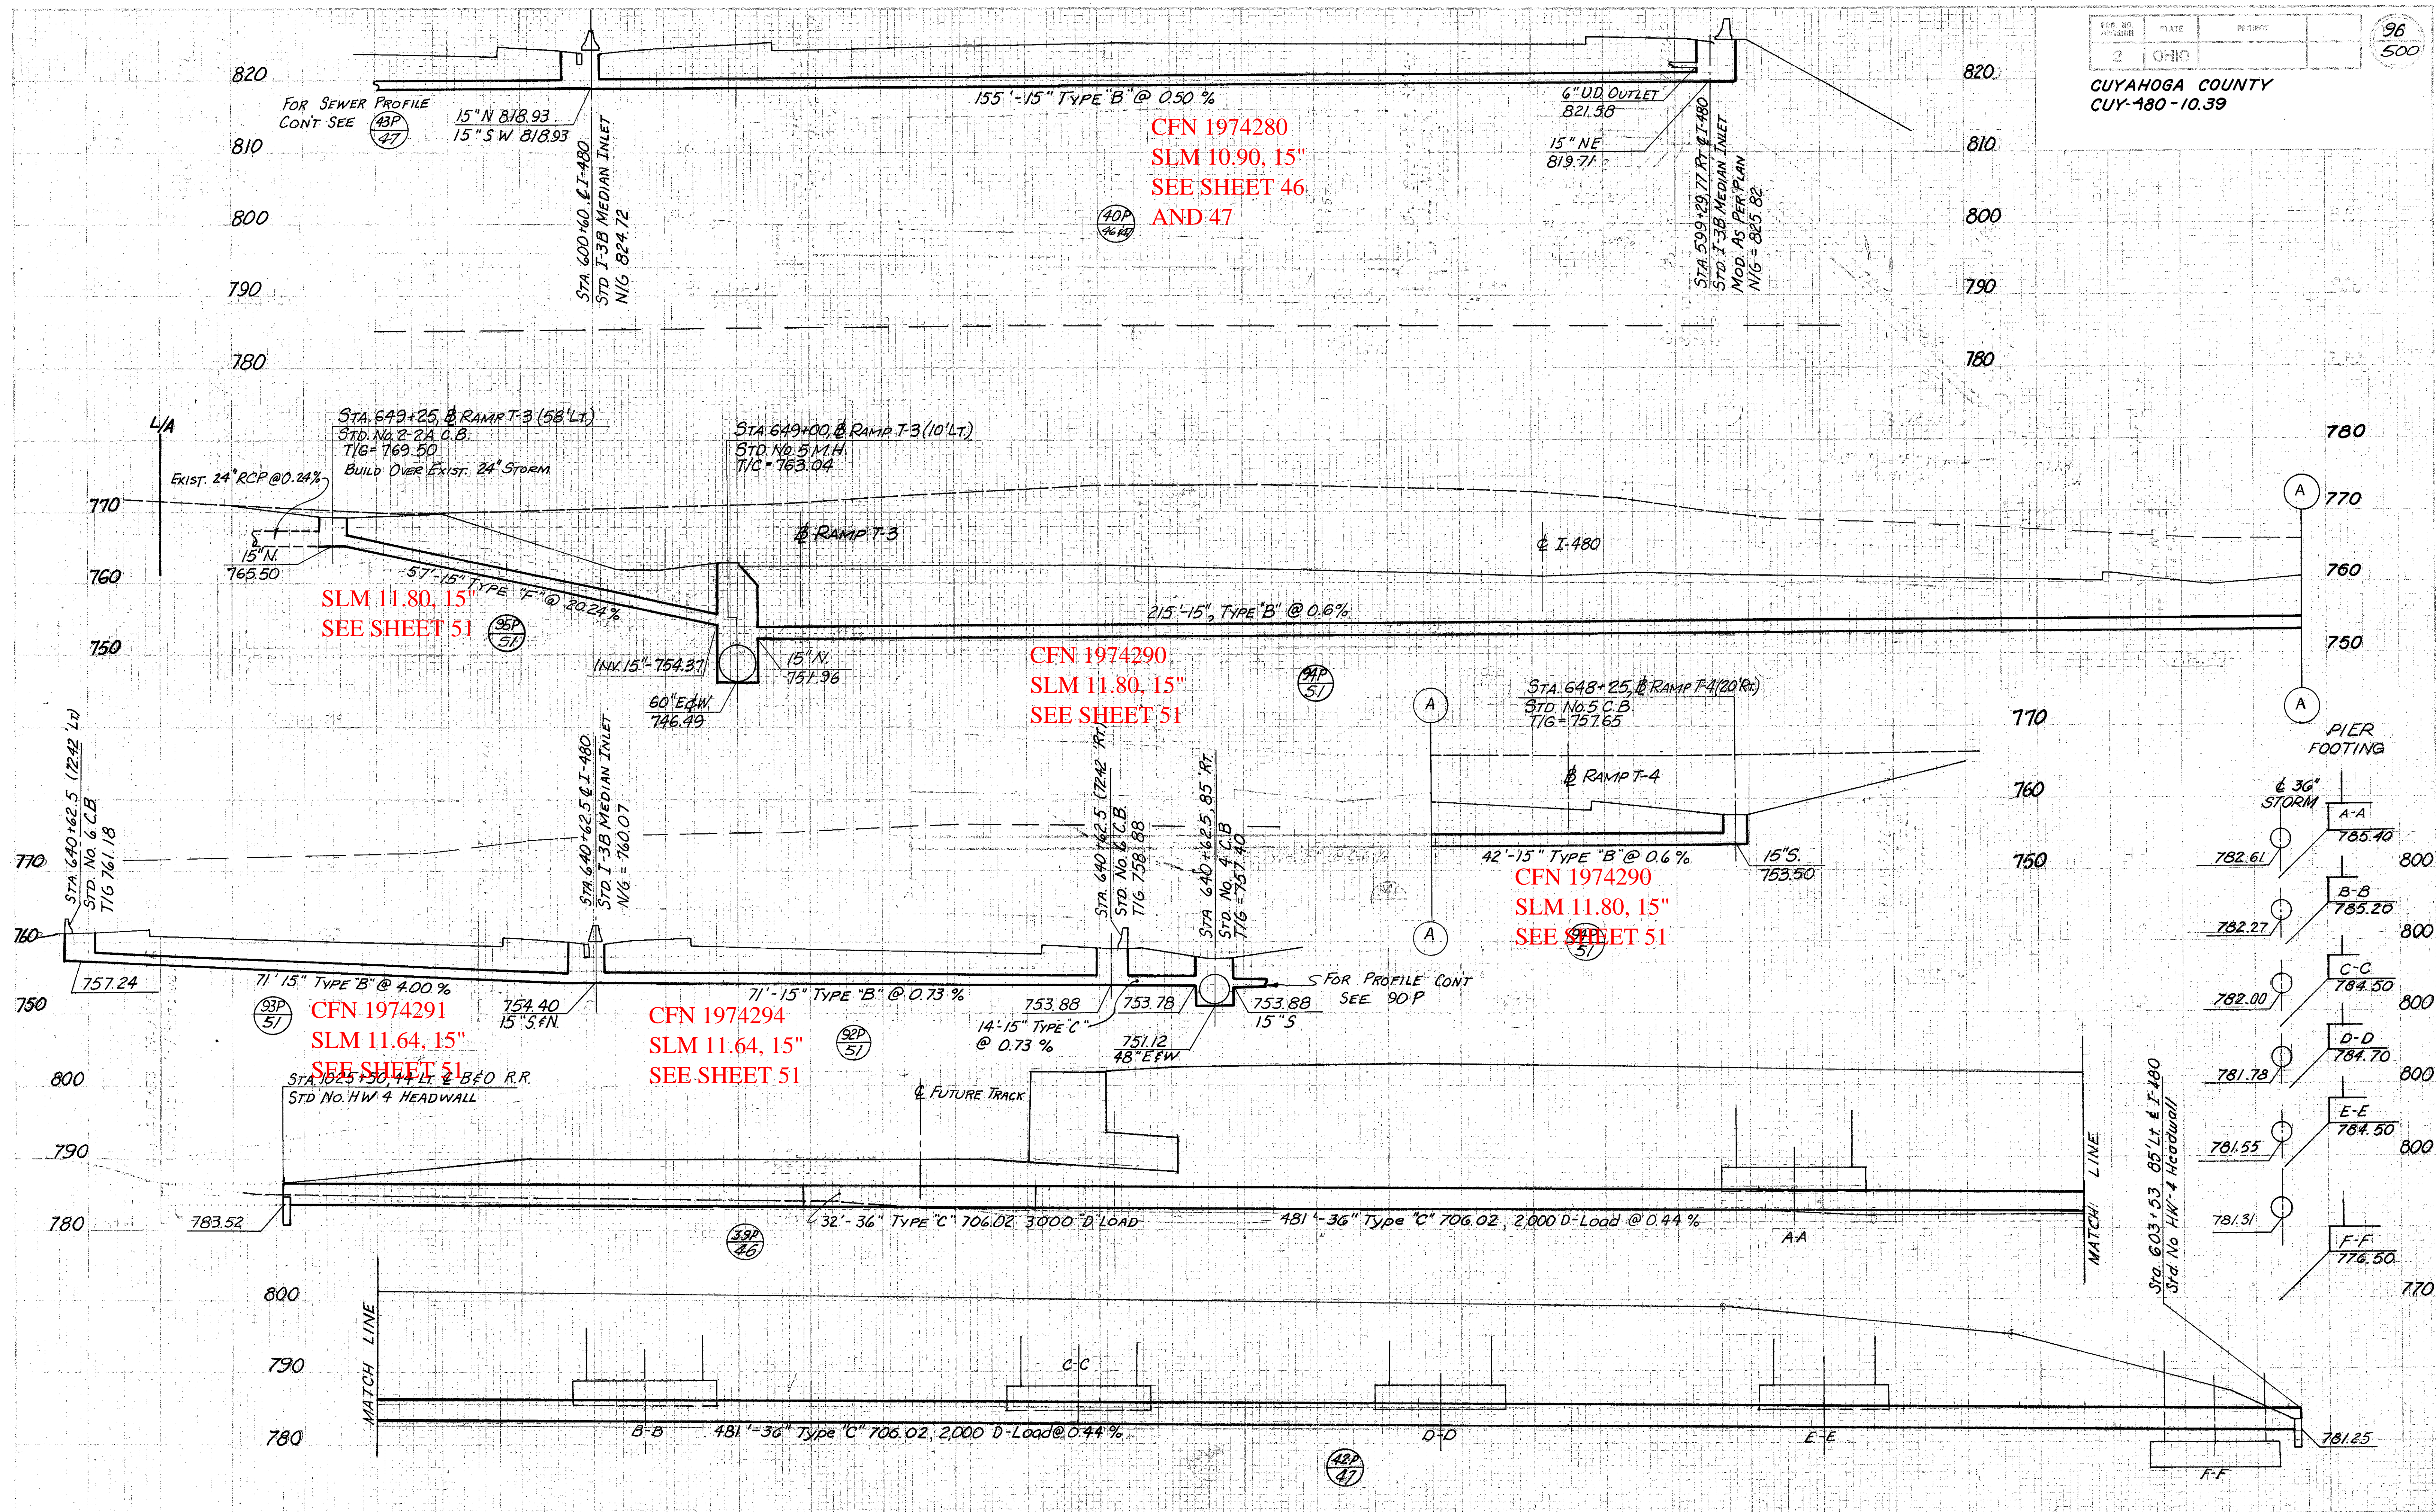

STORM SEWER PROFILE