


CFN 1972262  
SLM 8.05, 12"  
SEE SHEET 187

CFN 1972259  
SLM 8.08, 15"  
SEE SHEET 187

CFN 1972295  
SLM 8.11, 18"  
SEE SHEET 187

CFN 1972276  
SLM 8.16, 21"  
SEE SHEET 187

CFN 1972253  
SLM 8.16, 21"  
SEE SHEET 187

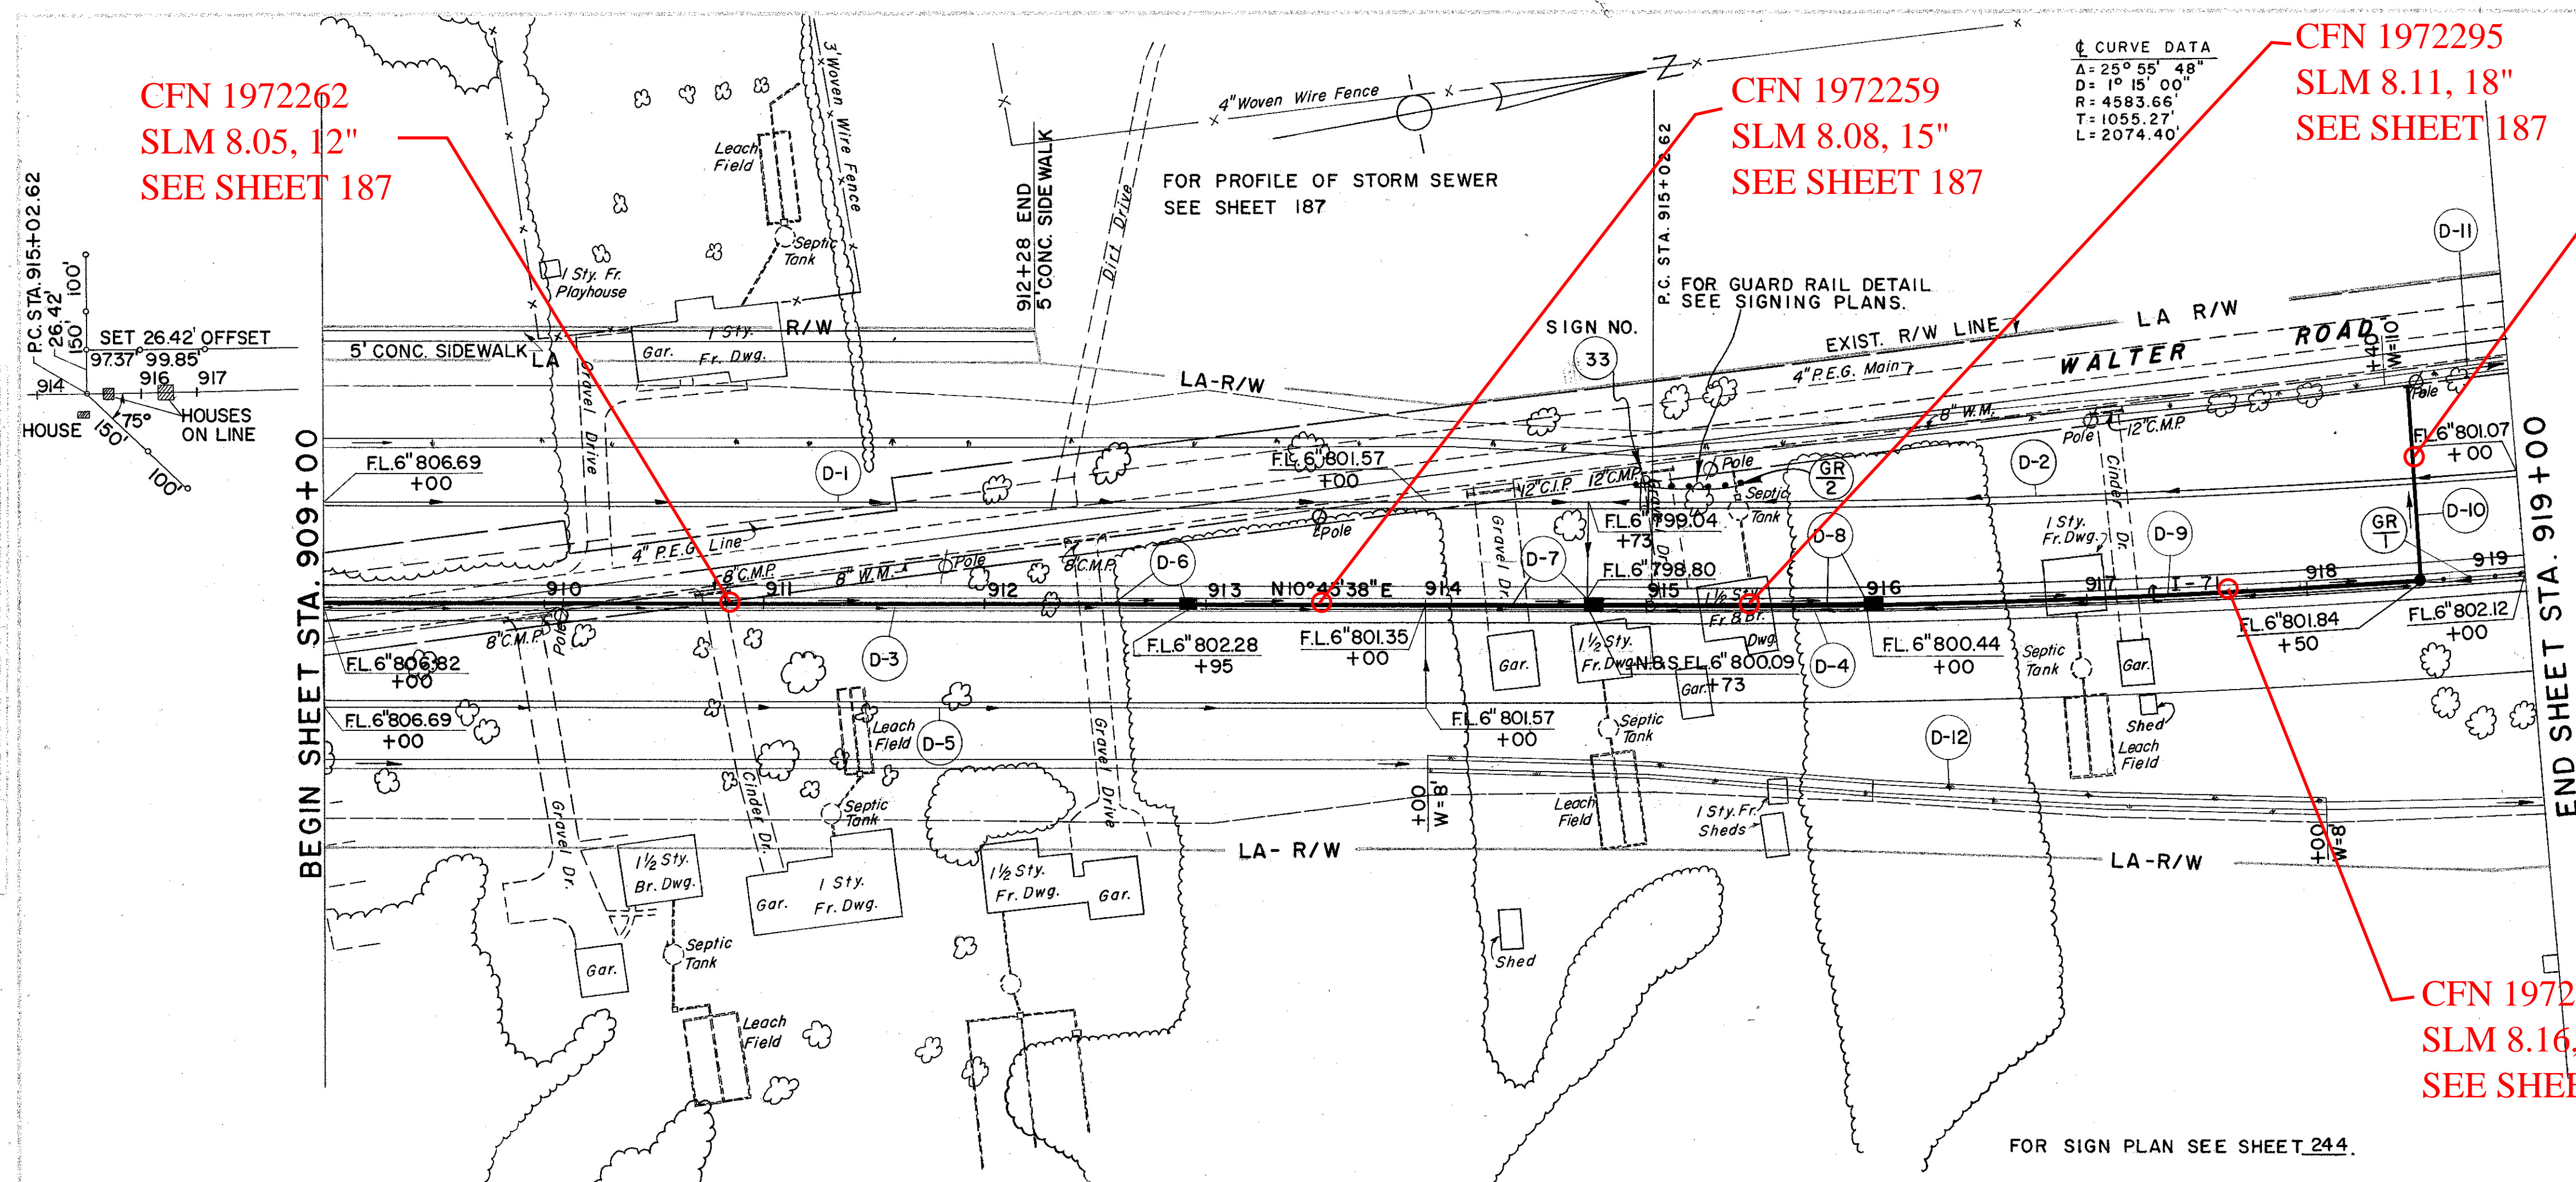


D DRAINAGE

REF. NO.	STATION	FROM	TO	S	I-1	I-5	I-8	I-2	I-10	L-10												
				CLASS	EA.	EA.	C.Y.	S.Y.														
D-1	909+00	914+00	LT.	500																		
D-2	914+00	919+00	LT.			I																
D-3	909+00	914+00	€	490																		
D-4	914+00	919+00	€																			
D-5	909+00	914+00	RT.	500		I	I															
D-6	909+00	912+95	€																			
D-7	912+95	914+73	€																			
D-8	914+73	916+00	€																			
D-9	916+00	918+50	€																			
D-10	918+50	919+00	€																			
D-11	918+40	919+00	LT.																			
D-12	914+00	918+00	LT.																			
TOTAL					1490	945	72	80	395	178	127	250	88	I	2	I	3	0.36	2.7	2	67	356

ROADWAY

ITEM NO.	STATION	FROM	TO	S	I-15	GUARD RAIL	STEEL BEAM (DEEP)	
							AS PER PLAN	BARRIER
GR-1	909+00	919+00	M				1000	
GR-2	914+97	915+47	LT.				50	
TOTAL							50	1000

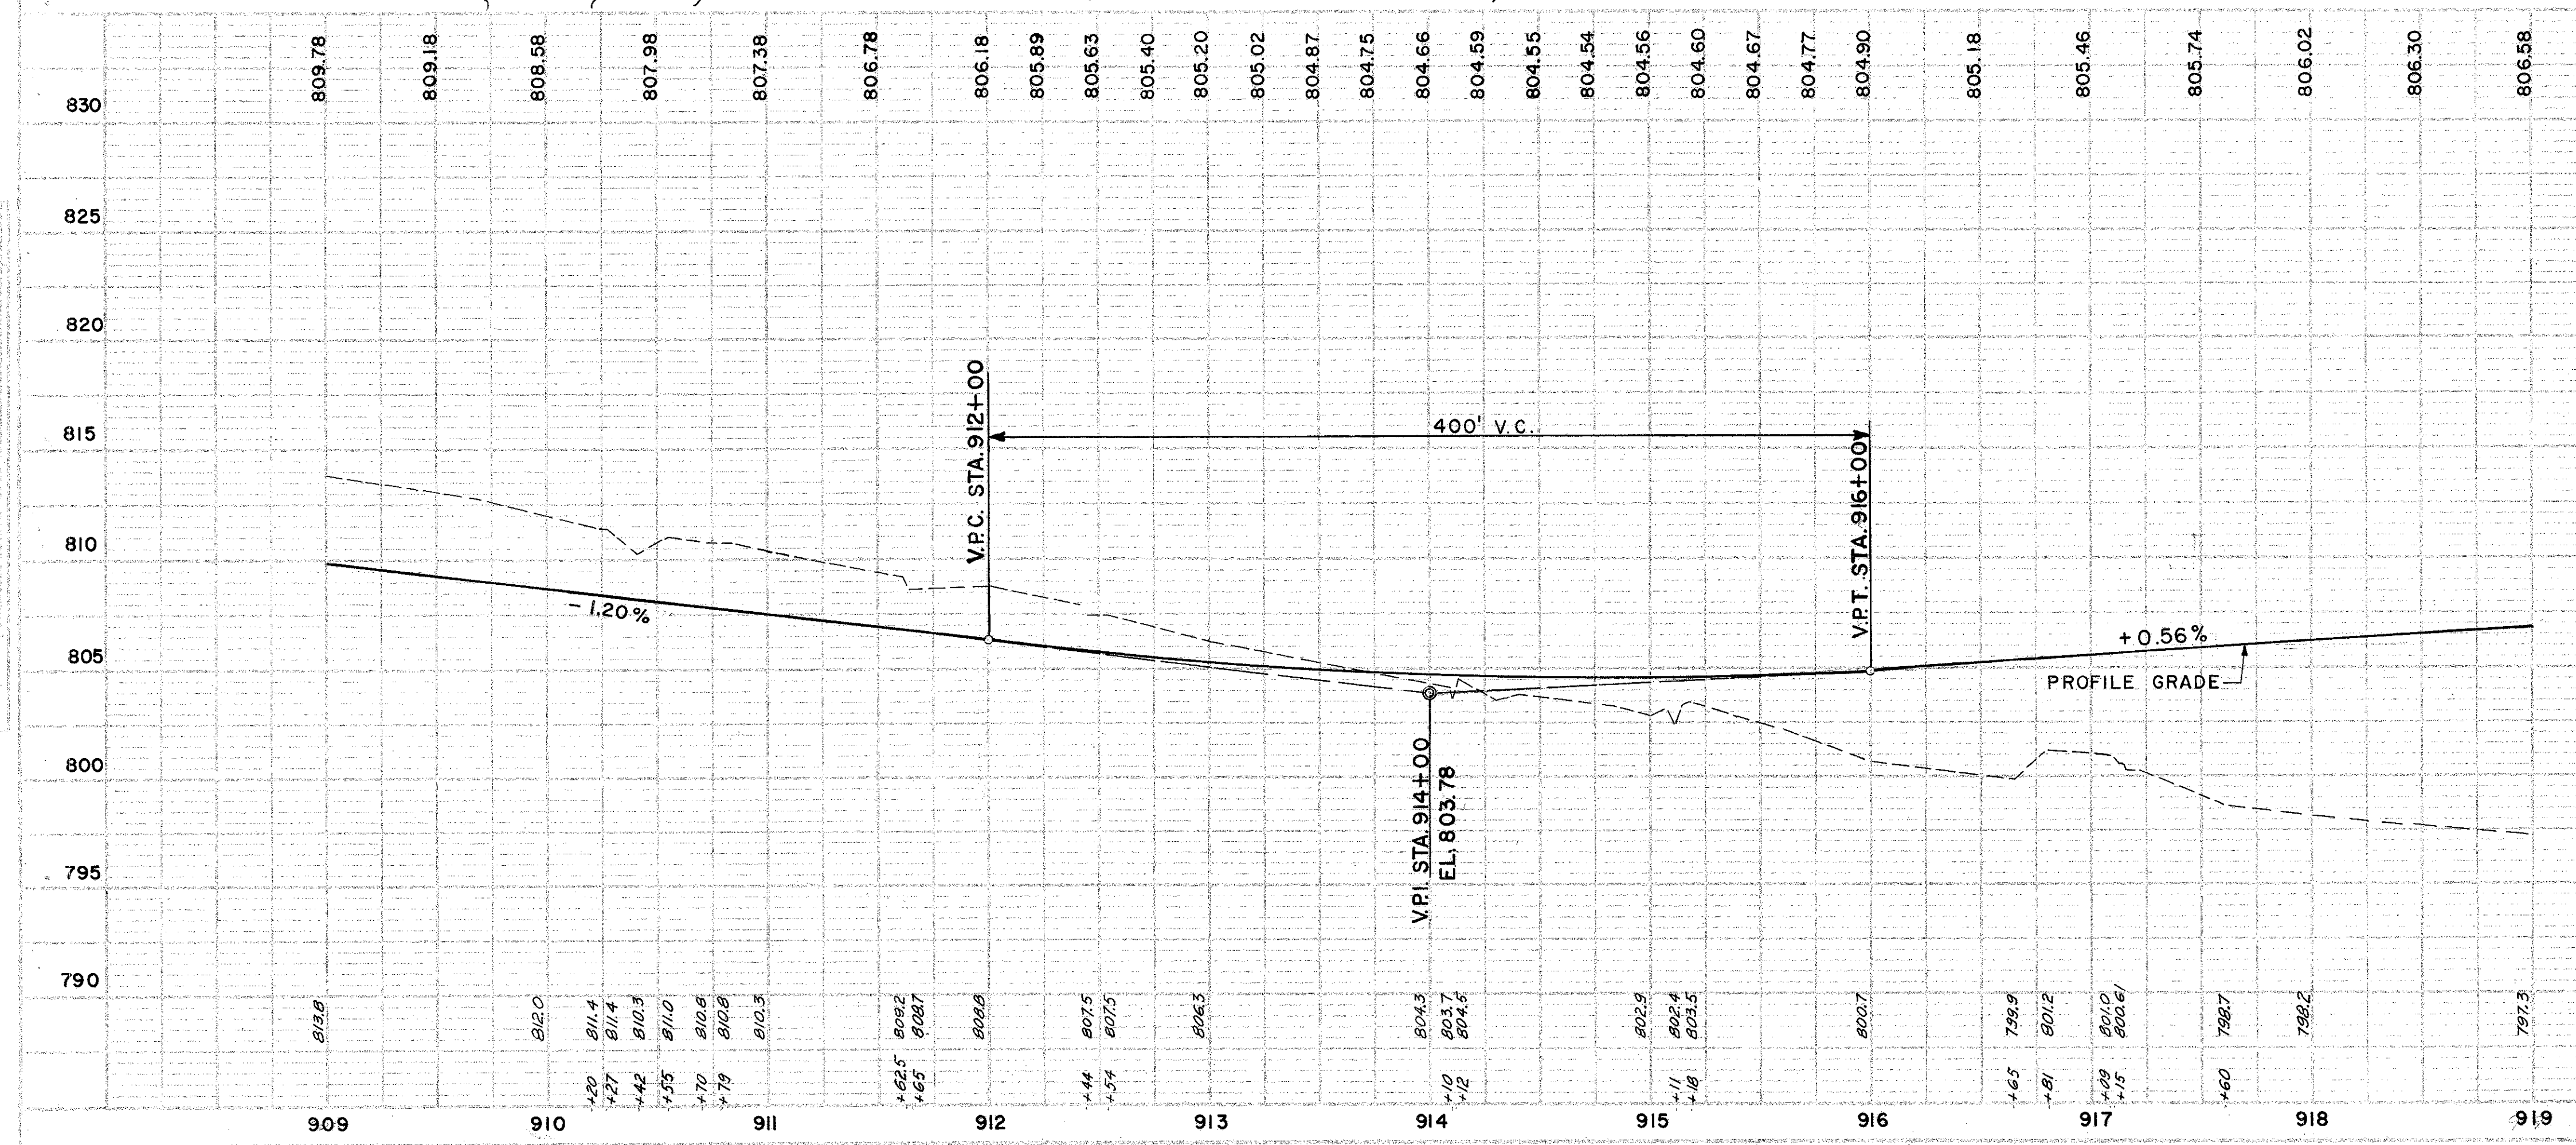

PLAN & PROFILE - STA 909+00 TO STA 919+00