
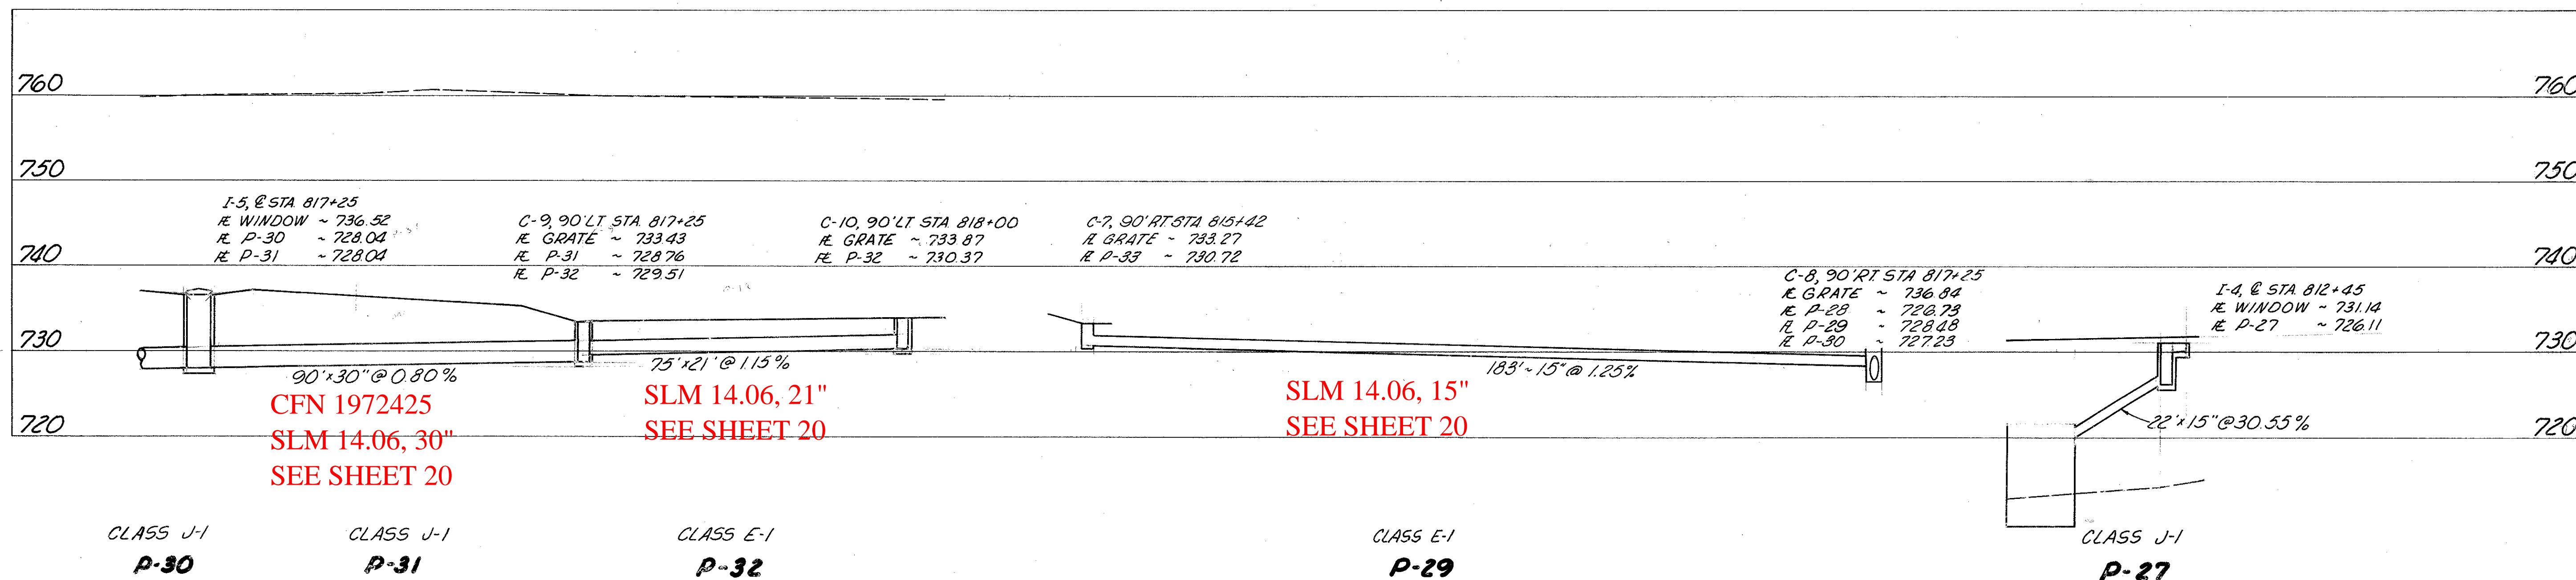


CUYAHOGA COUNTY
CUY-71-13.68

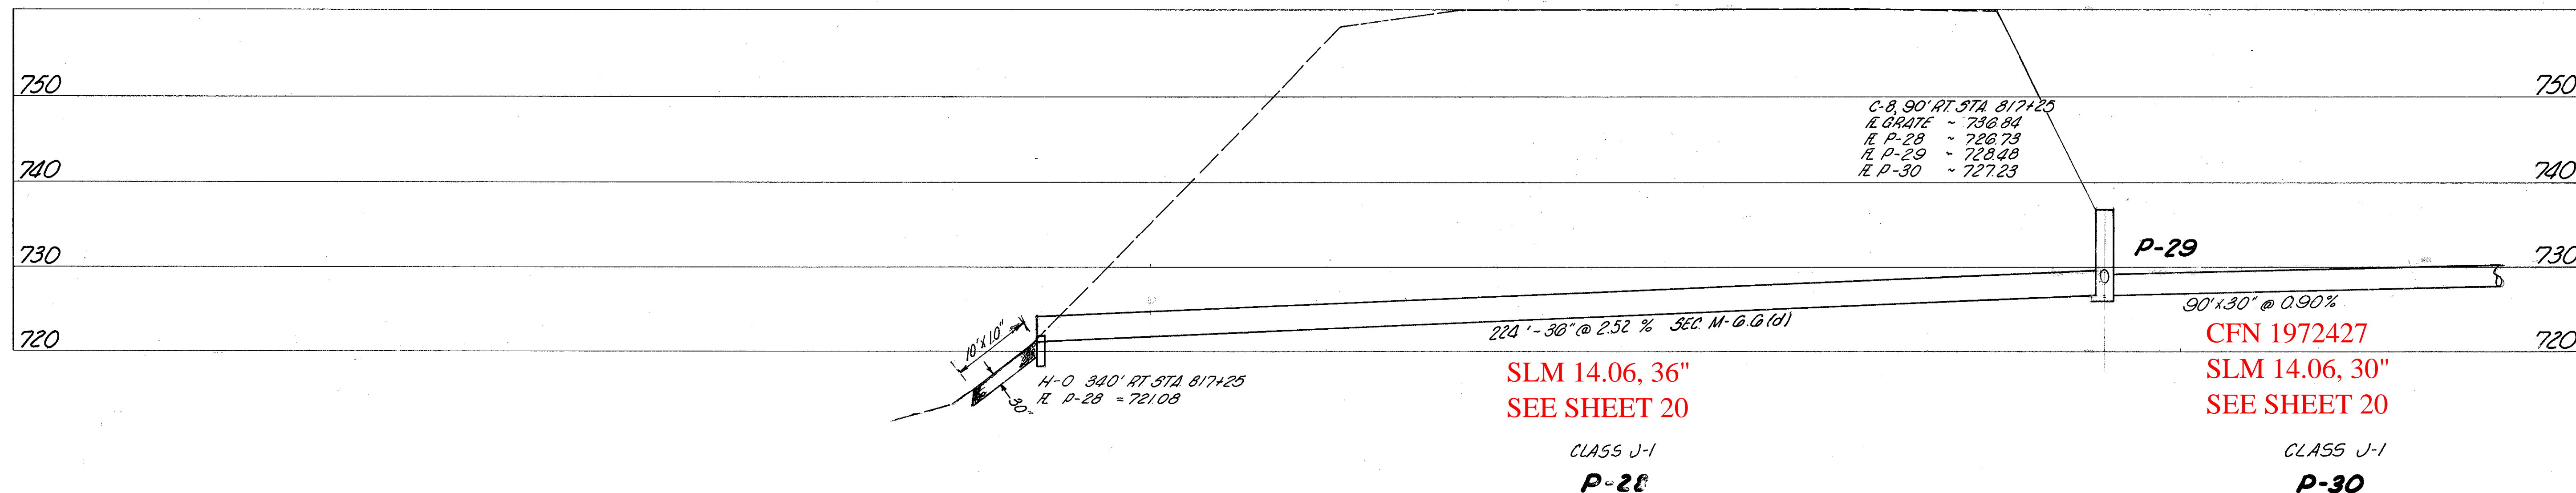

PIPE REFERENCE	STRUCTURES INCLUDED	ESTIMATED QUANTITIES											SEE SHEET NO.		
		I-1			I-8			L-120	I-10	I-2					
		CLASS J-1		CLASS E-1		SPECIAL INLET NO. 2-5	SPECIAL INLET NO. 2-6				STANDARD NO. 5 CATCH BASIN	JUTE MATTING		DUMPED ROCK CHANNEL PROTECTION	MASONRY
		M-G.G.(d)	M-G.G.(d)	Sec M G.G.(d)	15" LIN.FT.	21" LIN.FT.	NO. 2-5 C.B. MODIFIED	NO. 2-6	NO. 5	S.Y.	CY	CY			
P-28	C-7			224											
P-29	C-8				183					1	125	4	026		
P-30	I-5		90												
P-31	C-9		90												
P-32	C-10				75					1	42				
											1	125			
P-27	I-4	22													
TOTALS		22	180	224	183	75	1	1	1	3	417	4	026		

CHECKED BY: []
 PLOTTED BY: []
 DATE: []
 RVT
 []
 []
 []