FED. RD. DIVISION	STATE	PROJECT	
2	OHIO		

113/241

17/28

CUYAHOGA COUNTY
CUY—71—17.18

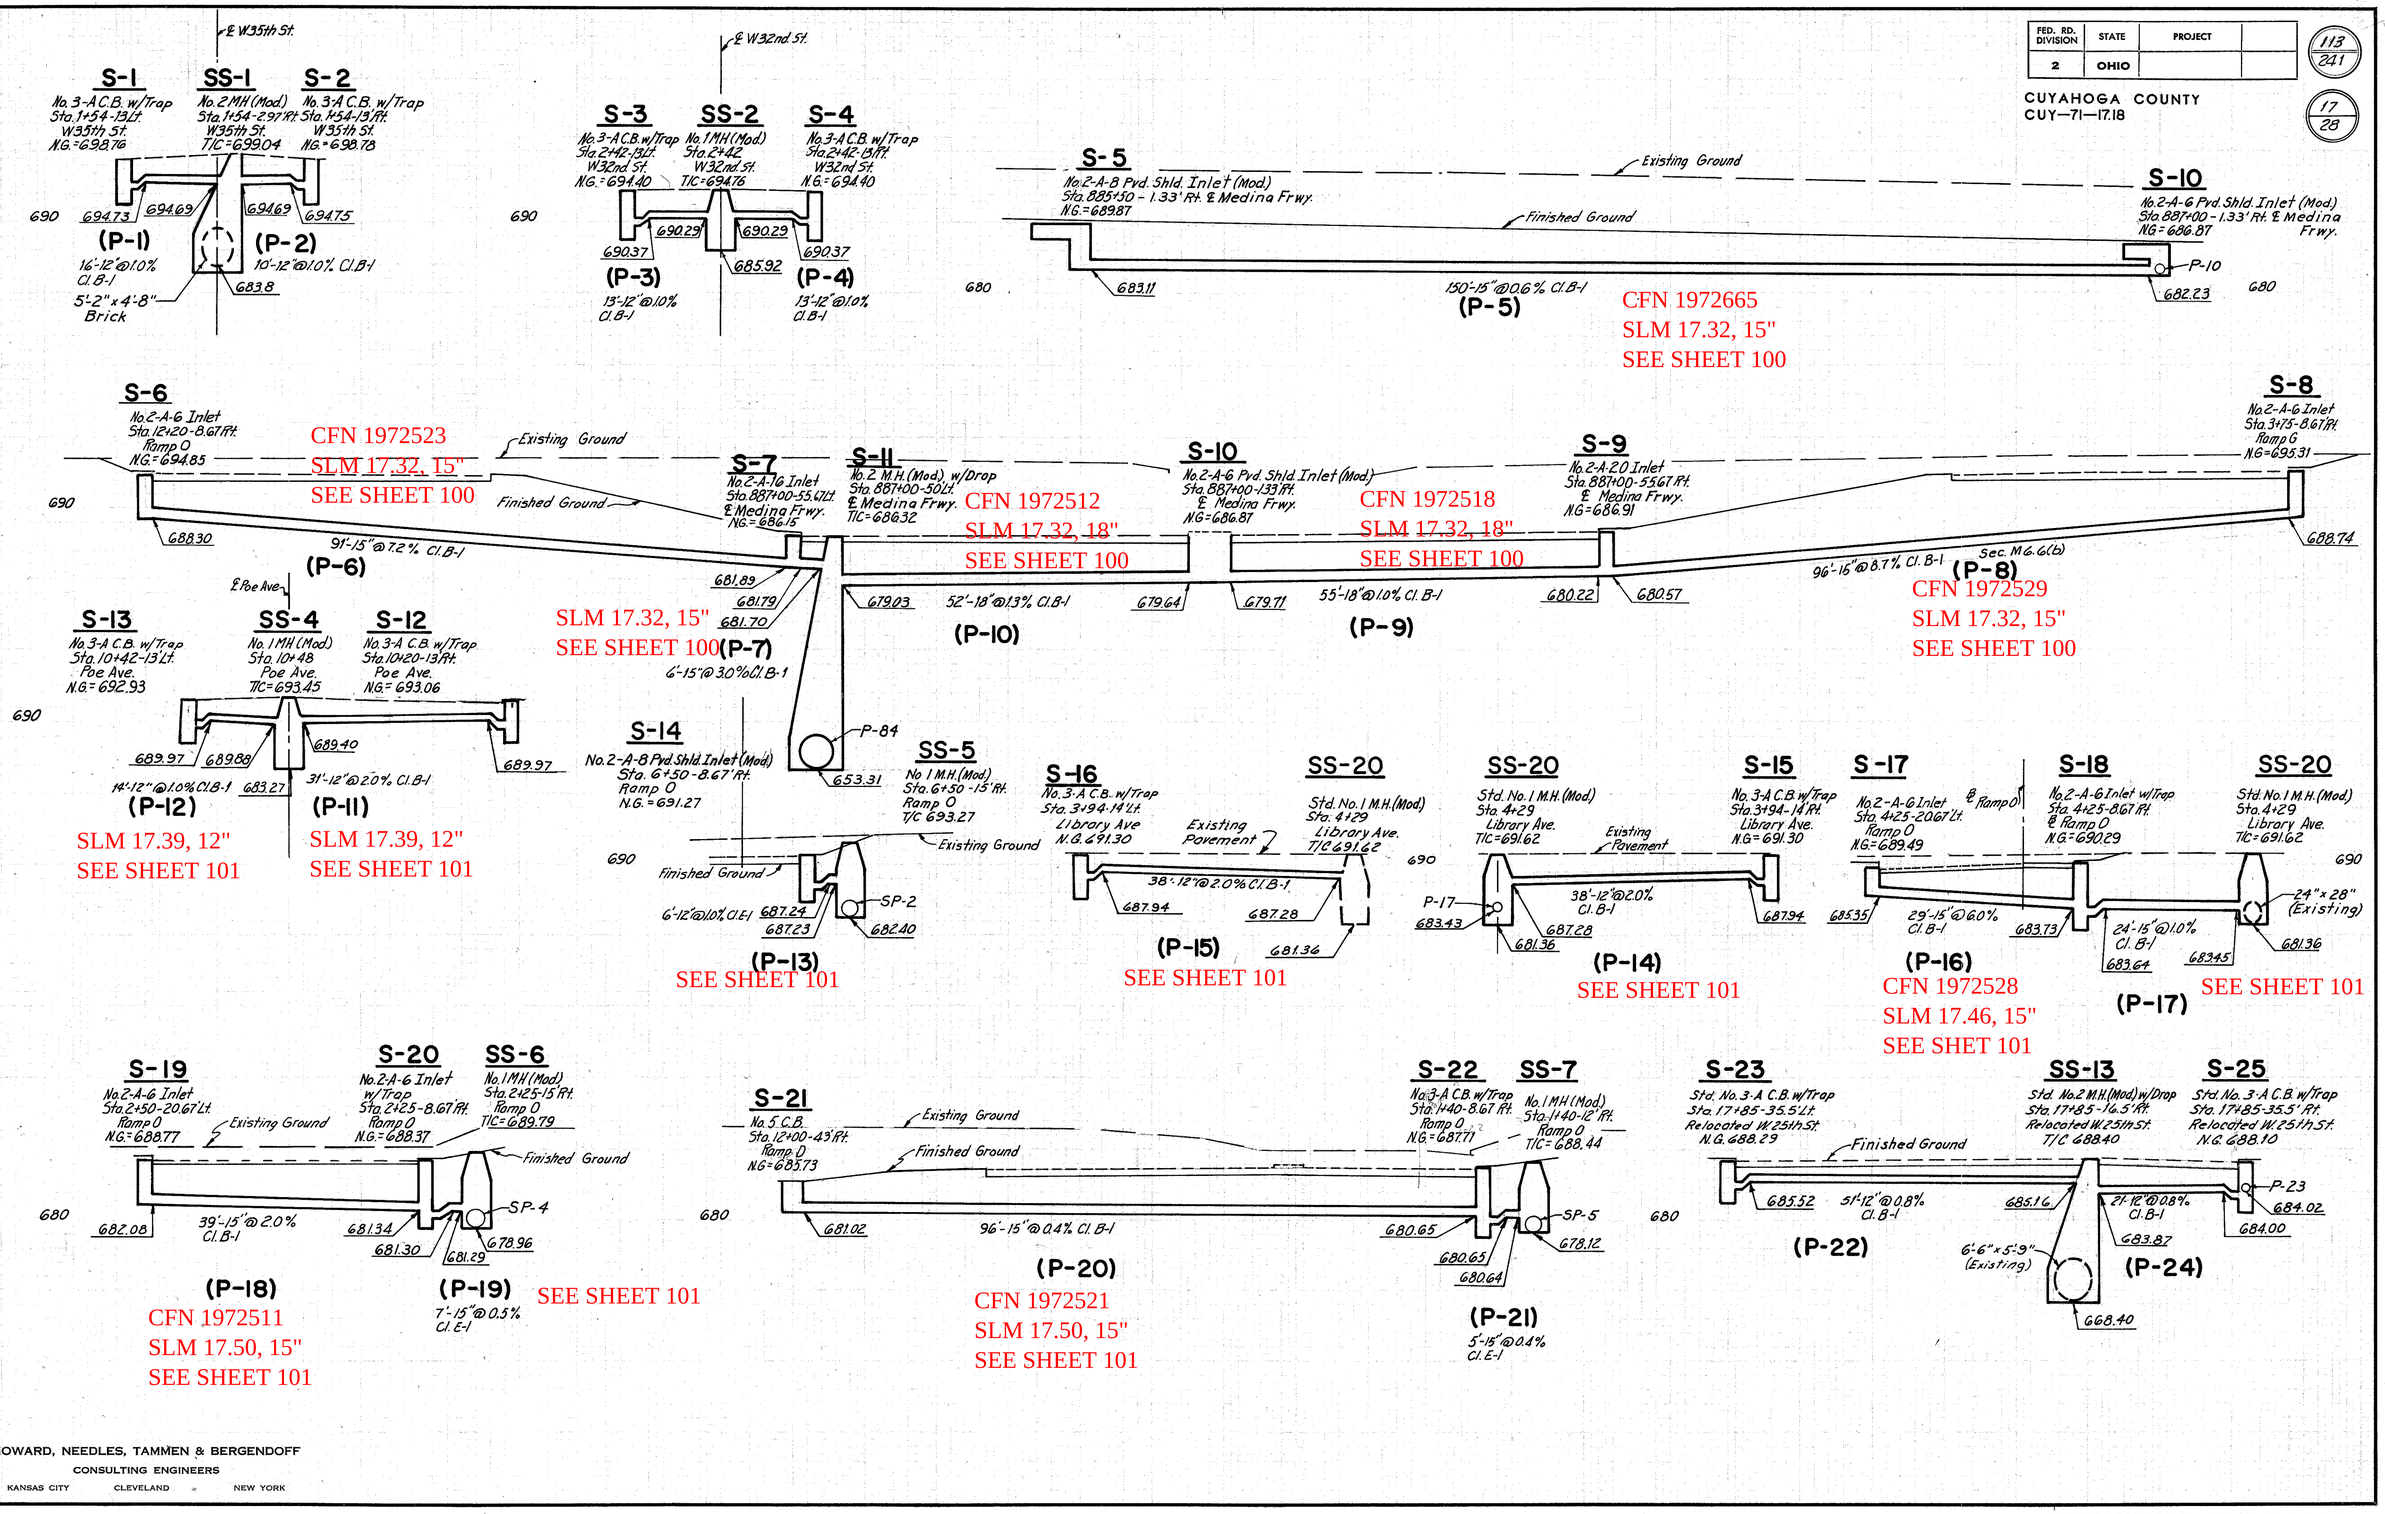

HOWARD, NEEDLES, TAMMEN & BERGENDOFF
CONSULTING ENGINEERS
KANSAS CITY CLEVELAND NEW YORK

SEWER PROFILES P-1 TO P-22 & P-24