FED. RD. DIVISION	STATE	PROJECT	
2	OHIO		

115 / 241

19 / 28

CUYAHOGA COUNTY
CUY-71-17.18

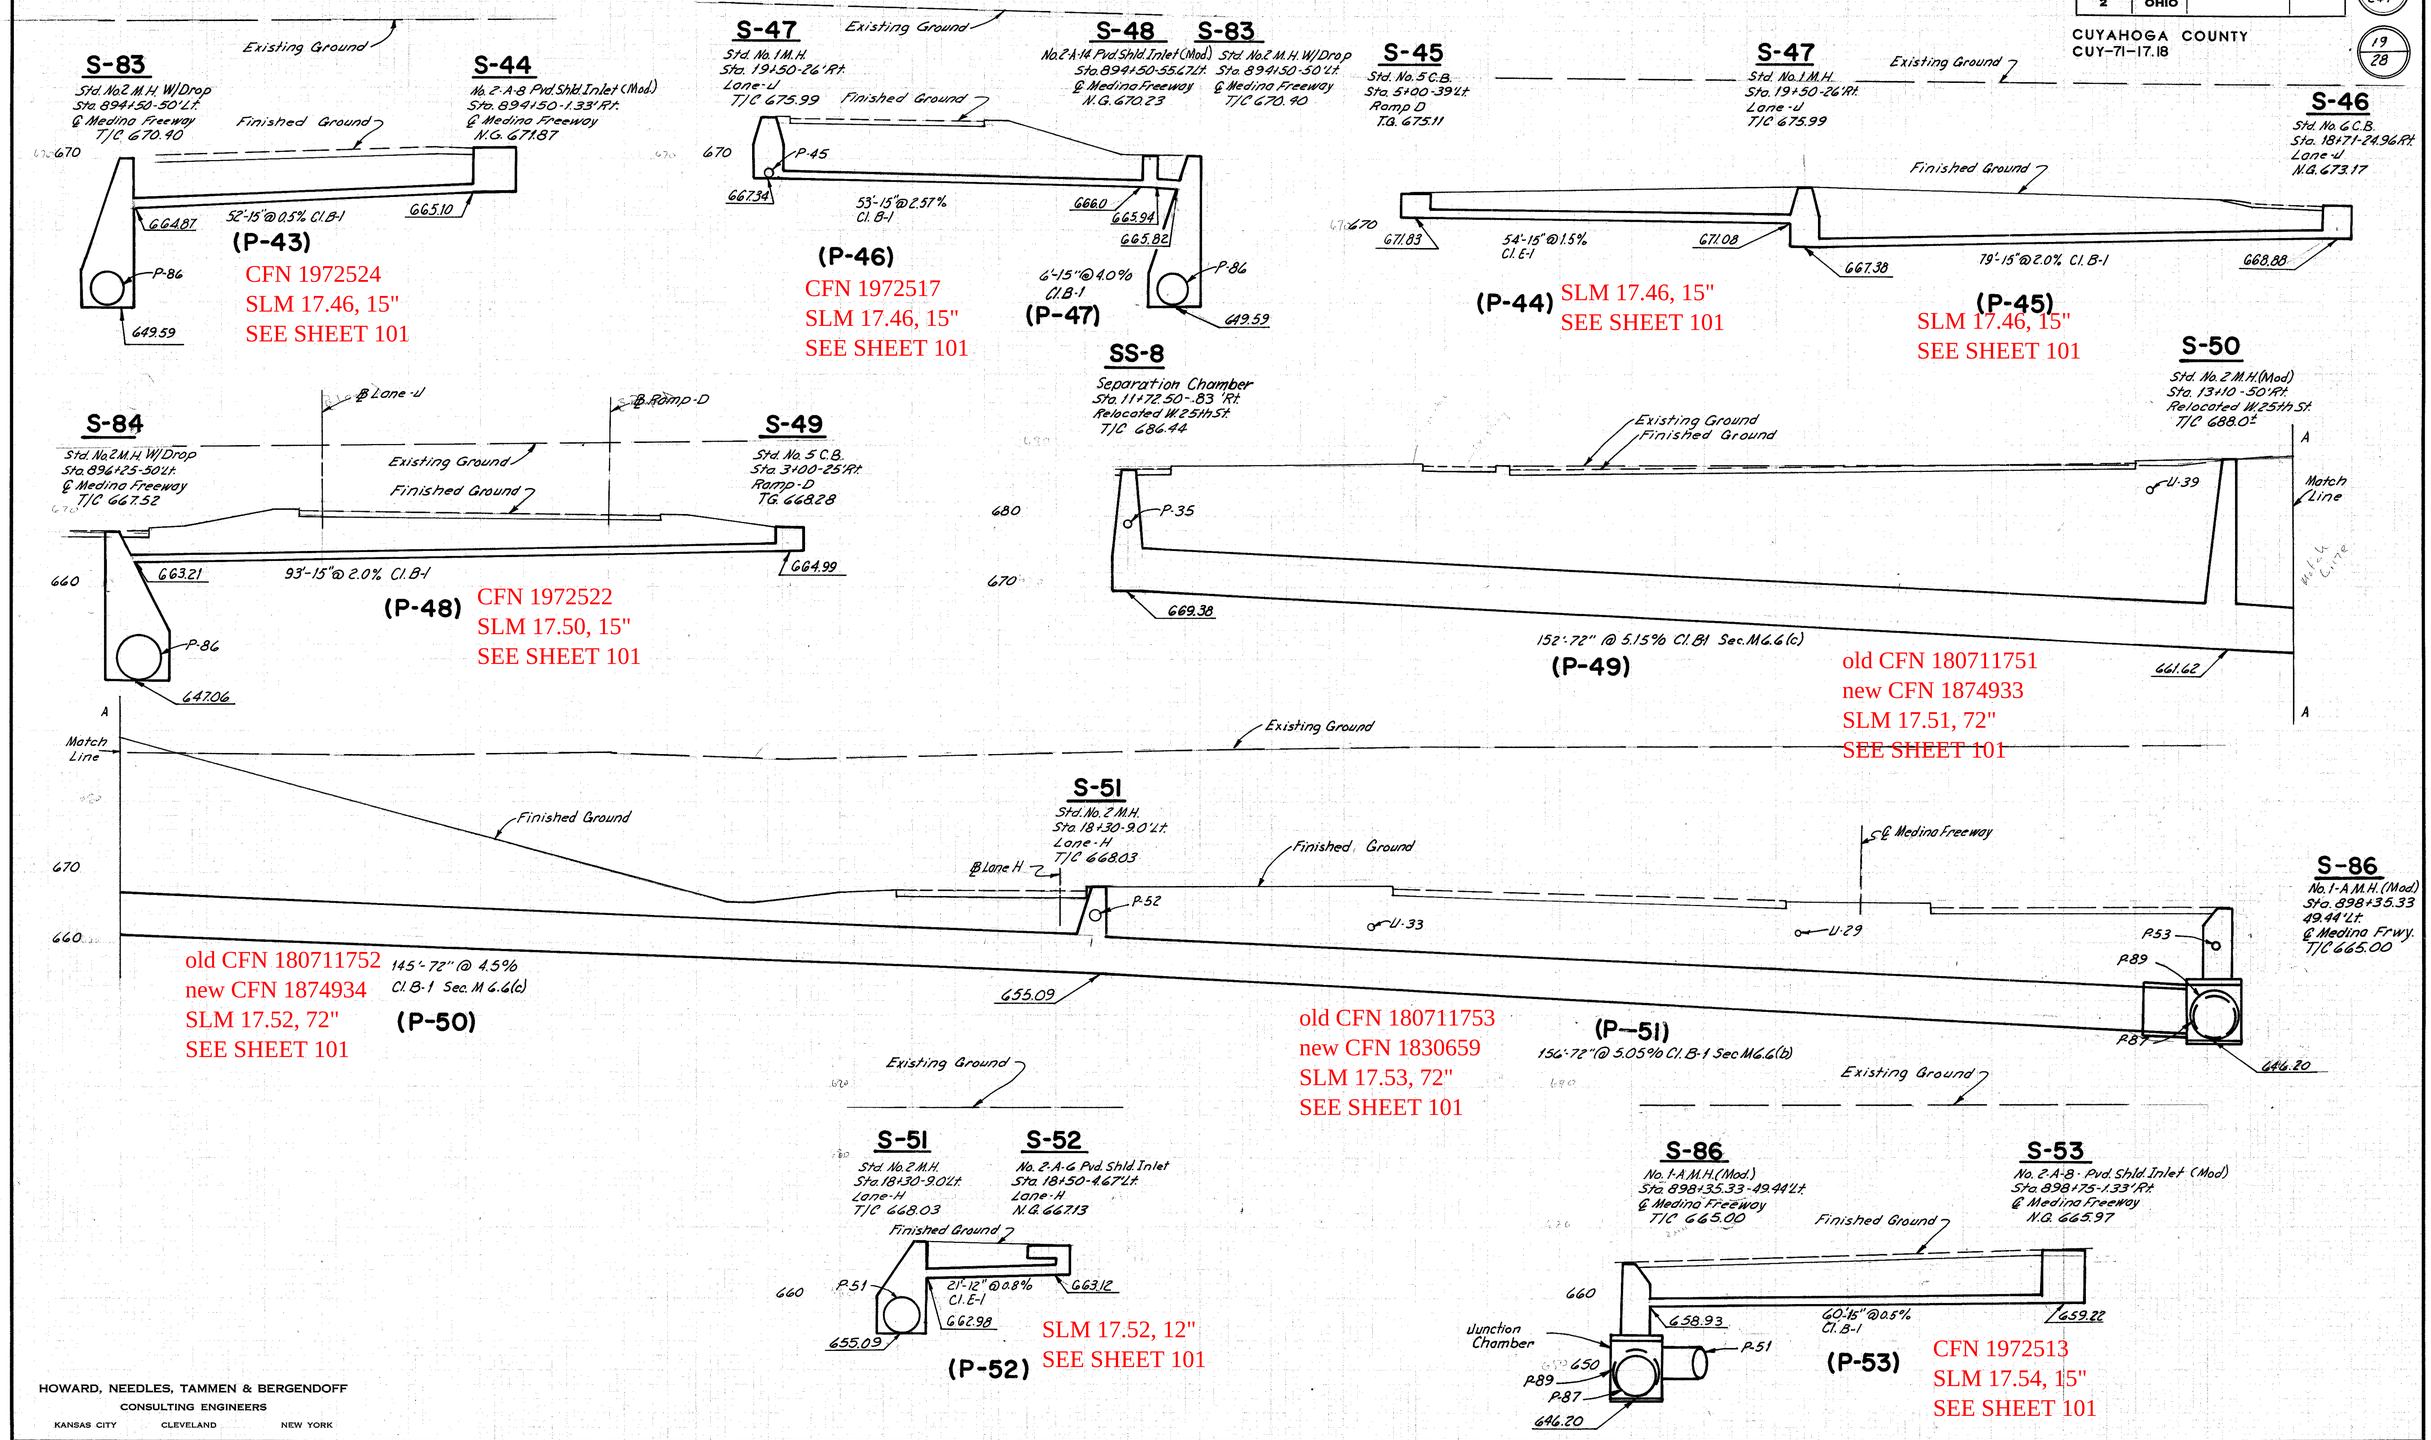

HOWARD, NEEDLES, TAMMEN & BERGENDOFF
CONSULTING ENGINEERS
KANSAS CITY CLEVELAND NEW YORK

R.D.J. 1-29-65 R.B.H. 2-11-65

SEWER PROFILES P-43 TO P-53