


Seeding
End
Width Sq. Yd.

CUYAHOGA & LAKE COUNTIES
CUY-1-15.91
LAK-1-0.00

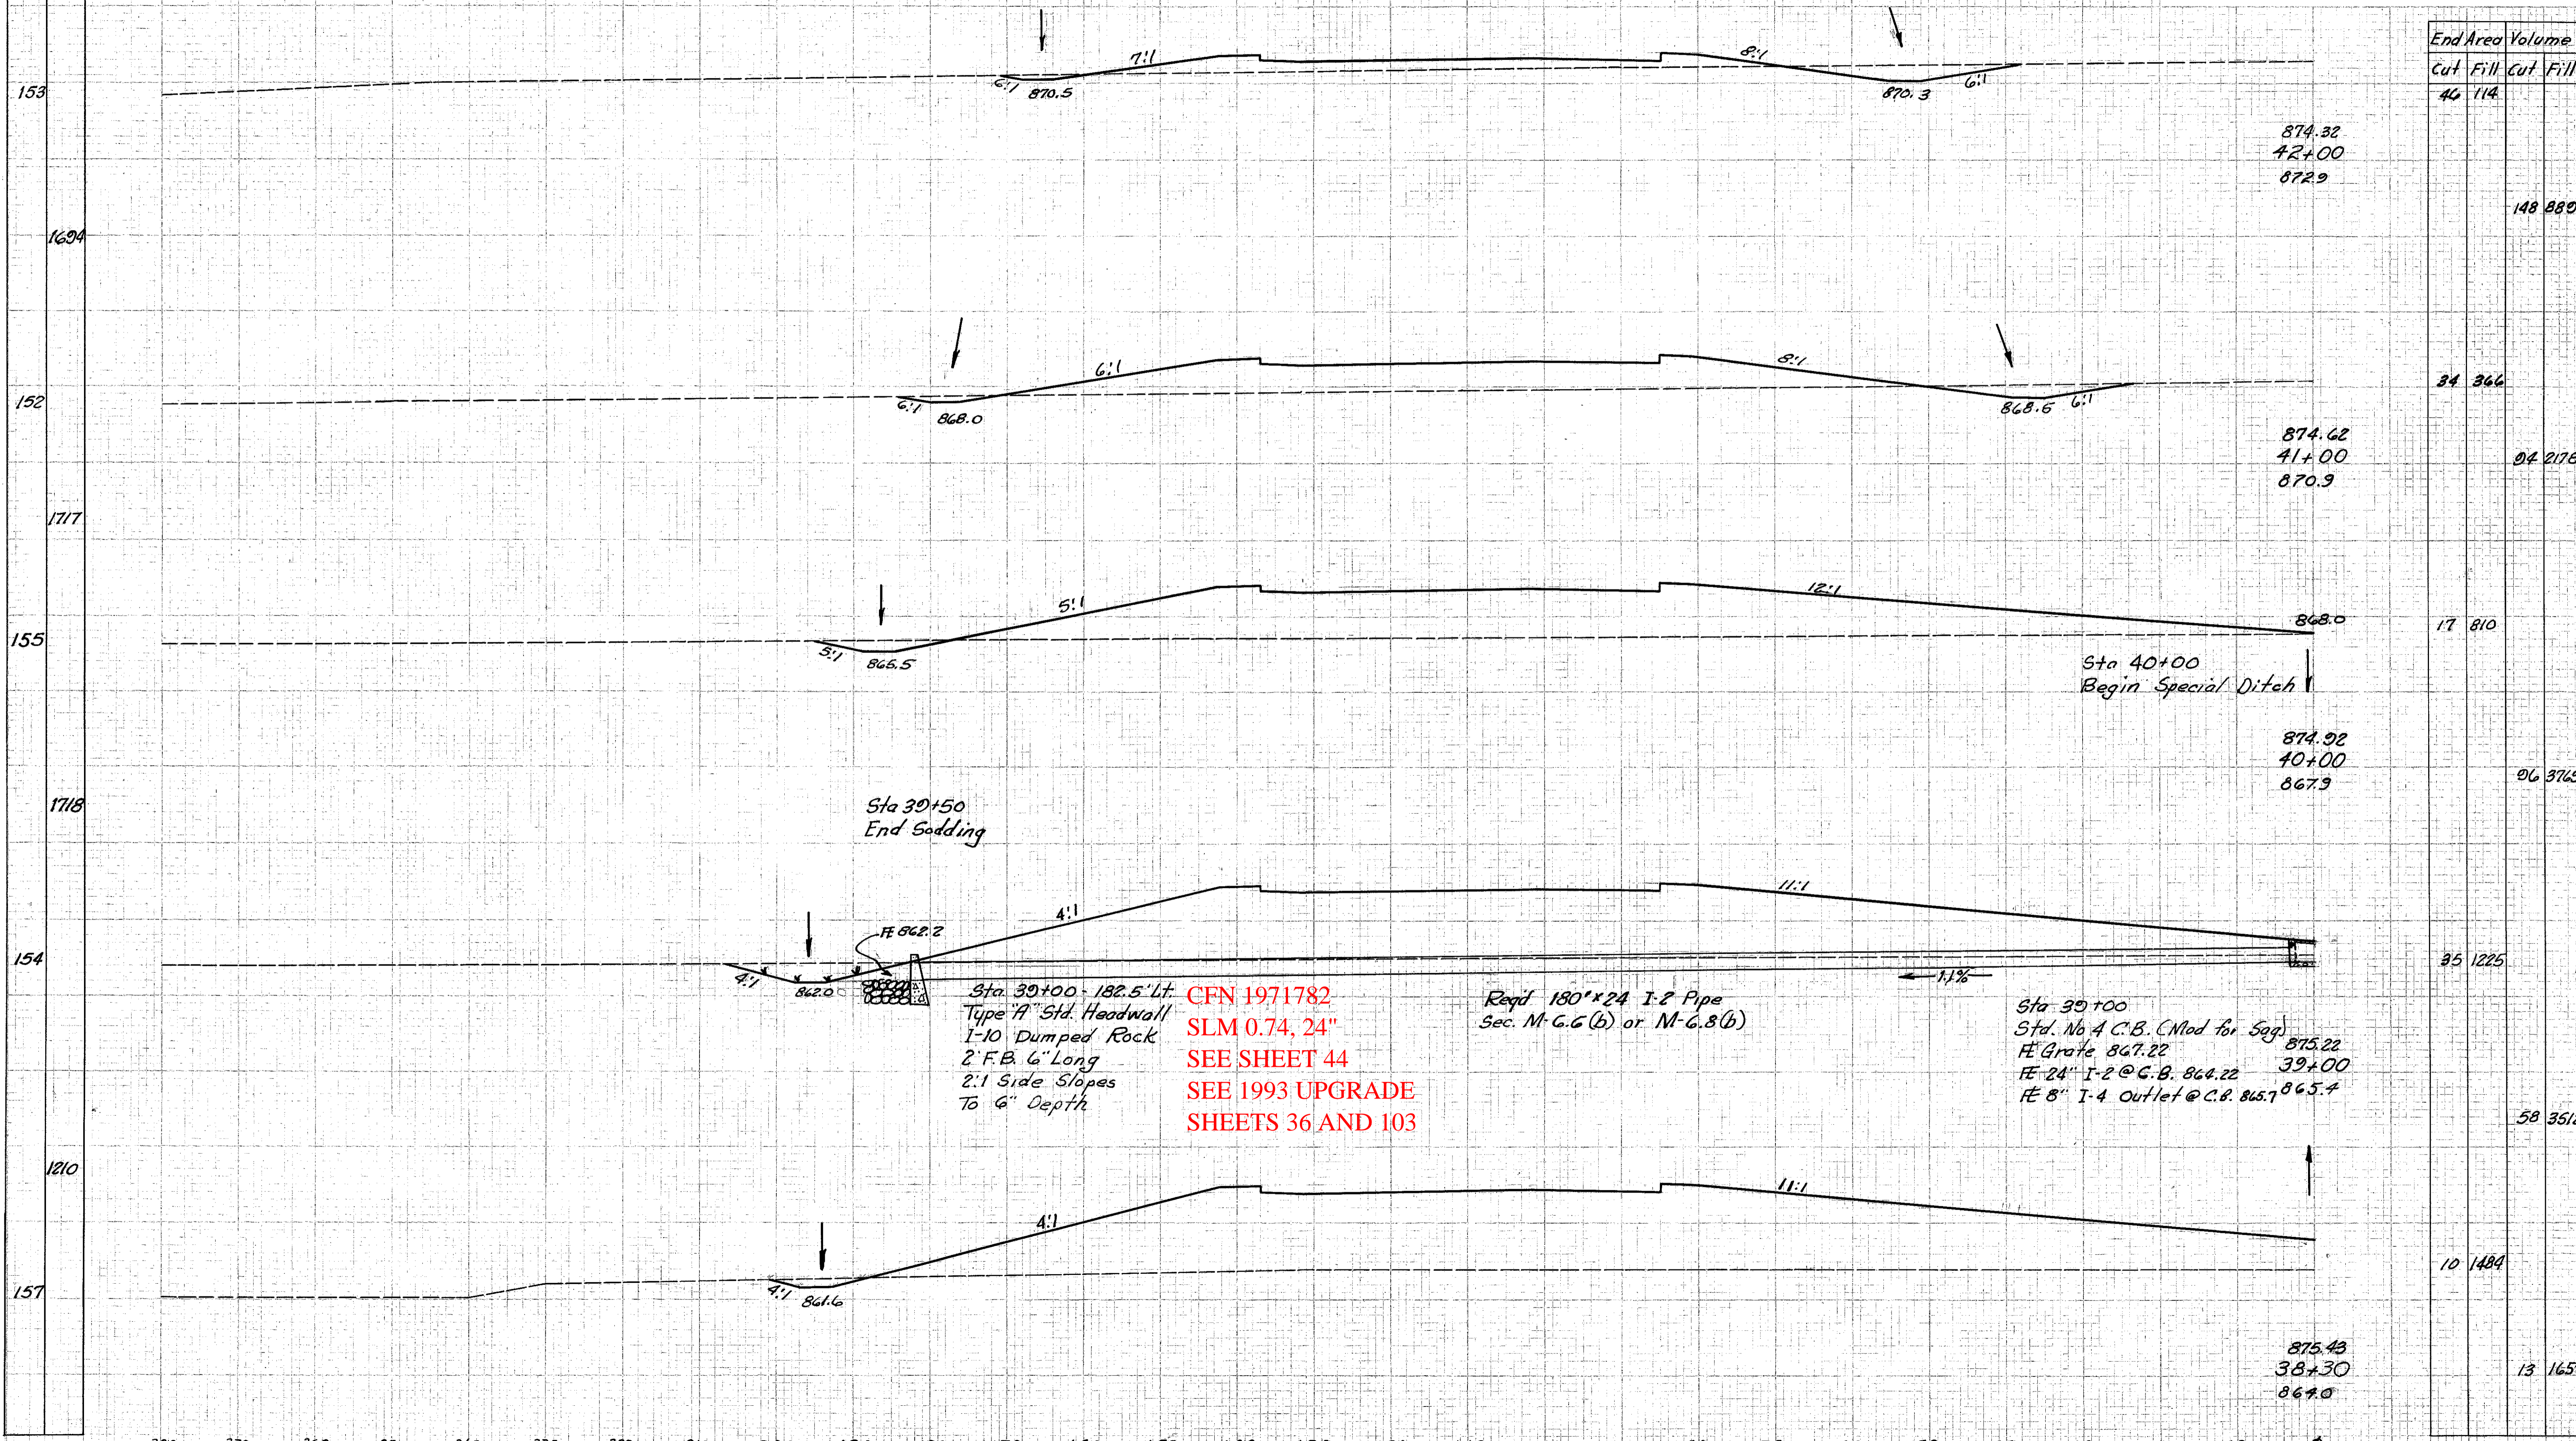


Type 'A' Std. Headwall
1-10 Dumped Rock
2' FB 6" Long
2:1 Side Slopes
To 6" Depth

CFN 1971782
SLM 0.74, 24"
SEE SHEET 44
SEE 1993 UPGRADE
SHEETS 36 AND 103

Req'd 180"x24" I-2 Pipe
Sec. M-G.6 (b) or M-G.8 (b)

Sta 39+00
Std. No 4 C.B. (Mod for 5sq)
FE Grate 867.22
FE 24" I-2 @ C.B. 864.22
FE 8" I-4 Outlet @ C.B. 865.4

Sta. 38+30 to Sta. 42+00 Lt. E