


Seeding
Width Sq.Yd

LAKE COUNTY
LAK-1-2.16

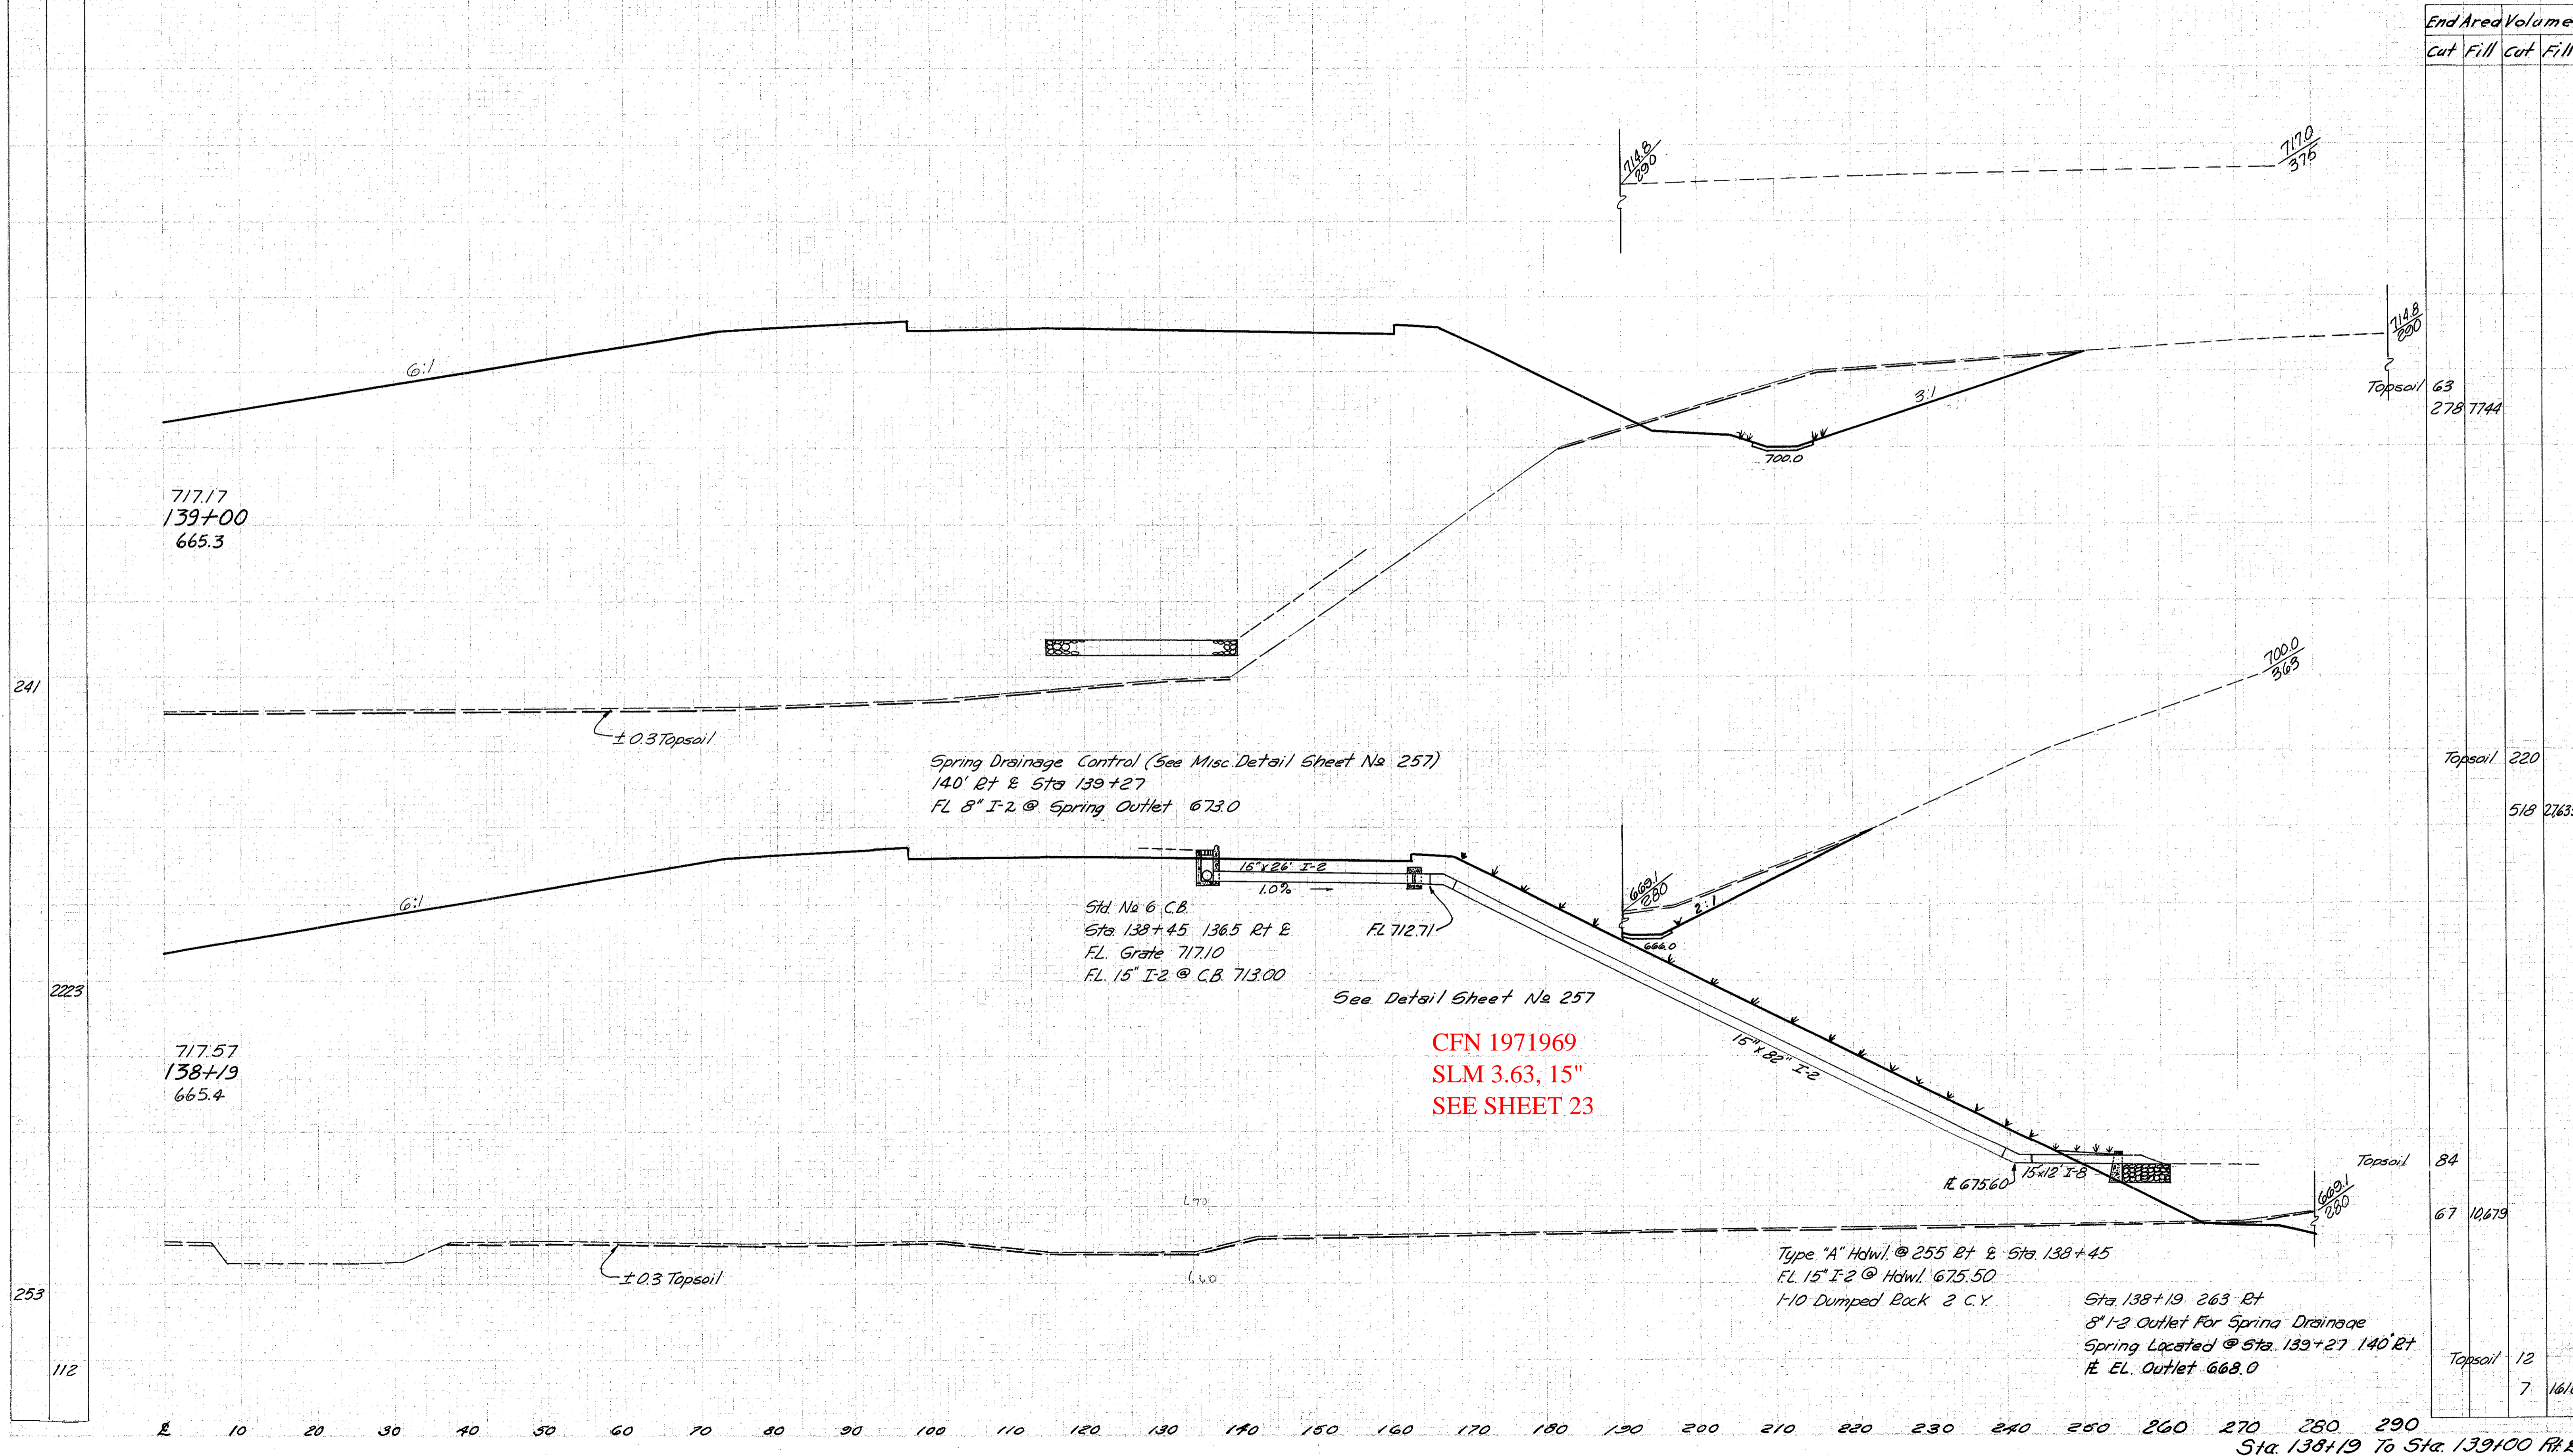

End Area		Volume	
Cut	Fill	Cut	Fill
	63		
	278	1744	
		220	
		518	27635
	84		
	67	10679	
		12	
		7	1610

241

2225

253

112

Sta. 138+19 To Sta. 139+00 Rt &