


LAKE COUNTY  
LAK -I-4.02

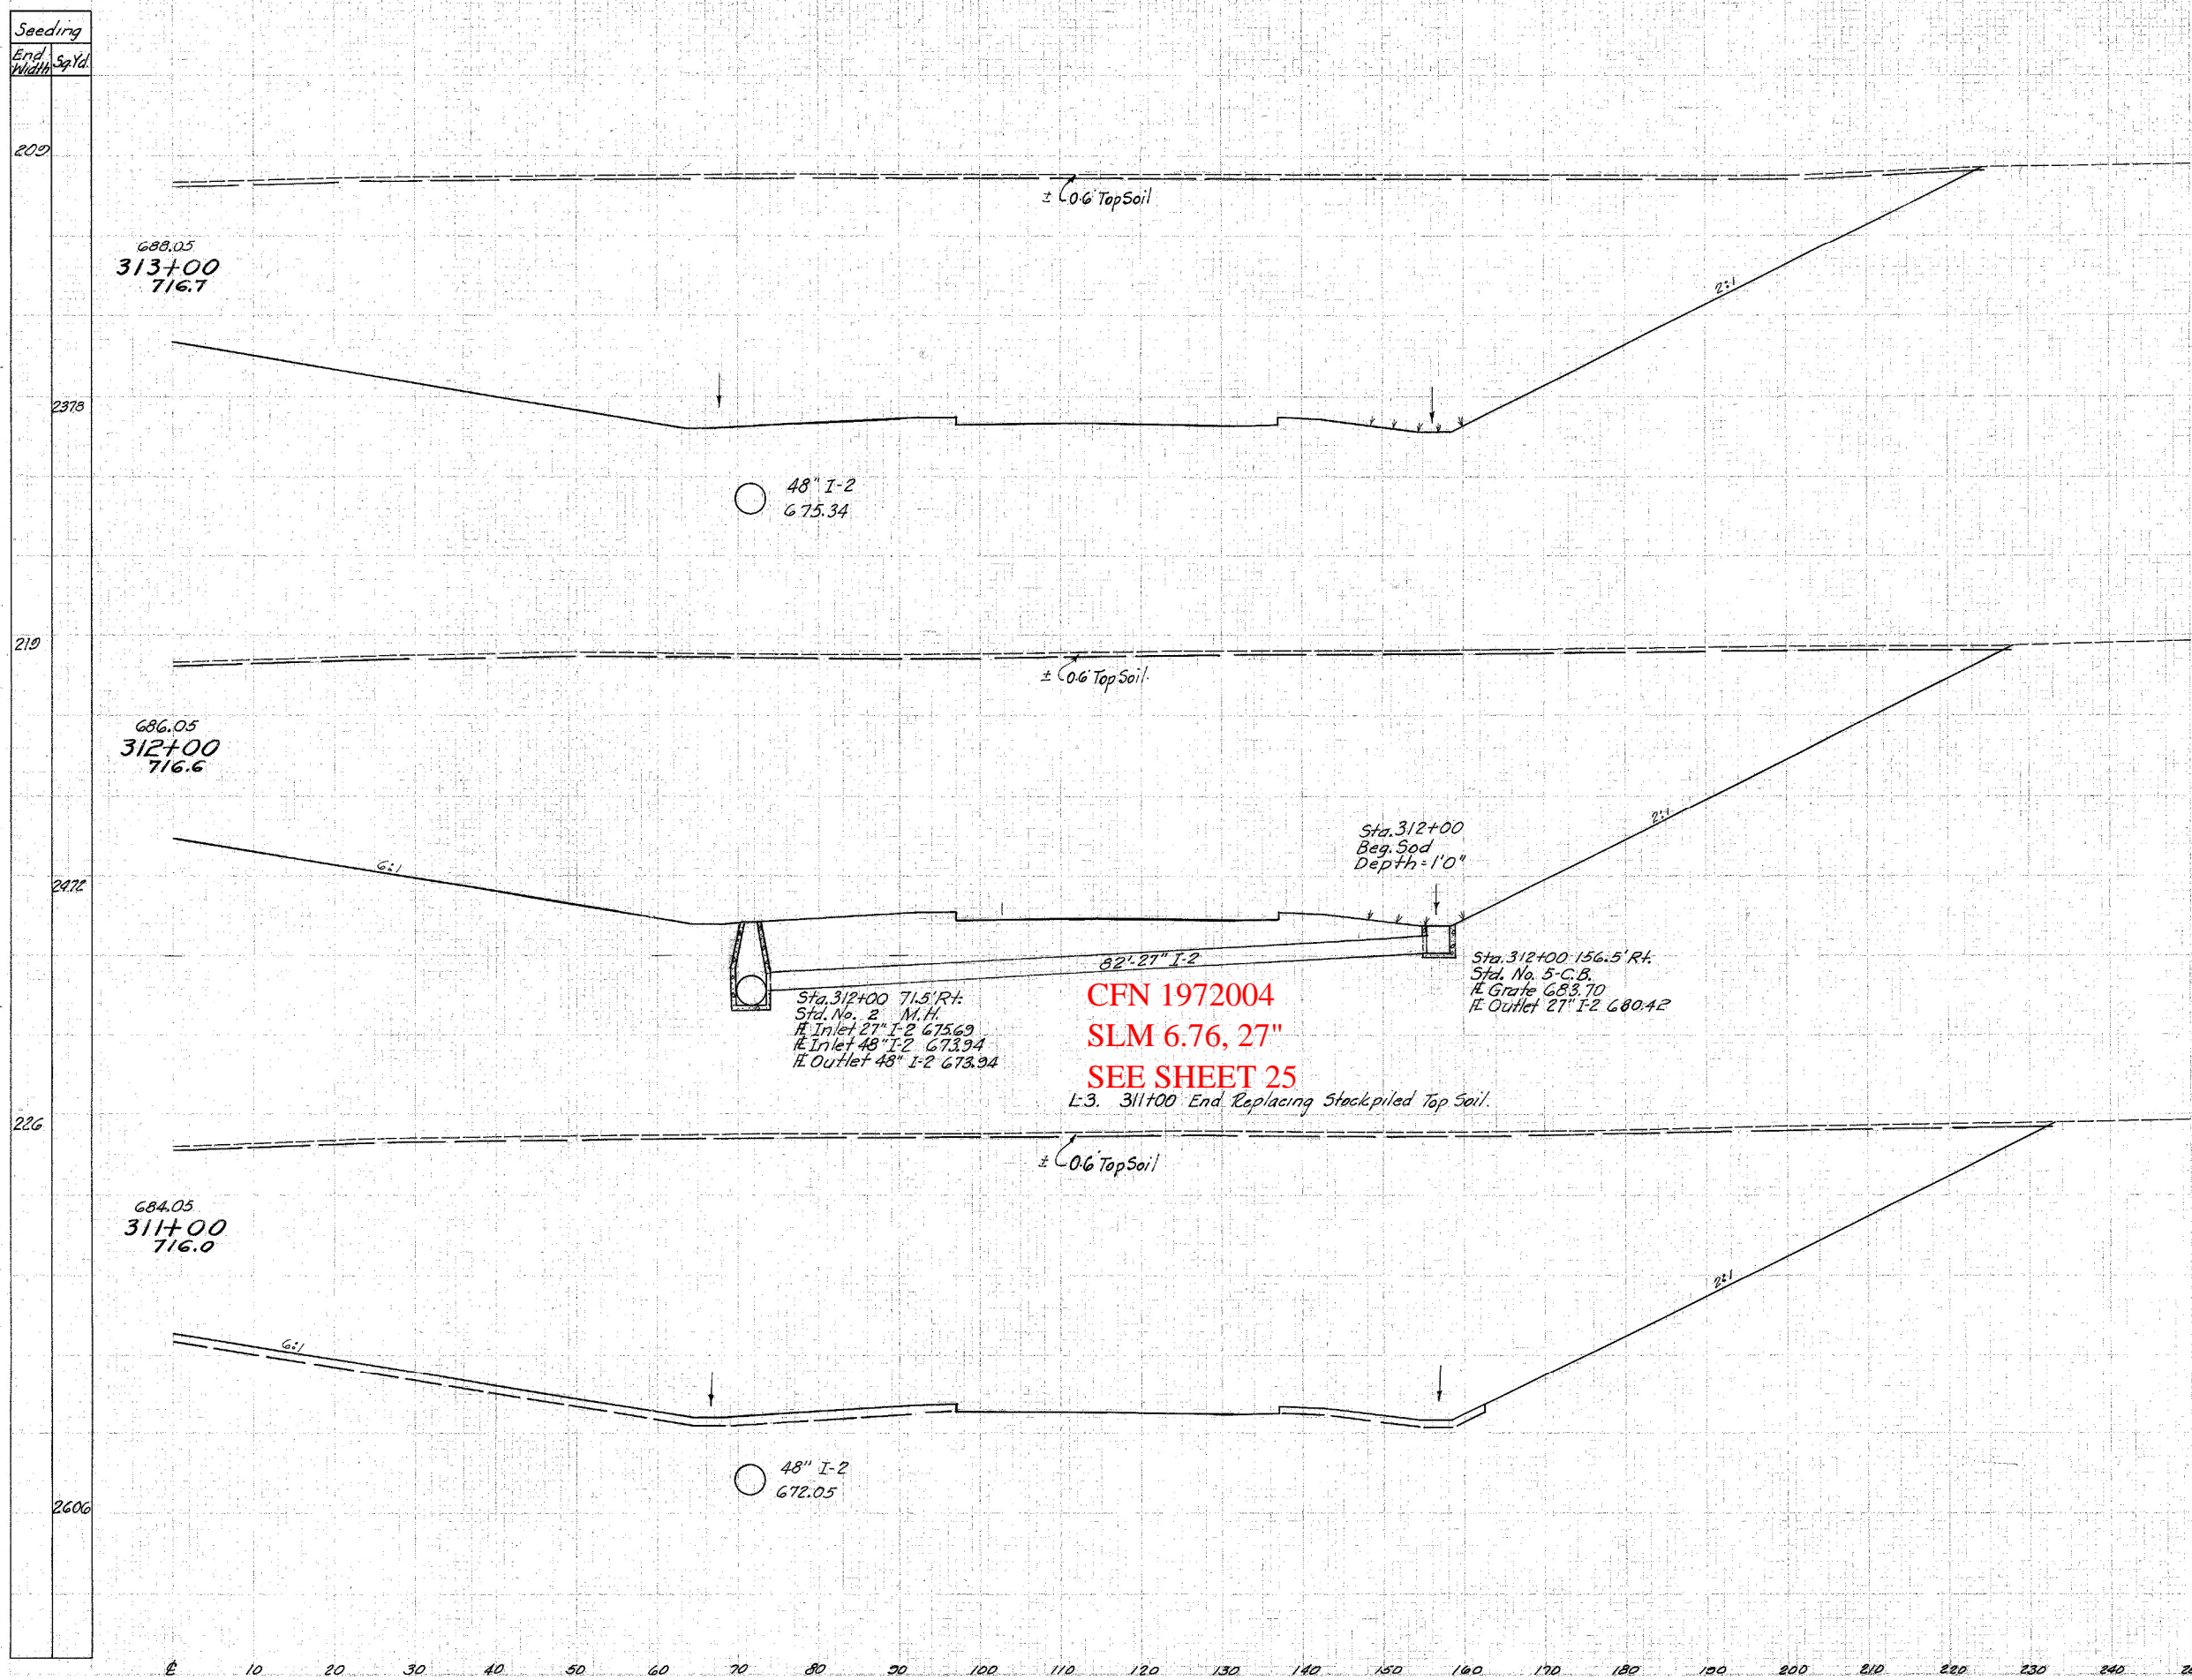

	End Area		Volume	
	Cut	Fill	Cut	Fill
Top Soil	135			
	5471	0		
Top Soil	504			
	21,143	0		
Top Soil	137			
	5946	0		
Top Soil	513			
	22,887	0		
Top Soil	140			
At:	6307	0		
Bl:	6516			
Top Soil	520			
	24,322	0		

**CFN 1972004**  
**SLM 6.76, 27"**  
**SEE SHEET 25**  
L-3. 311+00 End Replacing Stockpiled Top Soil.

Sta. 311+00 to Sta. 313+00 R/L