


Seeding
Erod Width Sp. Yd.

CUYAHOGA & LAKE COUNTIES
CUI-I-15.91
LAK-I-0.00

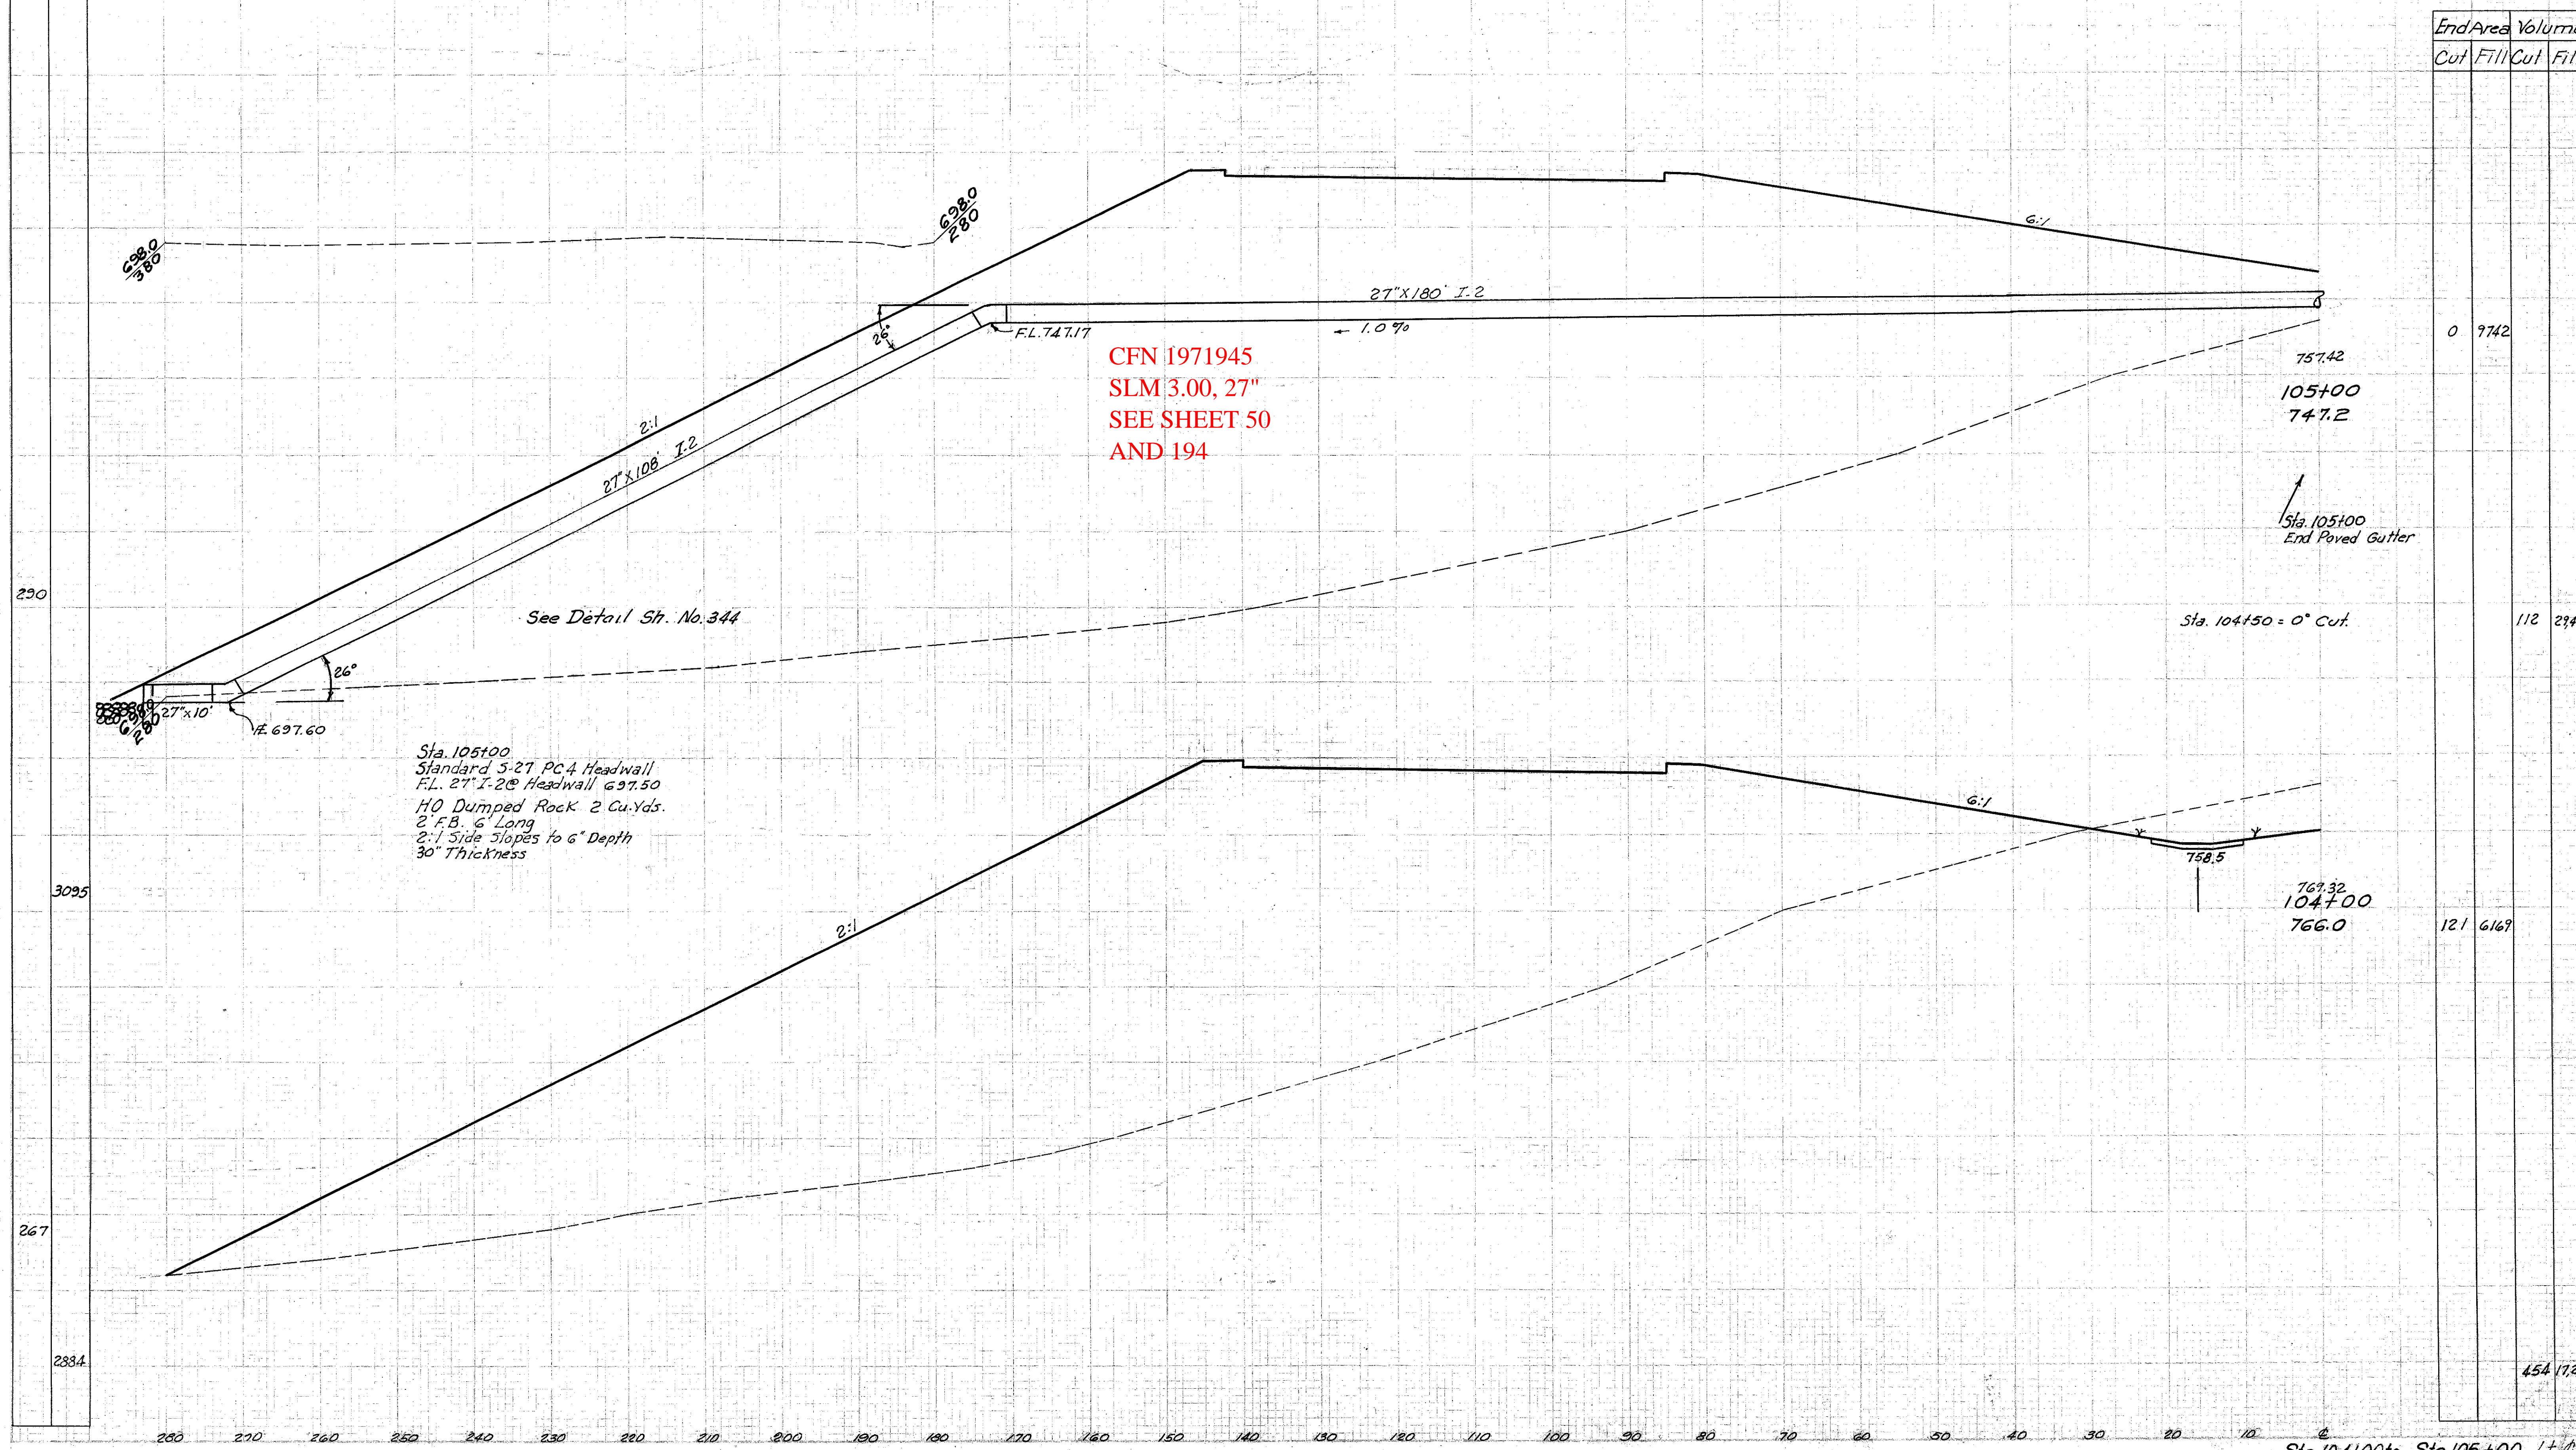

Sta. 104+00 to Sta. 105+00 Lt. 2