


FED. RD. DIVISION	STATE	PROJECT	
2	OHIO		

259A
313

CUYAHOGA COUNTY
CUY-1-2-20

DATE	BY	REVISION
6-19-61	W.P.	REVISED
6-19-61	W.P.	REVISED
6-19-61	W.P.	REVISED

DATE	BY	REVISION

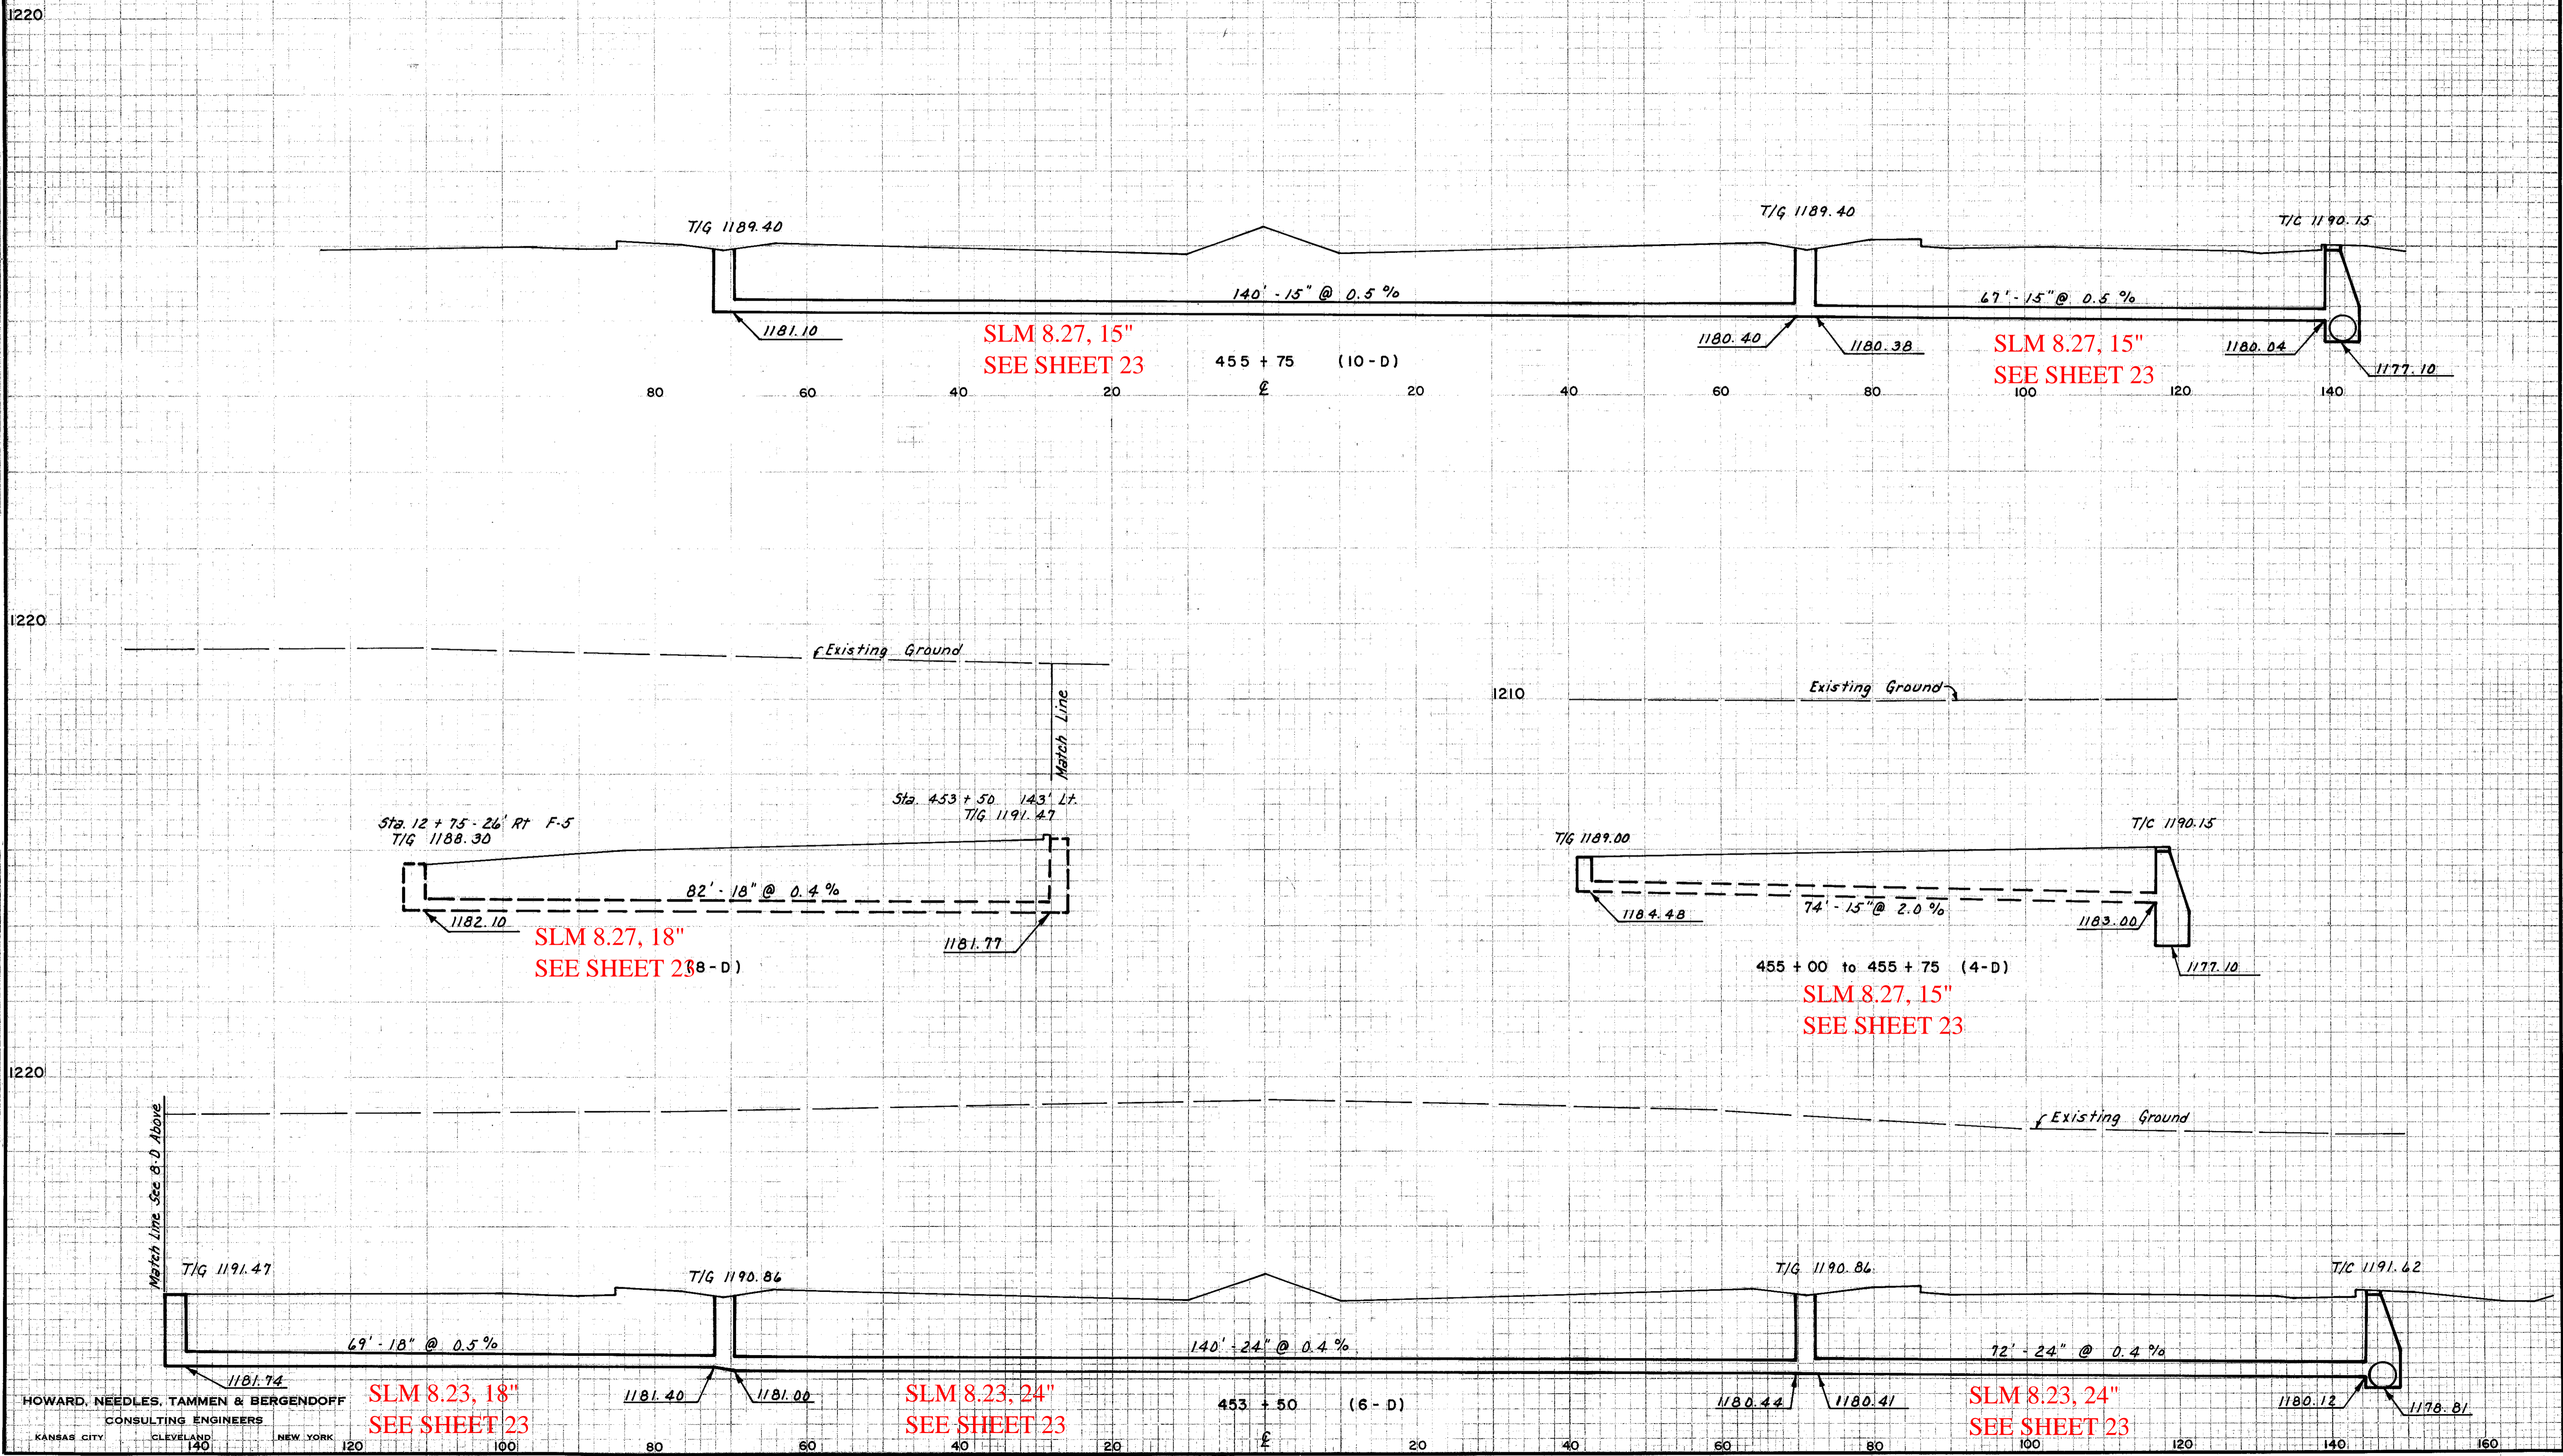

HOWARD, NEEDLES, TAMMEN & BERGENDOFF
CONSULTING ENGINEERS
KANSAS CITY CLEVELAND NEW YORK