
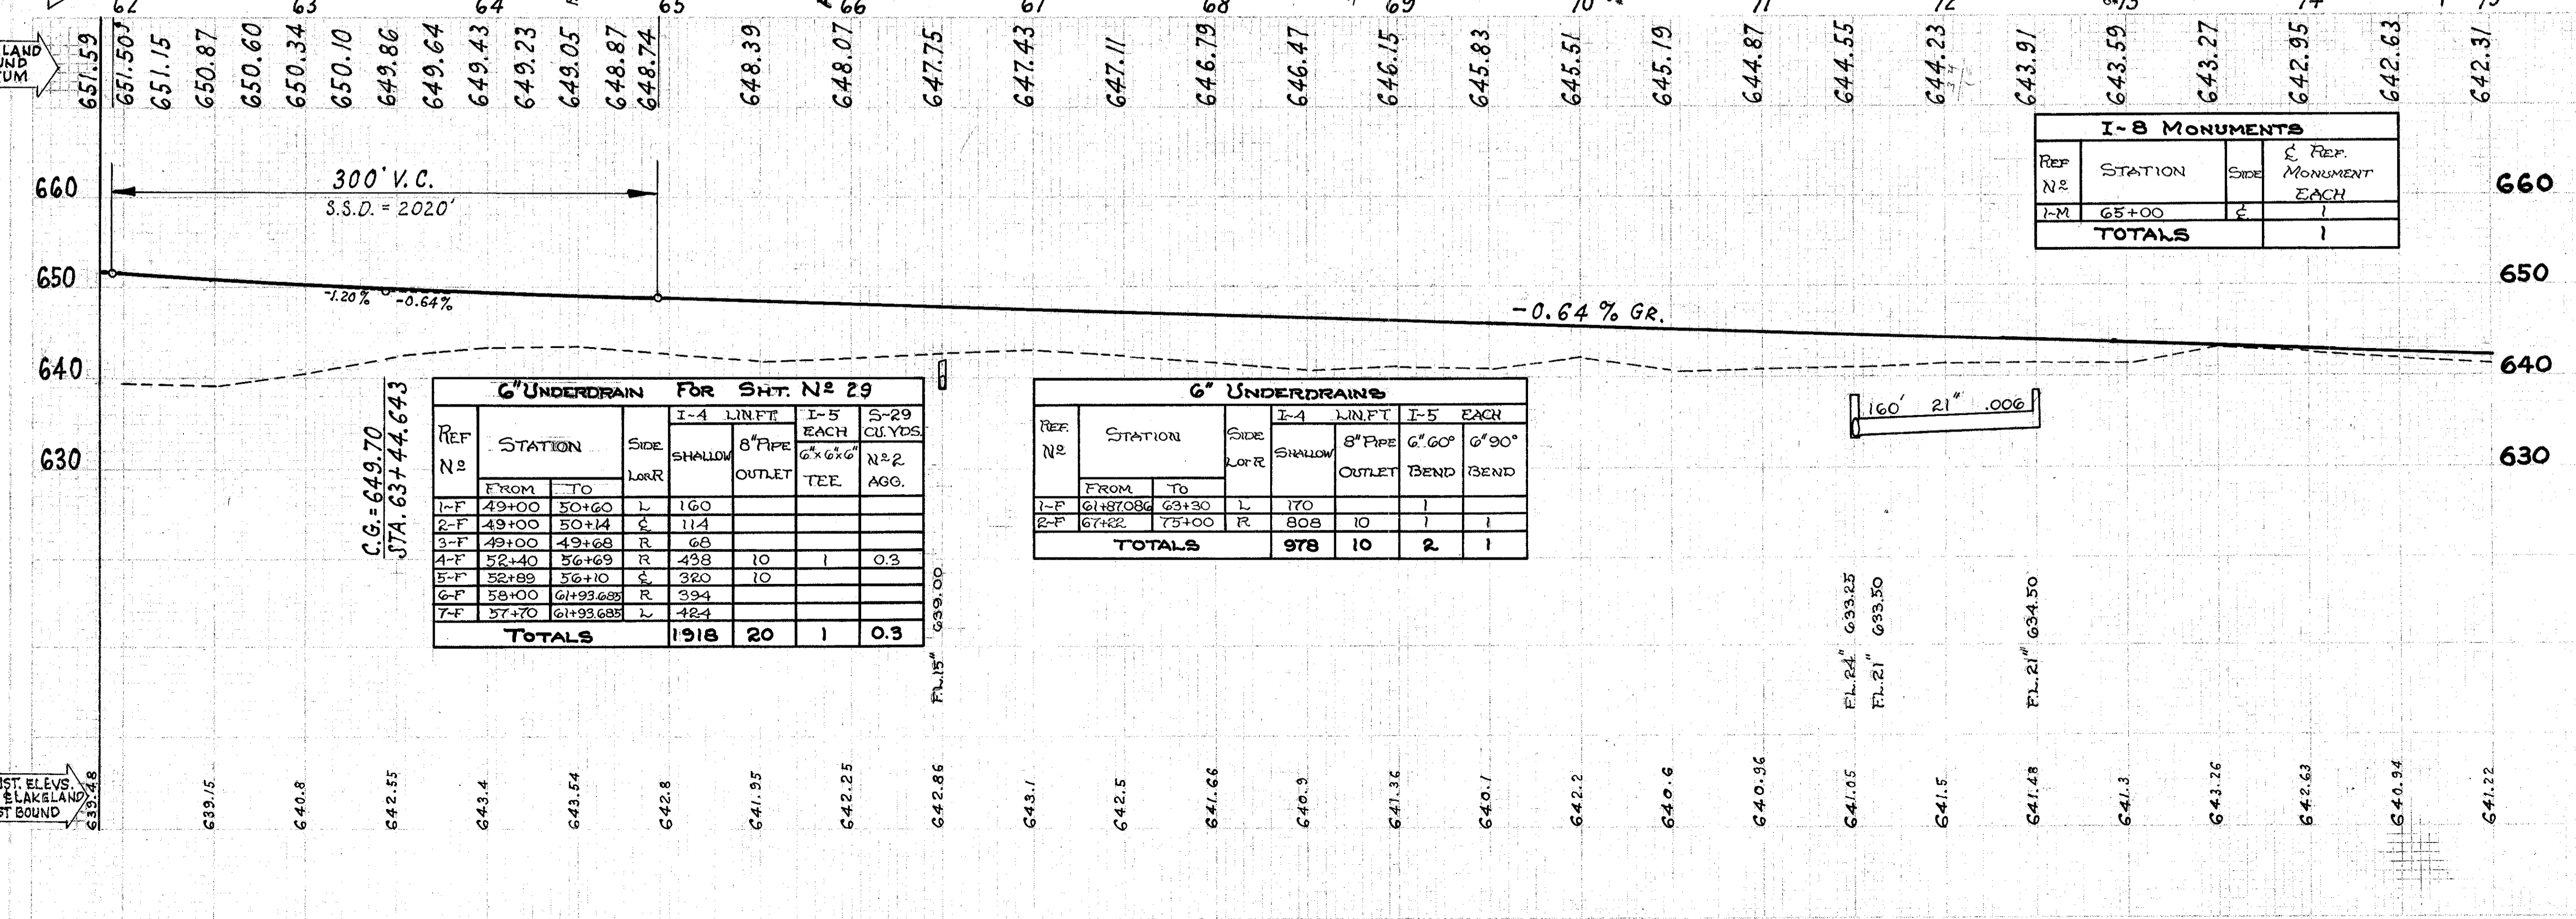


CUYAHOGA COUNTY
 SEC. CUY - 2 - 28.16
 CUY - 525-0.00
 LAKE COUNTY
 SEC. LAK - 525-0.00

LAKELAND FRY
 R/W & CURVE DATA
 D = 0°30'
 Δ = 4°16'25.96"
 R = 11459.16'
 L = 854.77'
 T = 427.59'
 Ch = 854.58'
 E = 7.98'

LAKELAND FWY, E. BOUND & CURVE DATA
 ①
 D = 0°28'00"

CFN 1971595
 SLM 29.49, 21"
 SEE BELOW

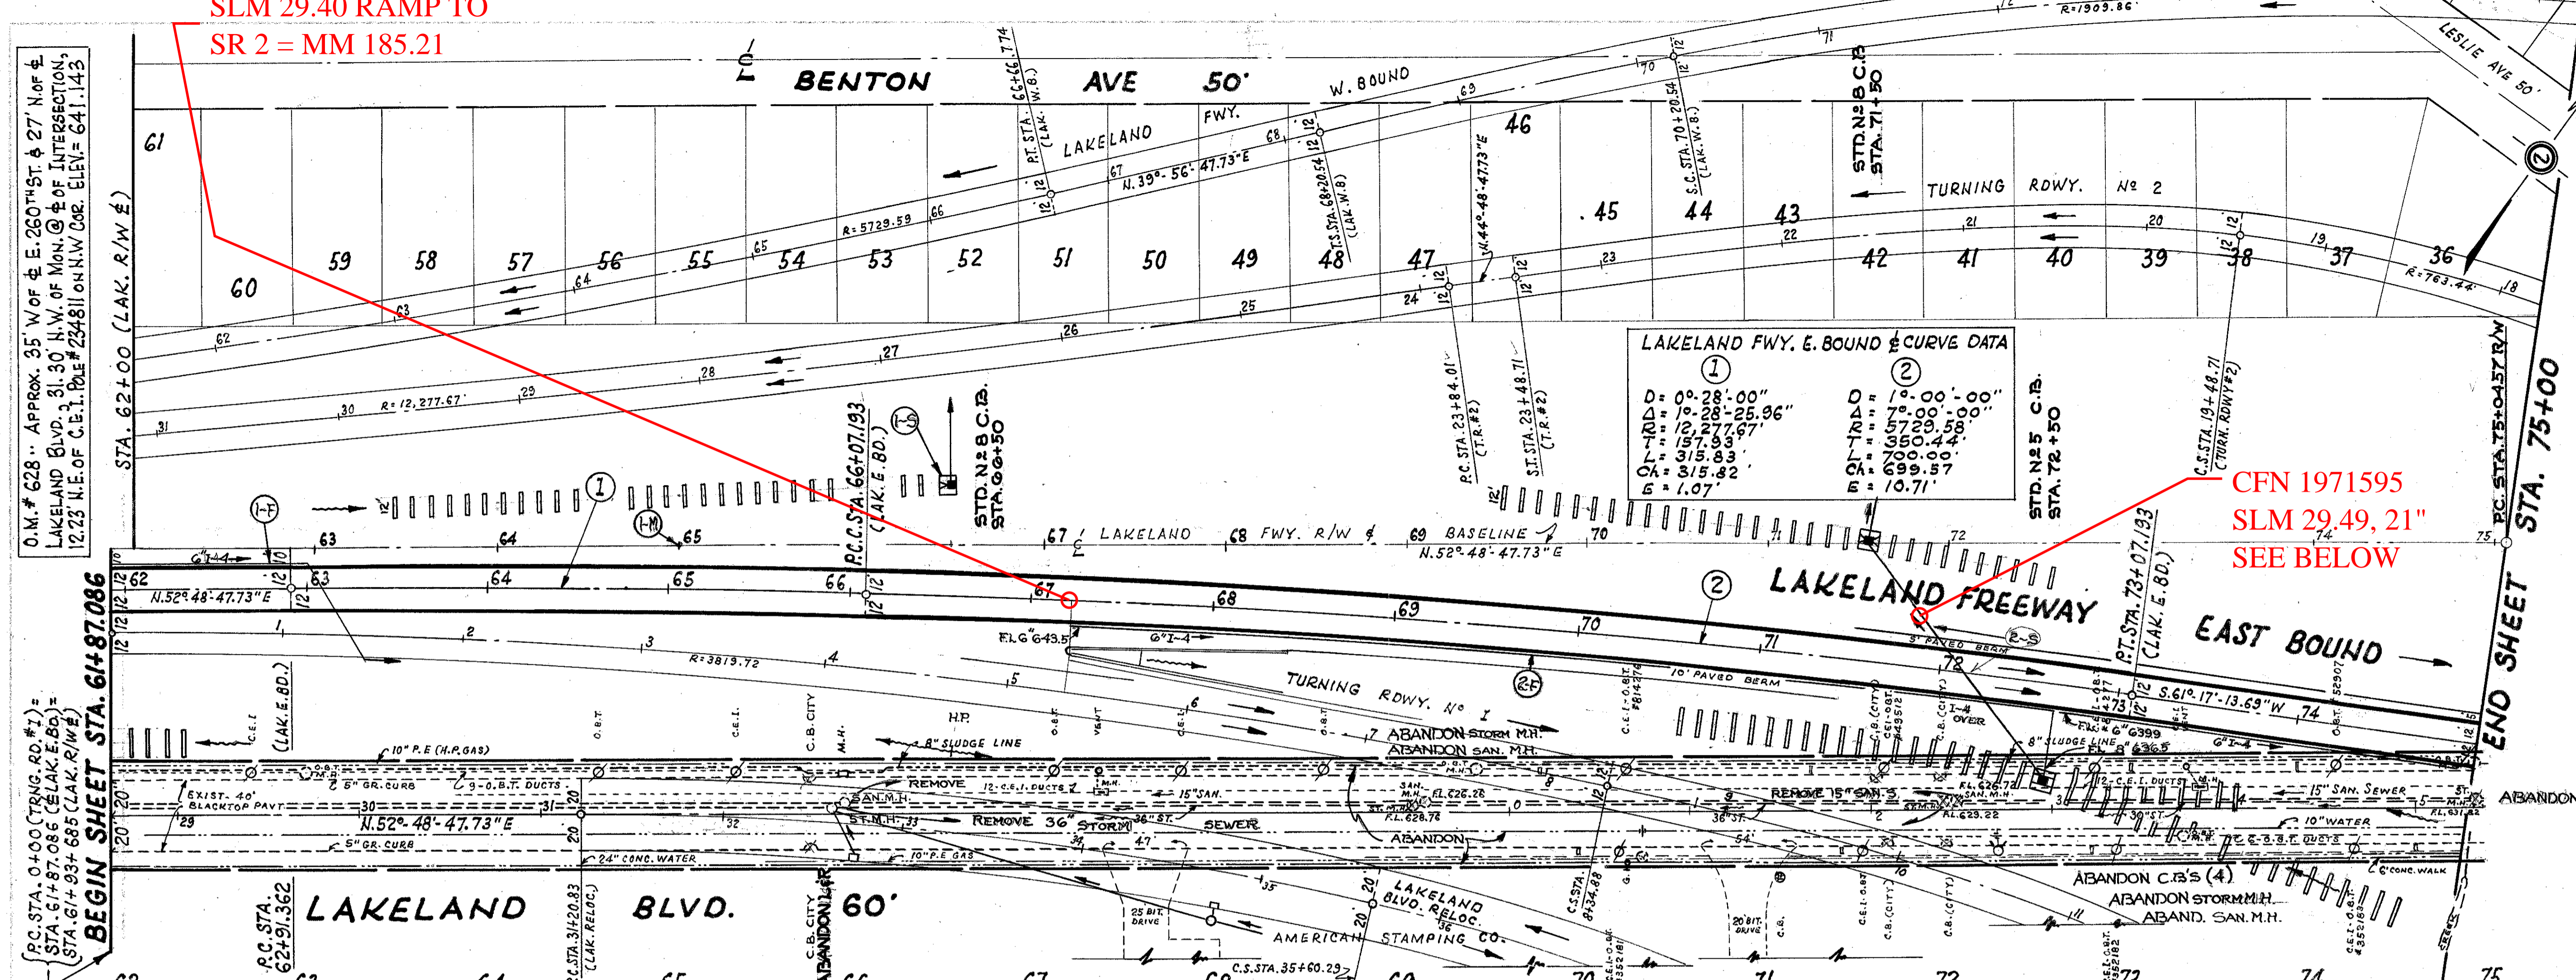

I-B MONUMENTS			
REF. NO.	STATION	SIDE	Σ REF. MONUMENT EACH
I-M	65+00	E	1
TOTALS			1

6" UNDERDRAIN FOR SHT. N° 29						
REF. NO.	STATION	SIDE	I-4 LINFT		I-5 EACH	S-29
			SHALLOW	8" PIPE	6" x 6" TEE	CLYDS
1-F	49+00	L	160			
2-F	49+00	R	114			
3-F	49+00	R	68			
4-F	52+40	R	438	10	1	0.3
5-F	52+89	R	320	10		
6-F	58+00	R	394			
TOTALS			1918	20	1	0.3

6" UNDERDRAINS						
REF. NO.	STATION	SIDE	I-4 LINFT		I-5 EACH	
			SHALLOW	8" PIPE	6" 60°	6" 90°
1-F	61+87.086	L	170			
2-F	67+82	R	808	10	1	1
TOTALS			978	10	2	1

REF. NO.	STATION	SIDE	I-2 LINFT		I-8 EACH		I-10 SODDING		I-16 MANHOLE		I-18 PIPE	
			21"	21"	SHALLOW	DEPT.	ABAND.	REMOVED	OVERLIES	UNDER	UNDER	UNDER
1-S	63+40	L	1	60								
2-S	63+50	R	1	190								
	61+87	R		11								
TOTALS			2	261								

PLAN & PROFILE · LAKELAND FREEWAY E.BD. · STA. 61+87.086 to STA. 75+00