


SEEDING
END SQ.
WIDTH YDS.

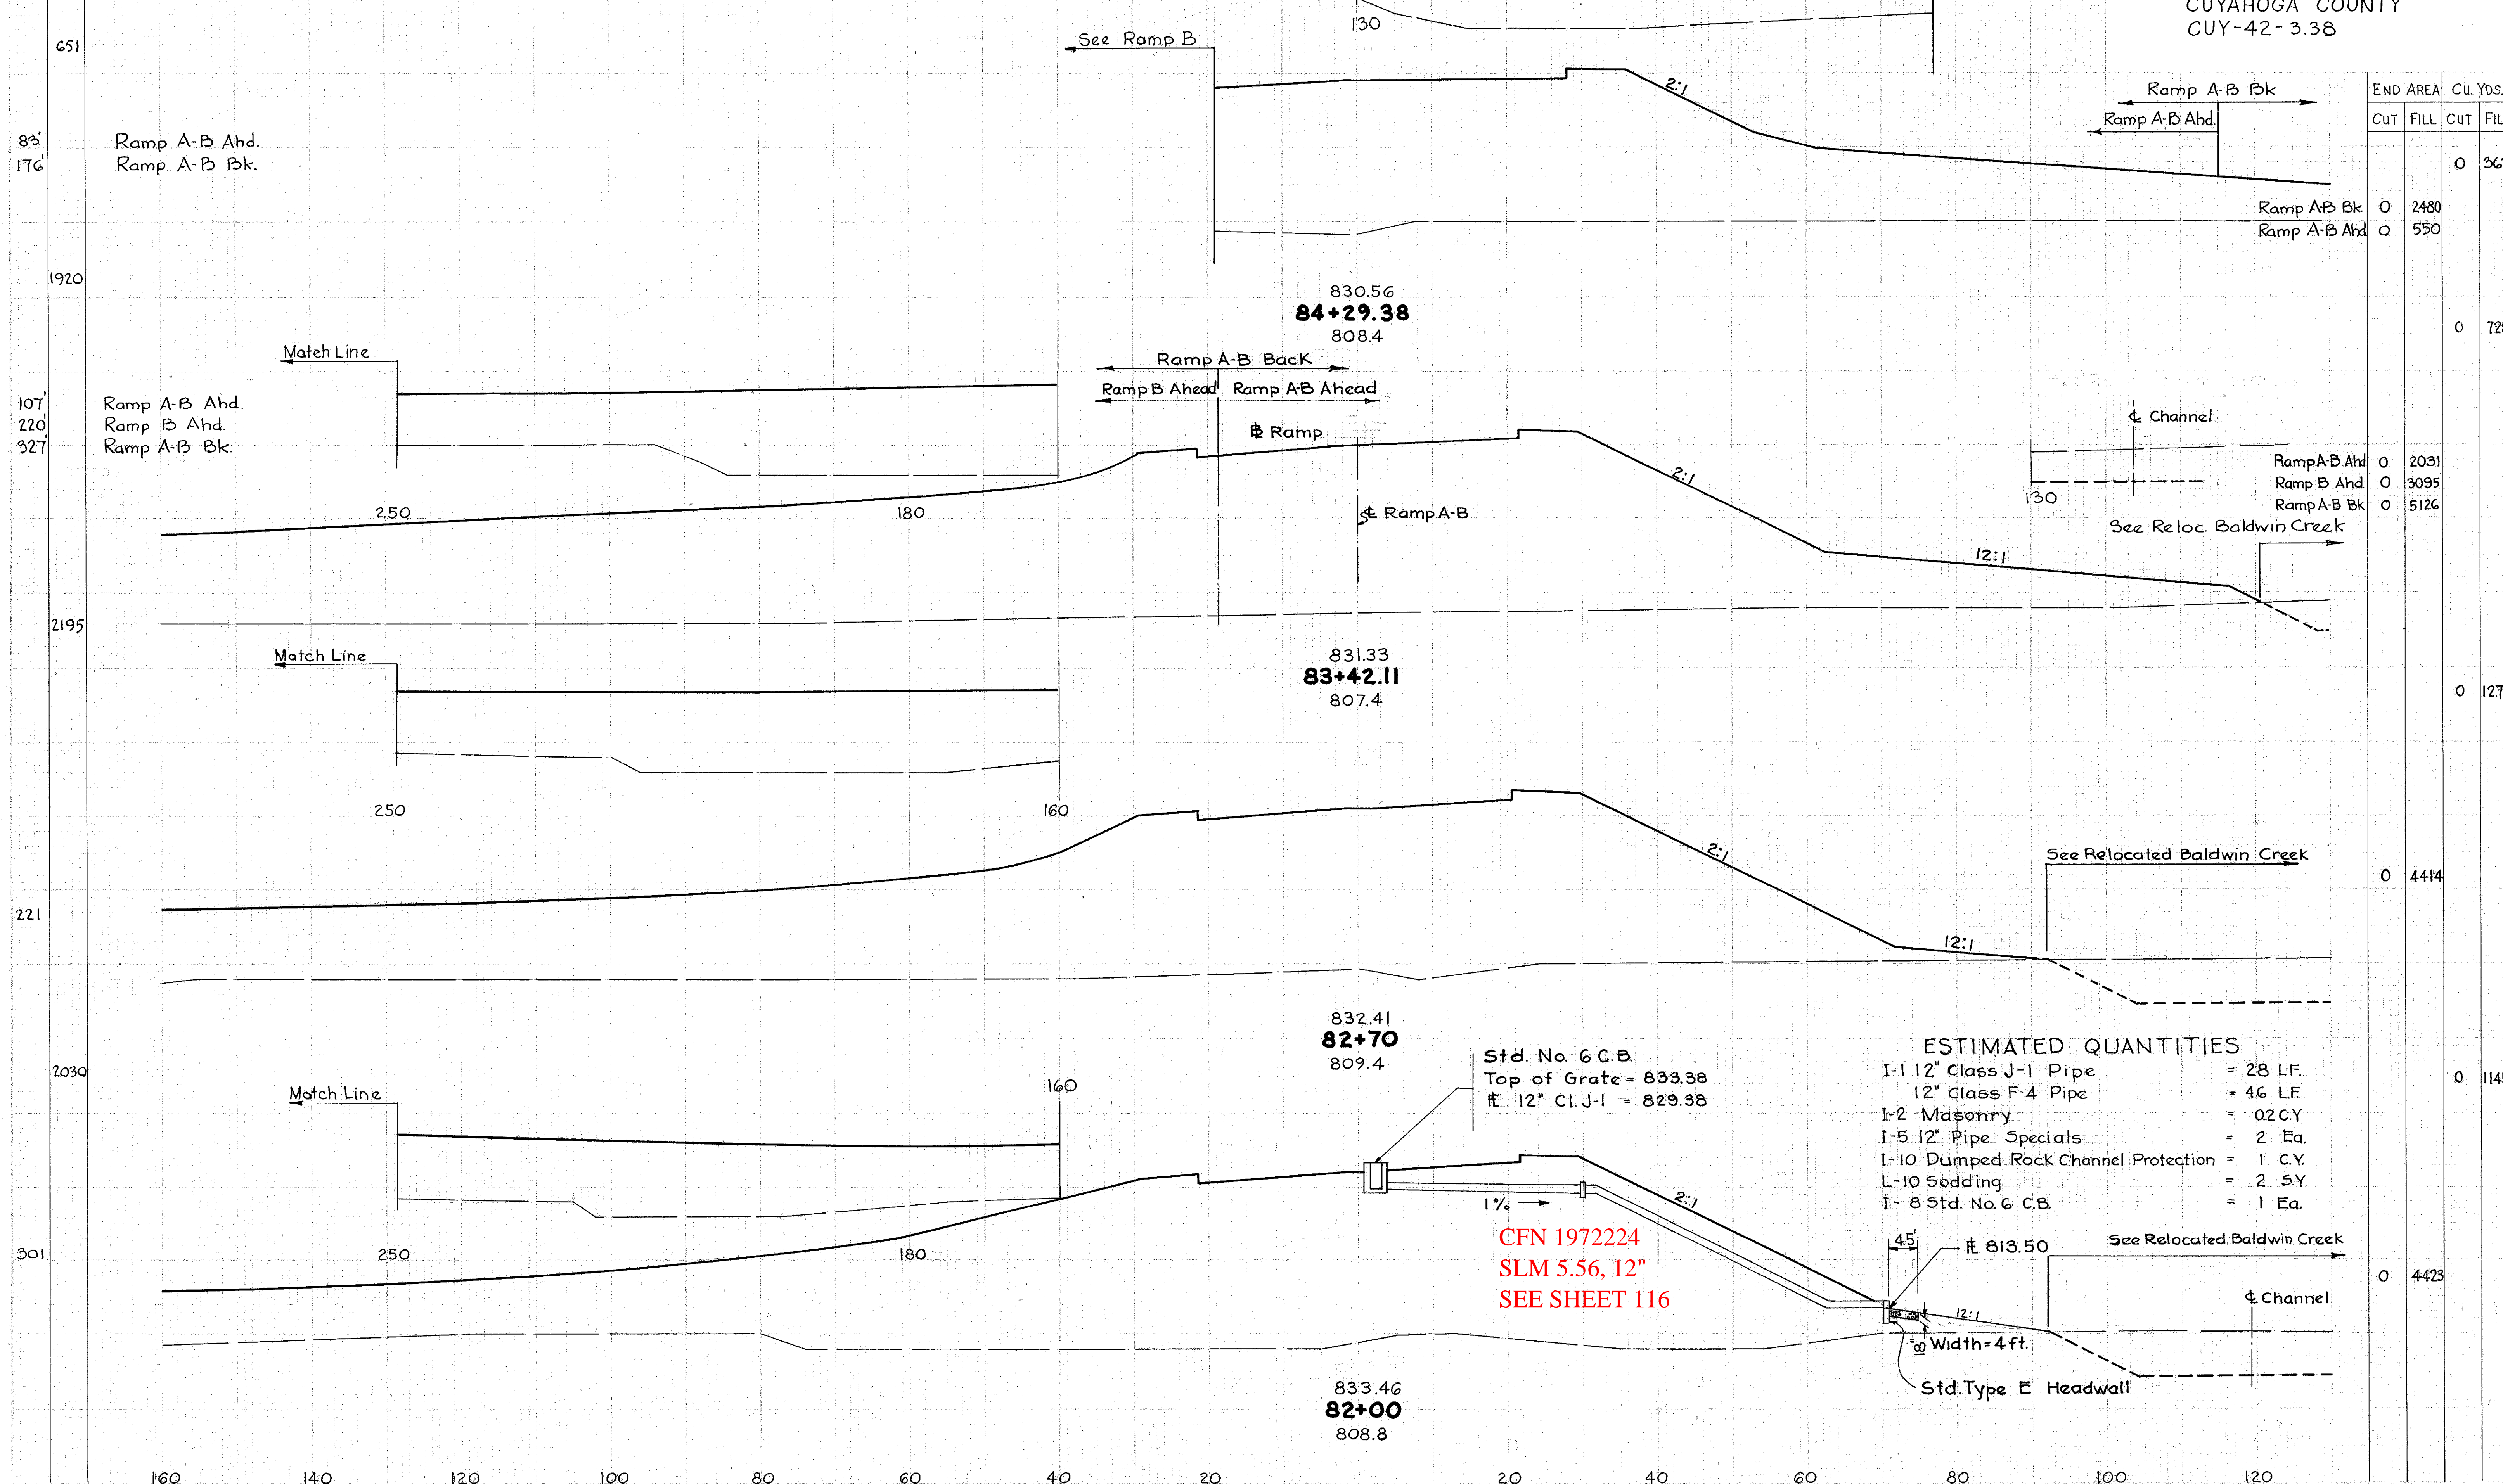

END AREA	Cu. Yds.	
	CUT	FILL
	0	3623
Ramp A-B Bk	0	2480
Ramp A-B Ahd	0	550
	0	7289
Ramp A-B Ahd	0	2031
Ramp B Ahd	0	3095
Ramp A-B Bk	0	5126
	0	12739
	0	4414
	0	11454
	0	4423

- ESTIMATED QUANTITIES**
- I-1 12" Class J-1 Pipe = 28 LF.
 - 12" Class F-4 Pipe = 46 LF.
 - I-2 Masonry = 02 CY
 - I-5 12" Pipe Specials = 2 Ea.
 - I-10 Dumped Rock Channel Protection = 1 CY.
 - L-10 Sodding = 2 SY.
 - I-8 Std. No. 6 C.B. = 1 Ea.

Std. No. 6 C.B.
Top of Grate = 833.38
12" Cl. J-1 = 829.38

CFN 1972224
SLM 5.56, 12"
SEE SHEET 116