


FED. RD. DIVISION	STATE	PROJECT
2	OHIO	

284
646

33
54

CUYAHOGA COUNTY
CUY-71-17.83
CUY-176-12.76

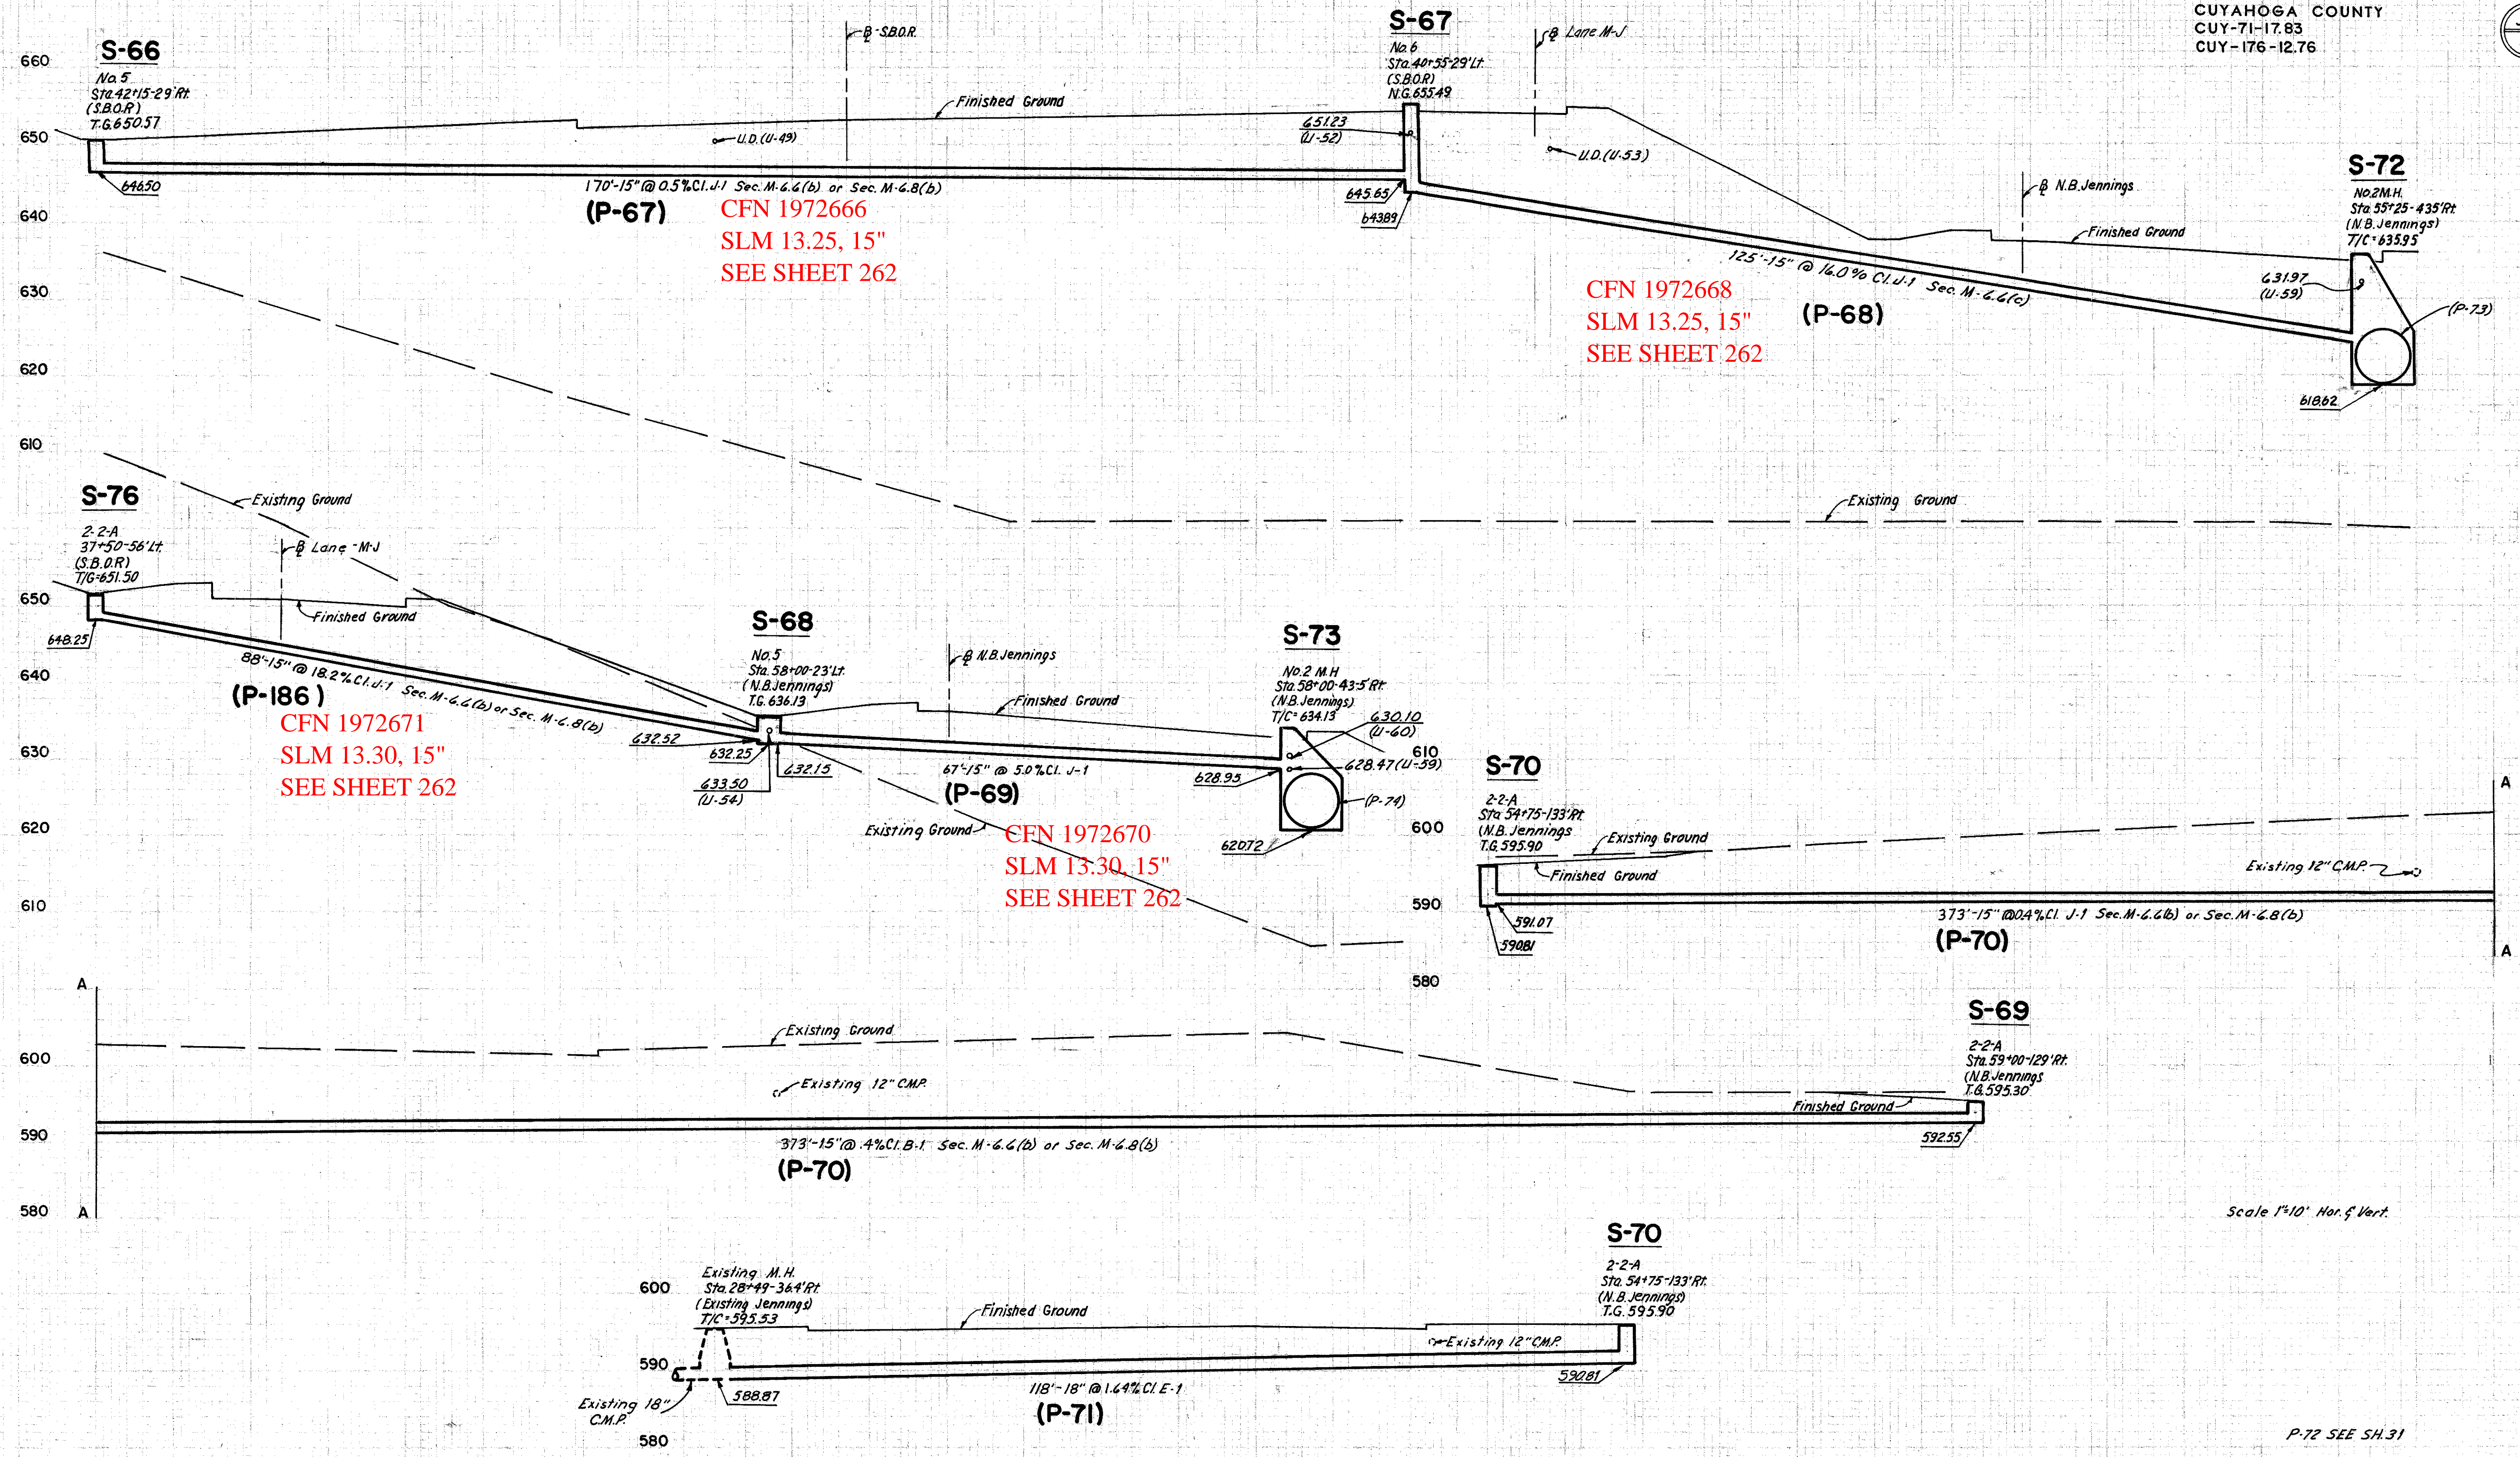

9-22-01
 R.D.J.
 J.M.D.

Scale 1"=10' Hor. & Vert.

P-72 SEE SH.31

HOWARD, NEEDLES, TAMMEN & BERGENDOFF
CONSULTING ENGINEERS
KANSAS CITY CLEVELAND NEW YORK