


120 100 80 60 40 20 20 40 60 80 100 120

FED. RD. DIVISION	STATE	PROJECT	195 382
2	OHIO		

CUYAHOGA COUNTY
CUY-77-407

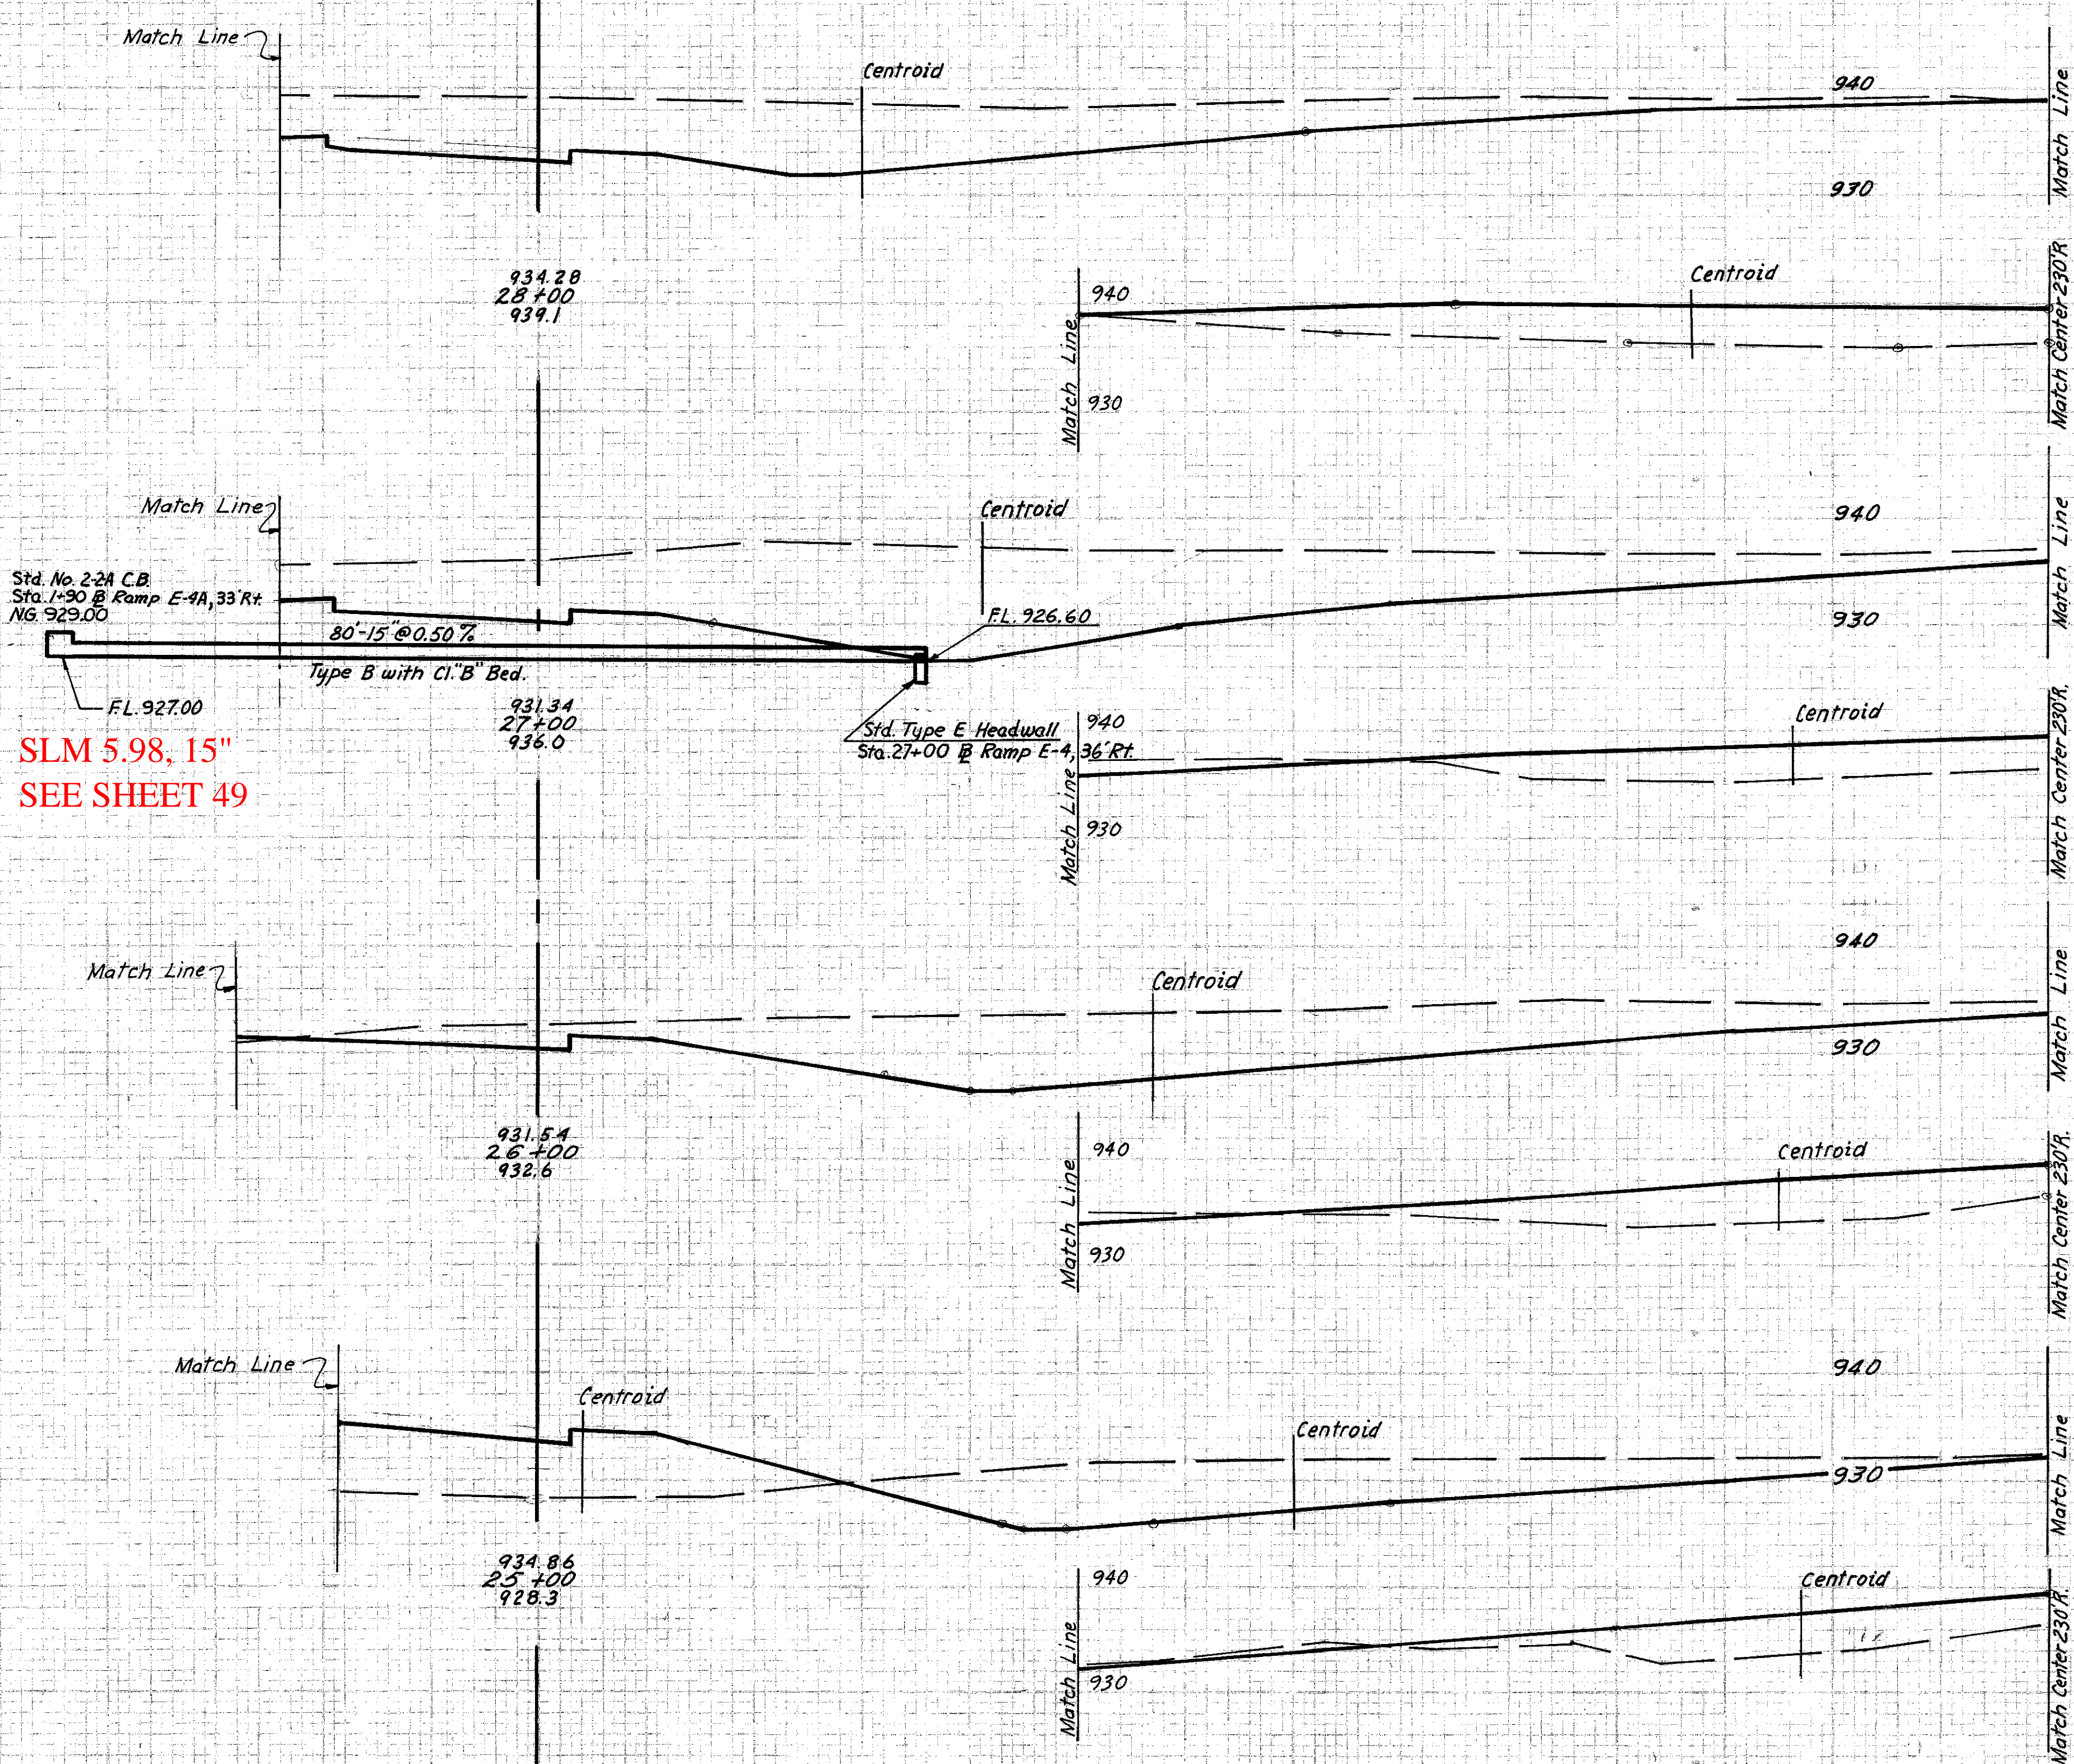

SLM 5.98, 15"
SEE SHEET 49

EARTHWORK			
END	AREA	VOLUME	
EXC.	EMB.	EXC.	EMB.
			578
569	250		
		2280	114
915	161		
		2249	67
603	203		
		1299	531
371	403		
		801	1645
Sta. 24+00	265	765	

HLD 1922-66 Y D.C.
 HLD 1922-66 Y S.D.P.
 HLD 1922-66 H.L.D.
 HLD 1922-66 H.L.D.
 HLD 1922-66 H.L.D.
 1-15-66

HOWARD, NEEDLES, TAMMEN & BERGENDOFF
CONSULTING ENGINEERS
KANSAS CITY CLEVELAND NEW YORK

140 120 100 80 60 40 20 20 40 60 80 100 120

RAMP E-4 STA. 25+00 TO STA. 28+00