

SLM 17.79, 24"
SEE SHEET 79

CFN 1974678
SLM 17.86, 21"
SEE SHEET 78

SLM 17.94, 15"
SEE SHEET 85

SLM 17.89, 18"
SEE SHEET 85

SLM 17.87, 15"
SEE SHEET 85

CFN 1974673
SLM 17.87, 21"
SEE SHEET 85

SLM 17.87, 24"
SEE SHEET 85

FED. RD. DIVISION	STATE	PROJECT	65 410
2	OHIO		

CUYAHOGA COUNTY
CUY. - 77-8.69
CUY. - 80-17.37

CFN 1974657
SLM 17.86, 18"
SEE SHEET 70
AND 86

old CFN 184801795
new CFN 1862354
SLM 17.84, 78"
SEE SHEET 70
72, 74 AND 76

SLM 17.92, 15"
SEE SHEET 86

CFN 1974677
SLM 17.95, 15"
SEE SHEET 90

SLM 17.96, 15"
SEE SHEET 90

CFN 1974675
SLM 17.98, 15"
SEE SHEET 77

SLM 17.96, 15"
SEE SHEET 90

SLM 17.98, 15"
SEE SHEET 87

SLM 17.98, 27"
SEE SHEET 77

CFN 1974667
SLM 18.02, 15"
SEE SHEET 89

CFN 1974681
SLM 18.01, 15"
SEE SHEET 87


CFN 1974680
SLM 18.01, 27"
SEE SHEET 77

CFN 1974679
SLM 18.01, 27"
SEE SHEET 77


SLM 18.02, 27"
SEE SHEET 89

CFN 1974674
SLM 18.02, 27"
SEE SHEET 88

CFN 1974682
SLM 18.03, 27"
SEE SHEET 88

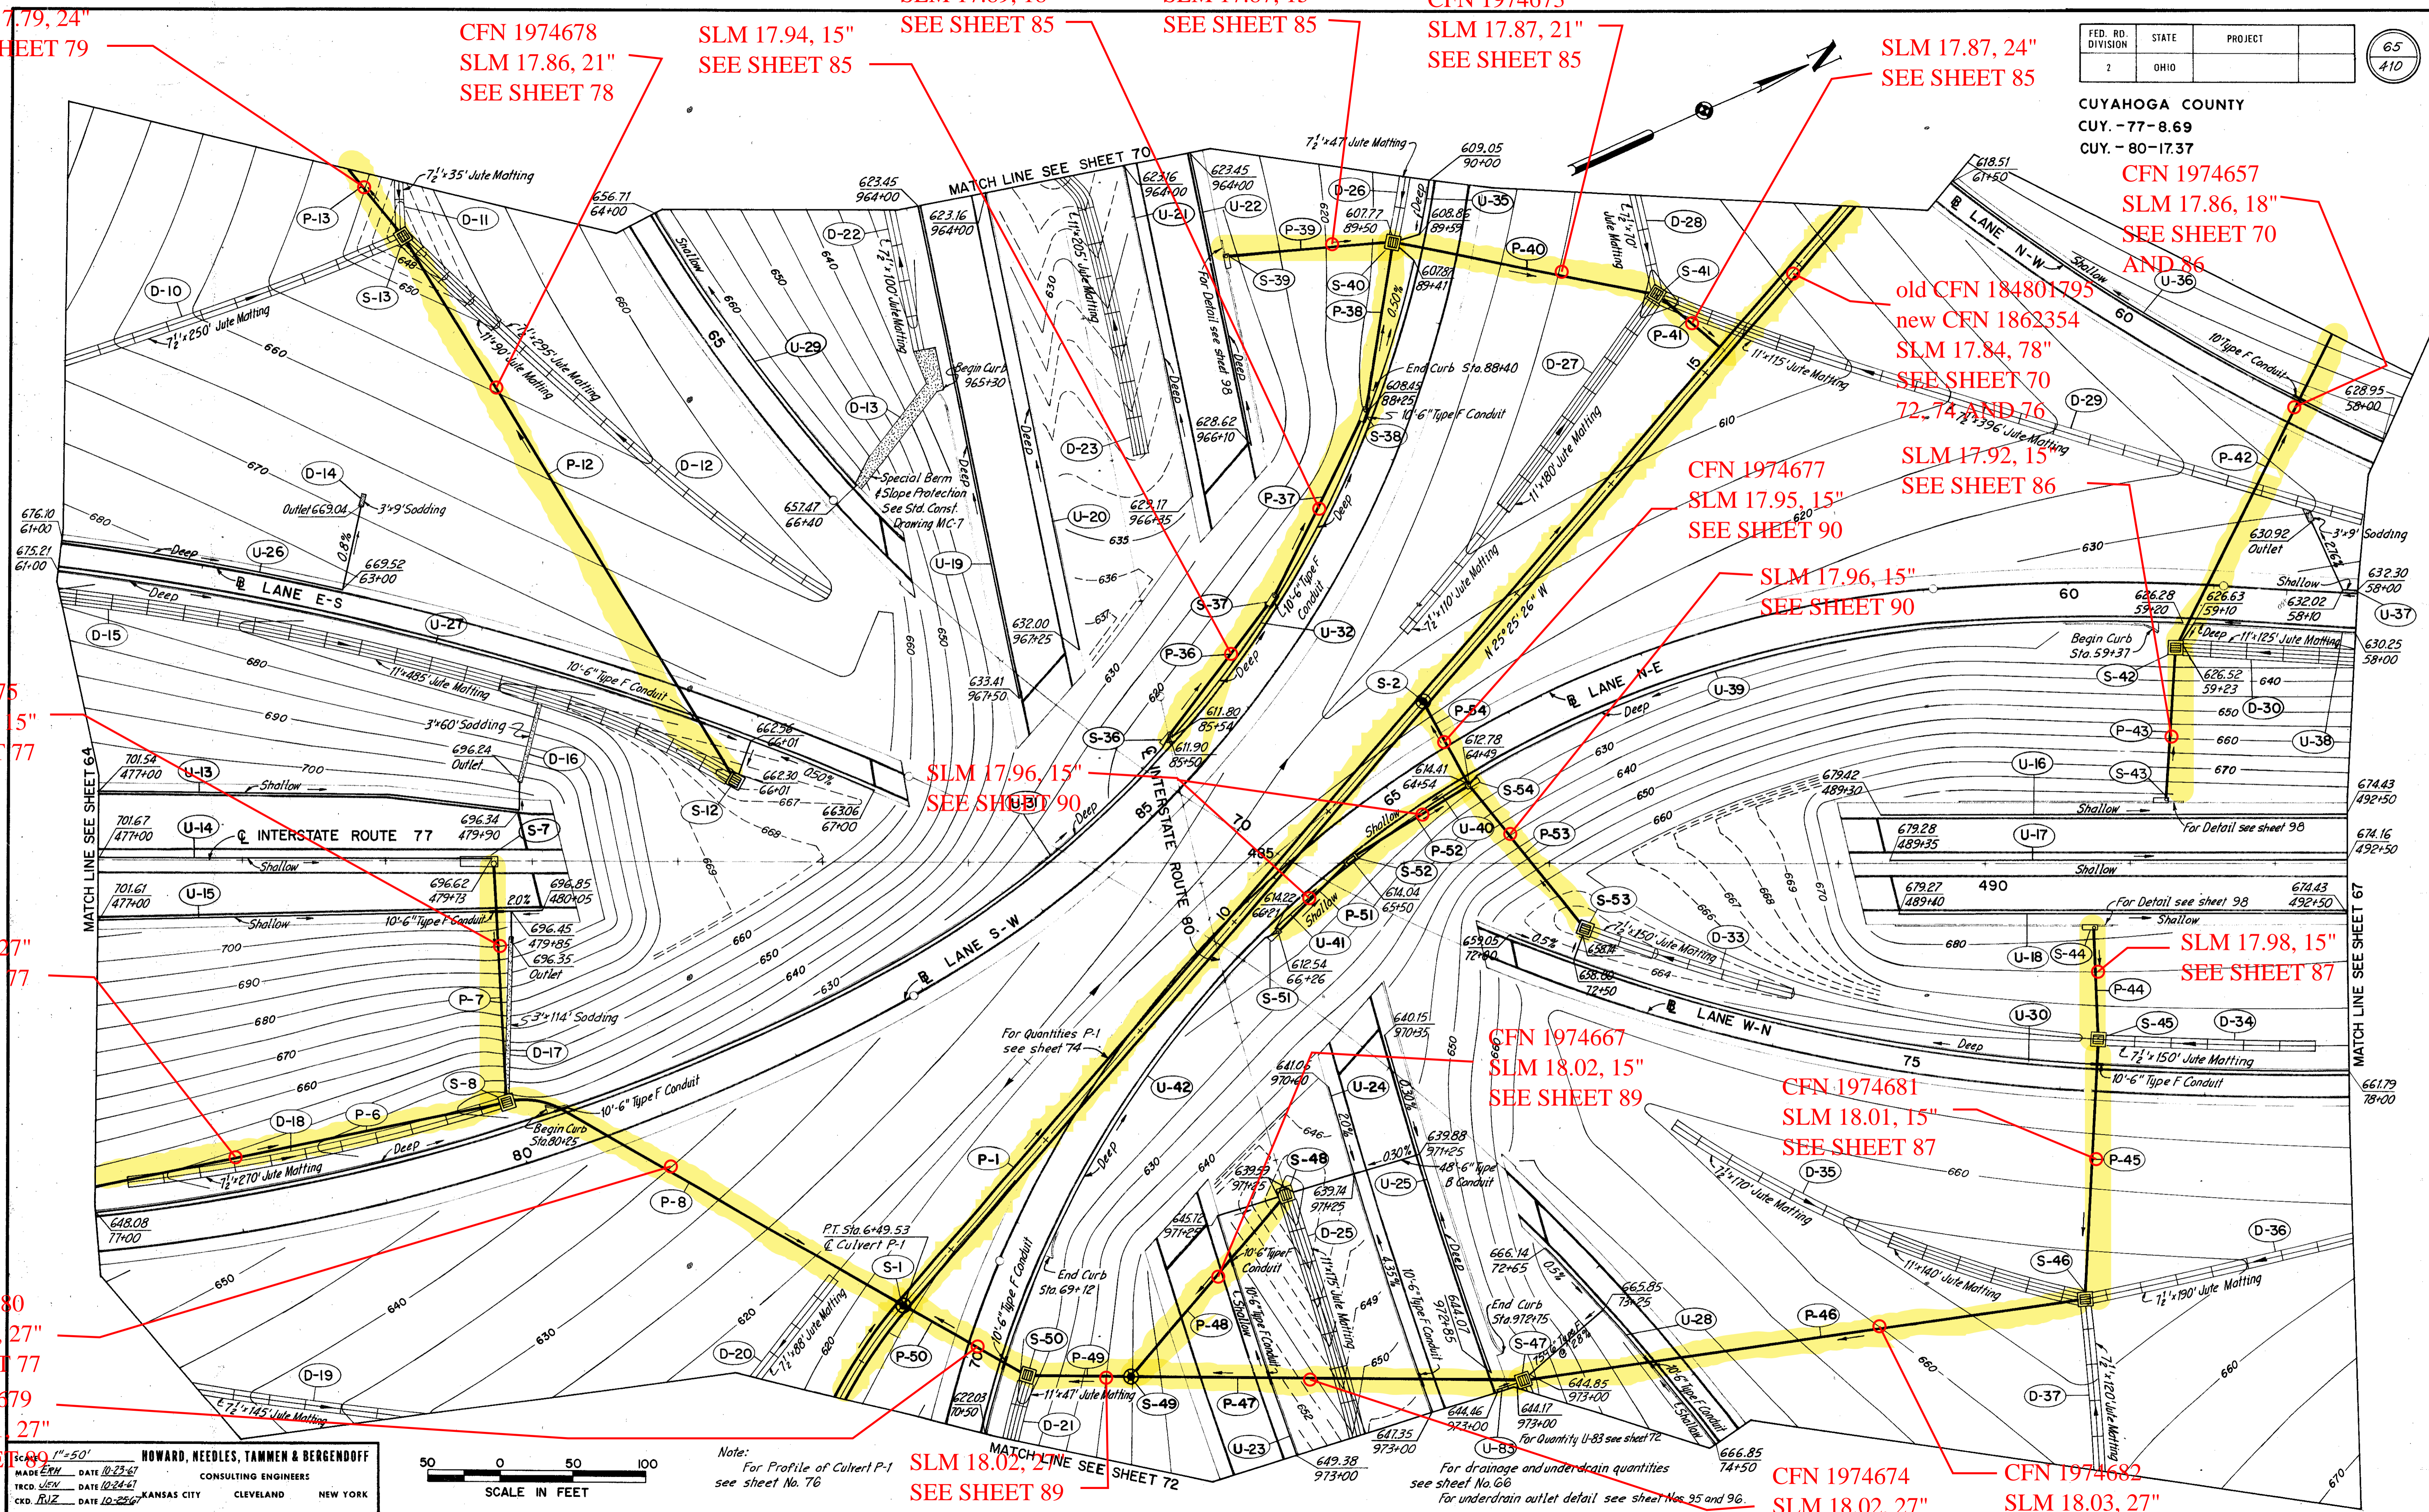

HOWARD, NEEDLES, TAMMEN & BERGENDOFF
CONSULTING ENGINEERS
KANSAS CITY CLEVELAND NEW YORK

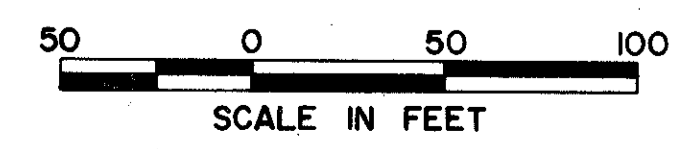

Note:
For Profile of Culvert P-1
see sheet No. 76

For drainage and underdrain quantities
see sheet No. 66
For underdrain outlet detail see sheet Nos. 95 and 96.