SLM 7.87, 60"
SEE SHEET 116

SLM 7.90, 60"
SEE SHEET 116

old CFN 184800796
new CFN 1884801
SLM 7.94, 60"
SEE SHEET 116
AND 117

SLM 7.98, 33"
SEE SHEET 118

SLM 7.78, 66"
SEE SHEET 116

CFN 1974179
SLM 7.87, 21"
SEE SHEET 124

old CFN 184800798
new CFN 1884802
SLM 7.98, 54"
SEE SHEET 117

SLM 7.87, 21"
SEE SHEET 124

ROCKY RIVER DRIVE (SR 237)
SLM 7.91 = MM 10.08

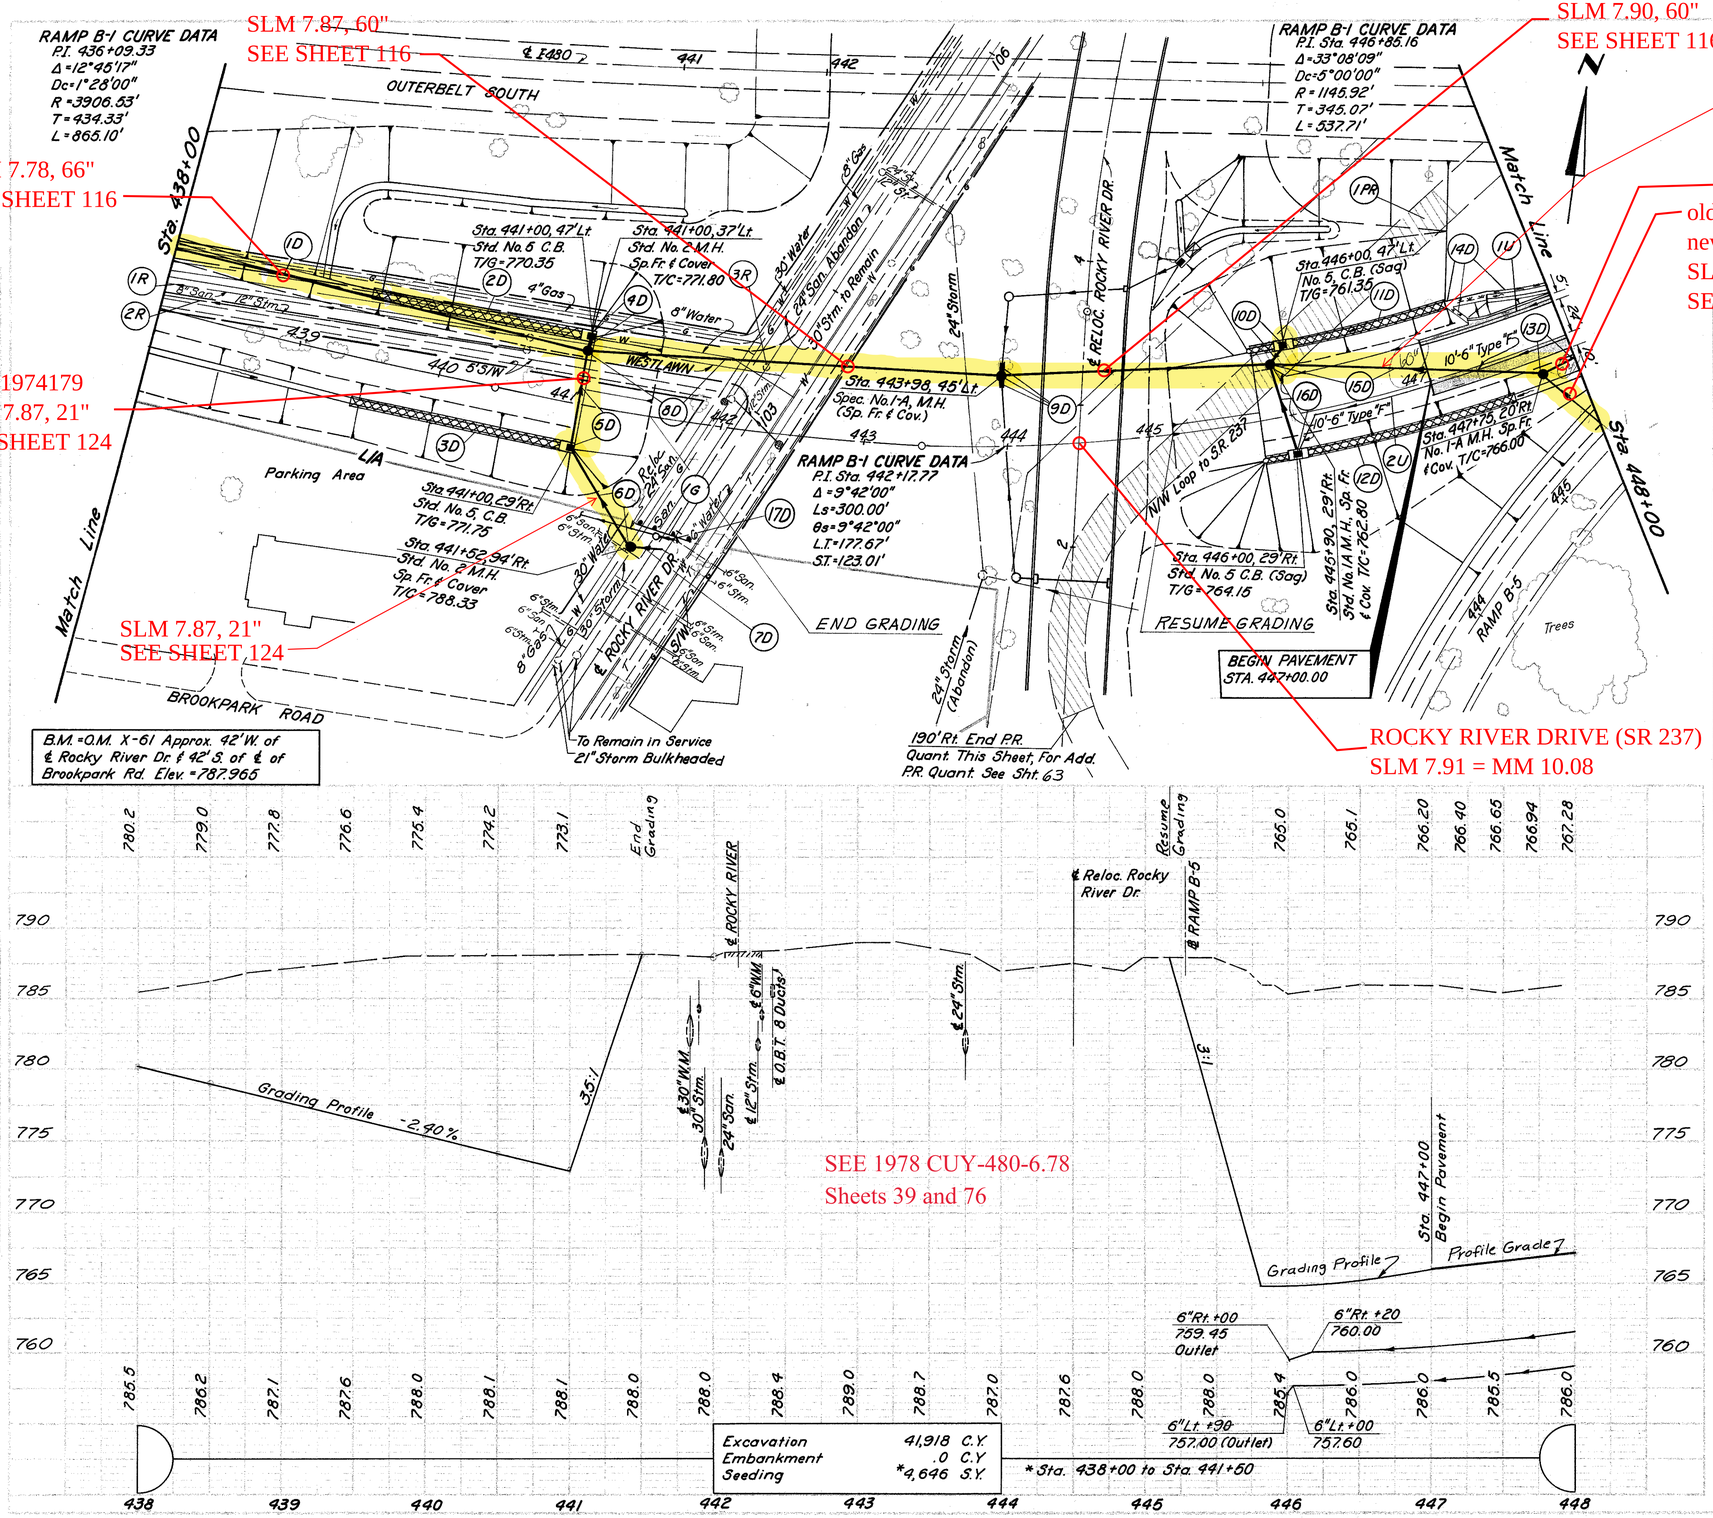

CALC. BY B.O.S. DATE 9-29-71
CHKD. BY J.R.B. DATE 9-27-71

DIVISION	STATE	PROJECT
2	OHIO	526

CUYAHOGA COUNTY
480-8.00
CUY-17-7.59

CROSS REFERENCE	
Sht. No.	Item
116, 117	Storm Sewer Profiles
118, 124	" " "
156	Sanitary Sewer
186, 187	Water Line Work
143	Spec. No. 1-A, M.H. Detail
459	Retaining Wall (B-1)
63	Additional Pav't Rem'l

ESTIMATED QUANTITIES				
ROADWAY	202 606	Guard Rail Type 5	L.F.	50
	202	Pavement Removed	S.Y.	1243
		Ref. / Side / Location	1-G Lt./Rt. 101+98 R.R. D.R.	1PR Lt./Rt. 444+40 to 447+50
		TOTAL	50	1243

| ESTIMATED QUANTITIES | | | |