


CHKD. BY AH DATE 3-83  
CHKD. BY KH DATE 1-84

2 OHIO PROJECT 132  
632

CUYAHOGA COUNTY  
CUY-480-12.08

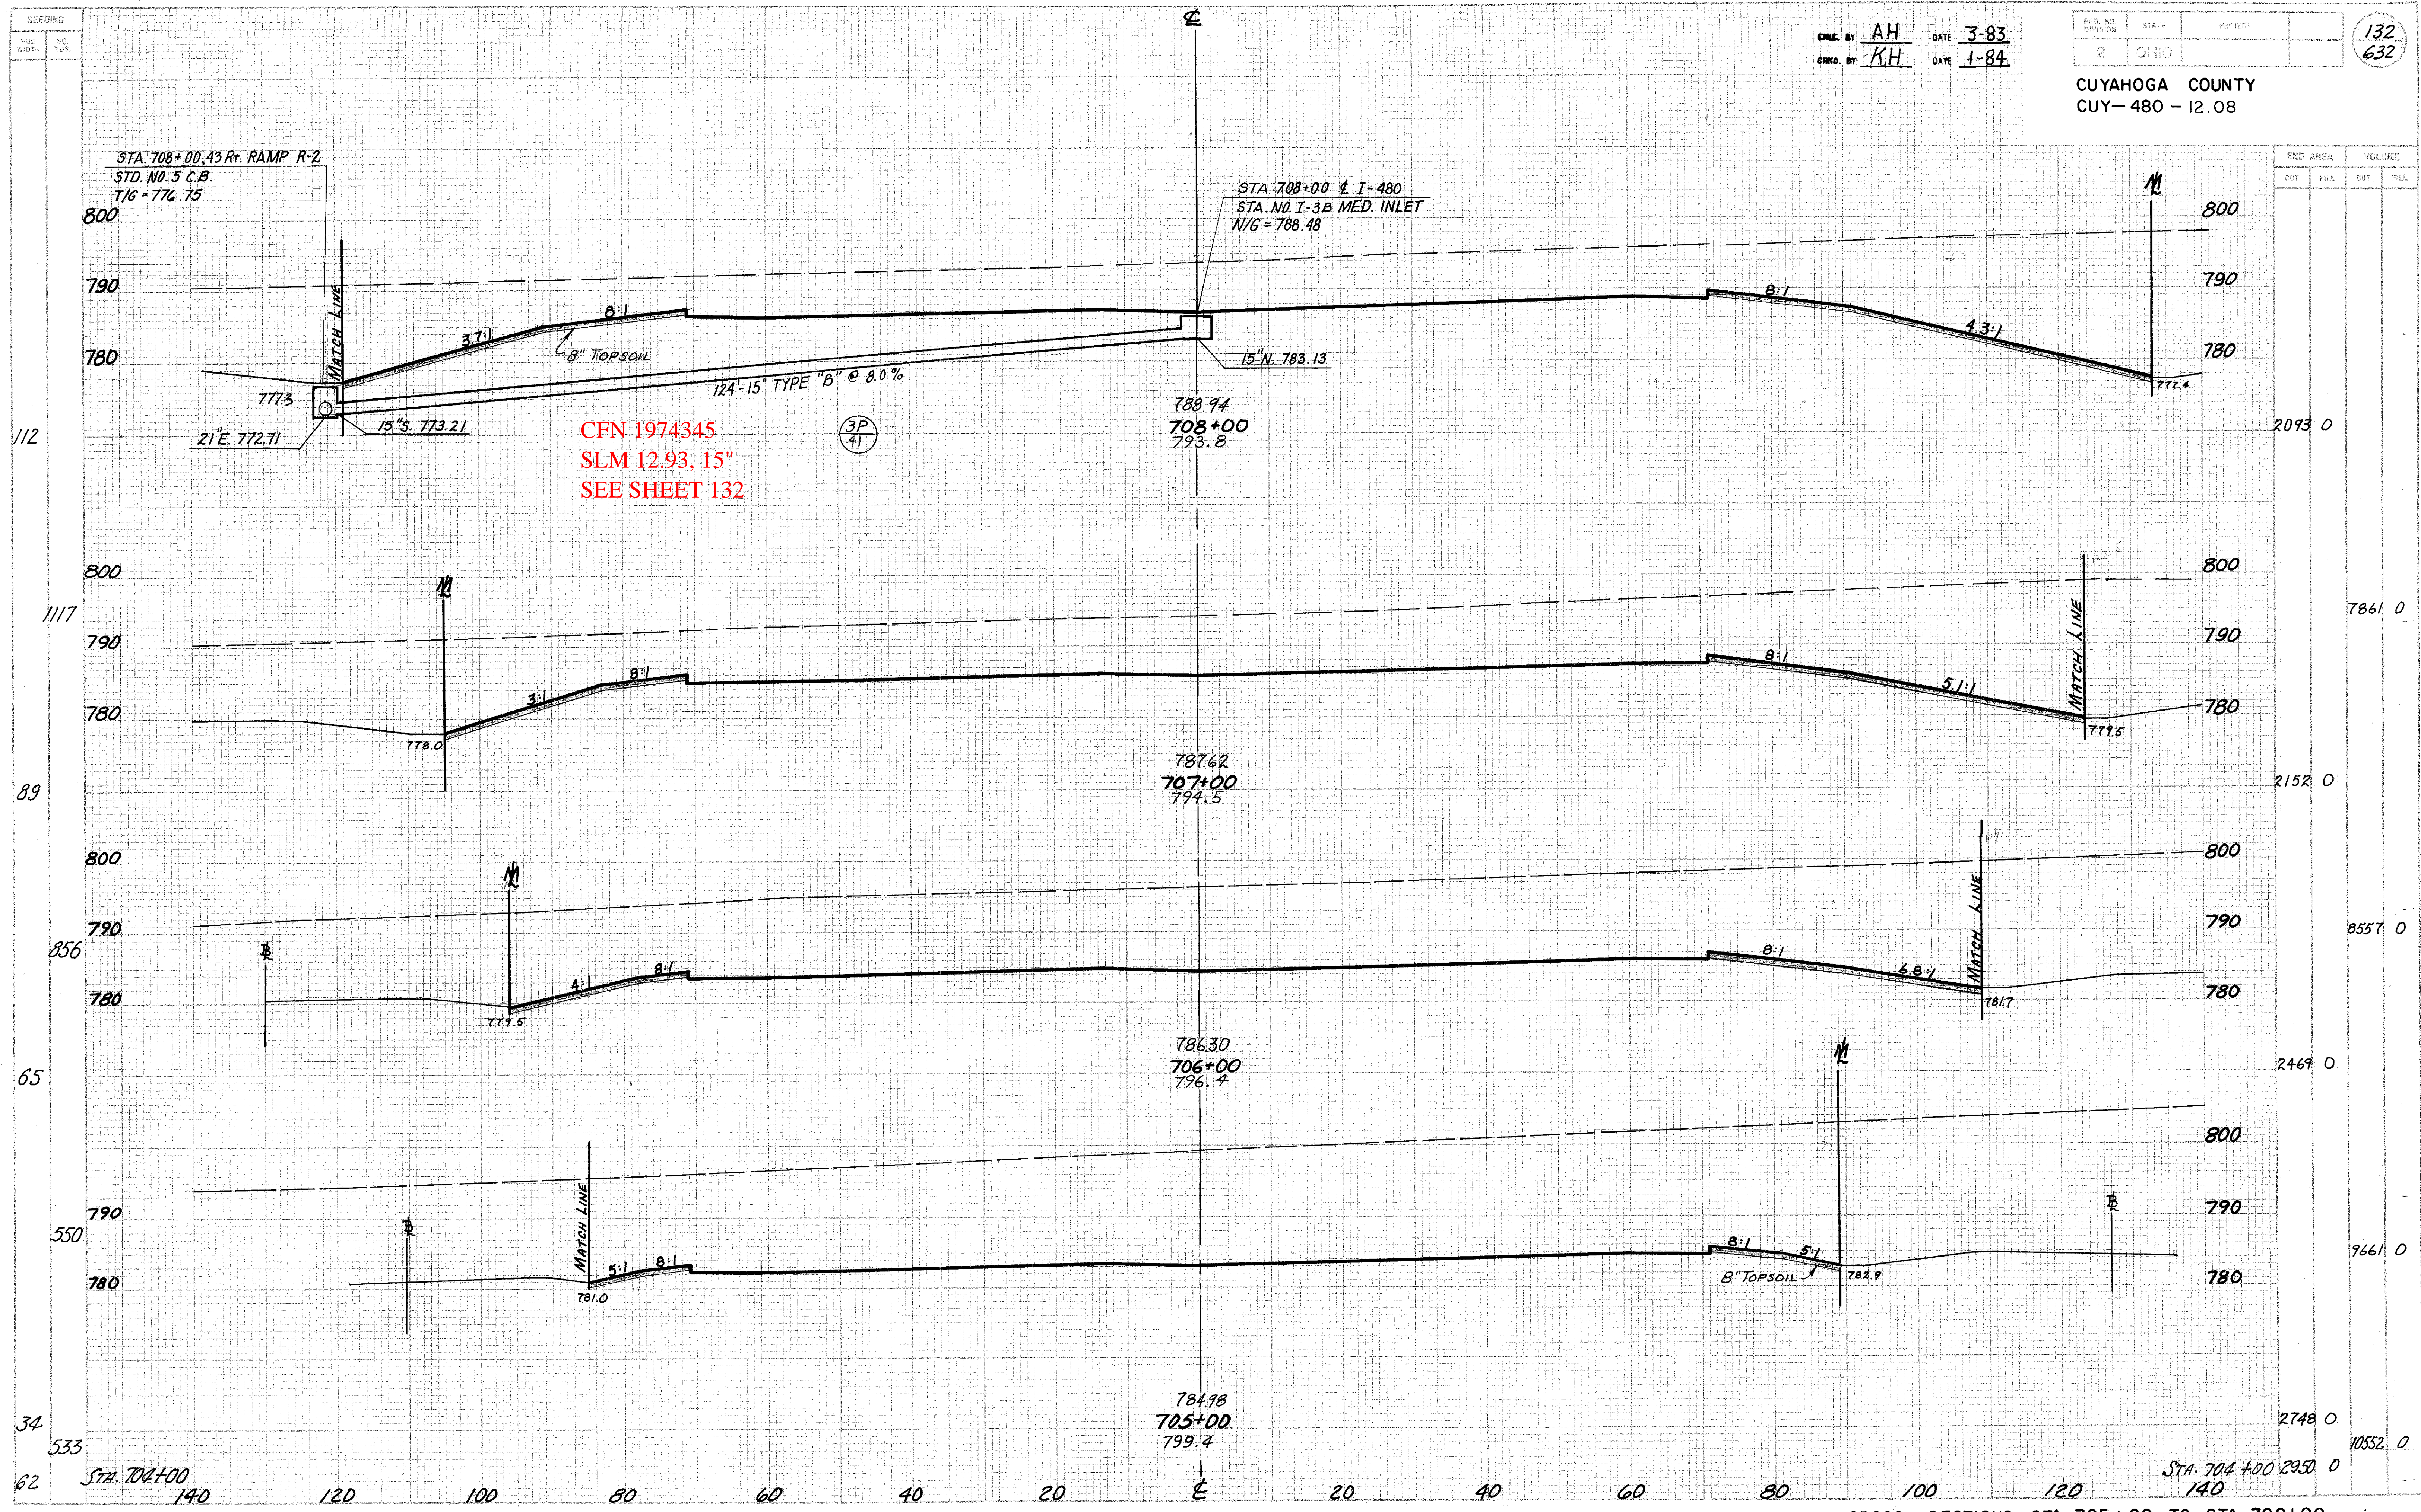

CFN 1974345  
SLM 12.93, 15"  
SEE SHEET 132

STATION	END AREA		VOLUME	
	CUT	FILL	CUT	FILL
708+00			2093	0
707+00			7861	0
706+00			2152	0
705+00			8557	0
			2469	0
			9661	0
			2748	0
			10552	0

CROSS-SECTIONS STA. 705+00 TO STA. 708+00