


06 MAR 2000
 P:\PR22308\CADD\1738GX.DGN

SEEDING	END	
	WIDTH	SO. YDS.
	108	
	15	
	56	
	5	
	61	
	17	
	225	

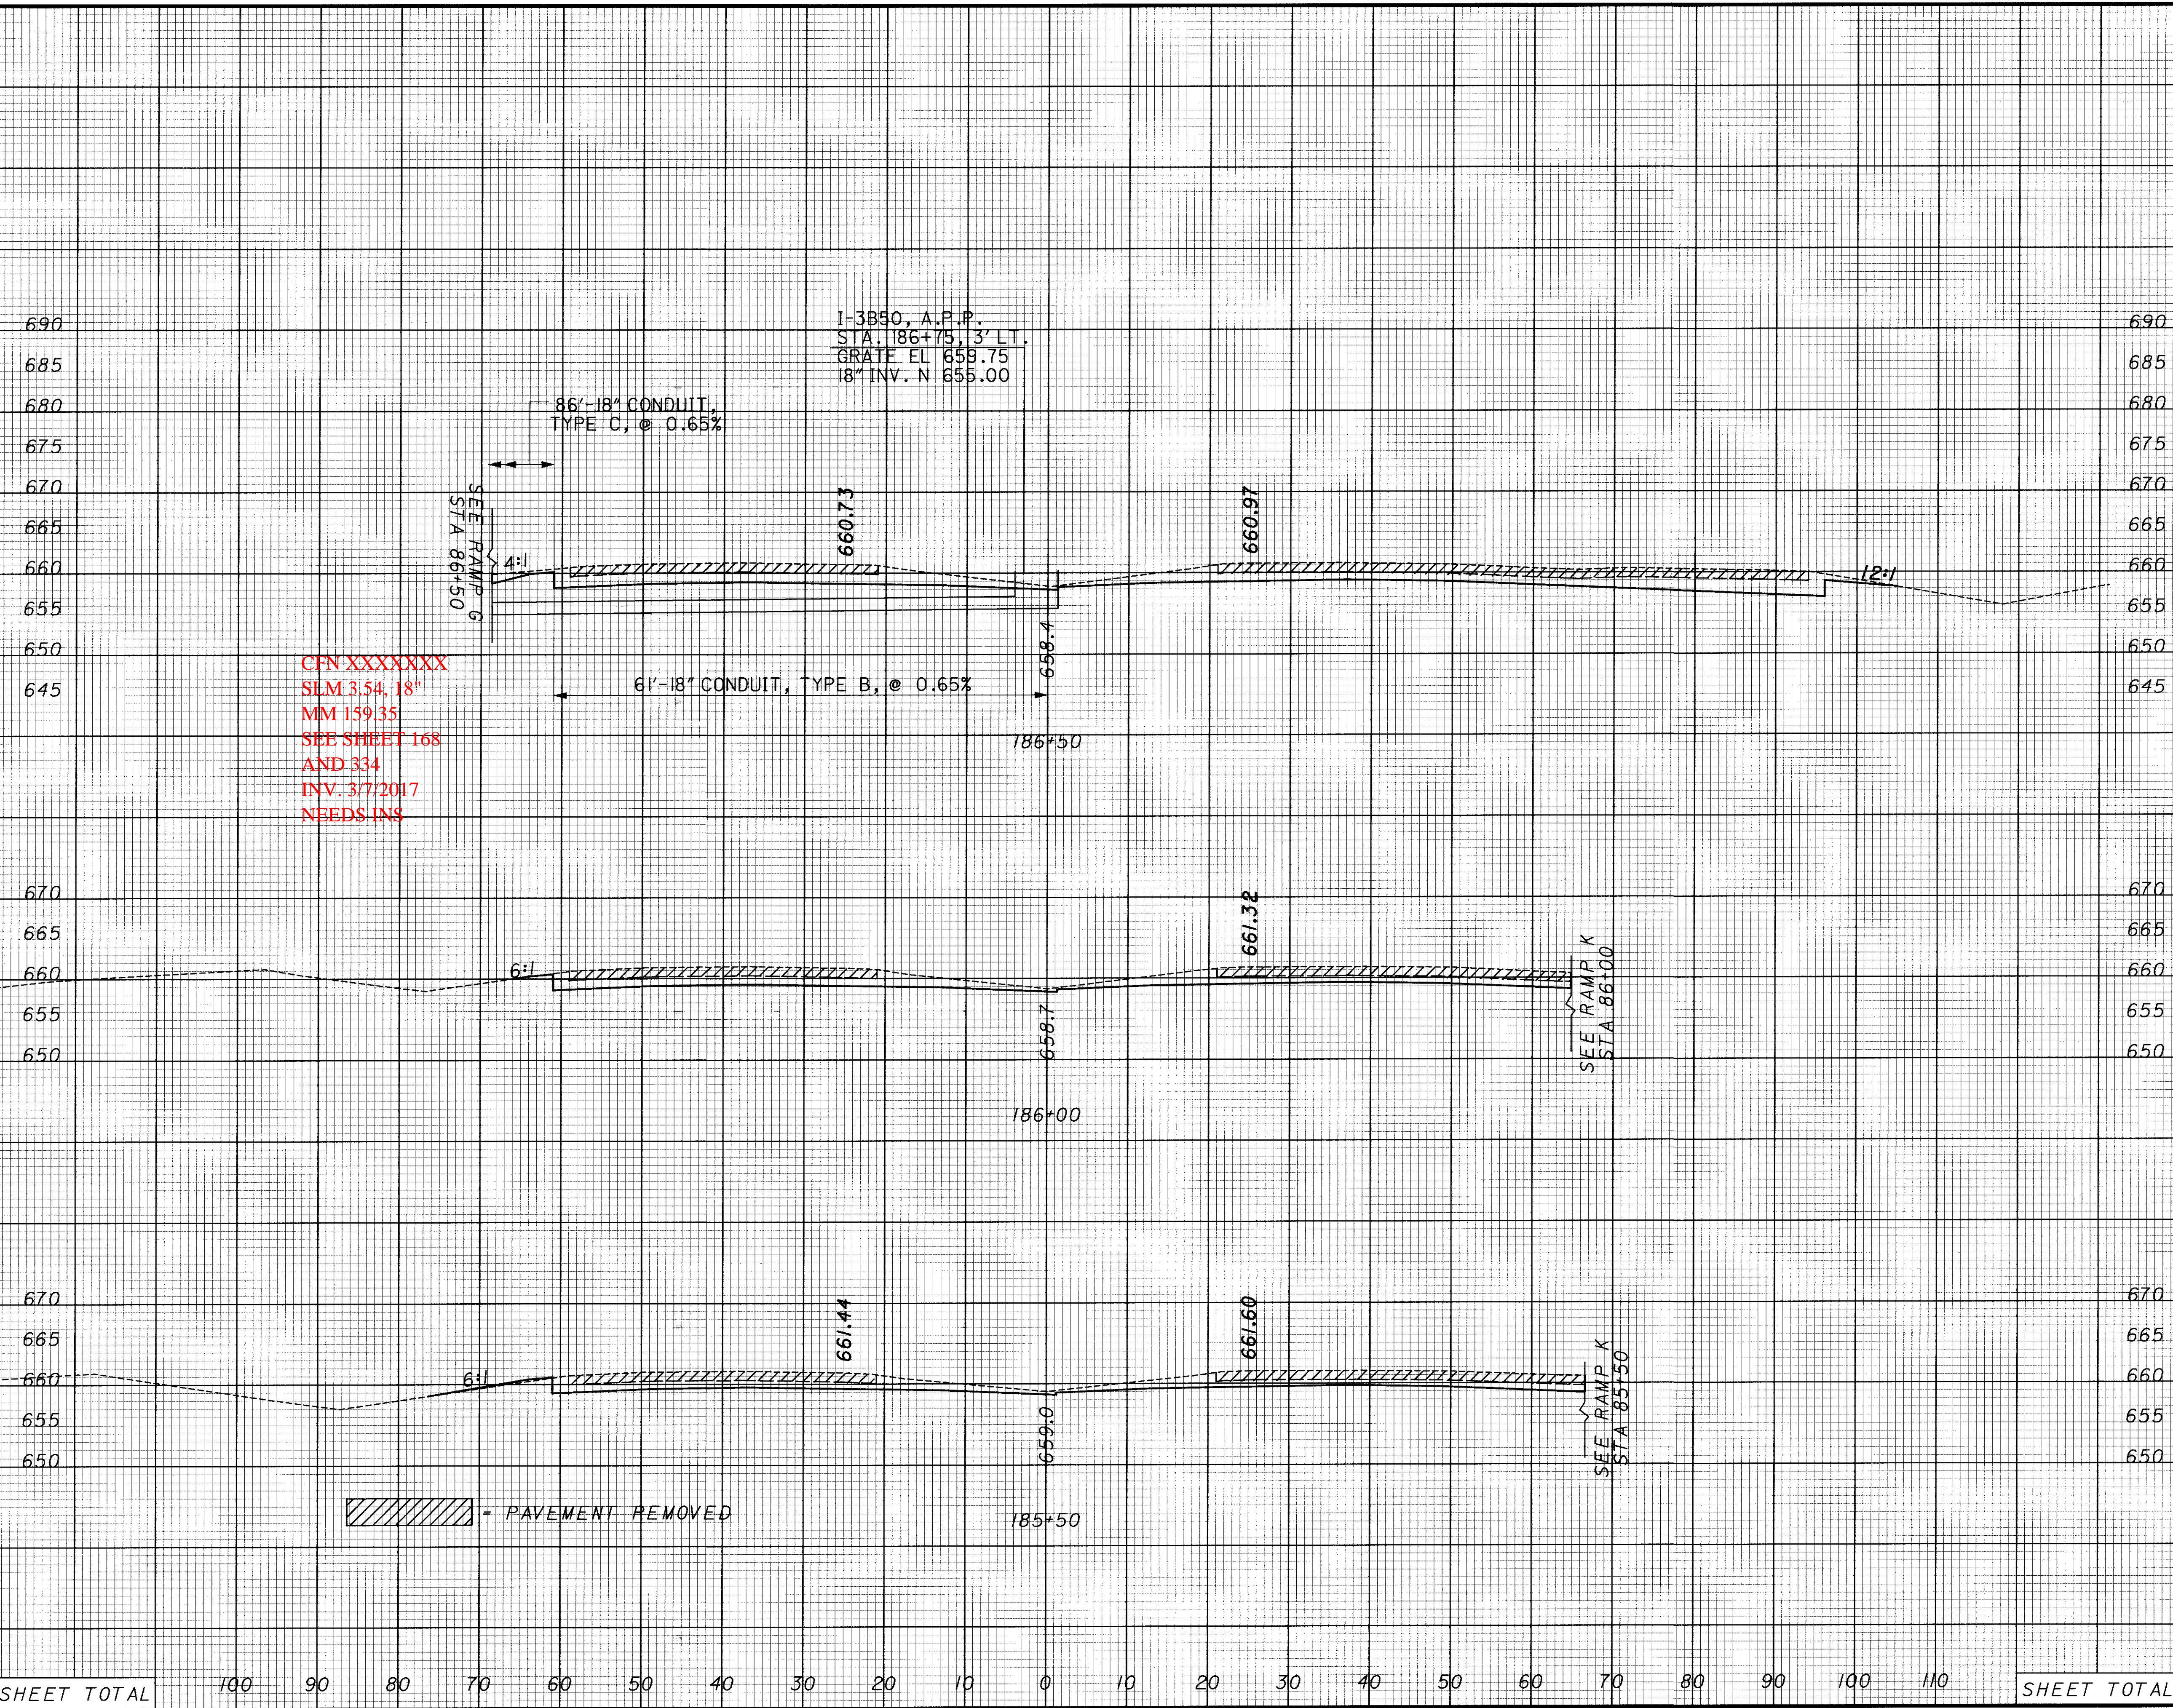

END	AREA		VOLUME	
	CUT	FILL	CUT	FILL
690				
685				
680				
675				
670				
665				
660				
655				
650				
645	203	0		
670			305	0
665				
660				
655				
650	126	0		
670			222	5
665				
660				
655				
650	114	2		
SHEET TOTAL	214	6	741	11

CALCULATED BY: M.H. CHECKED BY: R.A.S.
CROSS SECTIONS STA 185+50 TO STA 186+50
CUY-90-0.00
 301
 582