


CUYAHOGA COUNTY
CITY OF CLEVELAND
MEDINA-CLARK INTERCHANGE
CUY-71-18.54
CUY-90-13.81


ESTIMATED QUANTITIES

CODE	ROADWAY	INLET CODE		I-1 PIPE				
				CLASS B-1	CLASS E-1	CLASS E-1	CLASS E-1	
		FROM	TO	24"	18"	21"	CLASS E-1 Sec. M-6.6(c) 24"	
P-5	LANE S-W	5	10		503			
P-10	LANE S-W	10	12			389		
P-12	LANE S-W	12	16	171				
P-16	Clark Freeway	16	17				121	
CUY-71-18.54 TOTALS					171	503	389	121

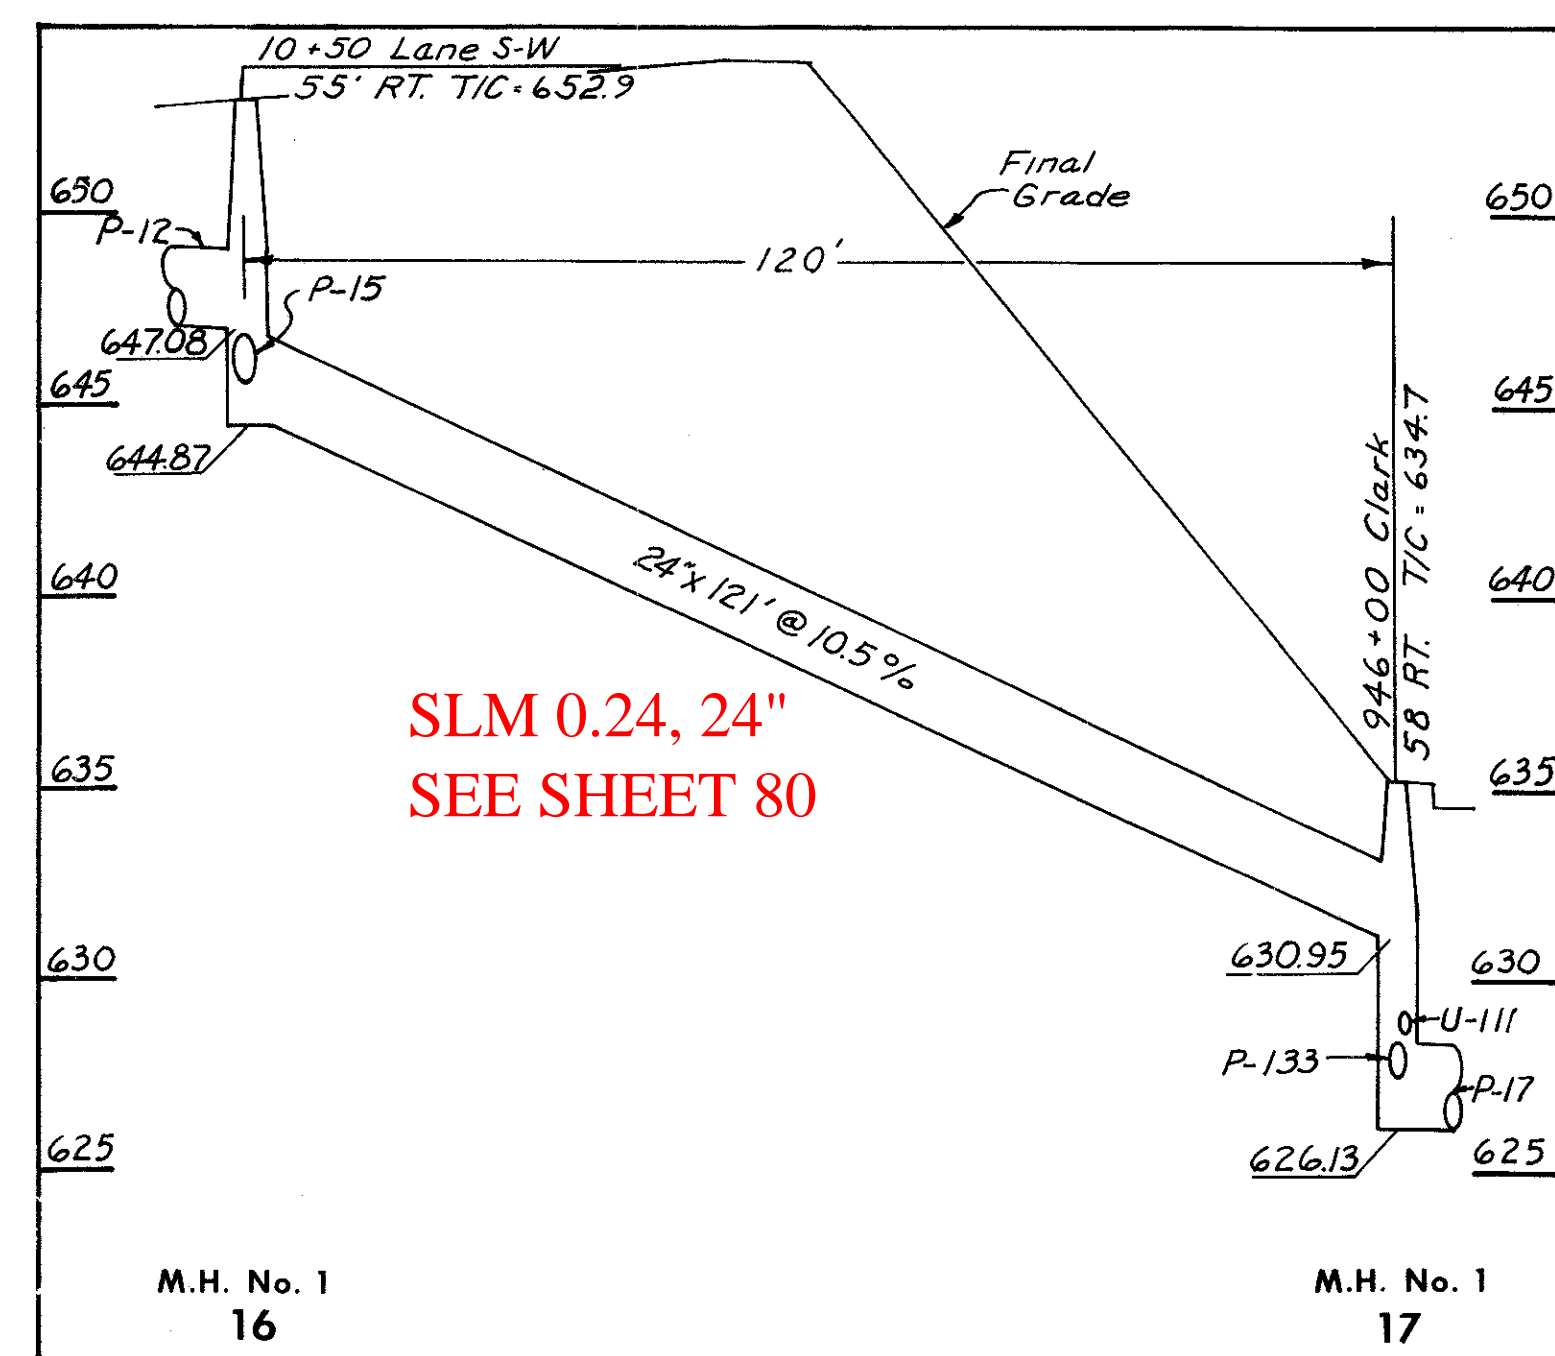


SLM 0.24, 24"
SEE SHEET 80

P-16
CLASS E-1 Sec. M-6.6(c)

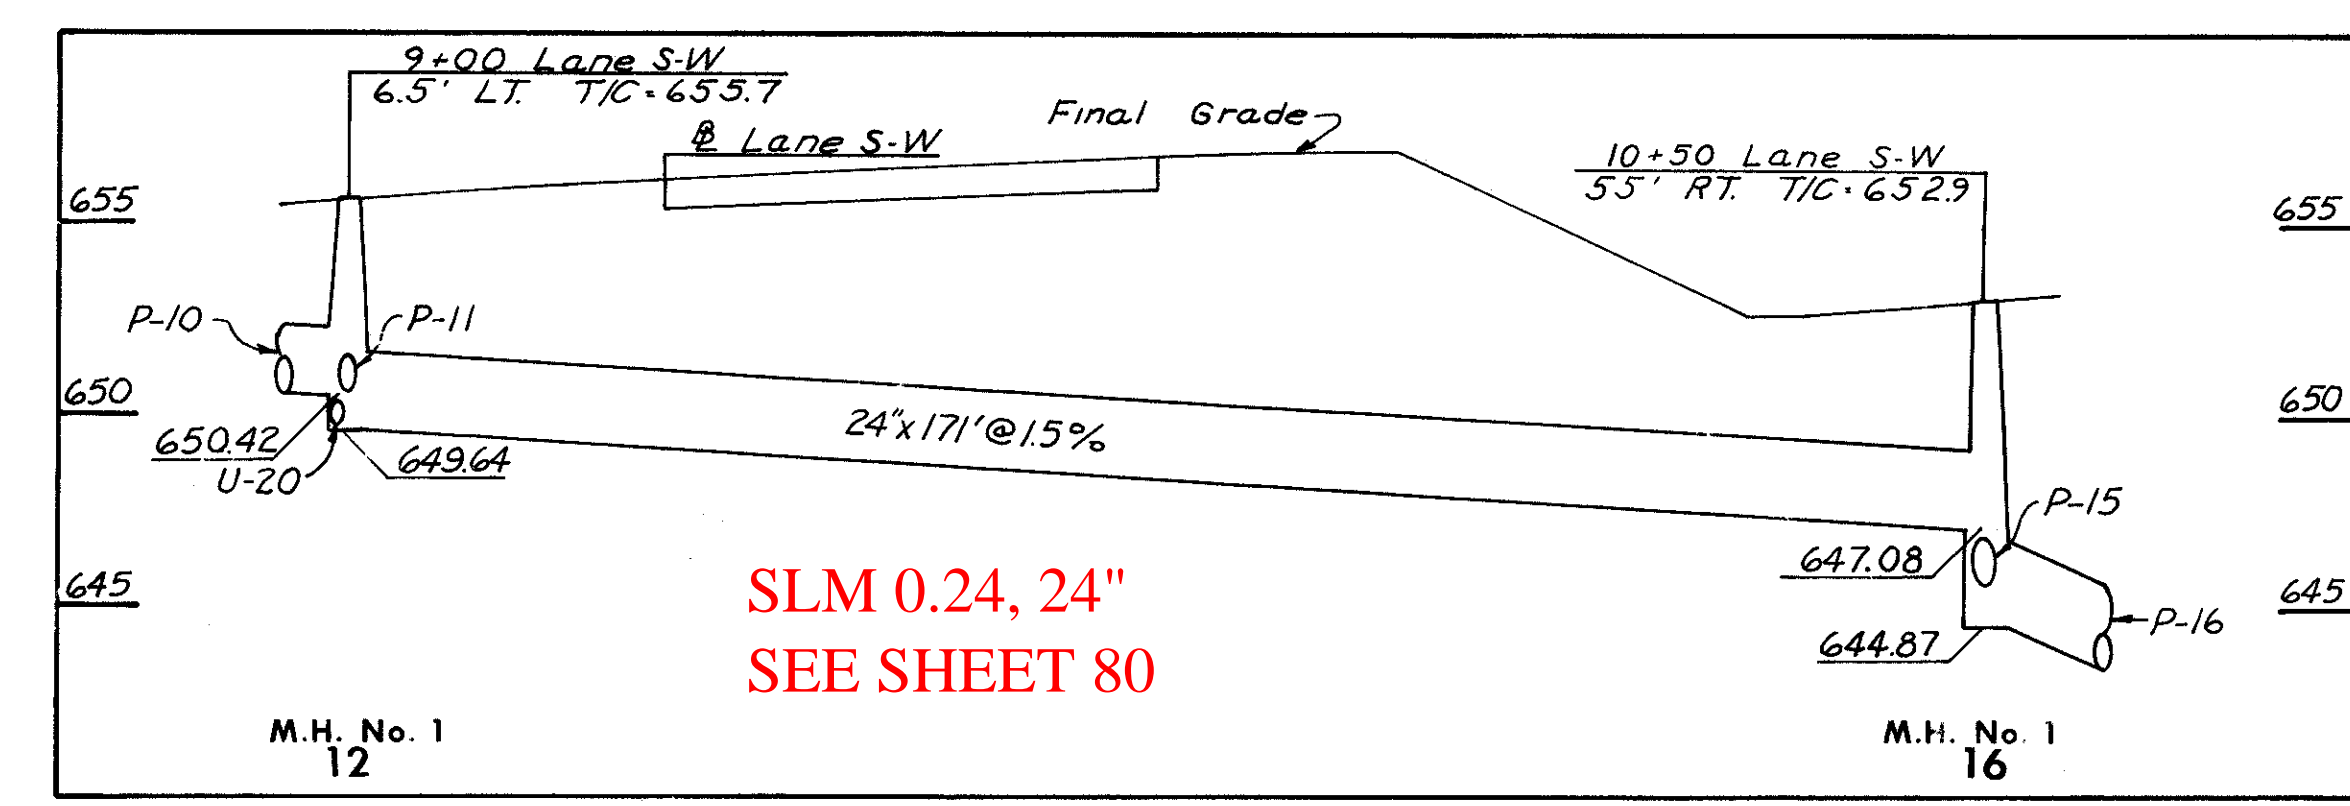


SLM 0.24, 24"
SEE SHEET 80

P-12
CLASS B-1

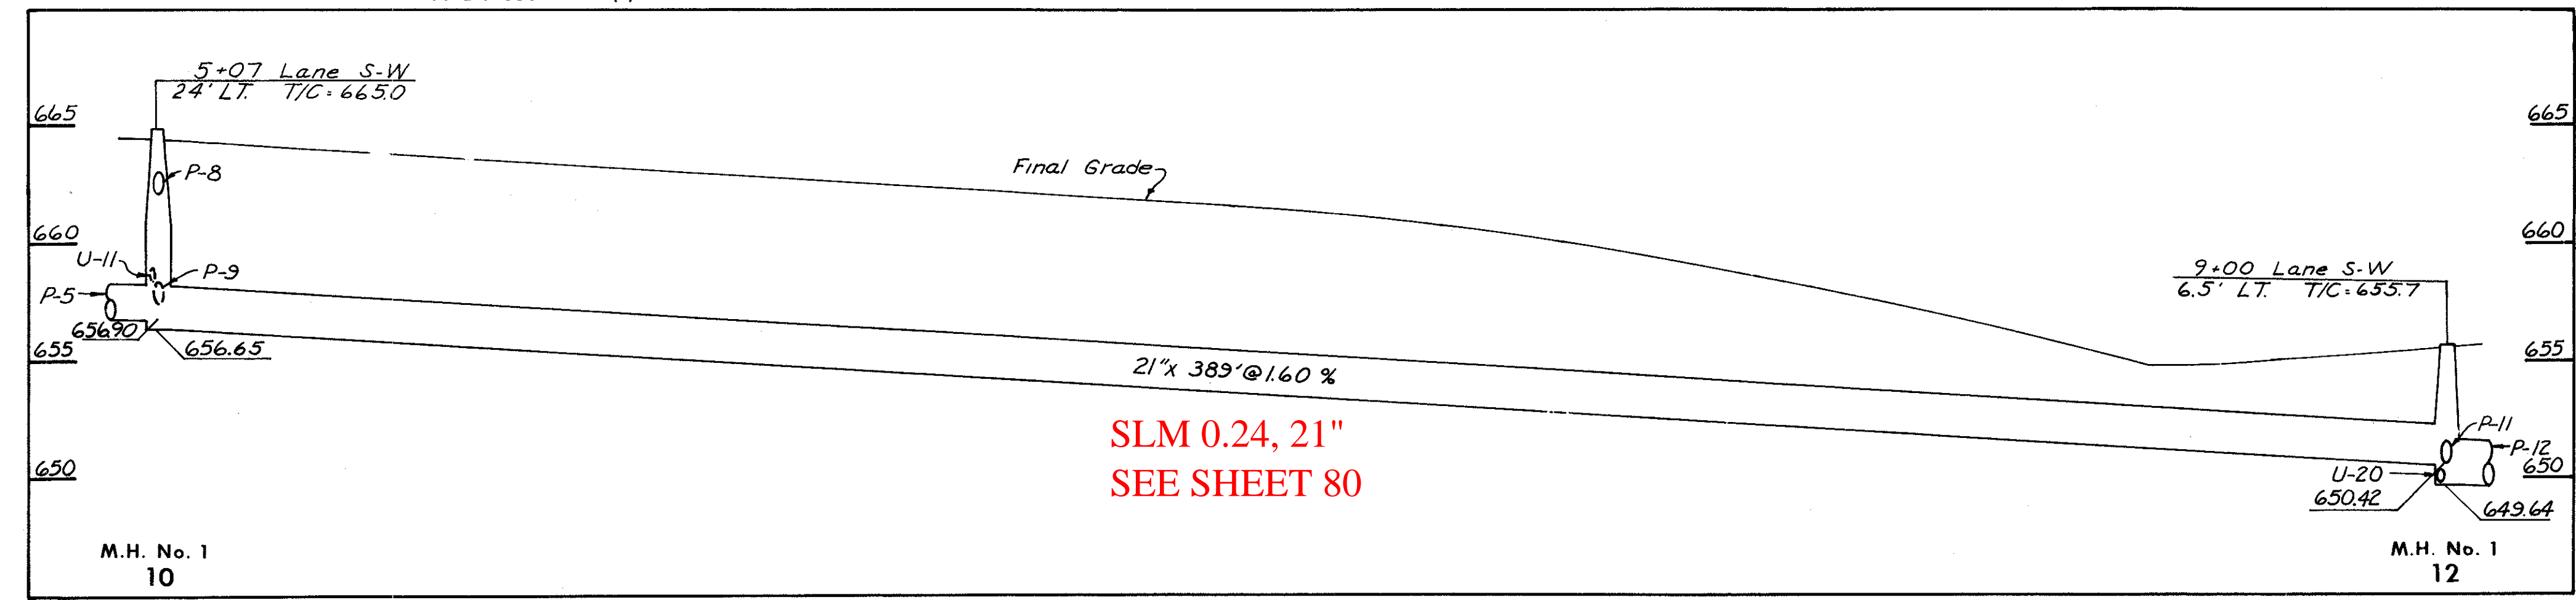

SLM 0.24, 21"
SEE SHEET 80

P-10
CLASS E-1

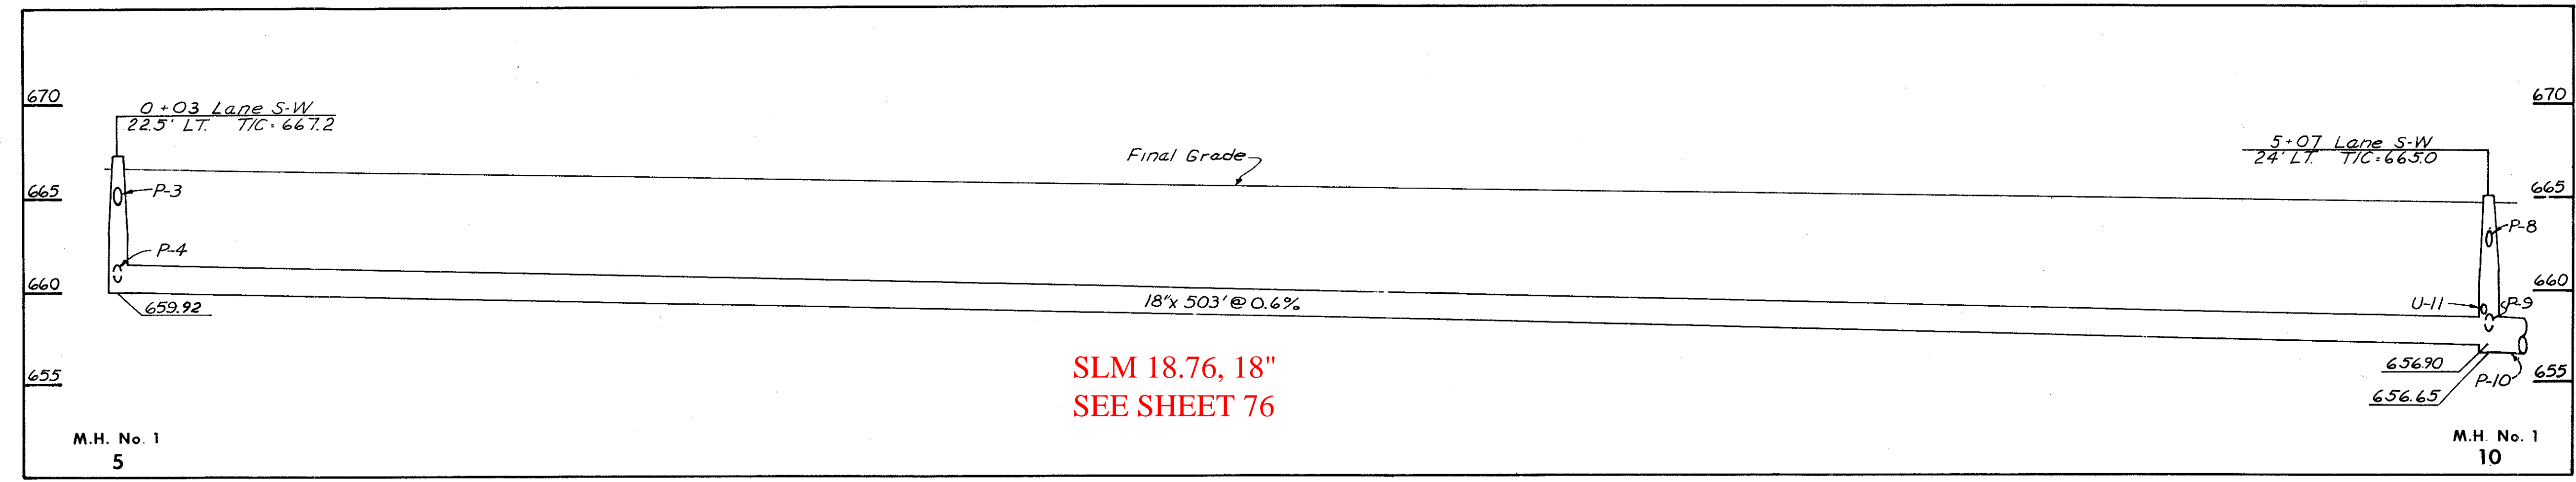

SLM 18.76, 18"
SEE SHEET 76

P-5
CLASS E-1

P-5, P-10,
P-12, and P-16
SEWER PROFILES