


CUYAHOGA COUNTY
CUY-71-10.16

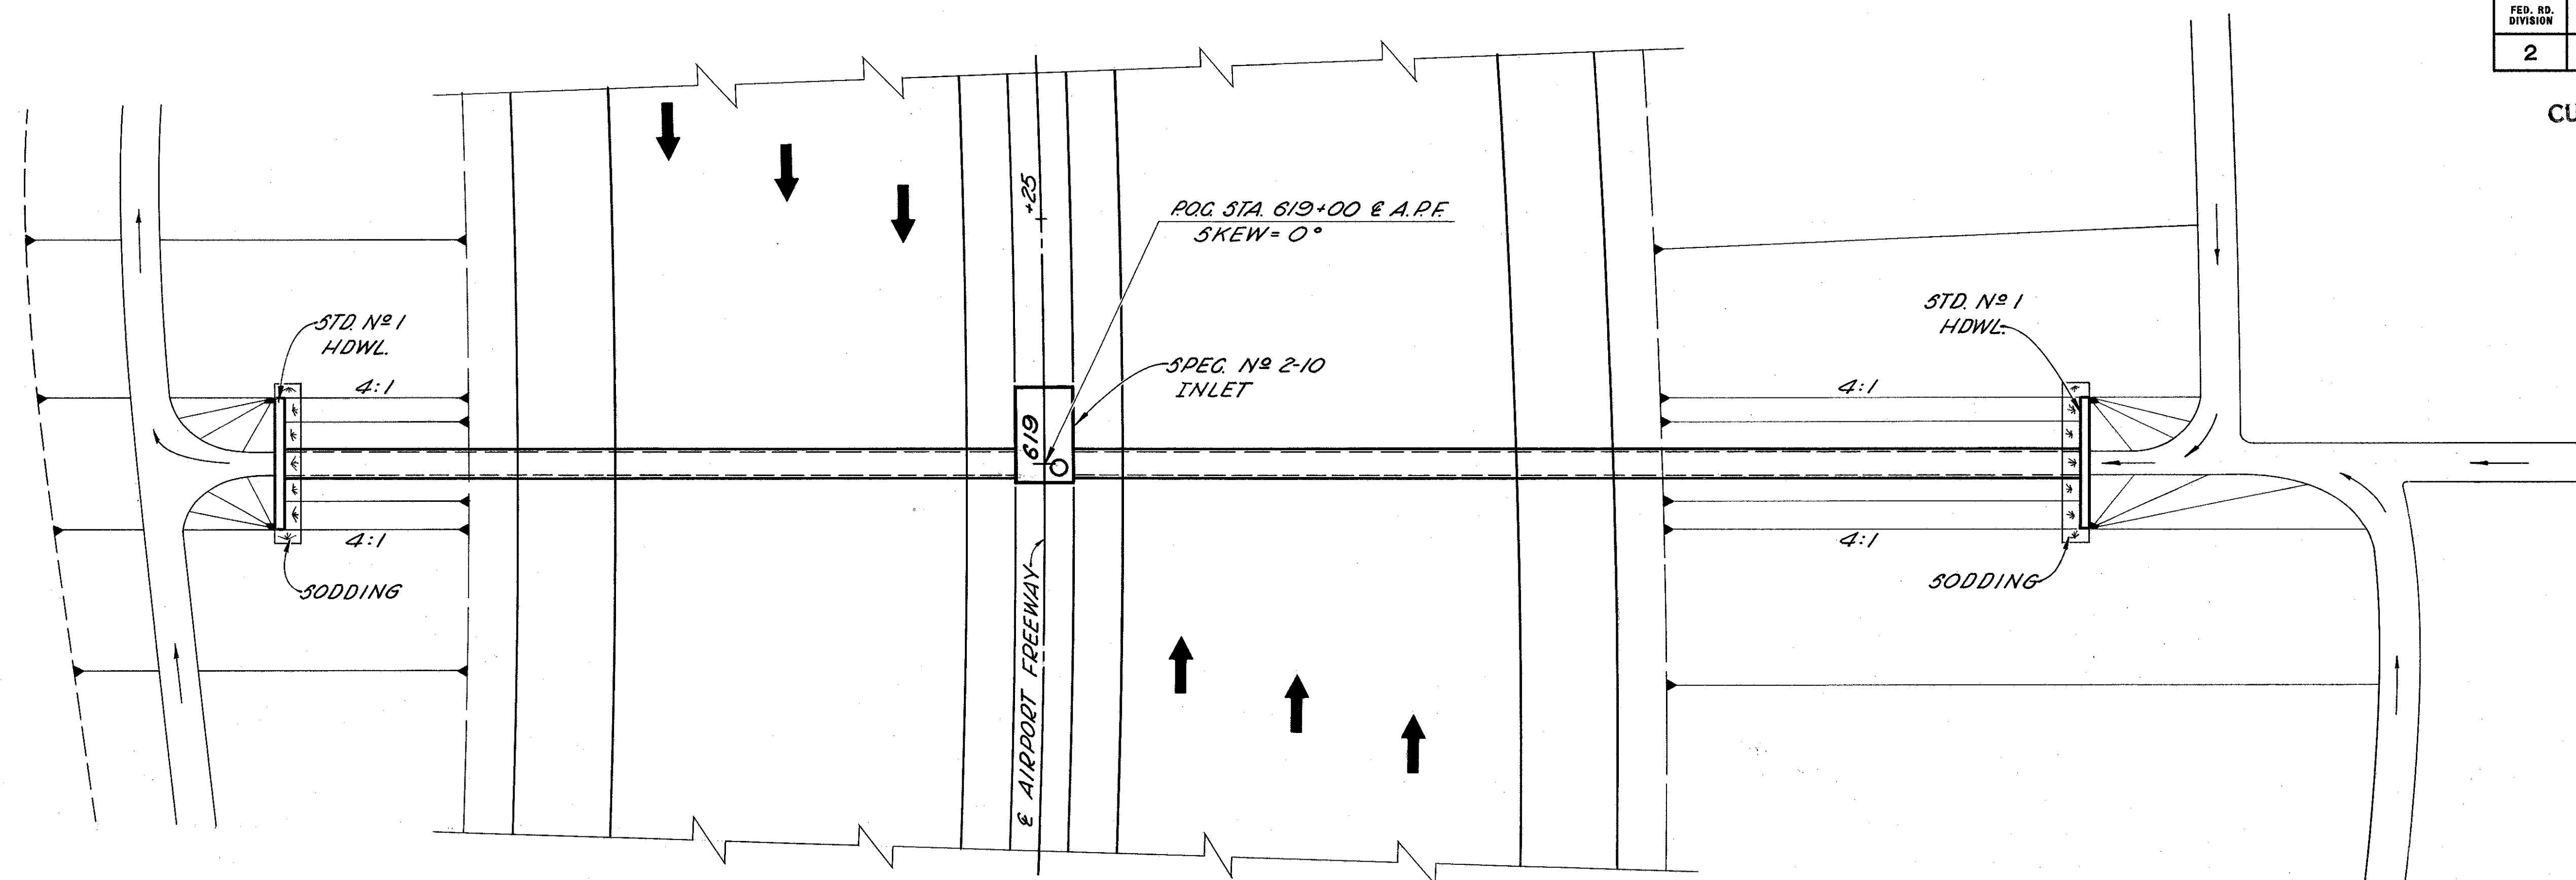

D.A. = 6.2 Acres
Q50 = 30 c.f.s.


SCALE: HOR. 1"=10'
VERT. 1"=5'

CULVERT DATA

TYPE: Standard strength reinforced concrete culvert pipe
class A-1, Sec. M-6.6(b) or Sec. M-6.8(b).
Standard headwalls No. 1 and special inlet No. 2-10
SIZE: 30" x 79' and 30" x 107'

ESTIMATED QUANTITIES

I-1	30" Cl. A-1, Sec. M-6.6(b) or Sec. M-6.8(b)	186 Lin. Ft.
I-2	Masonry	4.7 Cu. Yds.
I-8	Standard No. 2-10 Inlet Modified as per plan	1 Each
L-10	Sodding	6 Sq. Yds.

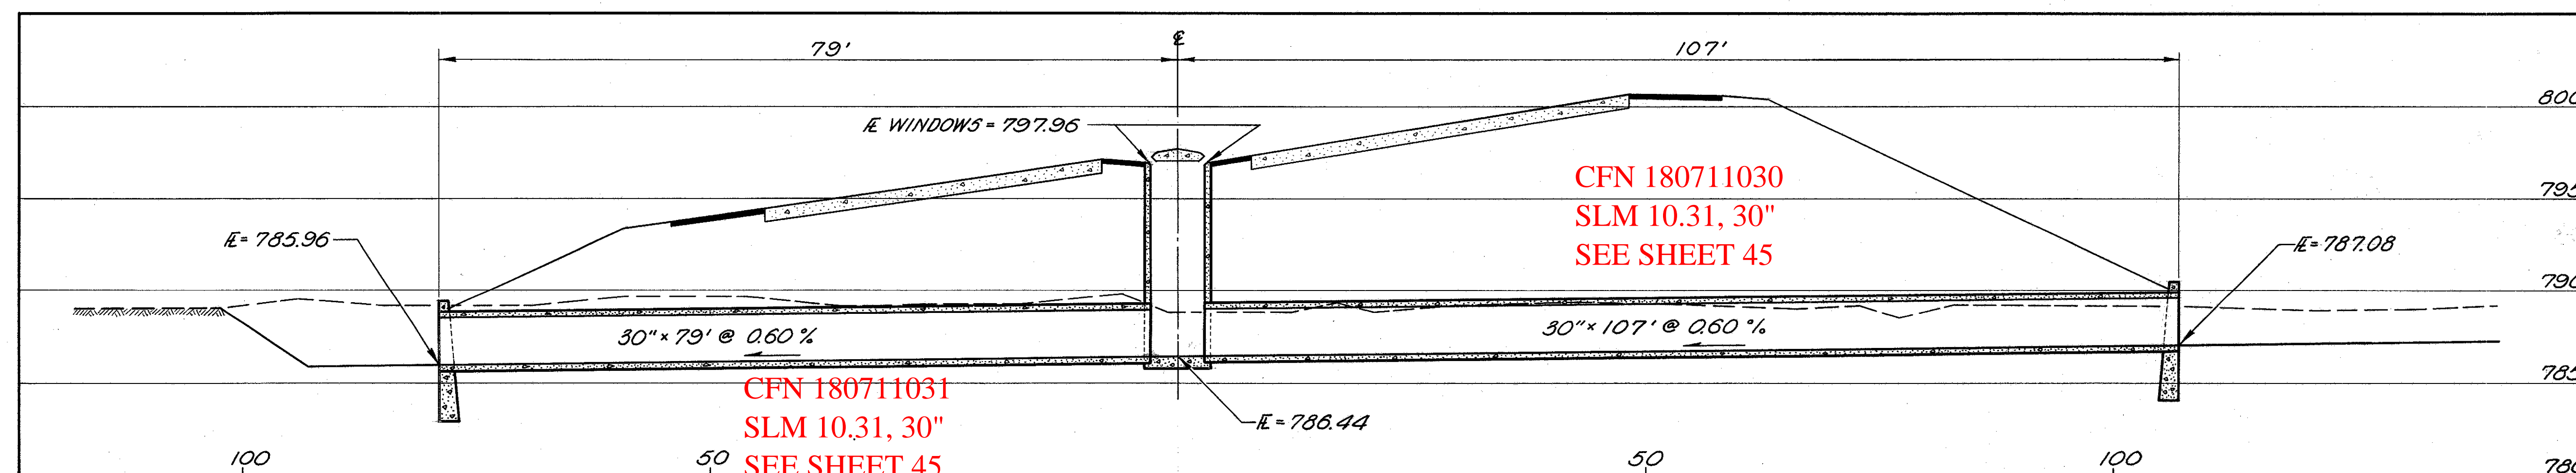

NOTE:
For details of Special
No. 2-10 Inlet, See Sht. NO. 50