



STATE ROUTE 5 - STATE ROUTE 7

WILLIAMSFIELD KINSMAN RD

STATE ROUTE 5 - STATE ROUTE 7

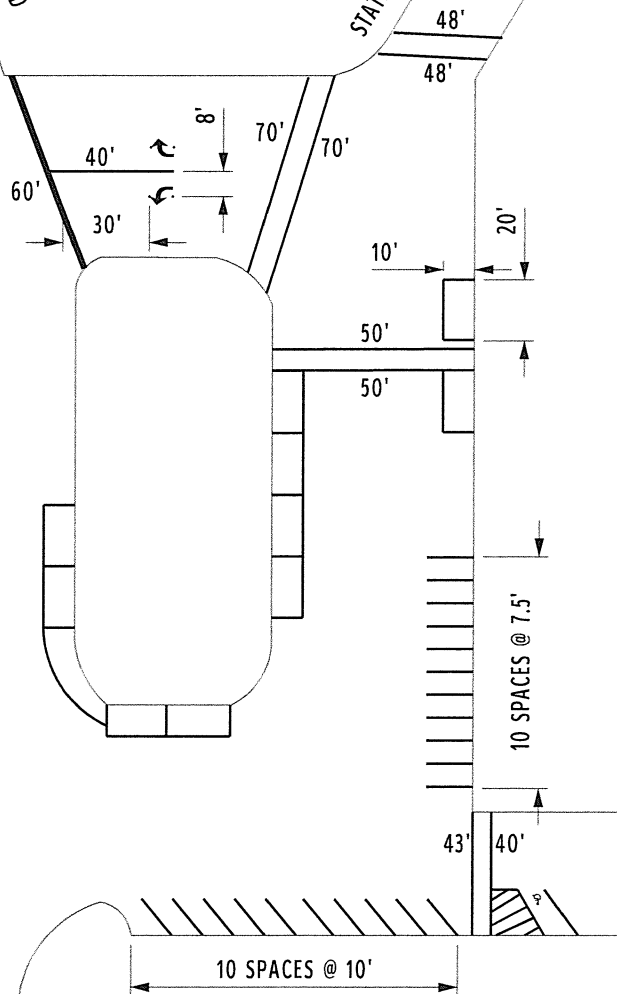

COUNTY:	TRUMBULL		
LOCATION:	S.R. 5D		
S.L.M.:	0.026		
24" STOP LINE:	60	L.F.	
12" CROSSWALK LINE:	422	L.F.	
DOTTED LINE:		L.F.	
8" CHANNELIZING LINE:	40	L.F.	
12" CHANNELIZING LINE:		L.F.	
24" TRANSVERSE LINE (WT):	35	L.F.	
24" TRANSVERSE LINE (YW):		L.F.	
SYMBOL: 1 - LEFT ARROW, 1 - RIGHT ARROW			
705 L.F. PARKING STALL MARKINGS, 1 - HANDICAP SYMBOL			

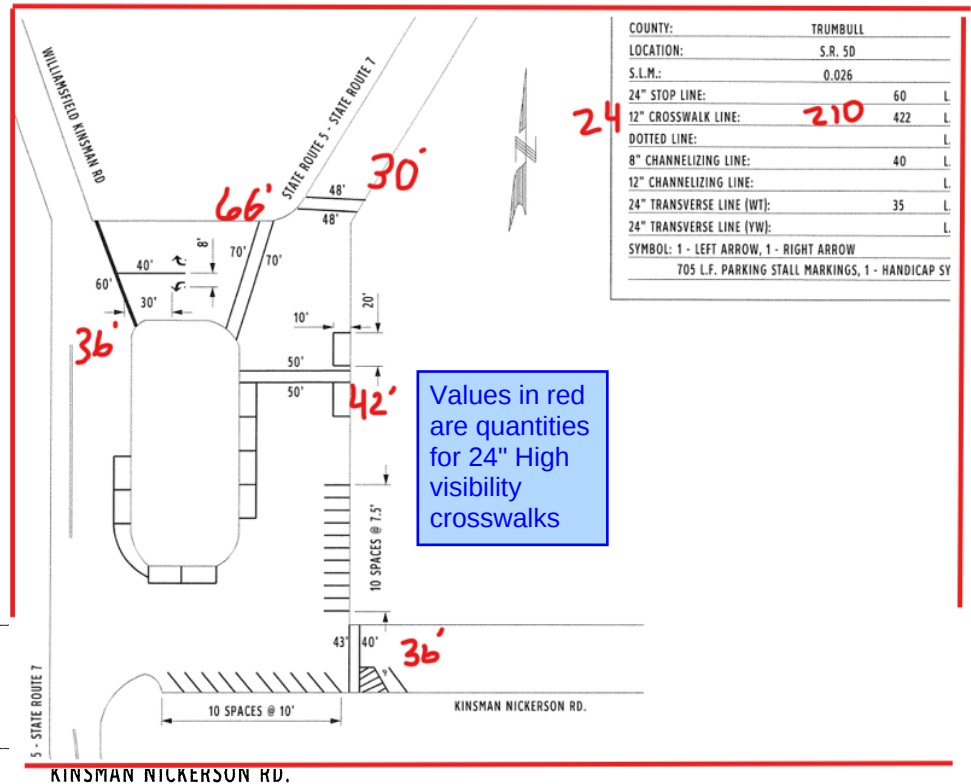

COUNTY:	TRUMBULL	
LOCATION:	S.R. 5D	
S.L.M.:	0.026	
24" STOP LINE:	60	L
4 12" CROSSWALK LINE:	210	L
DOTTED LINE:		L
8" CHANNELIZING LINE:	40	L
12" CHANNELIZING LINE:		L
24" TRANSVERSE LINE (WT):	35	L
24" TRANSVERSE LINE (YW):		L
SYMBOL: 1 - LEFT ARROW, 1 - RIGHT ARROW		
705 L.F. PARKING STALL MARKINGS, 1 - HANDICAP SY		

Values in red
are quantities
for 24" High
visibility
crosswalks

5 - STATE ROUTE 7

KINSMAN NICKERSON RD.

KINSMAN NICKERSON RD.