C

### UTILITIES

LISTED BELOW ARE ALL UTILITIES LOCATED WITHIN THE PROJECT CONSTRUCTION LIMITS TOGETHER WITH THEIR RESPECTIVE OWNERS:

CHARTER COMMUNICATIONS (SPECTRUM/TIME WARNER) 11252 CORNELL PARK DR. CINCINNATI. OH 45242 PHONE 513-386-5499 ATTN.: KENT REIGER

CINCINNATI BELL - UNDERGROUND STRUCTURES 221 E. 4TH ST., BLDG. 121-900 CINCINNATI. OH 45201 PHONE 513-565-7043 ATTN.: BRECK COWAN

CINCINNATI BELL- AERIAL & PLACING 221 E. 4TH ST, BLDG. 121-900 CINCINNATI. OH 45201 PHONE 513-566-8039 ATTN.: NANCY MORRIS NANCY.MORRIS@CINBELL.COM ROADPROJECTS@CINBELL.COM

DUKE ENERGY – ELECTRIC (DISTRIBUTION) 2010 DANA AVE CINCINNATI, OH 45207 PHONE 513-514-8211 ATTN.: AARON WRIGHT AARON.WRIGHT@DUKE-ENERGY.COM

DUKE ENERGY GAS 139 EAST 4TH ST., ROOM 460A CINCINNATI, OH 45202 PHONE 513-906-0128 ATTN.: BRIAN HOLLMANN

DUKE ENERGY ELECTRIC - TRANSMISSION 2010 DANA AVE. EF 324 CINCINNATI, OH 45207 PHONE 513-287-1266 ATTN.: TIM MEYER

BUTLER COUNTY WATER AND SEWER 130 HIGH ST. HAMILTON, OH 45011 PHONE 1-513-887-5699 ATTN.: JEFF FRECHTLING JEFF.FRECHTLING@BCOHIO.US

OIL **BP OIL** 150 W. WARRENVILLE ROAD NAPERSVILLE, IL 60563 BPPIPELINESROW@BP.COM

TELEPHONE ACD.NET/ACD TELECOM OSP ENGINEERING SPECIAL PROJECTS 1800 N. GRAND RIVER AVE LANSING, MI 48906 TELEPHONE: 517-999-3259 (JEREMIAH BRAND) BRAND.JEREMIAH@ACD.NET GENERAL EMAIL: OSP@ACD.NET

THE LOCATION OF THE UNDERGROUND UTILITIES SHOWN ON THE PLANS ARE AS OBTAINED FROM THE OWNERS AS REQUIRED BY SECTION 153.64 O.R.C.

# **CONSTRUCTION NOISE**

ACTIVITIES AND LAND USE ADJACENT TO THIS PROJECT MAY BE AFFECTED BY CONSTRUCTION NOISE. IN ORDER TO MINIMIZE ANY ADVERSE CONSTRUCTION NOISE IMPACTS, DO NOT OPERATE POWER-OPERATED CONSTRUCTION-TYPE DEVICES BETWEEN THE HOURS OF 7:00 PM AND 7:00 AM. IN ADDITION, DO NOT OPERATE AT ANY TIME ANY DEVICE IN SUCH A MANNER THAT THE NOISE CREATED SUBSTANTIALLY EXCEEDS THE NOISE CUSTOMARILY AND NECESSARILY ATTENDANT TO THE REASONABLE AND EFFICIENT PERFORMANCE OF SUCH EQUIPMENT.

### SHAFOR DR. WATERLINE RELOCATION

BUTLER COUNTY WATER AND SEWER (BCWS) IS REPLACING THE CAST IRON WATER MAIN ON SHAFOR DR. THE CONTRACTOR SHALL COORDINATE WITH THE BCWS CONTACT LISTED ABOVE.

### SURVEYING PARAMETERS

PRIMARY PROJECT CONTROL MONUMENTS GOVERN ALL POSITIONING ON ODOT PROJECTS. SEE SHEET 2 OF THE PLANS FOR A TABLE CONTAINING PROJECT CONTROL INFORMATION.

USE THE FOLLOWING PROJECT CONTROL, VERTICAL POSITIONING, AND HORIZONTAL POSITIONING PARAMETERS FOR ALL SURVEYING:

PROJECT CONTROL

POSITIONING METHOD: GPS/VRS/CONVENTIONAL **MONUMENT TYPE:** 

**VERTICAL POSITIONING** 

ORTHOMETRIC HEIGHT DATUM: NAVD 88 12B GEOID:

HORIZONTAL POSITIONING

REFERENCE FRAME: NAD 83(2011) **ELLIPSOID**: GRS80

LAMBERT CONFORMAL CONIC MAP PROJECTION: COORDINATE SYSTEM: OHIO STATE PLANE SOUTH

ORIGIN OF COORDINATE

SYSTEM: 0,0

USE THE POSITIONING METHODS AND MONUMENT TYPE USED IN THE ORIGINAL SURVEY TO RESTORE ALL MONUMENTS RELATED TO PRIMARY PROJECT CONTROL THAT ARE DAMAGED OR DESTROYED BY CONSTRUCTION ACTIVITIES. RESTORE THE DAMAGED OR DESTROYED MONUMENTS IN ACCORDANCE WITH CMS 623.

UNITS ARE IN U.S. SURVEY FEET.

# **WORK LIMITS**

THE WORK LIMITS SHOWN ON THESE PLANS ARE FOR PHYSICAL CONSTRUCTION ONLY. PROVIDE THE INSTALLATION AND OPERATION OF ALL WORK ZONE TRAFFIC CONTROL AND WORK ZONE TRAFFIC CONTROL DEVICES REQUIRED BY THESE PLANS WHETHER INSIDE OR OUTSIDE THESE WORK LIMITS.

# PATCHING PLANED SURFACE

THE FOLLOWING QUANTITY HAS BEEN CARRIED TO THE GENERAL SUMMARY FOR USE AS DIRECTED BY THE ENGINEER FOR USE IN PATCHING PLANED SURFACES

ITEM 254 - PATCHING PLANED SURFACE


653 SY

### ITEM 254 - PAVEMENT PLANING

THE PAVEMENT PLANING SHALL BE SCHEDULED SO AS TO BE COVERED BY THE SURFACE COURSE WITHIN 5 CALENDAR DAYS. THE COST OF THE ABOVE SHALL BE INCLUDED IN THE UNIT BID PRICE FOR THE RESPECTIVE ITEM. A DISINCENTIVE IN THE AMOUNT OF \$7,200 SHALL BE ASSESSED FOR EACH DAY, OR PORTION THEREOF, A PLANED SURFACE IS OPEN TO TRAFFIC BEYOND THE SPECIFIED TIME LIMIT.

#### ITEM 253 - PAVEMENT REPAIR

AN ESTIMATED QUANTITY OF 10 CY OF ITEM 253 - PAVEMENT REPAIR HAS BEEN CARRIED TO THE GENERAL SUMMARY TO BE USED AS DIRECTED BY THE ENGINEER. THIS OPERATION SHALL BE PERFORMED BEFORE PAVEMENT PLANING OF ROADWAY.

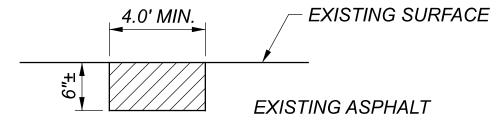

EXISTING SUBBASE

EXISTING DETERIORATED ASPHALT SHALL BE REMOVED TO A MAXIMUM DEPTH OF 6" OR AS DIRECTED BY THE ENGINEER AND REPLACED WITH ITEM 301. ASPHALT CONCRETE BASE. THE 301 SHALL BE COMPACTED AS PER 401.15 AND IN APPROXIMATELY EQUAL LAYERS. THE LOCATIONS AND SIZE OF THE REPAIRS SHALL BE DETERMINED BY THE ENGINEER.



LAA REVIEWER CSR 6/15/20

ROJECT ID 110424

15

#### ITEM 614. MAINTAINING TRAFFIC

BASED ON TRAFFIC VOLUMES, LANE CLOSURES ARE NOT PERMITTED DURING PEAK HOURS. REFER TO THE LANE VALUE CONTRACT TABLE BELOW FOR RESTRICTED HOURS. OUTSIDE OF THE RESTRICTED HOURS. A MINIMUM OF 1 LANE(S) OF TRAFFIC IN EACH DIRECTION SHALL BE MAINTAINED AT ALL TIMES BY USE OF THE EXISTING PAVEMENT, THE COMPLETED PAVEMENT, ITEM 615 PAVEMENT FOR MAINTAINING TRAFFIC. AND TEMPORARY SURFACES USING ITEMS 410 AND 614.

LANE VALUE CONTRACT TABLE					
DOAD SEGMENT	RESTRICTED	TIME	DISINCENTIVE AMOUNT		
ROAD SEGMENT	TIME PERIOD	UNIT	PER TIME UNIT		
SR 4	6AM - 10AM	1 MIN.	\$90		
3R 4	2PM - 7PM	Tivilia.	φθυ		
LIBERTY	6AM - 10AM	1 MIN.	\$120		
FAIRFIELD RD	2PM - 7PM	, ivilia.	Ψ120		

LENGTH AND DURATION OF LANE CLOSURES AND RESTRICTIONS SHALL BE AT THE APPROVAL OF THE ENGINEER. IT IS THE INTENT TO MINIMIZE THE IMPACT TO THE TRAVELING PUBLIC. LANE CLOSURES OR RESTRICTIONS OVER SEGMENTS OF THE PROJECT IN WHICH NO WORK IS ANTICIPATED WITHIN A REASONABLE TIME FRAME. AS DETERMINED BY THE ENGINEER. SHALL NOT BE PERMITTED. THE LEVEL OF UTILIZATION OF MAINTENANCE OF TRAFFIC DEVICES SHALL BE COMMENSURATE WITH THE WORK IN PROGRESS.

NOTICE OF CLOSURE SIGNS (W20-H13) SHALL BE ERECTED BY THE CONTRACTOR PRIOR TO THE SCHEDULED ROAD CLOSURE IN ACCORDANCE WITH THE NOTICE OF CLOSURE TIME TABLE BELOW. AT THE APPROVAL OF THE ENGINEER. PORTABLE CHANGEABLE MESSAGE SIGNS MAY BE USED IN LIEU OF THE STANDARD FLATSHEET SIGN FOR CLOSURE DURATIONS OF LESS THAN 1 WEEK.

THE SIGNS SHALL BE ERECTED ON THE RIGHT-HAND SIDE OF THE ROAD FACING TRAFFIC. THEY SHALL BE PLACED SO AS NOT TO INTERFERE WITH THE VISIBILITY OF ANY OTHER TRAFFIC CONTROL SIGNS. ON ROADWAYS, THEY SHOULD BE ERECTED AT OR NEAR THE POINT OF CLOSURE.

NOTIFICATION TIME TABLE				
ITEM	DURATION OF CLOSURE	NOTICE DUE TO DISTRICT		
	>= 2 WEEKS	14 CALENDAR DAYS PRIOR TO CLOSURE		
RAMP & ROAD CLOSURES	> 12 HOURS & < 2 WEEKS	7 CALENDAR DAYS PRIOR TO CLOSURE		
	< 12 HOURS	2 BUSINESS DAYS PRIOR TO CLOSURE		

THE SIGN SHALL DISPLAY THE DATE OF THE CLOSURE IN MMM-DD FORMAT AND THE NUMBER OF DAYS OF THE CLOSURE. THE LAST LINE OF THE W20-H13 SIGN LISTS A PHONE NUMBER WHICH A MOTORIST MAY CALL FOR ADDITIONAL INFORMATION. THIS IS TO BE A SPECIFIC OFFICE WITHIN THE DISTRICT RATHER THAN THE GENERAL SWITCHBOARD NUMBER.

ALL WORK AND TRAFFIC CONTROL DEVICES SHALL BE IN ACCORDANCE WITH C&MS 614 AND OTHER APPLICABLE PORTIONS OF THE SPECIFICATIONS, AS WELL AS THE OHIO MANUAL OF UNIFORM TRAFFIC CONTROL DEVICES. PAYMENT FOR ALL LABOR, EQUIPMENT AND MATERIALS SHALL BE INCLUDED IN THE LUMP SUM CONTRACT PRICE FOR ITEM 614. MAINTAINING TRAFFIC. UNLESS SEPARATELY ITEMIZED IN THE PLAN.

# SEQUENCE OF CONSTRUCTION

PHASE 1: MILL AND FILL LIBERTY FAIRFIELD RD.

PHASE 2: SHIFT SIGNAL HEADS AT THE INTERSECTION OF LIBERTY FAIRFIELD RD WITH SR 4. AND PLACE PAVEMENT MARKINGS THROUGHOUT PROJECT.

### ITEM 614 - LAW ENFORCEMENT OFFICER (WITH PATROL CAR) FOR ASSISTANCE DURING CONSTRUCTION OPERATIONS

USE OF LAW ENFORCEMENT OFFICERS (LEOS) BY CONTRACTORS OTHER THAN THE USES SPECIFIED BELOW WILL NOT BE PERMITTED AT PROJECT COST. LEOS SHOULD NOT BE USED WHERE THE OMUTCD INTENDS THAT FLAGGERS BE USED.

IN ADDITION TO THE REQUIREMENTS OF C&MS 614 AND THE OMUTCD. A UNIFORMED LEO WITH AN OFFICIAL PATROL CAR (CAR WITH TOP-MOUNTED EMERGENCY FLASHING LIGHTS AND COMPLETE MARKINGS OF THE APPROPRIATE LAW ENFORCEMENT AGENCY) SHALL BE PROVIDED FOR THE FOLLOWING TRAFFIC CONTROL TASKS:

DURING THE ENTIRE ADVANCE PREPARATION AND CLOSURE SEQUENCE WHERE COMPLETE BLOCKAGE OF TRAFFIC IS REQUIRED.

DURING A TRAFFIC SIGNAL INSTALLATION WHEN IMPACTING THE NORMAL FUNCTION OF THE SIGNAL OR THE FLOW OF TRAFFIC, OR WHEN TRAFFIC NEEDS TO BE DIRECTED THROUGH AN ENERGIZED TRAFFIC SIGNAL CONTRARY TO THE SIGNAL DISPLAY (E.G., DIRECTING MOTORISTS THROUGH A RED LIGHT).

IN ADDITION TO THE REQUIREMENT OF C&MS 614 AND THE OMUTCD. A UNIFORMED LEO WITH AN OFFICIAL PATROL CAR (CAR WITH TOP-MOUNTED EMERGENCY FLASHING LIGHTS AND COMPLETE MARKINGS OF THE APPROPRIATE LAW ENFORCEMENT AGENCY) SHOULD BE PROVIDED FOR THE FOLLOWING TRAFFIC CONTROL TASKS AS APPROVED BY THE ENGINEER:

FOR LANE CLOSURES: DURING INITIAL SET-UP PERIODS, TEAR DOWN PERIODS, SUBSTANTIAL SHIFTS OF A CLOSURE POINT OR WHEN A NEW LANE CLOSURE ARRANGEMENTS ARE INITIATED FOR LONG-TERM LANE CLOSURES/SHIFTS (FOR THE FIRST AND LAST DAY OF MAJOR CHANGES IN TRAFFIC CONTROL SETUP).

IN GENERAL, LEOS SHOULD BE POSITIONED IN ADVANCE OF AND ON THE SAME SIDE AS THE LANE RESTRICTION OR AT THE POINT OF ROAD CLOSURE, AND TO MANUALLY CONTROL TRAFFIC MOVEMENTS THROUGH SIGNALIZED INTERSECTIONS IN WORK ZONES.

LEOS SHOULD NOT FORGO THEIR TRAFFIC CONTROL RESPONSIBILITIES TO APPREHEND MOTORISTS FOR ROUTINE TRAFFIC VIOLATIONS. HOWEVER, IF A MOTORIST'S ACTIONS ARE CONSIDERED TO BE RECKLESS. THEN PURSUIT OF THE MOTORIST IS APPROPRIATE.

THE LEOS WORK AT THE DIRECTION OF THE CONTRACTOR. THE CONTRACTOR IS RESPONSIBLE FOR SECURING THE SERVICES OF THE LEOS WITH THE APPROPRIATE AGENCIES AND COMMUNICATING THE INTENTIONS OF THE PLANS WITH RESPECT TO DUTIES OF THE LEOS. THE ENGINEER SHALL HAVE FINAL CONTROL OVER THE LEOS' DUTIES AND PLACEMENT. AND WILL RESOLVE ANY ISSUES THAT MAY ARISE BETWEEN THE TWO PARTIES.

ENSURE PROVIDED LEOS HAVE BEEN TRAINED APPROPRIATE TO THE JOB DECISIONS THEY ARE REQUIRED TO MAKE WHILE ON THE PROJECT, IN ACCORDANCE WITH C&MS 614.03.

USE OF LAW ENFORCEMENT OFFICERS (LEOS) BY THE LEO SHALL REPORT IN TO THE CONTRACTOR PRIOR TO THE START OF THE SHIFT. IN ORDER TO RECEIVE INSTRUCTIONS REGARDING THE SPECIFIC WORK ASSIGNMENTS DURING HIS/HER SHIFT. THE LEO IS EXPECTED TO STAY AT THE PROJECT SITE FOR THE ENTIRE DURATION OF HIS/HER SHIFT. THE LEO SHALL REPORT TO THE CONTRACTOR AT THE END OF HIS/HER SHIFT. SHOULD IT BE NECESSARY TO LEAVE THE PROJECT SITE, THE LEO SHALL NOTIFY THE ENGINEER. THE CONTRACTOR SHALL PROVIDE THE LEO WITH A TWO-WAY COMMUNICATION DEVICE WHICH SHALL BE RETURNED TO THE CONTRACTOR AT THE END OF HIS/HER SHIFT.

LEOS (WITH PATROL CAR) REQUIRED BY THE TRAFFIC MAINTENANCE TASKS ABOVE SHALL BE PAID FOR ON A UNIT PRICE (HOURLY) BASIS UNDER ITEM 614, LAW ENFORCEMENT OFFICER (WITH PATROL CAR) FOR ASSISTANCE. THE FOLLOWING ESTIMATED QUANTITIES HAVE BEEN CARRIED TO THE GENERAL SUMMARY:

ITEM 614, LAW ENFORCEMENT OFFICER WITH PATROL CAR FOR ASSISTANCE 75 HOURS

THE HOURS PAID SHALL INCLUDE ANY MINIMUM SHOW-UP TIME REQUIRED BY THE LAW ENFORCEMENT AGENCY INVOLVED.

ANY ADDITIONAL COSTS (ADMINISTRATIVE OR OTHERWISE) INCURRED BY THE CONTRACTOR TO OBTAIN THE SERVICES OF A LEO ARE INCLUDED WITH THE BID UNIT PRICE FOR ITEM 614, LAW ENFORCEMENT OFFICER WITH PATROL CAR FOR ASSISTANCE.

#### NOTIFICATION OF TRAFFIC RESTRICTIONS

THROUGHOUT THE DURATION OF THE PROJECT. THE CONTRACTOR SHALL NOTIFY THE PROJECT ENGINEER IN WRITING OF ALL TRAFFIC RESTRICTIONS AND UPCOMING MAINTENANCE OF TRAFFIC CHANGES. THE CONTRACTOR SHALL ENSURE THE WRITTEN NOTIFICATION IS SUBMITTED IN A TIMELY MANNER TO ALLOW THE PROJECT ENGINEER TO MEET THE REQUIRED TIME FRAMES SET FORTH IN THE TABLE BELOW TO INFORM THE SPECIAL HAULING PERMITS SECTION (HAULING.PERMITS@DOT.OHIO.GOV) AND THE DISTRICT PUBLIC INFORMATION OFFICE (PIO). THIS NOTIFICATION SHALL BE RECEIVED BY THE PROJECT ENGINEÉR PRIOR TO THE PHYSICAL SETUP OF ANY APPLICABLE SIGNS OR MESSAGE BOARDS.

INFORMATION SHOULD INCLUDE. BUT IS NOT LIMITED TO. ALL CONSTRUCTION ACTIVITIES THAT IMPACT OR INTERFERE WITH TRAFFIC AND SHALL LIST THE SPECIFIC LOCATION, TYPE OF WORK, ROAD STATUS, DATE AND TIME OF RESTRICTION, DURATION OF RESTRICTION. NUMBER OF LANES MAINTAINED. NUMBER OF LANES CLOSED, MINIMUM VERTICAL CLEARANCE, MINIMUM WIDTH OF DRIVABLE PAVEMENT, DETOUR ROUTES, IF APPLICABLE, AND ANY OTHER INFORMATION REQUESTED BY THE PROJECT ENGINEER.

NOTIFICATION TIME TABLE					
ITEM	DURATION OF CLOSURE	NOTICE DUE TO PERMITS & PIO			
	>= 2 WEEKS	21 CALENDAR DAYS PRIOR TO CLOSURE			
RAMP & ROAD CLOSURES	> 12 HOURS & < 2 WEEKS	14 CALENDAR DAYS PRIOR TO CLOSURE			
	< 12 HOURS	4 BUSINESS DAYS PRIOR TO CLOSURE			
LANE CLOSURES & RESTRICTIONS	>= 2 WEEKS	14 CALENDAR DAYS PRIOR TO CLOSURE			
	> 12 HOURS & < 2 WEEKS	5 BUSINESS DAYS PRIOR TO CLOSURE			
START OF CONSTRUCTION & TRAFFIC PATTER CHANGES	N/A	14 CALENDAR DAYS PRIOR TO CLOSURE			

ANY UNFORESEEN CONDITIONS NOT SPECIFIED IN THE PLANS REQUIRING TRAFFIC RESTRICTIONS SHALL ALSO BE REPORTED TO THE PROJECT ENGINEER USING THE NOTIFICATION TIME TABLE.

# **DETECTION MAINTENANCE**

IF VEHICLE DETECTION BECOMES UNEXPECTEDLY DISABLED. REQUIRES MODIFICATION, OR IS SCHEDULED TO BE TEMPORARILY REMOVED DURING THE CONSTRUCTION PROJECT. THE CONTRACTOR SHALL IMMEDIATELY NOTIFY THE PROJECT ENGINEER AND DISTRICT TRAFFIC ENGINEER.

IF THE LOSS OF VEHICLE DETECTION IS KNOWN PRIOR TO THE START OF CONSTRUCTION, IT SHALL BE DISCUSSED AT THE PRECONSTRUCTION MEETING. AT SUCH TIME. THE DISTRICT TRAFFIC ENGINEER SHALL ADVISE THE PROJECT ENGINEER AND CONTRACTOR ON THE APPROPRIATE ACTION TO RECTIFY ANY LOSS OF VEHICLE DETECTION. THIS MAY INCLUDE PLACING THE TRAFFIC SIGNAL ON MINIMUM OR MAXIMUM RECALL, MODIFYING THE MINIMUM GREEN TIMES, AND REMOVING THE MALFUNCTIONING DETECTION FROM SERVICE. WHERE NON-INTRUSIVEDETECTION (I.E. VIDEO, RADAR) ALREADY EXISTS, THE CONTRACTOR SHALL INSURE THAT DETECTION IS OPERATING AND MAINTAINED BY RECONFIGURING THE DETECTION UNITS ACCORDINGLY DURING ALL CONSTRUCTION PHASES. THIS IS TO AVOID THE SIGNAL FROM MAXING OUT THE EFFECTED SIGNAL PHASE AND CREATING UNNECESSARY DELAYS.

LOCATIONS WHERE NON-INTRUSIVE DETECTION IS PROPOSED AND THE EXISTING VEHICLE DETECTION IS TO BE ABANDONED, THE NON-INTRUSIVE VEHICLE DETECTION SHALL BE INSTALLED, CONFIGURED AND MADE FULLY FUNCTIONAL PRIOR TO THE EXISTING DETECTION BEING DISABLED. THE CONTRACTOR SHALL CONTINUE TO MAINTAIN AND MODIFY THE DETECTION UNTIL FINAL ACCEPTANCE OF THE TRAFFIC SIGNAL. THIS IS TO ENSURE VEHICLE DETECTION REMAINS FULLY FUNCTIONAL THROUGHOUT CONSTRUCTION.

### **WORK ZONE MARKINGS AND SIGNS**

THE FOLLOWING ESTIMATED QUANTITIES HAVE BEEN CARRIED TO THE GENERAL SUMMARY FOR USE AT LOCATIONS IDENTIFIED BY THE ENGINEER FOR WORK ZONE PAVEMENT MARKINGS AND SIGNS PER THE REQUIREMENTS OF C&MS 614.04 AND 614.11.

	ITEM 614 - WORK ZONE EDGE LINE,	0.26 MILES
	CLASS I, 4", 642 PAINT  ITEM 614 - WORK ZONE LANE LINE,  CLASS I, 4", 642 PAINT	0.28 MILES
,	ITEM 614 - WORK ZONE CENTER LINE, CLASS I, 642 PAINT	0.20 MILES
(	ITEM 614 - WORK ZONE CHANNELIZING LINE, CLASS I, 8", 642 PAINT	1,006 FT
( (	ITEM 614 - WORK ZONE STOP LINE, CLASS I, 642 PAINT	80 FT
(	> ITEM 614 - WORK ZONE CROSSWALK LINE, > CLASS I, 642 PAINT	560 FT
(	ITEM 614 - WORK ZONE EDGE LINE, CLASS III, 4", 642 PAINT	0.26 MILES
(	> ITEM 614 - WORK ZONE LANE LINE, CLASS III, 4", 642 PAINT	0.28 MILES
(	> ITEM 614 - WORK ZONE CENTER LINE, > CLASS III, 642 PAINT	0.20 MILES
(	ITEM 614 - WORK ZONE CHANNELIZING LINE, CLASS III, 8", 642 PAINT	1,006 FT
(	TIEM 614 - WORK ZONE STOP LINE, CLASS III, 642 PAINT	80 FT
(	ITEM 614 - WORK ZONE CROSSWALK LINE,	560 FT

CLASS III. 642 PAINT

^^^^^

**ESIGN AGENCY ESIGNER** 

ACF REVIEWER CSR 6/22/20

110424

ROJECT ID

15