
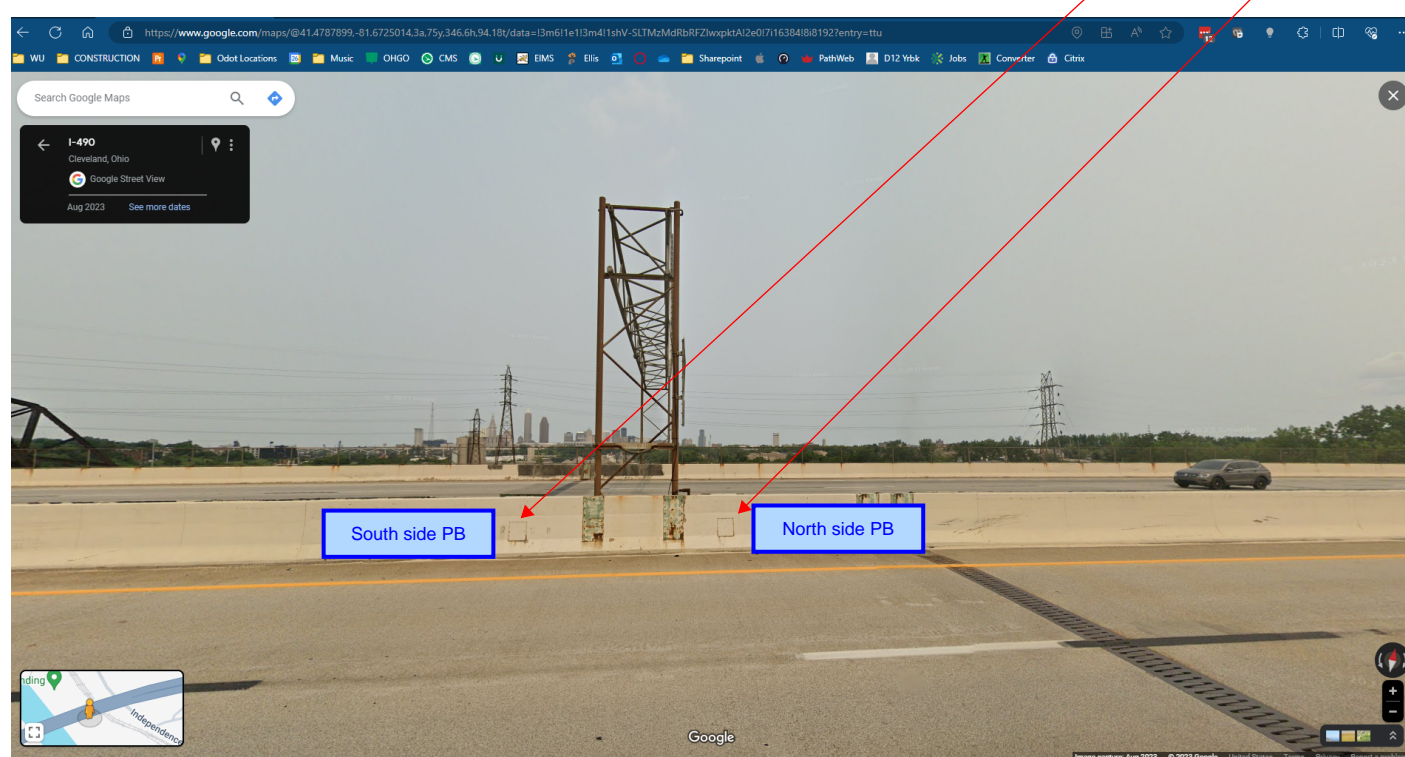


Existing

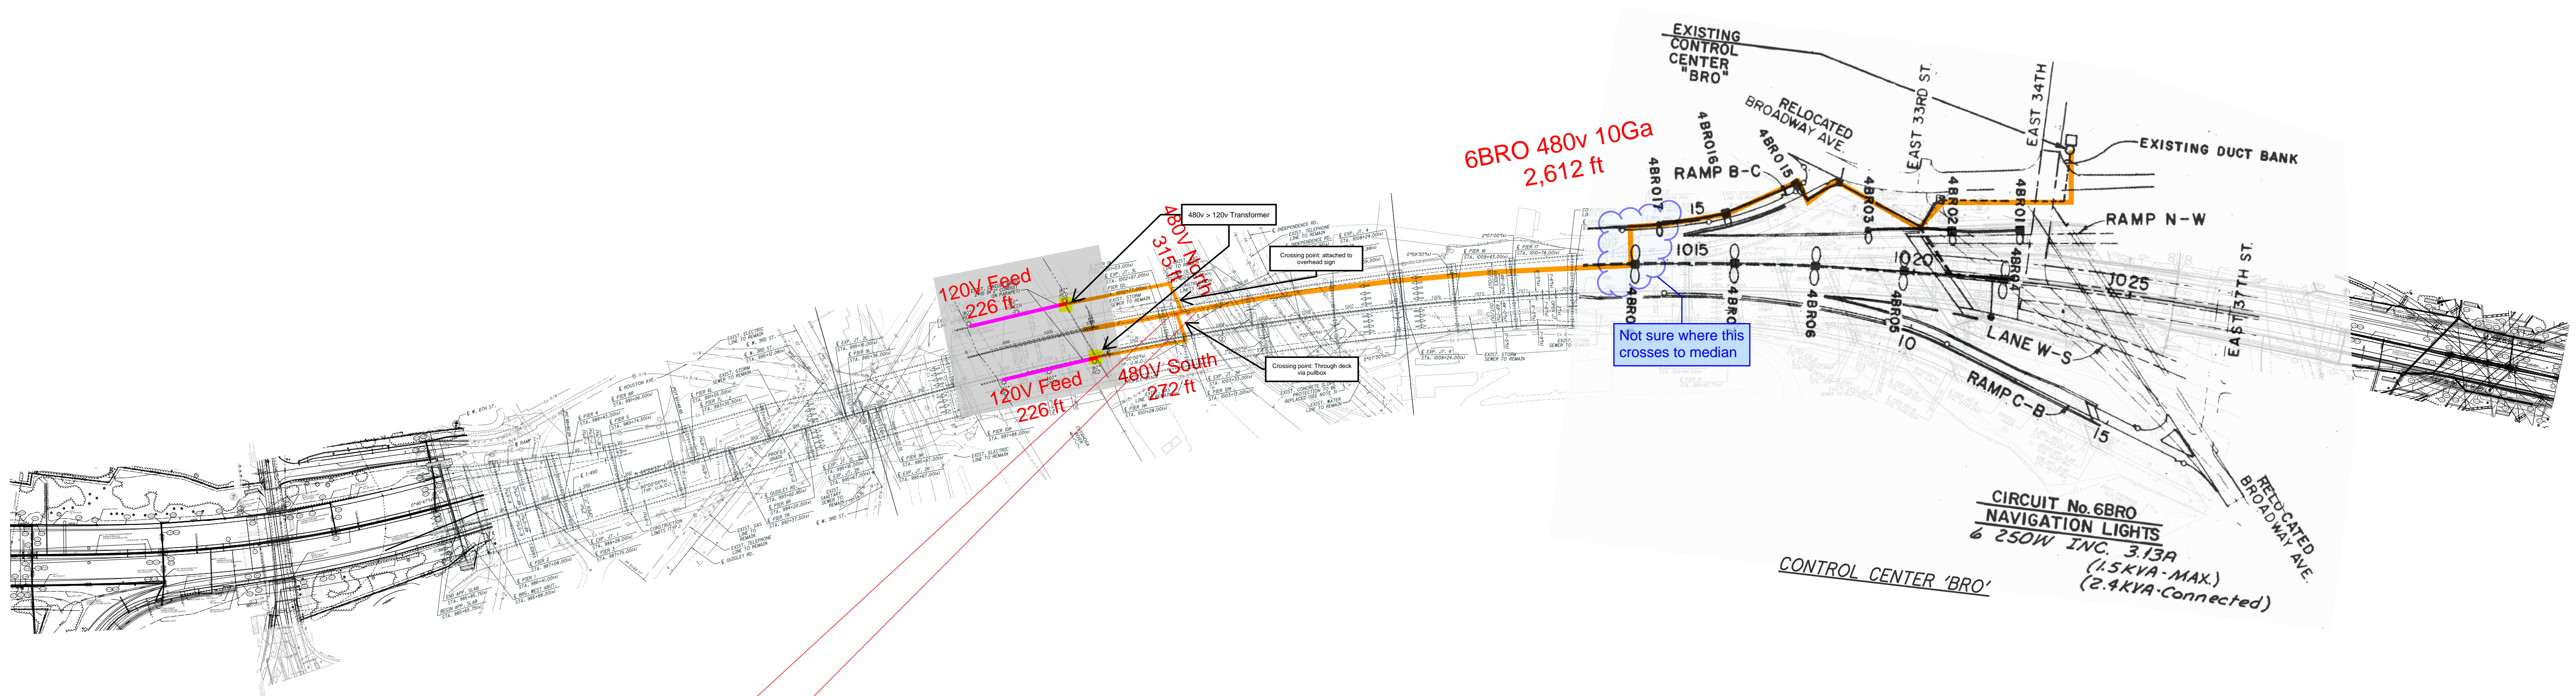

Existing Wire Details

Description	Quantity	Unit
6BRO 480v 10Ga	2,612	ft
120V 10 Ga Feed (N)	226	ft
120V 10 Ga Feed (S)	226	ft
480v > 120v Trans	2	Count
480V 10Ga North	315	ft
480V 10Ga South	272	ft