

OUPS DESIGN TICKET B301800205 CWDP


1 message

OCCLS Support <support@occls.com>Fri, Jan 27, 2023 at 10:40 AM

To: fred_roberts@clevelandwater.com, Rasheed_Warith@clevelandwater.com, FSNYDER@fokeng.com, lbrooks@occls.com

Prints for the above referenced design tickets are attached. Please contact lbrooks@occls.com if you have any questions.


9 attachments

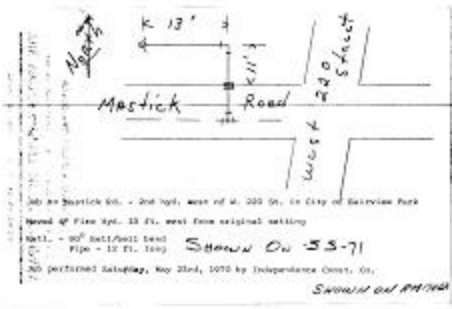

007 (1).tif
247K



01825b.tif
77K

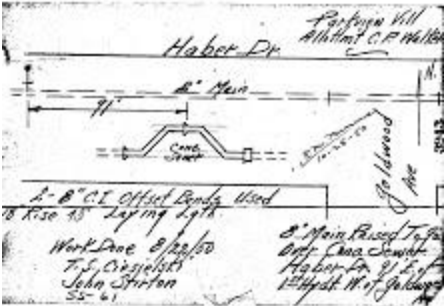

005 (3).tif
235K



01825a.tif
281K



01966a.tif
199K

01966.tif
234K



Screenshot 2023-01-27 103632B301800205 cwdp.png
620K



Water GIS Legend - Copy (004).jpg
53K

 **B301800205.pdf**
653K