




ODOT DISTRICT 12 VERTICAL CLEARANCE SURVEY FORM

PROJECT NUMBER: 115826
STRUCTURE FILE NUMBER: 1814168
BRIDGE NUMBER (C-R-S): CUY-480-06.12
FEATURED INTERSECTION: W.220th & IR-480
MEASURED BY: F.Snyder, Jr., PS
DATE MEASURED: 03/01/2023


NOTES

- 1. OHIO PROFESSIONAL SURVEYOR SHALL USE THIS FORM TO DOCUMENT ALL VERTICAL CLEARANCE MEASUREMENTS. ADDITIONAL MEASUREMENTS MAY BE NECESSARY TO CAPTURE ACTUAL MINIMUM VERTICAL CLEARANCE.
- 2. THE COMPLETED FORM SHALL BEAR THE STAMP OR SEAL OF THE OHIO PROFESSIONAL SURVEYOR WHO HAS TAKEN THE MEASUREMENTS.
- 3. FOR UN-DIVIDED ROADWAYS, USE ONE-HALF OF THE APPLICABLE DRAWING.

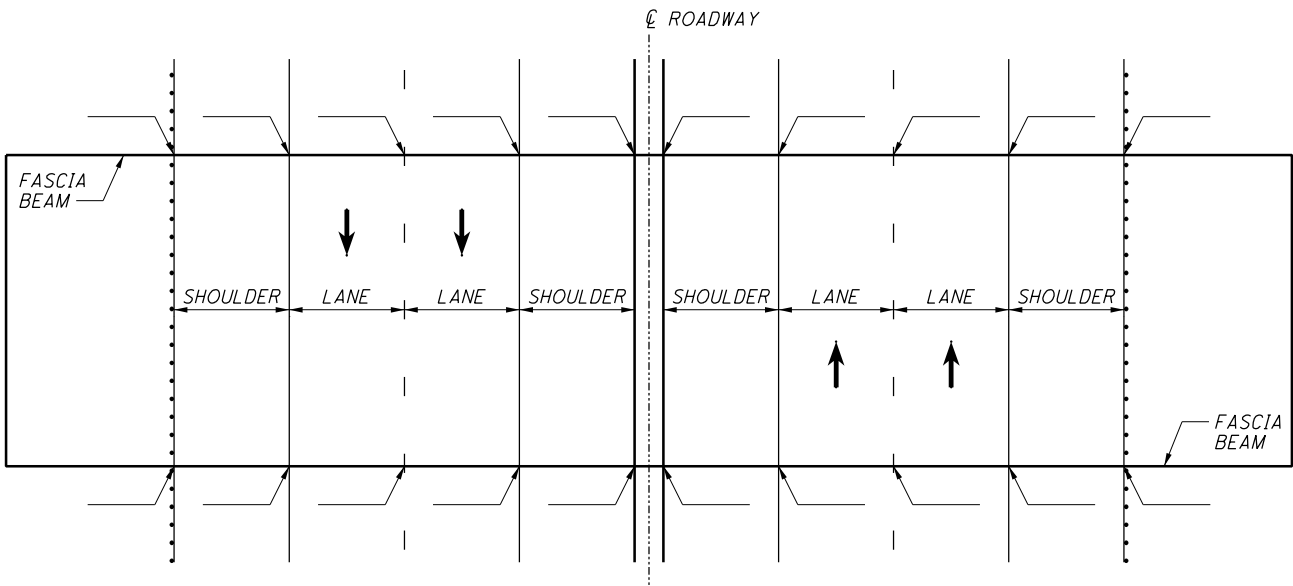

PLAN - TWO LANE DIVIDED ROADWAY

INSERT
NORTH
ARROW

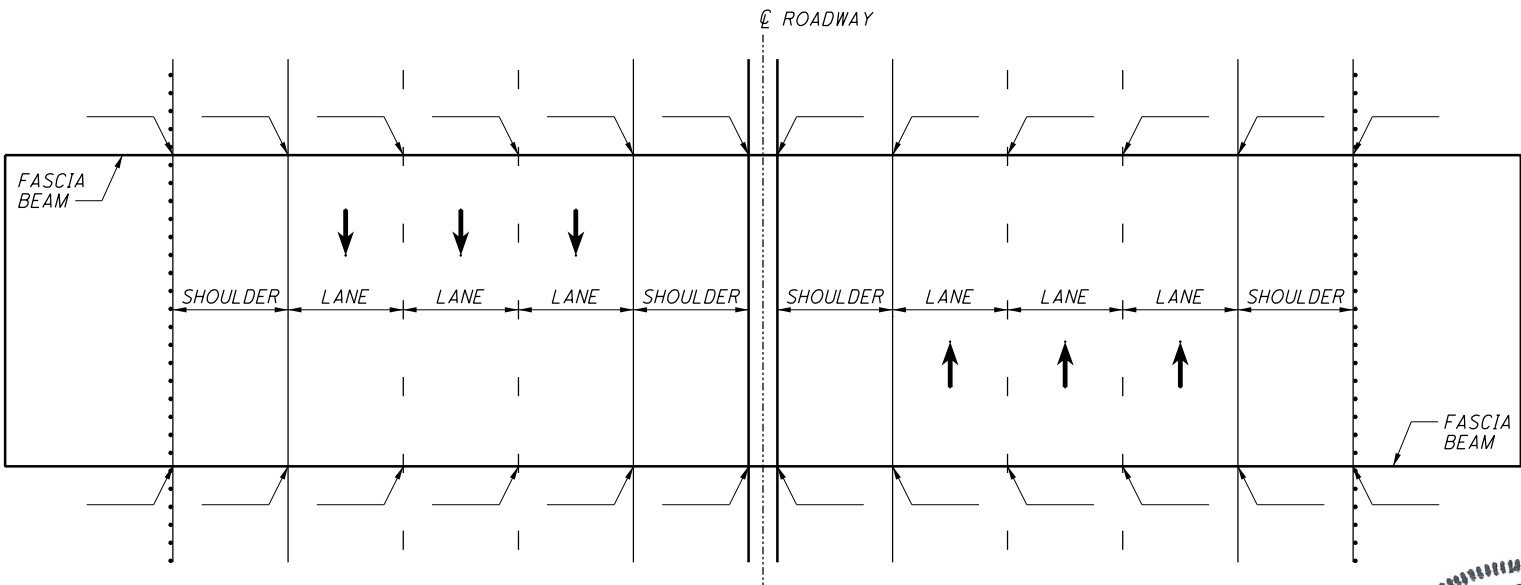


PLAN - THREE LANE DIVIDED ROADWAY

INSERT
NORTH
ARROW



03/01/2023

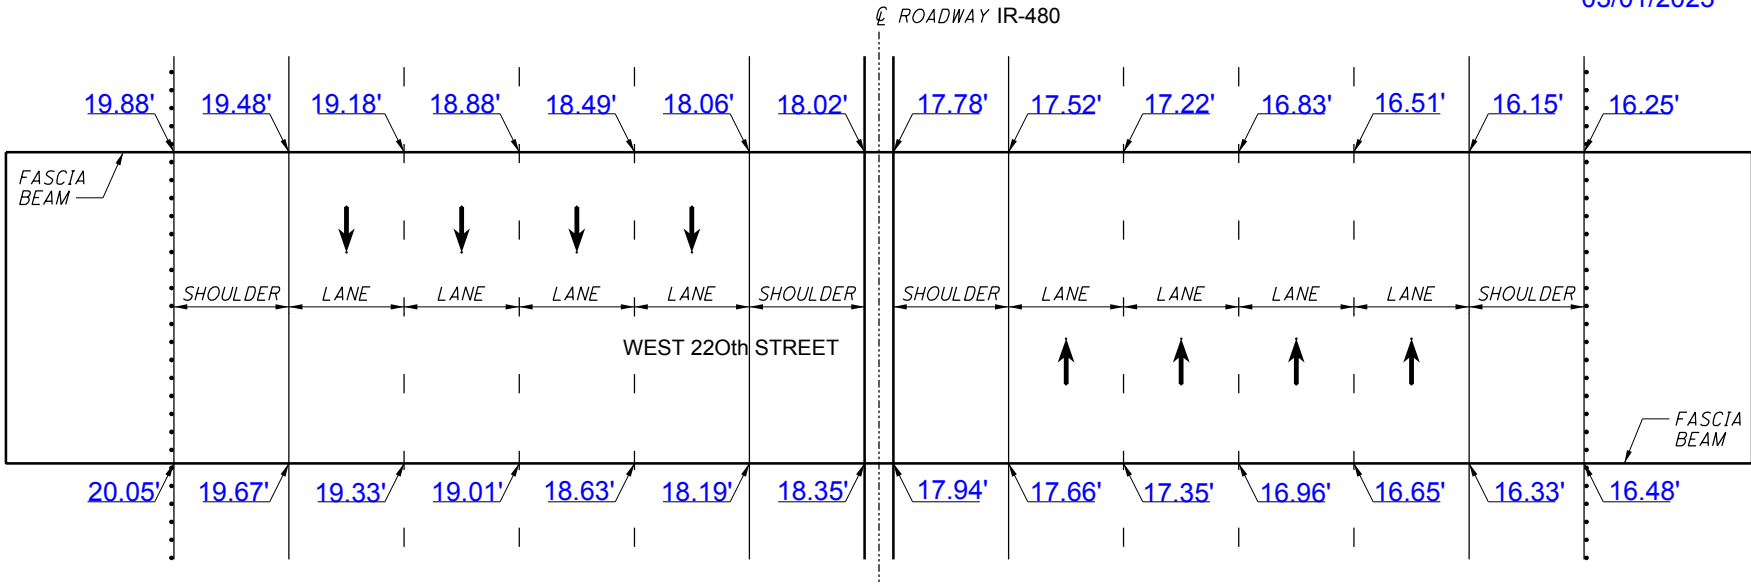

PLAN - FOUR LANE DIVIDED ROADWAY

