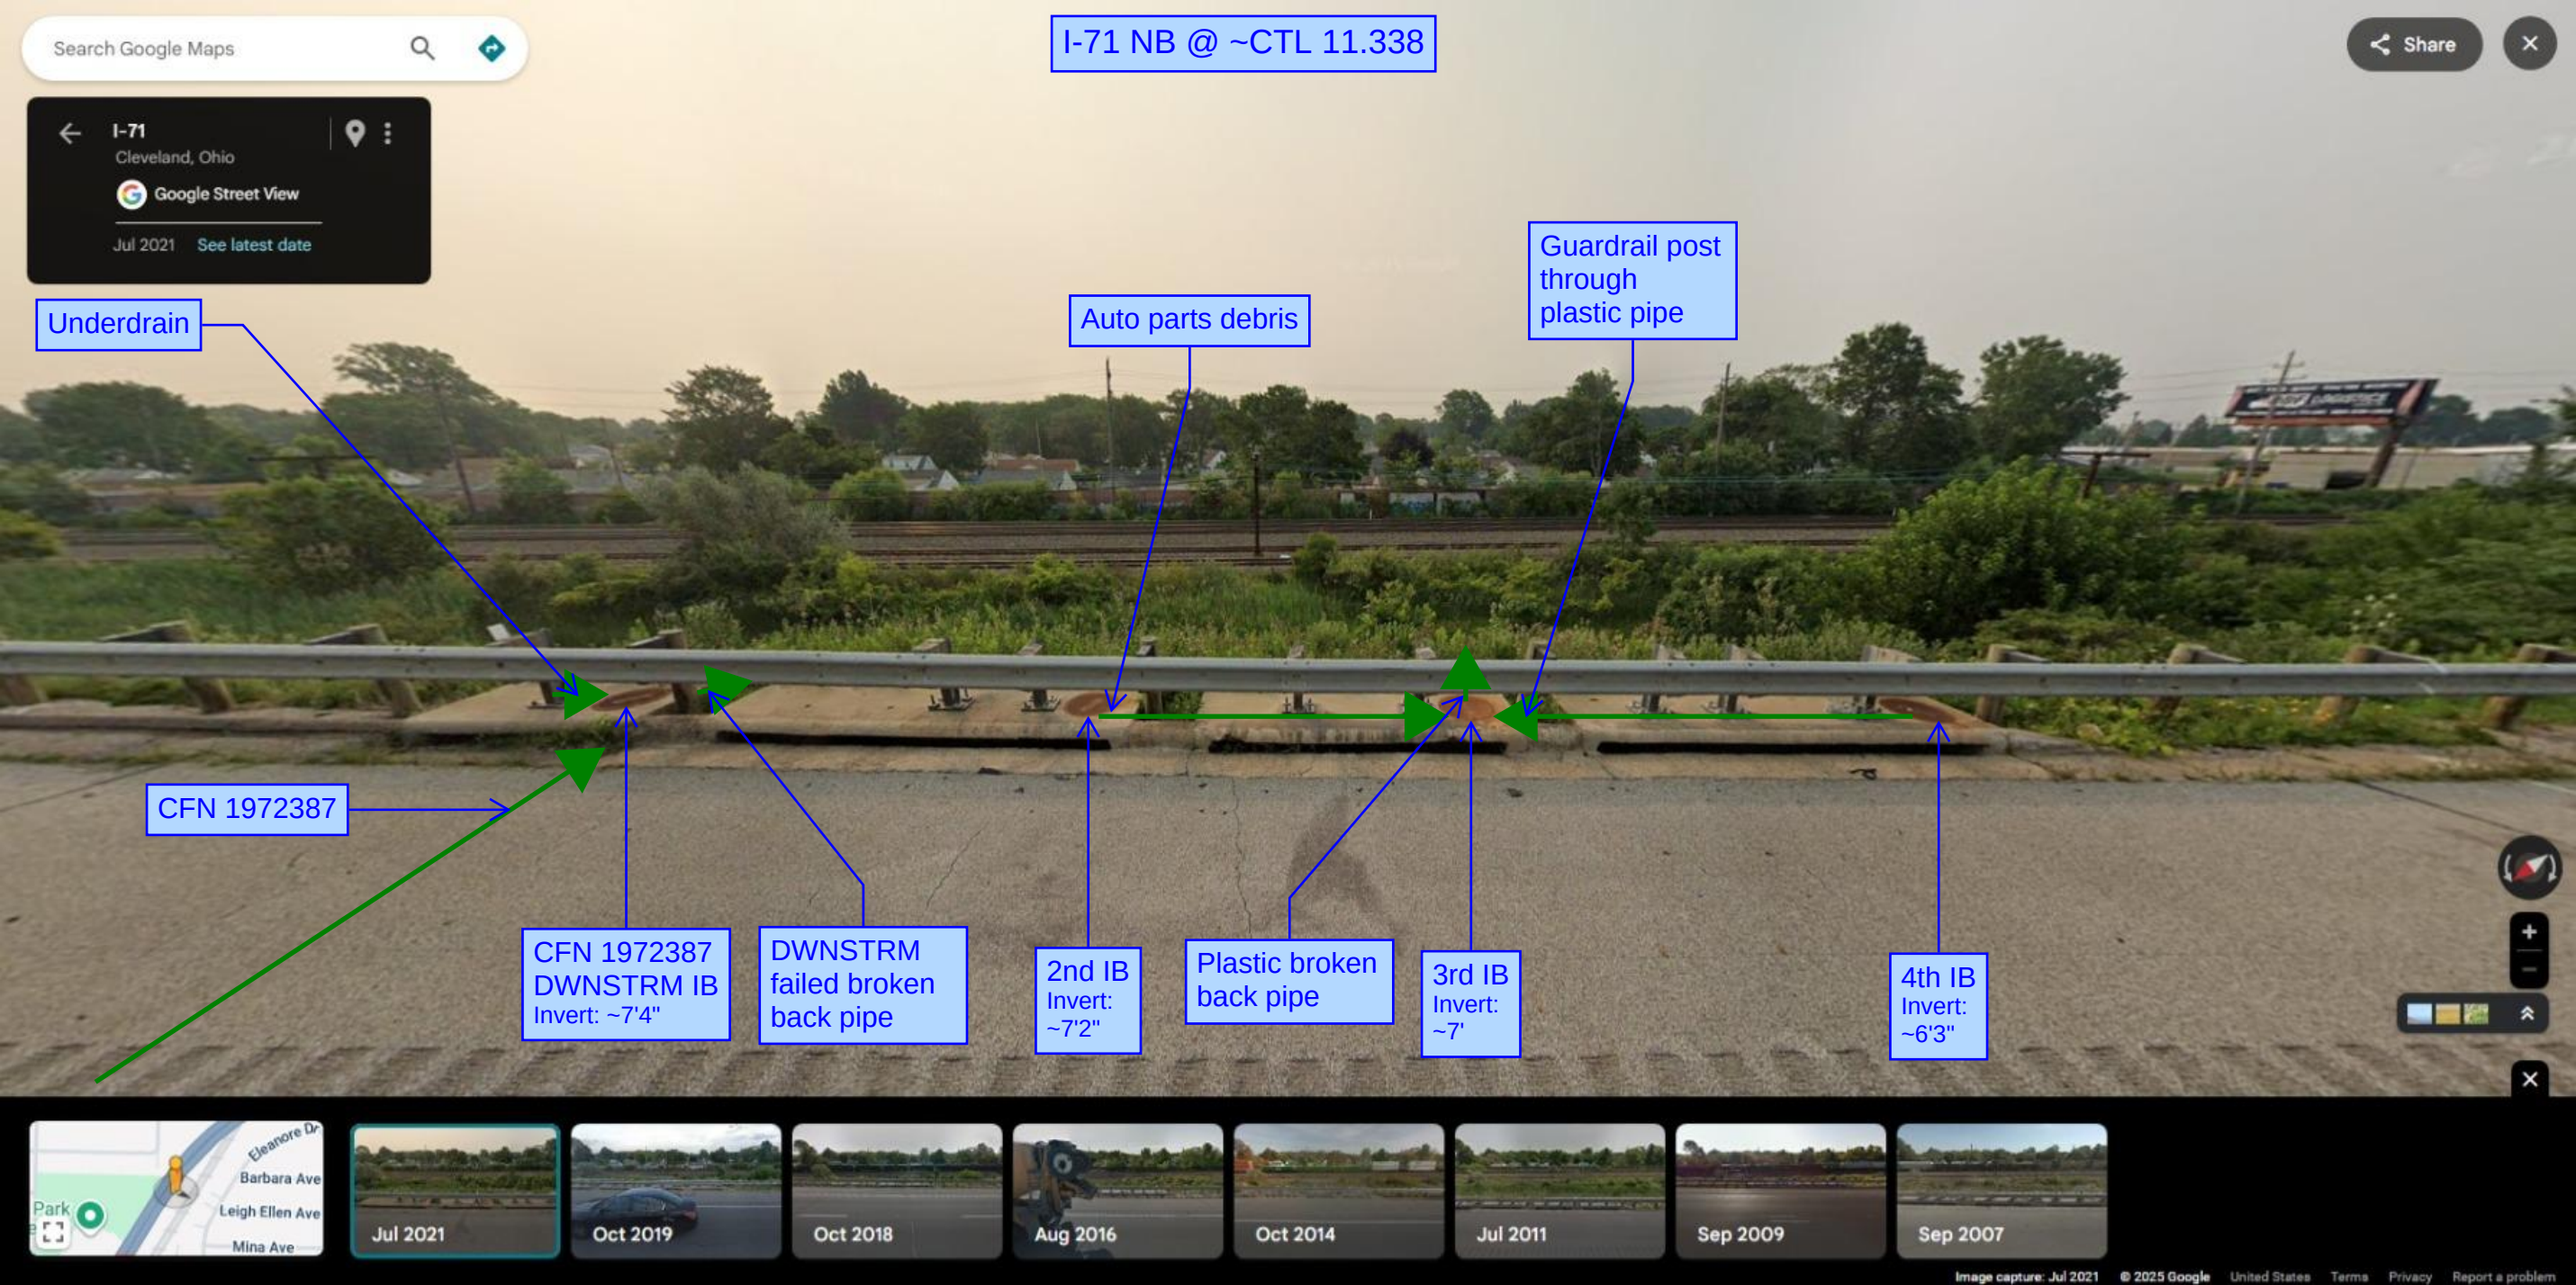
Search Google Maps
I-71
Cleveland, Ohio
Google Street View
Jul 2021
See latest date
I-71 NB @ ~CTL 11.338
Share
Underdrain
Auto parts debris
Guardrail post through plastic pipe
CFN 1972387
CFN 1972387 DWNSTRM IB Invert: ~7'4"
DWNSTRM failed broken back pipe
2nd IB Invert: ~7'2"
Plastic broken back pipe
3rd IB Invert: ~7'
4th IB Invert: ~6'3"
Eleanore Dr
Barbara Ave
Leigh Ellen Ave
Mina Ave
Park
Jul 2021
Oct 2019
Oct 2018
Aug 2016
Oct 2014
Jul 2011
Sep 2009
Sep 2007
Image capture: Jul 2021
© 2025 Google
United States
Terms
Privacy
Report a problem