

IMPROVEMENT IS ESPECIALLY DESIGNED THROUGH TRAFFIC AND HAS BEEN DECLARED LIMITED ACCESS HIGHWAY OR FREEWAY BY THE DIRECTOR OF HIGHWAYS IN ACCORDANCE WITH THE PROVISIONS OF SECTION 5511.02 REVISED CODE OF OHIO.

STATE OF OHIO
DEPARTMENT OF HIGHWAYS

ACI-1088 (3)

MONTGOMERY COUNTY
CITY OF DAYTON
DAYTON EXPRESSWAY SYSTEM
EXPRESSWAY-PART 3
MOT-25-15.88

DAYTON EXPRESSWAY SYSTEM

Yellow

NOTE: Federal Project No. D-1088(3) appearing throughout these plans shall be considered to read ACI-1088(3).

MOT.-25-15.88
MONTGOMERY COUNTY
CITY OF DAYTON
HARRISON TOWNSHIP

LIMITED ACCESS

PART 3 - KEOWEE STREET TO NEFF ROAD

THE STANDARD SPECIFICATIONS OF THE STATE OF OHIO DEPARTMENT OF HIGHWAYS, INCLUDING CHANGES AND SUPPLEMENTAL SPECIFICATIONS LISTED IN THE PROPOSAL SHALL GOVERN THIS IMPROVEMENT.

I HEREBY APPROVE THESE PLANS AND DECLARE THAT THE MAKING OF THIS IMPROVEMENT WILL NOT REQUIRE THE CLOSING TO TRAFFIC OF THE HIGHWAY AND THAT PROVISIONS FOR THE MAINTENANCE AND SAFETY OF TRAFFIC WILL BE AS SET FORTH IN THE PLANS AND ESTIMATE.

THE RIGHT OF WAY FOR THIS IMPROVEMENT WILL BE PROVIDED BY THE STATE OF OHIO.

APPROVED DATE 12-18-57
APPROVED DATE 12-18-57
APPROVED DATE 12-18-57
APPROVED DATE 12-14-57
APPROVED DATE 12-14-57
APPROVED DATE 1-3-58
APPROVED DATE 12-30-57
APPROVED DATE 1-2-58
APPROVED DATE 1-2-58
APPROVED DATE 1-2-58
APPROVED DATE 1-2-58
APPROVED DATE 1-2-58

Max L. Mitchell
CHIEF ENGINEER MIAMI CONSERVANCY DISTRICT

W. H. Smith
DIRECTOR OF SERVICE AND BUILDINGS, CITY OF DAYTON

W. H. Smith
CITY MANAGER, CITY OF DAYTON

E. D. Ackerman
DIVISION DEPUTY DIRECTOR

E. H. Mahoney
DEPUTY DIRECTOR OF PLANNING AND PROGRAMMING

R. E. Shultz
ENGINEER OF BRIDGES

R. E. Shultz
ENGINEER OF LOCATION AND DESIGN

R. E. Shultz
DEPUTY DIRECTOR OF DESIGN AND CONSTRUCTION

R. E. Shultz
FIRST ASSISTANT DIRECTOR

W. H. Smith
ACTING DIRECTOR OF HIGHWAYS

INDEX OF SHEETS


SHEET	37-39	DRAINAGE DETAILS
PLAN	40-69	CROSS SECTIONS
REFERENCE PTS.	70-76	RIGHT OF WAY
NOTES	77-78	PUMPING STATION NOTES
QUANTITIES	79-83	ONE AVENUE PUMPING STATION
INITIALS	84-101	STANLEY AVENUE PUMPING STATION
GENERAL NOTES & ESTIMATED QUANTITIES (STRUCTURES)	102-103	
COMMON DETAILS	104-105	
EXPRESSWAY OVER LEO STREET	106-112	
EXPRESSWAY OVER STANLEY AVENUE	113-123	
PEDESTRAIN UNDERPASS AT STA. 463+06	124-125	
EXPRESSWAY OVER NEVA DRIVE	126-134	
EXPRESSWAY OVER WAGNER FORD ROAD	135-144	

Shts 114-113 revised 6-3-58
Sheet 81 revised 2-30-58
Sheets 103, 112 & 114 revised 1-16-58

LINE DATA

RESUME PROJECT	STA. 413+56.00	
SUSPEND PROJECT	STA. 455+67.00	4211.00 LIN. FT.
RESUME PROJECT	STA. 461+42.00	4403.83 LIN. FT.
END PROJECT	STA. 505+43.33	
TOTAL LENGTH OF PROJECT		8614.83 LIN. FT. = 1.631 MILES
AVENUE	STA. 0+00 TO STA. 15+40 = 1494.91 LIN. FT.	
	STA. 410+10 TO STA. 413+56 = 346.00 LIN. FT.	
	STA. 455+67 TO STA. 456+95 = 128.00 LIN. FT.	
	STA. 460+52 TO STA. 461+42 = 90.00 LIN. FT.	
	STA. 505+43.33 TO STA. 505+84 = 40.51 LIN. FT.	
	STA. 0+56 TO STA. 8+64 = 826.00 LIN. FT.	

WORK = 11,537.91 LIN. FT. = 2.185 MILES.

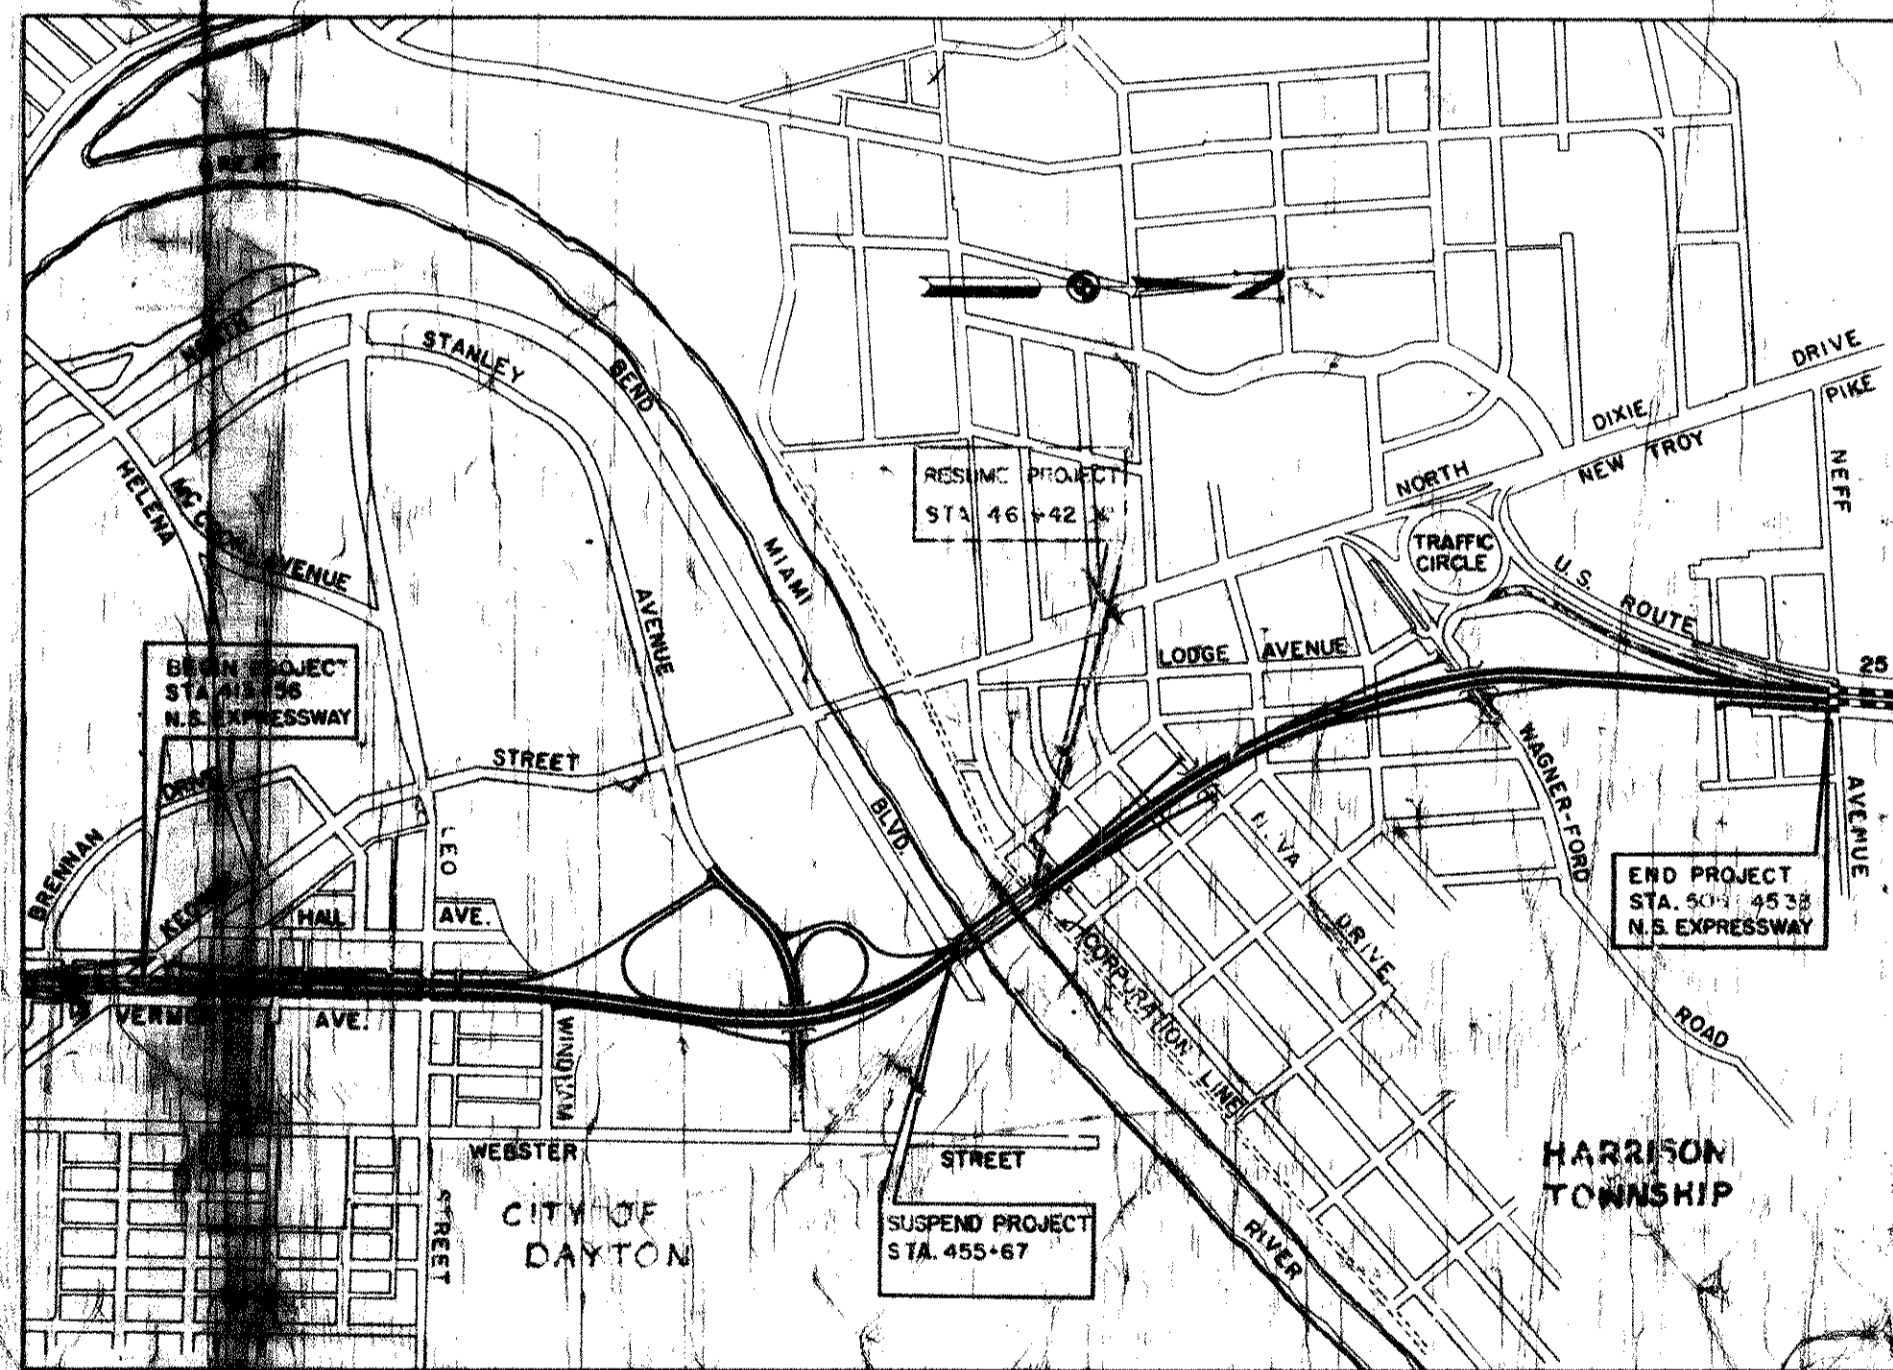

LOCATION PLAN


DELIVERY POINT: 8 & T WEBSTER AVE. 27 MILES AVERAGE HAUL

RECOMMENDED BY
TAMMEN & BERGENDOFF
ENGINEERS
MELAND NEW YORK

H. G. SOURS
ASSOCIATE
COLUMBUS

SUPPLEMENTAL SPECIFICATIONS

NUMBER	DATE	BY
5	6-1-55	
18	REV	
E-101	1-1-55	
S-114	REV	

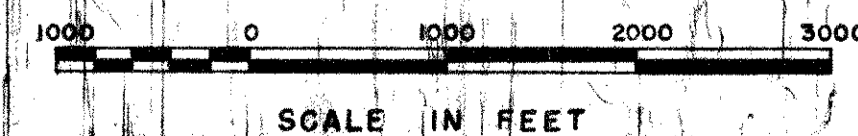

PORTION TO BE IMPROVED
OTHER HIGHWAYS AND STREETS
FUTURE WORK

STANDARD DRAWINGS

NUMBER	DATE	NUMBER	DATE
S-27	4-1-54	I-8 C.B. 2-5	2-6 5-11-52
		I-8 C.B. 3-1	2-4 5-11-52
I-21-23	8-1-56		
L-3-A	4-1-50	I-8 I.N.O. 2	12-1-54
L-3	4-1-50	I-8 M.H. NO. 1	5-1-52
R-1	1-3-55	I-8 M.H. NO. 1-A	1-3-55
T-35	1-2-56	I-8 M.H. NO. 2	5-1-52
L.J. NO. 1	7-1-55	I-12	7-1-54
T.J.	5-1-56		4-1-57
AS-1-54	12-1-54	I-15 NO. 1	8-1-55
OS-1	12-17-56	I-15 NO. 2	6-1-57
I-1, 2, 3, 4, 5	2-20-45		
I-6, 7, 8, 2-AB	8-1-54	6-7-07	6-1-56




Revised R/W Plan, Sheet No. 75 by adding three non-limited access parcels J.R.B. 5-14-58

DEPARTMENT OF COMMERCE
BUREAU OF PUBLIC ROADS

APPROVED:




ENGINEER

MONTGOMERY COUNTY
CITY OF DAYTON
DAYTON EXPRESSWAY SYSTEM
MOT-25-15.88

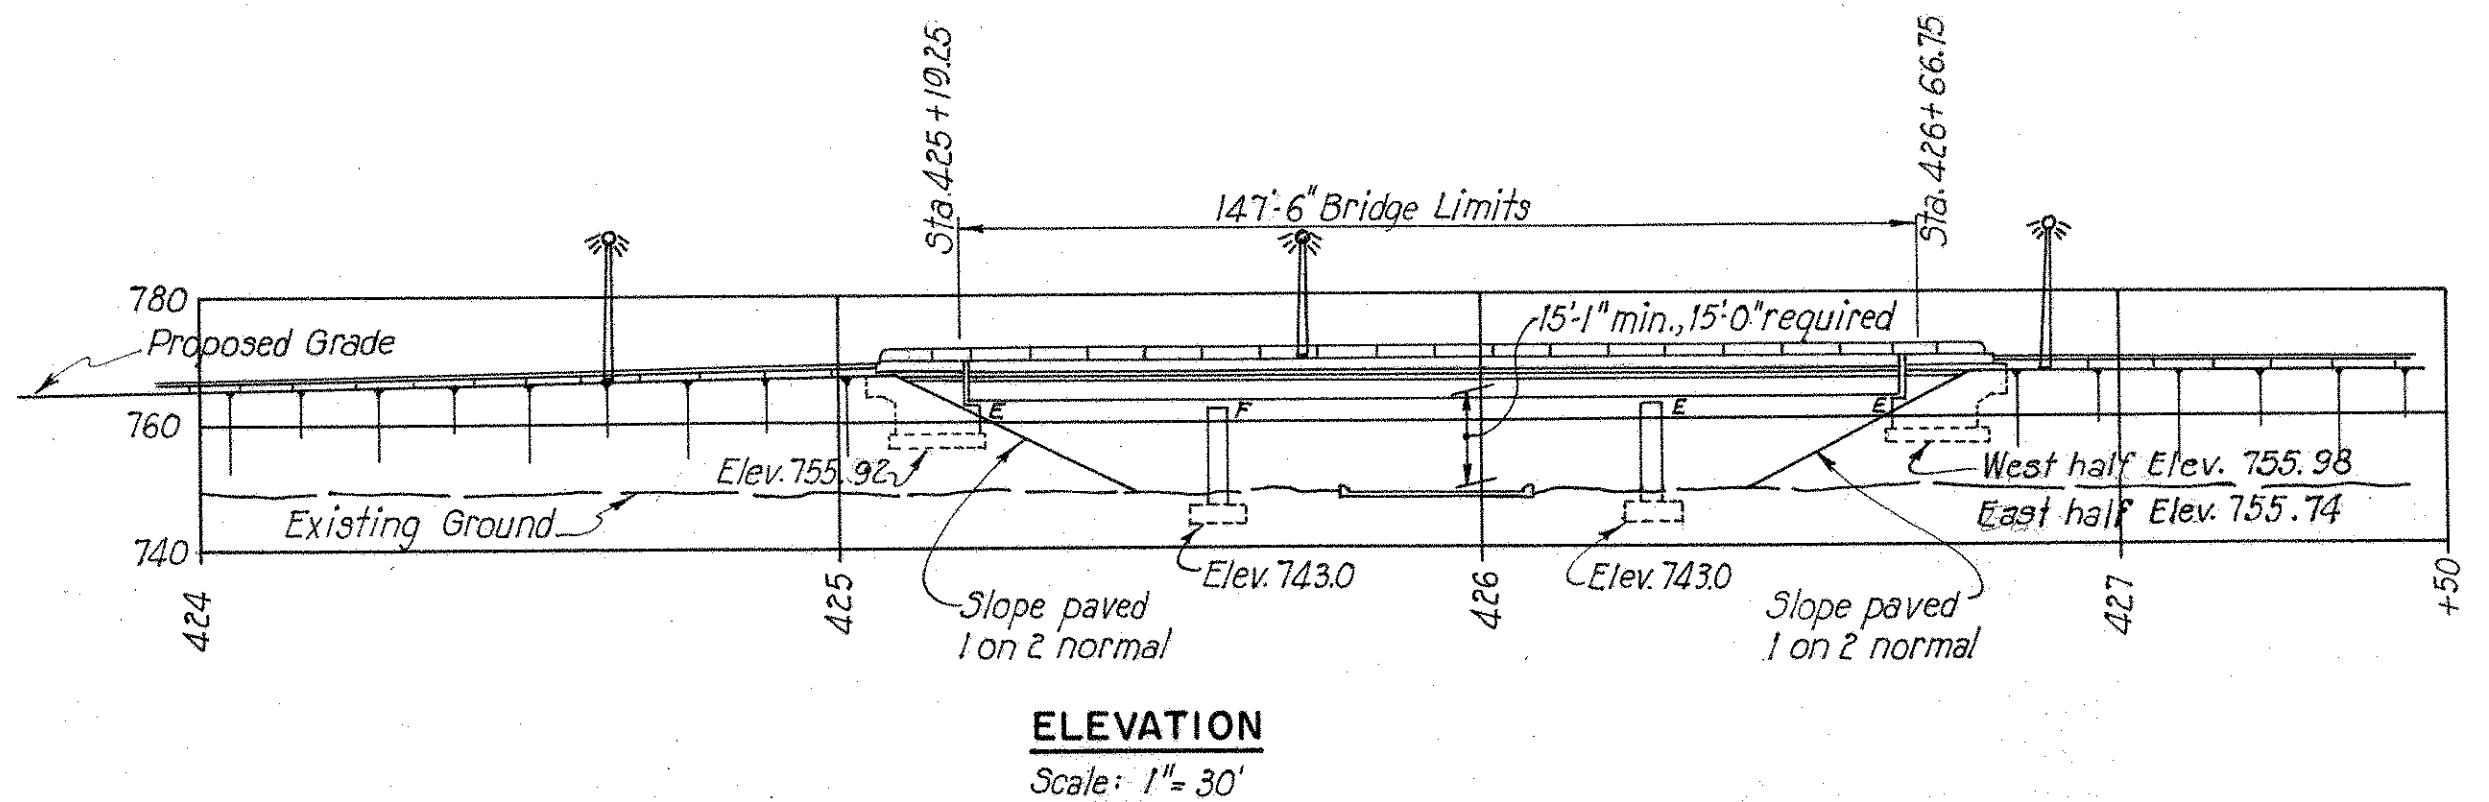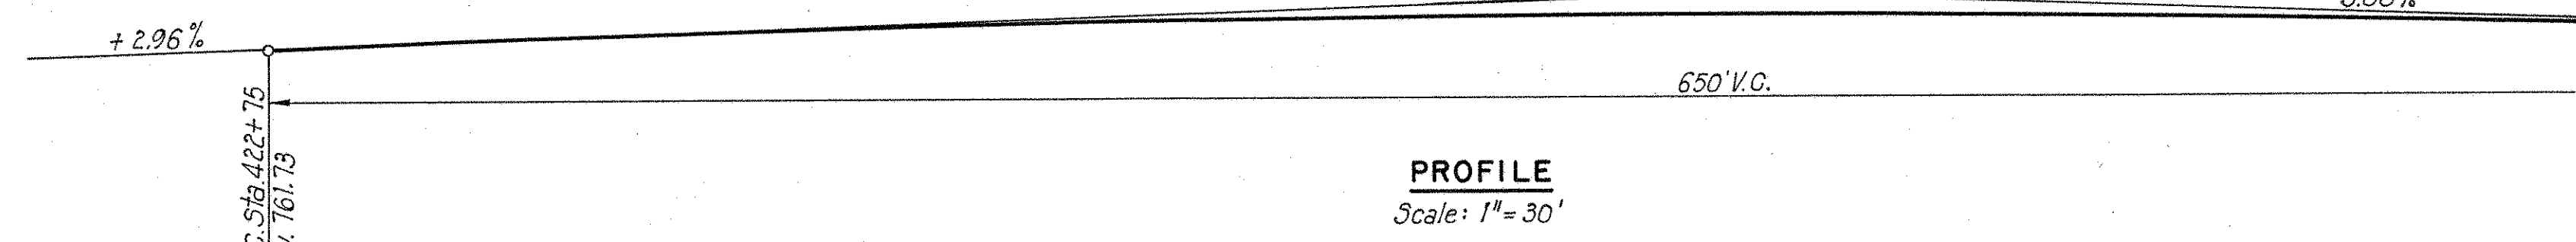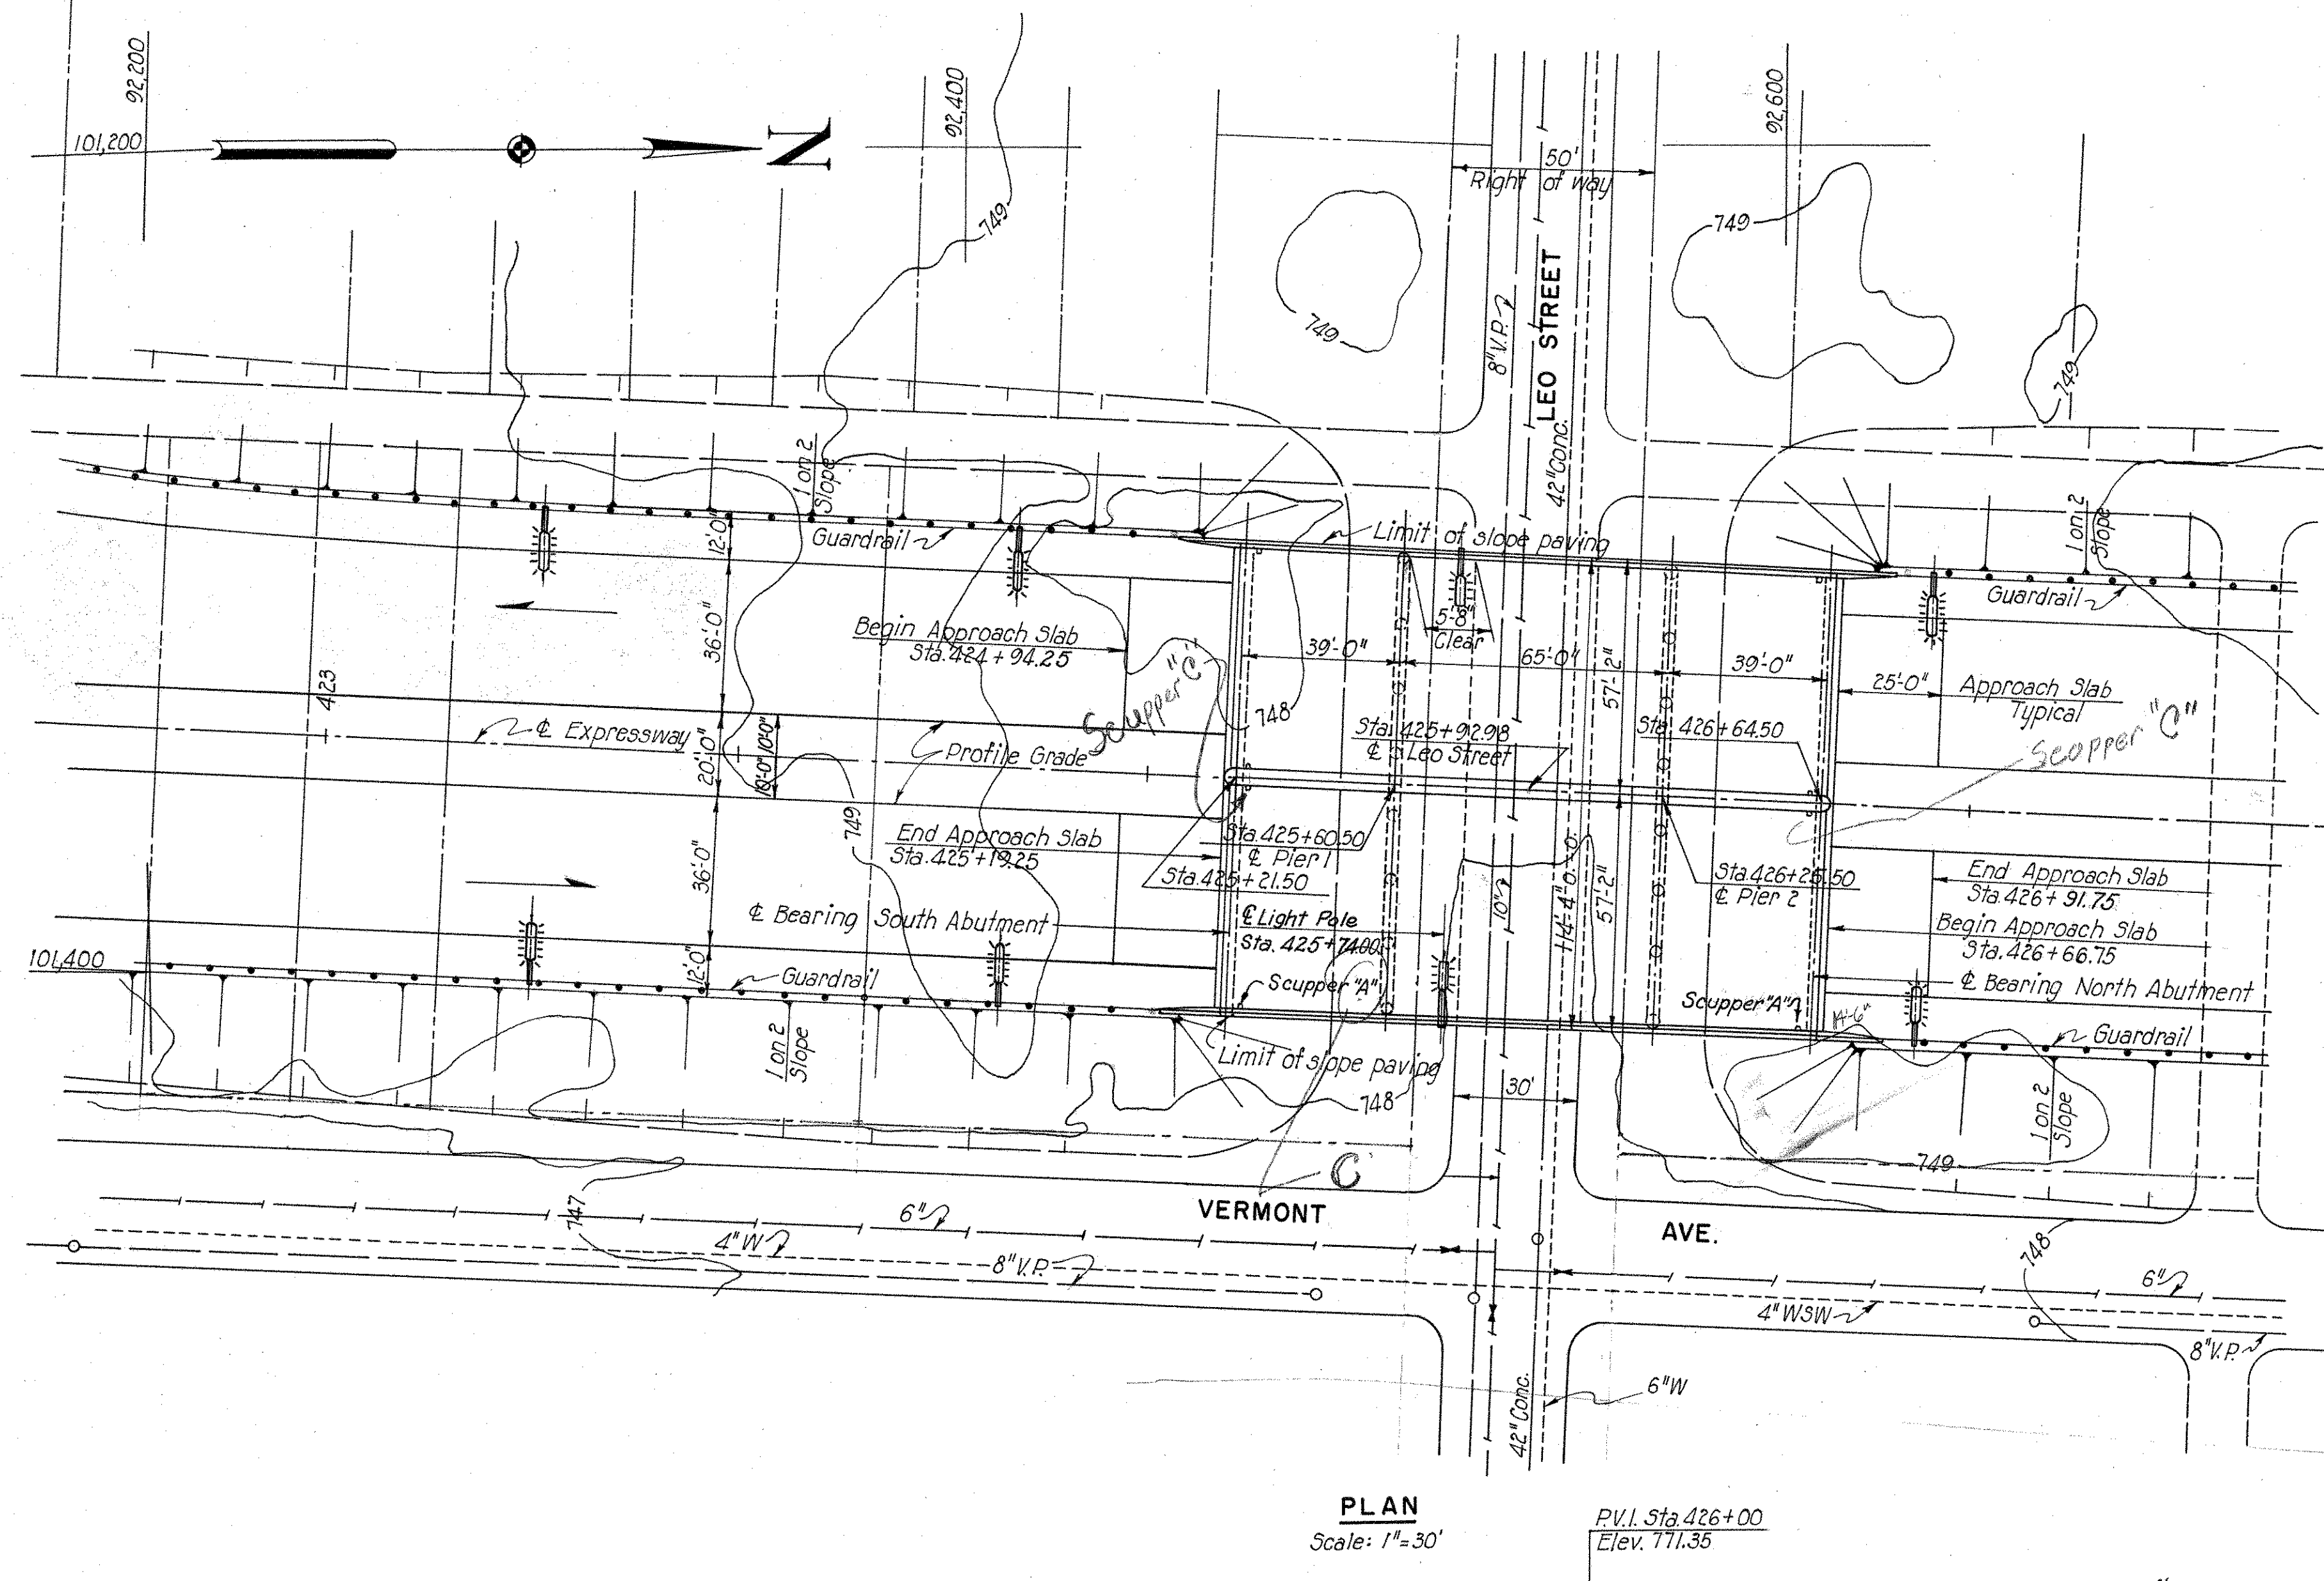

LEGEND

	Water main
	Sanitary Sewer
	Storm Sewer
	Manhole
	Water Valve
	Property Line
	Gas Line

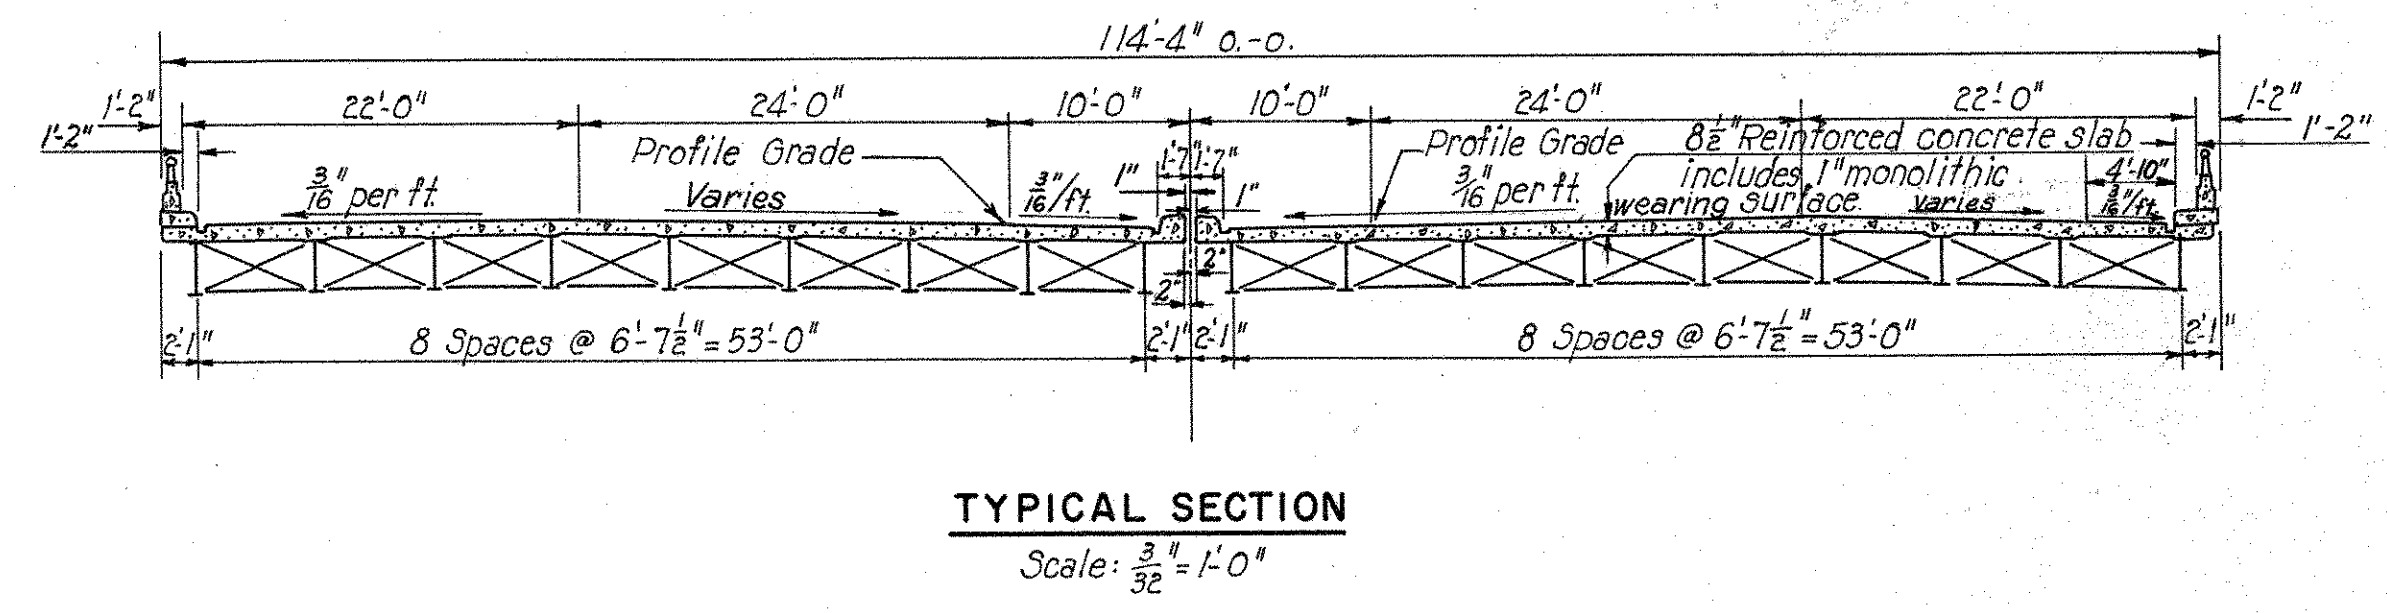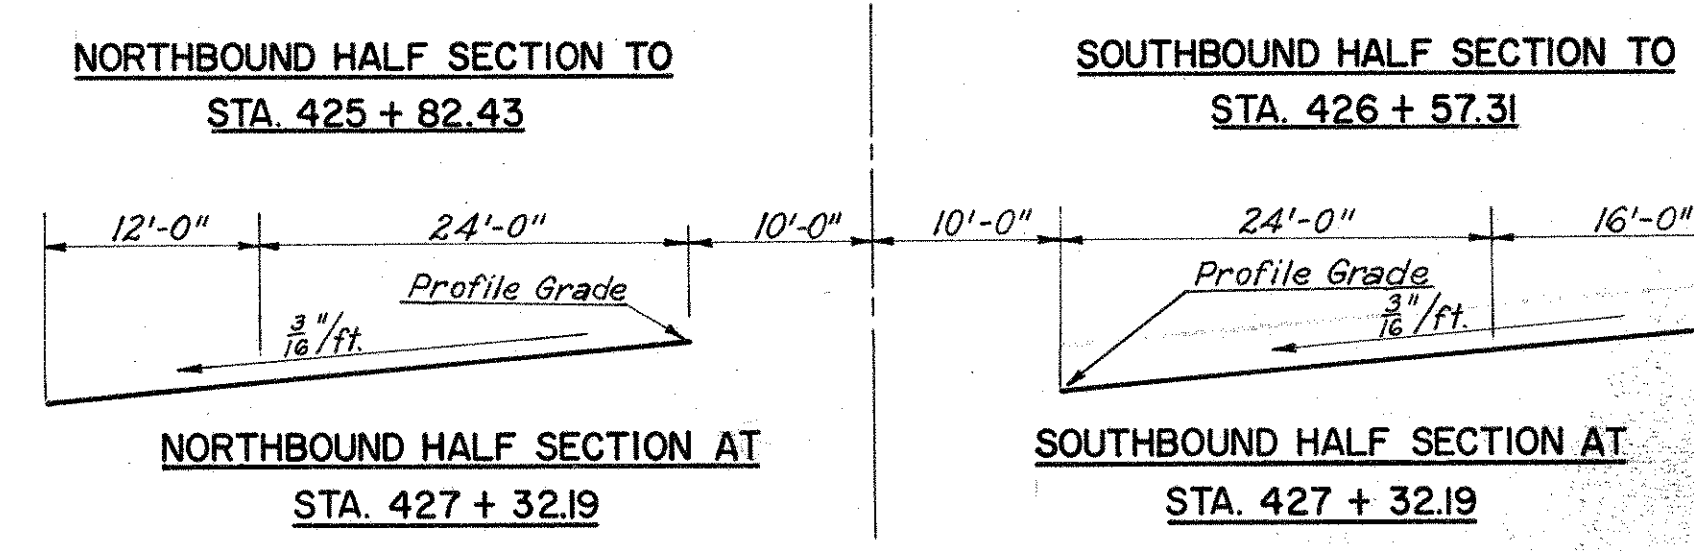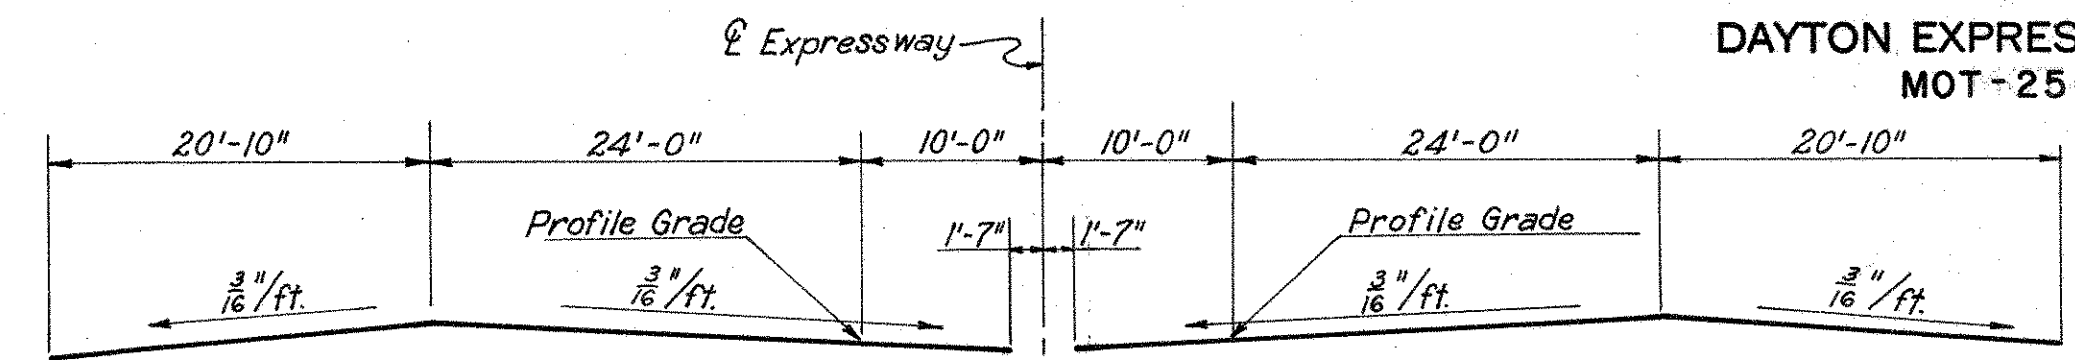

PROPOSED STRUCTURE

TYPE: three span continuous rolled beam bridges with reinforced concrete deck and substructure.

SPAN: 39'-0", 65'-0", 39'-0" = 143'-0"

ROADWAY: 2-5 1/2' Roadways with 1'-0" curbs

LOADING: CF 2000, adequate for AASHTO alternate loading

SKEW: None

SURFACE COURSE: 1" Monolithic concrete wearing surface

APPROACH SLABS: AS-1-54 (25' long)

ALIGNMENT: Tangent

The superelevation transition is a straight line variation except for rounding 12.5' before and after start of transition.

Foundation Soundings: Foundation design and foundation quantities are based on a study of rod soundings and soil-sampling soundings made at the site.

This sounding information may be inspected in the office of the Bureau of Bridges in Columbus, or in the Division office, but the State assumes no responsibility for the accuracy thereof.

HOWARD, NEEDLES, TAMMEN & BERGENDOFF
CONSULTING ENGINEERS
KANSAS CITY CLEVELAND NEW YORK






SITE PLAN
EXPRESSWAY OVER LEO STREET

BR. NO. MOT- 25- 1616 STA. 425 + 19.25
SCALE: As Shown 426 + 66.75

DAYTON EXPRESSWAY SYSTEM
DAYTON, MONTGOMERY COUNTY, OH

DRAWN GRC	TRACED R.R.	CHECKED P.M.	REVIEWED	REVISED
DATE 7-25-57	DATE 8-22-57	DATE 10-26-57	DATE 10-26-57	DATE 10-26-57

944 SHEET 106

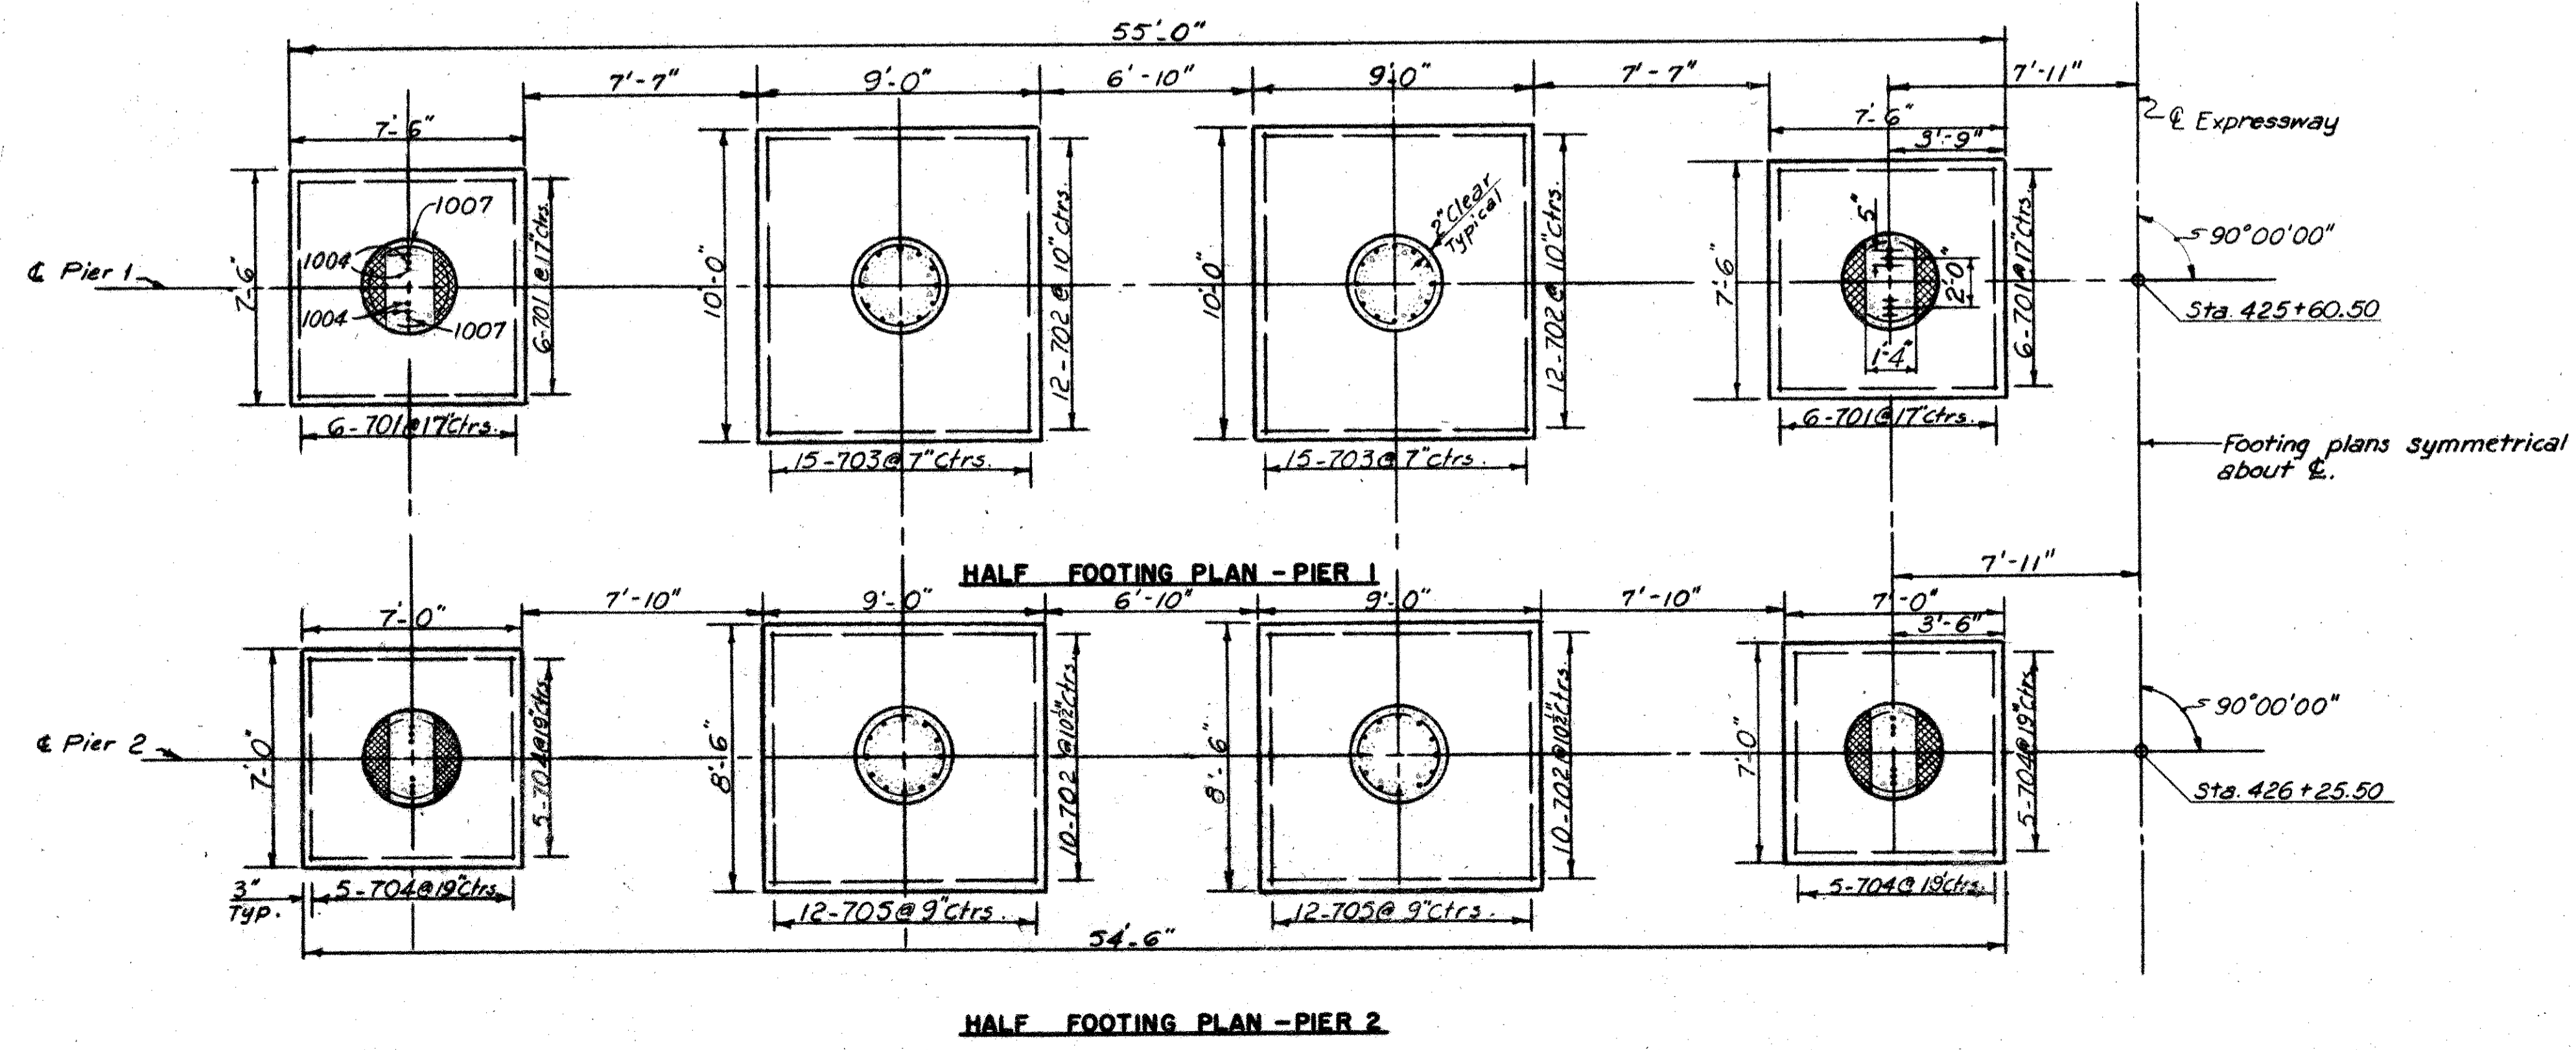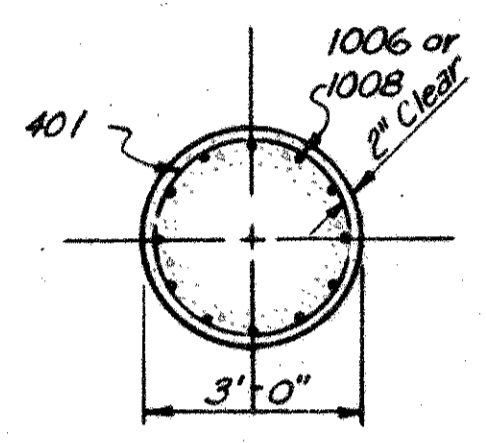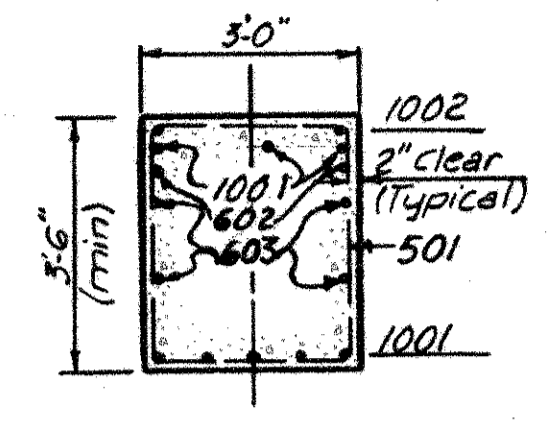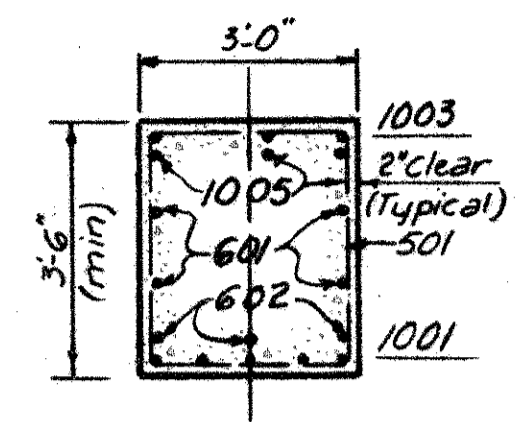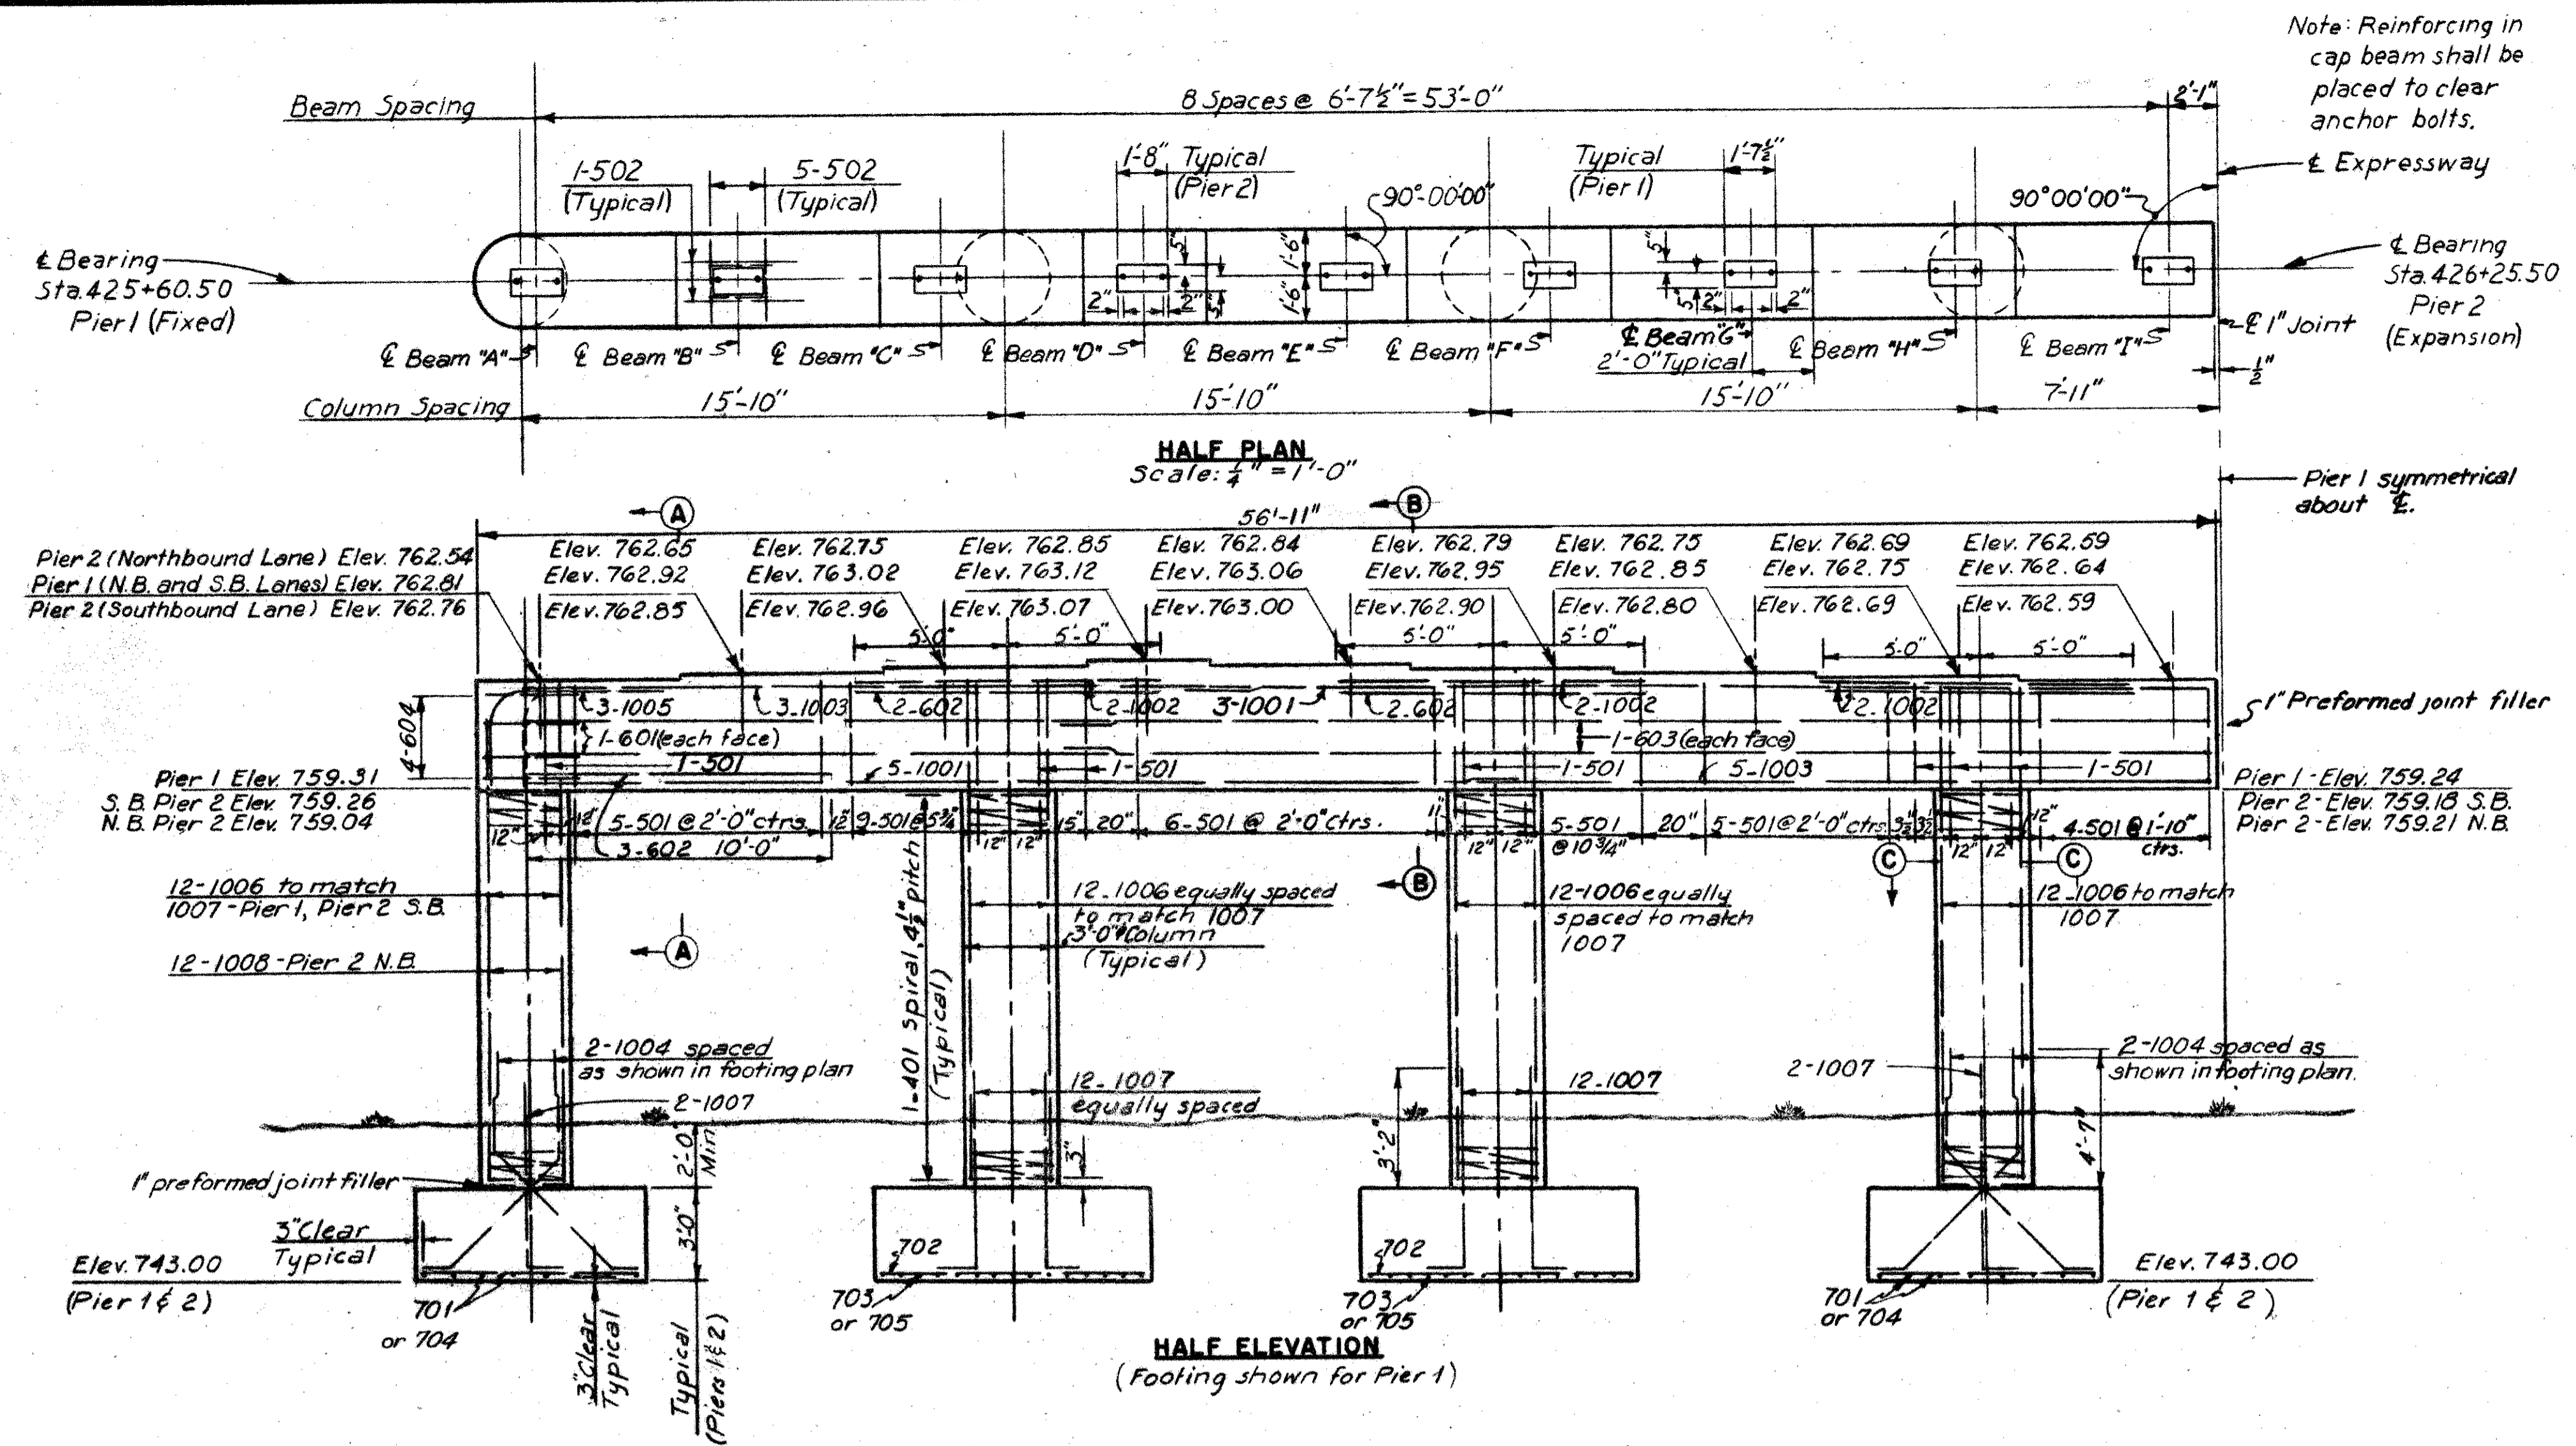


Notes:
For reinforcing steel schedule see sheet 112.
Maximum soil pressure is 4.20 tons per square foot.

HOWARD, NEEDLES, TAMMEN & BERGENDOFF
CONSULTING ENGINEERS
KANSAS CITY CLEVELAND NEW YORK


PIERS
EXPRESSWAY OVER LEO STREET
BR. NO. MOT- 25-1616 STA. 425+19.25
SCALE: 426+66.75
DAYTON EXPRESSWAY SYSTEM
DAYTON, MONTGOMERY COUNTY, OHIO

DRAWN BY TH TRACED CHECKED BY G.A. REVIEWED BY
DATE 8.8.57 DATE 10-22-57 DATE 10-26-57 944 SHEET 107


MONTGOMERY COUNTY
CITY OF DAYTON
DAYTON EXPRESSWAY SYSTEM
MOT-25-15.88

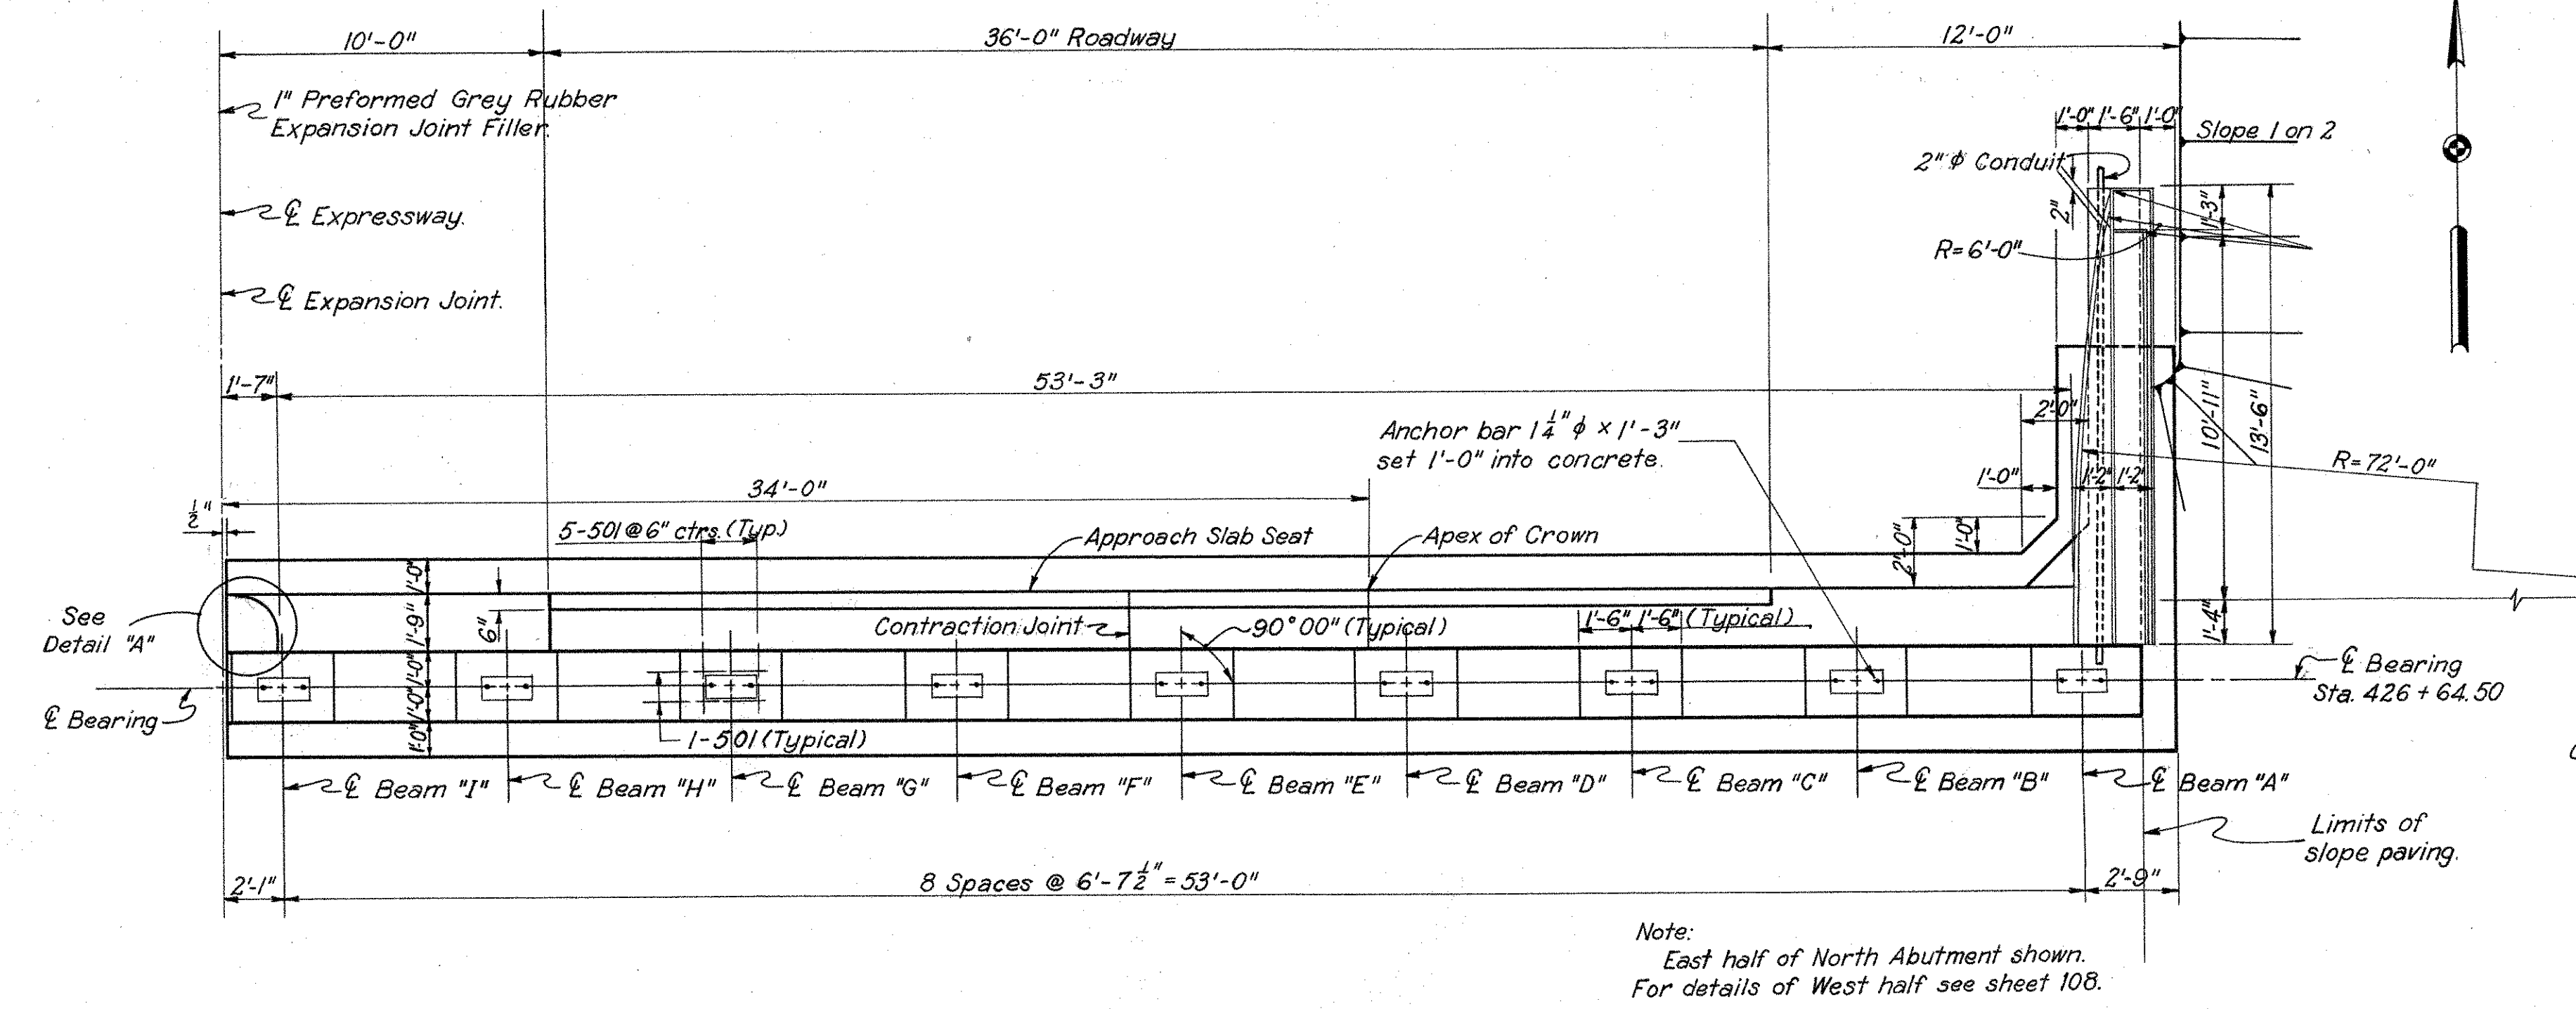


PLAN

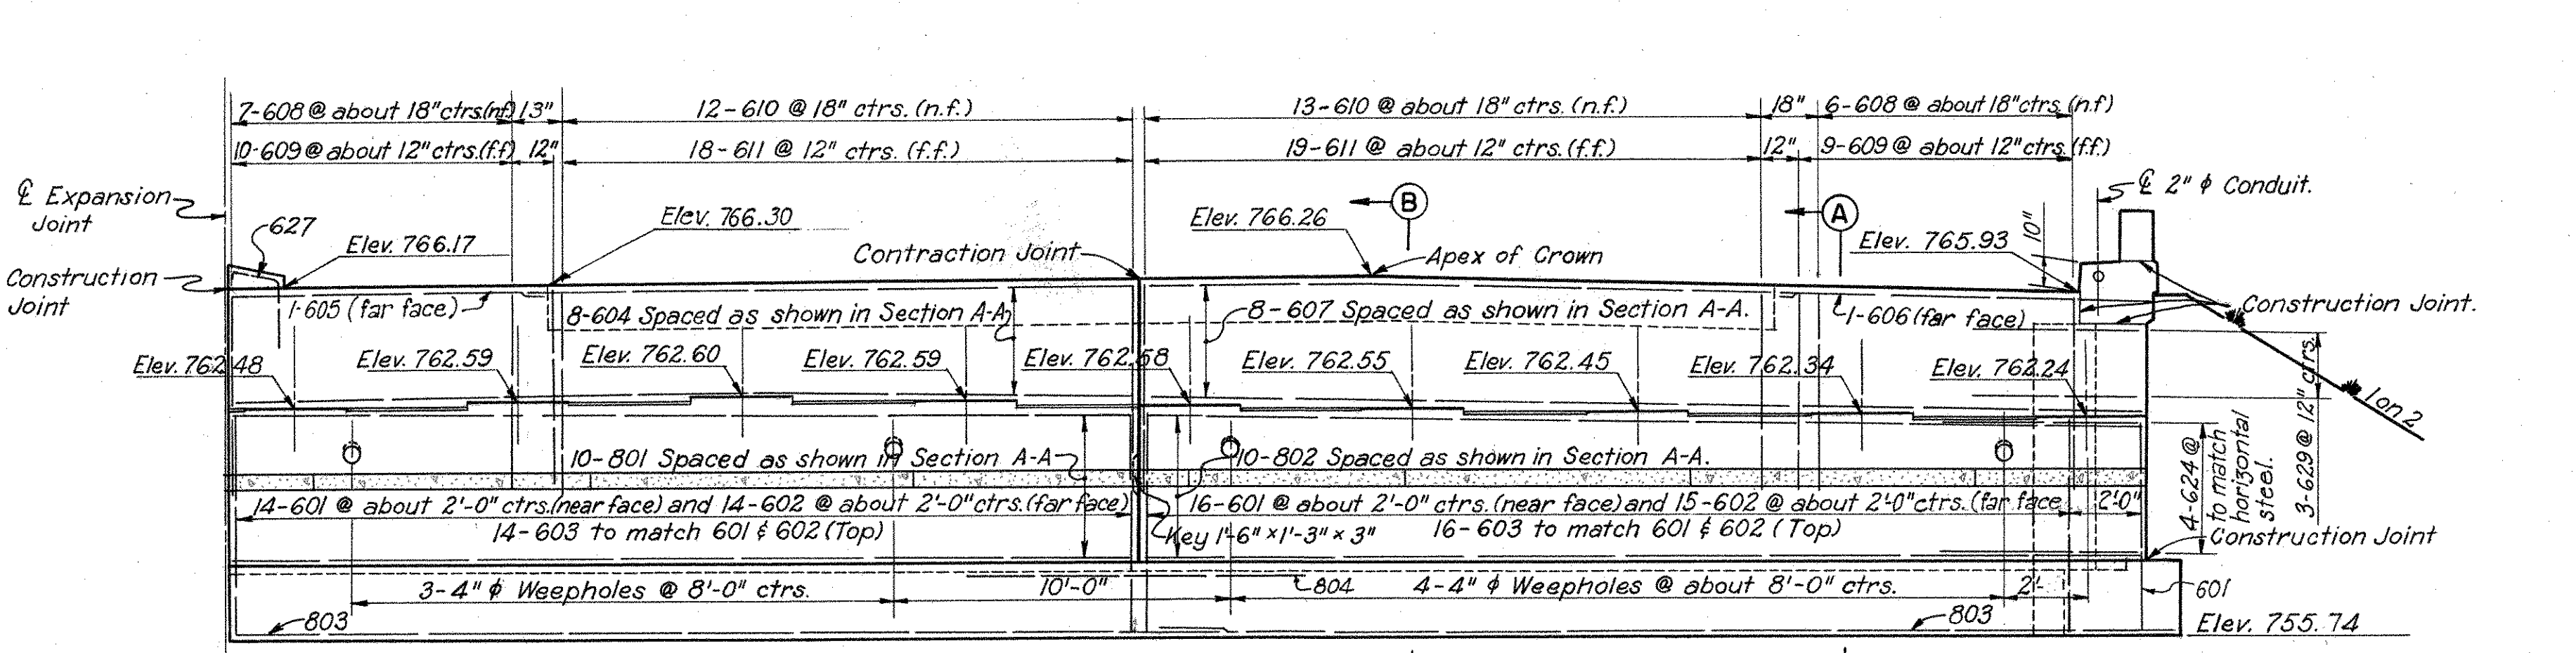


ELEVATION

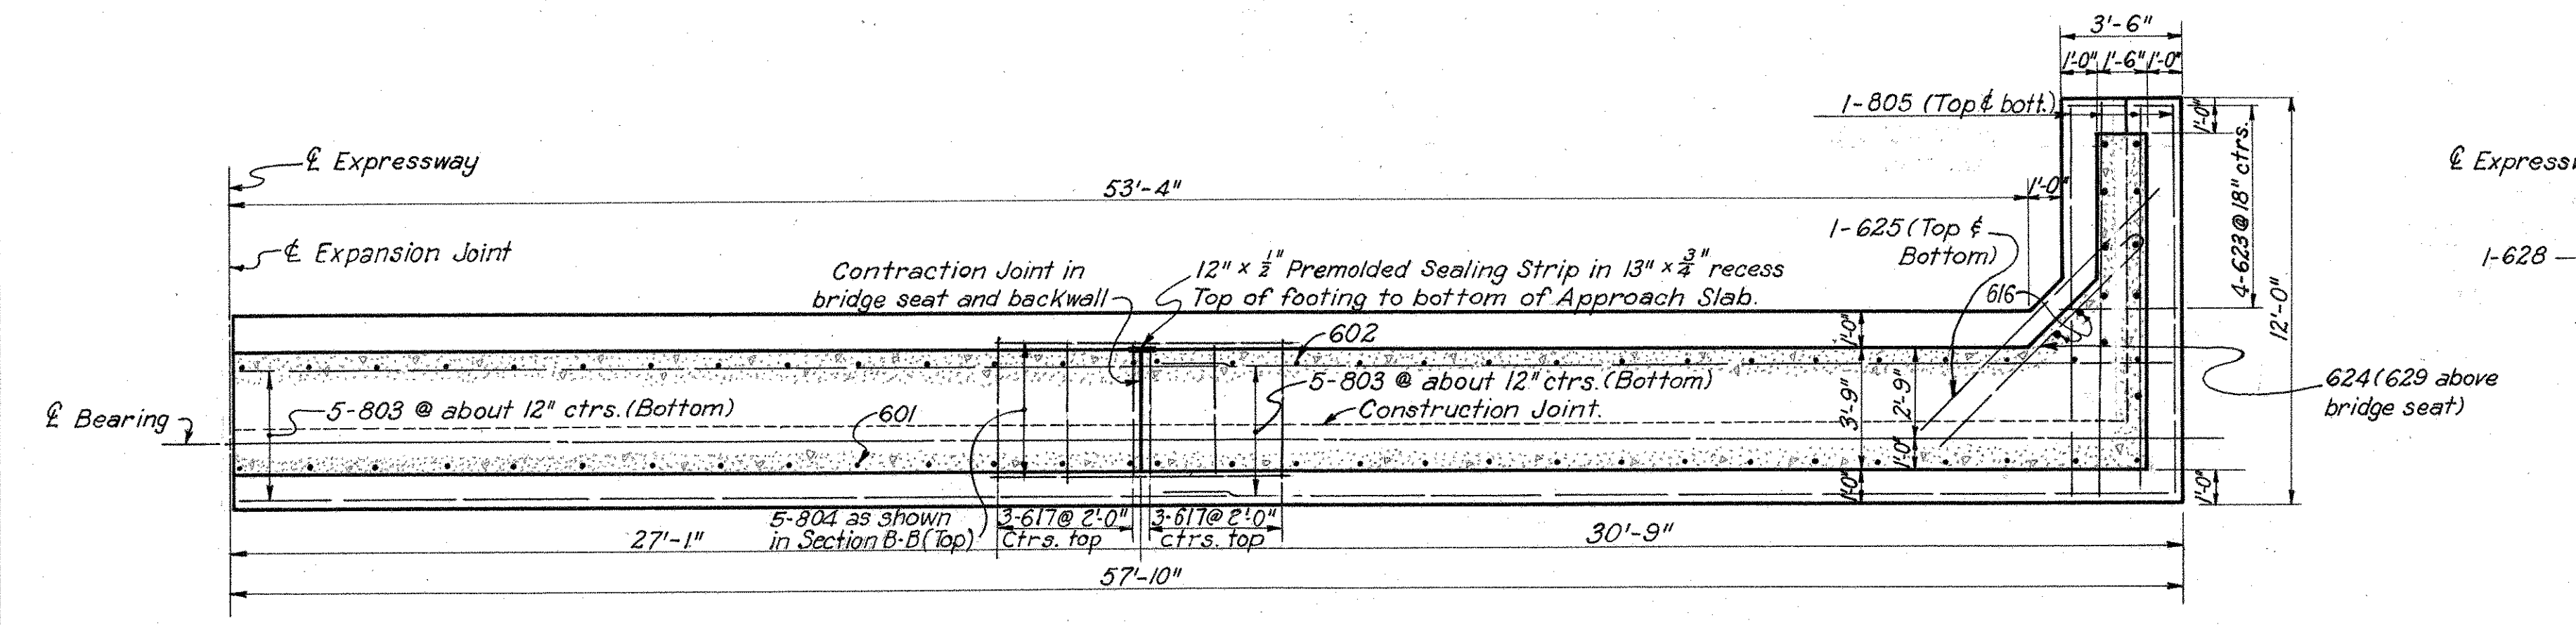


FOOTING PLAN

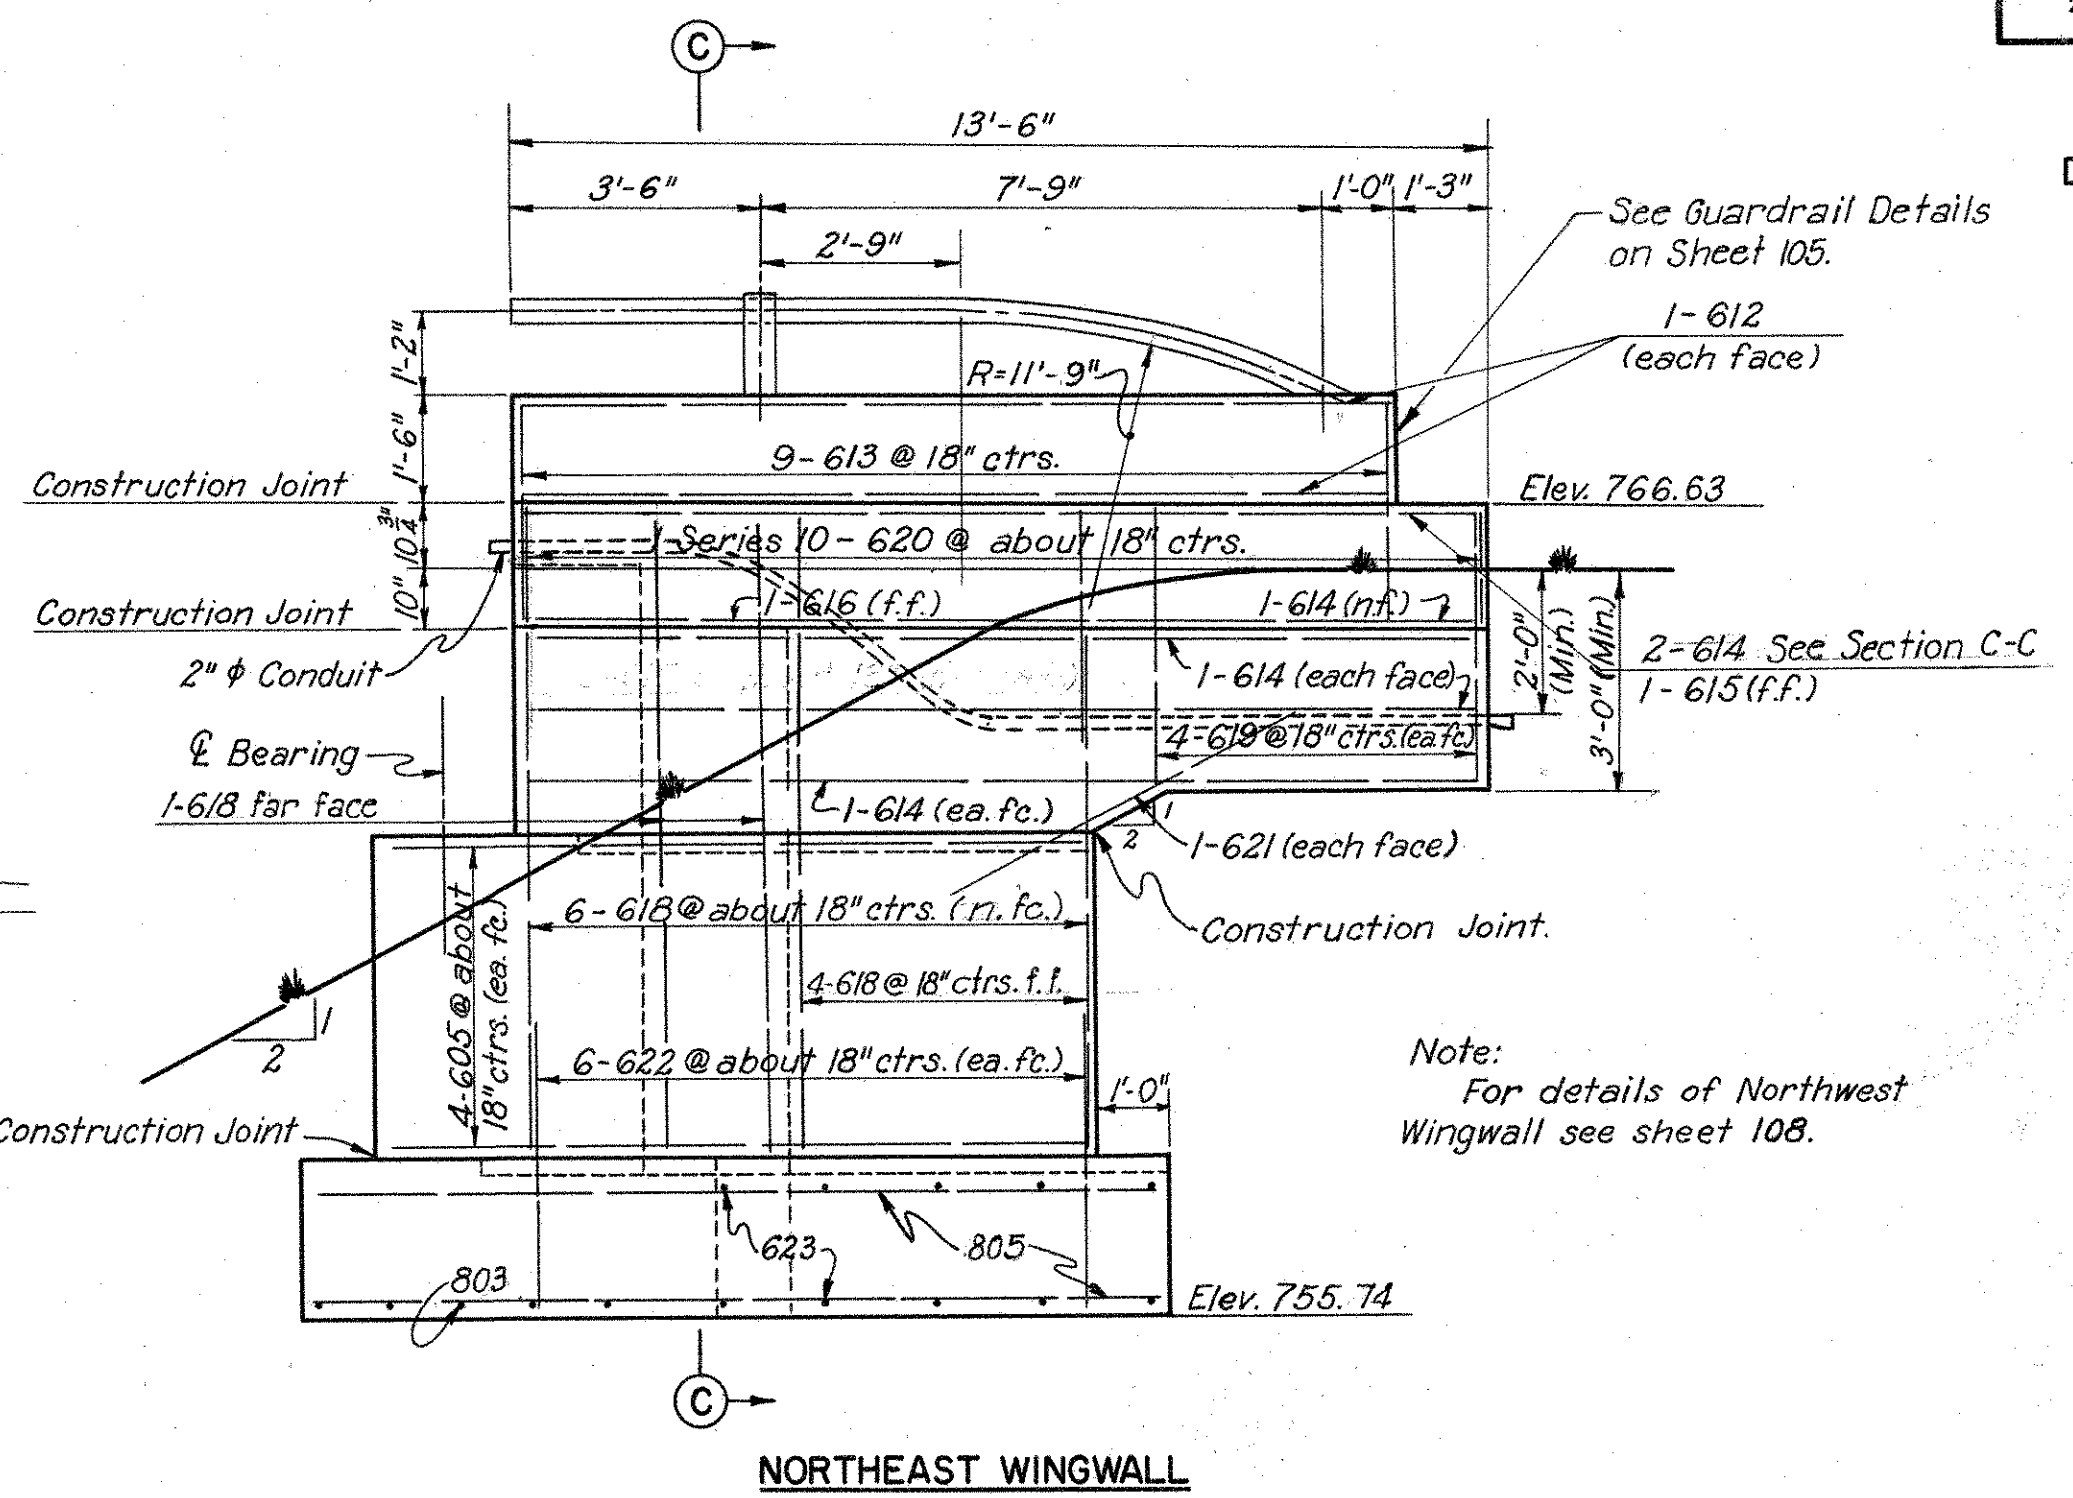


NORTHEAST WINGWALL

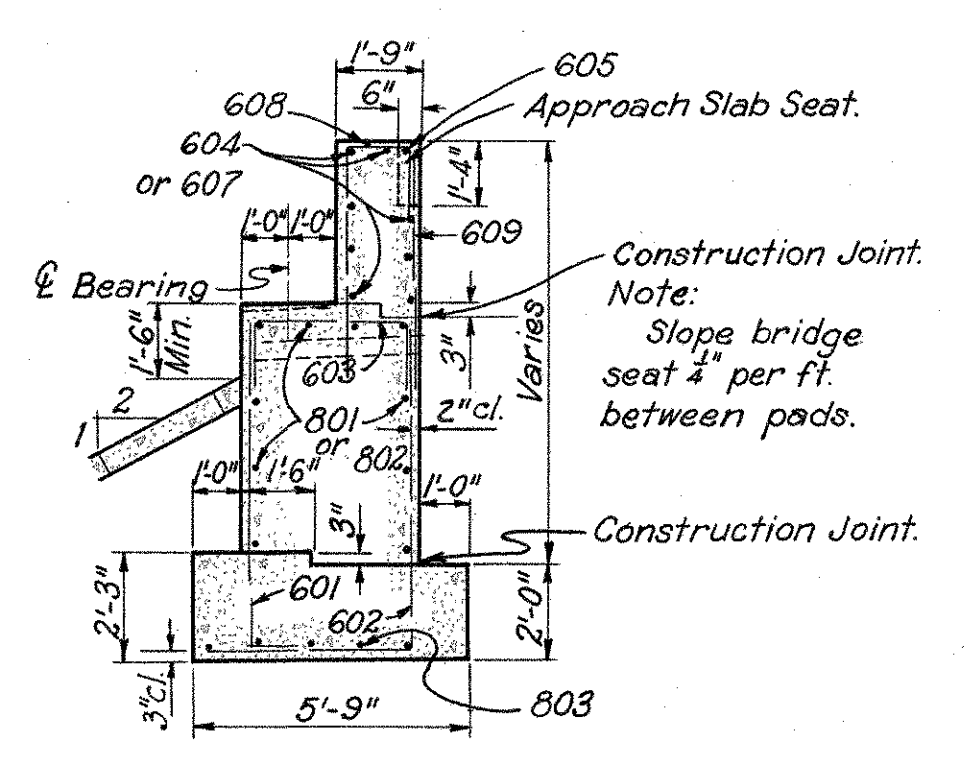

SECTION A-A

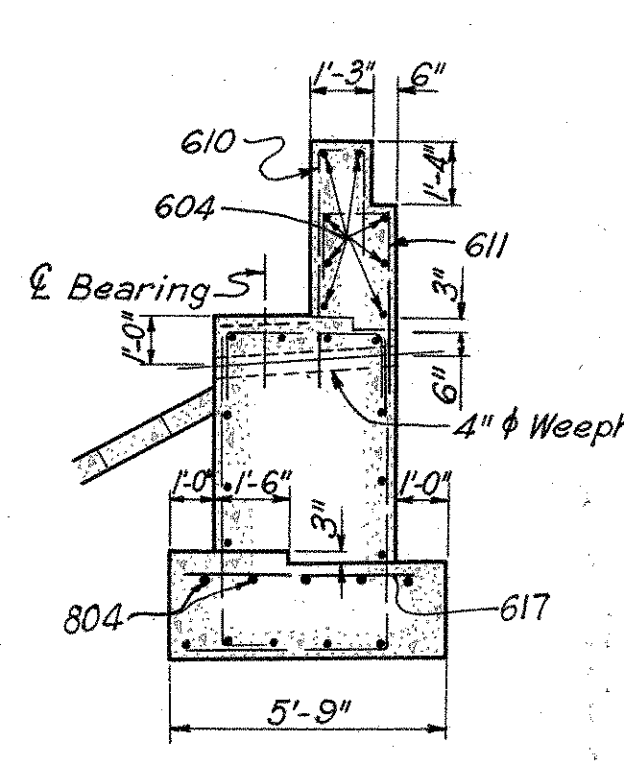

SECTION B-B

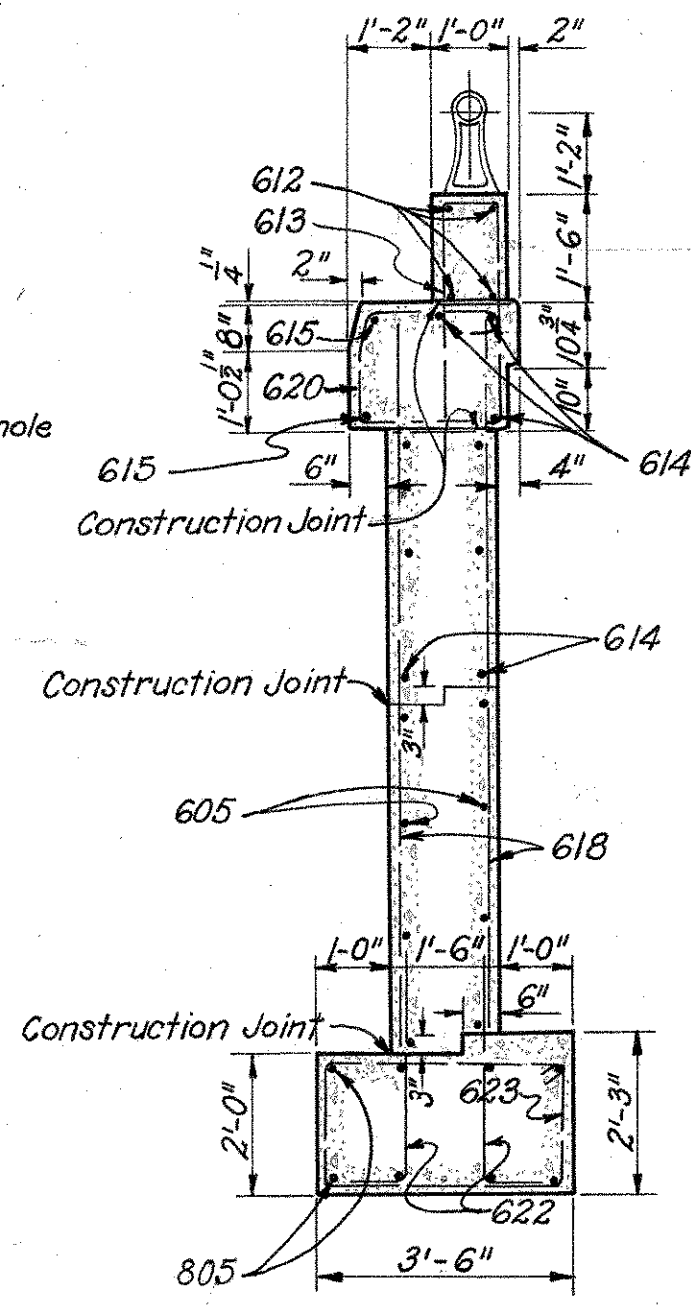

SECTION C-C

Notes:
For porous backfill and weepholes, see Common Details.
For Reinforcing Steel Schedule see sheet 112.
For Expansion Joint Details see Common Details.
For details of slope paving see Common Details.
Maximum soil pressure under abutment 1.10 tons per square foot.
Procedure: The embankment shall be placed and compacted to full height of embankment slopes or subgrade, after which excavation shall be made for the abutment.

HOWARD, NEEDLES, TAMMEN & BERGENDOFF CONSULTING ENGINEERS KANSAS CITY CLEVELAND NEW YORK		
EAST HALF OF NORTH ABUTMENT		
EXPRESSWAY OVER LEO STREET		
BR. NO. MOT-25-1616	STA. 425 + 19.25	
SCALE: 1/4" = 1'-0" except as noted.	426 + 66.75	
DAYTON EXPRESSWAY SYSTEM		
DAYTON,	MONTGOMERY COUNTY,	OHIO
DRAWN G.R.C. DATE 10-19-57	TRACED J.A.C. DATE 10-22-57	CHECKED P.F.F. REVIEWED G.A. DATE 11-28-57 DATE 12-29-57
		REVISED 944 SHEET 109




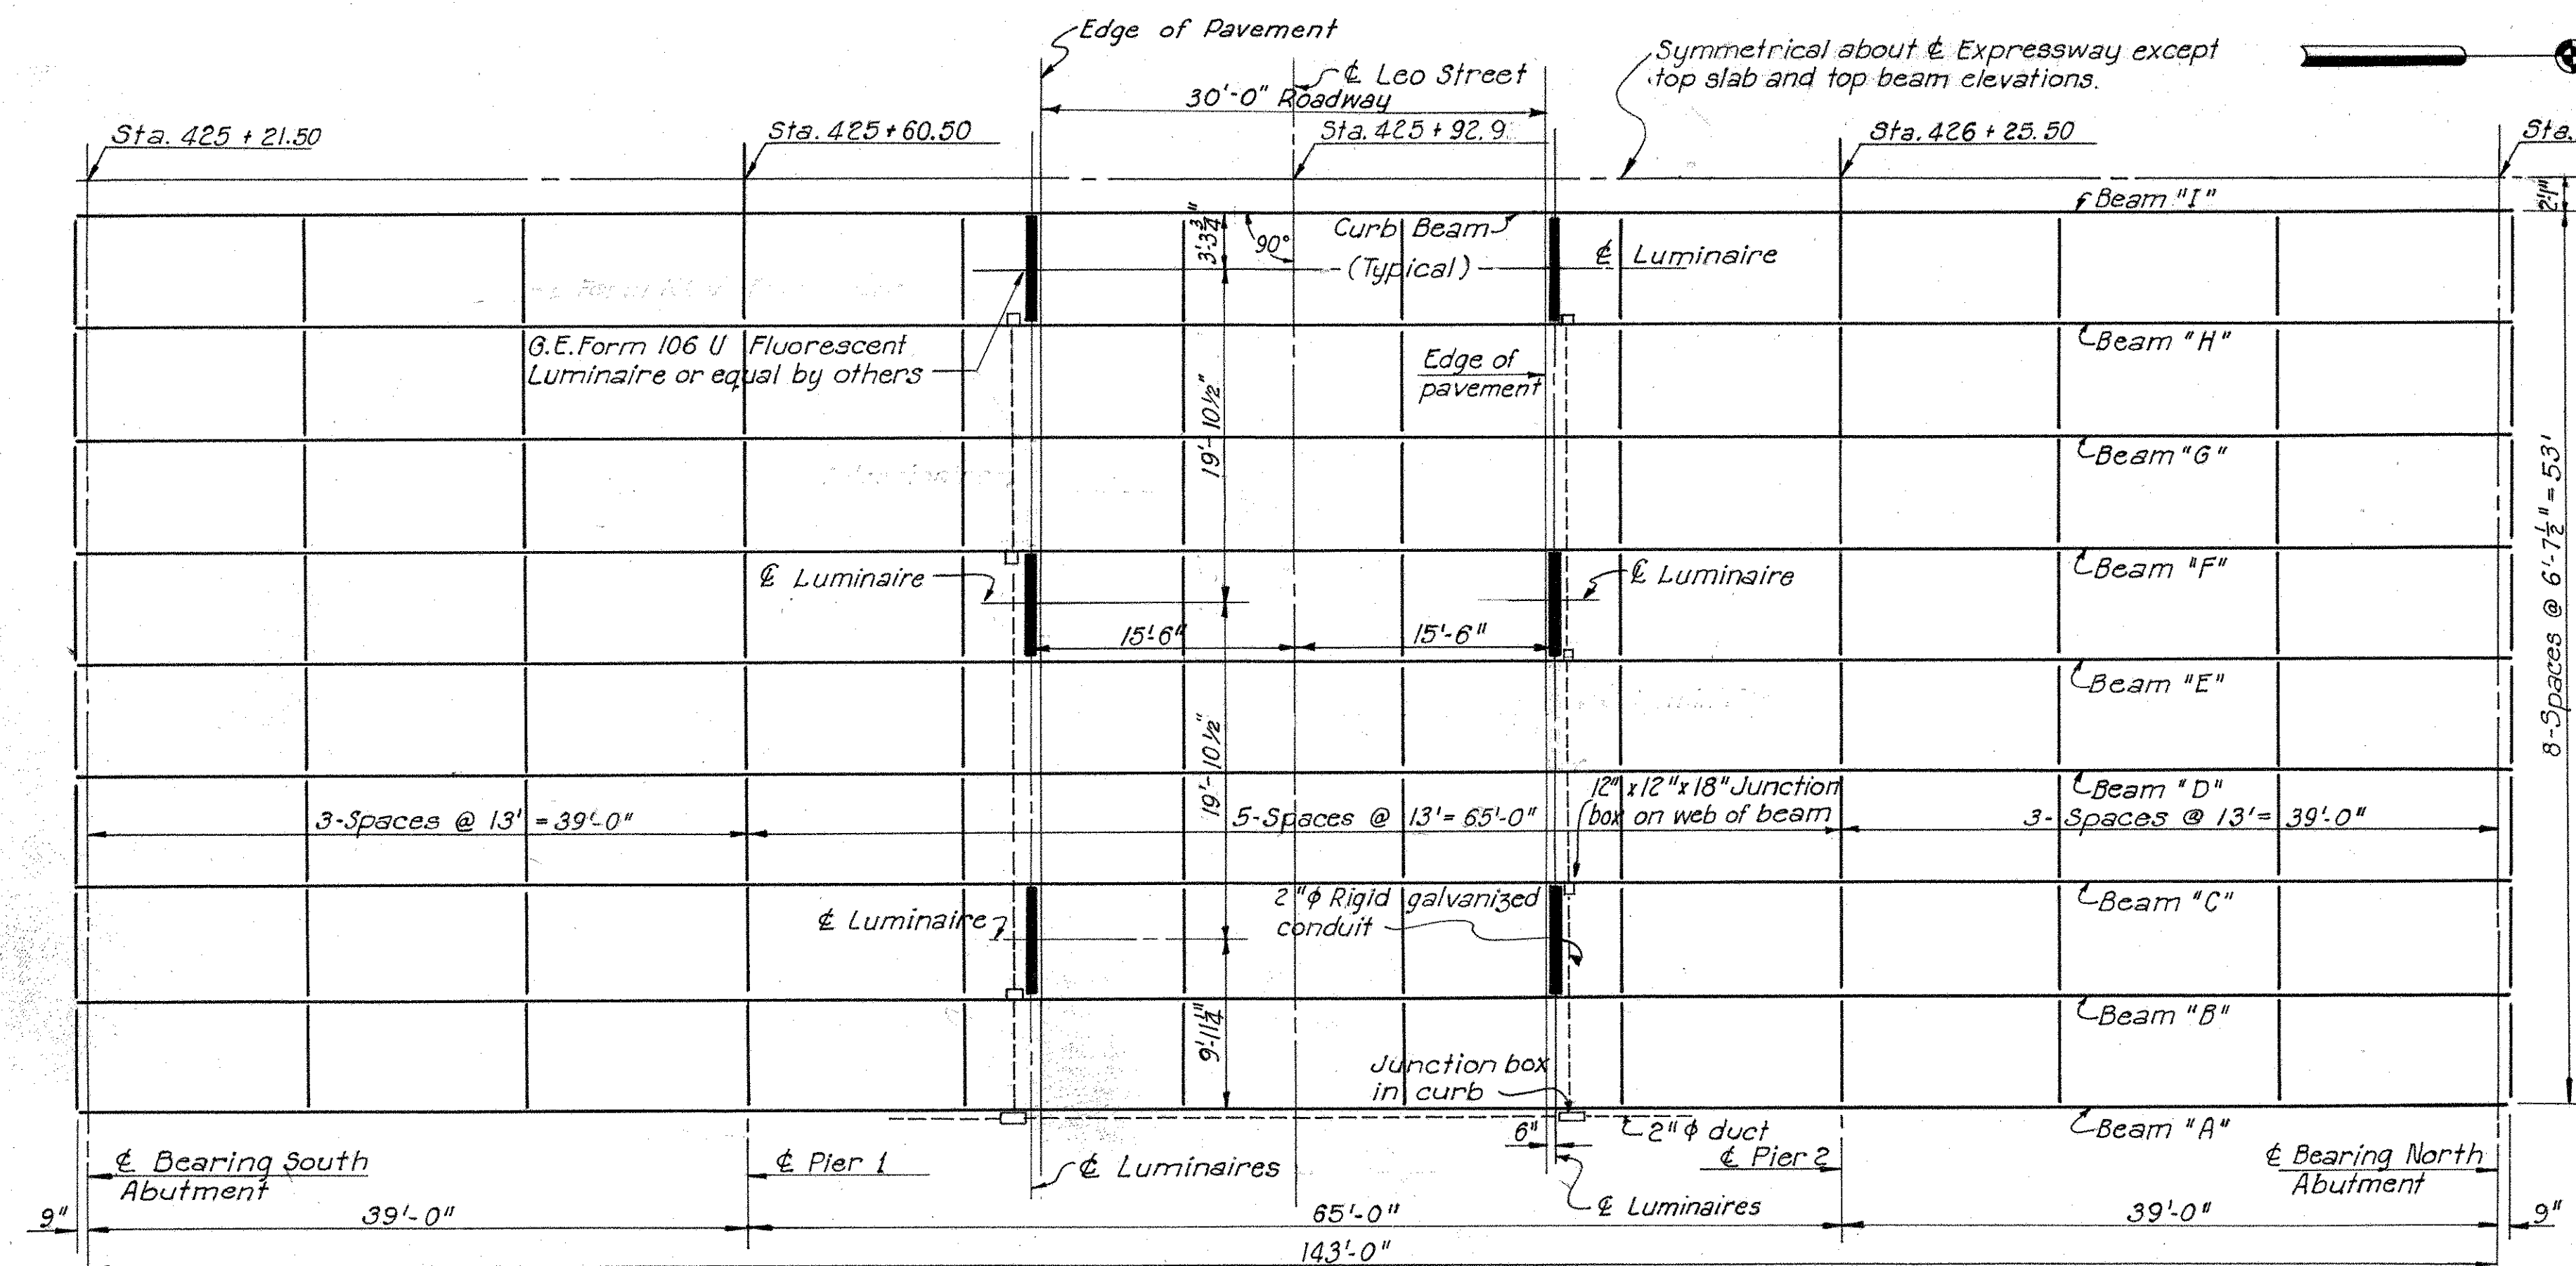


TABLE OF ELEVATIONS

SOUTHBOUND LANE									
	SOUTH ABUTMENT		PIER 1		PIER 2		NORTH ABUTMENT		
Beam	Top Slab	Top Beam	Top Slab	Top Beam	Top Slab	Top Beam	Top Slab	Top Beam	Beam
"A"	766.29	765.53	766.49	765.74	766.52	765.77	766.44	765.68	"A"
"B"	766.39	765.63	766.59	765.84	766.62	765.87	766.53	765.77	"B"
"C"	766.49	765.73	766.70	765.95	766.73	765.98	766.60	765.84	"C"
"D"	766.60	765.84	766.80	766.05	766.83	766.08	766.67	765.91	"D"
"E"	766.53	765.77	766.73	765.98	766.76	766.01	766.59	765.83	"E"
"F"	766.43	765.67	766.63	765.88	766.66	765.91	766.49	765.73	"F"
"G"	766.32	765.56	766.53	765.78	766.56	765.81	766.39	765.53	"G"
"H"	766.22	765.46	766.42	765.67	766.45	765.70	766.29	765.53	"H"
"I"	766.12	765.36	766.32	765.57	766.35	765.60	766.18	765.42	"I"

NORTHBOUND LANE

	SOUTH ABUTMENT		PIER 1		PIER 2		NORTH ABUTMENT		
Beam	Top Slab	Top Beam	Top Slab	Top Beam	Top Slab	Top Beam	Top Slab	Top Beam	Beam
"A"	766.29	765.53	766.49	765.74	766.30	765.55	765.94	765.18	"A"
"B"	766.39	765.63	766.59	765.84	766.41	765.66	766.04	765.28	"B"
"C"	766.49	765.73	766.70	765.95	766.51	765.76	766.15	765.39	"C"
"D"	766.60	765.84	766.80	766.05	766.61	765.86	766.25	765.49	"D"
"E"	766.53	765.77	766.73	765.98	766.60	765.85	766.28	765.52	"E"
"F"	766.43	765.67	766.63	765.88	766.55	765.80	766.29	765.53	"F"
"G"	766.32	765.56	766.53	765.78	766.51	765.76	766.30	765.54	"G"
"H"	766.22	765.46	766.42	765.67	766.45	765.70	766.28	765.52	"H"
"I"	766.12	765.36	766.32	765.57	766.35	765.60	766.18	765.42	"I"

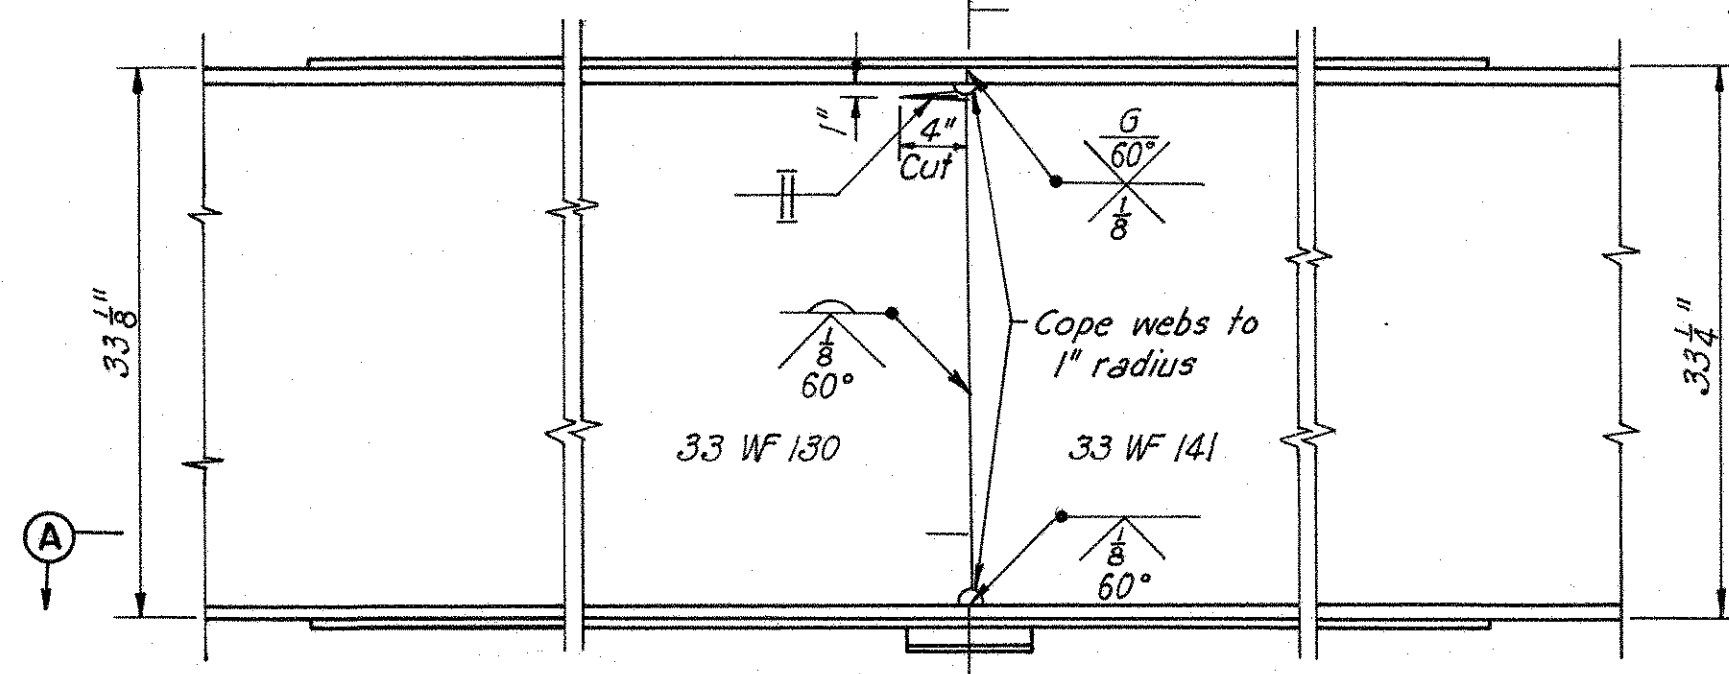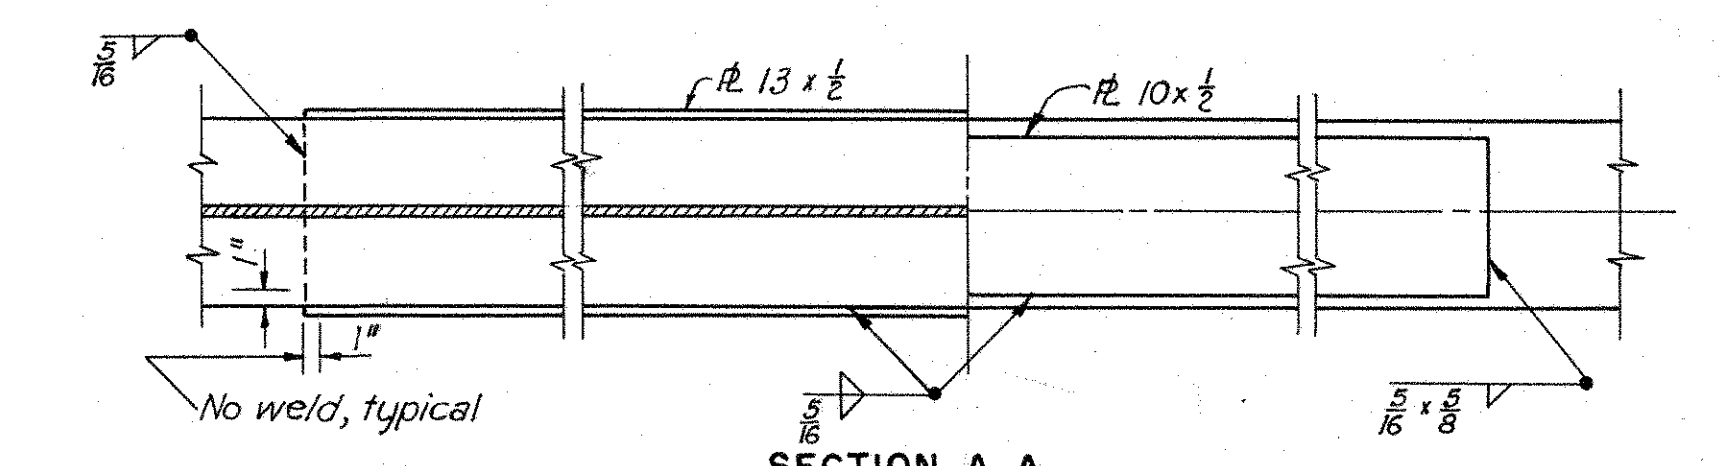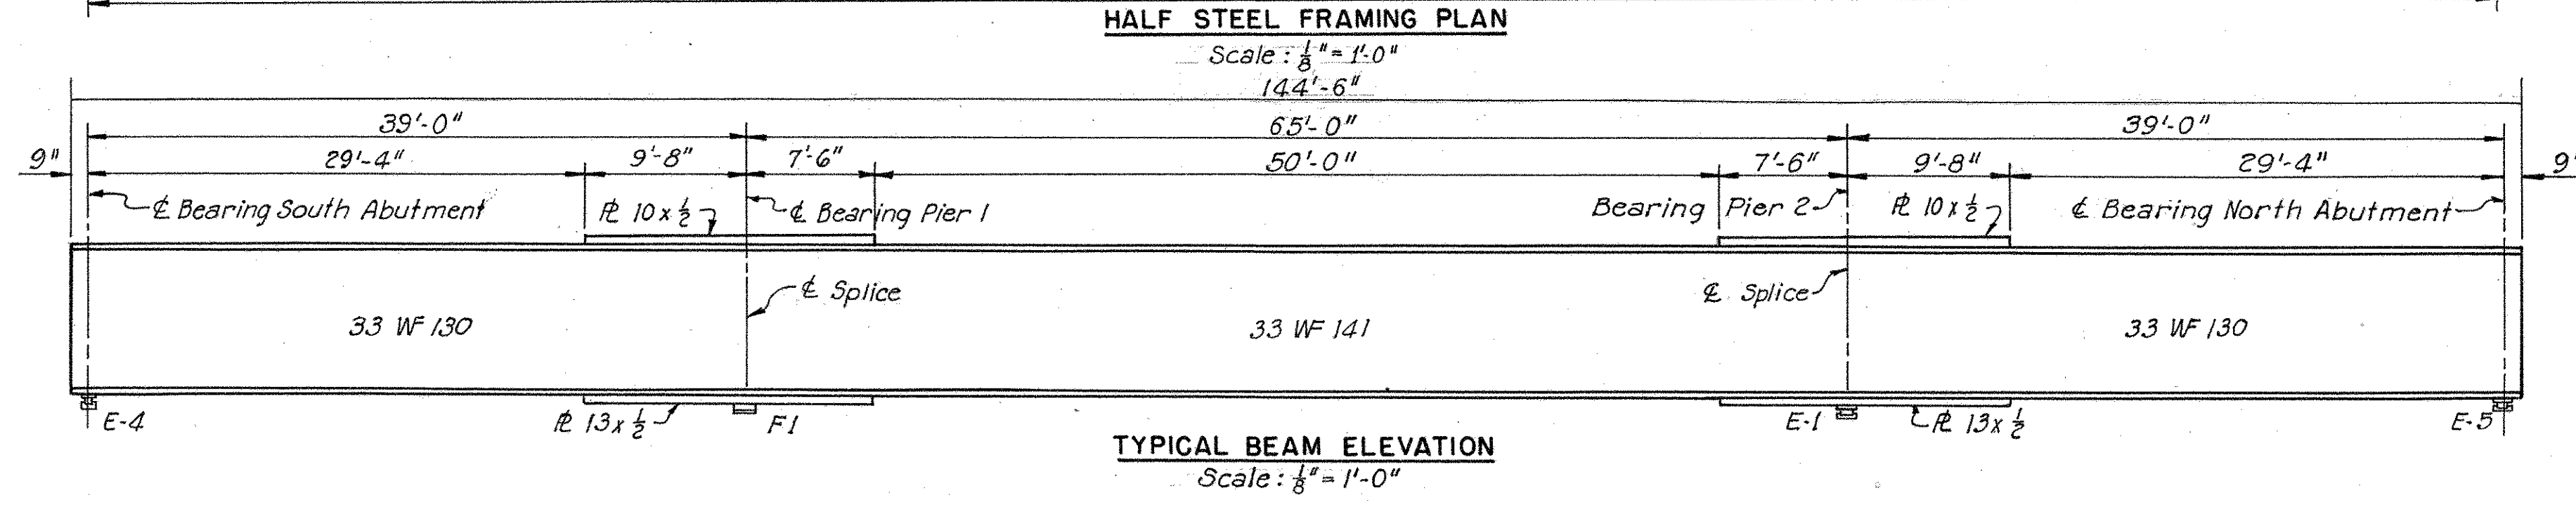

Notes:
For crossframe and end finish details see Sheets 111 and 105
For details of Bearing Plates E-1, E-4, E-5 and F-1 see Sheet 104.

BEAM SPLICE WELDING PROCEDURE

1. Raise the abutment ends of the beams 5/8".
2. Buffweld the beam flanges and web, using the following sequence: make one pass on each flange, then one on the web; repeat until welds are completed.
3. Weld the bottom and top moment plates.
4. Lower the beam ends to final position.
5. Weld crossframes into place.

BEAMS "A"








DEFLECTION AND CONVEXITY DATA
No scale

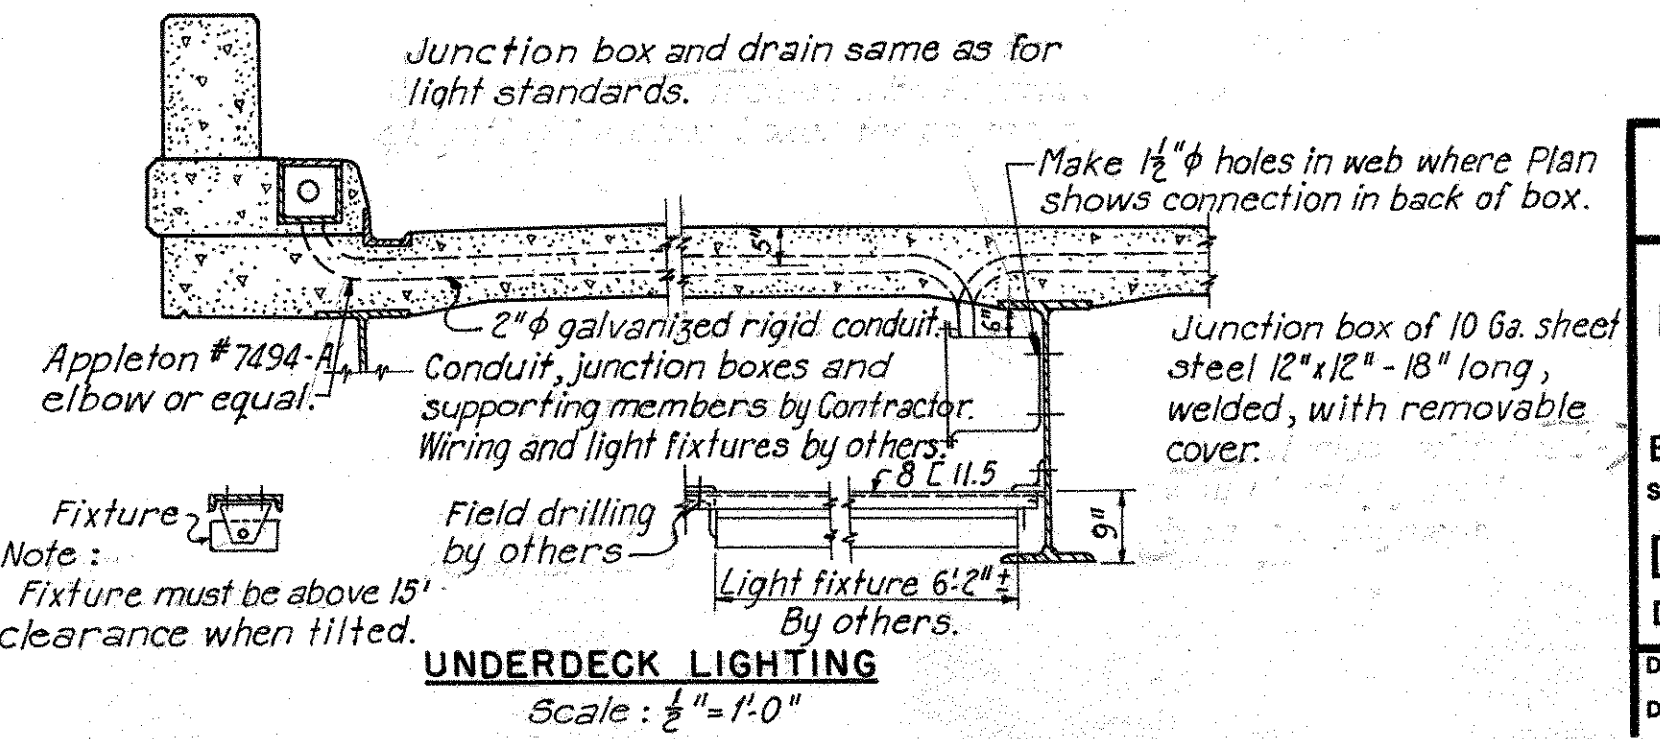

Revised 4-29-59
HOWARD, NEEDLES, TAMMEN & BERGENDOFF
CONSULTING ENGINEERS
KANSAS CITY CLEVELAND NEW YORK

FRAMING PLAN AND BEAM ELEVATIONS
EXPRESSWAY OVER LEO STREET
BR. NO. MOT-25-1616 STA. 425+19.25
SCALE: As shown 426+66.75
DAYTON EXPRESSWAY SYSTEM
DAYTON, MONTGOMERY COUNTY, OHIO
DRAWN R.E.B. TRACED A.H. CHECKED P.R.C. REVIEWED G.A. REVISIONS
DATE 7-19-57 DATE 10-17-57 DATE 10-20-57 DATE 10-26-57
944 SHEET 110

