

CONCRETE AND STONE MASONRY BRIDGES

DATE 1-3-89

O-BR. 140053

TYPE OF BRIDGE 231) Prestressed Conc. Box Beam		NO. OF SPANS 1		DATE BUILT 8800	
APPROX. SAFE LOAD CAPACITY HS 20-44 Alt. Military Loading		4601858			
CLEAR SPAN 75'-0"	LENGTH OUT TO OUT OF FLOOR 79.07'	WIDTH BETWEEN CURBS 44'-0"	WIDTH OUT TO OUT 44'-0"	WIDTH OF SIDEWALKS -	HEIGHT OF FLOOR ABOVE BRIDGE SEAT 2.75'
ROADWAY CLEARANCE MAX. HEIGHT WIDTH MIN. HEIGHT		OPEN			
TYPE OF RAILING DBR-2-73					TYPE AND SIZE OF CURB
TYPE AND THICKNESS OF WEARING SURFACE 2 1/2" AC on Type D Waterproofing = 369 SY.					
DESCRIPTION OF FLOOR DRAINAGE Over side - Steel Drip Strip =					
ALIGNMENT AND SKEW OF STRUCTURE Tan. 15° LF		APPROACH SLABS AS-1-81		LENGTH 20'	
LIGHTING SYSTEM		STREAM N. Fk. of Gr. Miami River		HEIGHT FROM GRADE TO STREAM BED 13.66'	
CHANNEL CHARACTERISTICS BETWEEN BANKS		CHANNEL DEPTH		HEIGHT FROM GRADE TO HIGH WATER Normal = 9.86'	
CONDITION OF BANKS		NATURE OF BOTTOM		25 yr. = 4.16'	
SKEW OF NORMAL FLOW		ALIGNMENT OF STREAM ABOVE AND BELOW STRUCTURE		100 yr. = 3.16'	
SKEW OF FLOOD FLOW		SKEW OF FLOOD FLOW			

CONCRETE SLAB

STD. DRAWING NO.

THICKNESS OF SLAB

CONCRETE BEAM

STD. DRAWING NO. PSBD-1-81 9-18-81

NO. OF BEAMS	SPACING OF BEAMS	WIDTH OF BEAMS	HEIGHT OF BEAM INCLUDING SLAB	THICKNESS OF SLAB
11	Adjacent	4'-0"	33"	-

CONCRETE GIRDER

STD. DRAWING NO.

WIDTH OF GIRDER	DEPTH OF GIRDER		FLOOR BEAMS		THICKNESS OF FLOOR SLAB
	AT CENTER	AT ENDS	SIZE	SPACING	

ARCHES

STD. DRAWING NO.

MATERIAL	TYPE		SHAPE				
TYPE OF RAIL OR PARAPET	CLEAR SPAN	RISE	CROWN THICKNESS	SPRING THICKNESS	FILLING MATERIAL	DEPTH OF FILL AT CROWN	HEIGHT OF PARAPET ABOVE GRADE

SUB-STRUCTURE

STD. DRAWING NO.

ABUTMENTS AND PIERS	MATERIAL	TYPE	HEIGHT FOOTER TO BRIDGE SEAT	WIDTH OF BRIDGE SEAT	LENGTH OF BRIDGE SEAT	FOUNDATIONS (PILING)	WINGS (LENGTHS, ANGLES, ETC.)
REAR	Concrete	Stub-capped		2'-0"	46.16'	8-12" CIP - 30'	8'-4" @ 345° ; 7'-4" @ 15°
FORWARD	Concrete	"		2'-0"	46.16'	8-12" CIP - 40'	8'-4" @ 345° ; 7'-4" @ 15°
PIER							
PIER							

BRIDGE NO.	COUNTY	ROUTE NO.	S.H. NO.	SECTION	STRENGTH			ROADWAY			CLEARANCE				TYPE									
					H10-	H12	H15	H20	15-18	19-22	23+	12-	12-14	14+	OPEN	A	B	G	S	T				
0126	LOGAN	117	02.03	00.00				X											X					

01.26


LOGAN

117


00.00

H10	H12	H15	H20	15-18	19-22	23 +	12-	12-14	14 +	OPEN	A	B	G	S	T
			X				X				X	X			
STRENGTH				ROADWAY			CLEARANCE				TYPE				

SKETCH OF STRUCTURE SHOWING DIMENSIONS

 

LOCATION SKETCH

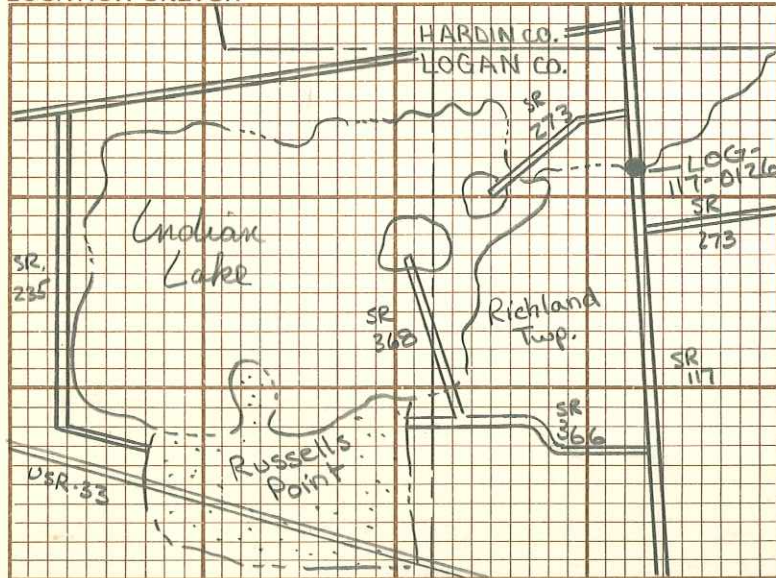

REMARKS:-

Proj = 453-88 BRS-632(3)
 Replaces = Rein. Conc. Thru Girder
 4601831

LOG-117-0000
 LOG-117-0126
 Station 66+38.74 to 67+17.81
 12-6-88 Opened

PVI Sta. 66+00 elev. 1006.31
 200' Vertical curve
 +0.81% , -0.18%

Drainage Data = 20.2 Sq. Mi.
 Q25 = 1709 CFS
 Q100 = 2332 CFS

4601858