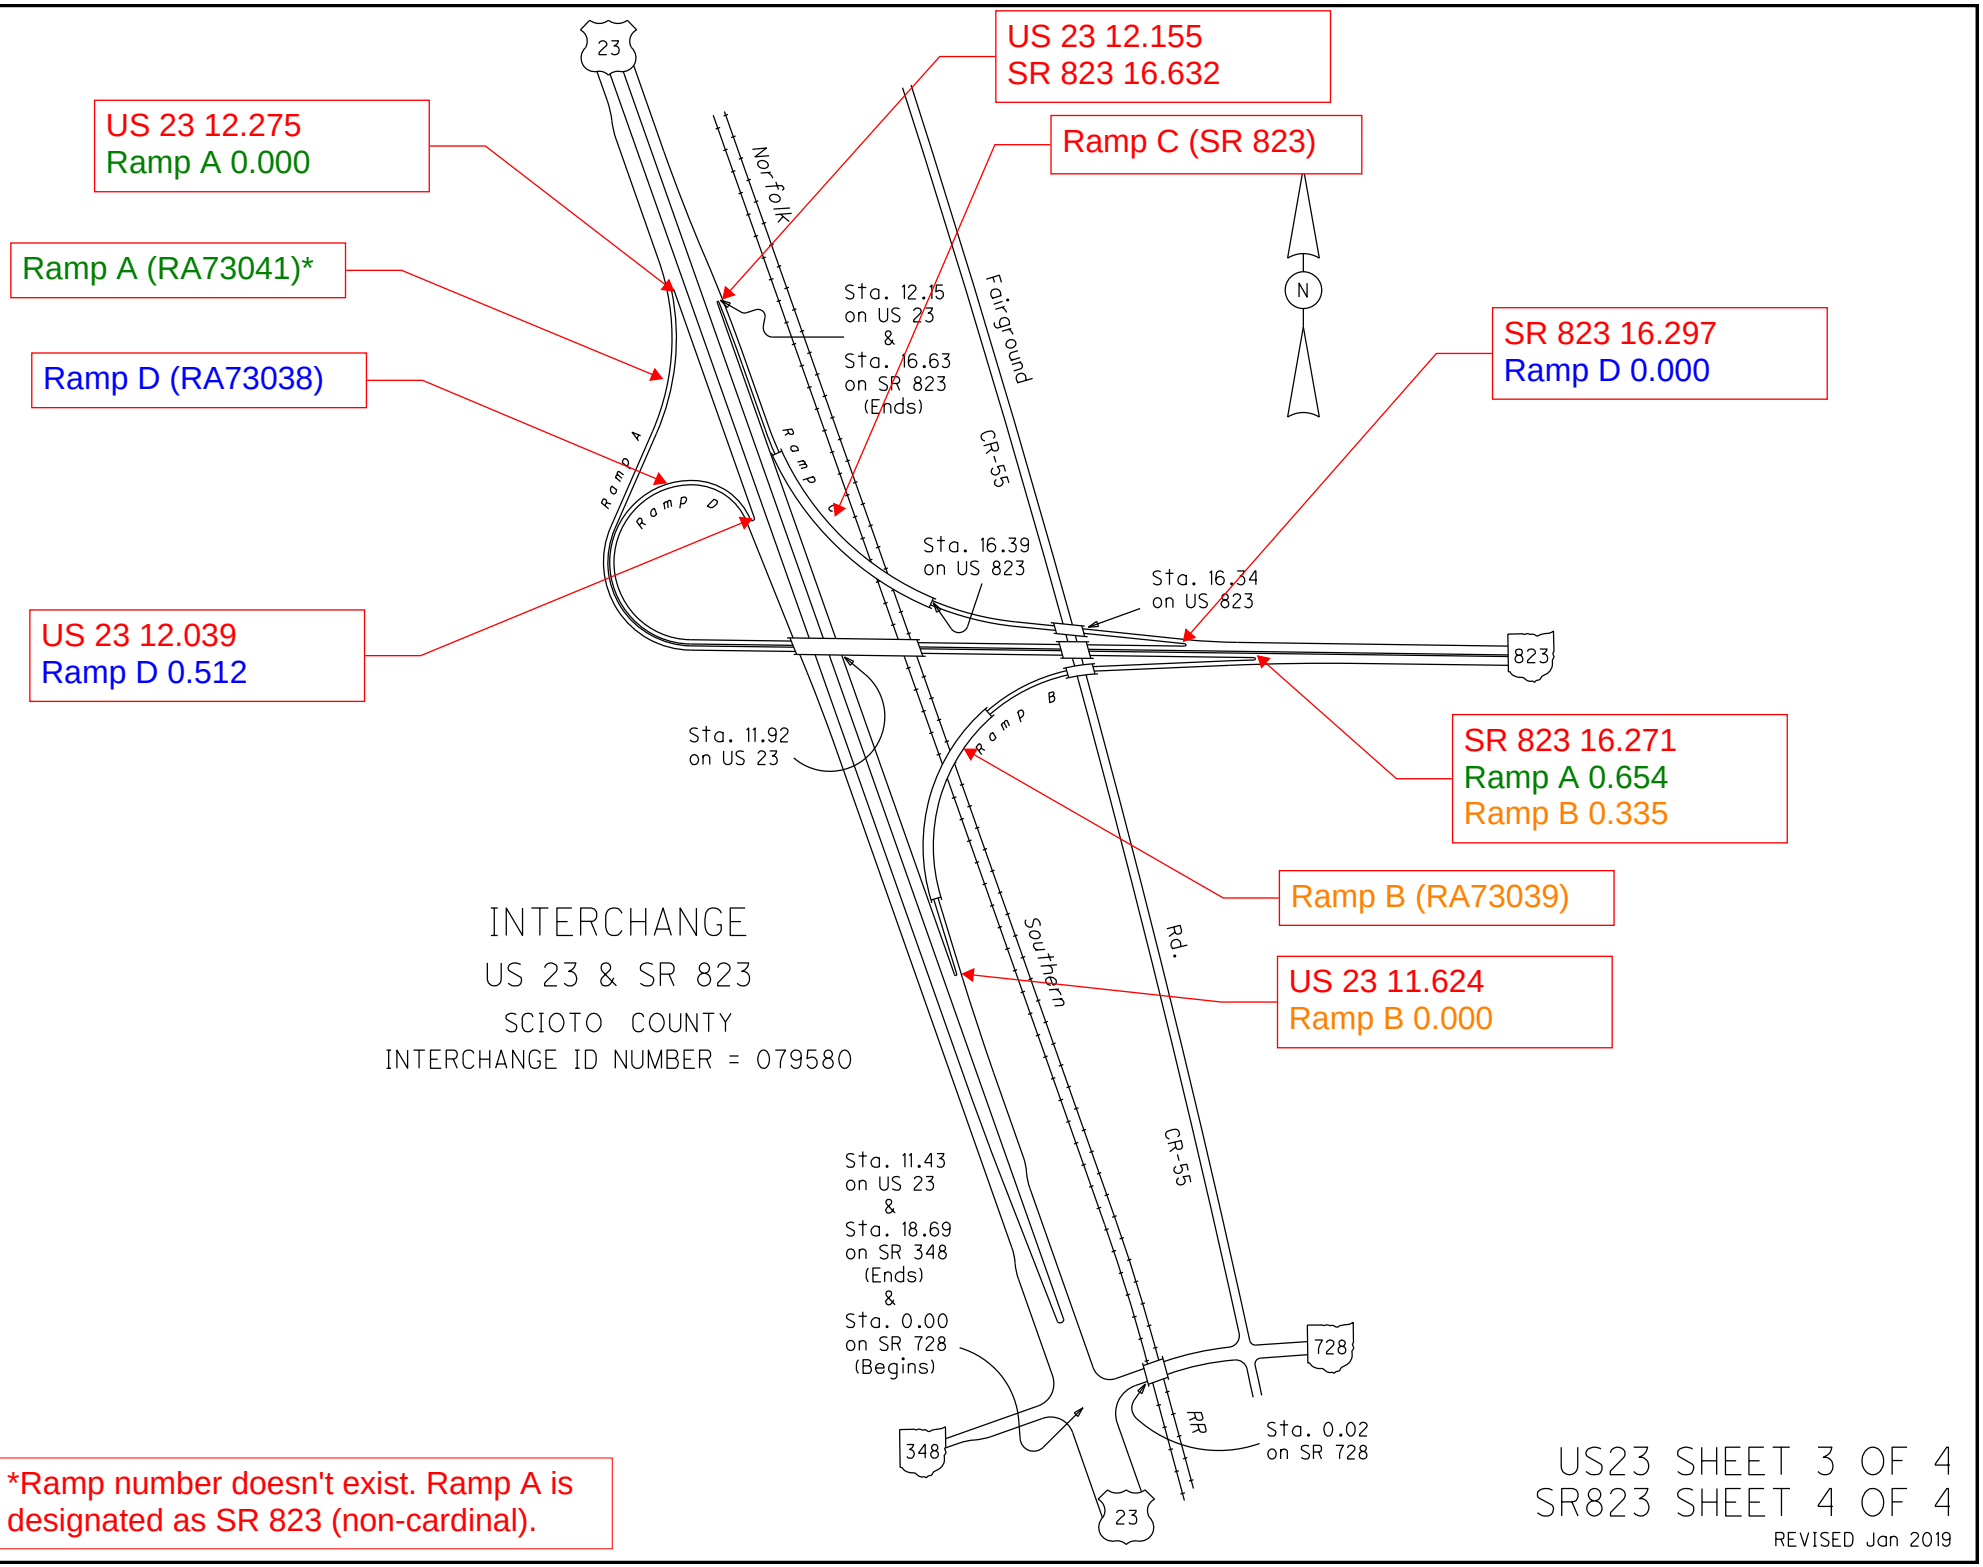

*Ramp number doesn't exist. Ramp A is designated as SR 823 (non-cardinal).

US23 SHEET 3 OF 4
SR823 SHEET 4 OF 4

REVISED Jan 2019