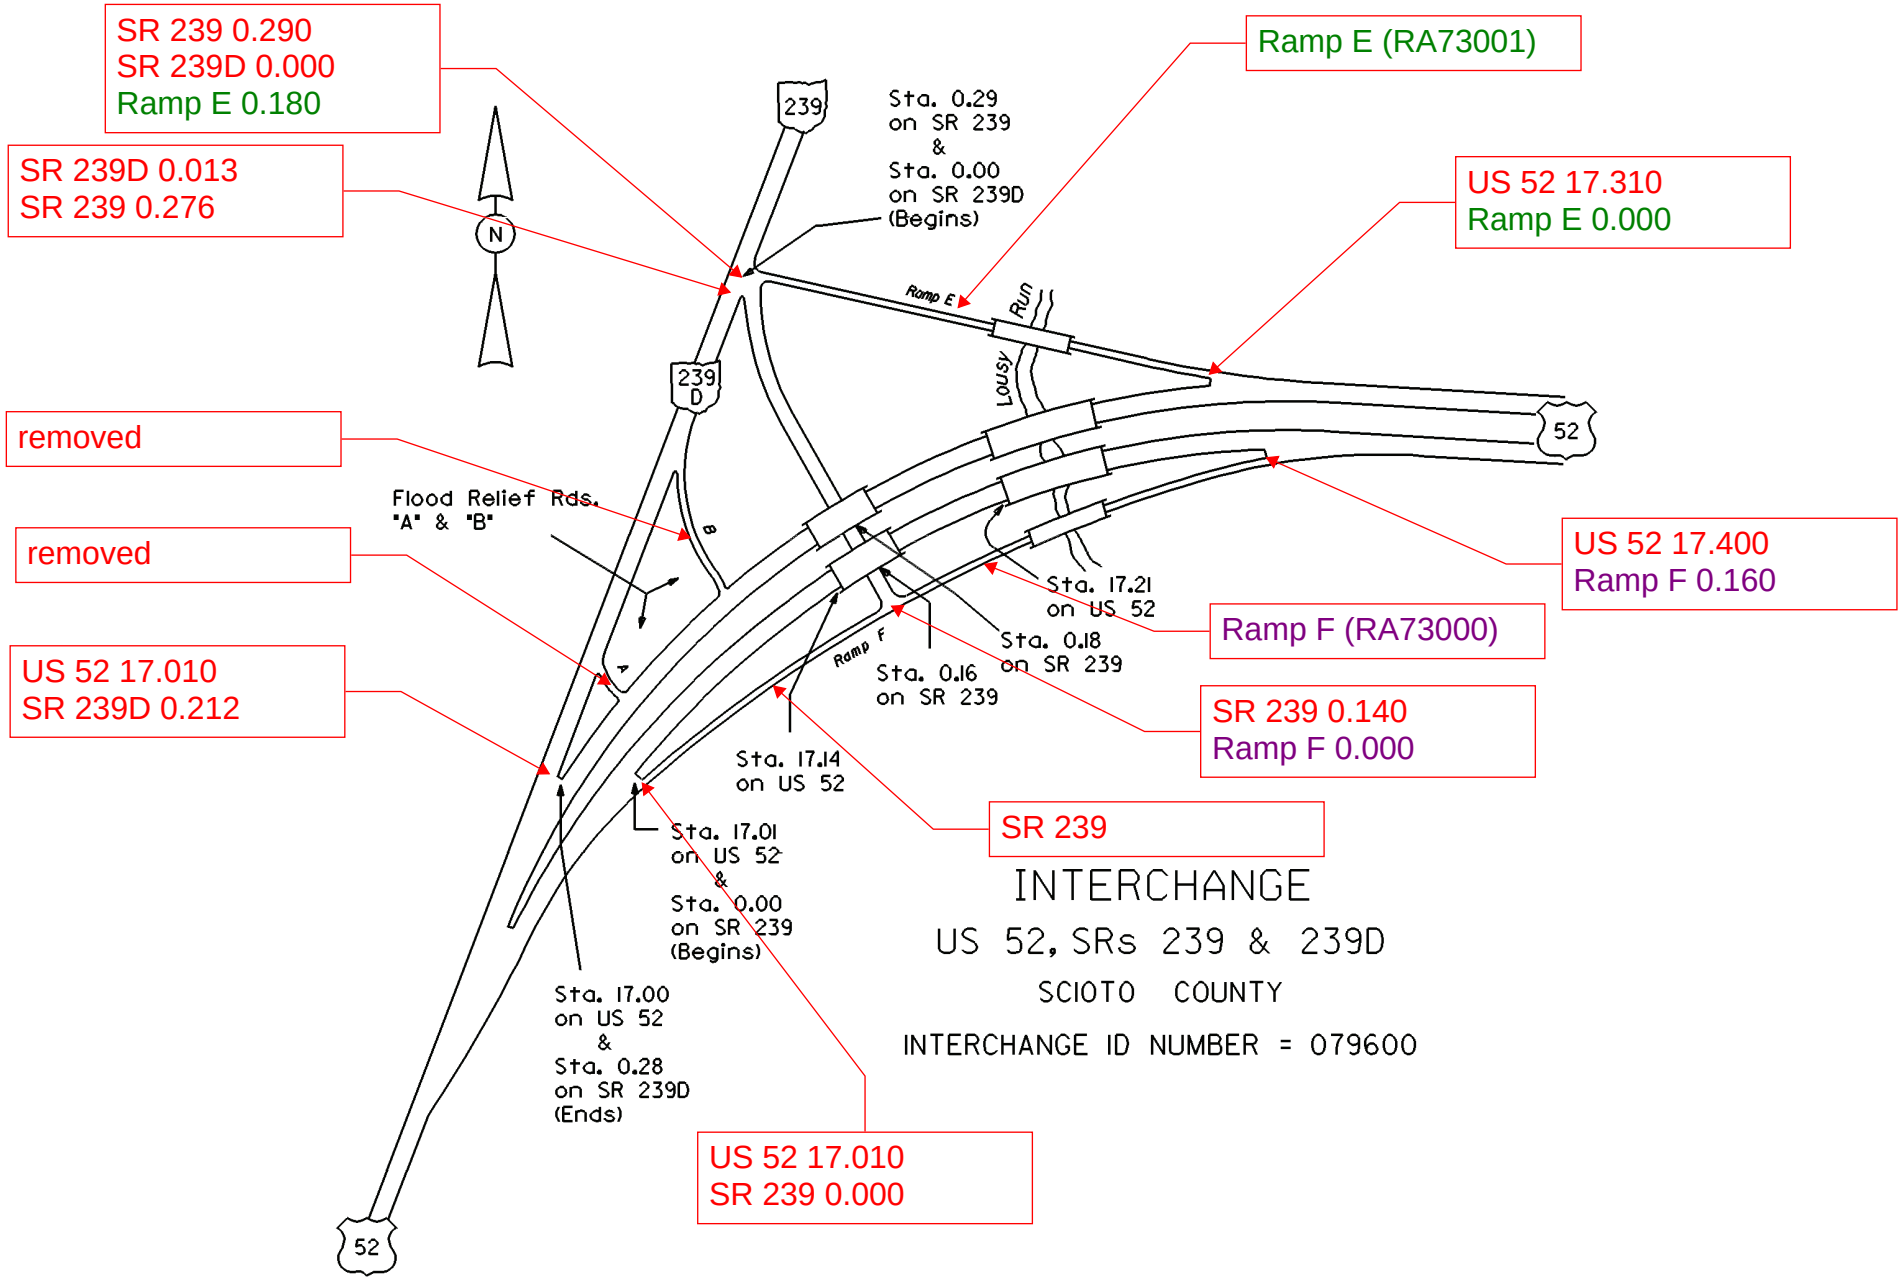

US52 SHEET 4 OF 8
SR239 SHEET 1 OF 1
SR239D SHEET 1 OF 1

REVISED Jan 2003