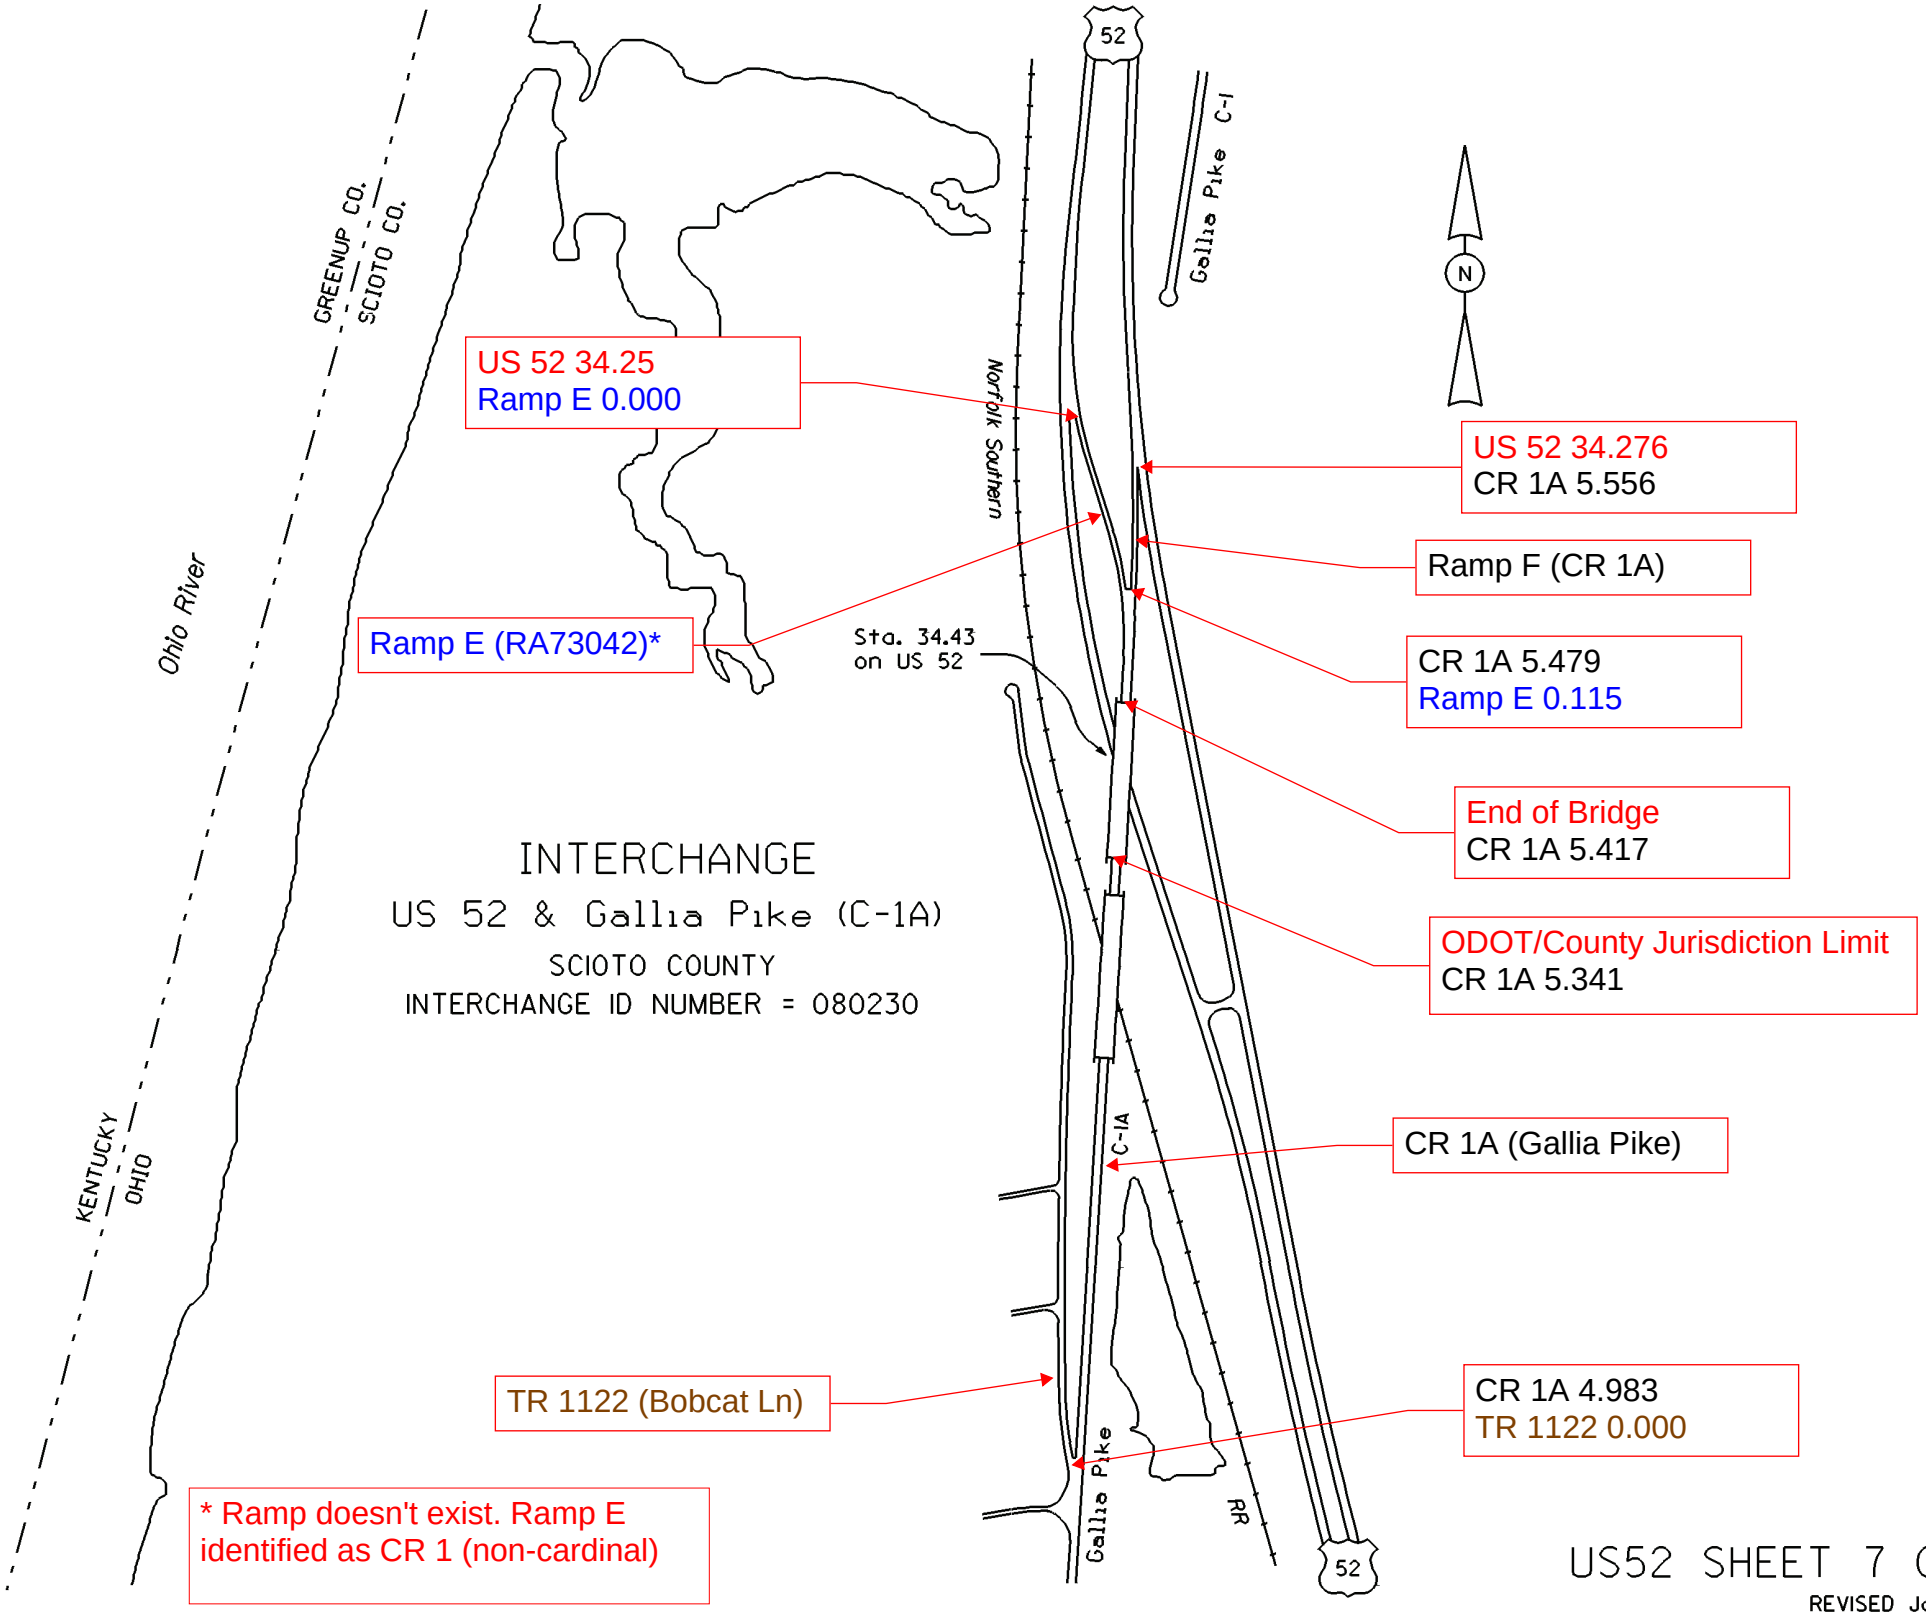

US52 SHEET 7 OF 8

REVISED Jan 2003