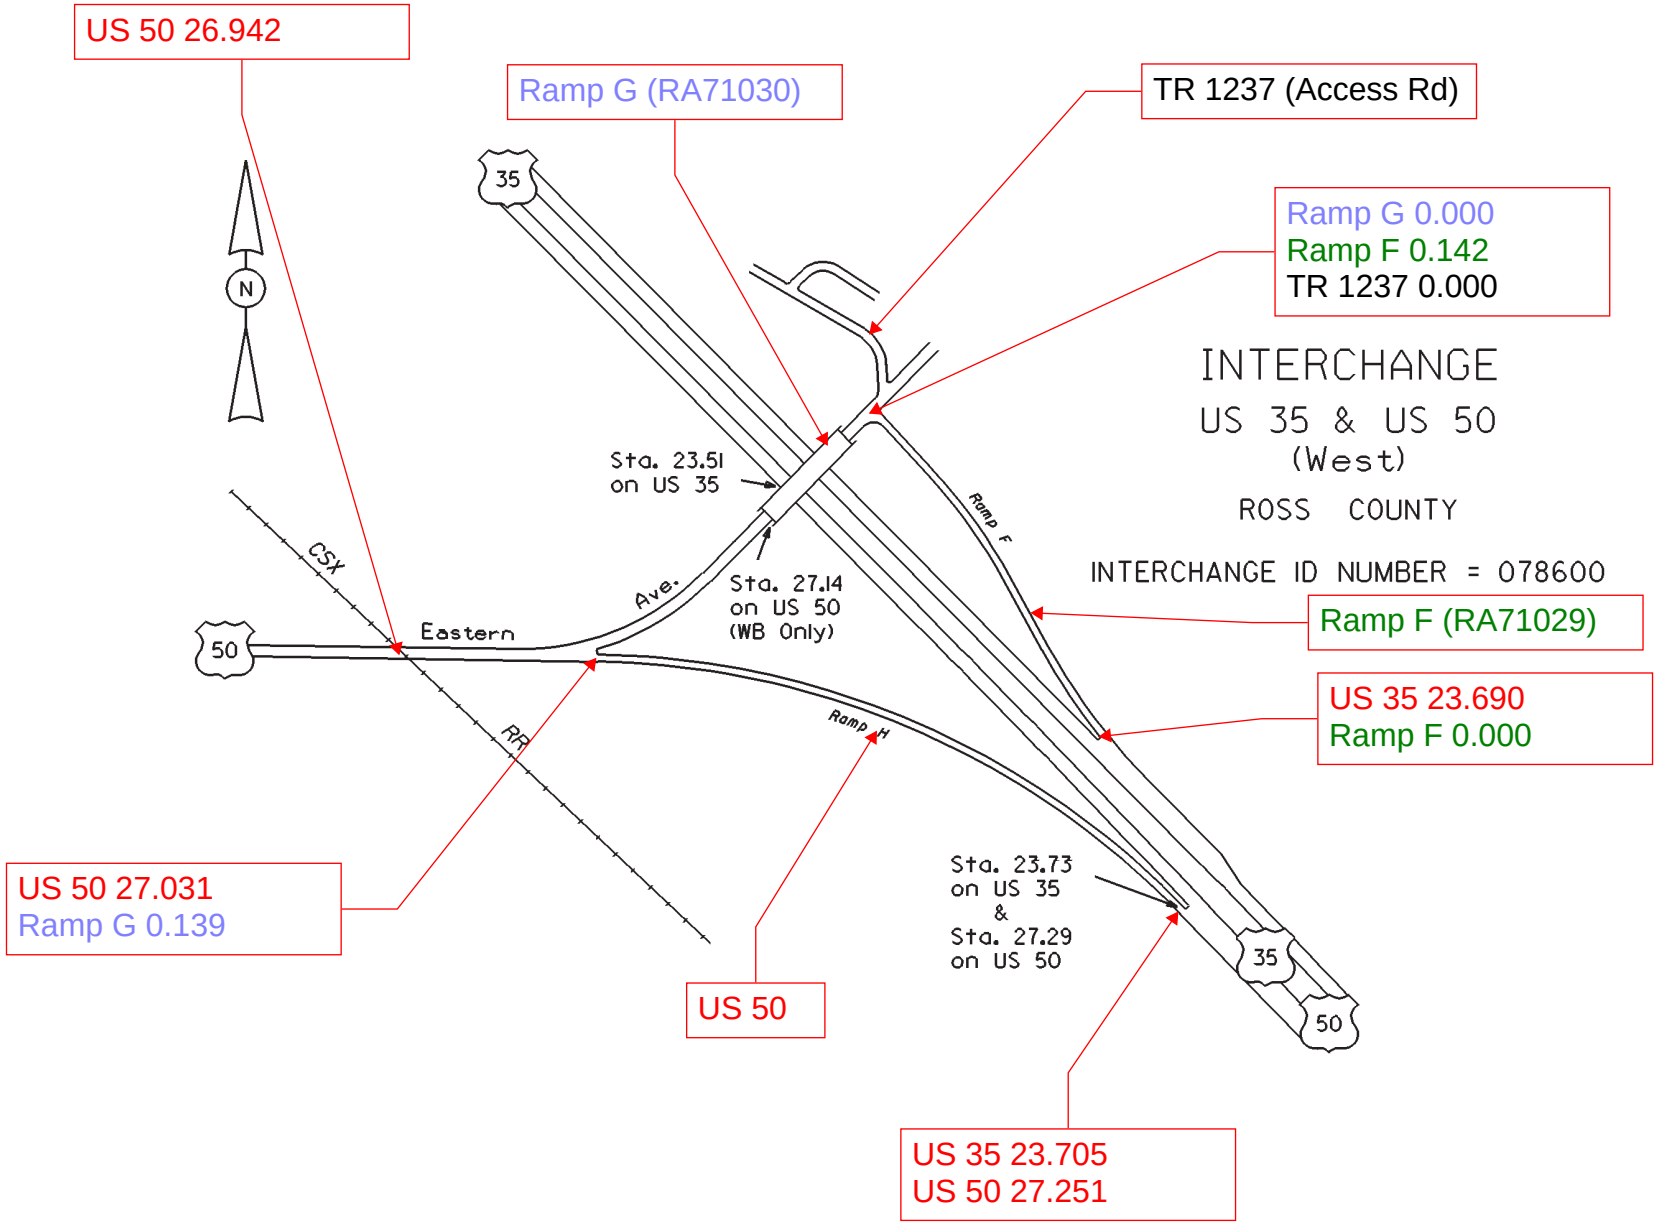

US35 SHEET 5 OF 8
US50 SHEET 6 OF 8

REVISED Jan 2003