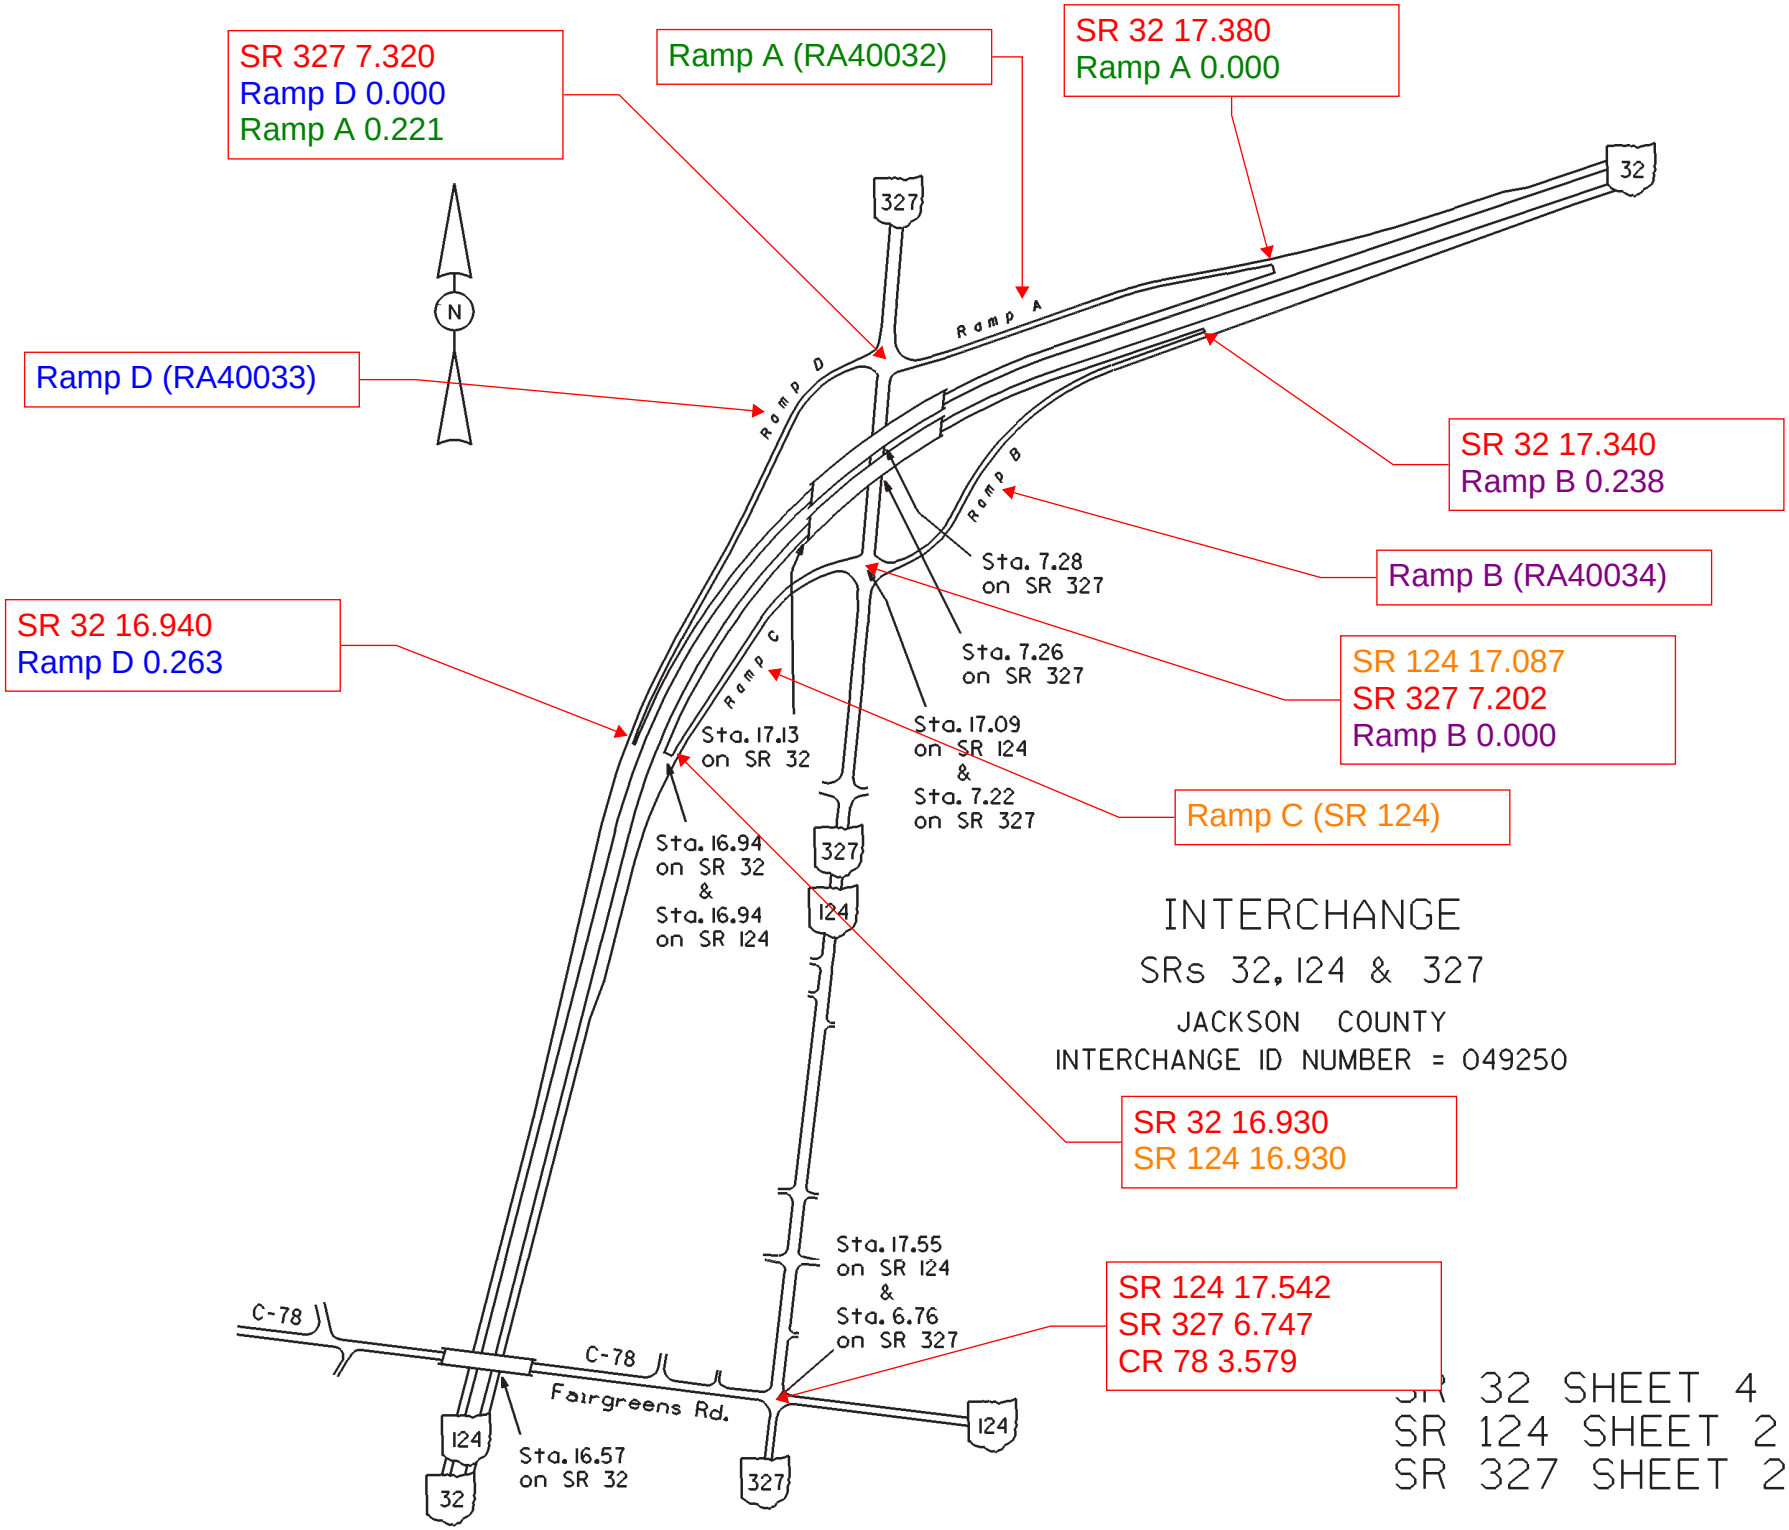

INTERCHANGE

SRs 32, 124 & 327

JACKSON COUNTY

INTERCHANGE ID NUMBER = 049250

SR 32 SHEET 4 OF 5
SR 124 SHEET 2 OF 3
SR 327 SHEET 2 OF 5

REVISED Jan 2005