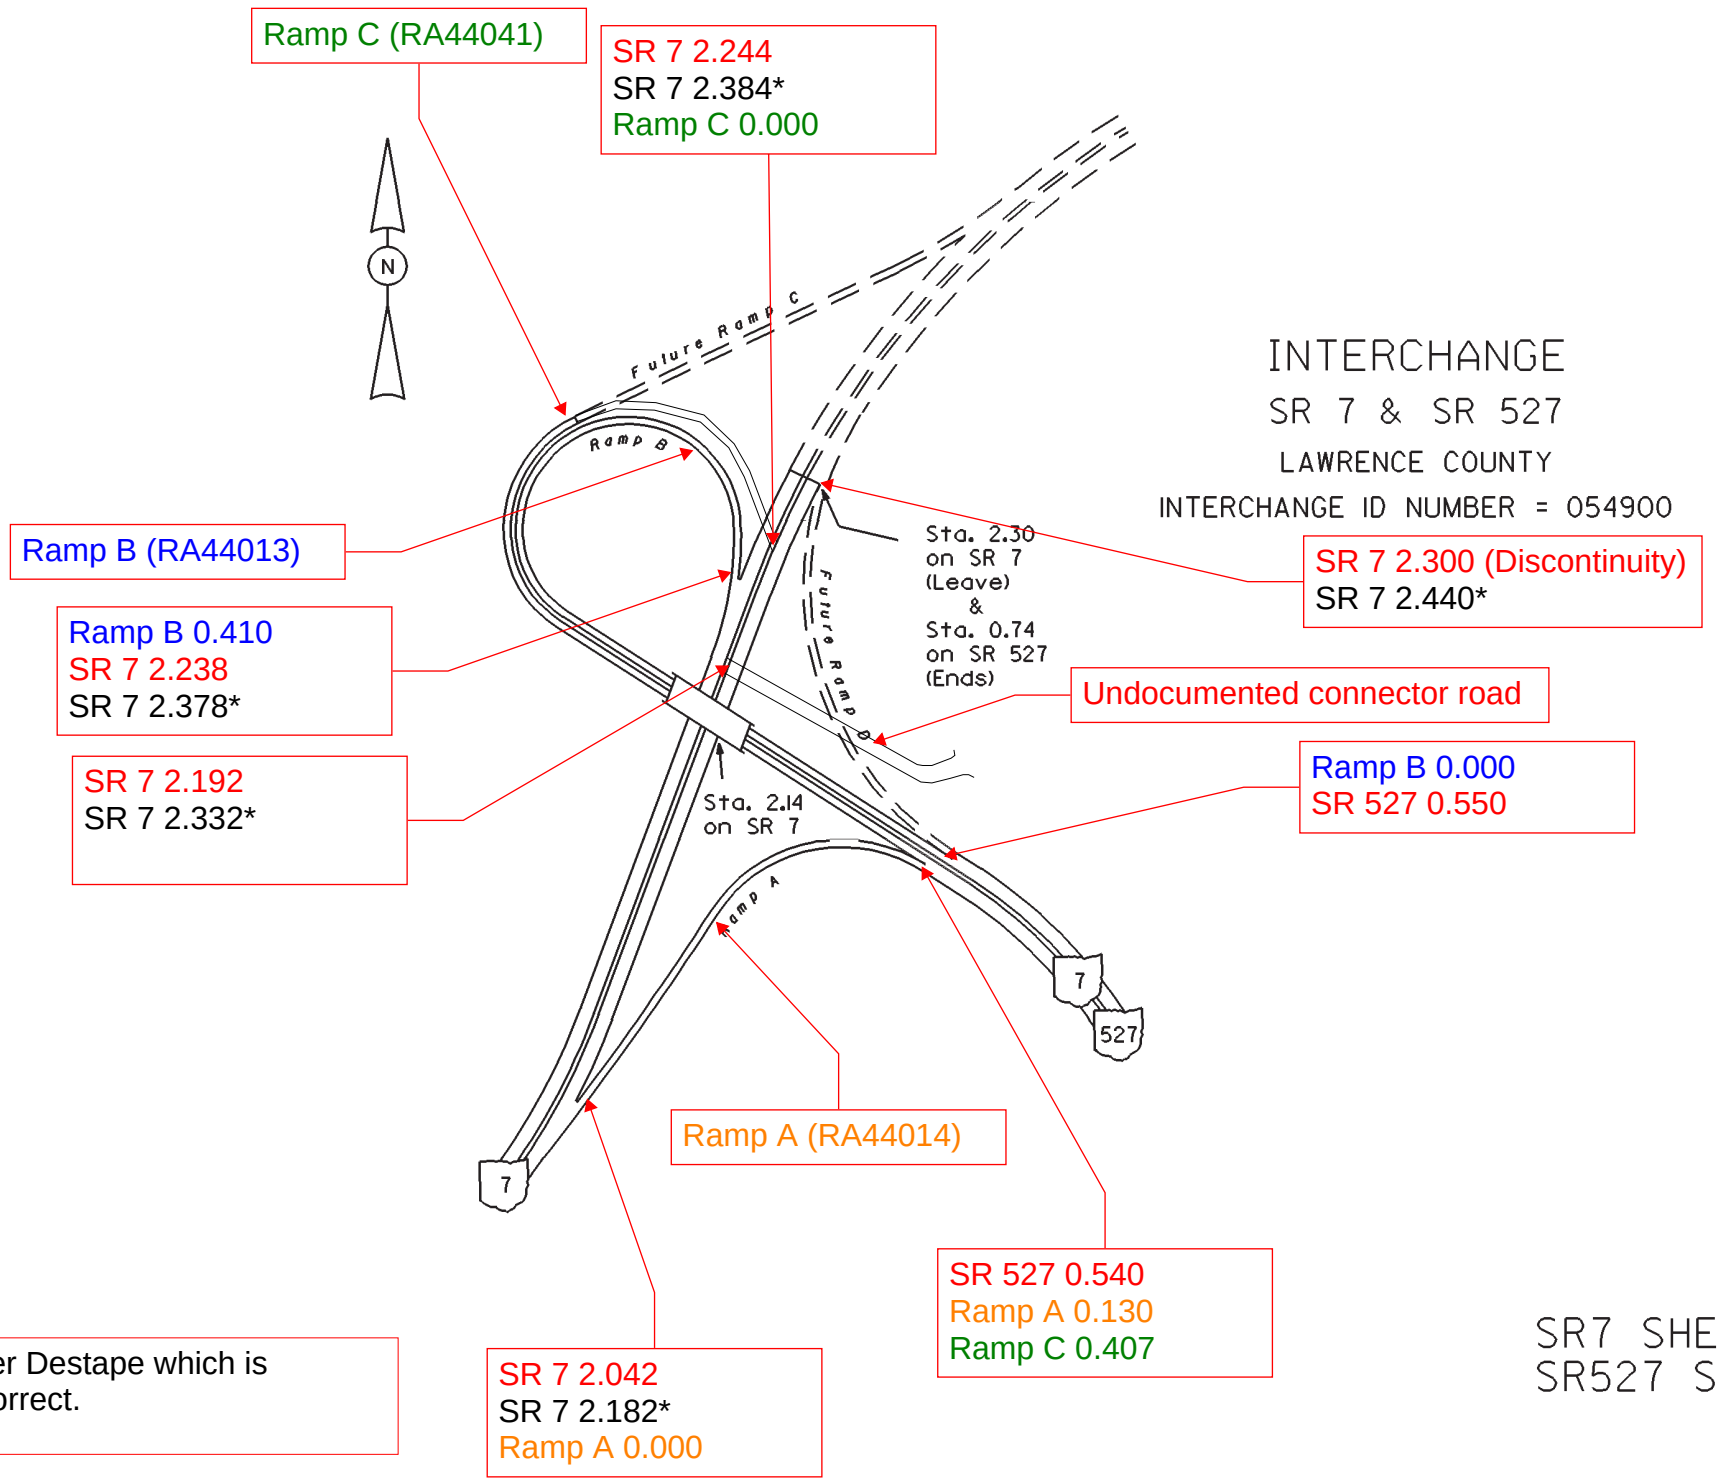

INTERCHANGE

SR 7 & SR 527

LAWRENCE COUNTY

INTERCHANGE ID NUMBER = 054900

SR7 SHEET 1 OF 5
SR527 SHEET 1 OF 1

REVISED Jan 2007