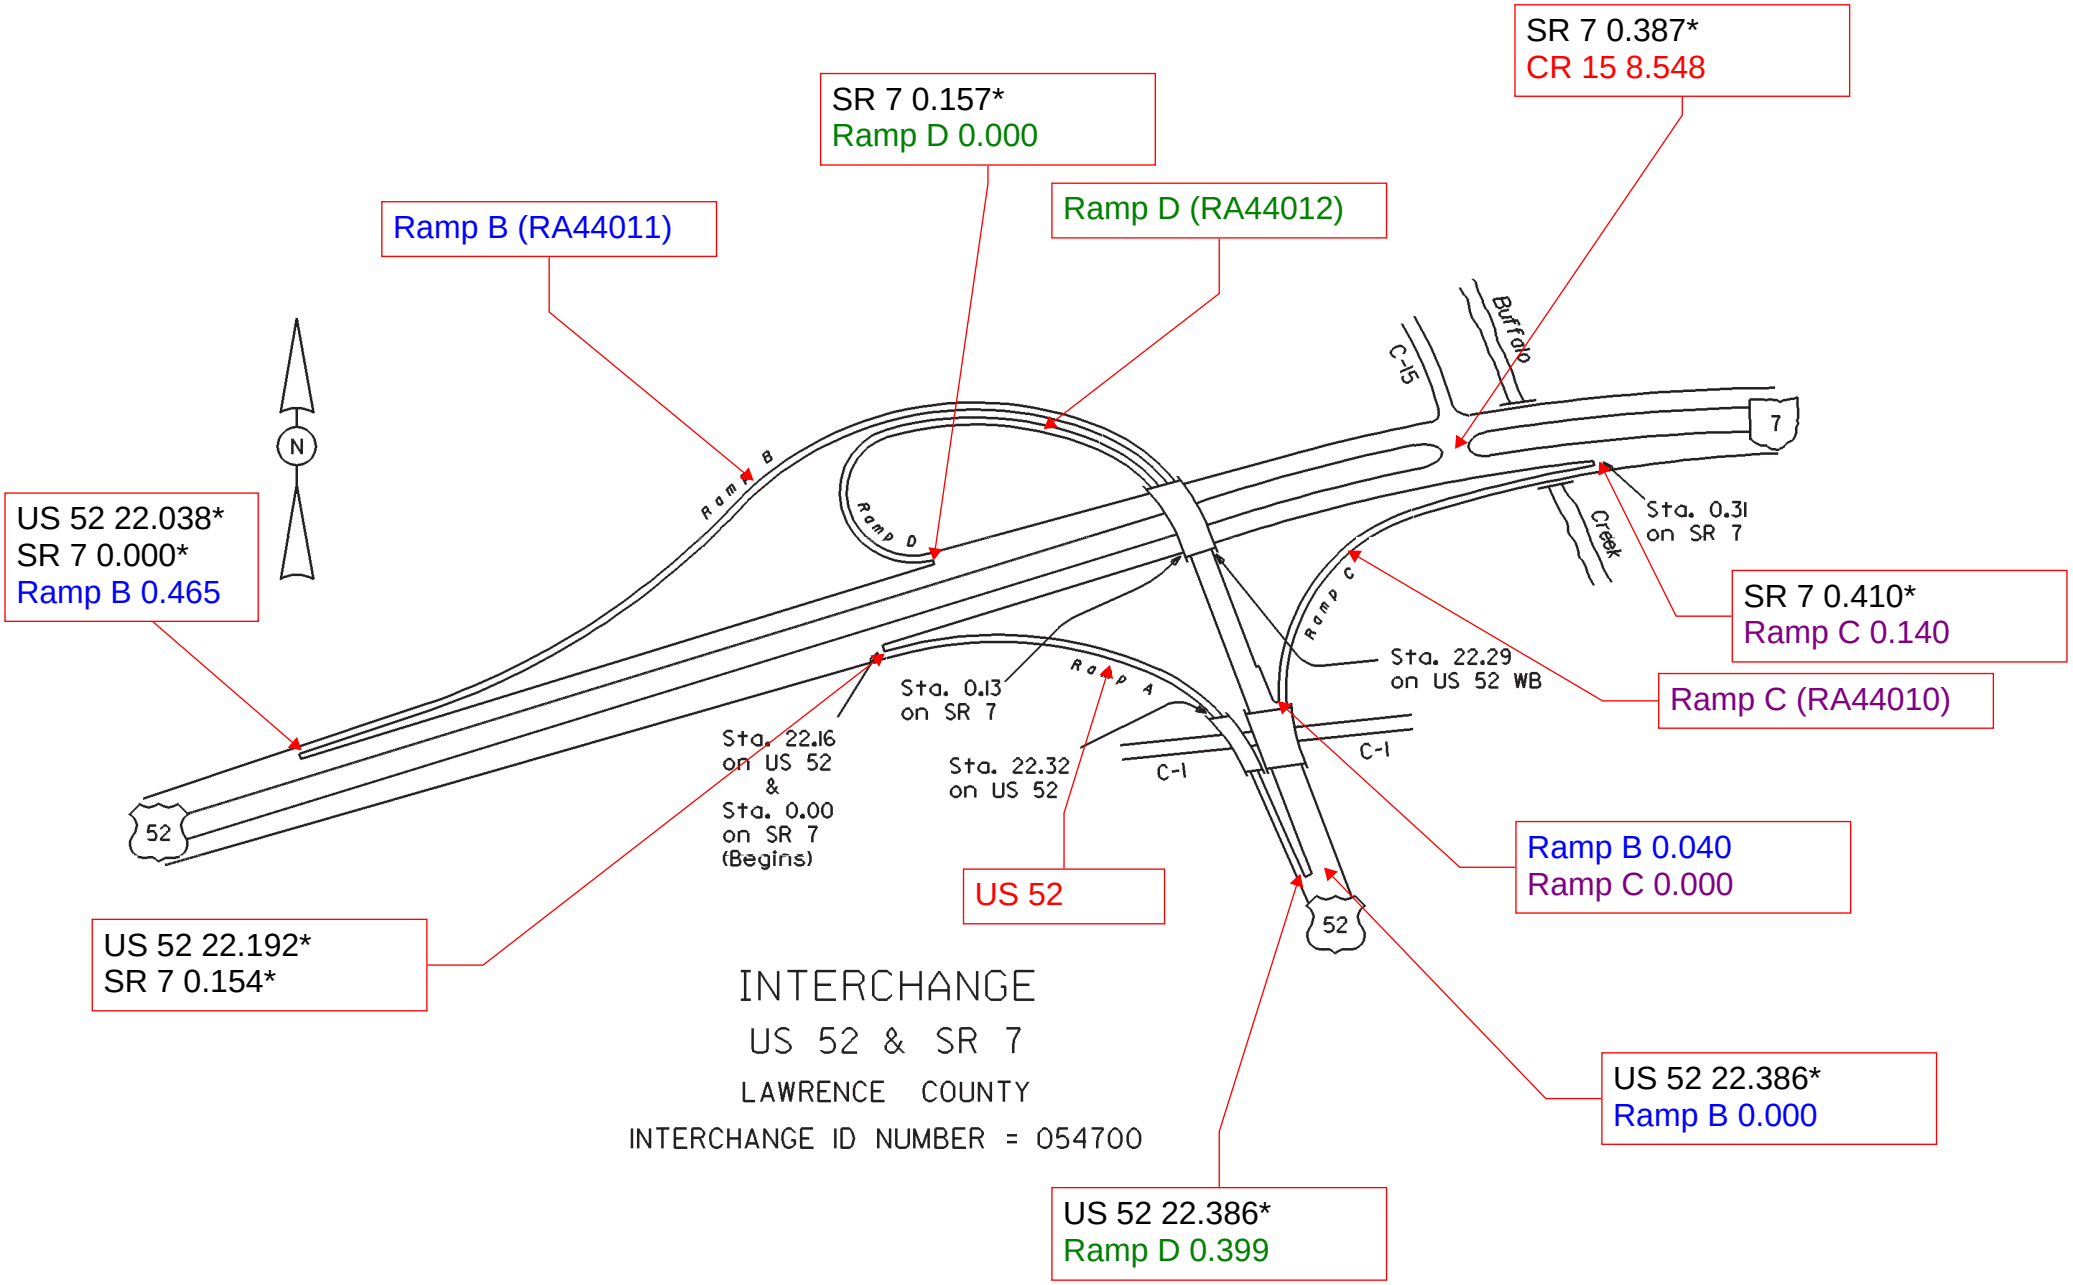

US52 SHEET 5 OF 5
SR7 SHEET 1 OF 5

REVISED Jan 2007

* per Destape which is incorrect. SR 7 should start at the EB off-ramp.