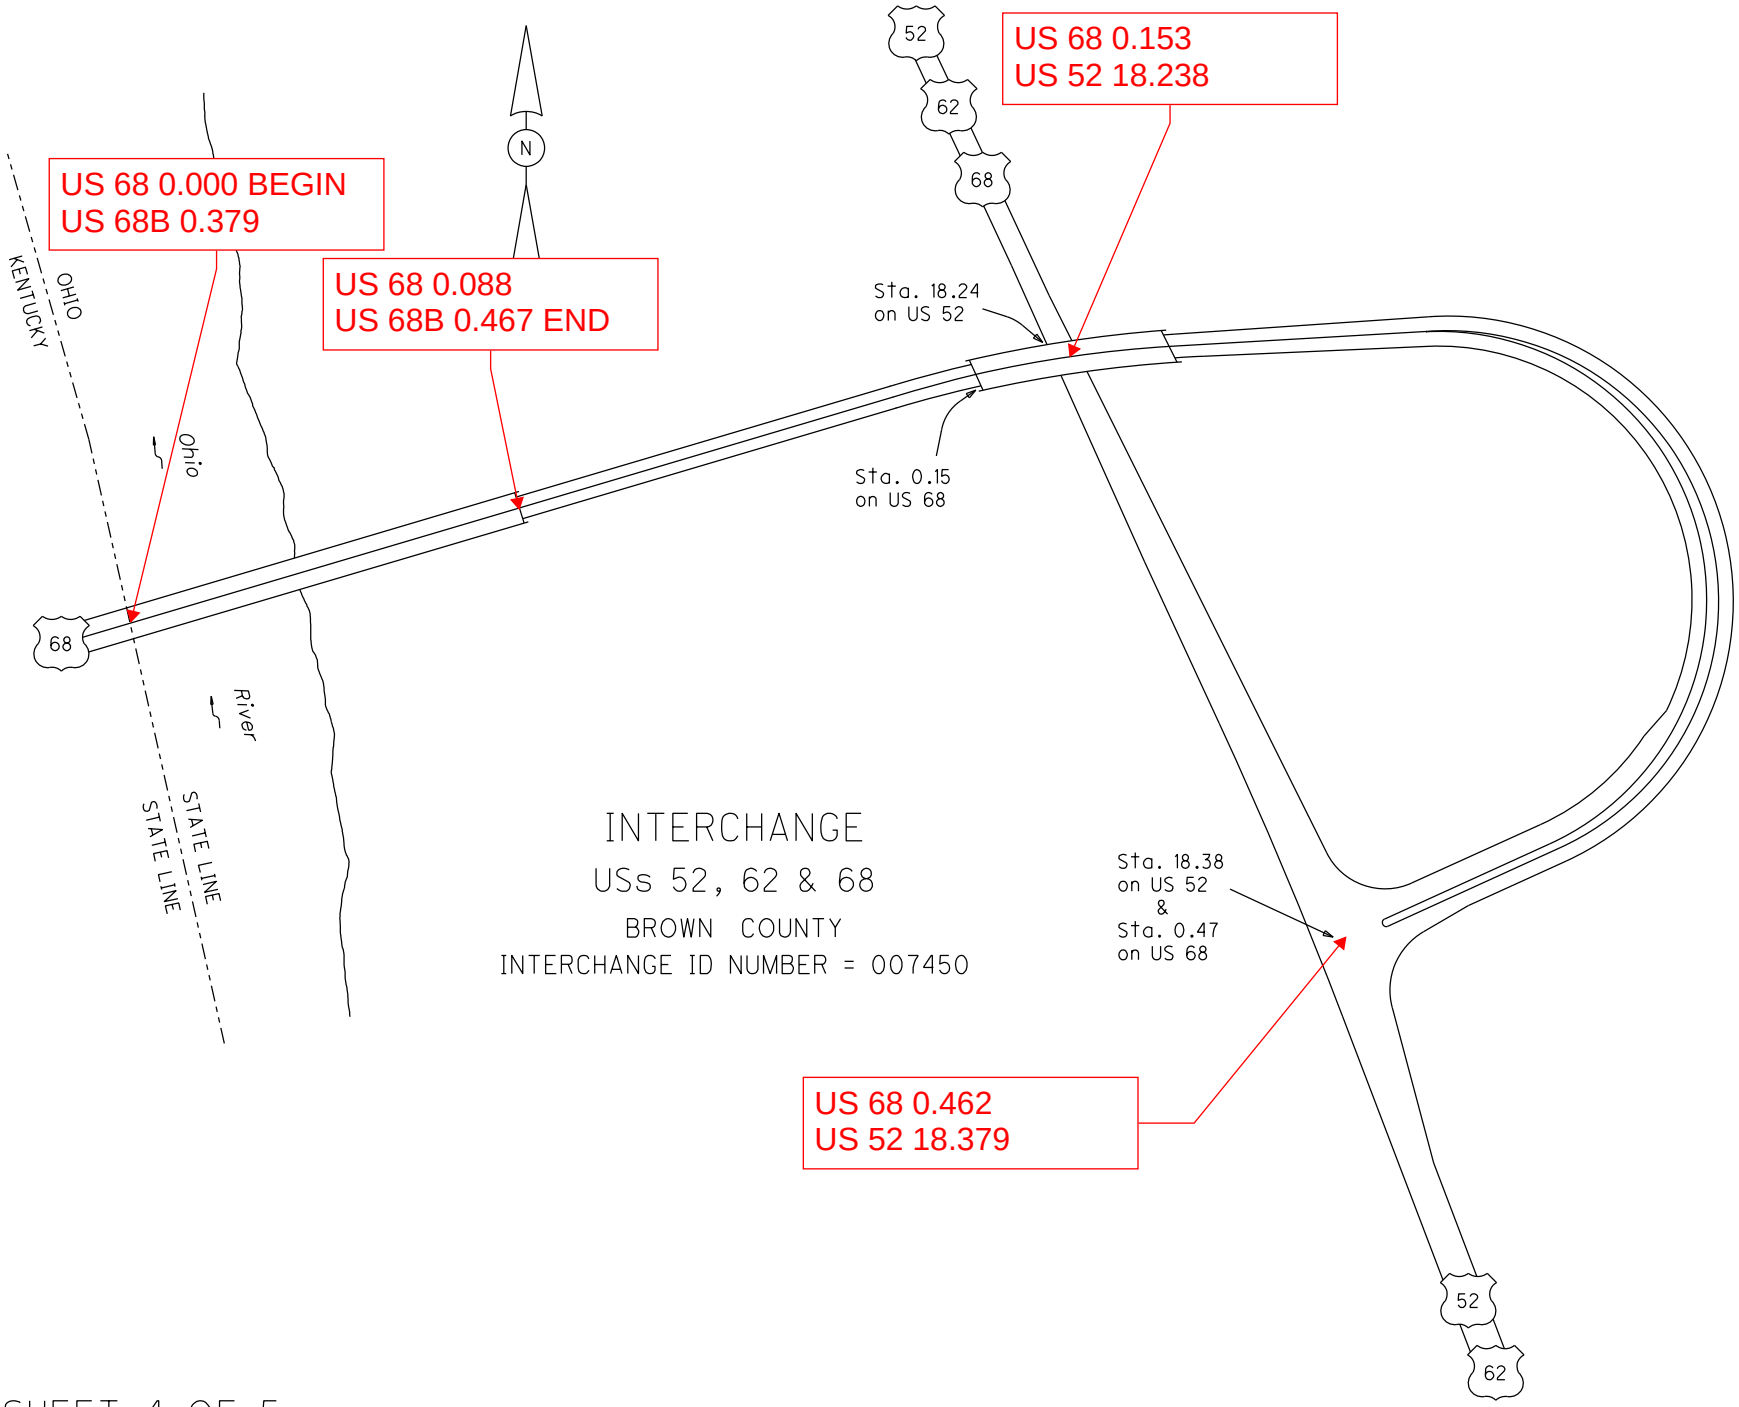

US52 SHEET 4 OF 5
US68 SHEET 1 OF 6

REVISED Jan 2013