


INDEX OF SHEETS

TITLE SHEET.....	1
INDEX OF SHEETS.....	2
TYPICAL SECTION.....	3
GENERAL NOTES.....	4-6
MAINTENANCE OF TRAFFIC NOTES.....	7-8
GENERAL SUMMARY.....	9
ADAMS SUB-SUMMARY.....	10
BROWN SUB-SUMMARY.....	11
LAWRENCE SUB-SUMMARY.....	12
ROSS SUB-SUMMARY.....	13
NO SPRAY AREAS SUMMARY.....	14
GUARDRAIL & SIGNPOST SPRAYING DETAILS.....	15
CURB & CONCRETE BARRIER SPRAYING DETAILS.....	16

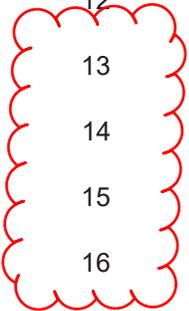

HERBICIDAL SPRAYING NONSELECTIVE VEGETATION CONTROL DATA FOR PIKE COUNTY

C O U N T Y	R O U T E	S L M		GUARDRAIL S P R A Y E D	CONCRETE D I V I D E R S P R A Y E D	CURB SPRAYED	TOTAL T R E A T E D				C O M M E N T S
		FROM	TO	MILE	MILE	MILE	ACRES				
		SLM	SLM								
PIK	23	0.00	7.08	4.17			1.68				SCIOTO C.L. TO PIKETON CORP.
PIK	23	8.29	11.61	5.27							PIKETON CORP. TO WAVERLY CORP.
PIK	23	13.26	16.28	2.33			0.94				WAVERLY CORP. TO ROSS C.L.
PIK	32	0.00	28.42	8.83	0.23		3.57				ADAMS C.L. TO JACKSON C.L.
PIK	41	0.00	5.39	0.57			0.23				HIGHLAND C.L. TO ROSS C.L.
PIK	104	0.00	12.20	14.21	0.08		5.74				SCIOTO C.L. TO WAVERLY CORP.
PIK	124	0.00	17.12	4.07			1.64				HIGHLAND C.L. TO S.R 32
PIK	220	0.00	7.03	2.93			1.18				SR 772 TO WAVERLY CORP.
PIK	220	8.01	8.14	0.08		0.10	0.07				WAVERLY CORP. TO WAVERLY CORP.
PIK	220	9.55	14.00	0.99			0.40				WAVERLY CORP TO S.R. 32 - SPRAY TOP OF CURB FROM 10.56 TO 10.66
PIK	335	0.00	6.90	1.25			0.51				SCIOTO C.L. TO BEAVER CORP.
PIK	335	7.90	24.78	4.33			1.75				BEAVER CORP. TO WAVERLY CORP.
PIK	551	0.00	2.87	0.67			0.27				BEGIN S.R. 220 TO S.R. 104
PIK	552	0.00	1.75	0.34			0.14				BEGIN S.R. 220 TO S.R. 104
PIK	772	0.00	9.29	2.23			0.90				SCIOTO C.L. TO S.R. 32
PIK	772	13.62	24.02	1.13			0.46				S.R. 124 TO ROSS C.L.
PIK	776	0.00	0.99	0.05			0.02				SCIOTO C.L. TO JACKSON C.L.
TOTALS FOR THIS SHEET				53.45	0.31	0.10	19.51				
SUB-TOTALS				53.86							
TOTALS CARRIED TO GENERAL SUMMARY				54							

Herbicideal NO SPRAY areas					Description
County	Route	Section	LT/RT		
Ada	41	0.47	0.57		No Spray Signs
Ada	41	30.80			Oscad Entrance (Small Area)
Ada	52	3.80	4.10		Moyer's Vineyard
Ada	52	4.90	5.20		No Spray Signs
Ada	125	15.60	15.80		No Spray Area
Ada	125	18.00	18.26		No Spray Signs
Ada	136	9.95	10.30		Wildflower Area
Ada	247	12.90	13.50	RT	Organic Farm
Ada	781	3.70	3.80		No Spray Signs
Bro	41	1.49	1.56		No Spray Signs
Bro	50	1.00	1.27		Vinyard
Bro	50	3.80	3.81		No Spray Requested by property owner
Bro	52	1.80	1.90		No Spray Requested by property owner
Bro	52	3.39	3.43		No Spray Signs
Bro	52	5.70	5.80		No Spray Requested by property owner
Bro	52	9.39	9.55		No Spray Signs
Bro	52	10.30	10.32	LT & RT	No Spray Requested by property owner
Bro	52	16.50	16.53		No Spray Signs
Bro	68	36.00	37.36	LT & RT	
Bro	68	37.70	38.18		No Spray Signs
Bro	68	43.30	43.39		No Spray Requested by property owner
Bro	125	0.27	0.40	RT	No Spray Requested by property owner
Bro	221	0.04	0.08	LT	No Spray Requested by property owner
Bro	221	5.50	5.55		No Spray Area
Bro	251	3.80	4.01		No Spray Area
Bro	286	3.48	3.55	LT	No Spray Requested by property owner
Bro	286	4.21	4.34		No Spray Requested by property owner
Bro	774	3.40	3.42		No Spray Requested by property owner
Law	7	14.90	15.50	LT	Greenhouse
Law	7			LT	Village of Millersport - Orchard
Law	7	16.60		LT	Tobacco Bed
Law	217	11.30		RT	Tobacco Bed
Law	217	12.60	12.90	LT	Orchard
Law	217	17.53	(SR 7)	LT	Orchard
Law	218	0.20		LT & RT	Tobacco Bed
Law	218	0.90		RT	Tobacco Bed
Law	218	1.70		LT	Tobacco Bed
Law	218	2.10		LT	Tobacco Bed
Law	378	6.30		RT	Tobacco Bed
Law	522	8.10		RT	Tobacco Bed
Law	775	6.90			Greenhouse and Tobacco Bed
Law	775	10.80		LT	Tobacco Bed
Law	775	11.10		LT	Tobacco Bed
Law	775	12.10		LT	Tobacco Bed
Law	775	13.70		RT	Tobacco Bed
Law	775	14.20	14.95	LT	Tobacco Bed
Law	775	18.30		LT	Tobacco Bed
Law	775	19.10		LT	Tobacco Bed
Ros	23	0.37		RT	Shelley's Nursery
Ros	28		Lattaville	RT	Village of Lattaville - Grapevines
Ros	28	10.90		RT	Grapevines
Ros	41	9.35		LT	Vineyard
Ros	50	20.80		RT	Nursery and Greenhouse
Ros	159	10.20		RT	Greenhouse and Shrubs
Ros	327	5.50	5.70	RT	Do Not Spray
Ros	207	1.02		LT	Fruit Trees
Ros	207	3.50	3.75	LT & RT	Do Not Spray
Ros	207	4.70	4.80	RT	Do Not Spray
Ros	772		Address 13823	RT	Richard Senter Residence
Ros	772	12.70	13.30	LT & RT	Hirsch Fruit Farm