




PLAN - SR-315
STA. 296+00 TO STA. 301+00

CROSS REFERENCES	SEE SHEETS
DRAINAGE DETAILS	P.112 - P.116
DRIVE DETAILS	P.104 - P.111
PAVEMENT DETAILS	P.017 - P.018
REMOVALS	P.044 - P.048

DESIGN AGENCY	2LMN
DESIGNER	KAZ
REVIEWER	DES 01/09/24
PROJECT ID	113662
SHEET	P.050
TOTAL	129

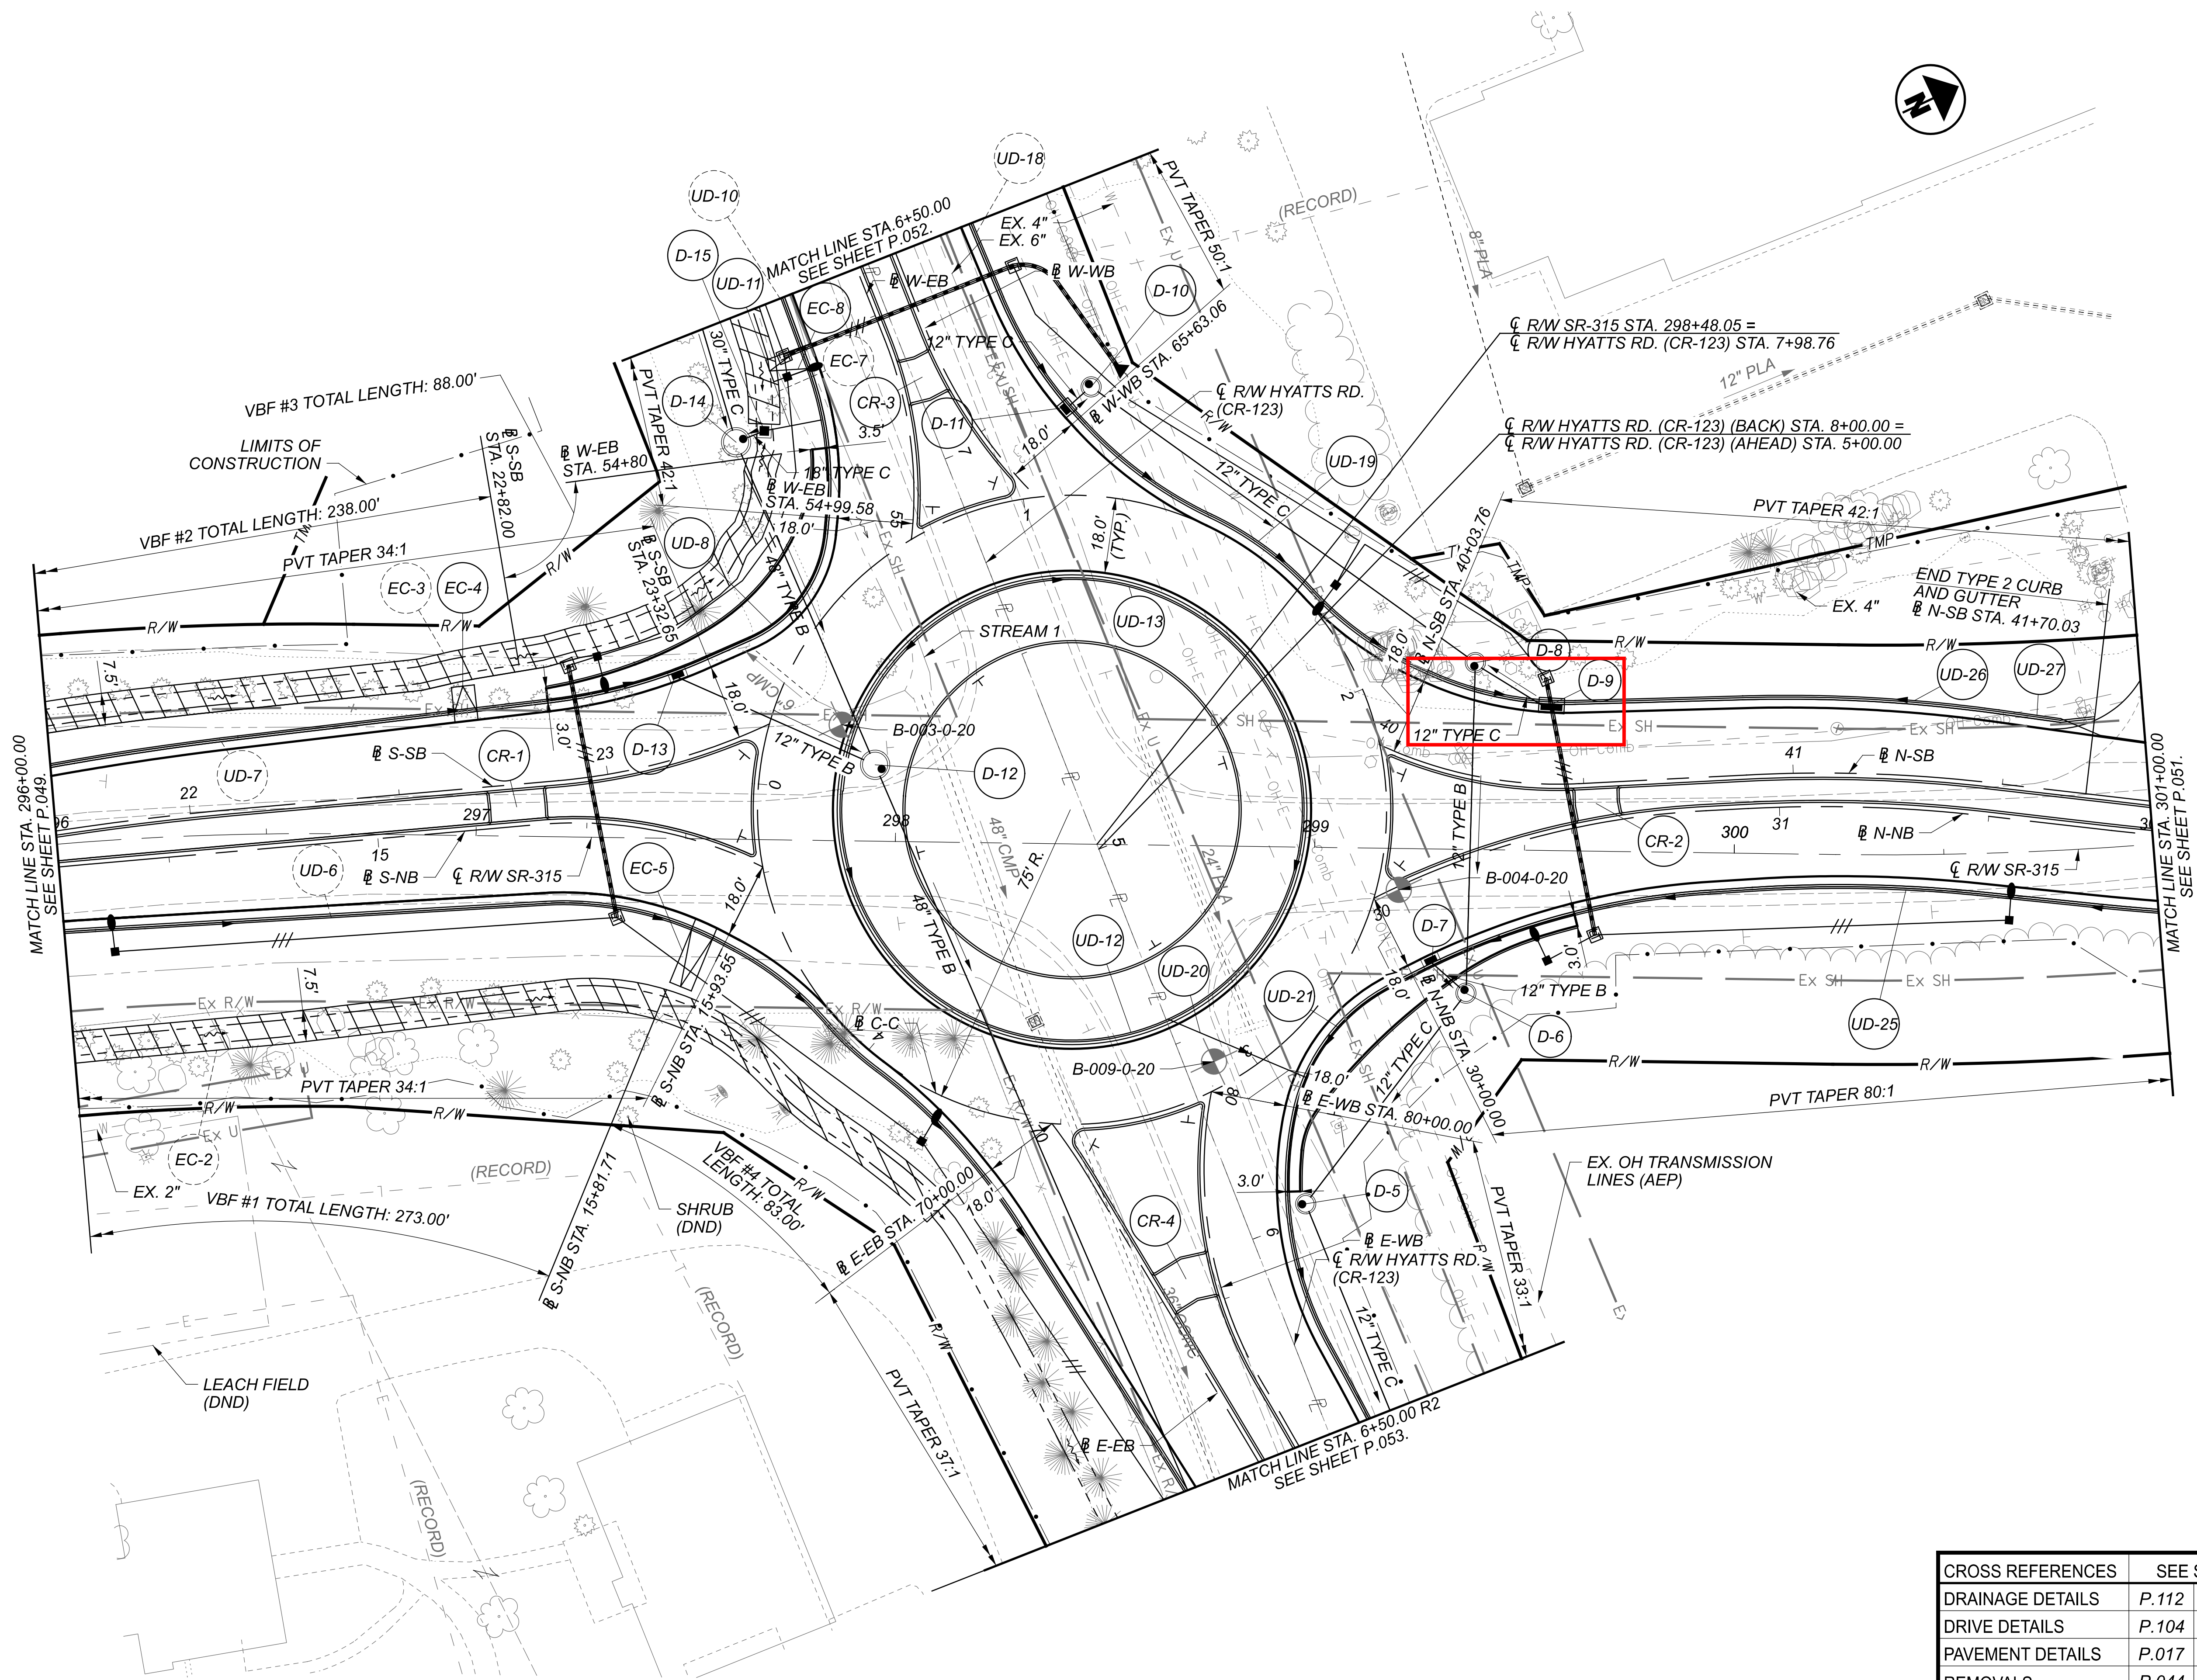

HORIZONTAL
SCALE IN FEET

PAVEMENT DETAILS INTERSECTION DETAIL

DESIGN AGENCY


2LMN

DESIGNER
KAZ


REVIEWER
DES 01/09/24

PROJECT ID
113662


SHEET	TOTAL
P.097	12

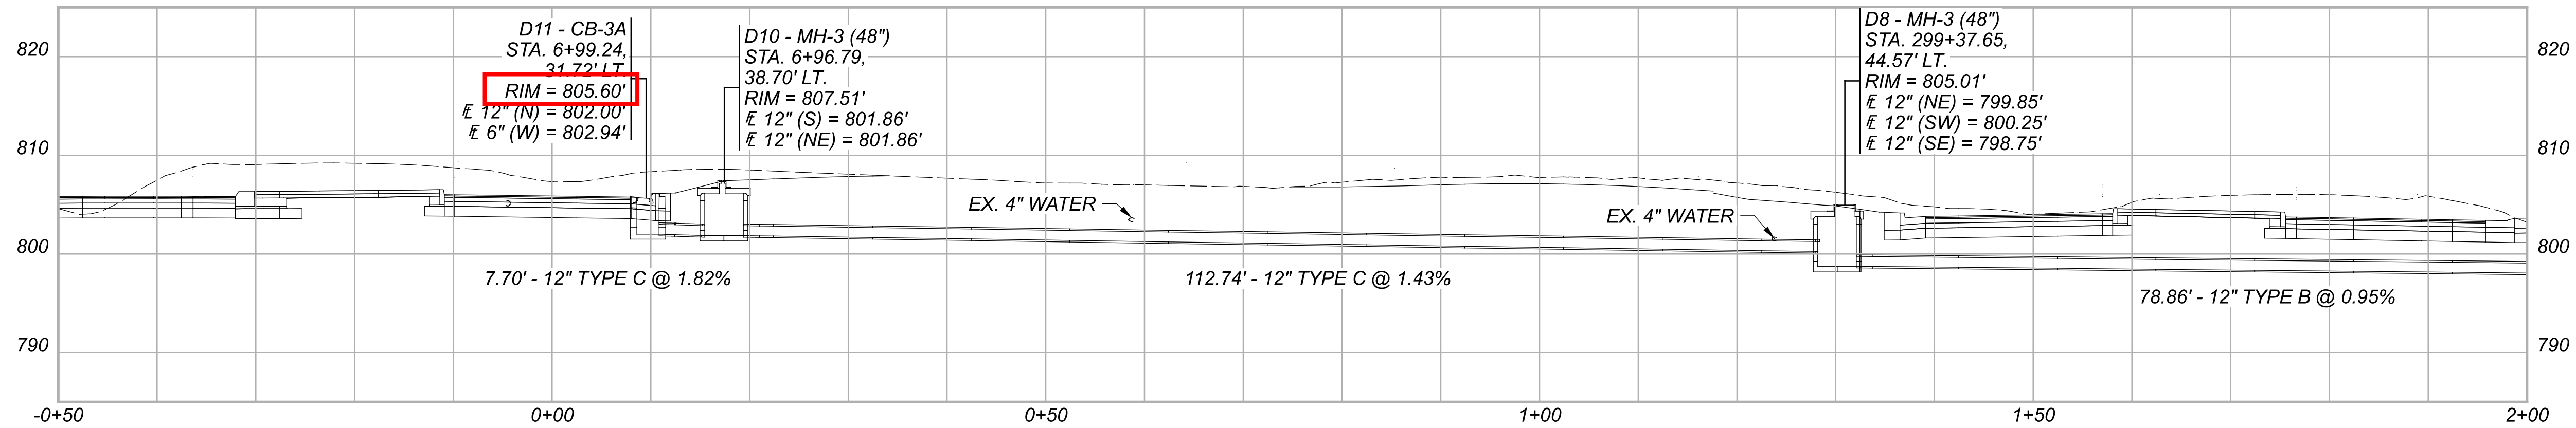


D11 - D8

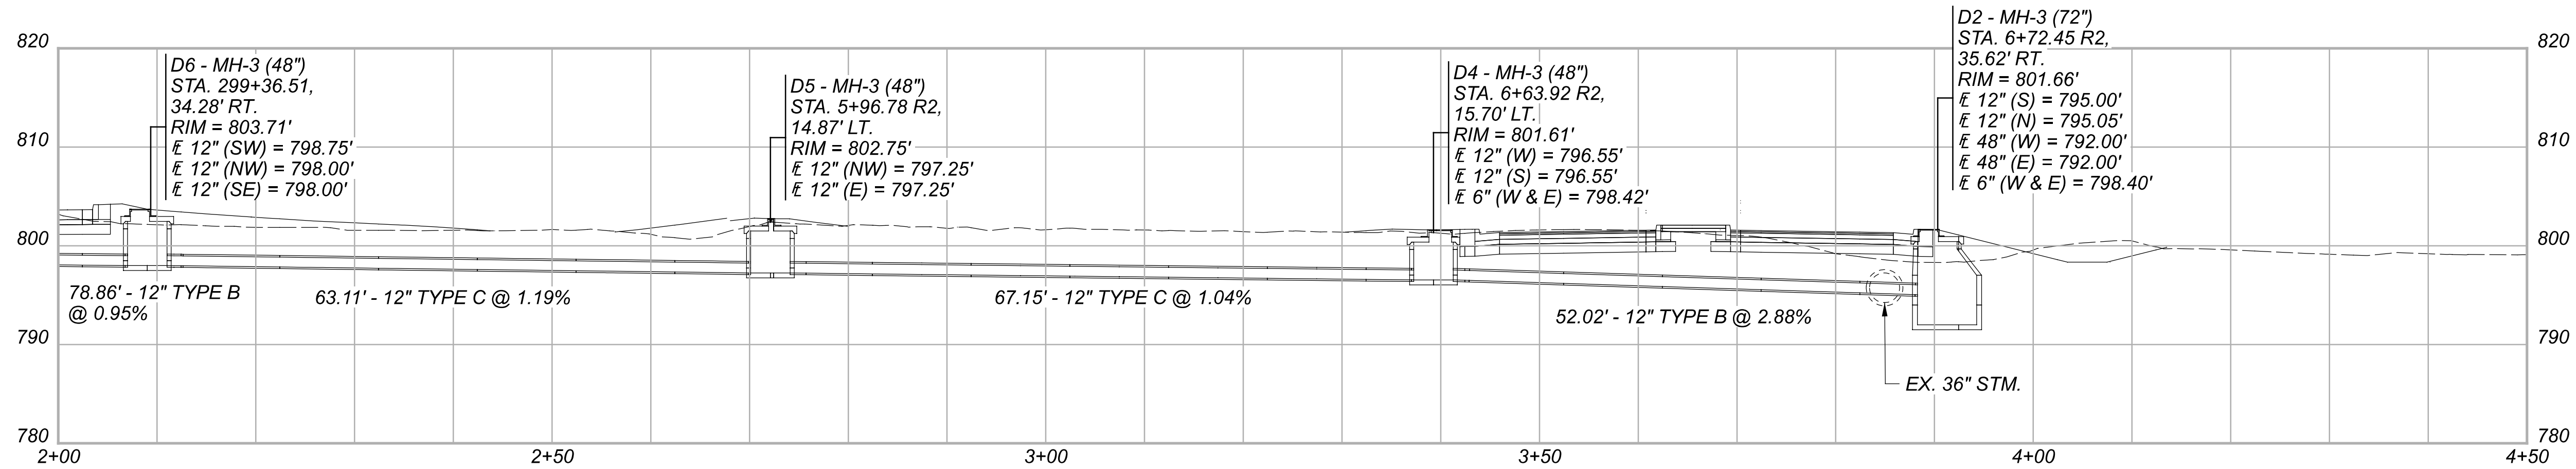

D6 - D2

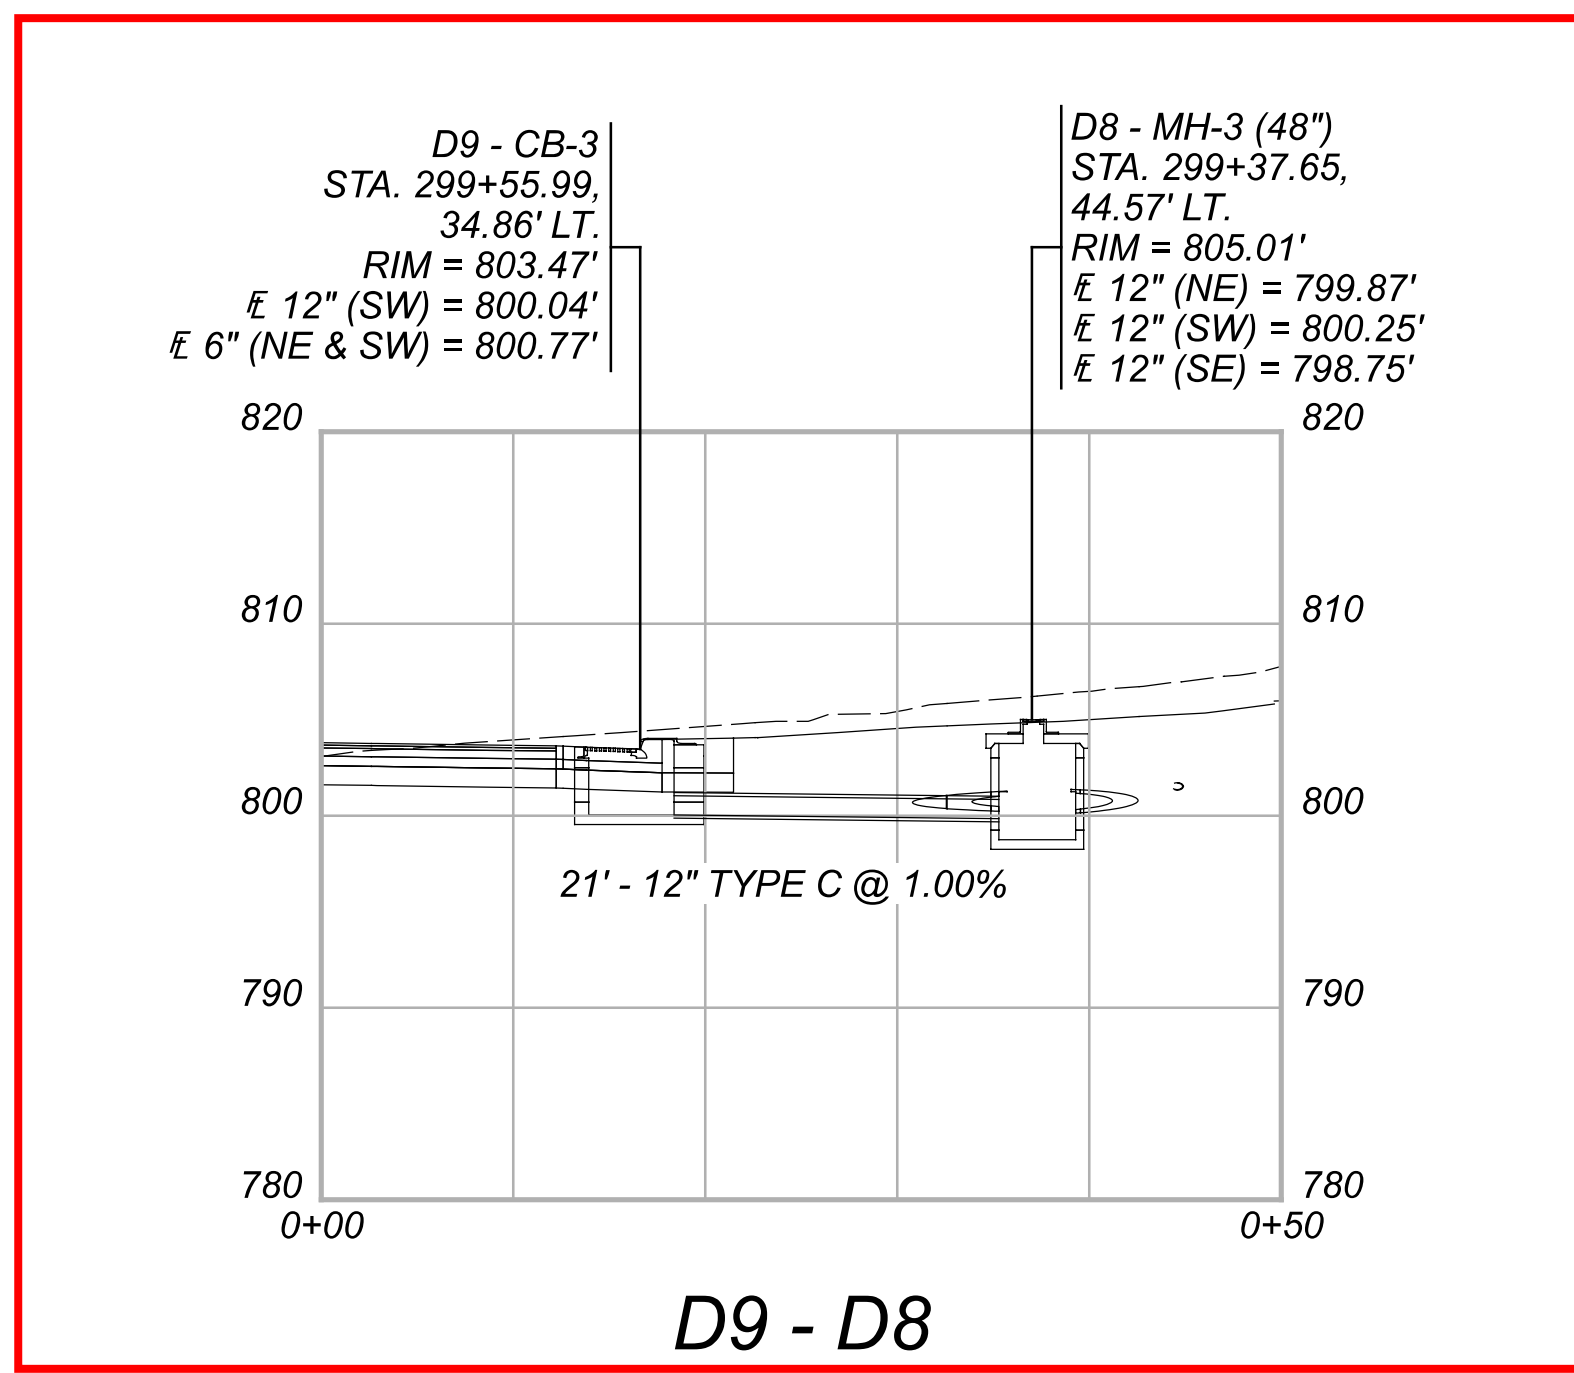

D9 - D8

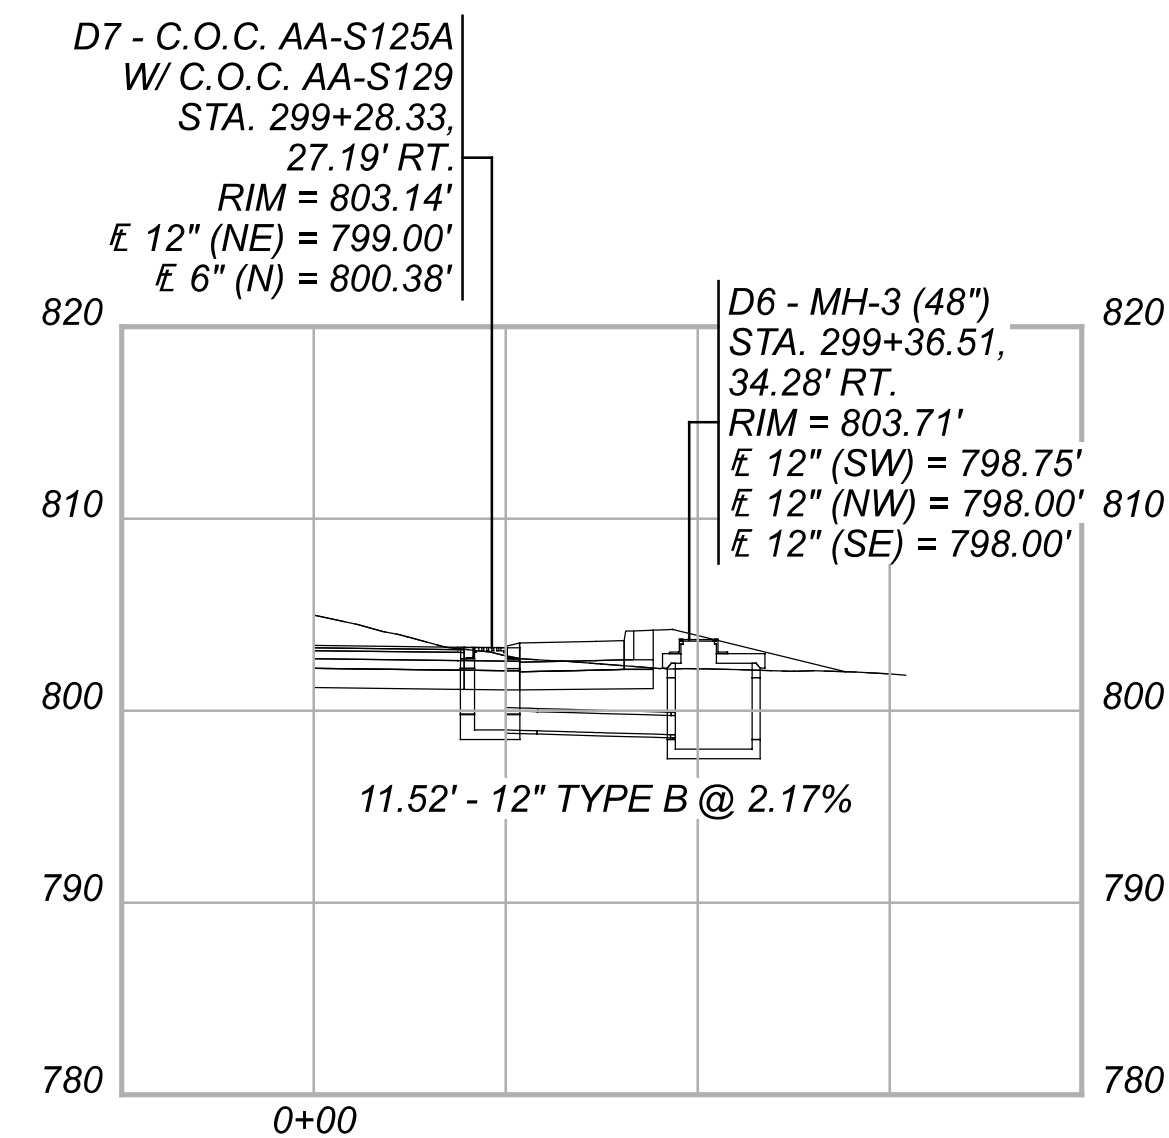

D7 - D6