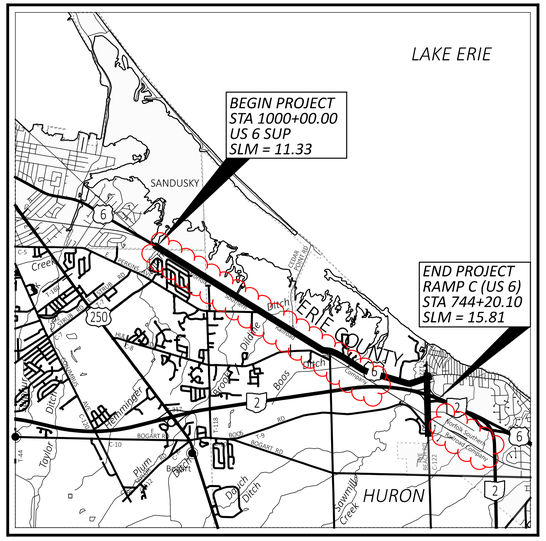


LOCATION MAP

LATITUDE: 41°25'22" N LONGITUDE: 82°38'19" W

SCALE IN MILES

0 1 2 3 4

PORTION TO BE IMPROVED

INTERSTATE HIGHWAY

FEDERAL ROUTES

STATE ROUTES

COUNTY & TOWNSHIP ROADS

OTHER ROADS

DESIGN DESIGNATION

FOR DESIGN DESIGNATIONS, SEE SHEET P.0002

STATE OF OHIO
DEPARTMENT OF TRANSPORTATION

ERI-US 0006-CONNECTIVITY CORRIDOR

HURON TOWNSHIP & PERKINS TOWNSHIP
ERIE COUNTY

INDEX OF SHEETS:

TITLE SHEET	P.0001	SUPERELEVATION TABLES	P.0713 - P.0719
SCHEMATIC PLANS	P.0002 - P.0012	INTERSECTION AND CURB RAMP DETAILS	P.0720 - P.0752
ROUNDABOUT GEOMETRIC LAYOUTS	P.0013 - P.0022	SPLITTER ISLAND DETAILS	P.0753 - P.0764
TYPICAL SECTIONS	P.0023 - P.0059	DRIVEWAY DETAILS	P.0765 - P.0796
PLANING DETAILS	P.0060 - P.0063	STORM SEWER PROFILES	P.0797 - P.0814
GENERAL NOTES	P.0064 - P.0069	CULVERT DETAILS	P.0815 - P.0831
MAINTENANCE OF TRAFFIC	P.0070 - P.0284	DRAINAGE DETAILS	P.0832 - P.0842
GENERAL SUMMARY	P.0285 - P.0300	RETAINING WALLS	P.0843 - P.0844
ESTIMATED QUANTITIES	P.0301 - P.0366	WATER WORK	P.0845 - P.0870
PROJECT SITE PLAN	P.0367 - P.0374	PLAN INSERT SHEETS	P.0871
PLAN & PROFILES		TRAFFIC CONTROL	P.0872 - P.0964
US 6 (CLEVELAND RD W) & SUP	P.0375 - P.0421	TRAFFIC SIGNAL REMOVAL PLANS	P.0965 - P.0972
US 6 SIDE ROADS	P.0422 - P.0423	LIGHTING	P.0973 - P.1010
RYE BEACH ROAD & SUP	P.0424 - P.0437	LANDSCAPING	P.1011 - P.1015
INTERCHANGE RAMPS	P.0438 - P.0441	STRUCTURES OVER 20 FOOT SPAN	
SIDE STREET PROFILES	P.0442	ERI-00006-12.481	P.1016 - P.1024
ROUNDABOUT PROFILES	P.0443 - P.0460	ERI-00006-15.071	P.1025 - P.1039
PAVEMENT REMOVAL PLAN	P.0461 - P.0462	ERI-00006-15.521	P.1040 - P.1045
CROSS SECTIONS		GEOTECHNICAL PROFILE - ROADWAY	P.1046 - P.1106
US 6 (CLEVELAND RD W) & SUP	P.0463 - P.0623		
US 6 SIDE ROADS	P.0624 - P.0628		
RYE BEACH ROAD & SUP	P.0629 - P.0664		
INTERCHANGE RAMPS	P.0665 - P.0683		
ROUNDABOUTS	P.0684 - P.0712		

FEDERAL PROJECT NUMBER

E(220) 276

RAILROAD INVOLVEMENT

NORFOLK SOUTHERN RAILWAY COMPANY

PROJECT DESCRIPTION

THIS PROJECT INCLUDES THE CONSTRUCTION OF FIVE NEW ROUNDABOUTS ALONG US ROUTE 6 IN ERIE COUNTY AT PERKINS AVE, CAMP RD, RYE BEACH RD, AND THE EASTBOUND AND WESTBOUND RAMP TERMINALS AT THE INTERCHANGE OF US 6, SR 2, AND RYE BEACH RD. US 6 IS ALSO BEING RESURFACED AND WIDENED (ALONG CLEVELAND RD W) BETWEEN CAMP RD AND RYE BEACH RD TO ACCOMMODATE A TWO-WAY LEFT TURN LANE. MULTI-MODAL CONNECTIVITY IS BEING IMPROVED THROUGHOUT THE PROJECT BY EXTENDING THE SANDUSKY BAY PATHWAY FROM CEDAR POINT DRIVE TO SPORTS FORCE PARK, THEN ALONG US 6 (CLEVELAND RD W) TO RYE BEACH RD, THEN SOUTH ALONG RYE BEACH RD TO UNIVERSITY DR. A NEW PEDESTRIAN BRIDGE OVER SAWMILL CREEK IS BEING ADDED TO ACCOMMODATE THE SHARED USE PATH.

EARTH DISTURBED AREAS

PROJECT EARTH DISTURBED AREA:	50.18 ACRES
ESTIMATED CONTRACTOR EARTH DISTURBED AREA:	9.00 ACRES
NOTICE OF INTENT EARTH DISTURBED AREA:	59.18 ACRES

2023 SPECIFICATIONS

THE STANDARD SPECIFICATIONS OF THE STATE OF OHIO, DEPARTMENT OF TRANSPORTATION, INCLUDING SUPPLEMENTAL SPECIFICATIONS LISTED IN THE PLANS, CHANGES LISTED IN THE PROPOSAL, AND THE SUPPLEMENTAL SPECIFICATION 800 VERSION INDICATED ON THE PROPOSAL SHALL GOVERN THIS IMPROVEMENT.

I HEREBY APPROVE THESE PLANS AND DECLARE THAT THE MAKING OF THIS IMPROVEMENT WILL NOT REQUIRE THE CLOSING TO TRAFFIC OF THE HIGHWAY EXCEPT AS NOTED ON SHEETS P.0104- P.0108, AND THAT PROVISIONS FOR THE MAINTENANCE AND SAFETY OF TRAFFIC WILL BE AS SET FORTH ON THE PLANS AND ESTIMATES.

Robert Weaver
District 03 Deputy Director

Pamela Boratyn
Director, Department of Transportation

DESIGN EXCEPTIONS

DESIGN FEATURE	APPROVAL DATE	SHEET NUMBERS
SHOULDER WIDTH	07/07/2025	P.0030, P.1016
HORIZONTAL CURVE RADIUS & SUPERELEVATION RATES	09/30/2025	P.0007

ADA DESIGN WAIVERS

NONE REQUIRED

UNDERGROUND UTILITIES
Contact Two Working Days Before You Dig
OHIO811.org Before You Dig
OHIO811, 8-1-1, or 1-800-362-2764
(Non members must be called directly)

PLAN PREPARED BY:
TRANSYSTEMS
400 W. NATIONWIDE BLVD., STE 225
COLUMBUS, OHIO 43215

* DATE INTENTIONALLY REFERS TO AN OLDER VERSION OF THE SCD TO MATCH DESIGN

STANDARD CONSTRUCTION DRAWINGS												SUPPLEMENTAL SPECIFICATIONS		SPECIAL PROVISIONS	
BP-1.1	7/28/00	DM-4.3	1/15/16	RM-4.6	7/18/25	HL-50.11	1/16/15	MT-101.60	1/17/25	TC-42.20	10/18/13	800-2023	7/18/25	NSRR	11/04/22
BP-2.1	1/21/22	DM-4.4	1/15/16	RM-5.2	7/21/23	HL-60.11	7/21/17	MT-101.70	7/19/24	TC-51.11	7/18/25	807	1/17/25		
BP-2.2	1/15/21					HL-60.12	7/21/23	MT-101.75	7/21/23	TC-52.10	10/18/13	813	7/21/23		
BP-3.1	1/19/24	F-2.1	7/20/18	A-1-20	7/19/24	HL-60.31	7/19/24	MT-101.90	7/17/20	TC-52.20	1/15/21	832	7/18/25		
BP-3.2	1/18/19	F-3.3	7/19/13	DBR-2-73	7/19/02			MT-103.10	7/18/25	TC-61.10	4/21/23	870	7/18/25		
BP-4.1	7/19/13			DBR-3-11	7/15/11	ITS-13.10	7/19/24	MT-105.10	1/17/20	TC-64.10	7/21/23	902	7/19/19		
BP-5.1	7/18/25	I-3D	7/19/24	EXJ-2-81	7/15/22	ITS-14.10	1/17/25	MT-110.10	7/19/13	TC-65.10	1/17/14	913	4/16/21		
BP-7.1	7/18/25			HW-1.1	7/18/25	ITS-15.10	7/18/25			TC-65.11	1/17/25	921	7/19/24		
		MGS-2.1	7/18/25	HW-2.1	7/15/22			TC-16.22	7/18/25	TC-71.10	7/18/25				
CB-1	7/19/24	MGS-3.1	7/18/25	HW-2.2	7/20/18	MT-95.31	7/18/25	TC-21.11	7/16/21	TC-72.20	7/18/25				
CB-2-2A, 2B, 2C	7/19/24	MGS-3.2	7/18/25			MT-95.32	7/18/25	TC-21.21	7/18/25	TC-74.10	7/21/23				
CB-2-3, 2-4	7/19/24	MGS-4.2	7/18/25	HL-10.11	7/21/23	MT-95.41	7/18/25	TC-22.10	1/17/25	TC-84.20	1/19/24				
CB-3	7/19/24	MGS-4.3	7/18/25	HL-10.12	7/21/23	MT-95.60	4/19/19	TC-22.20	7/18/25	TC-84.21	10/18/13				
CB-3A	7/19/24			HL-10.13	1/20/23	MT-95.61	4/19/19	TC-41.10	7/19/13	TC-85.21	7/18/25				
CB-5	7/19/24	MH-3	7/19/24	HL-20.11	7/18/25	MT-97.10	7/18/25	TC-41.20	10/18/13	TC-85.22	4/21/23				
CB-6	7/19/24			HL-30.11	7/21/23	MT-98.10	1/17/20	TC-41.30	4/21/23						
		RM-1.1	1/20/23	HL-30.21	4/17/20	MT-98.20	4/19/19	TC-41.40	10/18/13						
DM-1.1	1/17/25	RM-3.1	7/20/18	HL-30.22	1/17/25	MT-98.29	1/17/20	TC-41.41	7/19/19						
DM-1.2	1/17/25	RM-4.2	7/18/25	HL-40.10	7/19/24	MT-98.30	7/18/25	TC-41.50	10/18/13						
DM-4.1	7/17/20	RM-4.5	*1/17/25	HL-40.20	7/18/25	MT-99.30	1/17/20	TC-42.10	10/18/13						

ENGINEER'S SEAL	ENGINEER'S SEAL	ENGINEER'S SEAL
ROADWAY: TRANSYSTEMS SHEETS STATE OF OHIO · GAIL MASSIE · E-71812 · REGISTERED PROFESSIONAL ENGINEER	ROADWAY: OHM SHEETS STATE OF OHIO · SEAN OATMAN · E-82939 · REGISTERED PROFESSIONAL ENGINEER	MAINTENANCE OF TRAFFIC TRAFFIC CONTROL/LIGHTING STATE OF OHIO · SANTI SOPRASEUTH · E-86742 · REGISTERED PROFESSIONAL ENGINEER
ENGINEER'S SEAL	ENGINEER'S SEAL	ENGINEER'S SEAL
TRAFFIC CONTROL: OHM SHEETS STATE OF OHIO · JOHN GRIMM · E-80245 · REGISTERED PROFESSIONAL ENGINEER	STRUCTURES: ERI-00006-15.071 STATE OF OHIO · BRIAN AVARELLO · E-66619 · REGISTERED PROFESSIONAL ENGINEER	ALL OTHER STRUCTURES OVER 20' STATE OF OHIO · JAWDAT SIDDIQI · E-54891 · REGISTERED PROFESSIONAL ENGINEER

TITLE SHEET

DESIGN AGENCY
TRANSYSTEMS
400 W. NATIONWIDE BLVD., STE 225
COLUMBUS, OHIO 43215

DESIGNER JIW


REVIEWER GHM 07/30/25

PROJECT ID 116570

SHEET P.0001 TOTAL 1106

ERI-US 0006-CONNECTIVITY CORRIDOR

MODEL: Sheet PAPERSIZE: 34x22 (in.) DATE: 2/25/2026 TIME: 11:06:08 AM PLTDRV: OHDOT_PDF.pltcfg PENTBL: OHDOT_Pen.tbl USER: hrthornton@gfitinc.com WORKSPACE: OHDOTCEv02 WORKSET: 116570 PRODUCT: OpenRoadsDesigner 24.00.02.25
pw:\\ohiodot-pw.bentley.com:ohiodot-pw-02\Documents\01 Active Projects\District 03\Erie\116570\402-Engineering_TranSystems\Roadway\Sheets\116570_GT001.dgn

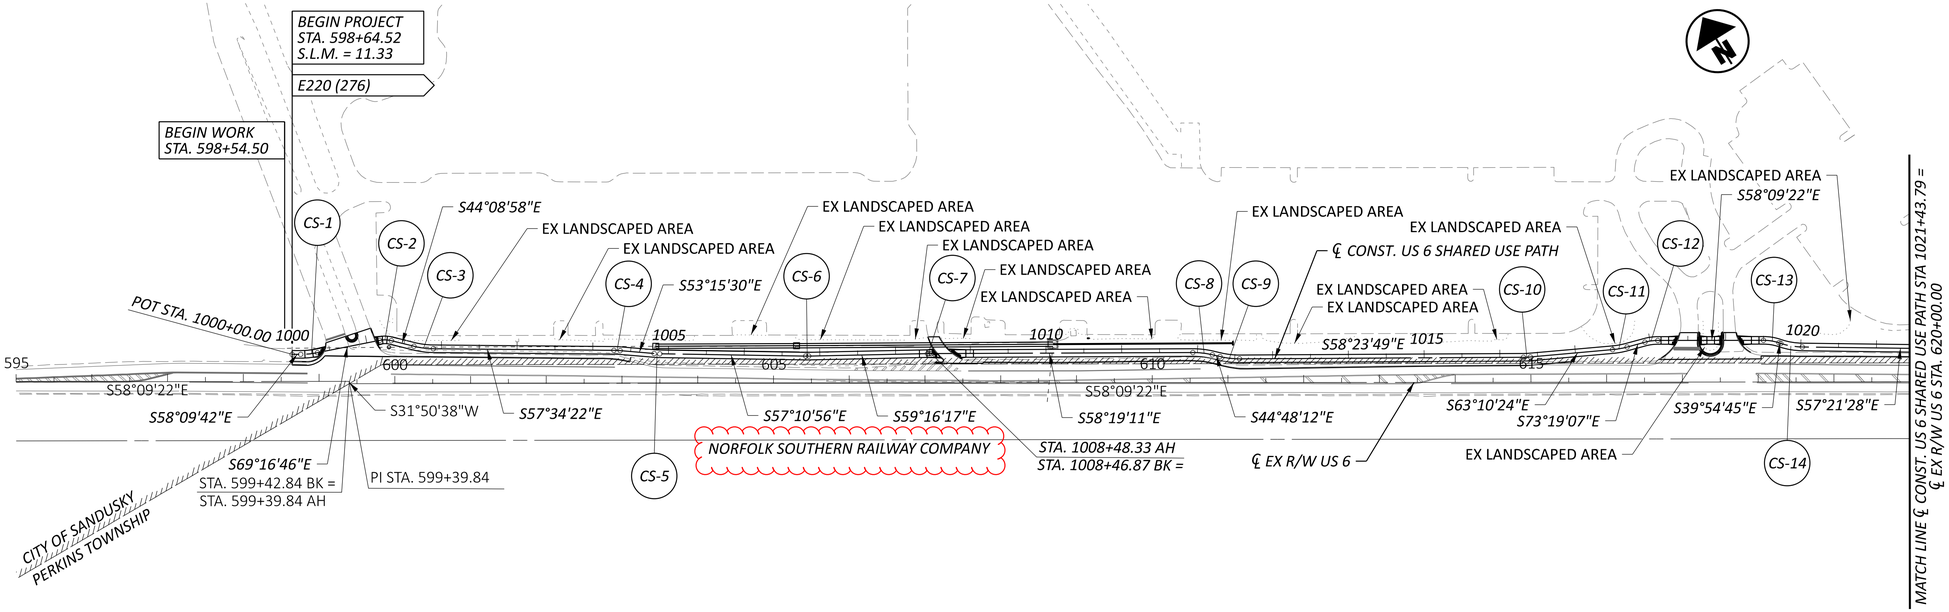

FOR PRIMARY PROJECT CONTROL INFORMATION, SEE SHEET P.0003

HORIZONTAL SCALE IN FEET
0 50 100 200

SCHEMATIC PLAN

EX R/W US 6 STA. 596+00 TO STA. 645+00/CL CONST. US 6 SUP STA. 1000+00 TO STA. 1046+46.14

DESIGN AGENCY
OHM


DESIGNER	SDH
REVIEWER	SEO 10/27/25
PROJECT ID	116570
SHEET	P.0004
TOTAL	1106

ERI-US 0006-CONNECTIVITY CORRIDOR

MODEL: GB101 [Sheet] PAPERSIZE: 34x22 (in.) DATE: 2/26/2026 TIME: 10:08:42 AM PLTDRV: OHDOT_PDF_Levels.pltcfg PENTBL: OHDOT_Pen.tbl USER: Brennon.Cain@ohm-advisors.com WORKSPACE: OHDOTCEv02 WORKSET: 116570 PRODUCT: OpenRoadsDesigner 24.00.00.205
pw:\\ohiodot-pw.bentley.com:ohiodot-pw-02\Documents\01 Active Projects\District 03\Erie\116570\403-Engineering_OHMAdvisors\Roadway\Sheets\116570_GB101.dgn

MODEL: GB102 [Sheet] PAPERSIZE: 34x22 (in.) DATE: 2/26/2026 TIME: 10:08:55 AM PLTDRV: OHDOT_PDF_Levels.plctg PENTBL: OHDOT_Pen.tbl USER: Brennon.Cain@ohm-advisors.com WORKSPACE: OHDOTCivil02 WORKSET: 116570 PRODUCT: OpenRoadsDesigner 24.00.00.205
pw:\\ohiodot-pw.bentley.com:ohiodot-pw-02\Documents\01 Active Projects\District 03\Erie\116570\403-Engineering_OHMAdvisors\Roadway\Sheets\116570_GB101.dgn

ERI-US 0006-CONNECTIVITY CORRIDOR

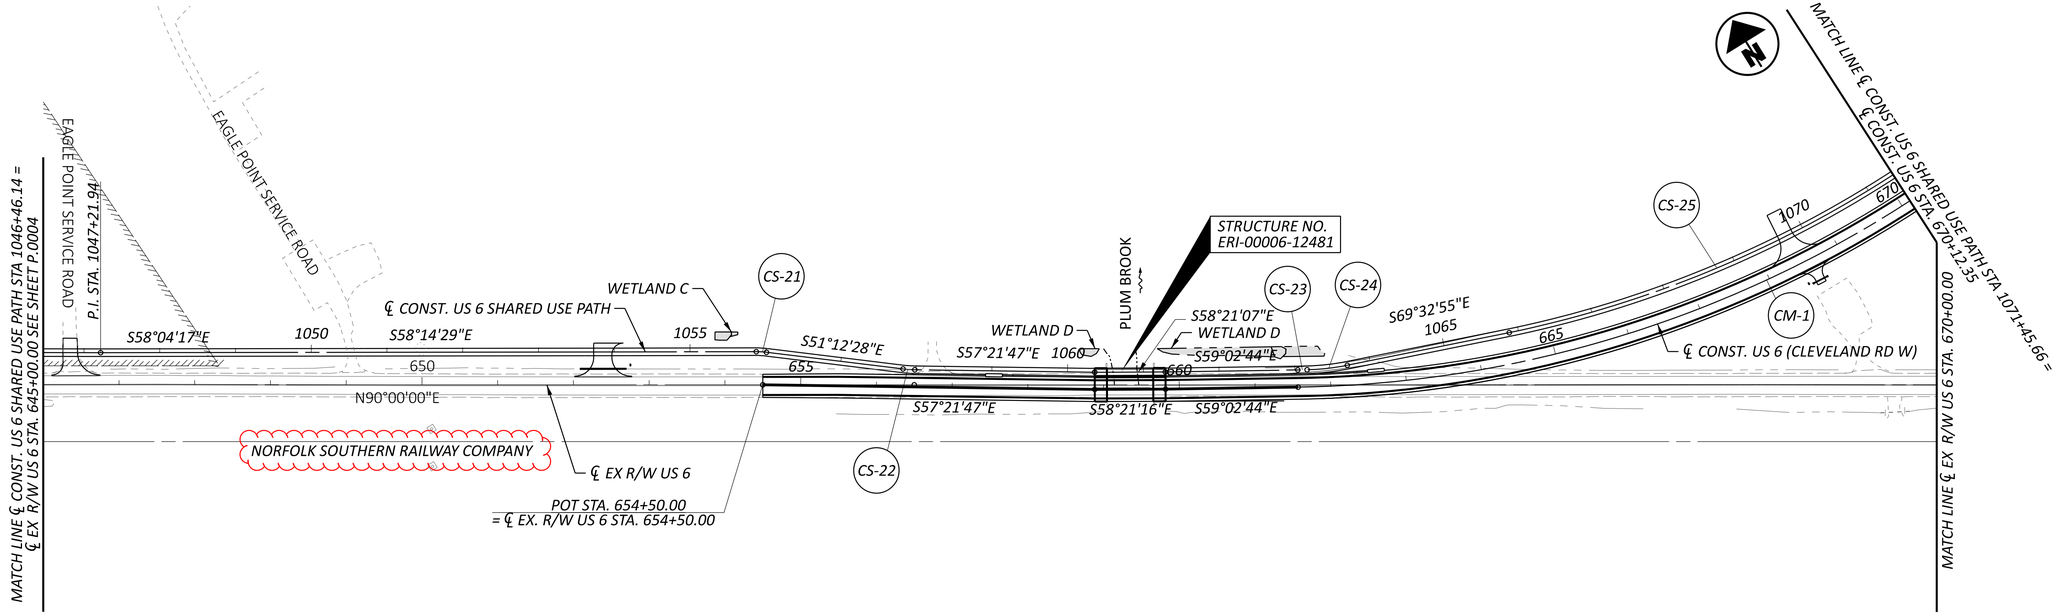

HORIZONTAL SCALE IN FEET
0 50 100 200


SCHEMATIC PLAN


EX R/W US 6 STA. 645+00 TO STA. 698+00/CL CONST. US 6 SUP STA. 1046+46.14 TO STA. 1099+73.49

FOR PRIMARY PROJECT CONTROL INFORMATION, SEE SHEET P.0003

DESIGN AGENCY
OHM

DESIGNER	SDH
REVIEWER	SEO 10/27/25
PROJECT ID	116570
SHEET	P.0006
TOTAL	1106

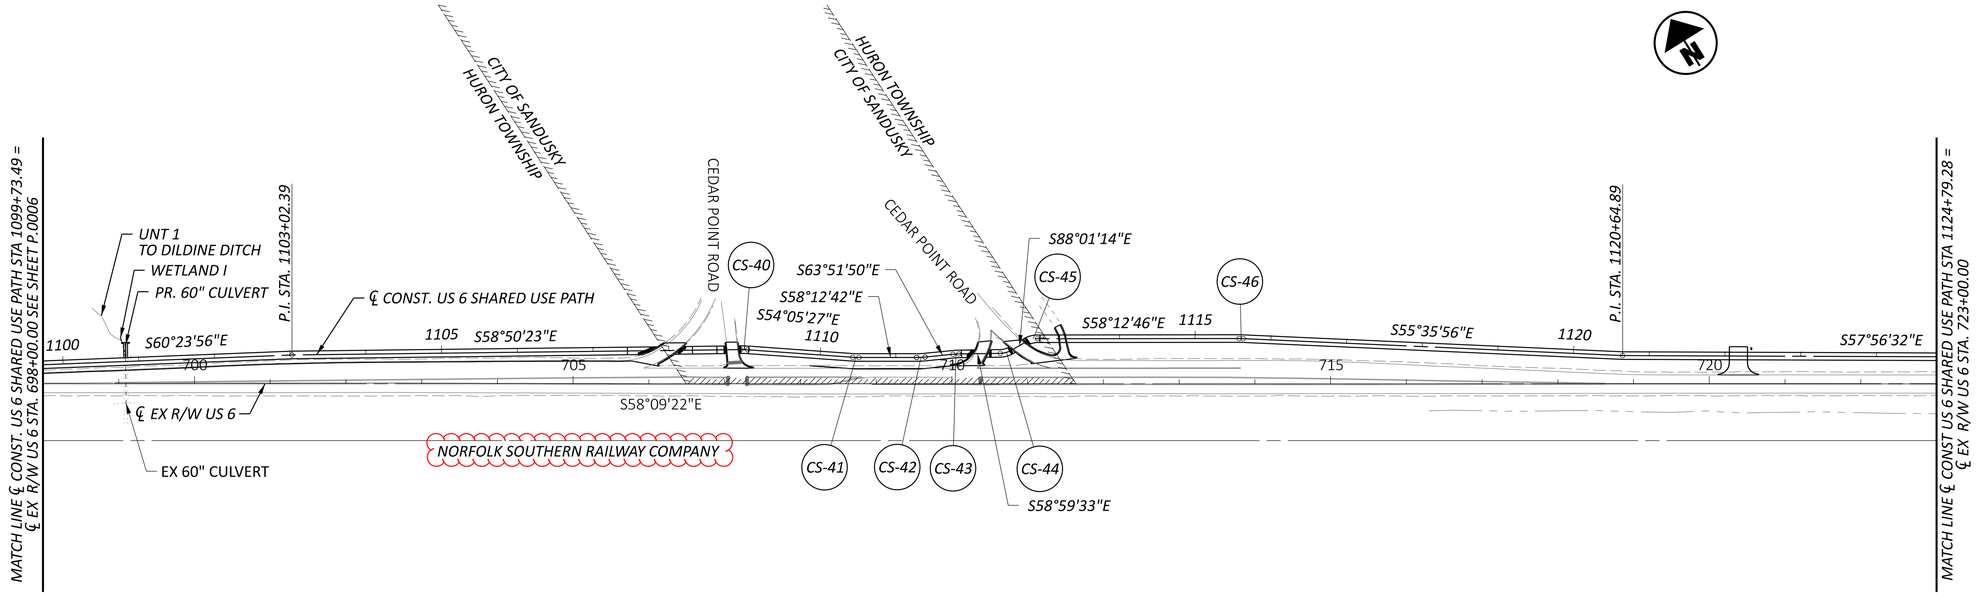

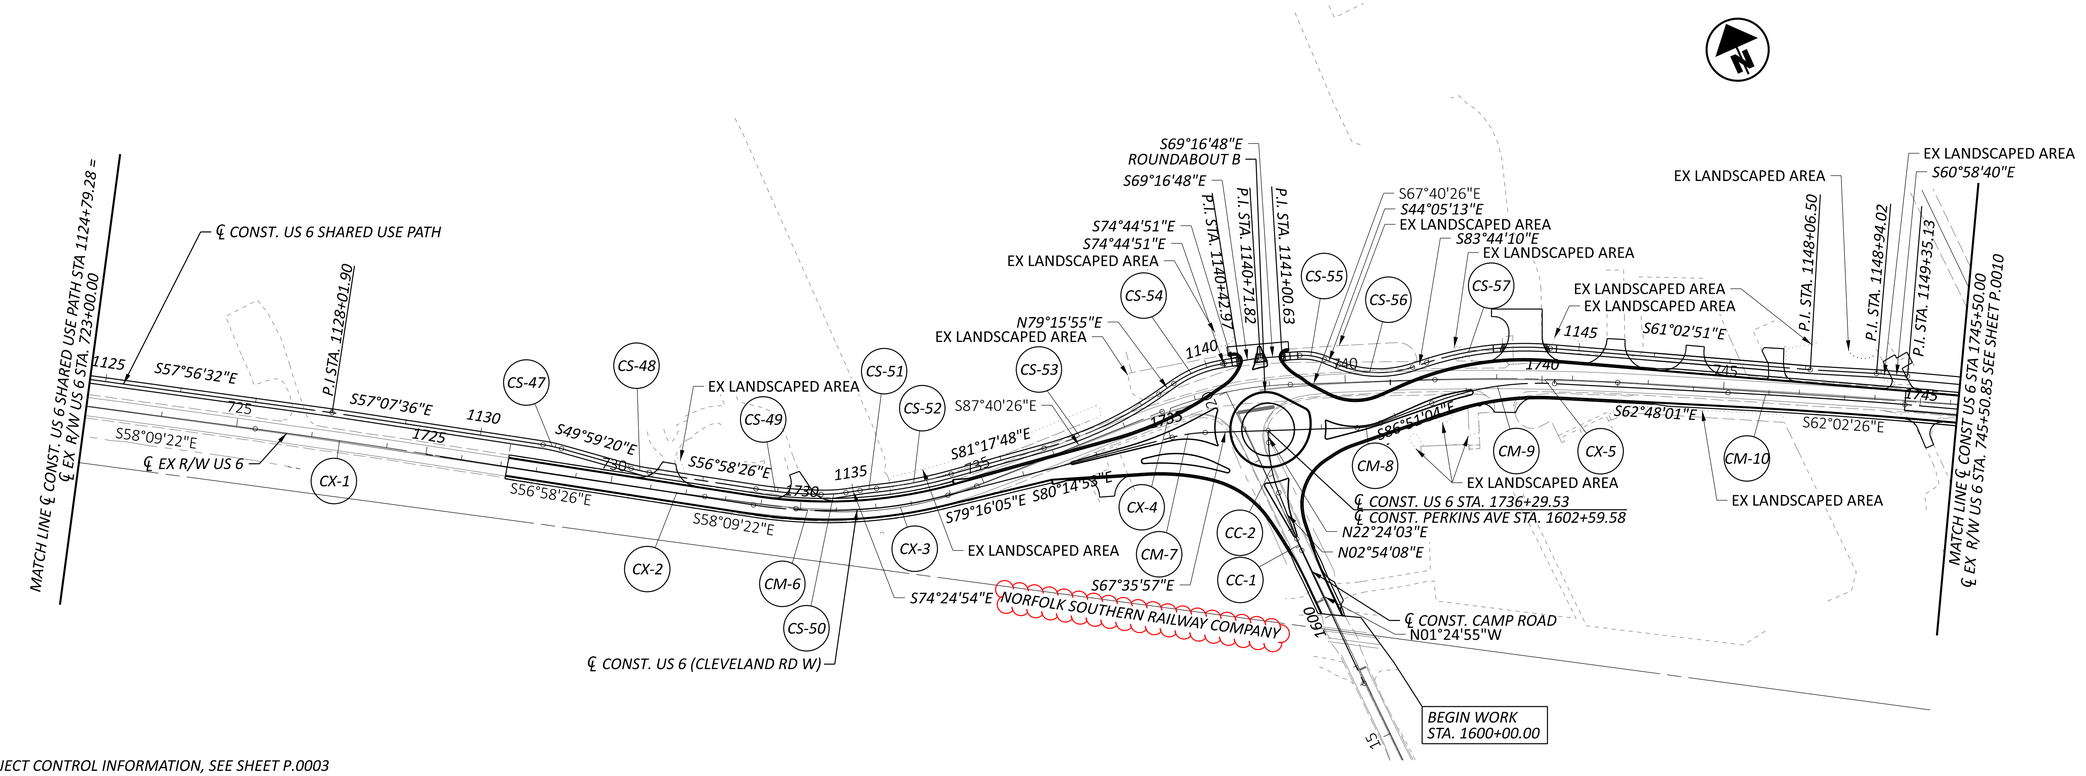

FOR PRIMARY PROJECT CONTROL INFORMATION, SEE SHEET P.0003

HORIZONTAL SCALE IN FEET
0 50 100 200

SCHEMATIC PLAN
EX R/W US 6 STA. 698+00 TO US 6 STA. 745+50/CL CONST. US 6 SUP STA. 1099+73.49 TO STA. 1149+29.73

DESIGN AGENCY
OHM

DESIGNER	SDH
REVIEWER	SEO 10/27/25
PROJECT ID	116570
SHEET	P.0008
TOTAL	1106

ERI-US 0006-CONNECTIVITY CORRIDOR

MODEL: GB103 [Sheet] PAPERSIZE: 34x22 (in.) DATE: 2/26/2026 TIME: 10:08:57 AM PLTDRV: OHDOT_PDF_Levels.pltcfg PENTBL: OHDOT_Pen.tbl USER: Brennon.Cain@ohm-advisors.com WORKSPACE: OHDOTCEv02 WORKSET: 116570 PRODUCT: OpenRoadsDesigner 24.00.00.205
pw:\\ohiodot-pw.bentley.com:ohiodot-pw-02\Documents\01 Active Projects\District 03\Erie\116570\403-Engineering_OHMAdvisors\Roadway\Sheets\116570_GB101.dgn

SCHEMATIC PLAN
RYE BEACH ROAD STA 118+00.00 TO STA 166+00.00

HORIZONTAL SCALE IN FEET
0 50 100 200

HURON TOWNSHIP
CITY OF HURON
SAWMILL PARKWAY
BOOS RD
UNIVERSITY DR E
BEGIN WORK STA. 25+72.63
℄ CONST RYE BEACH ROAD
℄ EX R/W RYE BEACH ROAD
SUSPEND WORK STA. 132+62.23
RESUME WORK STA. 133+00.47
EX LANDSCAPED AREA
℄ CONST RYE BEACH RD SHARED USE PATH
NORFOLK SOUTHERN RAILWAY COMPANY
N01°37'46"W
N02°09'08"W
N02°44'11"W
MATCH LINE ℄ CONST RYE BEACH ROAD STA 140+00.00
℄ EX R/W RYE BEACH ROAD STA. 39+99.97
SEE BELOW LEFT
CP-1 CP-2 CP-3 CP-4 CP-5 CP-6

BEGIN WORK STA. 787+60.00
MATCHLINE STA. 863+00.00 - SEE BELOW
BEGIN WORK STA. 863+60.00
℄ CONST RAMP D
℄ CONST RAMP A
℄ CONST RYE BEACH ROAD
℄ CONST RYE BEACH ROAD (US 6)
℄ EX R/W RYE BEACH ROAD (US 6)
S27°27'36"E
S29°57'55"E
N70°59'25"E
℄ CONST US 6 (CLEVELAND RD W)
MATCH LINE ℄ CONST US 6 STA 1804+00.00
℄ EX R/W US 6 STA. 806+54.73
SEE SHEET P.0010
N69°52'18"E
ROUNDABOUT C
STA. 160+14.24 ℄ US 6 =
STA. 1808+73.62 ℄ RYE BEACH ROAD
N24°37'24"E
HURON TOWNSHIP
CITY OF HURON
ROUNDABOUT E
WETLAND F
N61°48'45"E
℄ CONST RYE BEACH ROAD
EX LANDSCAPED AREA
N00°55'39"W
CR-1 CR-2 CD-17 CD-18 CD-19 CE-1 CE-2 CR-5 CR-6 CE-3 CR-9 CR-11 CR-12 CR-13 CR-14 CR-16 CM-24 CM-25

MATCH LINE ℄ CONST RYE BEACH ROAD STA 140+00.00
℄ EX R/W RYE BEACH ROAD STA. 39+99.97
SEE ABOVE RIGHT
N01°47'27"W
N03°18'11"E
N00°47'56"W
N00°47'56"W
N13°06'05"E
N09°37'42"W
N01°29'42"W
N03°33'42"E
N14°07'28"W
N20°26'41"W
ROUNDABOUT D
STRUCTURE NO. ERI-00006-15.521
END WORK STA. 814+40.00
S29°57'19"E
S23°55'37"E
CD-20 CD-21 CD-22 CD-23 CD-24 CR-3 CR-4 CE-5 CE-6 CE-4 CR-7 CR-8 CR-10 CR-15 CM-26 CM-27

℄ EX R/W RYE BEACH ROAD
END PROJECT STA. 744+20.00
SLM = 15.81
E220 (276)
℄ CONST RAMP C
SR 2 & US 6
END WORK STA. 744+40.00
℄ CONST RAMP B
WETLAND G
℄ EX R/W CLEVELAND RD W
℄ CONST CLEVELAND RD W
END WORK STA. 164+75.00
END WORK STA. 1814+20.00
CM-28

WETLAND AREA

BEGIN WORK STA. 1027+48.57
MATCHLINE STA. 863+00.00 - SEE ABOVE
MATCHLINE ℄ SR-2 STA. 1049+00.00- SEE RIGHT
MATCHLINE ℄ SR-2 STA. 1049+00.00- SEE LEFT
END WORK STA. 1064+03.06

FOR PRIMARY PROJECT CONTROL POINT INFORMATION, SEE SHEET P.0003

ERI-US 0006-CONNECTIVITY CORRIDOR

MODEL: 100 Scale 2 PAPERSIZE: 34x22 (in.) DATE: 2/25/2026 TIME: 11:34:11 AM PLTDRV: OHDOT_PDF.pltcfg PENTBL: OHDOT_Pen.tbl USER: hrthornton@gftinc.com WORKSPACE: OHDOTCtv02 WORKSET: 116570 PRODUCT: OpenRoadsDesigner 24.00.02.25
pw:\\ohiodot-pw.bentley.com:ohiodot-pw-02\Documents\01 Active Projects\District 03\Erie\116570\402.Engineering_TranSystems\Roadway\Sheets\116570_GB001.dgn

DESIGN AGENCY
TRANSYSTEMS
400 W. NATIONWIDE BLVD., STE 225
COLUMBUS, OHIO 43215

DESIGNER TK
REVIEWER GHM 02/28/24
PROJECT ID 116570
SHEET P.0011 TOTAL 1050

DELINEATION OF PORTABLE AND PERMANENT BARRIER

BARRIER REFLECTORS AND OBJECT MARKERS SHALL BE INSTALLED ON ALL PORTABLE BARRIER (PB) USED FOR TRAFFIC CONTROL; AND, ON PERMANENT CONCRETE BARRIER (INCLUDING BRIDGE PARAPETS) LOCATED WITHIN 5 FEET OF THE EDGE OF THE ADJACENT TRAVEL LANE.

BARRIER REFLECTORS SHALL CONFORM TO C&MS 626, EXCEPT THAT THE SPACING SHALL BE AS PER TRAFFIC SCD MT-101.70. OBJECT MARKERS AND THEIR INSTALLATION SHALL CONFORM TO C&MS 614.03 AND SCD MT-101.70. WHEN THE PB CONTAINS GLARE SCREEN, ONE SET OF THREE VERTICAL STRIPES OF SHEETING SHALL BE CONSIDERED EQUIVALENT TO AN OBJECT MARKER, ONE-WAY.

INCREASED BARRIER DELINEATION, AS SPECIFIED HEREIN, SHALL BE INSTALLED ON ALL PB AND PERMANENT CONCRETE BARRIER LOCATED WITHIN 5 FEET OF THE EDGE OF THE TRAVELED LANE UNDER EITHER OF THE FOLLOWING CONDITIONS: ALONG TAPERS AND TRANSITION AREAS; OR ALONG CURVES (OUTSIDE ONLY) WITH DEGREE OF CURVATURE GREATER THAN OR EQUAL TO 3 DEGREES.

THE INCREASED BARRIER DELINEATION SHALL CONSIST OF EITHER DELINEATION PANELS OR THE TRIPLE STACKING OF WORK ZONE BARRIER REFLECTORS.

DELINEATION PANELS SHALL CONSIST OF PANELS OF DELINEATION, APPROXIMATELY 34 INCHES LONG AND 6 INCHES WIDE AND SHALL BE "CRIMPED." PANELS SHALL BE INSTALLED AND SPACED PER TRAFFIC SCD MT-101.70.

TRIPLE-STACKED BARRIER REFLECTORS SHALL CONSIST OF ALIGNING THREE BARRIER REFLECTORS VERTICALLY, AT LOCATIONS WHERE A SINGLE BARRIER REFLECTOR WOULD BE OTHERWISE ATTACHED. THERE SHALL BE NO OPEN SPACE BETWEEN THE ADJACENT BARRIER REFLECTORS. THE TRIPLE-STACKED BARRIER REFLECTORS SHALL CONFORM TO C&MS 626, EXCEPT THAT THEY SHALL BE SPACED AND ALIGNED PER TRAFFIC SCD MT-101.70.

THE FOLLOWING ITEMS ARE QUANTIFIED IN THE MOT SUBSUMMARY:

ITEM 614,	*BARRIER REFLECTOR, TYPE 1 (ONE-WAY)*	*14 EACH*
ITEM 614,	*OBJECT MARKER, ONE-WAY*	*14 EACH*
ITEM 614,	*INCREASED BARRIER DELINEATION*	*696 FEET*

PAYMENT SHALL BE FULL COMPENSATION FOR ALL MATERIAL, LABOR, INCIDENTALS AND EQUIPMENT NECESSARY FOR FURNISHING, INSTALLING, MAINTAINING AND REMOVING EACH OF THE ABOVE ITEMS.

ALONG RUNS OF INCREASED BARRIER DELINEATION WHERE THIS ITEM IS PROVIDED, THE QUANTITY SHALL BE MEASURED AS THE ENTIRE LENGTH OF THE RUN OF INCREASED BARRIER DELINEATION, INCLUDING THE SPACES BETWEEN THE INDIVIDUAL DELINEATION PANELS OR STACKS OF BARRIER REFLECTORS.

DELINEATION OF TEMPORARY AND PERMANENT GUARDRAIL

BARRIER REFLECTORS SHALL BE INSTALLED ON ALL TEMPORARY GUARDRAIL USED FOR TRAFFIC CONTROL; AND, ON ALL PERMANENT GUARDRAIL LOCATED WITHIN 5 FEET OF THE EDGE OF THE ADJACENT TRAVEL LANE. BARRIER REFLECTORS SHALL CONFORM TO C&MS 626 AND THE SPACING SHALL BE APPROXIMATELY 50 FEET.

[OBJECT MARKERS SHALL BE INSTALLED ON ALL TEMPORARY AND PERMANENT GUARDRAIL LOCATED WITHIN 5 FEET OF THE EDGE OF THE ADJACENT TRAVEL LANE. GUARDRAIL-MOUNTING OF OBJECT MARKERS SHALL BE MADE BY INSTALLING THE OBJECT MARKERS ON THE EXTENSION BLOCKS RATHER THAN DIRECTLY ONTO THE GUARDRAIL ITSELF. OBJECT MARKERS SHALL CONFORM TO C&MS 614.03 AND THE SPACING SHALL BE APPROXIMATELY 50 FEET WITH A 25 FOOT OFFSET FROM THE BARRIER REFLECTORS.]

THE FOLLOWING ITEMS ARE QUANTIFIED AND CARRIED TO THE GENERAL SUMMARY:

ITEM 614, OBJECT MARKER, ONE-WAY 84 EACH

PAYMENT SHALL BE FULL COMPENSATION FOR ALL MATERIAL, LABOR, INCIDENTALS AND EQUIPMENT NECESSARY FOR FURNISHING, INSTALLING, MAINTAINING AND REMOVING THE ABOVE ITEM(S).

MAINTENANCE ACCESS TO ALL PROPERTIES DURING CONSTRUCTION

ACCESS SHALL BE MAINTAINED TO ALL RESIDENTIAL AND COMMERCIAL PROPERTIES EXCEPT WHEN A DRIVEWAY MUST BE CLOSED FOR CONSTRUCTION. ALL RESIDENTS AND PROPERTY OWNERS SHALL BE PROVIDED WRITTEN NOTIFICATION BY THE CONTRACTOR A MINIMUM OF 24 HOURS PRIOR TO THE CLOSURE. THE NOTICE SHALL LIST THE TIME THE CLOSURE WILL BE EFFECT AND SHALL LIST 24-HOUR EMERGENCY PHONE NUMBERS OF THE CONTRACTOR RESPOSIBLE FOR THE CLOSURE. THE TIMES SHALL BE COORDINATED WITH EACH RESIDENT AND PROPERTY OWNER. INDIVIDUAL DRIVE CLOSURES SHALL BE KEPT TO THE MINIMUM TIME NEEDED FOR CONSTRUCTION ACTIVITIES. EVERY EFFORT MUST BE MADE TO ACCOMMODATE THE RESIDENT OR OWNER'S NEED FOR ACCESS. ACCESS MAY BE MAINTAINED WITH THE USE OF ASPHALT, AGGREGATE, OR STEEL PLATES.

WHERE A DRIVEWAY IS WIDE ENOUGH, THE CONTRACTOR SHALL CONSTRUCT THE DRIVEWAY PART-WITH WHILE MAINTAINING TWO-WAY TRAFFIC. WHERE A PROPERTY HAS MORE THAN ONE DRIVEWAY, DRIVES SHALL BE CONSTRUCTED ONE AT A TIME.

ALL LABOR AND MATERIALS REQUIRED FOR THE WORK DESCRIBED ABOVE SHALL BE CONSIDERED INCIDENTAL TO AND INCLUDED IN THE LUMP SUM BID PRICE FOR ITEM 614- MAINTAINING TRAFFIC.

NORFOLK SOUTHERN RAILWAY COMPANY NOTICE

ALL WORK ON, OVER, UNDER, OR ADJACENT TO NORFOLK SOUTHERN RAILWAY COMPANY (NS) RIGHT-OF-WAY SHALL BE DONE IN ACCORDANCE TO NS "SPECIAL PROVISIONS FOR THE PROTECTION OF RAILWAY INTERESTS" (NS SPECIAL PROVISIONS).

CONTRACTOR SHALL NOT BE PERMITTED TO STORE ANY EQUIPMENT ON NS PROPERTY WITHOUT THE PERMISSION FROM NS RAILROAD ENGINEER IN ACCORDANCEWITH SECTION E.6.K.1 OF THE NS PUBLIC PROJECTS MANUAL.

CONTRACTOR SHALL COORDINATE WITH NORFOLK SOUTHERN RAILWAY COMPANY'S SIGNAL'S DEPARTMENT FOR REPLACEMENT OF THE CROSSING GATE/FLASHERS IMPACTED BY THE PROPOSED CONSTRUCTION.

RAILROAD FLAGGING SERVICE

FLAGGING FOR WORK ON RAILROAD RIGHT OF WAY SHALL BE COORDINATED, OBTAINED AND PAID FOR BY THE CONTRACTOR. FLAGGING SHALL BE PROVIDED BY THE CONTRACTOR WHENEVER REQUIRED BY THE NORFOLK SOUTHERN RAILWAY COMPANY SPECIAL PROVISIONS FOR THE PROTECTION OF RAILWAY INTEREST. NORFOLK SOUTHERN RAILWAY COMPANY SHALL APPROVE THE FLAGGING SERVICE PROVIDER AND THEIR STAFF

NORFOLK SOUTHERN RAILWAY COMPANY HAS THE SOLE AUTHORITY TO DETERMINE THE NEED FOR PROTECTION SERVICES TO PROTECT ITS OPERATIONS IN GENERAL. THE REQUIREMENTS OF SUCH SERVICES WILL BE WHENEVER THE CONTRACTOR'S PERSONNEL OR EQUIPMENT ARE OR ARE LIKELY TO BE, WORKING ON THE RAILROAD'S RIGHT OF WAY, OR ACROSS, OVER, ADJACENT TO, OR UNDER A TRACK, OR WHEN SUCH WORK HAS DISTURBED OR IS LIKELY TO DISTURB A RAILROAD STRUCTURE OR THE RAILROAD ROADBED OR SURFACE AND ALIGNMENT OF ANY TRACK TO SUCH EXTENT THAT THE MOVEMENT OF TRAINS MUST BE CONTROLLED BY FLAGGING.

THE TOTAL DOLLARS IN THE ESTIMATED QUANTITIES IS BASED UPON AN ESTIMATE OF TOTAL FLAGGING DOLLARS NEEDED TO COMPLETE THE PLANNED WORK.

ONLY THE FOLLOWING CERTIFIED FLAGGING PROVIDERS ARE ACCEPTABLE BY NORFOLK SOUTHERN RAILWAY COMPANY:

RAILPROS
FIELD SUPPORT TEAM
877-315-0513 (OPTION 1)
NS.INFO@RAILPROS.COM
ADAM BROWN
334-530-2861
ADAM.BROWN@RAILPROS.COM

R&R CONSULTING TEAM
DAVID N. CRAFT CO-OWNER & PRESIDENT R&R CONSULTING TEAM, LLC.
PO BOX 4739
HARRISBURG, PA 17111
717-497-4373 (CELL) 775-521-2495 (E-FAX)
DCRAFT@RRCONSULTINGTEAM.COM
WWW.RRCONSULTINGTEAM.COM

NORTH CAROLINA RAILROAD COMPANY (RALEIGH, NC)
GENERAL INQUIRIES: TPP@NCRR.COM
JOHN GASS | SENIOR SAFETY & COMPLIANCE MANAGER
JGLASS@NCRR.COM; 864-504-0455

PAYMENT FOR CERTIFIED FLAGGING PROVIDERS WILL BE MADE PER ITEM 900E00100 EACH – RAILROAD FLAGGING SERVICES BASED UPON THE INVOICES RECEIVED FROM THE FLAGGING SERVICE FOR THE DOLLARS USED, INCLUDING A FIVE PERCENT MARKUP FOR CONTRACTOR OVERHEAD FOR ADMINISTERING THE CONTRACT WITH THE FLAGGING SERVICE.

IN THE EVENT THE PROJECT IS DELAYED DUE TO RAILROAD FLAGGER AVAILABILITY, THE CONTRACTOR WILL PROVIDE DOCUMENTATION SUPPORTING THEIR EFFORTS TO SCHEDULE A FLAGGER FROM THE FLAGGING SERVICE.

DUST CONTROL

THE CONTRACTOR SHALL FURNISH AND APPLY WATER FOR DUST CONTROL AS DIRECTED BY THE ENGINEER. THE FOLLOWING ESTIMATED QUANTITIES HAVE BEEN INCLUDED FOR DUST CONTROL PURPOSES:

ITEM 616, WATER 657 M. GAL.

ITEM 614 PORTABLE CHANGEABLE MESSAGE SIGN, AS PER PLAN

THE CONTRACTOR SHALL FURNISH, INSTALL, MAINTAIN AND REMOVE, WHEN NO LONGER NEEDED, A CHANGEABLE MESSAGE SIGN. THE SIGN SHALL BE OF A TYPE SHOWN ON A LIST OF APPROVED PCMS UNITS AVAILABLE ON THE (OFFICE OF MATERIALS MANAGEMENT WEB PAGE). THE LIST CONTAINS CLASS A AND B UNITS WITH MINIMUM LEGIBILITY DISTANCES OF 650 FEET AND 475 FEET, RESPECTIVELY.

EACH SIGN SHALL BE TRAILER-MOUNTED AND EQUIPPED WITH A FUNCTIONAL DIMMING MECHANISM, TO DIM THE SIGN DURING DARKNESS, AND A TAMPER AND VANDAL PROOF ENCLOSURE. EACH SIGN SHALL BE PROVIDED WITH APPROPRIATE TRAINING AND OPERATION INSTRUCTIONS TO ENABLE ON-SITE PERSONNEL TO OPERATE AND TROUBLESHOOT THE UNIT. THE SIGN SHALL ALSO BE CAPABLE OF BEING POWERED BY AN ELECTRICAL SERVICE DROP FROM A LOCAL UTILITY COMPANY. THE PCMS SHALL BE DELINEATED IN ACCORDANCE WITH C&MS 614.03.

THE PROBABLE PCMS LOCATIONS AND WORK LIMITS FOR THOSE LOCATIONS ARE SHOWN ON SHEET(S) OF THE PLAN. PLACEMENT, OPERATION, MAINTENANCE AND ALL ACTIVATION OF THE SIGNS BY THE CONTRACTOR SHALL BE AS DIRECTED BY THE ENGINEER. THE PCMS SHALL BE LOCATED IN A HIGHLY VISIBLE POSITION YET PROTECTED FROM TRAFFIC. THE CONTRACTOR SHALL, AT THE DIRECTION OF THE ENGINEER, RELOCATE THE PCMS TO IMPROVE VISIBILITY OR ACCOMMODATE CHANGED CONDITIONS. WHEN NOT IN USE, THE PCMS SHALL BE TURNED OFF. ADDITIONALLY, WHEN NOT IN USE FOR EXTENDED PERIODS OF TIME, THE PCMS SHALL BE TURNED AWAY FROM ALL TRAFFIC.

THE ENGINEER SHALL BE PROVIDED ACCESS TO EACH SIGN UNIT AND SHALL BE PROVIDED WITH APPROPRIATE TRAINING AND OPERATION INSTRUCTIONS TO ENABLE ODOT PERSONNEL TO OPERATE AND TROUBLESHOOT THE UNIT, AND TO REVISE SIGN MESSAGES, IF NECESSARY.

(THE CONTRACTOR SHALL IMPLEMENT A SYSTEM WHEREBY CHANGEABLE MESSAGES WILL BE IMPLEMENTED WITHIN TWO HOURS FOLLOWING TELEPHONE NOTIFICATION FROM THE PROJECT ENGINEER TO A DESIGNATED PHONE.)

MAINTENANCE OF TRAFFIC - GENERAL NOTES

ERI-US 0006-CONNECTIVITY CORRIDOR

MODEL: Sheet PAPERSIZE: 34x22 (in.) DATE: 2/25/2026 TIME: 3:55:34 PM PLTDRV: OHDOT_PDF.pltcfg PENTBL: OHDOT_Pen.tbl USER: jcolon@gftinc.com WORKSPACE: pw:\\ohiodot-pw.bentley.com:ohiodot-pw-02\Documents\01 Active Projects\District 03\Erie\116570\0402-Engineering_TranSystems\MOT\Sheets\116570_MN004.dgn
WORKSPACE: OHDOTCEv02 WORKSET: 116570 PRODUCT: OpenRoadsDesigner 24.00.00.205

DESIGN AGENCY
TRANSYSTEMS
400 W. NATIONWIDE BLVD., STE 225
COLUMBUS, OHIO 43215

DESIGNER SSA

REVIEWER SS 10/27/25

PROJECT ID 116570

SHEET P.0072 TOTAL 1106

MAINTENANCE OF LOCAL DETOUR ROUTE

A LOCAL DETOUR ROUTE, OTHER THAN THE OFFICIAL SIGNED ODOT DETOUR ROUTE, AS NOTED IN THESE PLANS, WILL BE SELECTED BY AGREEMENT BETWEEN ODOT AND LOCAL GOVERNMENTAL AGENCIES PRIOR TO THE HIGHWAY CLOSURE. DURING THE TIME THAT TRAFFIC IS DETOURED, THE CONTRACTOR SHALL MAINTAIN THIS ROUTE IN A CONDITION WHICH IS REASONABLY SMOOTH AND FREE FROM HOLES, RUTS, RIDGES, BUMPS, DUST, AND STANDING WATER. ONCE THE DETOUR IS REMOVED AND TRAFFIC RETURNED TO ITS NORMAL PATTERN, THE DESIGNATED LOCAL DETOUR ROUTE SHALL BE RESTORED TO A CONDITION THAT IS EQUIVALENT TO THAT WHICH EXISTED PRIOR TO ITS USE FOR THIS PURPOSE. ALL SUCH WORK SHALL BE PERFORMED WHEN AND AS DIRECTED BY THE ENGINEER. THE DESIGNATED LOCAL DETOUR ROUTE IS TO BE REVIEWED AND REPAIRED PRIOR TO THE ASPHALT CONTRACTOR OR SUBCONTRACTOR LEAVING THE PROJECT.

PAYMENT FOR THE WORK NECESSARY TO REPAIR THESE LOCAL ROADS WILL BE PERFORMED BY CHANGE ORDER.

FLOODLIGHTING

FLOODLIGHTING OF THE WORK SITE FOR OPERATIONS CONDUCTED DURING NIGHTTIME PERIODS SHALL BE ACCOMPLISHED SO THAT THE LIGHTS DO NOT CAUSE GLARE TO THE DRIVERS ON THE ROADWAY. TO ENSURE THE ADEQUACY OF THE FLOODLIGHT PLACEMENT, THE CONTRACTOR AND THE ENGINEER SHALL DRIVE THROUGH THE WORK SITE EACH NIGHT WHEN THE LIGHTING IS IN PLACE AND OPERATIVE PRIOR TO COMMENCING ANY WORK. IF GLARE IS DETECTED, THE LIGHT PLACEMENT AND SHIELDING SHALL BE ADJUSTED TO THE SATISFACTION OF THE ENGINEER BEFORE WORK PROCEEDS.

PAYMENT FOR ALL LABOR, EQUIPMENT AND MATERIALS SHALL BE INCLUDED IN THE LUMP SUM CONTRACT PRICE FOR ITEM 614, MAINTAINING TRAFFIC.

ITEM 614 BUSINESS ENTRANCE (M4-H15) SIGN, AS PER PLAN

THE BUSINESS ENTRANCE (M4-H15) SIGN SHOULD BE PROVIDED AT EACH TEMPORARILY RELOCATED COMMERCIAL DRIVEWAY FOR WHICH THE RELOCATION IS NOT OBVIOUS TO THE MOTORIST. THE PROJECT ENGINEER SHALL DETERMINE WHETHER OR NOT THE DRIVEWAY RELOCATION IS, OR IS NOT, OBVIOUS AND WHETHER OR NOT A SIGN SHOULD BE PROVIDED. ONLY ONE SIGN PER BUSINESS SHALL BE PERMITTED. THE SIGN SHALL BE 36 INCH X 48 INCH IN SIZE WITH TYPE G OR TYPE H ORANGE RETROREFLECTIVE SHEETING. THE SIGN LEGEND SHALL BE PLACED ON BOTH SIDES OF THE SIGN (BACK TO BACK). THE SIGN SHALL HAVE THE STANDARD M4-H15 LEGEND WITH THE WORD "BUSINESS"ON THE TOP LINE, EXCEPT UNDER UNUSUAL CIRCUMSTANCES WHERE IT MAY NOT BE INTUITIVE THAT A DRIVEWAY SERVES A SPECIFIC BUSINESS. IN SUCH UNUSUAL CASES, THE ACTUAL BUSINESS NAME MAY BE SUBSTITUTED FOR THE WORD "BUSINESS".

THE SIGN SHALL BE MOUNTED ON TWO #3 POSTS OR ON TEMPORARY POSTS IN ACCORDANCE WITH SCD MT105.10 AND IN ACCORDANCE WITH THE OHIO MANUAL OF UNIFORM TRAFFIC CONTROL DEVICES, LATEST EDITION. THE SIGN SHALL BE CLEARLY VISIBLE AND SHALL CLEARLY IDENTIFY THE LOCATION OF THE DRIVEWAY. THE SIGN SHOULD BE POSITIONED AT 90O TO THE DIRECTION(S) OF TRAFFIC. THE SIGN MAY NEED TO BE MOVED FOR EACH PHASE OF THE MAINTENANCE OF TRAFFIC OPERATIONS.

PAYMENT FOR ALL COSTS ASSOCIATED WITH MANUFACTURING, MOUNTING, RELOCATING, AND REMOVING THE SIGN, INCLUDING ALL LABOR, MATERIALS AND EQUIPMENT SHALL BE INCLUDED IN THE CONTRACT PRICE PER EACH FOR ITEM 614-BUSINESS ENTRANCE SIGN.

ITEM 614 BUSINESS ENTRANCE (M4-H15) SIGN, AS PER PLAN - (CONTINUED)

THE FOLLOWING ESTIMATED QUANTITY HAS BEEN CARRIED TO THE GENERAL SUMMARY FOR THIS ITEM:

ITEM 614, BUSINESS ENTRANCE SIGN 10 EACH

ITEM 614 LAW ENFORCEMENT OFFICER (WITH PATROL CAR) FOR ASSISTANCE DURING CONSTRUCTION OPERATIONS

USE OF LAW ENFORCEMENT OFFICERS (LEOS) BY CONTRACTORS OTHER THAN THE USES SPECIFIED BELOW WILL NOT BE PERMITTED AT PROJECT COST. LEOS SHOULD NOT BE USED WHERE THE OMUTCD INTENDS THAT FLAGGERS BE USED.

IN ADDITION TO THE REQUIREMENTS OF C&MS 614 AND THE OMUTCD, A UNIFORMED LEO WITH AN OFFICIAL PATROL CAR (CAR WITH TOP-MOUNTED EMERGENCY FLASHING LIGHTS AND COMPLETE MARKINGS OF THE APPROPRIATE LAW ENFORCEMENT AGENCY) SHALL BE PROVIDED FOR THE FOLLOWING TRAFFIC CONTROL TASKS:

DURING THE ENTIRE ADVANCE PREPARATION AND CLOSURE SEQUENCE WHERE COMPLETE BLOCKAGE OF TRAFFIC IS REQUIRED.

DURING A TRAFFIC SIGNAL INSTALLATION WHEN IMPACTING THE NORMAL FUNCTION OF THE SIGNAL OR THE FLOW OF TRAFFIC, OR WHEN TRAFFIC NEEDS TO BE DIRECTED THROUGH AN ENERGIZED TRAFFIC SIGNAL CONTRARY TO THE SIGNAL DISPLAY (E.G., DIRECTING MOTORISTS THROUGH A RED LIGHT).

IN ADDITION TO THE REQUIREMENT OF C&MS 614 AND THE OMUTCD, A UNIFORMED LEO WITH AN OFFICIAL PATROL CAR (CAR WITH TOP-MOUNTED EMERGENCY FLASHING LIGHTS AND COMPLETE MARKINGS OF THE APPROPRIATE LAW ENFORCEMENT AGENCY) SHOULD BE PROVIDED FOR THE FOLLOWING TRAFFIC CONTROL TASKS AS APPROVED BY THE ENGINEER:

FOR LANE CLOSURES: DURING INITIAL SET-UP PERIODS, TEAR DOWN PERIODS, SUBSTANTIAL SHIFTS OF A CLOSURE POINT OR WHEN NEW LANE CLOSURE ARRANGEMENTS ARE INITIATED FOR LONG-TERM LANE CLOSURES/SHIFTS (FOR THE FIRST AND LAST DAY OF MAJOR CHANGES IN TRAFFIC CONTROL SETUP).

FOR OPERATIONS WITHOUT POSITIVE PROTECTION OCCURRING WITHIN 10 FEET OF AN OPEN TRAVELED LANE THAT MEET ALL OF THE FOLLOWING CRITERIA:

ON A MULTI-LANE DIVIDED INTERSTATE, OTHER FREEWAY OR EXPRESSWAY; AND

AN AUTHORIZED SPEED LIMIT OF 45 MPH OR GREATER THAT IS IN EFFECT AT THE TIME OF THE OPERATION; AND,

AADT OF 50,000 (OR AADT OF 30,000 WITH 25% OR HIGHER PERCENT TRUCKS)

"WITHOUT POSITIVE PROTECTION" MEANS USE OF DRUMS, CONES, SHADOW VEHICLE, ETC, WITHOUT PROTECTION FROM PORTABLE BARRIER OR OTHER RIGID BARRIER ALONG THE WORK AREA. THIS PHRASE DOES NOT APPLY TO CASES WHERE POSITIVE PROTECTION IS REQUIRED. MOBILE OPERATIONS ARE REGARDED AS "WITHOUT POSITIVE PROTECTION". FOR WORK ZONES USING A COMBINATION OF BARRIER AND TEMPORARY TRAFFIC CONTROL DEVICES (CONES, DRUMS, ETC), THE DESIGNATION SHALL BE BASED UPON THE TYPE OF DEVICES USED IN THE AREA THAT WORKERS ARE LOCATED.

ITEM 614 LAW ENFORCEMENT OFFICER (WITH PATROL CAR) FOR ASSISTANCE DURING CONSTRUCTION OPERATIONS - (CONTINUED)

IF MULTIPLE ACTIVE LOCALIZED QUALIFYING WORK AREAS OCCUR WITHOUT POSITIVE PROTECTION, PER MAINLINE TRAFFIC DIRECTION, PROVIDE A UNIFORMED LEO AND OFFICIAL PATROL CAR IN ADVANCE OF:

THE FIRST ACTIVE WORK AREA THAT DRIVERS WILL ENCOUNTER; OR

THE ACTIVE WORK AREA LATERALLY CLOSEST TO THE OPEN TRAVELED LANE; OR

OTHER LOCATION AS APPROVED BY THE ENGINEER.

THE UNIFORMED LEO AND OFFICIAL PATROL CAR MAY RELOCATE AMONG THE LISTED LOCATIONS AS APPROPRIATE AS THE OPERATIONS PROCEED IN THE LOCALIZED QUALIFYING WORK AREAS.

IN GENERAL, LEOS SHOULD BE POSITIONED IN ADVANCE OF AND ON THE SAME SIDE AS THE LANE RESTRICTION (OR AT THE POINT OF ROAD CLOSURE), AND TO MANUALLY CONTROL TRAFFIC MOVEMENTS THROUGH SIGNALIZED INTERSECTIONS IN WORK ZONES.

LEOS SHOULD NOT FORGO THEIR TRAFFIC CONTROL RESPONSIBILITIES TO APPREHEND MOTORISTS FOR ROUTINE TRAFFIC VIOLATIONS. HOWEVER, IF A MOTORIST'S ACTIONS ARE CONSIDERED TO BE RECKLESS, THEN PURSUIT OF THE MOTORIST IS APPROPRIATE.

THE LEOS WORK AT THE DIRECTION OF THE CONTRACTOR. THE CONTRACTOR IS RESPONSIBLE FOR SECURING THE SERVICES OF THE LEOS WITH THE APPROPRIATE AGENCIES AND COMMUNICATING THE INTENTIONS OF THE PLANS WITH RESPECT TO DUTIES OF THE LEOS. THE ENGINEER SHALL HAVE FINAL CONTROL OVER THE LEOS' DUTIES AND PLACEMENT AND WILL RESOLVE ANY ISSUES THAT MAY ARISE BETWEEN THE TWO PARTIES.

ENSURE PROVIDED LEOS HAVE BEEN TRAINED APPROPRIATE TO THE JOB DECISIONS THEY ARE REQUIRED TO MAKE WHILE ON THE PROJECT, IN ACCORDANCE WITH C&MS 614.03.

THE LEO SHALL REPORT IN TO THE CONTRACTOR PRIOR TO THE START OF THE SHIFT, IN ORDER TO RECEIVE INSTRUCTIONS REGARDING SPECIFIC WORK ASSIGNMENTS DURING HIS/HER SHIFT. THE LEO IS EXPECTED TO STAY AT THE PROJECT SITE FOR THE ENTIRE DURATION OF HIS/HER SHIFT. THE LEO SHALL REPORT TO THE CONTRACTOR AT THE END OF HIS/HER SHIFT. SHOULD IT BE NECESSARY TO LEAVE THE PROJECT SITE, THE LEO SHALL NOTIFY THE ENGINEER. THE CONTRACTOR SHALL PROVIDE THE LEO WITH A TWO-WAY COMMUNICATION DEVICE THAT SHALL BE RETURNED TO THE CONTRACTOR AT THE END OF HIS/HER SHIFT.

LEOS (WITH PATROL CAR) REQUIRED BY THE TRAFFIC MAINTENANCE TASKS ABOVE SHALL BE PAID FOR ON A UNIT PRICE (HOURLY) BASIS UNDER ITEM 614, LAW ENFORCEMENT OFFICER (WITH PATROL CAR) FOR ASSISTANCE. THE FOLLOWING ESTIMATED QUANTITIES HAVE BEEN CARRIED TO THE GENERAL SUMMARY:

ITEM 614, LAW ENFORCEMENT OFFICER WITH PATROL CAR FOR ASSISTANCE 800 HOURS

THE HOURS PAID SHALL INCLUDE ANY MINIMUM SHOW-UP TIME REQUIRED BY THE LAW ENFORCEMENT AGENCY INVOLVED.

ANY ADDITIONAL COSTS (ADMINISTRATIVE OR OTHERWISE) INCURRED BY THE CONTRACTOR TO OBTAIN THE SERVICES OFAN LEO ARE INCLUDED WITH THE BID UNIT PRICE FOR ITEM 614, LAW ENFORCEMENT OFFICER WITH PATROL CAR FOR ASSISTANCE.

ITEM 614 MAINTAINING TRAFFIC, MISC.:
TEMPORARY LIGHTING (ROUNDABOUT A)
TEMPORARY LIGHTING (ROUNDABOUT B)
TEMPORARY LIGHTING (ROUNDABOUT C)
TEMPORARY LIGHTING (ROUNDABOUT D)
TEMPORARY LIGHTING (ROUNDABOUT E)

INSTALL ALL PERMANENT LIGHTING PRIOR TO OPENING THE PROPOSED FACILITY TO TRAFFIC. IF THE PERMANENT LIGHTING IS NOT ABLE TO BE COMPLETED PRIOR TO OPENING, SUPPLY TEMPORARY LIGHTING MEETING THE PHOTOMETRIC PROPERTIES OF THE PERMANENT LIGHTING PLAN PRIOR TO OPENING THE FACILITY TO TRAFFIC. A MINIMUM OF 14 DAYS PRIOR TO THE INSTALLATION OF ANY SUCH TEMPORARY LIGHTING, SUPPLY A TEMPORARY LIGHTING PLAN TO THE ENGINEER FOR APPROVAL. THIS LIGHTING PLAN MUST ALSO BE APPROVED BY THE DISTRICT TRAFFIC ENGINEER. THE CONTRACTOR IS PROHIBITED FROM INSTALLING ANY SUCH TEMPORARY LIGHTING UNTIL THE TEMPORARY LIGHTING PLAN IS APPROVED BY THE PROJECT AND DISTRICT TRAFFIC ENGINEERS.

AT A MINIMUM, THE TEMPORARY LIGHTING SHALL PROVIDE AN AVERAGE INITIAL INTENSITY OF 0.8 FOOT-CANDLES WITH AN AVERAGE-TO-MINIMUM UNIFORMITY NOT TO EXCEED 3:1. THE MOUNTING HEIGHT OF TEMPORARY LUMINAIRES SHALL NOT BE LESS THAN 30 FEET AND THE MINIMUM OVERHEAD CONDUCTOR CLEARANCE SHALL BE 20 FEET. TEMPORARY OVERHEAD CONSTRUCTION SHALL NOT BE LESS THAN GRADE "B" FOR STRENGTH REQUIREMENTS AS DEFINED BY THE NATIONAL ELECTRIC SAFETY CODE. WOOD POLES WITH OVERHEAD WIRING MAY BE USED. HOWEVER, TEMPORARY LIGHTING SHALL MEET FEDERAL AND STATE SAFETY CRITERIA. IF BREAKAWAY POLES ARE USED TO MEET THESE CRITERIA, THEN UNDERGROUND WIRING SHALL BE USED. RECONDITIONED OR USED MATERIALS MAY BE FURNISHED FOR TEMPORARY LIGHTING. WHEN POSSIBLE, THE TEMPORARY LIGHTING SHALL UTILIZE A PERMANENT POWER SOURCE (i.e. A POWER DROP FROM AN EXISTING OR PROPOSED TRANSMISSION OR DISTRIBUTION ELECTRIC LINE) RATHER THAN A TEMPORARY SOURCE (i.e. PORTABLE GENERATORS). TEMPORARY SOURCES OF ELECTRICITY MAY ONLY BE USED WHEN NO PERMANENT SOURCES ARE AVAILABLE.

AFTER THE INSTALLATION, INSPECTION, AND ACCEPTANCE OF THE FINAL PERMANENT LIGHTING, AND WHEN THE TEMPORARY LIGHTING IS NO LONGER NEEDED, REMOVE AND PROPERLY DISPOSE OF THE TEMPORARY LIGHTING EQUIPMENT AND MATERIALS.

IN ACCORDANCE WITH C&MS 105, THE CONTRACTOR IS ALSO RESPONSIBLE FOR MAINTAINING EXISTING LIGHTING PRIOR TO CLOSURE OF THE PROJECT AREA TO TRAFFIC.

PAYMENT FOR THE ABOVE DETAILED TEMPORARY LIGHTING AND MAINTENANCE OF TRAFFIC TO INSTALL PERMANENT LIGHTING, IF NEEDED, WILL BE PAID FOR UNDER ITEM 614E18000 MAINTAINING TRAFFIC, MISC.: TEMPORARY LIGHTING (BY ROUNDABOUT LOCATION) PER 5 EACH AND WILL INCLUDE ALL MATERIAL, EQUIPMENT, LABOR, AND OTHER INCIDENTALS NEEDED TO COMPLETE THE WORK.

ITEM 614 MAINTAINING TRAFFIC, MISC.: METER BASE, NON-FUSED SERVICE DISCONNECT SWITCH, AND RISER


DURING CONSTRUCTION OF THE PROPOSED ROUNDABOUT D, AT SR 2 EASTBOUND EXIT RAMP & RYE BEACH ROAD, SOUTHWEST CORNER OF THE INTERSECTION, THE EXISTING LIGHTING FACILITIES/ EQUIPMENT WILL BE IMPACTED AND REMOVED. THE REMOVAL OF THE METER BASE, NON-FUSED DISCONNECT SWITCH AND RISER SHALL BE SALVAGED AND RETURNED TO ODOT DISTRICT 3 TRAFFIC DEPARTMENT TO BE USED AT ANOTHER LOCATION / INVENTORY.

PAYMENT FOR THE ABOVE DETAILED WORK, WILL BE PAID FOR UNDER ITEM 614E18002 MAINTAINING TRAFFIC, MISC.: METER BASE, NON-FUSED SERVICE DISCONNECT SWITCH, AND RISER PER LUMP SUM AND WILL INCLUDE ALL MATERIAL, EQUIPMENT, LABOR, AND OTHER INCIDENTALS NEEDED TO COMPLETE THE WORK.

MAINTENANCE OF TRAFFIC - GENERAL NOTES

DESIGN AGENCY
TRANSYSTEMS
400 W. NATIONWIDE BLVD., STE 220
COLUMBUS, OHIO 43215
DESIGNER SSA
REVIEWER SS 10/27/25
PROJECT ID 116570
SHEET P.0074 TOTAL 1106

ERI-US 0006-CONNECTIVITY CORRIDOR
MODEL: Sheet PAPERSIZE: 34x22 (in.) DATE: 2/27/2026 TIME: 4:41:10 PM PLTDRV: OHDOT_PDF_Levels.pltcfg PENTBL: OHDOT_Pen.tbl USER: ssoprasuth@gftinc.com WORKSPACE: OHDOTCEv02 WORKSET: 116570 PRODUCT: OpenRoadsDesigner 24.00.02.25
pw:\\ohiodot-pw.bentley.com:ohiodot-pw-02\Documents\01 Active Projects\District 03\Eri\116570\402-Engineering_TranSystems\MOT\Sheets\116570_MN007.dgn

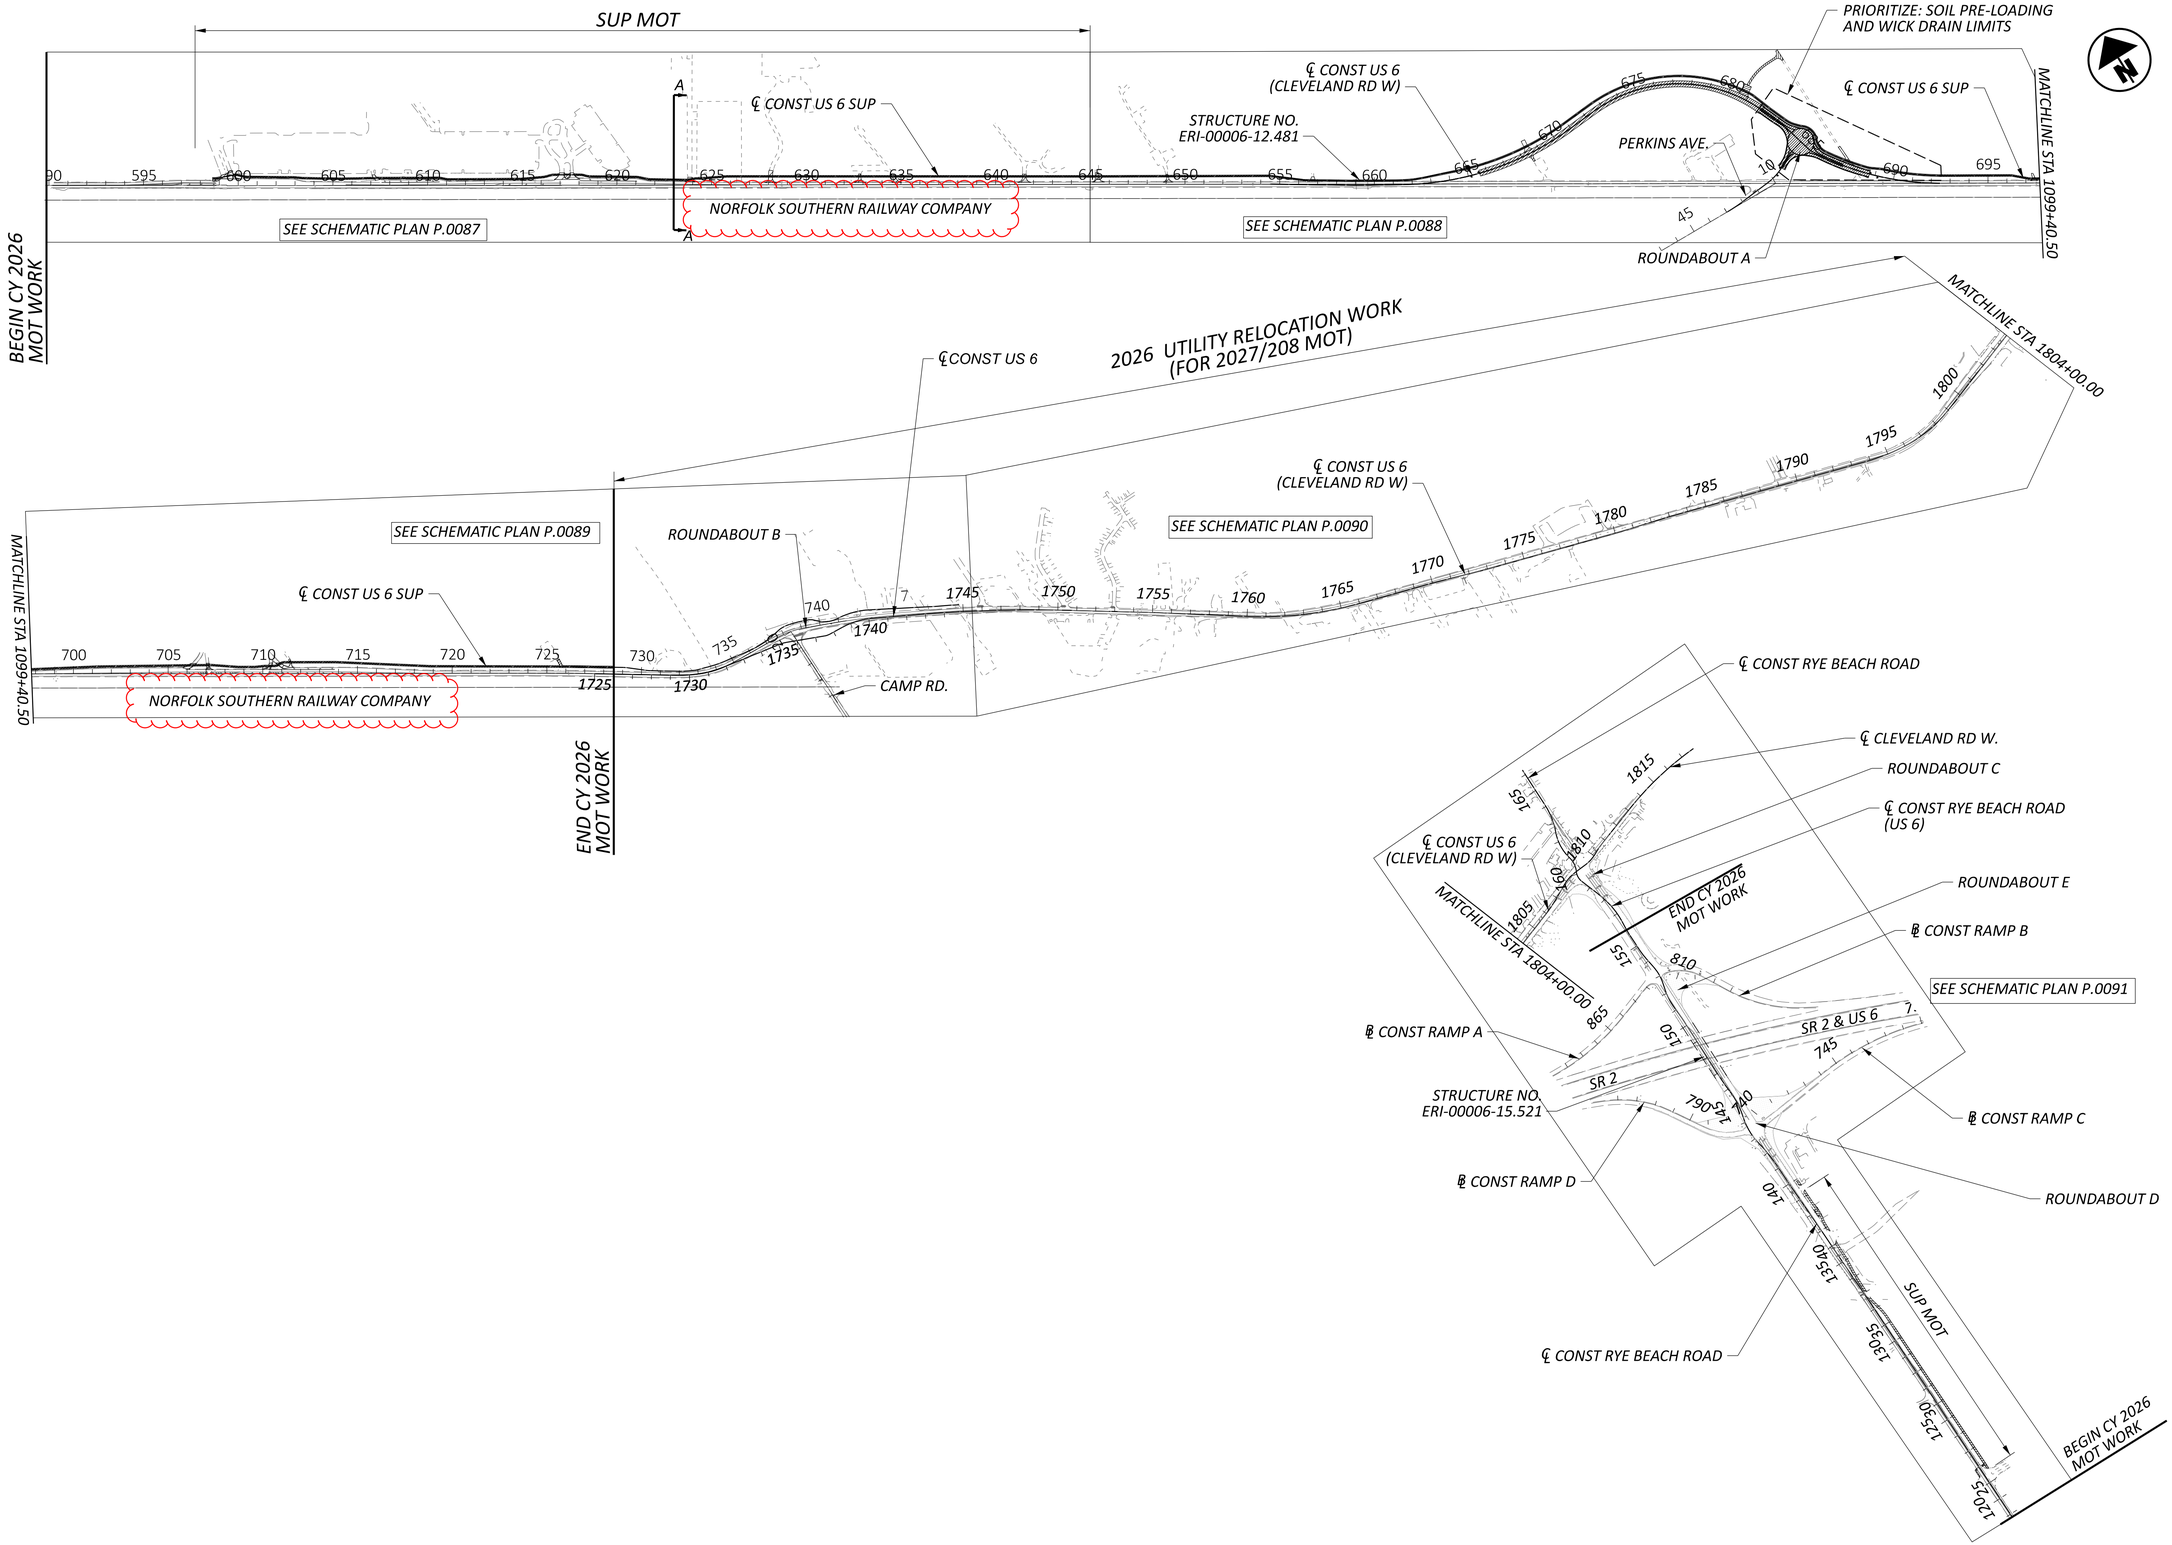

HORIZONTAL SCALE IN FEET
0 200 400 800

MOT OVERALL SCHEMATIC PLAN - PRE PHASE (2026 CONSTRUCTION)

ERI-US 0006-CONNECTIVITY CORRIDOR


DESIGN AGENCY
TRANSYSTEMS
400 W. NATIONWIDE BLVD., STE 205
COLUMBUS, OHIO 43215


DESIGNER: SSA
REVIEWER: SS 10/27/25
PROJECT ID: 116570
SHEET: P.0086 TOTAL: 1106

MODEL: 400 Scale PAPERSIZE: 34x22 (in.) DATE: 2/25/2026 TIME: 11:50:18 AM PLTDRV: OHDOT_PDF_Levels.pltcfg PENTBL: OHDOT_Pen.tbl USER: hrthornton@gftinc.com WORKSPACE: OHDOTCEv02 WORKSET: 116570 PRODUCT: OpenRoadsDesigner 24.00.02.25
pw:\\ohiodot-pw.bentley.com:ohiodot-pw-02\Documents\01 Active Projects\District 03\Erie\116570\402-Engineering_TranSystems\MOT\Sheets\116570_MB001_CY2026.dgn

MODEL: GB101 [Sheet] PAPERSIZE: 34x22 (in.) DATE: 2/25/2026 TIME: 11:55:46 AM PLTDRV: OHDOT_PDF_Levels.pltcfg PENTBL: OHDOT_Pen.tbl USER: hrthornton@gftinc.com
pw:\\ohiodot-pw.bentley.com:ohiodot-pw-02\Documents\01 Active Projects\District 03\Erie\116570\402-Engineering_TranSystems\MOT\Sheets\116570_MB002_CY2026.dgn

ERI-US 0006-CONNECTIVITY CORRIDOR

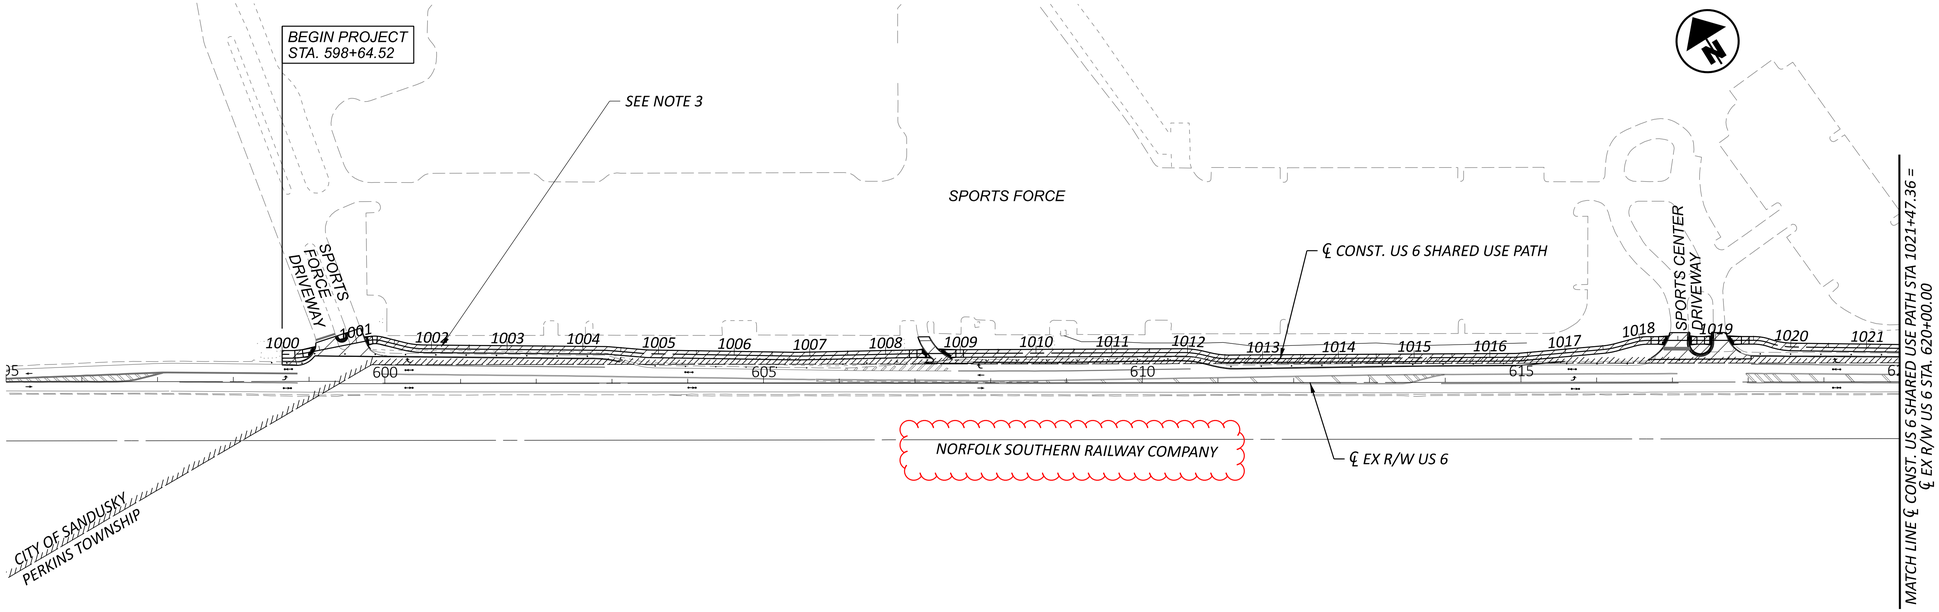

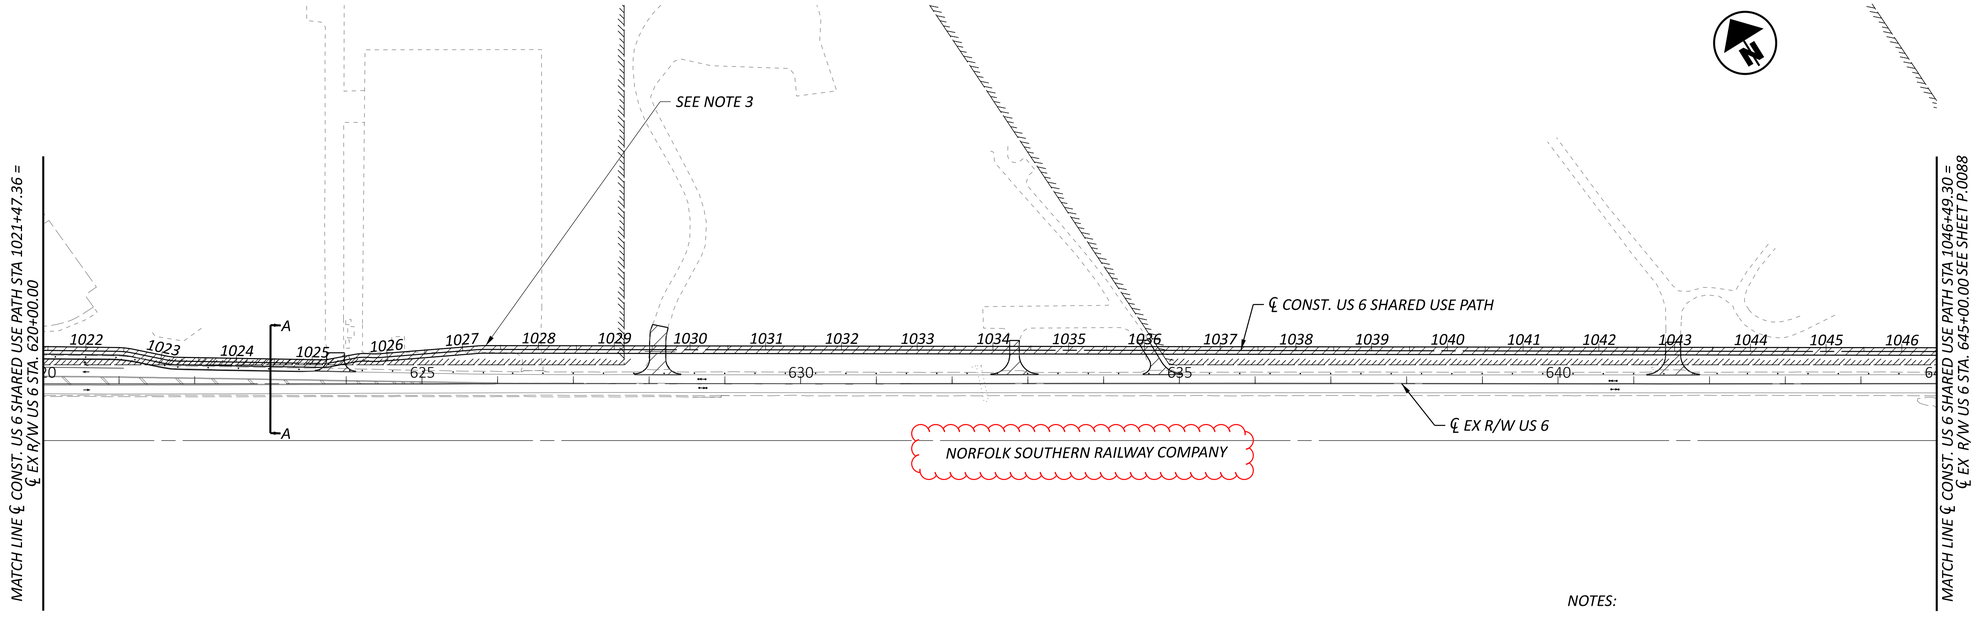

NOTES:

1. FOR MOT OVERALL SCHEMATIC PLAN, SEE SHEET P.0086.

2. FOR LEGEND, SEE SHEET P.0085.

3. SUP: USE FLAGGERS TO RESTRICT TRAFFIC TO ONE LANE WHERE NECESSARY TO CONSTRUCT THE RESURFACING AND MULTI-USE PATH OUTSIDE WIDENING AREAS AND PROPOSED ROUNDABOUTS. USE LEOS TO CONTROL TRAFFIC AT SIGNALIZED INTERSECTIONS WHEN NECESSARY. ASSUME SUP CONSTRUCTION DURATION OF 60 DAYS.

HORIZONTAL SCALE IN FEET
0 50 100 200


MOT SCHEMATIC PLAN - PRE-PHASE (2026 CONSTRUCTION)
US 6 BEGIN PROJECT TO STA 645+00


DESIGN AGENCY
TRANSYSTEMS
400 W. NATIONWIDE BLVD., STE 225
COLUMBUS, OHIO 43215

DESIGNER	SSA
REVIEWER	SS 10/27/25
PROJECT ID	116570
SHEET	P.0087
TOTAL	1106

MODEL: GB102 [Sheet] PAPERSIZE: 34x22 (in.) DATE: 2/25/2026 TIME: 12:01:08 PM PLTDRV: OHDOT_PDF_Levels.pltcfg PENTBL: OHDOT_Pen.tbl USER: hrthornton@gftinc.com
pw:\\ohiodot-pw.bentley.com:ohiodot-pw-02\Documents\01 Active Projects\District 03\Erie\116570\402-Engineering_TranSystems\MOT\Sheets\116570_MB002_CY2026.dgn

ERI-US 0006-CONNECTIVITY CORRIDOR

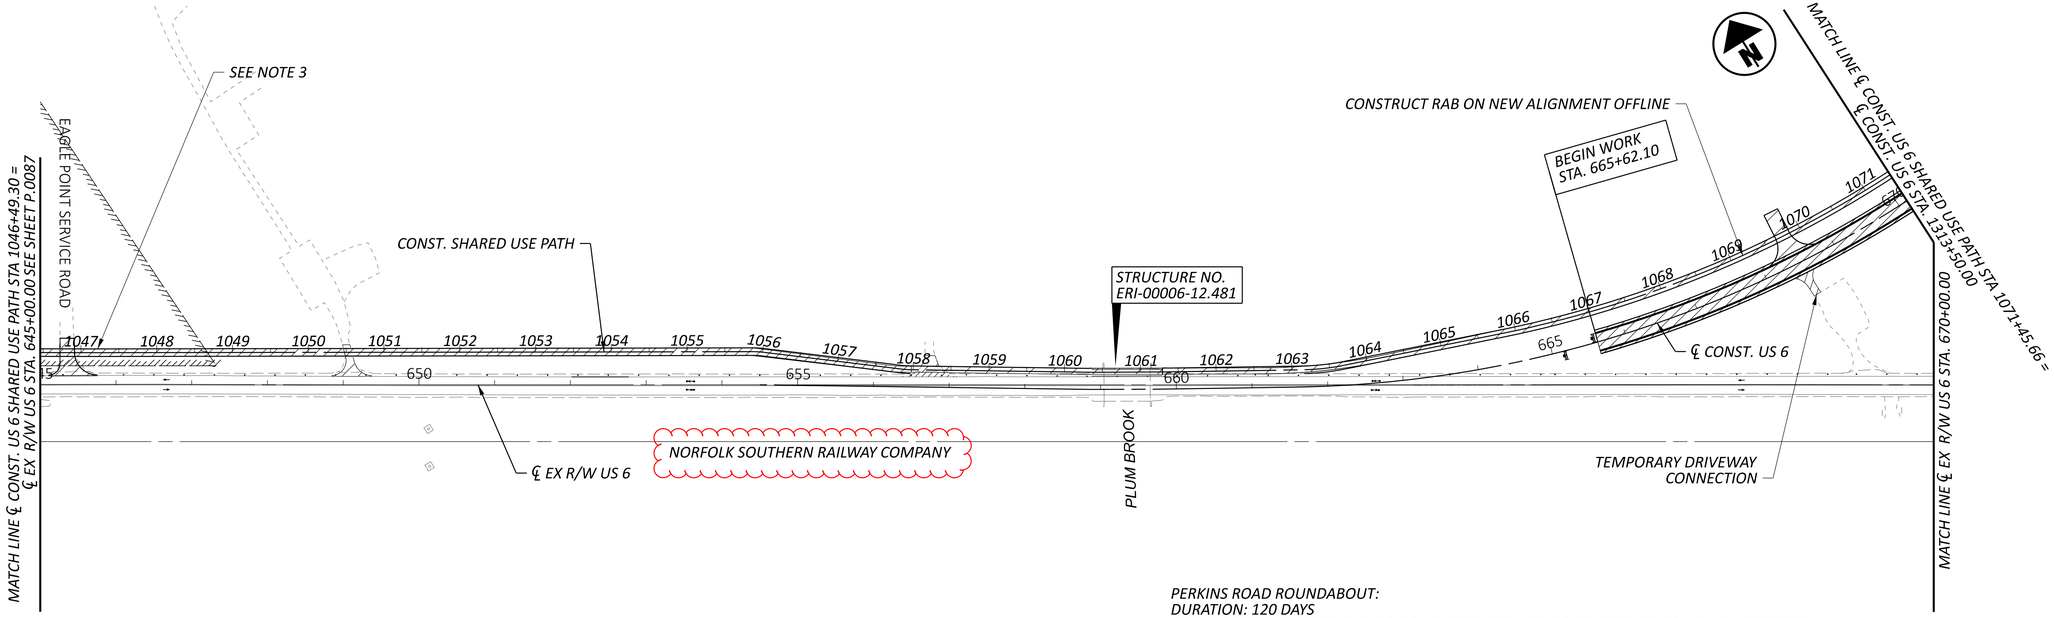

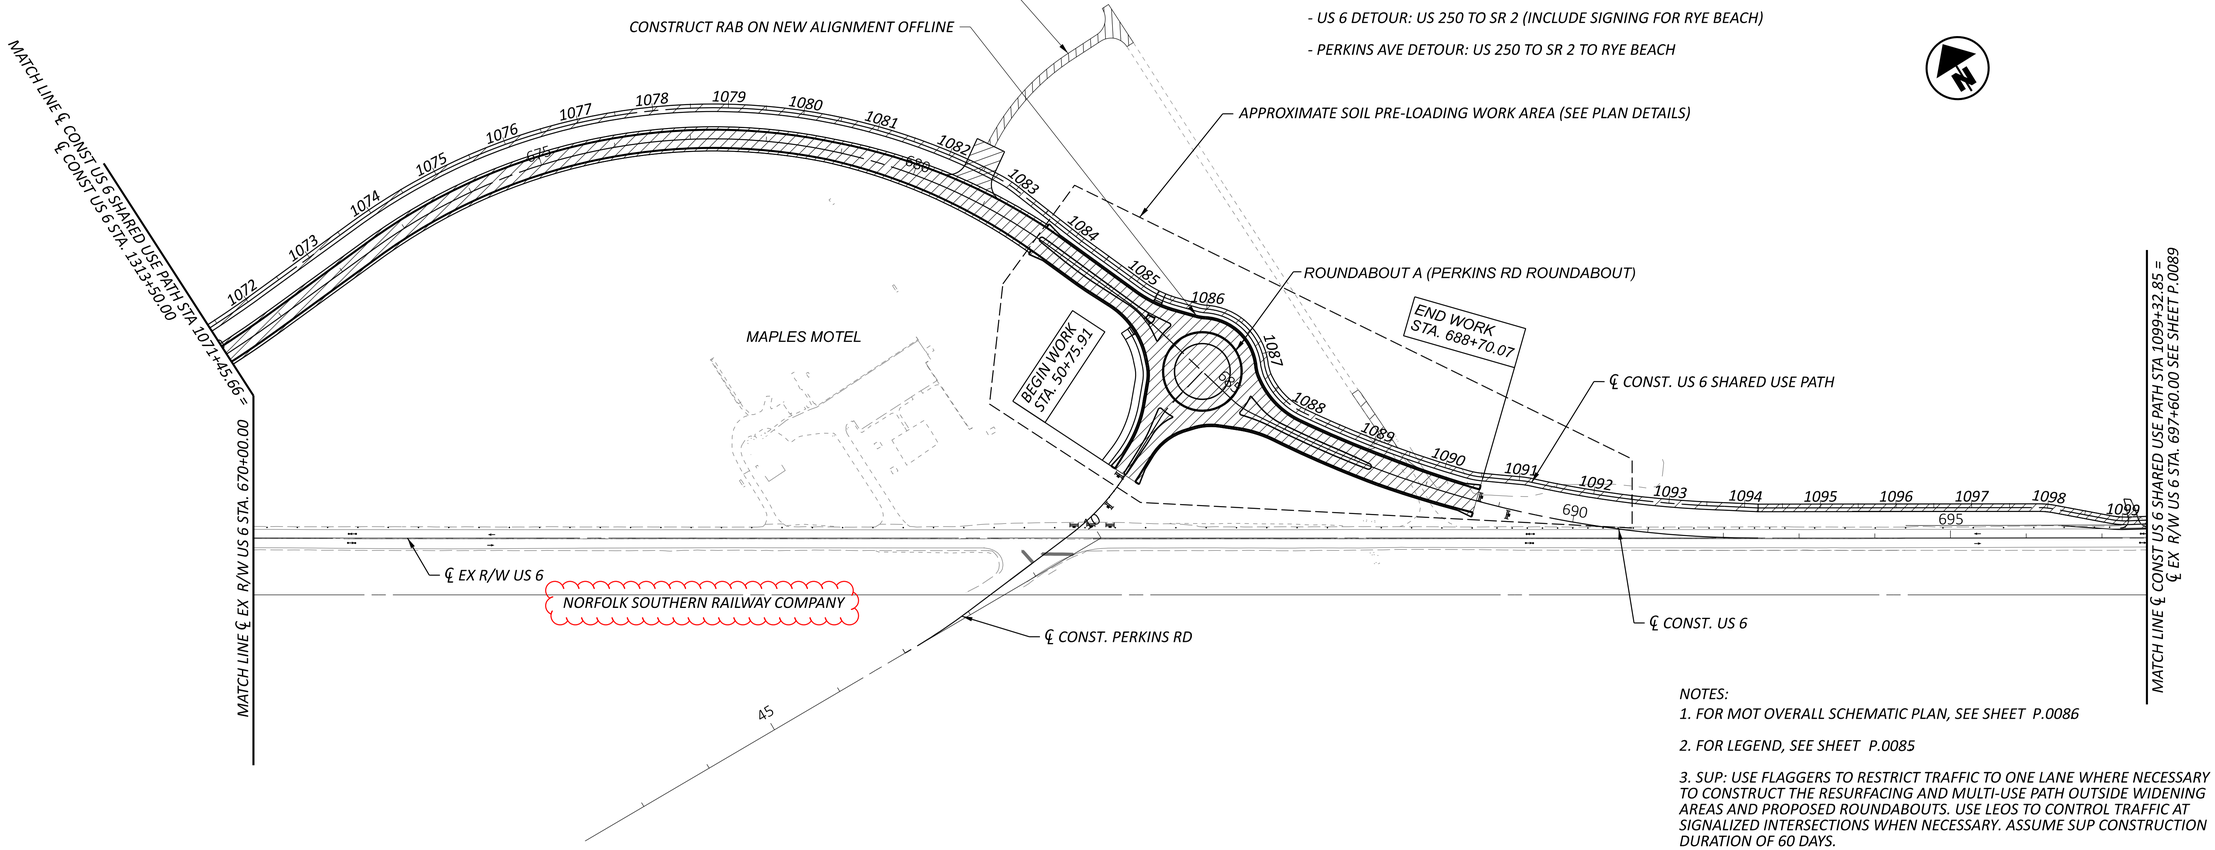

PERKINS ROAD ROUNDABOUT:
DURATION: 120 DAYS
CEDAR POINT: US 6/PERKINS, NO ROAD CLOSURES DURING TOURIST SEASON JUNE - OCTOBER

1. CONSTRUCT ROUNDABOUT WHILE MAINTAINING TRAFFIC ON US 6 (PROPOSED RAB IS NOT ALIGNED WITH EX. US 6)

2. CLOSE US 6 AND PERKINS AVE (CR 5) TO CONSTRUCT TIE-INS (30 DAYS)

- US 6 DETOUR: US 250 TO SR 2 (INCLUDE SIGNING FOR RYE BEACH)

- PERKINS AVE DETOUR: US 250 TO SR 2 TO RYE BEACH

NOTES:

1. FOR MOT OVERALL SCHEMATIC PLAN, SEE SHEET P.0086

2. FOR LEGEND, SEE SHEET P.0085

3. SUP: USE FLAGGERS TO RESTRICT TRAFFIC TO ONE LANE WHERE NECESSARY TO CONSTRUCT THE RESURFACING AND MULTI-USE PATH OUTSIDE WIDENING AREAS AND PROPOSED ROUNDABOUTS. USE LEOS TO CONTROL TRAFFIC AT SIGNALIZED INTERSECTIONS WHEN NECESSARY. ASSUME SUP CONSTRUCTION DURATION OF 60 DAYS.


HORIZONTAL SCALE IN FEET
0 50 100 200


MOT SCHEMATIC PLAN - PRE-PHASE (2026 CONSTRUCTION)
US 6 STA 645+00 TO STA 695+00

DESIGN AGENCY
TRANSYSTEMS
400 W. NATIONWIDE BLVD., STE 220
COLUMBUS, OHIO 43215

DESIGNER SSA
REVIEWER SS 10/27/25
PROJECT ID 116570
SHEET P.0088 TOTAL 1106

MODEL: GB103 [Sheet] PAPERSIZE: 34x22 (in.) DATE: 2/25/2026 TIME: 12:04:32 PM PLTDRV: OHDOT_PDF_Levels.pltcfg PENTBL: OHDOT_Pen.tbl USER: hrthornton@gftinc.com WORKSPACE: OHDOTCEv02 WORKSET: 116570 PRODUCT: OpenRoadsDesigner 24.00.02.25
pw:\\ohiodot-pw.bentley.com:ohiodot-pw-02\Documents\01 Active Projects\District 03\Erie\116570\402-Engineering_TranSystems\MOT\Sheets\116570_MB002_CY2026.dgn

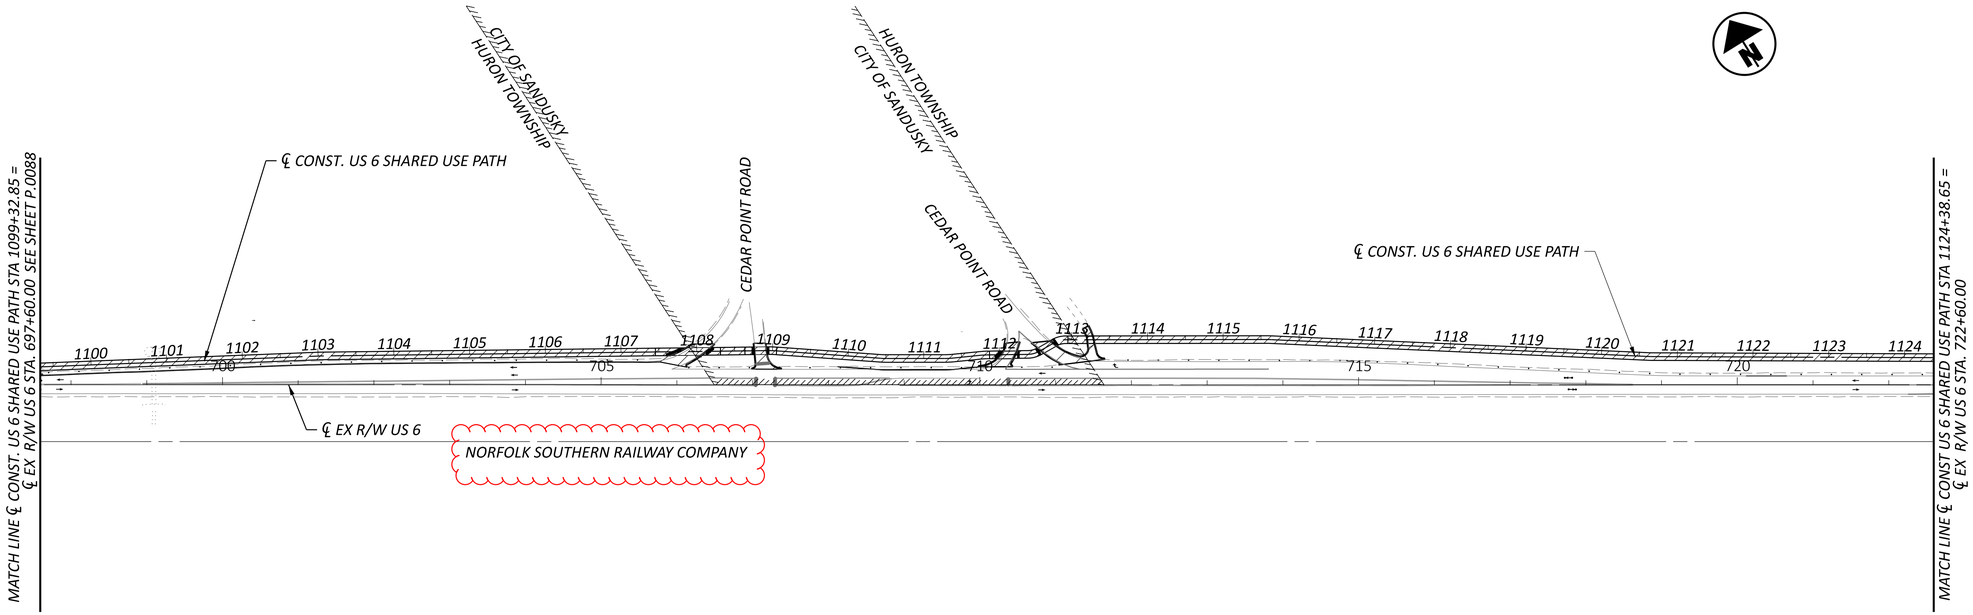

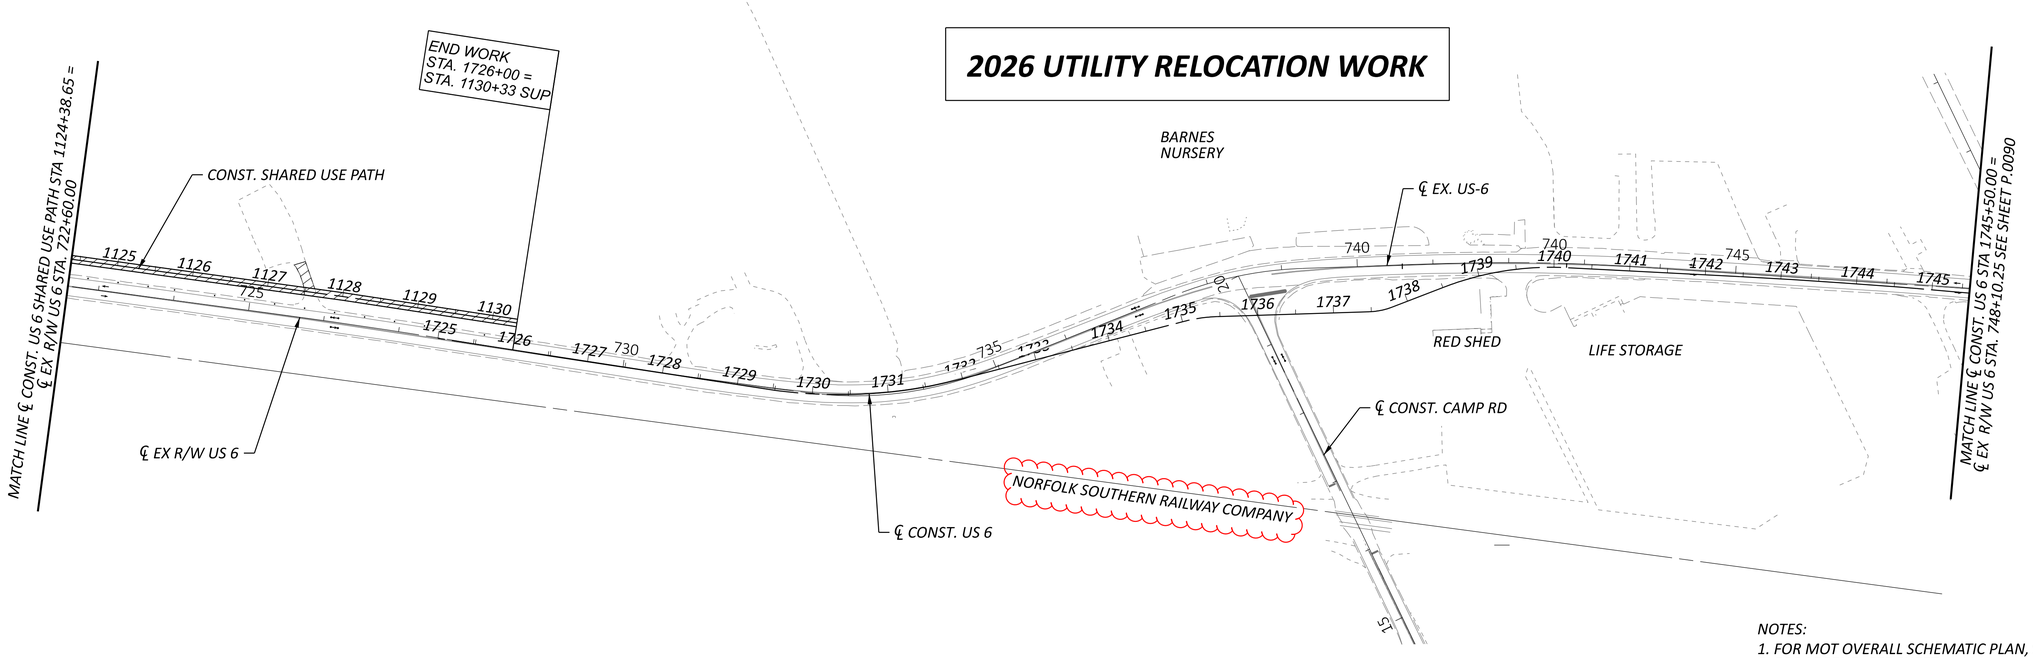

NOTES:
1. FOR MOT OVERALL SCHEMATIC PLAN, SEE SHEET P.0086
2. FOR LEGEND, SEE SHEET P.0085


HORIZONTAL SCALE IN FEET
0 50 100 200


MOT SCHEMATIC PLAN - PRE-PHASE (2026 CONSTRUCTION)
US 6 STA 695+00 TO STA 1745+50

DESIGN AGENCY
TRANSYSTEMS
400 W. NATIONWIDE BLVD., STE 220
COLUMBUS, OHIO 43215

DESIGNER	SSA
REVIEWER	SS 10/27/25
PROJECT ID	116570
SHEET	P.0089
TOTAL	1106

MODEL: 100 Scale 2 PAPERSIZE: 34x22 (in.) DATE: 2/25/2026 TIME: 12:20:19 PM PLTDRV: OHDOT_PDF_Levels.pltcfg PENTBL: OHDOT_Pen.tbl USER: hrthornton@gftinc.com WORKSPACE: OHDOTCEv02 WORKSET: 116570 PRODUCT: OpenRoadsDesigner 24.00.02.25
pw:\\ohiodot-pw.bentley.com:ohiodot-pw-02\Documents\01 Active Projects\District 03\Erie\116570\402-Engineering_TranSystems\MOT\Sheets\116570_MB001_CY2026.dgn

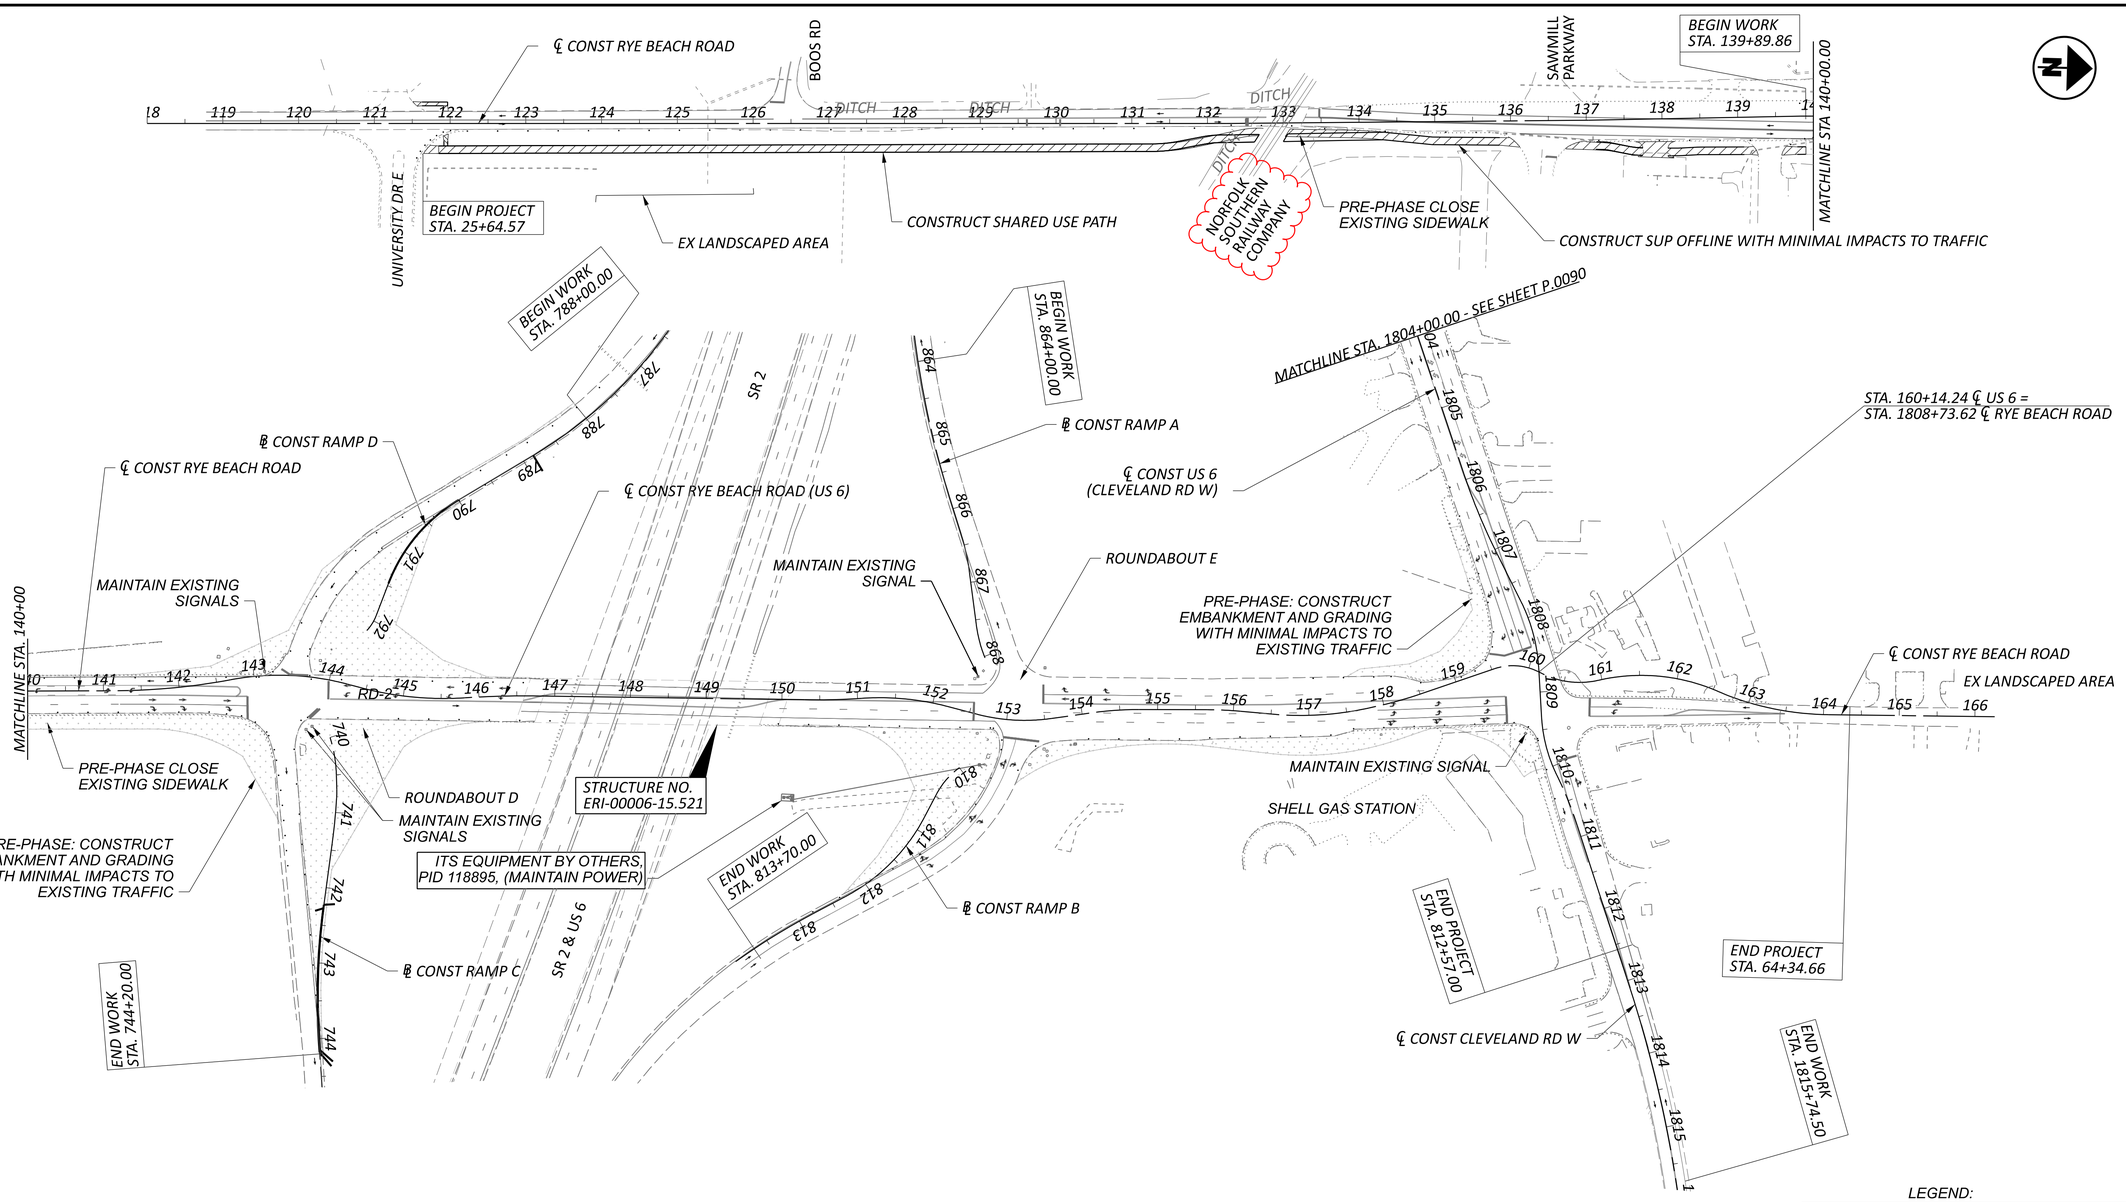

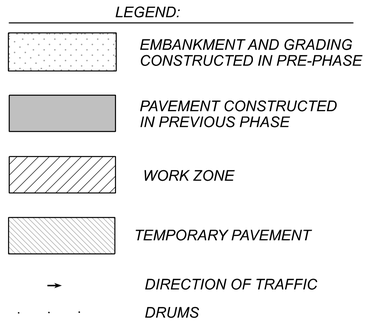

RYE BEACH ROUNDABOUTS:
DURATION: 180 DAYS
CEDAR POINT: NO ROAD CLOSURES ON US 6 DURING TOURIST SEASON IN JUNE - OCTOBER

PRE-PHASE:

CONSTRUCT EMBANKMENT, SUP AND GRADING WITH MINIMAL IMPACTS TO EXISTING TRAFFIC.

NOTES:

1. *FOR MOT OVERALL SCHEMATIC PLAN, SEE SHEET P.0086*
2. *FOR LEGEND, SEE SHEET P.0085*

HORIZONTAL SCALE IN FEET
0 50 100 200

MOT SCHEMATIC PLAN - PRE PHASE (2026 CONSTRUCTION)
RYE BEACH ROAD STA 118+00.00 TO STA 166+00.00

DESIGN AGENCY
TRANSYSTEMS
400 W. NATIONWIDE BLVD., STE 225
COLUMBUS, OHIO 43215

DESIGNER	SSA
REVIEWER	SS 10/27/25
PROJECT ID	116570
SHEET	P.0091
TOTAL	1106

MOT OVERALL SCHEMATIC PLAN - PHASE 1 (2026 CONSTRUCTION)

HORIZONTAL SCALE IN FEET
0 200 400 800

SUP MOT

SPORTS FORCE

℄ CONST US 6 SUP

℄ CONST US 6 (CLEVELAND RD W)

STRUCTURE NO. ERI-00006-12.481

NORFOLK SOUTHERN RAILWAY COMPANY

PERKINS AVE.

ROUNDABOUT A

℄ CONST US 6 SUP

MATCHLINE STA 1099+40.50

BEGIN CY 2026 MOT WORK

SEE SCHEMATIC PLAN P.0093

SEE SCHEMATIC PLAN P.0094

2026 UTILITY RELOCATION WORK (FOR 2027/2028 MOT)

MATCHLINE STA 1804+00.00

STRUCTURE NO. ERI-00006-15.070

℄ CONST US 6 (CLEVELAND RD W)

SEE SCHEMATIC PLAN P.0095

SEE SCHEMATIC PLAN P.0096

ROUNDABOUT B

℄ CONST US 6 SUP

MATCHLINE STA 1099+40.50

NORFOLK SOUTHERN RAILWAY COMPANY

CAMP RD.

END CY 2026 MOT WORK

℄ CONST RYE BEACH ROAD

℄ CLEVELAND RD W.

ROUNDABOUT C

℄ CONST RYE BEACH ROAD (US 6)

℄ CONST US 6 (CLEVELAND RD W)

MATCHLINE STA 1804+00.00

END CY 2026 MOT WORK

ROUNDABOUT E

℄ CONST RAMP B

SEE SCHEMATIC PLAN P.0097

SR 2 & US 6

SR 2

℄ CONST RAMP A

STRUCTURE NO. ERI-00006-15.521

℄ CONST RAMP C

℄ CONST RAMP D

ROUNDABOUT D

℄ CONST RYE BEACH ROAD

BEGIN CY 2026 MOT WORK


FOR DETOUR PLANS, SEE SHEET P.0105 AND SHEET P.0106

DESIGN AGENCY	TRANSYSTEMS 400 W. NATIONWIDE BLVD., STE 225 COLUMBUS, OHIO 43215
DESIGNER	SSA
REVIEWER	SS 10/27/25
PROJECT ID	116570
SHEET / TOTAL	P.0092 / 1106

ERI-US 0006-CONNECTIVITY CORRIDOR

MODEL: 400 Scale PAPERSIZE: 34x22 (in.) DATE: 2/25/2026 TIME: 12:27:40 PM PLTDRV: OHDOT_PDF_Levels.pltcfg PENTBL: OHDOT_Pen.tbl USER: hrthornton@gftinc.com WORKSPACE: OHDOTCEv02 WORKSET: 116570 PRODUCT: OpenRoadsDesigner 24.00.02.25
pw:\\ohiodot-pw.bentley.com:ohiodot-pw-02\Documents\01 Active Projects\District 03\Erie\116570\402-Engineering_TranSystems\MOT\Sheets\116570_MB003_CY2026.dgn

MODEL: GB101 [Sheet] PAPERSIZE: 34x22 (in.) DATE: 2/25/2026 TIME: 12:33:11 PM PLTDRV: OHDOT_PDF_Levels.pltcfg PENTBL: OHDOT_Pen.tbl USER: hrthornton@gftinc.com WORKSPACE: OHDOTCEv02 WORKSET: 116570 PRODUCT: OpenRoadsDesigner 24.00.02.25
pw:\\ohiodot-pw.bentley.com:ohiodot-pw-02\Documents\01 Active Projects\District 03\Erie\116570\402-Engineering_TranSystems\MOT\Sheets\116570_MB004_CY2026.dgn

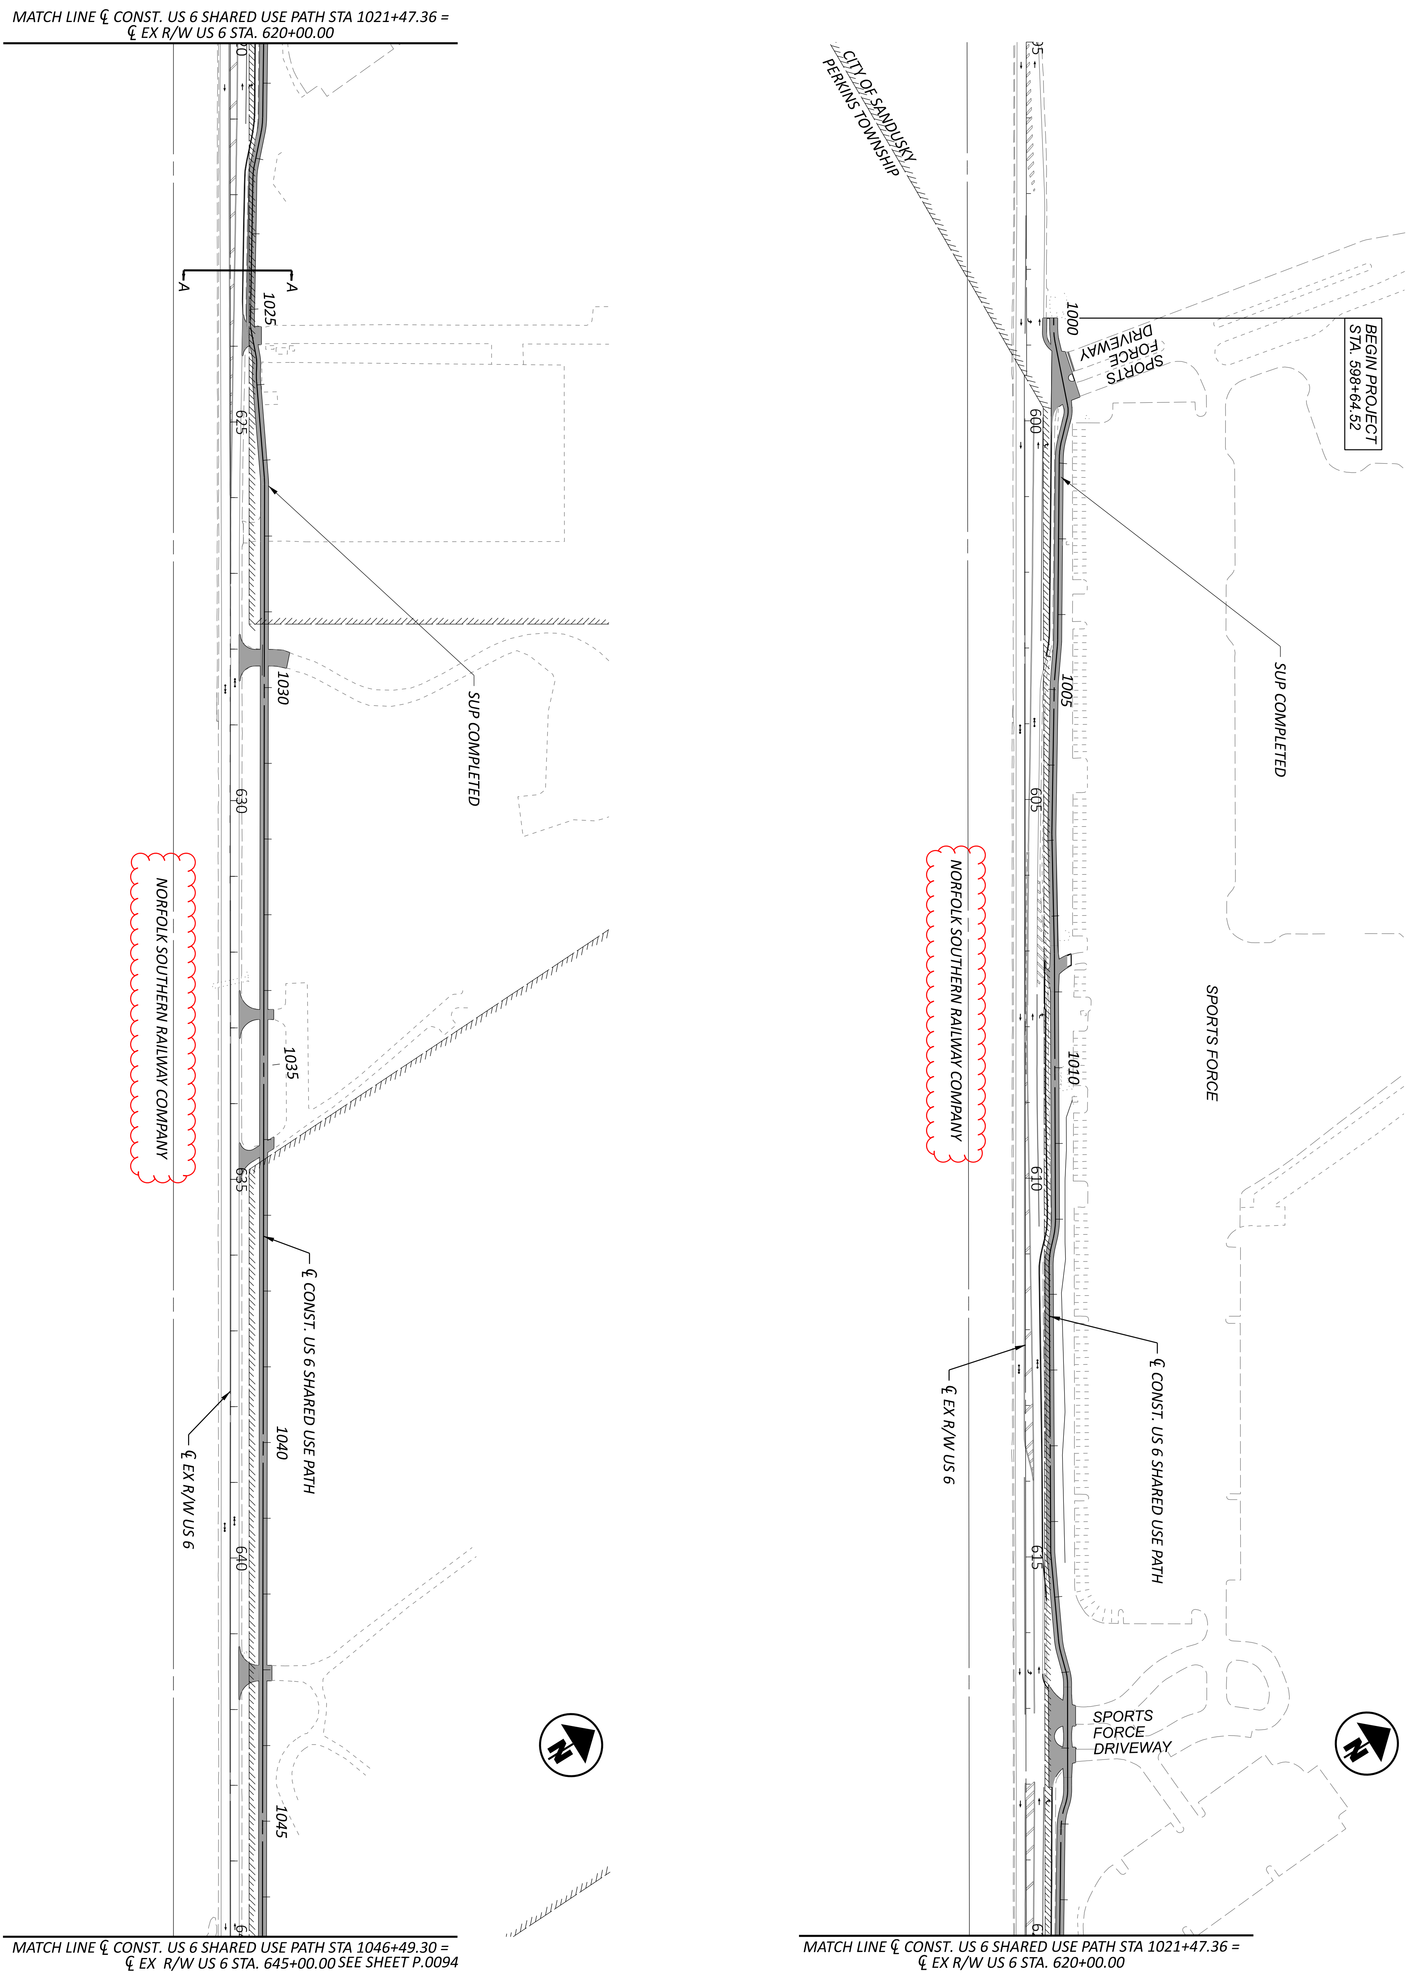

NOTES:
1. FOR MOT OVERALL SCHEMATIC PLAN, SEE SHEET P.0092
2. FOR LEGEND, SEE SHEET P.0085

SHEET	TOTAL
P.0093	1106

PROJECT ID: 116570

REVIEWER: SS 10/27/25


DESIGNER: SSA

TRANSYSTEMS
400 W. NATIONWIDE BLVD., STE 220
COLUMBUS, OHIO 43215

DESIGN AGENCY

MOT SCHEMATIC PLAN - PHASE 1 (2026 CONSTRUCTION)
US 6 BEGIN PROJECT TO STA 645+00

HORIZONTAL SCALE IN FEET
0 100
50 200

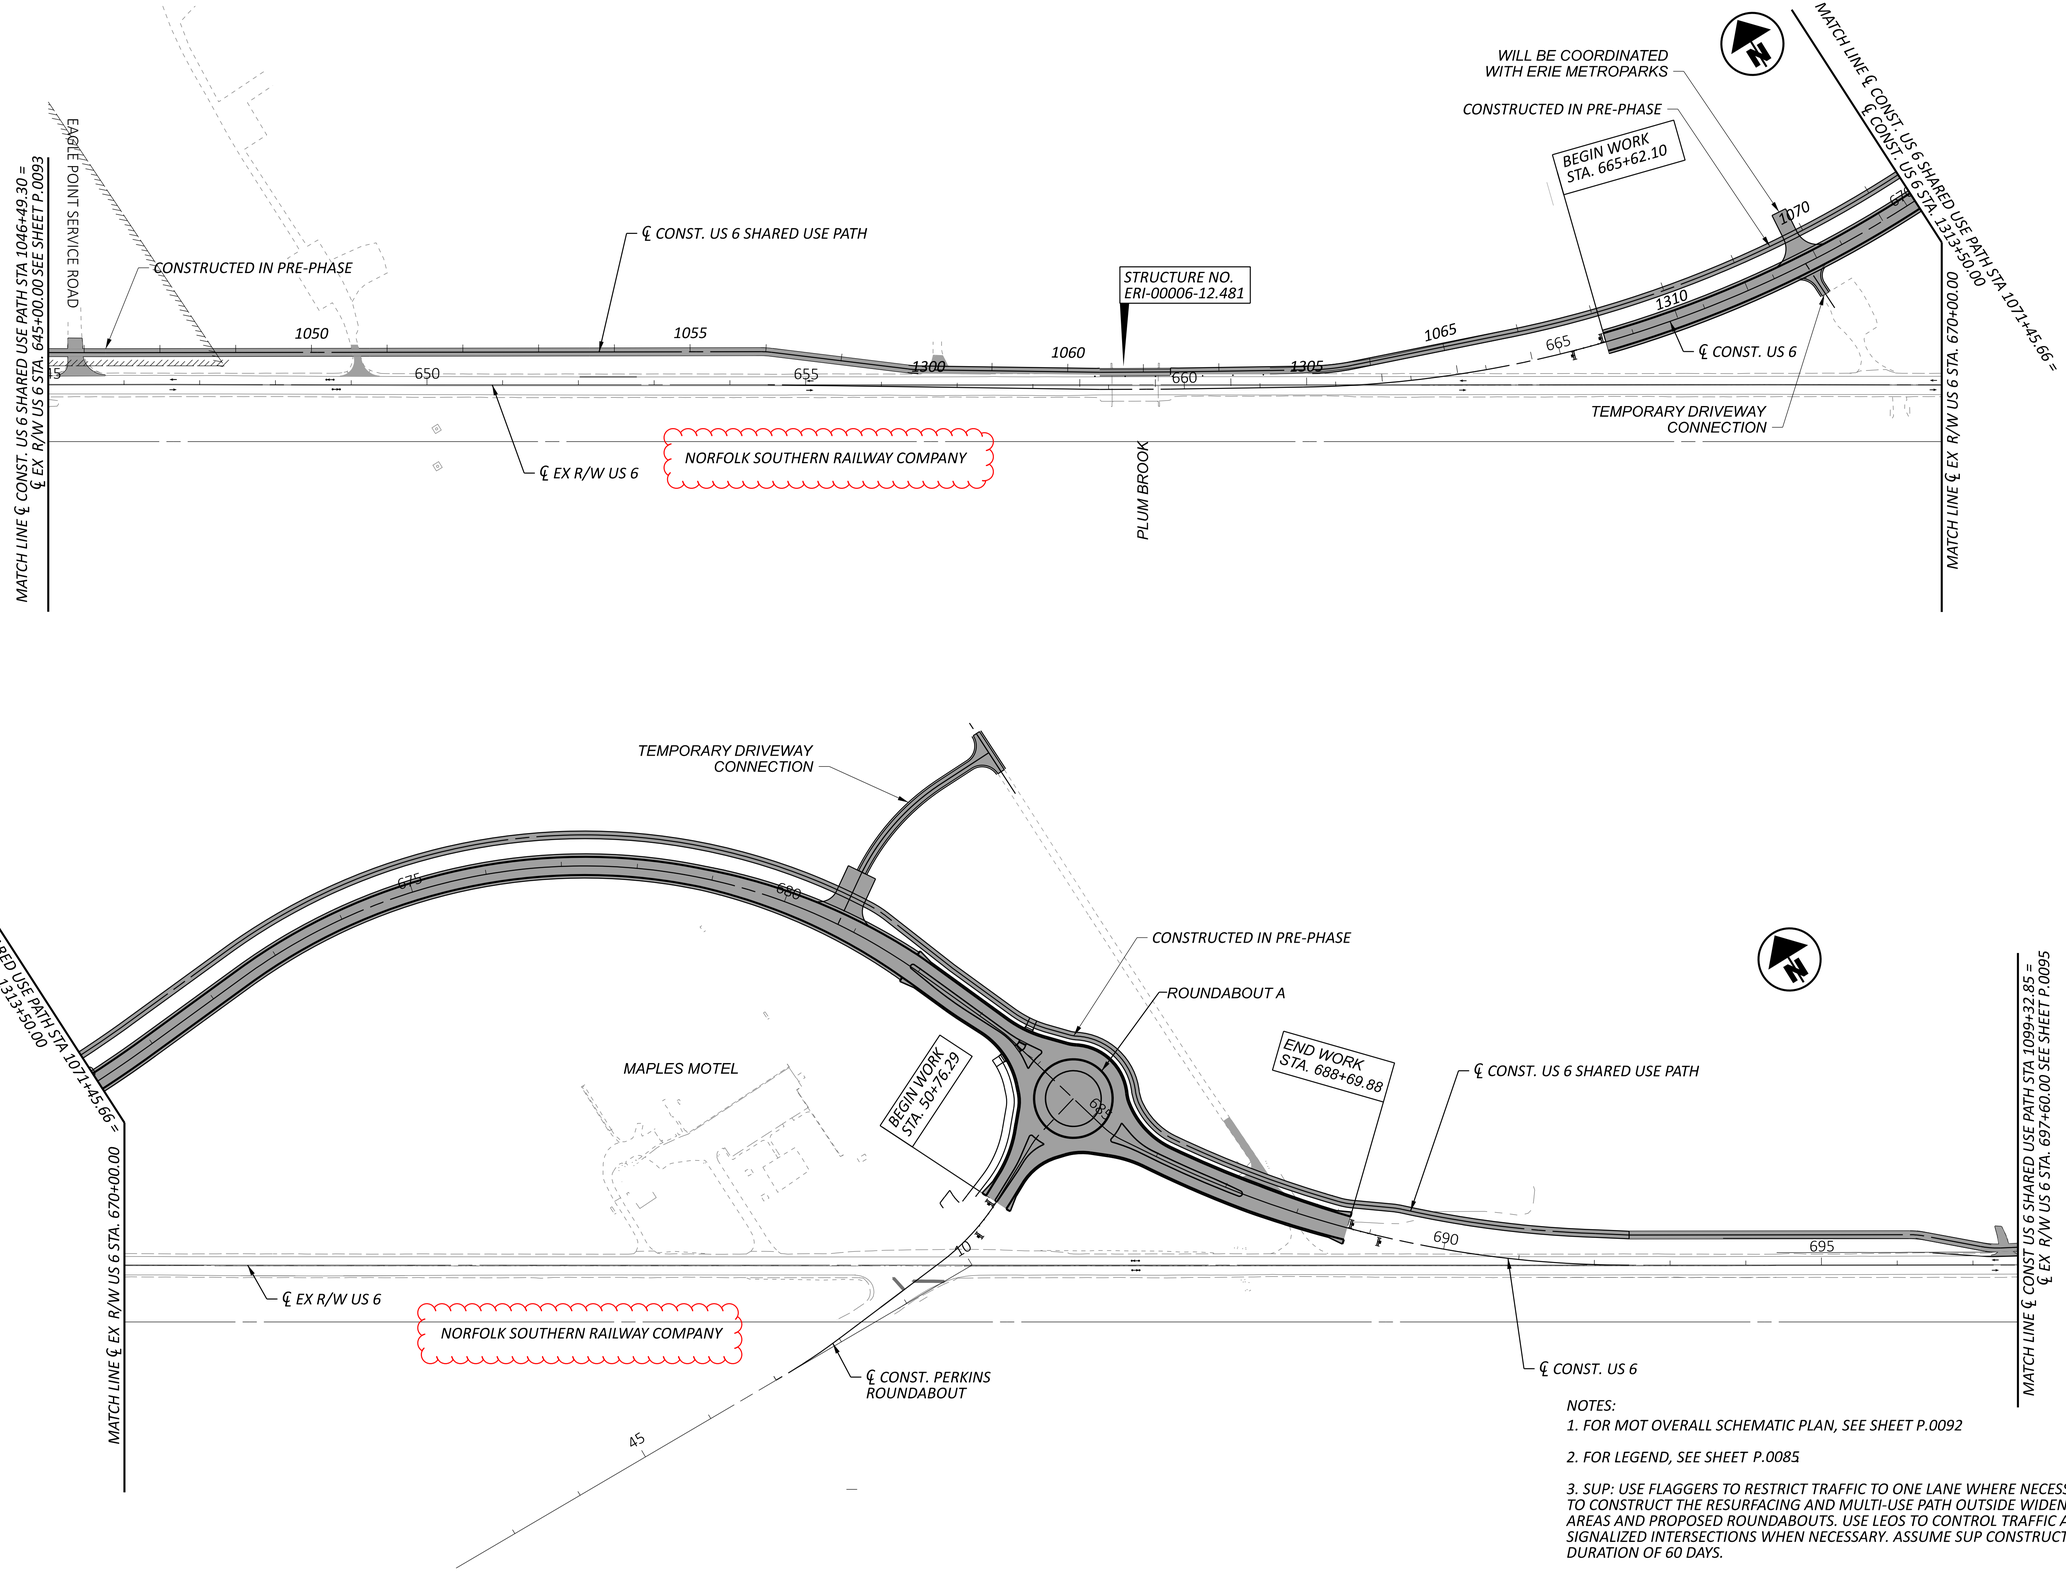

NOTES:

1. FOR MOT OVERALL SCHEMATIC PLAN, SEE SHEET P.0092

2. FOR LEGEND, SEE SHEET P.0085

3. SUP: USE FLAGGERS TO RESTRICT TRAFFIC TO ONE LANE WHERE NECESSARY TO CONSTRUCT THE RESURFACING AND MULTI-USE PATH OUTSIDE WIDENING AREAS AND PROPOSED ROUNDABOUTS. USE LEOS TO CONTROL TRAFFIC AT SIGNALIZED INTERSECTIONS WHEN NECESSARY. ASSUME SUP CONSTRUCTION DURATION OF 60 DAYS.

HORIZONTAL SCALE IN FEET
0 50 100 200


MOT SCHEMATIC PLAN - PHASE 1 (2026 CONSTRUCTION)
US 6 STA 645+00 TO STA 695+00


ERI-US 0006-CONNECTIVITY CORRIDOR

MODEL: GB102 [Sheet] PAPERSIZE: 34x22 (in.) DATE: 2/25/2026 TIME: 12:36:21 PM PLTDRV: OHDOT_PDF_Levels.pltcfg PENTBL: OHDOT_Pen.tbl USER: hrthornton@gftinc.com WORKSPACE: OHDOTCEv02 WORKSET: 116570 PRODUCT: OpenRoadsDesigner 24.00.02.25
pw:\\ohiodot-pw.bentley.com:ohiodot-pw-02\Documents\01 Active Projects\District 03\Erie\116570\402-Engineering_TranSystems\MOT\Sheets\116570_MB004_CY2026.dgn

DESIGN AGENCY
TRANSYSTEMS
400 W. NATIONWIDE BLVD., STE 225
COLUMBUS, OHIO 43215

DESIGNER	
SSA	
REVIEWER	
SS	10/27/25
PROJECT ID	
116570	
SHEET	TOTAL
P.0094	1106

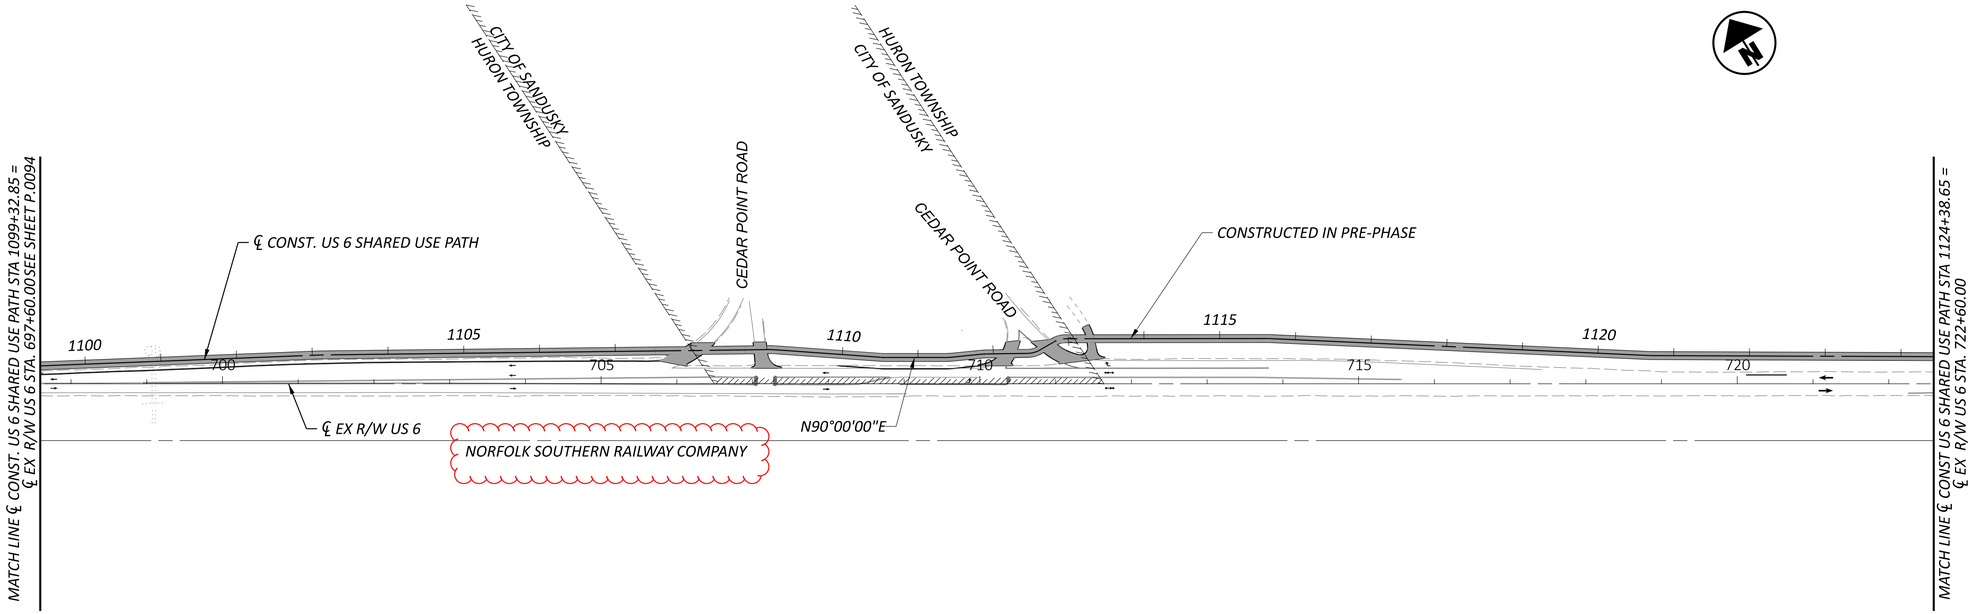

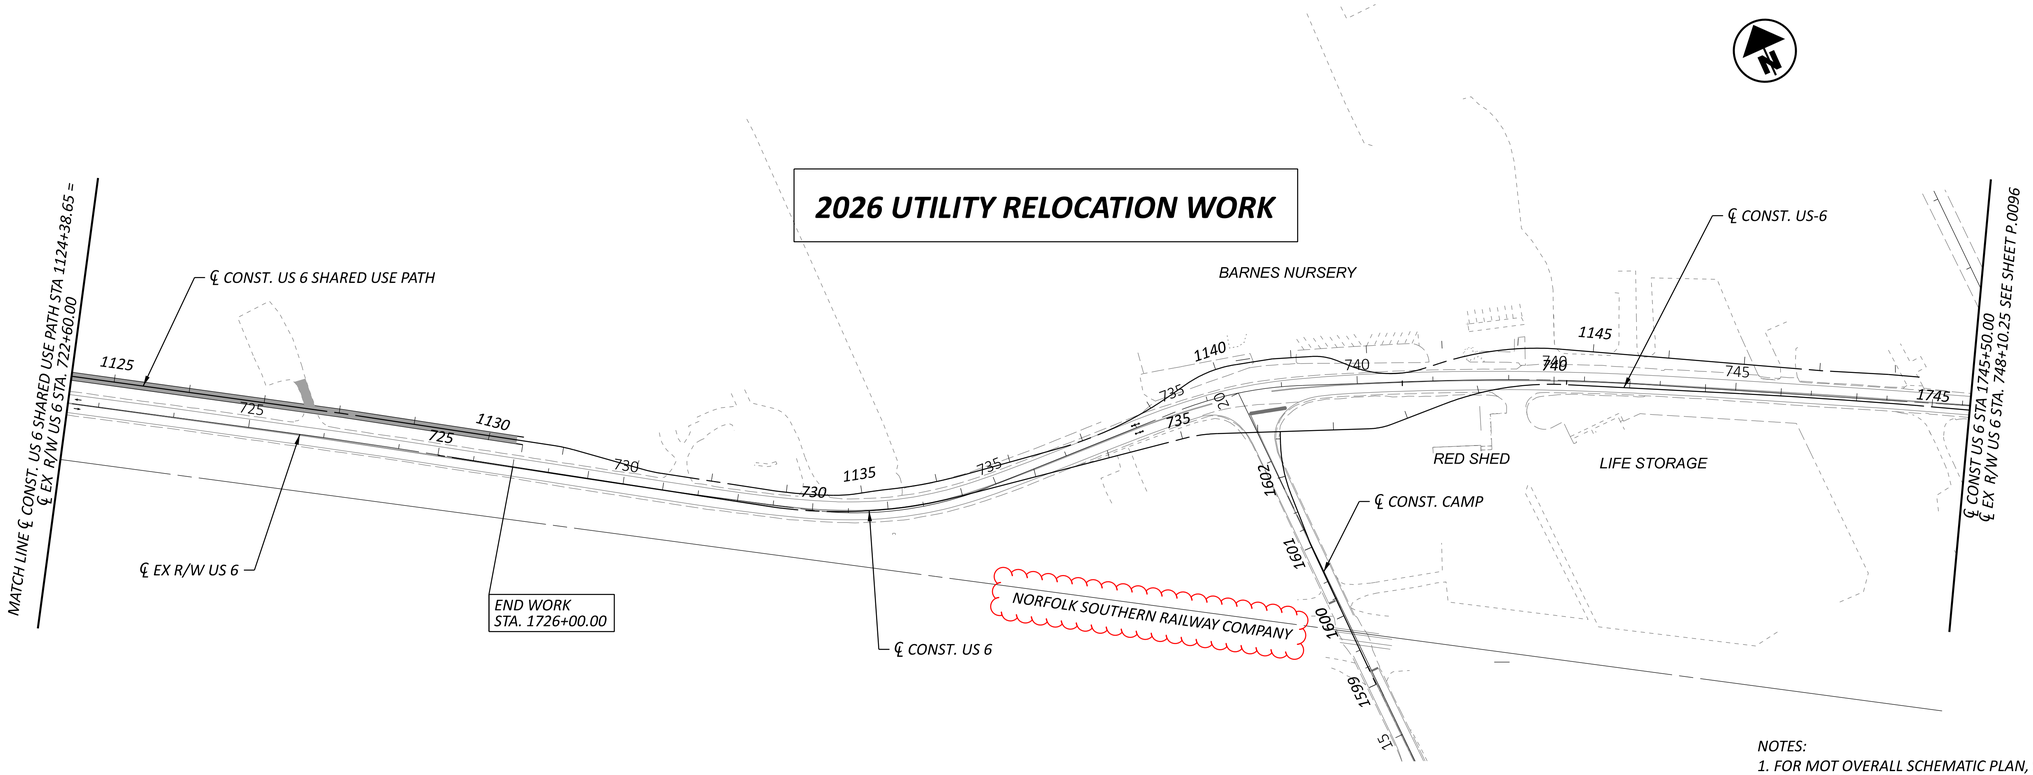

NOTES:
1. FOR MOT OVERALL SCHEMATIC PLAN, SEE SHEET P.0092
2. FOR LEGEND, SEE SHEET P.0085

HORIZONTAL SCALE IN FEET
0 50 100 200


MOT SCHEMATIC PLAN - PHASE 1 (2026 CONSTRUCTION)
US 6 STA 695+00 TO STA 745+50

DESIGN AGENCY
TRANSYSTEMS
400 W. NATIONWIDE BLVD. STE 225
COLUMBUS, OHIO 43215

DESIGNER	SSA
REVIEWER	SS 10/27/25
PROJECT ID	116570
SHEET	P.0095
TOTAL	1106

ERI-US 0006-CONNECTIVITY CORRIDOR

MODEL: GB103 [Sheet] PAPERSIZE: 34x22 (in.) DATE: 2/25/2026 TIME: 12:38:59 PM PLTDRV: OHDOT_PDF_Levels.pltcfg PENTBL: OHDOT_Pen.tbl USER: hrthornton@gftinc.com WORKSPACE: OHDOTCEv02 WORKSET: 116570
pw:\\ohiodot-pw.bentley.com:ohiodot-pw-02\Documents\01 Active Projects\District 03\Erie\116570\402-Engineering_TranSystems\MOT\Sheets\116570_MB004_CY2026.dgn

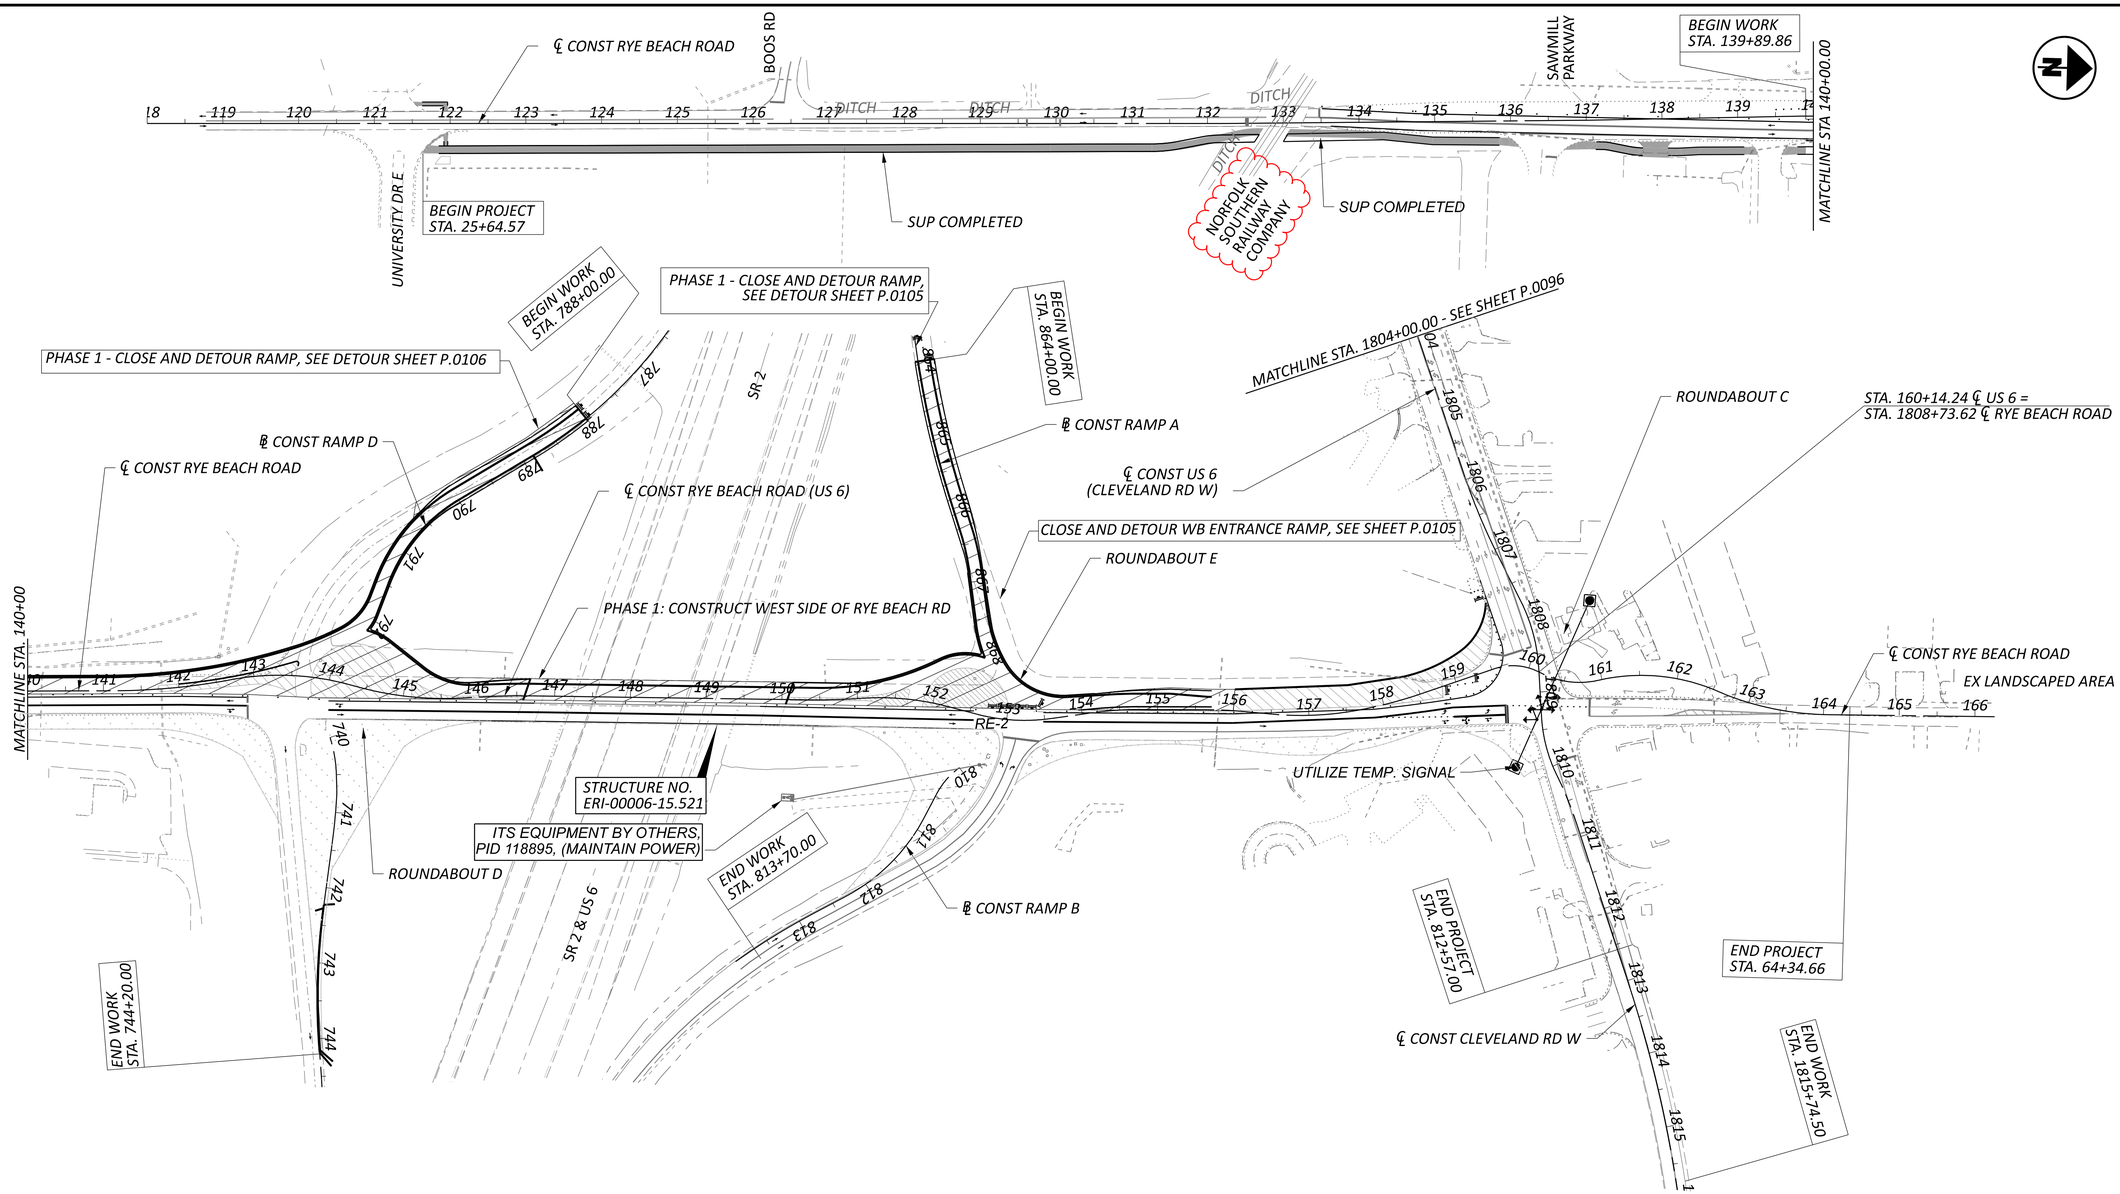

HORIZONTAL SCALE IN FEET
0 50 100 200

RYE BEACH INTERCHANGE:
DURATION: 180 DAYS
CEDAR POINT: NO EAST SIDE ROAD CLOSURES ON US 6 DURING TOURIST SEASON IN JUNE - OCTOBER

PHASE 1. SHIFT ONE LANE OF TRAFFIC EACH DIRECTION TO THE EAST SIDE OF RYE BEACH RD AND CONSTRUCT THE WEST SIDE. CLOSE AND DETOUR THE RAMPS ON THE WEST SIDE OF THE INTERCHANGE (THESE CLOSURES CAN BE DONE ANYTIME)

- WB ENTRANCE: SR 2 EB TO SR 13 NB TO SR 2 WB

- EB EXIT: SR 2 EB TO SR 13 NB TO SR 2 WB TO RYE BEACH RD

NOTES:
1. FOR MOT OVERALL SCHEMATIC PLAN, SEE SHEET P.0086
2. FOR LEGEND, SEE SHEET P.0085


MOT SCHEMATIC PLAN - PHASE 1 (2026 CONSTRUCTION)
RYE BEACH ROAD STA 118+00.00 TO STA 166+00.00

ERI-US 0006-CONNECTIVITY CORRIDOR

DESIGN AGENCY
TRANSYSTEMS
400 W. NATIONWIDE BLVD., STE 225
COLUMBUS, OHIO 43215

DESIGNER SSA
REVIEWER SS 10/27/25
PROJECT ID 116570
SHEET P.0097 TOTAL 1106

MODEL: 100 Scale 2 PAPERSIZE: 34x22 (in.) DATE: 2/25/2026 TIME: 12:44:24 PM PLTDRV: OHDOT_PDF_Levels.pltcfg PENTBL: OHDOT_Pen.tbl USER: hrthornton@gftinc.com WORKSPACE: OHDOTCEx02 WORKSET: 116570 PRODUCT: OpenRoadsDesigner 24.00.02.25
pw:\\ohiodot-pw.bentley.com:ohiodot-pw-02\Documents\01 Active Projects\District 03\Erie\116570\402-Engineering_TranSystems\MOT\Sheets\116570_MB003_CY2026.dgn
hrthornton@gftinc.com

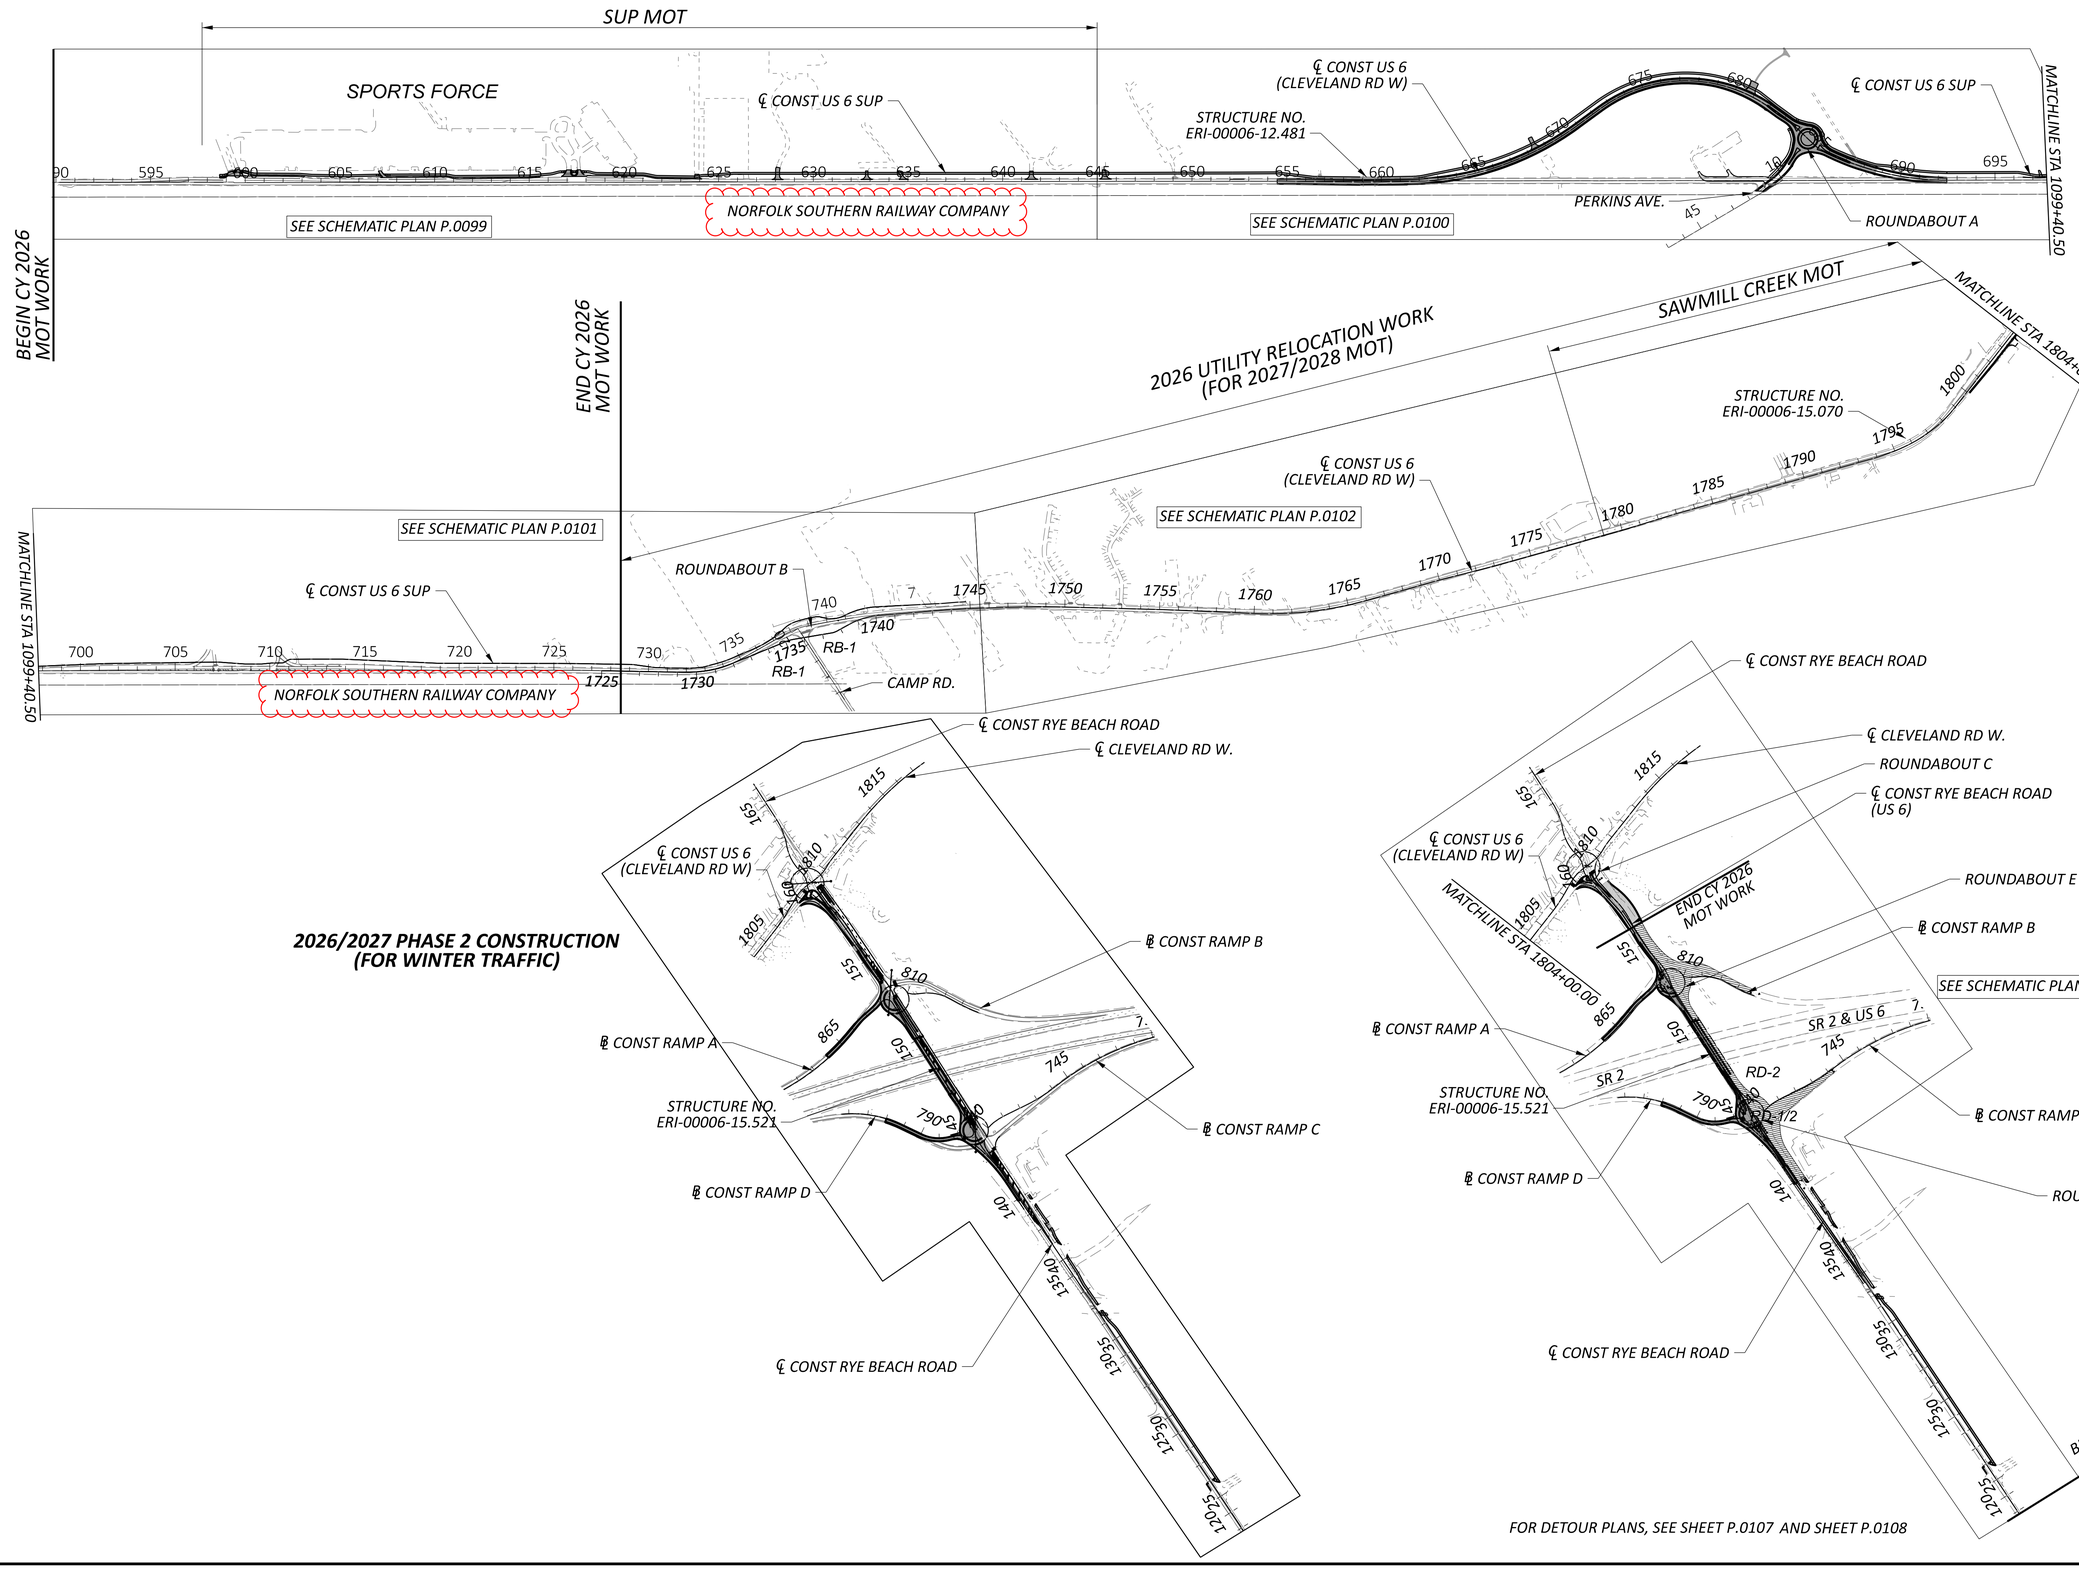

MOT OVERALL SCHEMATIC PLAN - PHASE 2 (2026 CONSTRUCTION)

ERI-US 0006-CONNECTIVITY CORRIDOR


MODEL: 400 Scale PAPERSIZE: 34x22 (in.) DATE: 2/25/2026 TIME: 12:49:50 PM PLTDRV: OHDOT_PDF_Levels.pltcfg PENTBL: OHDOT_Pen.tbl USER: hrthornton@gftinc.com WORKSPACE: OHDOTCEv02 WORKSET: 116570 PRODUCT: OpenRoadsDesigner 24.00.02.25
pw:\\ohiodot-pw.bentley.com:ohiodot-pw-02\Documents\01 Active Projects\District 03\Erie\116570\402-Engineering_TranSystems\MOT\Sheets\116570_MB005_CY2026.dgn

DESIGN AGENCY
TRANSYSTEMS
400 W. NATIONWIDE BLVD., STE 225
COLUMBUS, OHIO 43215

DESIGNER	SSA
REVIEWER	SS 10/27/25
PROJECT ID	116570
SHEET	P.0098
TOTAL	1106

ERI-US 0006-CONNECTIVITY CORRIDOR

MODEL: GB101 [Sheet] PAPERSIZE: 34x22 (in.) DATE: 2/25/2026 TIME: 12:54:35 PM PLTDRV: OHDOT_PDF_Levels.pltcfg PENTBL: OHDOT_Pen.tbl USER: hrthornton@gftinc.com WORKSPACE: OHDOTCEv02 WORKSET: 116570 PRODUCT: OpenRoadsDesigner 24.00.02.25
pw:\\ohiodot-pw.bentley.com:ohiodot-pw-02\Documents\01 Active Projects\District 03\Erie\116570\402-Engineering_TranSystems\MOT\Sheets\116570_MB006_CY2026.dgn

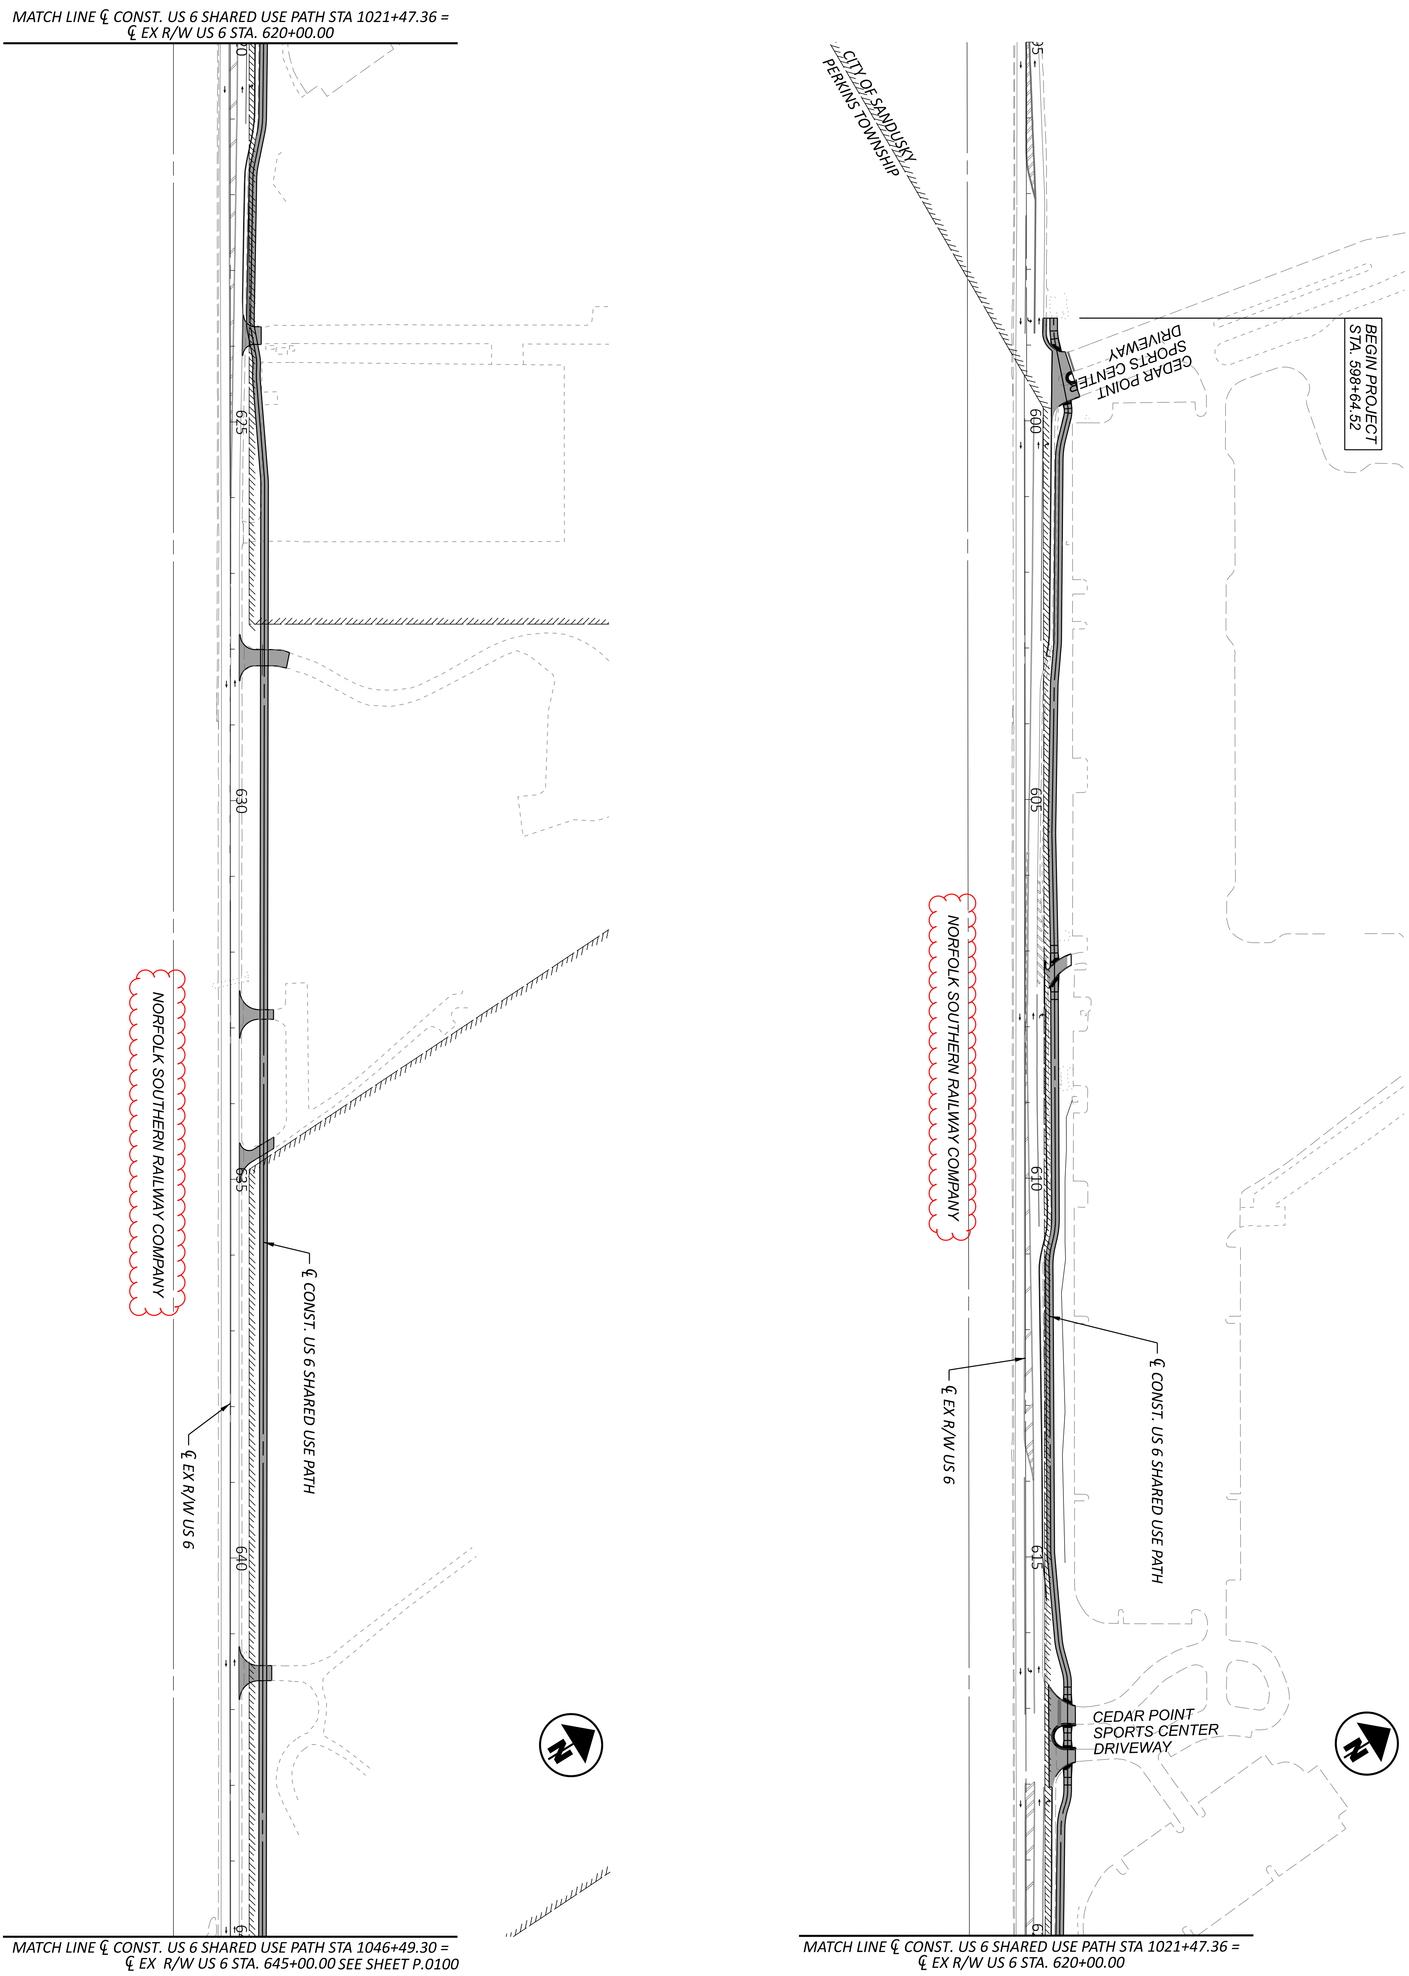

NOTES:
1. FOR MOT OVERALL SCHEMATIC PLAN, SEE SHEET P.0098
2. FOR LEGEND, SEE SHEET P.0085


SHEET	TOTAL	PROJECT ID	REVIEWER	DESIGNER	DESIGN AGENCY
P.0099	1106	116570	SS 10/27/25	SSA	TRANSYSTEMS 400 W. NATIONWIDE BLVD., STE 220 COLUMBUS, OHIO 43215

MOT SCHEMATIC PLAN - PHASE 2 (2026 CONSTRUCTION)
US 6 BEGIN PROJECT TO STA 645+00

HORIZONTAL SCALE IN FEET
0 100
50 200

ERI-US 0006-CONNECTIVITY CORRIDOR

MODEL: GB102 [Sheet] PAPERSIZE: 34x22 (in.) DATE: 2/25/2026 TIME: 12:58:01 PM PLTDRV: OHDOT_PDF_Levels.pltcfg PENTBL: OHDOT_Pen.tbl USER: hrthornton@gftinc.com WORKSPACE: OHDOTCEv02 WORKSET: 116570 PRODUCT: OpenRoadsDesigner 24.00.02.25
pw:\\ohiodot-pw.bentley.com:ohiodot-pw-02\Documents\01 Active Projects\District 03\Erie\116570\402-Engineering_TranSystems\MOT\Sheets\116570_MB006_CY2026.dgn

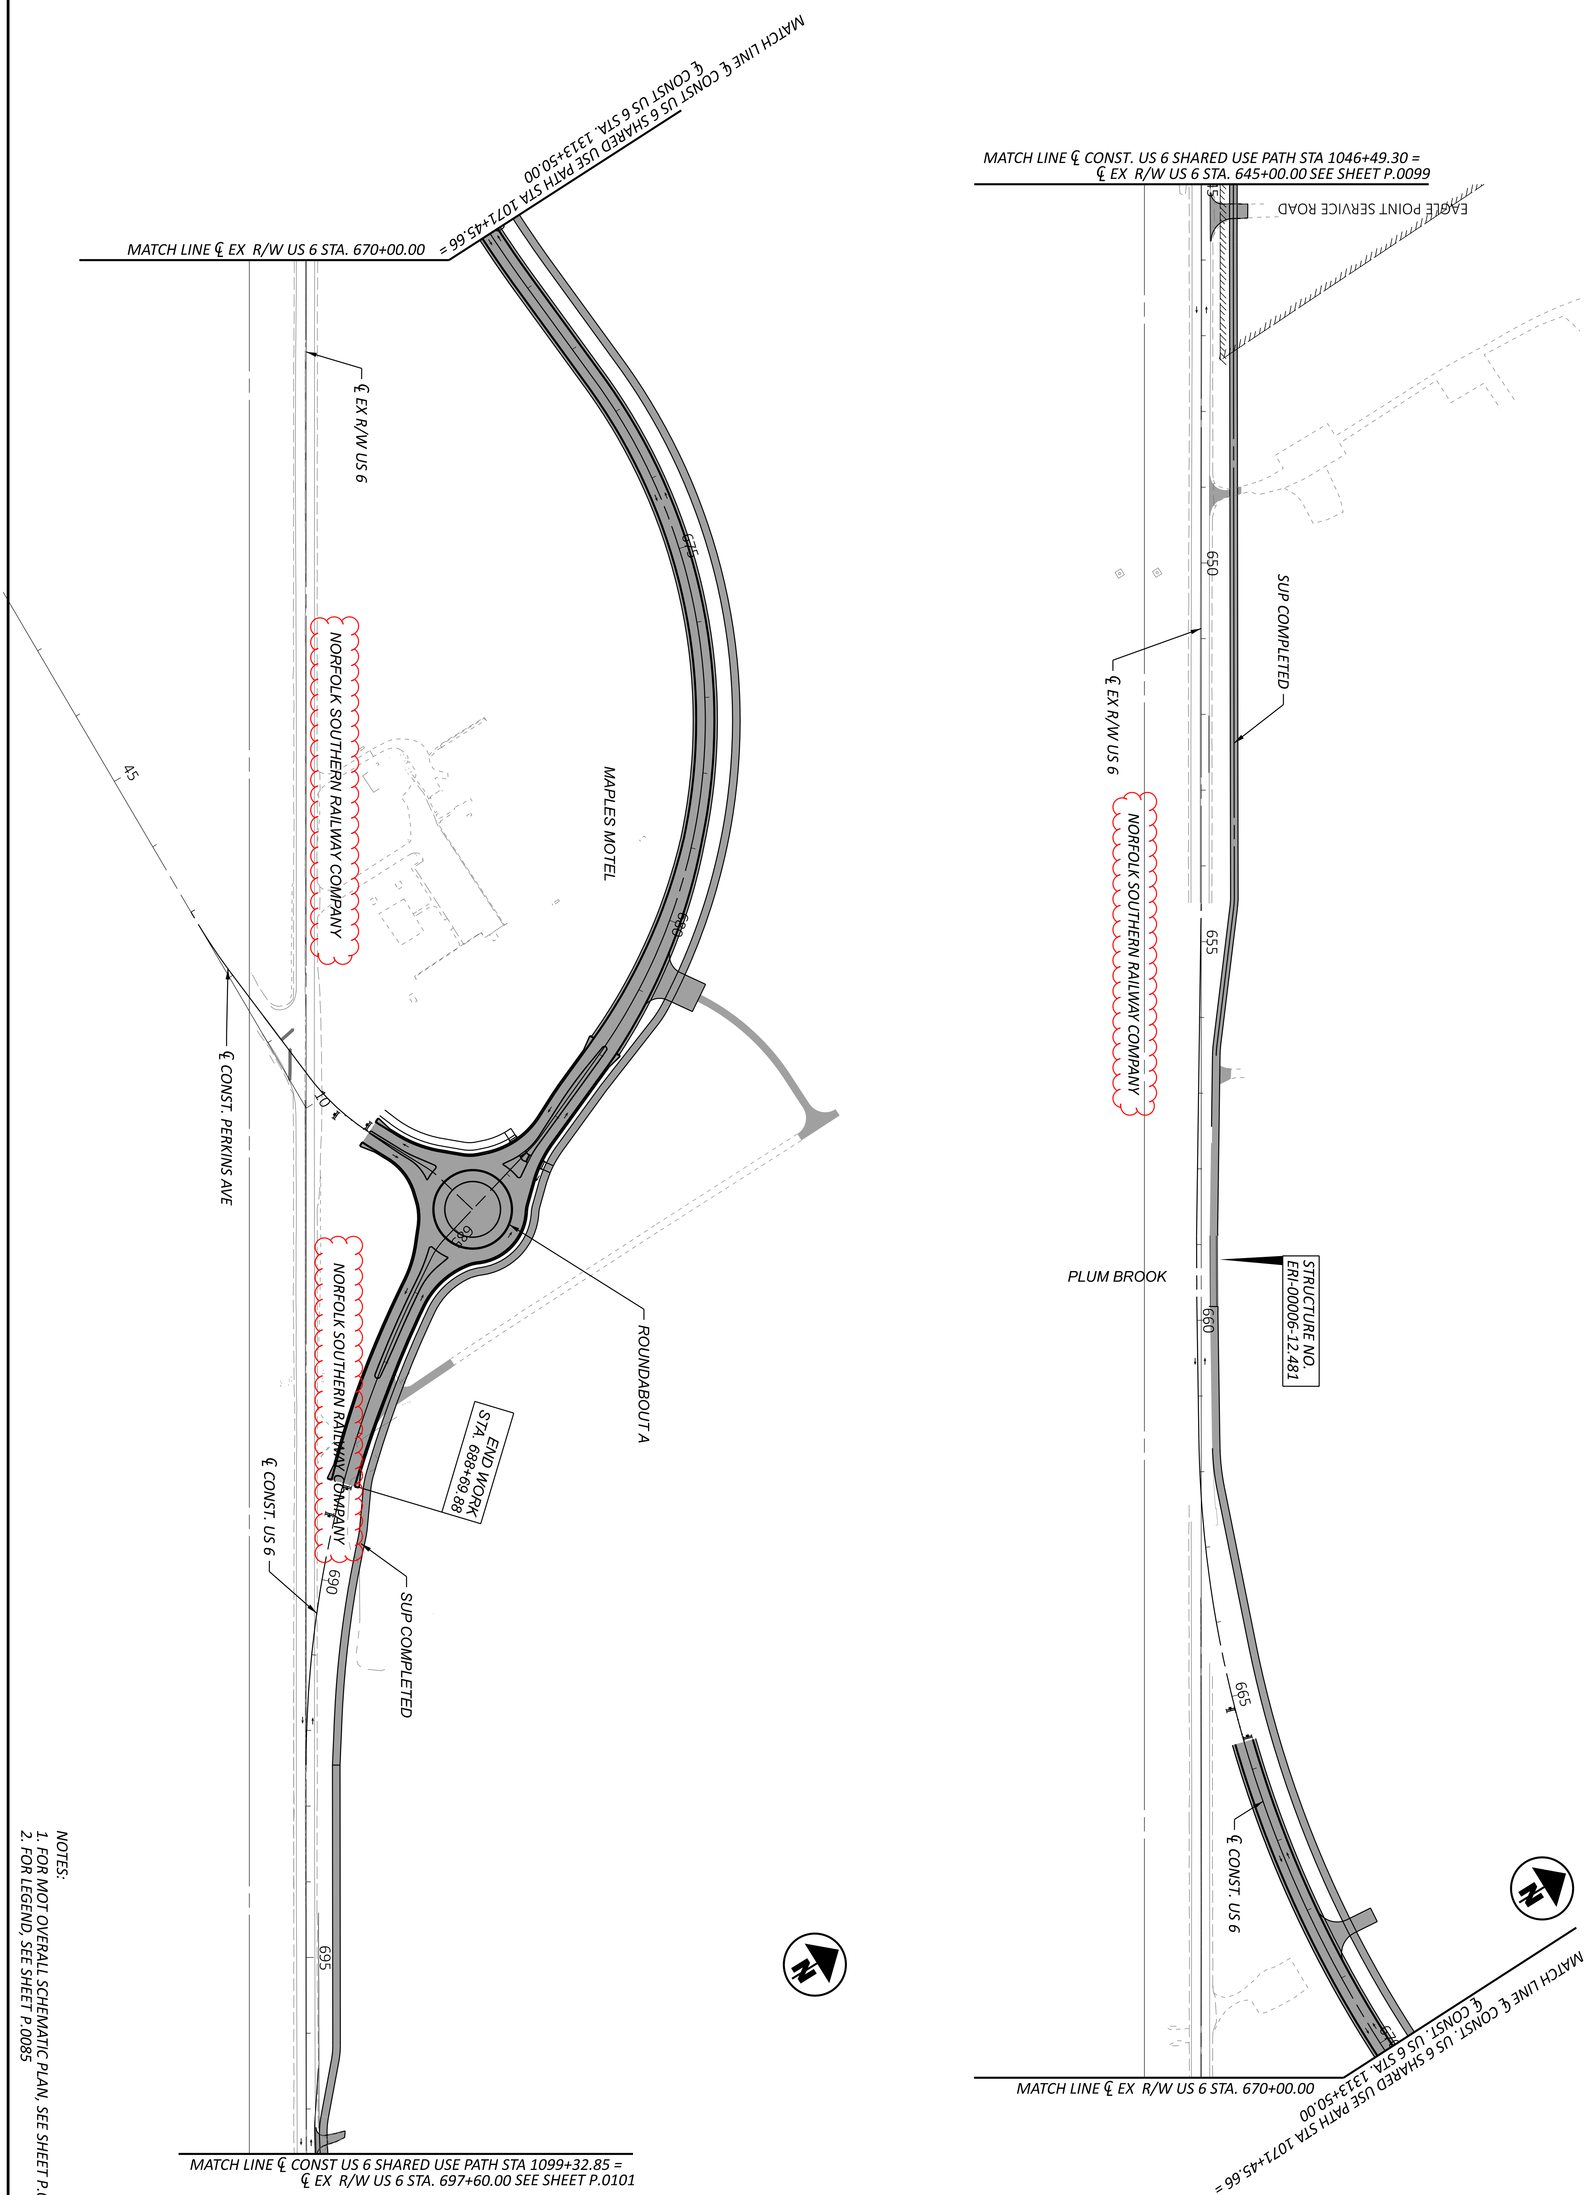

NOTES:
1. FOR MOT OVERALL SCHEMATIC PLAN, SEE SHEET P.0098
2. FOR LEGEND, SEE SHEET P.0085


SHEET	PROJECT ID	REVIEWER	DESIGNER	DESIGN AGENCY
P.0100	116570	SS 10/27/25	SSA	TRANSYSTEMS 400 W. NATIONWIDE BLVD., STE 220 COLUMBUS, OHIO 43215
TOTAL 1106				


MOT SCHEMATIC PLAN - PHASE 2 (2026 CONSTRUCTION)
US 6 STA 645+00 TO STA 695+00

HORIZONTAL SCALE IN FEET
0 100
50 200

MODEL: GB103 (Sheet) PAPERSIZE: 34x22 (in.) DATE: 2/25/2026 TIME: 1:03:06 PM PLTDRV: OHDOT_PDF_Levels.pltcfg PENTBL: OHDOT_Pen.tbl USER: hrthornton@gftinc.com WORKSPACE: OHDOTCEv02 WORKSET: 116570 PRODUCT: OpenRoadsDesigner 24.00.02.25
pw:\\ohiodot-pw.bentley.com:ohiodot-pw-02\Documents\01 Active Projects\District 03\Erie\116570\402 Engineering_TranSystems\MOT\Sheets\116570_MB006_CY2026.dgn

ERI-US 0006-CONNECTIVITY CORRIDOR

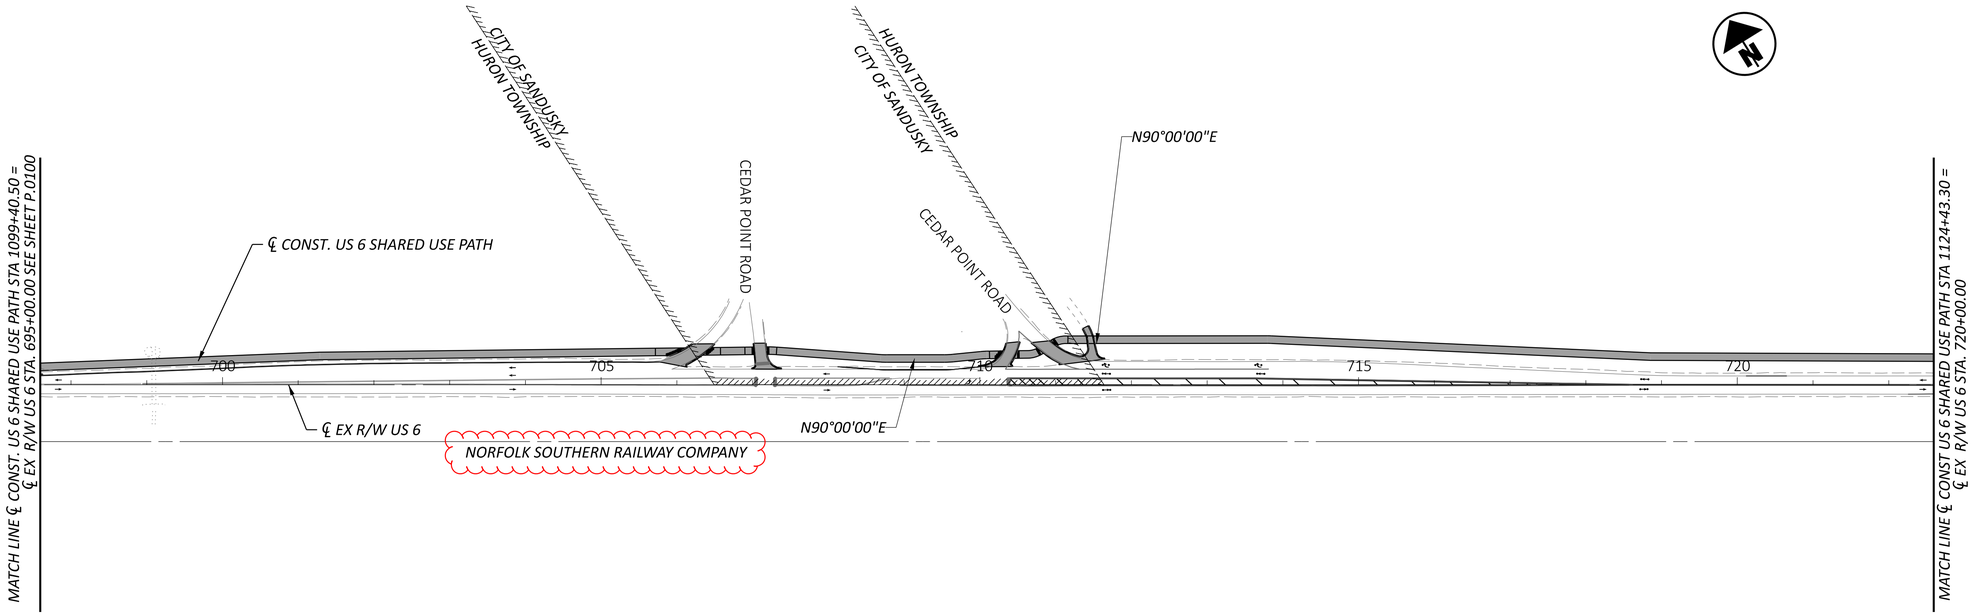

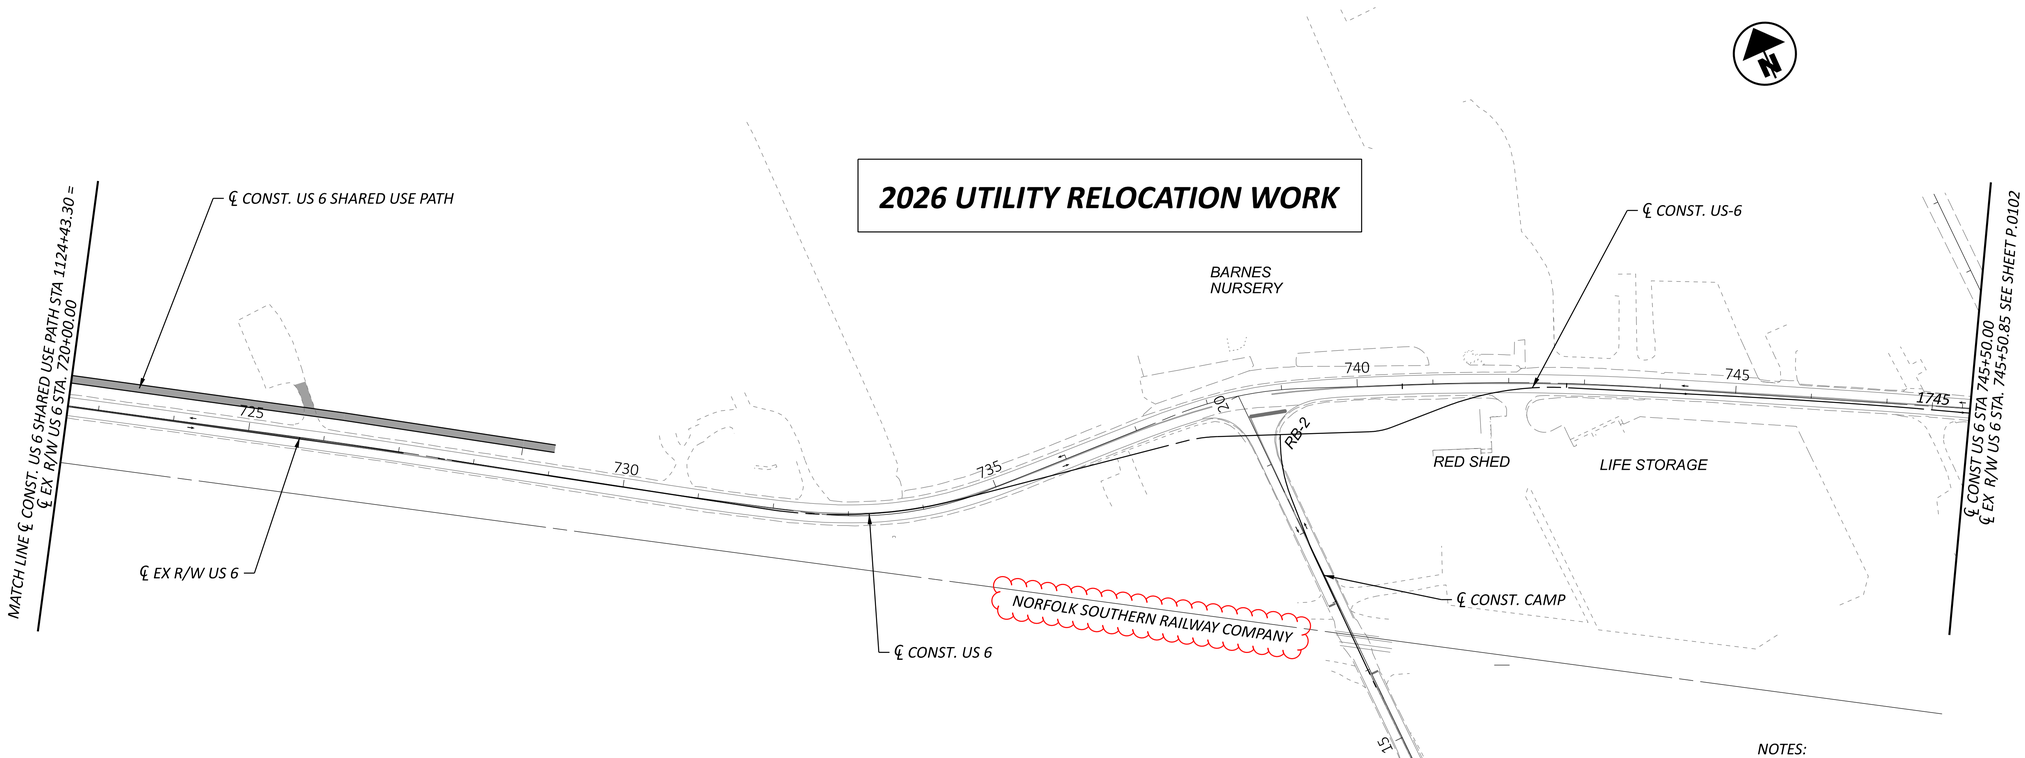


NOTES:
1. FOR MOT OVERALL SCHEMATIC PLAN, SEE SHEET P.0098
2. FOR LEGEND, SEE SHEET P.0085

HORIZONTAL SCALE IN FEET
0 50 100 200

MOT SCHEMATIC PLAN - PHASE 2 (2026 CONSTRUCTION)
US 6 STA 695+00 TO STA 745+50

DESIGN AGENCY
TRANSYSTEMS
400 W. NATIONWIDE BLVD., STE 225
COLUMBUS, OHIO 43215

DESIGNER	SSA
REVIEWER	SS 10/27/25
PROJECT ID	116570
SHEET	P.0101
TOTAL	1106

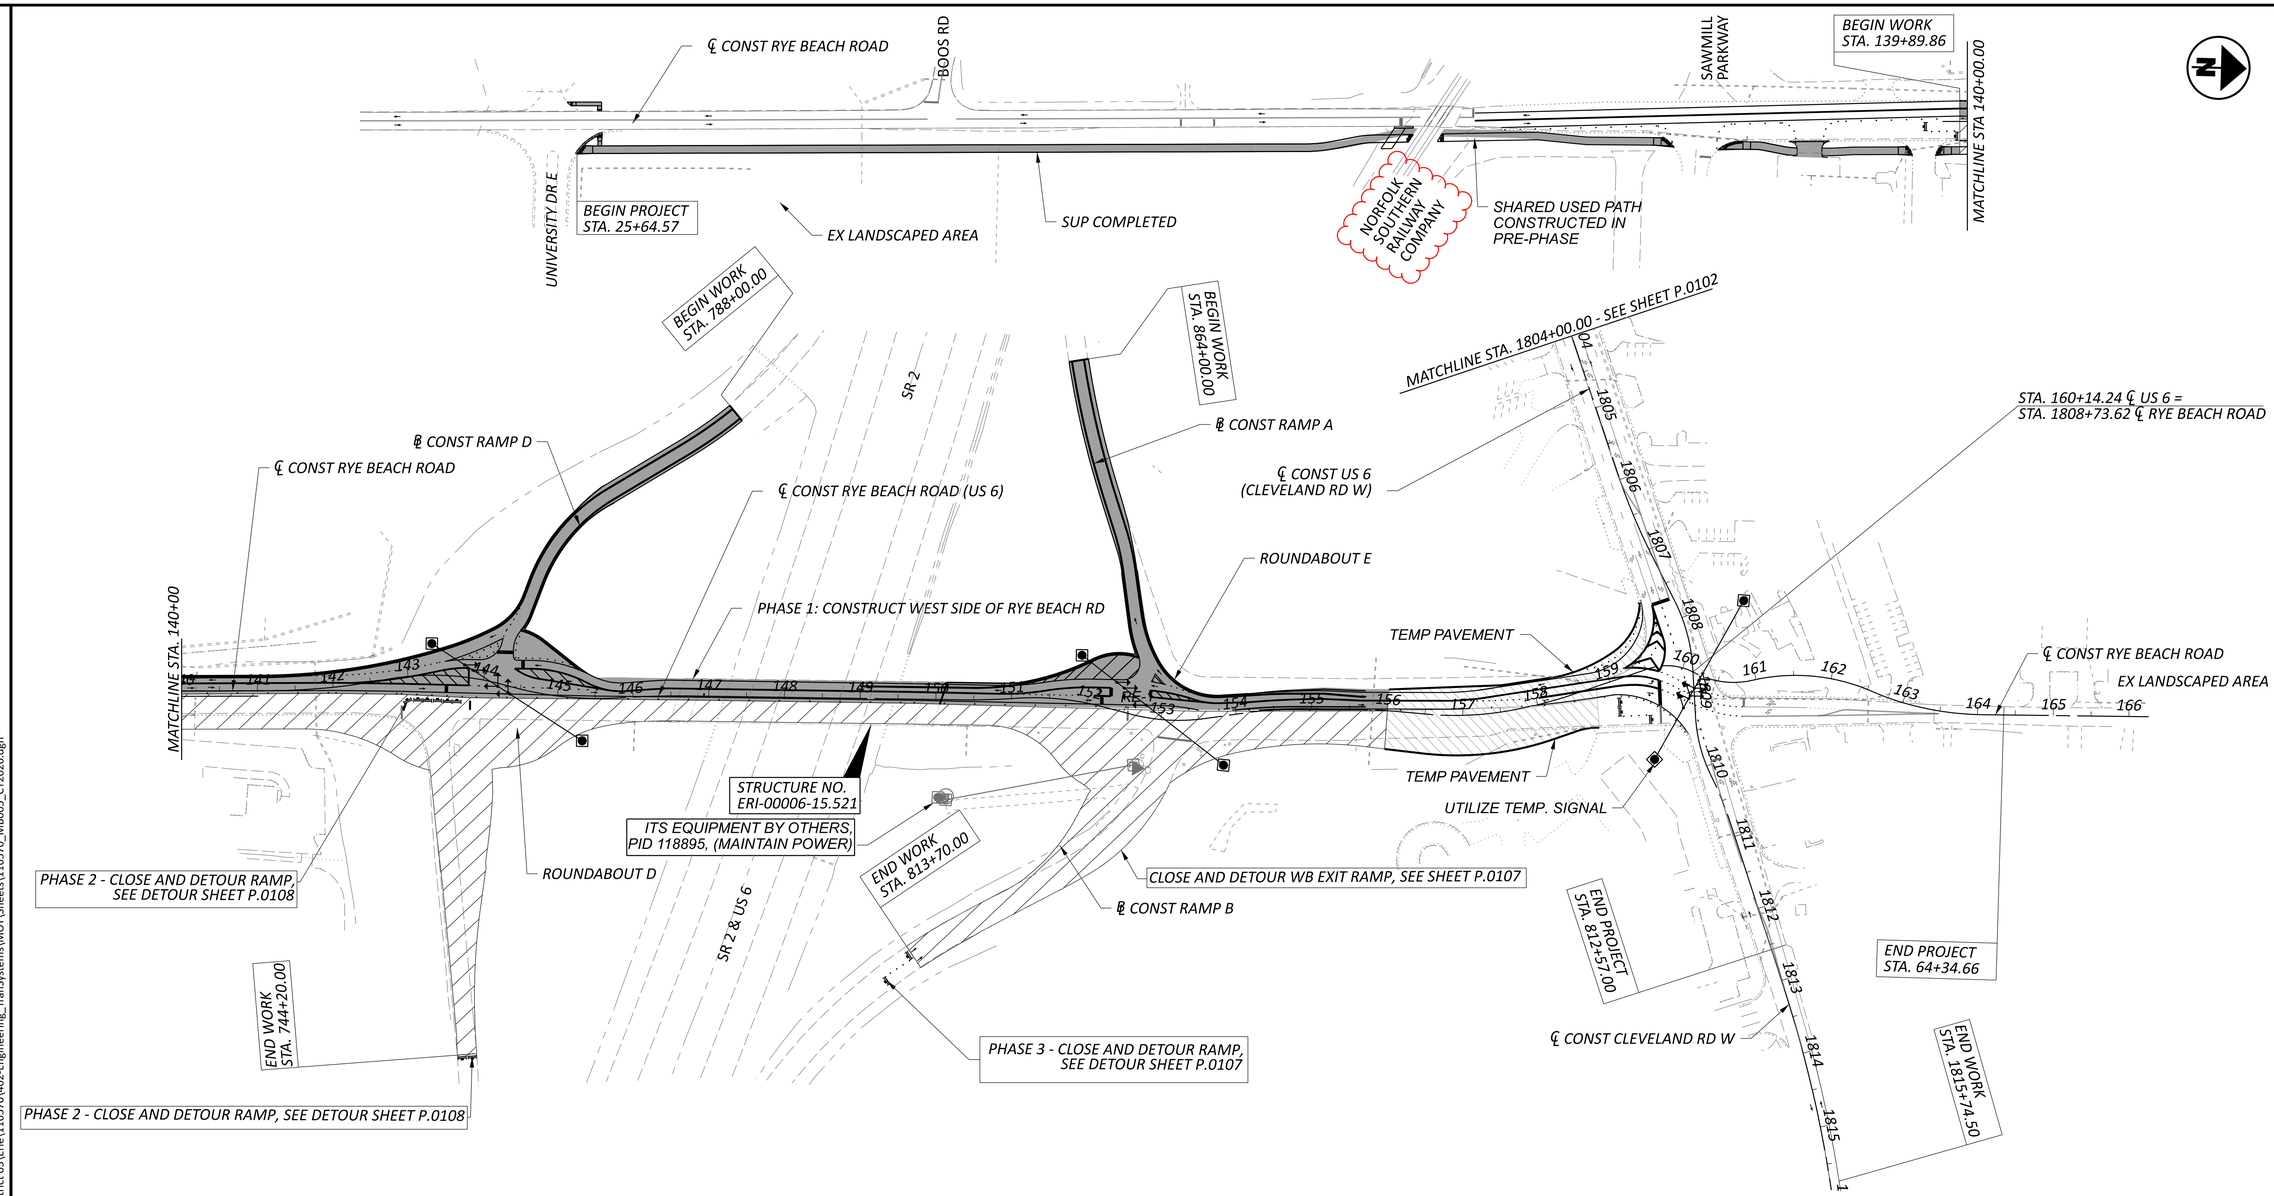

HORIZONTAL SCALE IN FEET
0 50 100 200

MOT SCHEMATIC PLAN - PHASE 2 (2026 CONSTRUCTION)
RYE BEACH ROAD STA 118+00.00 TO STA 166+00.00

RYE BEACH INTERCHANGE (2026 CONSTRUCTION):
DURATION: 180 DAYS
CEDAR POINT: NO EAST SIDE ROAD CLOSURES ON US 6 DURING TOURIST SEASON IN JUNE - OCTOBER

PHASE 2. OPEN THE WEST SIDE RAMPS TO TRAFFIC AND SHIFT SOUTHBOUND TRAFFIC TO THE WEST SIDE OF RYE BEACH RD. RAMPS WILL UTILIZE TEMP. SIGNAL. MAINTAIN 1 LANE OF NORTHBOUND TRAFFIC IN PHASES TO BUILD AS MUCH OF THE RAMP TERMINI AS POSSIBLE. DETOUR TRAFFIC TO/FROM RYE BEACH SOUTH OF THE INTERCHANGE (WHILE BG FIRELANDS IS NOT IN SESSION) TO ALLOW SMOOTH TRAFFIC FLOW.
MAINTAIN ACCESS TO LOCAL BUSINESSES.

- RYE BEACH RD: BOGART RD WB TO US 250 WB TO PERKINS AVE EB TO US 6 EB AND REVERSE. FOR DETOUR PLAN, SEE SHEET P.0107

- CLOSE THE EAST SIDE RAMPS TO TRAFFIC, SEPARATELY, AND DETOUR TRAFFIC TO FINISH THE RAMP TERMINI

- WB EXIT: SR 2 WB TO US 250 NB TO US 6 EB

- EB ENTRANCE: SR 2 WB, FLIP AT US 250

NOTES:
1. FOR MOT OVERALL SCHEMATIC PLAN, SEE SHEET P.0098
2. FOR LEGEND, SEE SHEET P.0085

ERI-US 0006-CONNECTIVITY CORRIDOR

DESIGN AGENCY
TRANSYSTEMS
400 W. NATIONWIDE BLVD., STE 200
COLUMBUS, OHIO 43215

DESIGNER: SSA
REVIEWER: SS 10/27/25
PROJECT ID: 116570
SHEET: P.0103 TOTAL: 1106

MODEL: 100 Scale 2 PAPERSIZE: 34x22 (in.) DATE: 2/25/2026 TIME: 1:44:25 PM PLTDRV: OHDOT_PDF_Levels.pltcfg PENTBL: OHDOT_Pen.tbl USER: hrthornton@gftinc.com WORKSPACE: OHDOTCEv02 WORKSET: 116570 PRODUCT: OpenRoadsDesigner 24.00.02.25
pw:\\ohiodot-pw.bentley.com:ohiodot-pw-02\Documents\01 Active Projects\District 03\Erie\116570\402-Engineering_TranSystems\MOT\Sheets\116570_MB005_CY2026.dgn
hrthornton@gftinc.com WORKSPACE: OHDOTCEv02 WORKSET: 116570_MB005_CY2026

ERI-US 0006-CONNECTIVITY CORRIDOR

MODEL: Sheet PAPERSIZE: 34x22 (in.) DATE: 2/25/2026 TIME: 2:15:03 PM PLTDRV: OHDOT_PDF_Levels.pltcfg PENTBL: OHDOT_Pen.tbl USER: hrthornton@gftinc.com WORKSPACE: OHDOTCivil WORKSET: 116570 PRODUCT: OpenRoadsDesigner 24.00.02.25
pw:\\ohiodot-pw.bentley.com:ohiodot-pw-02\Documents\01 Active Projects\District 03\Erie\116570\d02-Engineering_TranSystems\MOT\Sheets\116570_MD002.dgn

1 — TYPE A WARNING LIGHT
DETOUR AHEAD
EAST
6

2 — ROAD CLOSED
1 1/2 MILES AHEAD
LOCAL TRAFFIC ONLY
DETOUR
Camp Rd
M4-10L-48
D3-H6-48
R11-3a-60

3 — ROAD CLOSED
1 1/2 MILES AHEAD
LOCAL TRAFFIC ONLY
Camp Rd
R11-3a-60
D3-H6-48

4 — ROAD CLOSED
1 MILES AHEAD
LOCAL TRAFFIC ONLY
Camp Rd
R11-3a-60
D3-H6-48

5a — ROAD CLOSED
1/2 MILES AHEAD
LOCAL TRAFFIC ONLY
Camp Rd
R11-3a-60
D3-H6-48

6 — END DETOUR
M4-8a-24

5 — ROAD CLOSED
R11-2-48

ONLY CAMP RD INTERSECTION CLOSURE

7 — DETOUR TO EAST 6
M4-8-30 M4-5-30 M3-2-30 M1-4-36-1 M5-1-30

8 — DETOUR TO EAST 6
M4-8-30 M4-5-30 M3-2-30 M1-4-36-1 M6-1R-30

9 — DETOUR TO EAST 6
M4-8-30 M4-5-30 M3-2-30 M1-4-36-1 M6-3-30

10 — DETOUR TO EAST 6
M4-8-30 M4-5-30 M3-2-30 M1-4-36-1 M5-2-30

11 — DETOUR TO EAST 6
M4-8-30 M4-5-30 M3-2-30 M1-4-36-1 M6-1L-30

12 — DETOUR TO WEST 6
M4-8-30 M4-5-30 M3-4-30 M1-4-36-1 M5-1-30

13 — DETOUR TO WEST 6
M4-8-30 M4-5-30 M3-4-30 M1-4-36-1 M6-1R-30

14 — DETOUR TO WEST 6
M4-8-30 M4-5-30 M3-4-30 M1-4-36-1 M6-3-30

15 — DETOUR TO WEST 6
M4-8-30 M4-5-30 M3-4-30 M1-4-36-1 M5-2R-30

16 — DETOUR TO WEST 6
M4-8-30 M4-5-30 M3-4-30 M1-4-36-1 M5-1-30

17 — DETOUR TO WEST 6
M4-8-30 M4-5-30 M3-4-30 M1-4-36-1 M6-1L-30

18 — TYPE A WARNING LIGHT
DETOUR AHEAD
WEST
6
W20-2-48 M3-4-30 M1-4-36-1

19 — DETOUR TO Camp Rd
M4-8-30 M4-5-30 D3-H3-30 M6-3-30

20 — DETOUR TO Camp Rd
M4-8-30 M4-5-30 D3-H3-30 M5-1-30

21 — DETOUR TO Camp Rd
M4-8-30 M4-5-30 D3-H3-30 M6-1L-30

22 — DETOUR TO Camp Rd
M4-8-30 M4-5-30 D3-H3-30 M5-1-30

23 — DETOUR TO
M4-8-30 M4-5-30 D3-H3-30 M6-1R-30

24 — TYPE A WARNING LIGHT
DETOUR AHEAD
Camp Rd
W20-2-48 D3-H3-30

LEGEND:
- PROPOSED SIGN, 1 POST
- PROPOSED SIGN, 2 POST
- TYPE III BARRICADE
- DETOUR ROUTE
- CAMP RD DETOUR (FOR WB US 6)
- US 6 WEST DETOUR (FOR NB CAMP RD)
- CAMP RD DETOUR (FOR EB US 6)
- EAST US 6 DETOUR (FOR NB CAMP RD)

NOTE: ALL ROAD CLOSURES SHALL HAVE BARRICADE AND SIGN PLACEMENT PER SCD MT-101.60

FOR MOT SCHEMATIC PLAN, SEE SHEET P.0220

HORIZONTAL SCALE IN FEET
0 500 1000 2000

DETOUR PLAN (2027/2028 CONSTRUCTION)
PHASE 1 - CAMP ROAD CLOSURE

DESIGN AGENCY
TRANSYSTEMS
400 W. NATIONWIDE BLVD., STE 225
COLUMBUS, OHIO 43215

DESIGNER SSA
REVIEWER SS 10/27/25
PROJECT ID 116570
SHEET P.0109 TOTAL 1106

MODEL: Sheet PAPERSIZE: 34x22 (in.) DATE: 2/25/2026 TIME: 2:25:40 PM PLTDRV: OHDOT_PDF_Levels.pltcfg PENTBL: OHDOT_Pen.tbl USER: hrthornton@gftinc.com WORKSPACE: OHDOTCivil02 WORKSET: 116570 PRODUCT: OpenRoadsDesigner 24.00.02.25
pw:\\ohiodot-pw.bentley.com:ohiodot-pw-02\Documents\01 Active Projects\District 03\Erie\116570\402-Engineering_TranSystems\MOT\Sheets\116570_MD003.dgn

ERI-US 0006-CONNECTIVITY CORRIDOR

LEGEND:

- PROPOSED SIGN, 1 POST
- PROPOSED SIGN, 2 POST
- TYPE III BARRICADE
- DETOUR ROUTE

NOTE: ALL ROAD CLOSURES SHALL HAVE BARRICADE AND SIGN PLACEMENT PER SCD MT-101.60

1
TYPE A WARNING LIGHT

DETOUR AHEAD
W20-2-48


2
DETOUR TO SOUTH
Rye Beach Rd
M4-8-30 M4-5-30 M3-4-30 D3-H6-48 M5-2L-30

3
DETOUR TO SOUTH
Rye Beach Rd
M4-8-30 M4-5-30 M3-4-30 D3-H6-48 M6-1L-30

4
DETOUR TO SOUTH
Rye Beach Rd
M4-8-30 M4-5-30 M3-4-30 D3-H6-48 M5-2R-30

5
DETOUR TO SOUTH
Rye Beach Rd
M4-8-30 M4-5-30 M3-4-30 D3-H6-48 M6-1R-30

6
END DETOUR
M4-8a-24

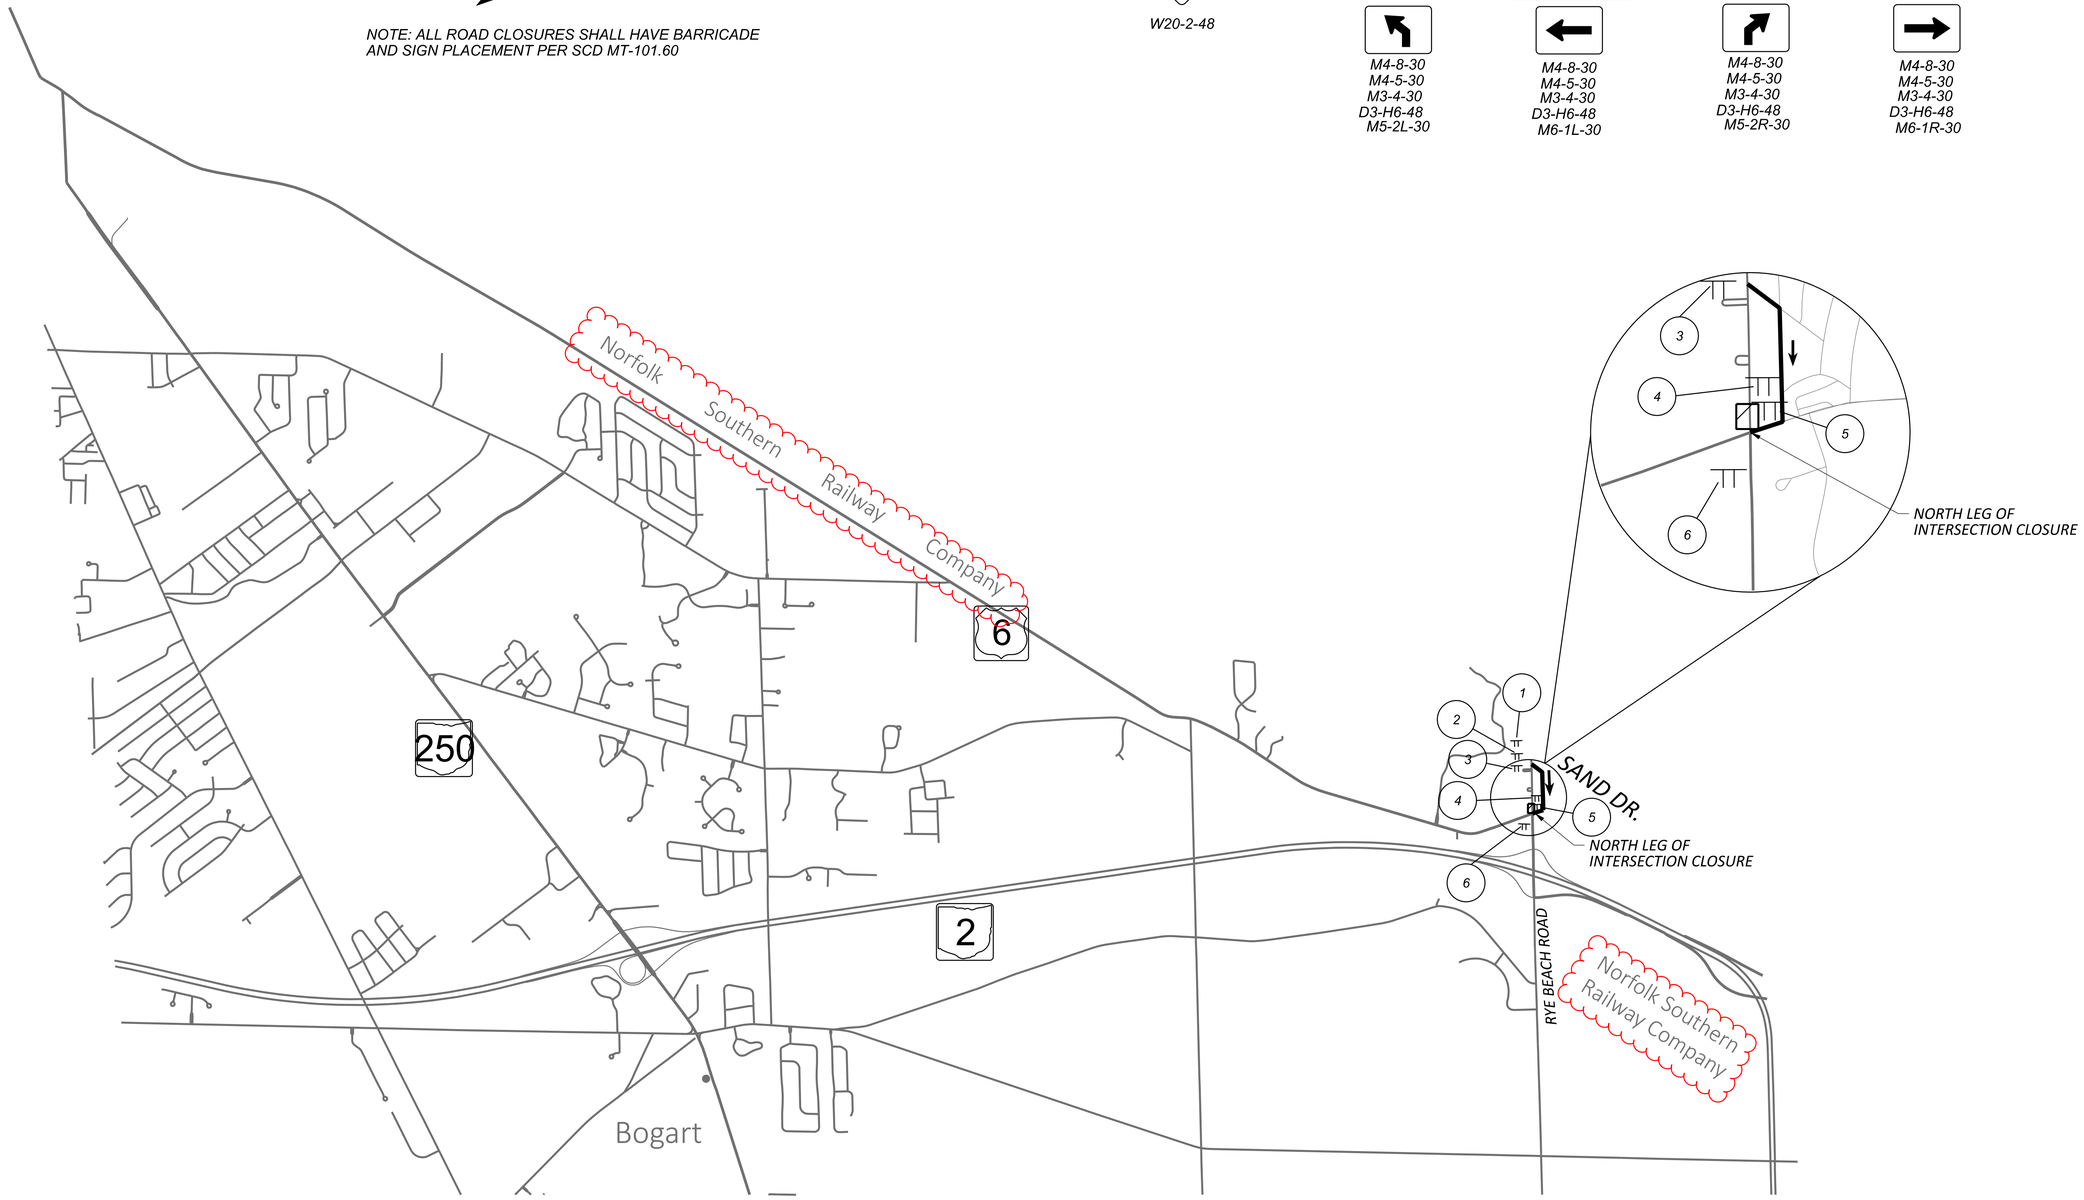

FOR MOT SCHEMATIC PLAN, SEE SHEET P.0222


HORIZONTAL SCALE IN FEET
0 500 1000 1500

DETOUR DETOUR PLAN (2027/2028 CONSTRUCTION)
PHASE 1 & 2 - NORTH LEG OF INTERSECTION CLOSURE

DESIGN AGENCY
TRANSYSTEMS
400 W. NATIONWIDE BLVD., STE 225
COLUMBUS, OHIO 43215

DESIGNER MZS
REVIEWER SS 10/27/25
PROJECT ID 116570
SHEET P.0110 TOTAL 1106

MODEL: CLP_SUP 1 - Plan 1-2 [Sheet] PAPERSIZE: 34x22 (in.) DATE: 2/25/2026 TIME: 2:35:06 PM PLTDRV: OHDOT_PDF_Levels.pltcfg PENTBL: OHDOT_Pen.tbl USER: hrthornton@gftinc.com WORKSPACE: OHDOTCEv02 WORKSET: 116570 PRODUCT: OpenRoadsDesigner 24.00.02.25
pw:\\ohiodot-pw.bentley.com:ohiodot-pw-02\Documents\01 Active Projects\District 03\Erie\116570\402-Engineering_TranSystems\MOT\Sheets\116570_MP000_CY2026.dgn

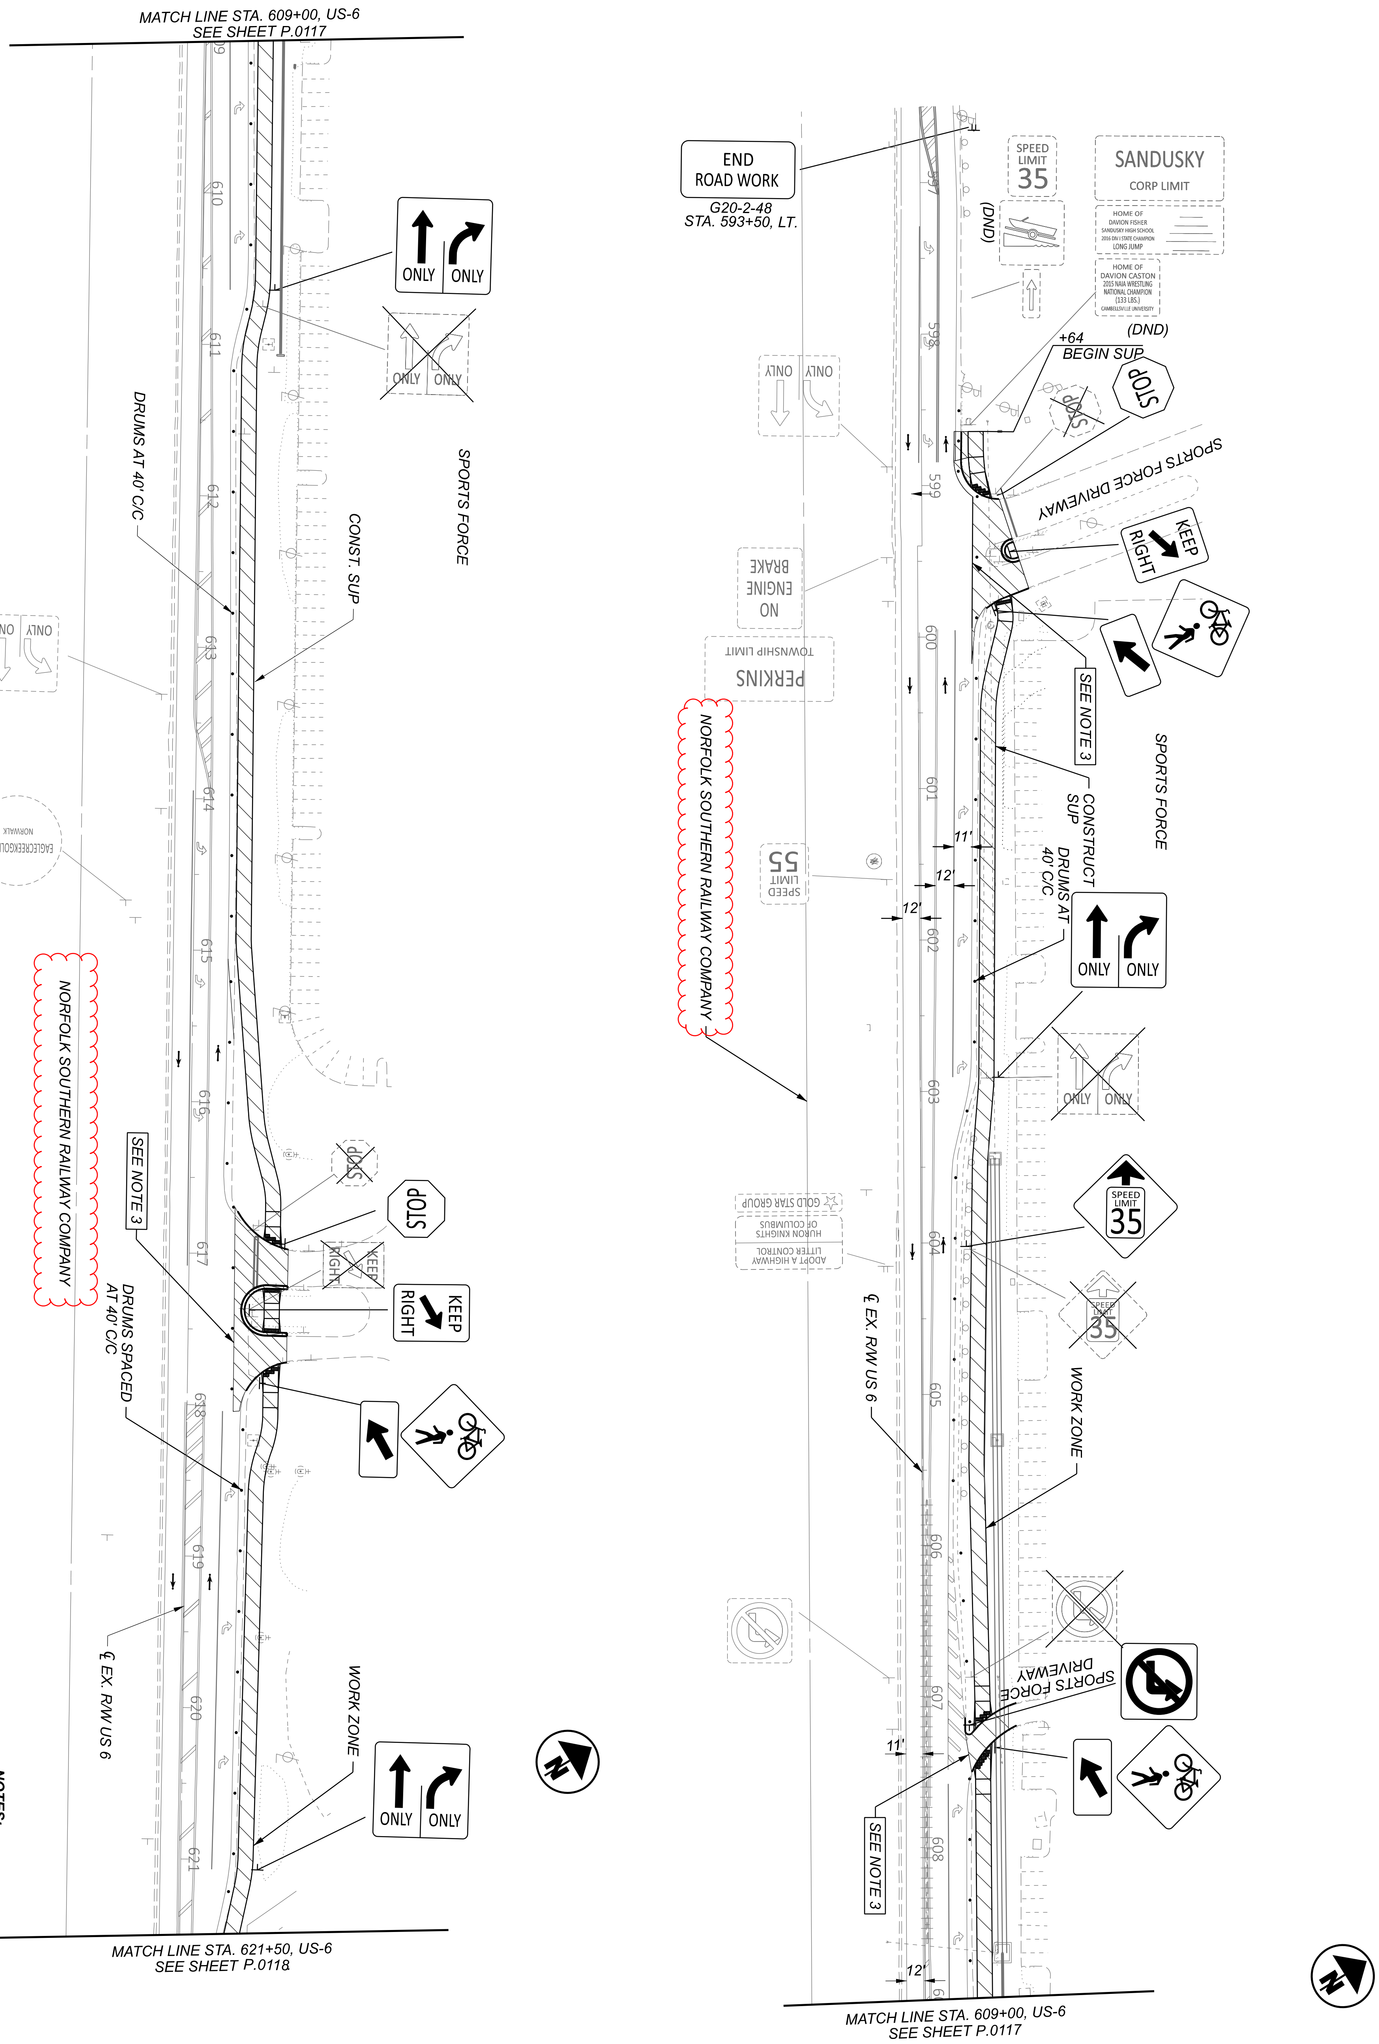

NOTES:

1. FOR MOT LEGEND, SEE SHEET P.0084
2. FOR PROPOSED SIGNING AND MARKING DETAILS, SEE TRAFFIC CONTROL PLANS.
3. MAINTAIN ACCESS TO DRIVES OR SIDE ROADS AT ALL TIMES. USE FLAGGING OPERATION AS NECESSARY.

SHEET	TOTAL
P 0118	1106

PROJECT ID	REVIEWER
116570	SS 10/27/25

DESIGNER: SSA


TRANSYSTEMS
400 W. NATIONWIDE BLVD., STE 220
COLUMBUS, OHIO 43215
DESIGN AGENCY


MAINTENANCE OF TRAFFIC - PRE-PHASE (2026 CONSTRUCTION)
US 6 - BEGIN PROJECT TO STA. 621+50

HORIZONTAL SCALE IN FEET
0 50
25 100

MODEL: CLP_SUP 1 - Plan 3-4 [Sheet] PAPERSIZE: 34x22 (in.) DATE: 2/25/2026 TIME: 2:39:00 PM PLTDRV: OHDOT_PDF_Levels.pltcfg PENTBL: OHDOT_Pen.tbl USER: hrthornton@gftinc.com WORKSPACE: OHDOTCEv02 WORKSET: 116570 PRODUCT: OpenRoadsDesigner 24.00.02.25
pw:\\ohiodot-pw.bentley.com:ohiodot-pw-02\Documents\01 Active Projects\District 03\Erie\116570\a02-Engineering_TranSystems\MOT\Sheets\116570_MP000_CY2026.dgn

ERI-US 0006-CONNECTIVITY CORRIDOR

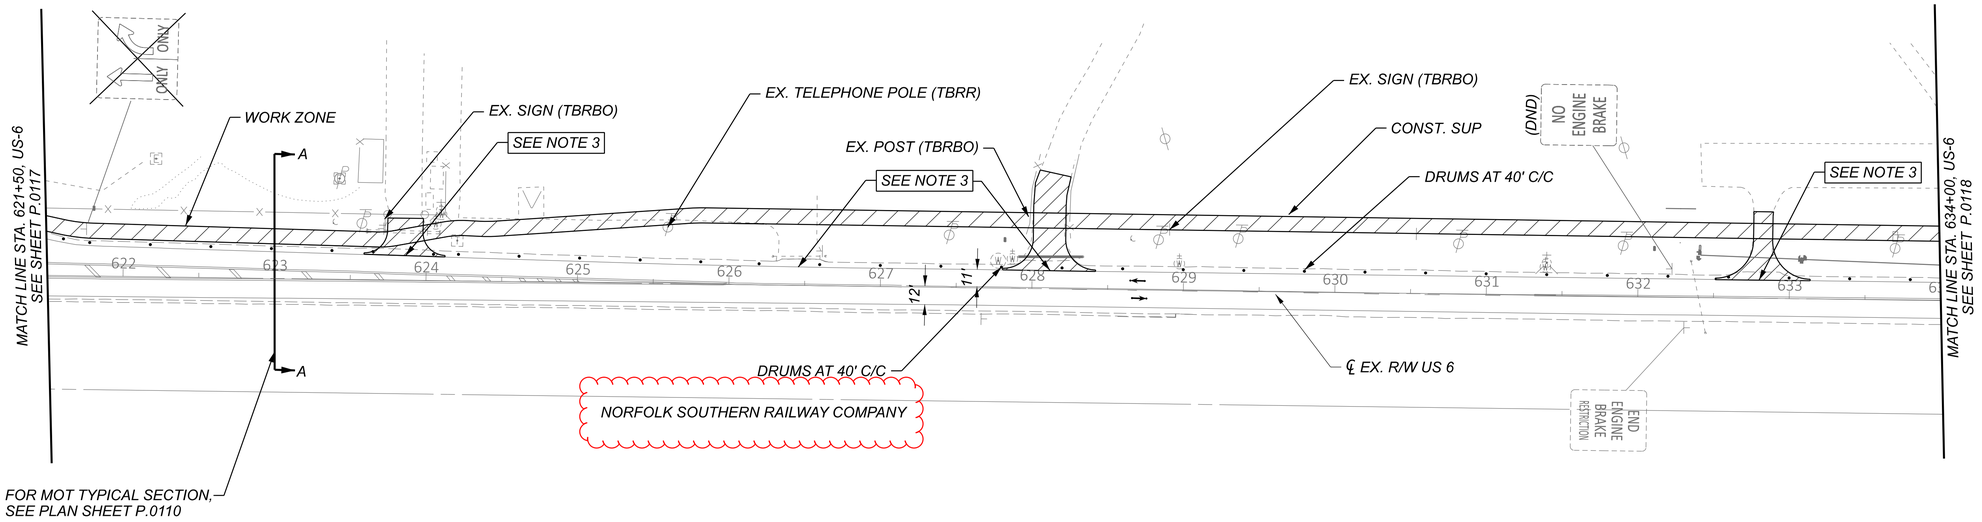

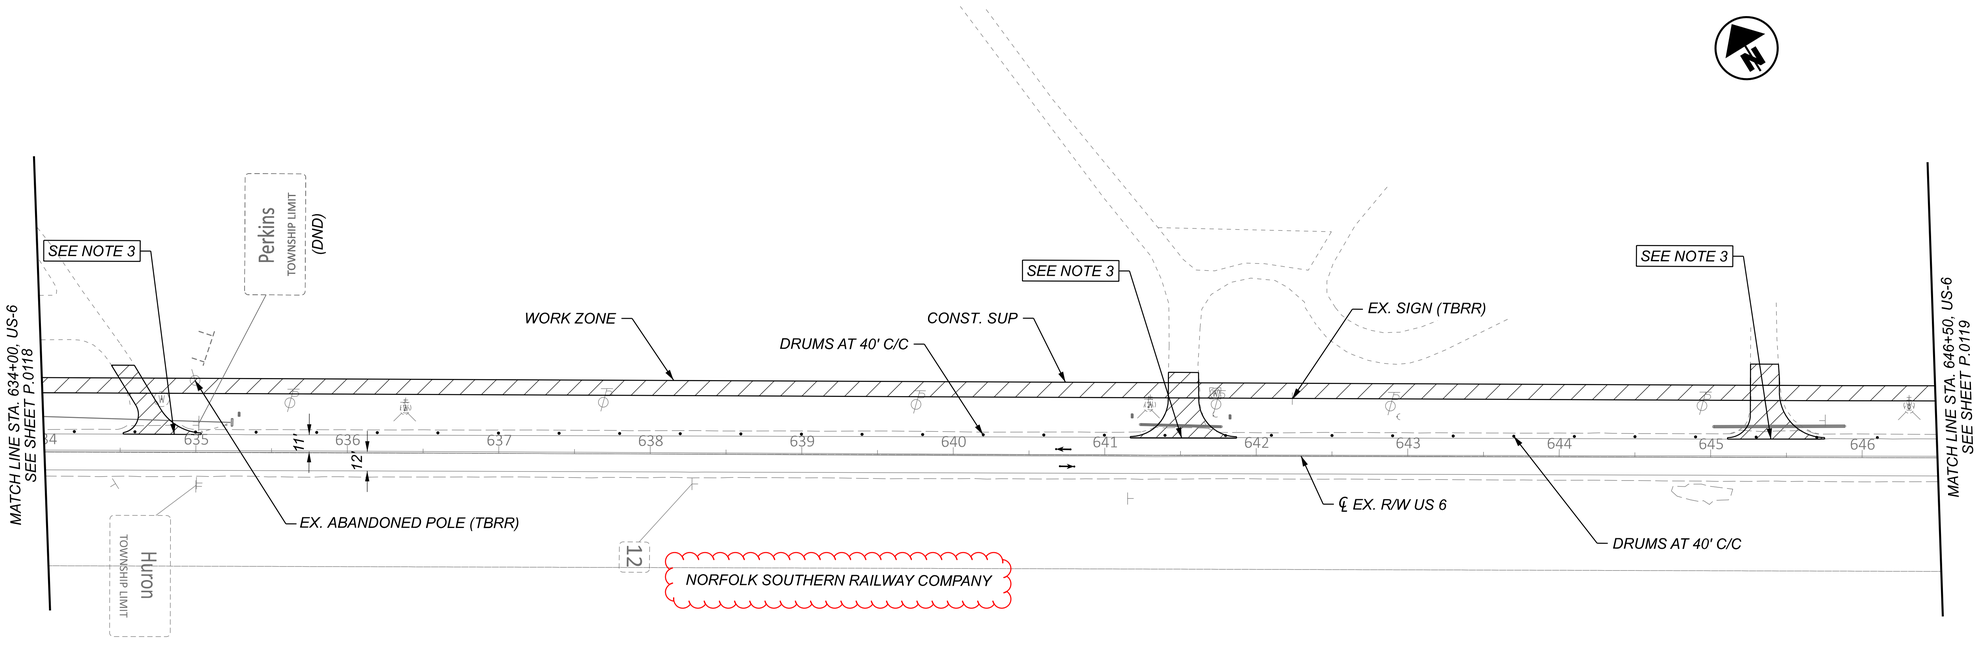

NOTES:

1. FOR MOT LEGEND, SEE SHEET P.0084
2. FOR PROPOSED SIGNING AND MARKING DETAILS, SEE TRAFFIC CONTROL PLANS.
3. MAINTAIN ACCESS TO DRIVES OR SIDE ROADS AT ALL TIMES. USE FLAGGING OPERATION AS NECESSARY.

HORIZONTAL SCALE IN FEET
0 25 50 100

MAINTENANCE OF TRAFFIC - PRE-PHASE (2026 CONSTRUCTION)
US 6 - STA. 621+50.00 TO STA. 646+50.00

DESIGN AGENCY
TRANSYSTEMS
400 W. NATIONWIDE BLVD., STE 220
COLUMBUS, OHIO 43215

DESIGNER	
SSA	
REVIEWER	
SS	10/27/25
PROJECT ID	
116570	
SHEET	TOTAL
P.0119	1106

NOTES:

1. FOR MOT LEGEND, SEE SHEET P.0084
2. FOR PROPOSED SIGNING AND MARKING DETAILS, SEE TRAFFIC CONTROL PLANS.
3. MAINTAIN ACCESS TO DRIVES OR SIDE ROADS AT ALL TIMES. USE FLAGGING OPERATION AS NECESSARY. REFER TO THE TEMPORARY DRIVEWAY PLAN & PROFILE SHEETS FOR DETAILS.

HORIZONTAL SCALE IN FEET
0 25 50 100

MAINTENANCE OF TRAFFIC - PRE-PHASE (2026 CONSTRUCTION)
US 6 - STA. 646+50.00 TO STA. 671+50.00

ERI-US 0006-CONNECTIVITY CORRIDOR


MODEL: CLP_SUP 1 - Plan 5-6 [Sheet] PAPERSIZE: 34x22 (in.) DATE: 2/25/2026 TIME: 2:42:40 PM PLTDRV: OHDOT_PDF_Levels.pltcfg PENTBL: OHDOT_Pen.tbl USER: hrthornton@gftinc.com WORKSPACE: OHDOTCEv02 WORKSET: 116570 PRODUCT: OpenRoadsDesigner 24.00.02.25
pw:\\ohiodot-pw.bentley.com:ohiodot-pw-02\Documents\01 Active Projects\District 03\Erie\116570\d02-Engineering_TranSystems\MOT\Sheets\116570_MP000_CY2026.dgn

DESIGN AGENCY
TRANSYSTEMS
400 W. NATIONWIDE BLVD., STE 220
COLUMBUS, OHIO 43215

DESIGNER SSA
REVIEWER SS 10/27/25
PROJECT ID 116570
SHEET P.0120 TOTAL 1106

ERI-US 0006-CONNECTIVITY CORRIDOR

MODEL: CLX_RW_ORIG_US006 - Plan 7-8 [Sheet] PAPERSIZE: 34x22 (in.) DATE: 2/25/2026 TIME: 2:46:48 PM PLTDRV: OHDOT_PDF_Levels.pltcfg PENTBL: OHDOT_Pen.tbl USER: hrthornton@gftinc.com WORKSPACE: OHDOTCEv02 WORKSET: 116570 PRODUCT: OpenRoadsDesigner 24.00.02.25
pw:\\ohiodot-pw.bentley.com:ohiodot-pw-02\Documents\01 Active Projects\District 03\Erie\116570\402-Engineering_TranSystems\MOT\Sheets\116570_MP000_CY2026.dgn

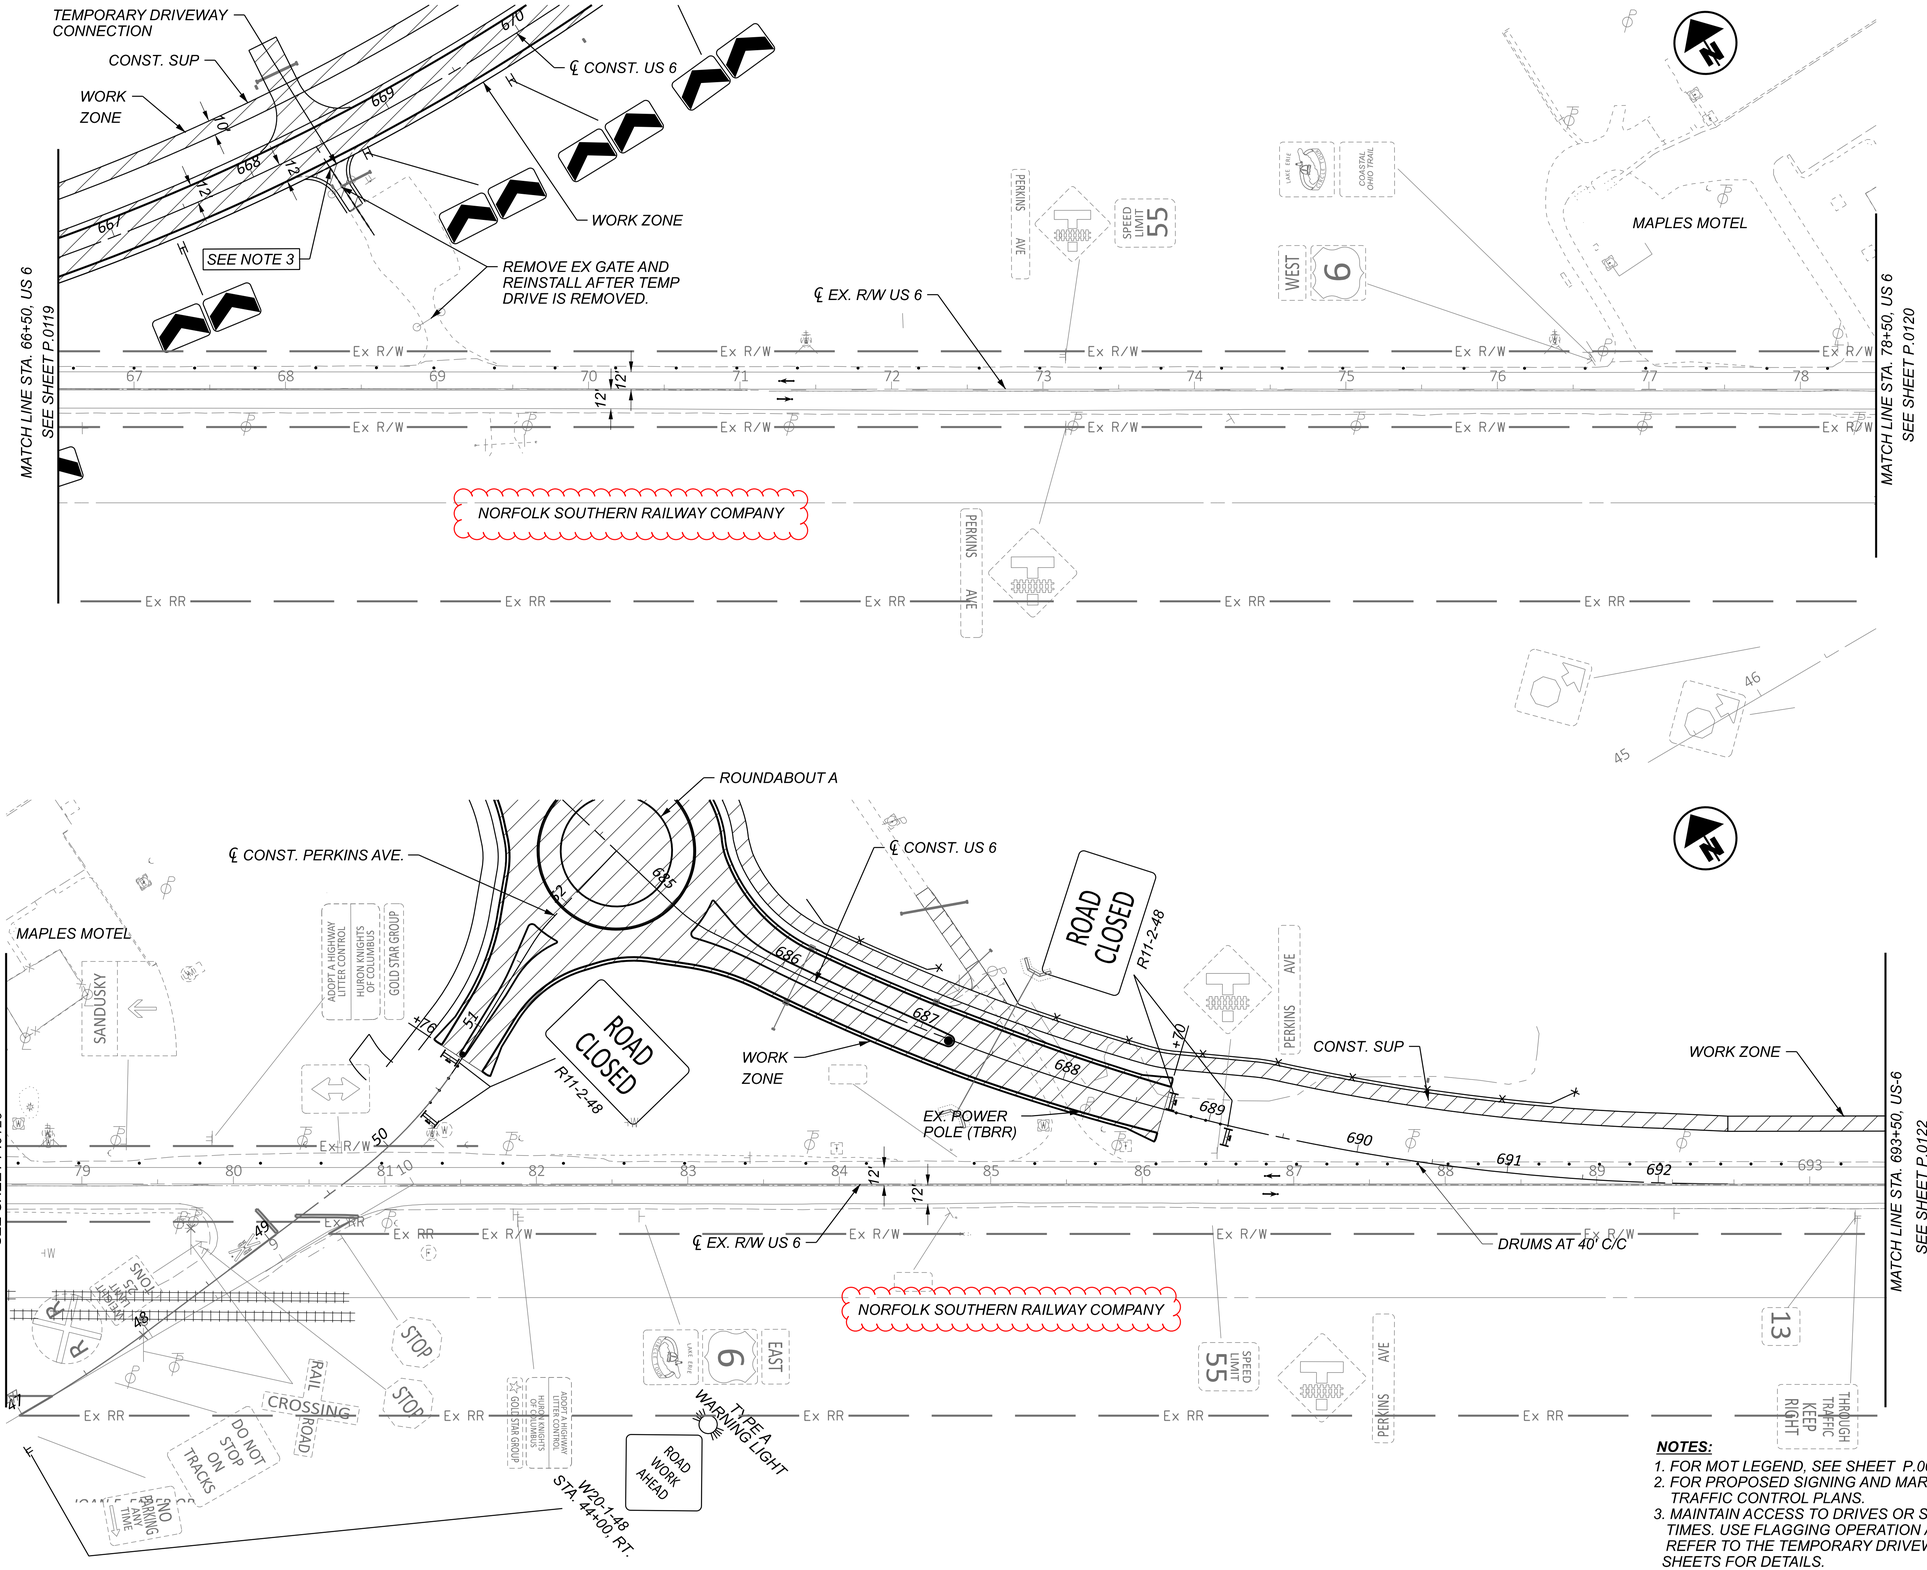

HORIZONTAL SCALE IN FEET
0 25 50 100

MAINTENANCE OF TRAFFIC - PRE-PHASE (2026 CONSTRUCTION)
US 6 - STA. 67+00.00 EX. US 6 TO 693+50.00 CONST. US 6 SUP

NOTES:


1. *FOR MOT LEGEND, SEE SHEET P.0084*
2. *FOR PROPOSED SIGNING AND MARKING DETAILS, SEE TRAFFIC CONTROL PLANS.*
3. *MAINTAIN ACCESS TO DRIVES OR SIDE ROADS AT ALL TIMES. USE FLAGGING OPERATION AS NECESSARY. REFER TO THE TEMPORARY DRIVEWAY PLAN & PROFILE SHEETS FOR DETAILS.*

DESIGN AGENCY
TRANSYSTEMS
400 W. NATIONWIDE BLVD., STE 225
COLUMBUS, OHIO 43215

DESIGNER	SSA
REVIEWER	SS 10/27/25
PROJECT ID	116570
SHEET	P.0121
TOTAL	1106

NOTES:

1. FOR MOT LEGEND, SEE SHEET P.0084
2. FOR PROPOSED SIGNING AND MARKING DETAILS, SEE TRAFFIC CONTROL PLANS.
3. MAINTAIN ACCESS TO DRIVES OR SIDE ROADS AT ALL TIMES. USE FLAGGING OPERATION AS NECESSARY.
4. SOIL STABILIZATION WILL BE REQUIRED ALONG CENTERLINE OF CONSTRUCTION US 6 STA. 681+50 TO 692+50 DUE TO SOFT SOILS ENCOUNTERED IN THE FIELD. THE FILL UNDER THE PROPOSED ROADWAY AND ESPECIALLY THE PROPOSED BOX CULVERT AT STA. 687+50 WILL LIKELY NEED TO BE PRE-LOADED TO ACHIEVE AN ACCEPTABLE BEARING CAPACITY TO PREVENT SETTLEMENT. PRE-LOADING THE FILL REQUIRES MORE TIME DURING CONSTRUCTION, AND IT IS RECOMMENDED THAT THIS AREA BE PRIORITIZED AT THE BEGINNING OF THE CONSTRUCTION SEQUENCING.

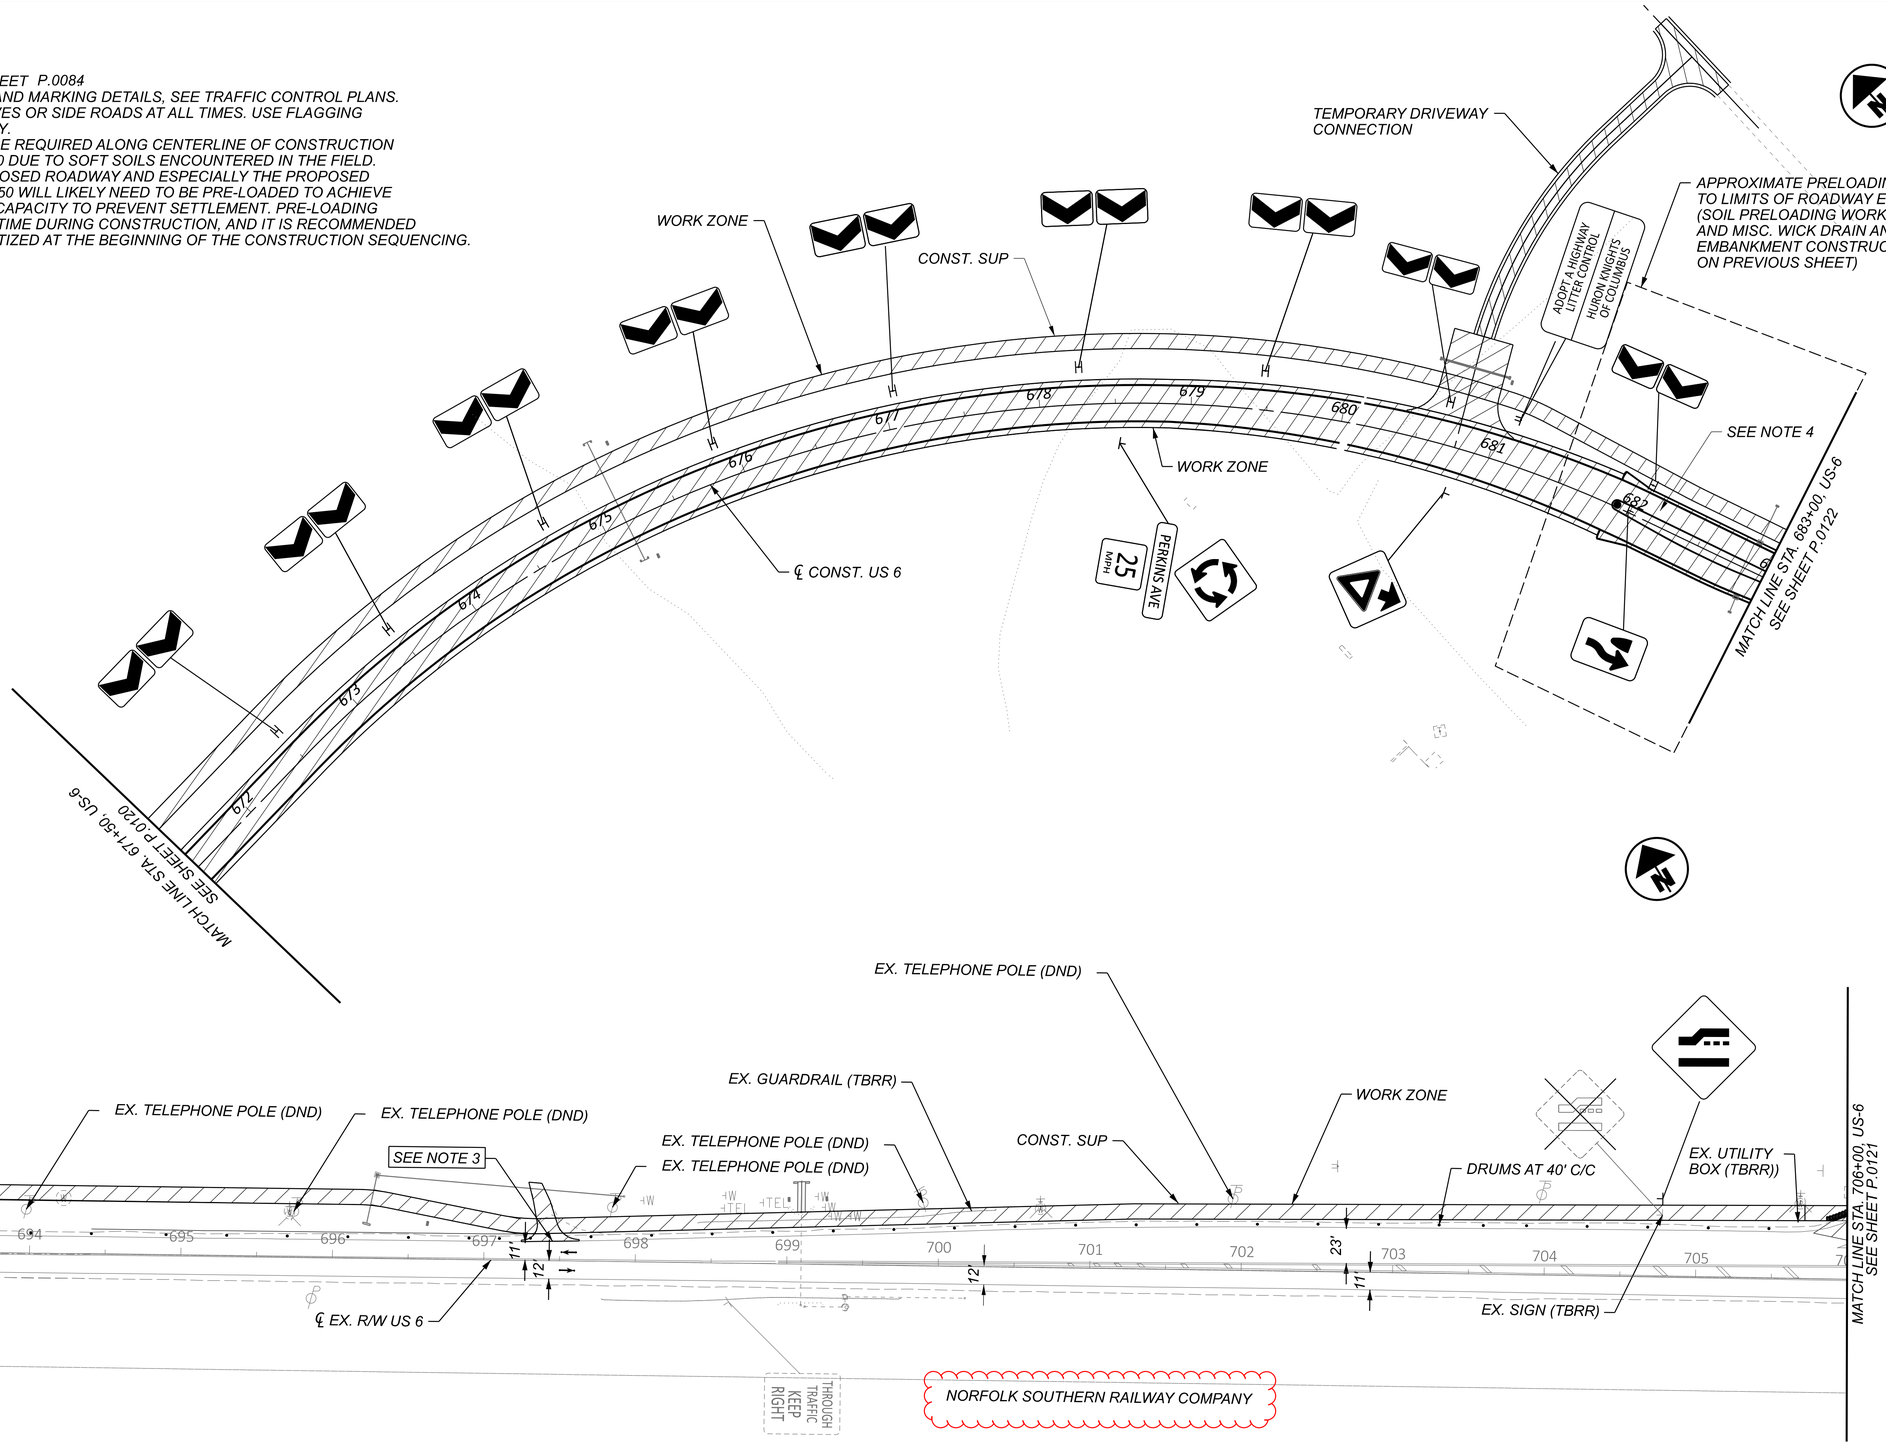

HORIZONTAL SCALE IN FEET
0 25 50 100

MAINTENANCE OF TRAFFIC - PRE-PHASE (2026 CONSTRUCTION)
US 6 - STA. 671+50.00 TO STA. 706+00.00

ERI-US 0006-CONNECTIVITY CORRIDOR


MODEL: CLP_SUP 1 - Plan 9-10 [Sheet] PAPERSIZE: 34x22 (in.) DATE: 2/25/2026 TIME: 2:49:34 PM PLTDRV: OHDOT_PDF_Levels.pltcfg PENTBL: OHDOT_Pen.tbl USER: hrthornton@gftinc.com WORKSPACE: OHDOTCEv02 WORKSET: 116570 PRODUCT: OpenRoadsDesigner 24.00.02.25
pw:\\ohiodot-pw.bentley.com:ohiodot-pw-02\Documents\01 Active Projects\District 03\Erie\116570\402-Engineering_TranSystems\MOT\Sheets\116570_MP000_CY2026.dgn


DESIGN AGENCY
TRANSYSTEMS
400 W. NATIONWIDE BLVD., STE 225
COLUMBUS, OHIO 43215

DESIGNER	SSA
REVIEWER	SS 10/27/25
PROJECT ID	116570
SHEET	P.0123
TOTAL	1106

MODEL: CLP_SUP 1 - Plan 12-13 [Sheet] PAPERSIZE: 34x22 (in.) DATE: 2/25/2026 TIME: 2:52:34 PM PLTDRV: OHDOT_PDF_Levels.pltcfg PENTBL: OHDOT_Pen.tbl USER: hrthornton@gftinc.com WORKSPACE: OHDOTCEv02 WORKSET: 116570 PRODUCT: OpenRoadsDesigner 24.00.02.25
pw:\\ohiodot-pw.bentley.com:ohiodot-pw-02\Documents\01 Active Projects\District 03\Erie\116570\402 Engineering_TranSystems\MOT\Sheets\116570_MP000_CY2026.dgn

ERI-US 0006-CONNECTIVITY CORRIDOR

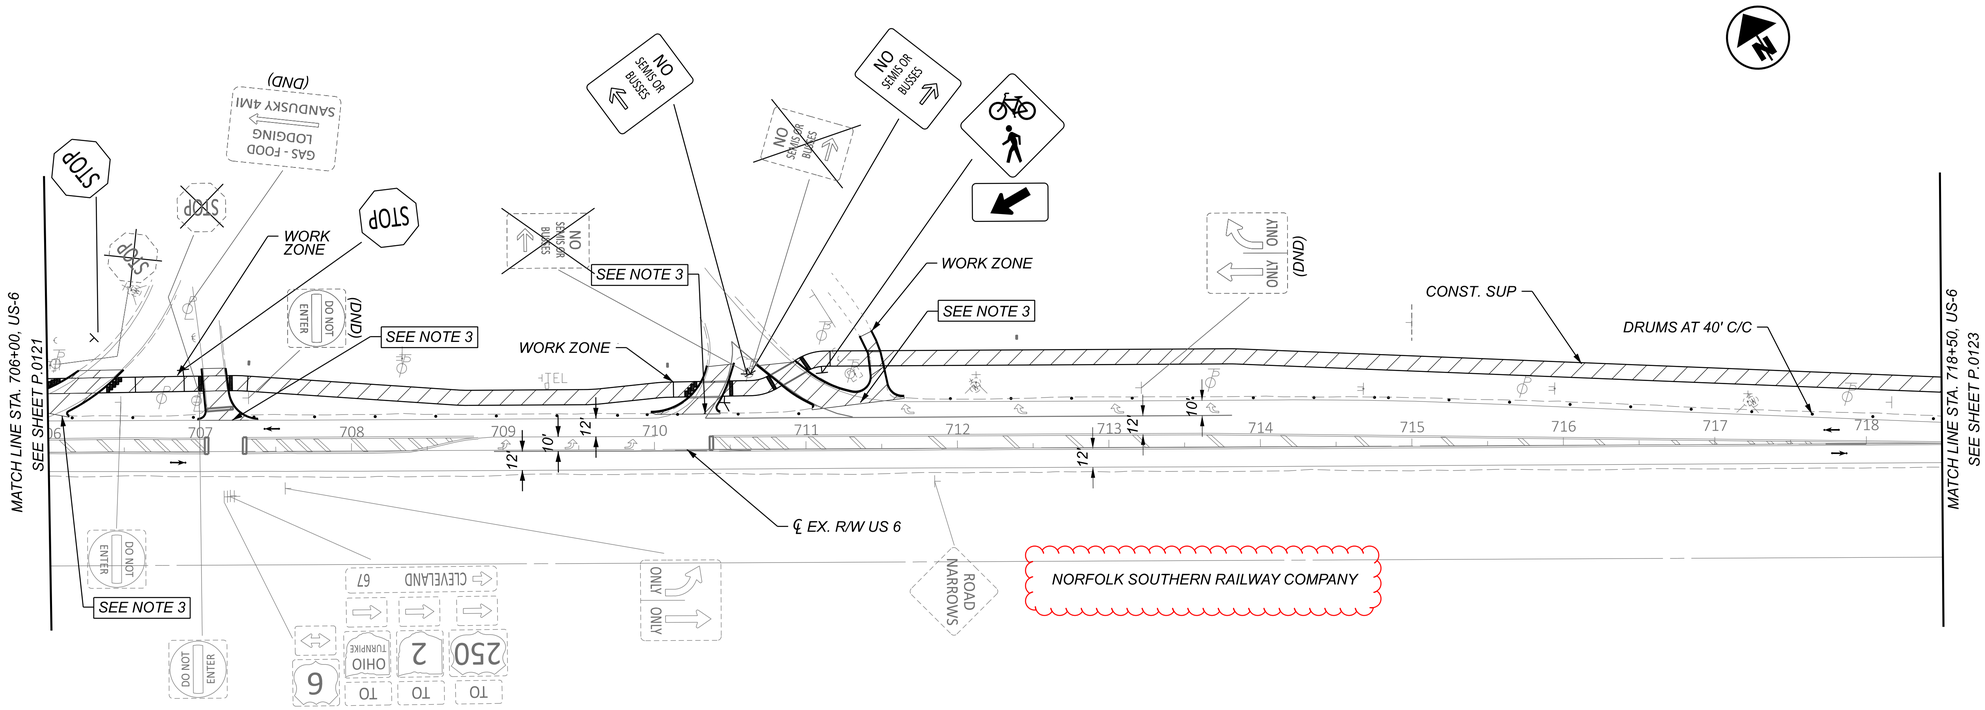

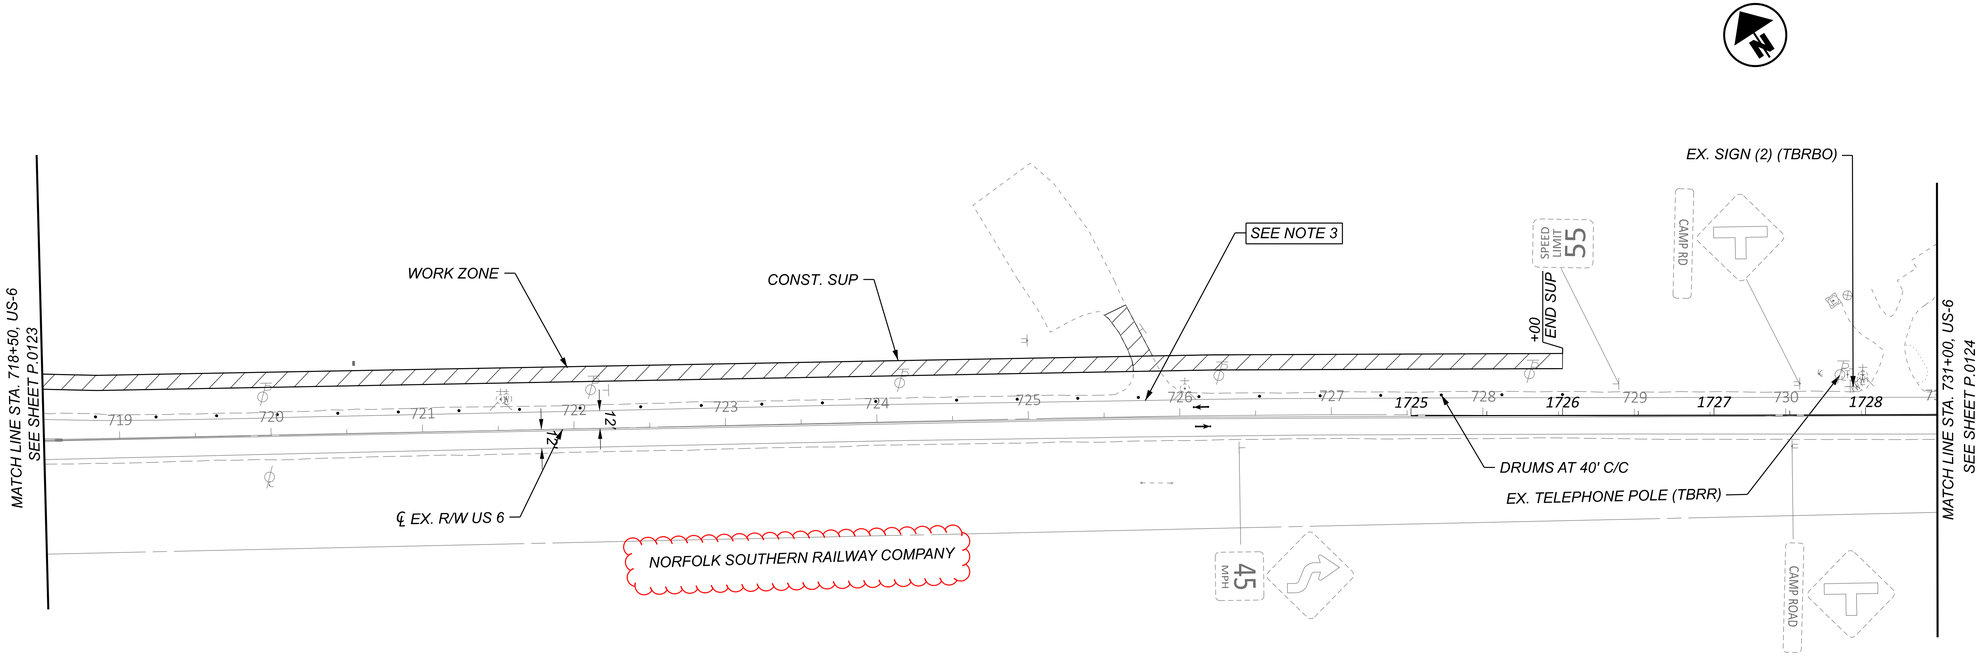

NOTES:

1. *FOR MOT LEGEND, SEE SHEET P.0084*
2. *FOR PROPOSED SIGNING AND MARKING DETAILS, SEE TRAFFIC CONTROL PLANS.*
3. *MAINTAIN ACCESS TO DRIVES OR SIDE ROADS AT ALL TIMES. USE FLAGGING OPERATION AS NECESSARY.*

HORIZONTAL SCALE IN FEET
0 25 50 100

MAINTENANCE OF TRAFFIC - PRE-PHASE (2026 CONSTRUCTION)


DESIGN AGENCY
TRANSYSTEMS
400 W. NATIONWIDE BLVD, STE 225
COLUMBUS, OHIO 43215

DESIGNER: SSA
REVIEWER: SS 10/27/25
PROJECT ID: 116570
SHEET: P.0124 TOTAL: 1106

MODEL: CLP_SUP 2 - Plan 14 [Sheet] PAPERSIZE: 34x22 (in.) DATE: 2/25/2026 TIME: 2:55:14 PM PLTDRV: OHDOT_PDF_Levels.pltcfg PENTBL: OHDOT_Pen.tbl USER: hrthornton@gfthinc.com WORKSPACE: OHDOTCEv02 WORKSET: 116570 PRODUCT: OpenRoadsDesigner 24.00.02.25
pw:\\ohiodot-pw.bentley.com:ohiodot-pw-02\Documents\01 Active Projects\District 03\Erie\116570\402 Engineering_TranSystems\MOT\Sheets\116570_MP000_CY2026.dgn

ERI-US 0006-CONNECTIVITY CORRIDOR

2026 UTILITY RELOCATION WORK

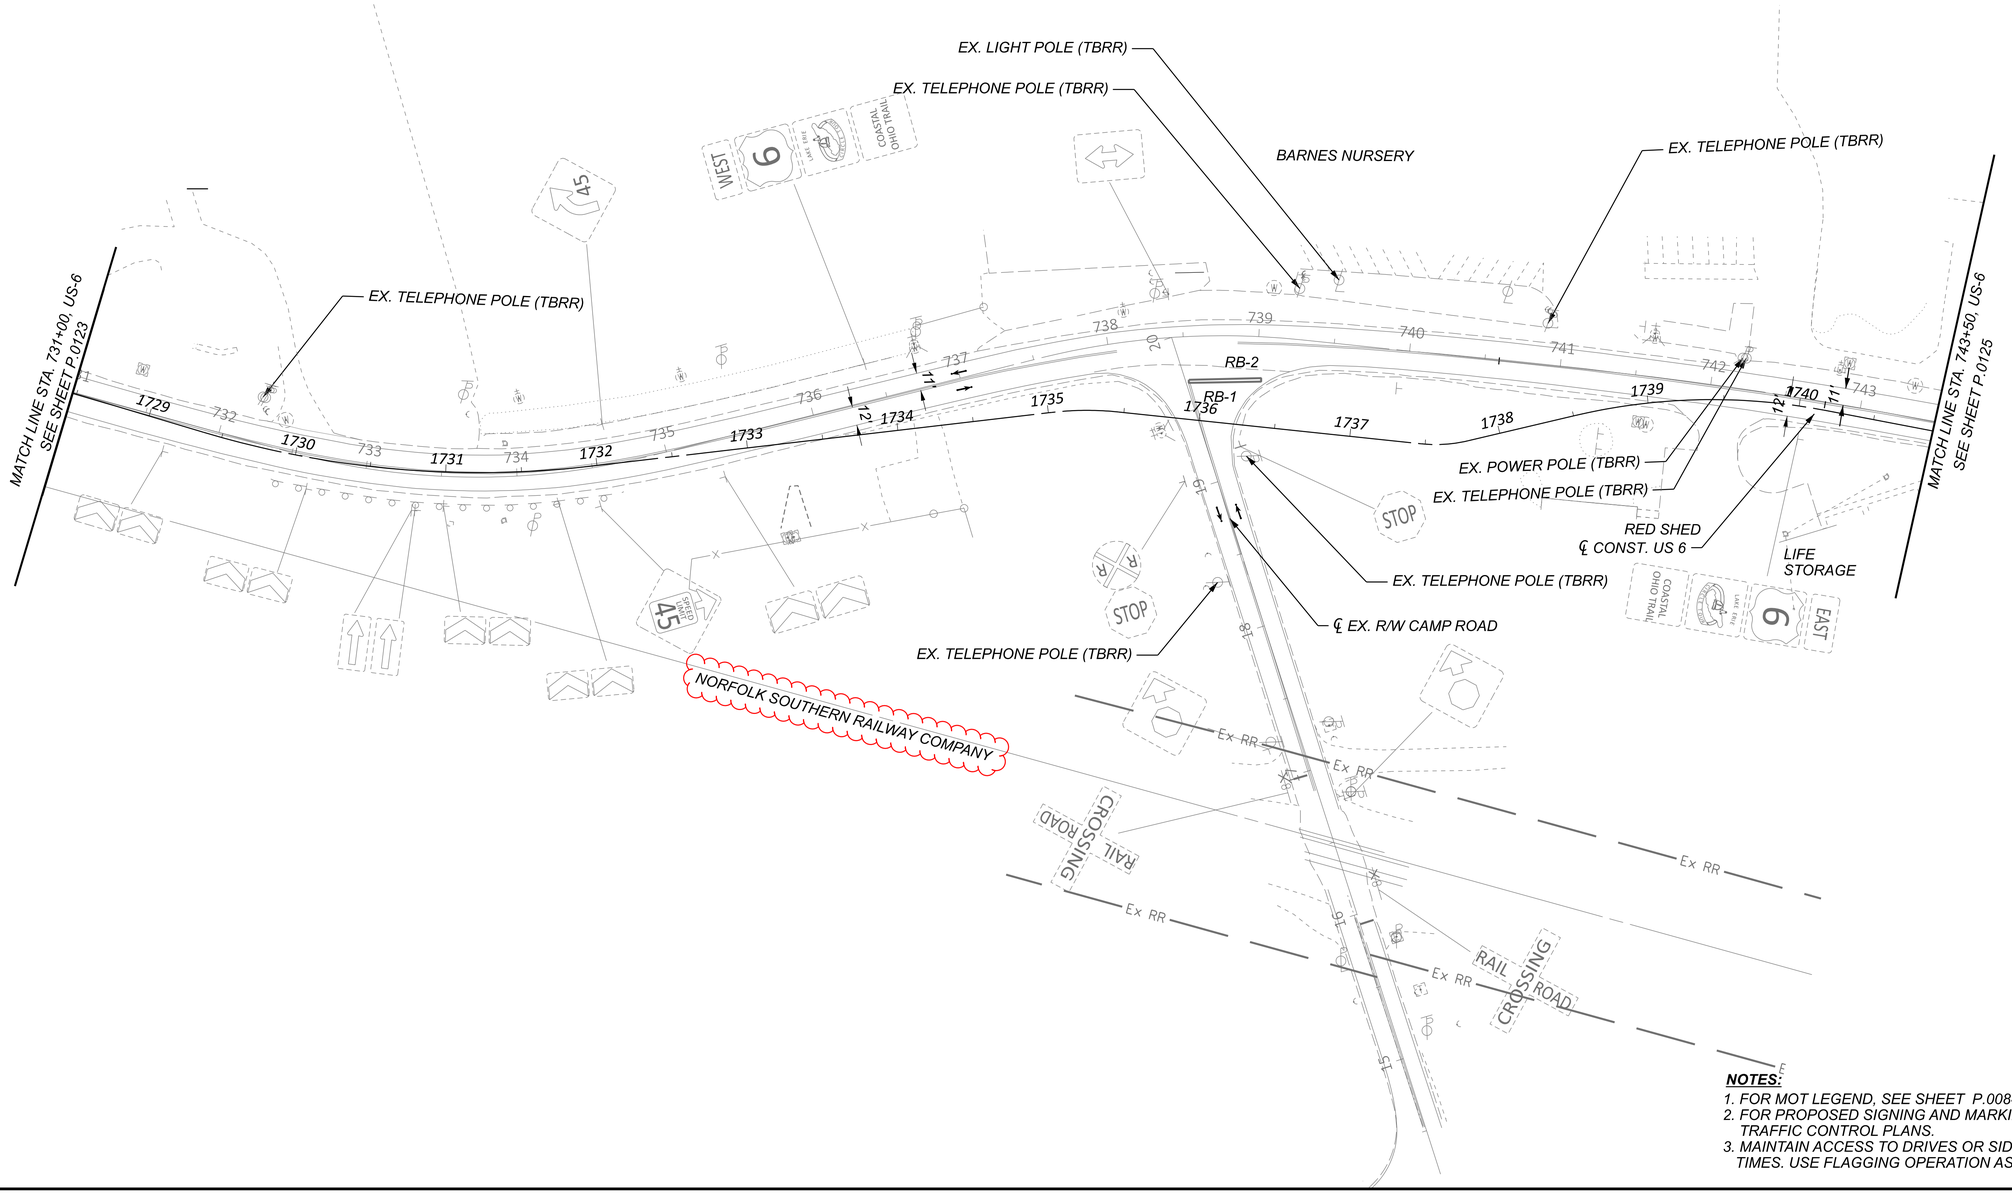

NOTES:

1. FOR MOT LEGEND, SEE SHEET P.0084
2. FOR PROPOSED SIGNING AND MARKING DETAILS, SEE TRAFFIC CONTROL PLANS.
3. MAINTAIN ACCESS TO DRIVES OR SIDE ROADS AT ALL TIMES. USE FLAGGING OPERATION AS NECESSARY.


HORIZONTAL SCALE IN FEET
0 25 50 100

MAINTENANCE OF TRAFFIC - PRE-PHASE (2026 CONSTRUCTION)
US 6 - STA. 731+00.00 TO STA. 743+50.00

DESIGN AGENCY
TRANSYSTEMS
400 W. NATIONWIDE BLVD., STE 225
COLUMBUS, OHIO 43215

DESIGNER	SSA
REVIEWER	SS 10/27/25
PROJECT ID	116570
SHEET	P.0125
TOTAL	1106

MODEL: CLP_SUP 1 - Plan 1-2 [Sheet] PAPERSIZE: 34x22 (in.) DATE: 2/25/2026 TIME: 4:48:10 PM PLTDRV: OHDOT_PDF_Levels.pltcfg PENTBL: OHDOT_Pen.tbl USER: hrthornton@gftinc.com WORKSPACE: OHDOTCEv02 WORKSET: 116570 PRODUCT: OpenRoadsDesigner 24.00.02.25
pw:\\ohiodot-pw.bentley.com:ohiodot-pw-02\Documents\01 Active Projects\District 03\Erie\116570\402-Engineering_TranSystems\MOT\Sheets\116570_MP001_CY2026.dgn

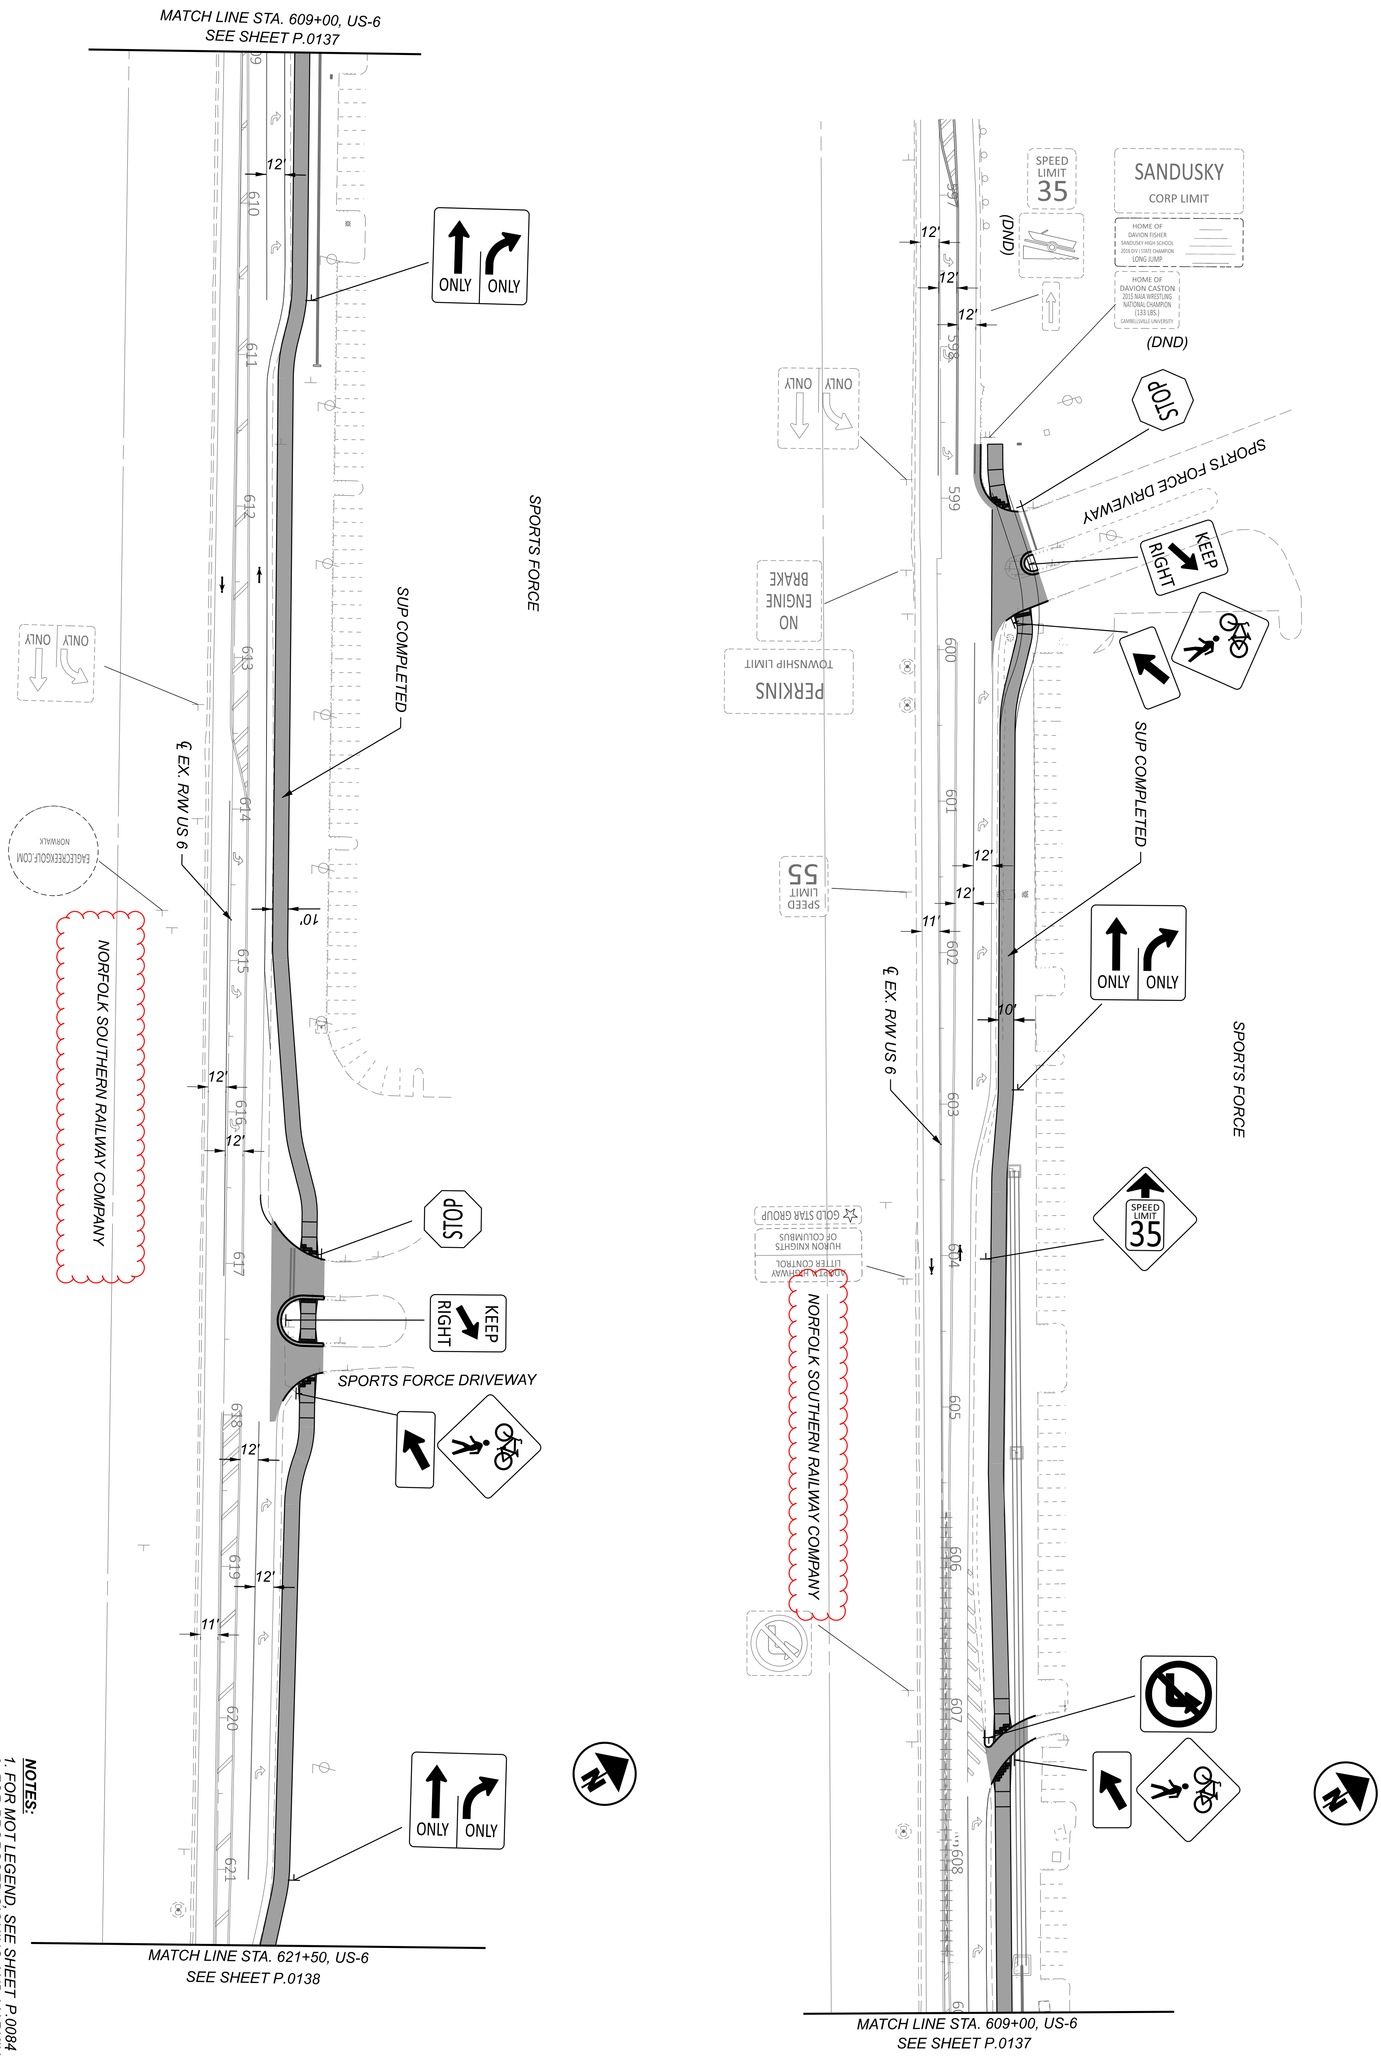

NOTES:

1. FOR MOT LEGEND, SEE SHEET P.0084
2. FOR PROPOSED SIGNING AND MARKING DETAILS, SEE TRAFFIC CONTROL PLANS.
3. MAINTAIN ACCESS TO DRIVES OR SIDE ROADS AT ALL TIMES. USE FLAGGING OPERATION AS NECESSARY.

SHEET	TOTAL
P 0138	1106


PROJECT ID	REVIEWER
116570	SS 10/27/25


DESIGNER: SSA

TRANSYSTEMS
400 W. NATIONWIDE BLVD., STE 220
COLUMBUS, OHIO 43215
DESIGN AGENCY

MAINTENANCE OF TRAFFIC - PHASE 1 (2026 CONSTRUCTION)
US 6 - BEGIN PROJECT TO STA. 621+50

HORIZONTAL SCALE IN FEET
0 50
25 100

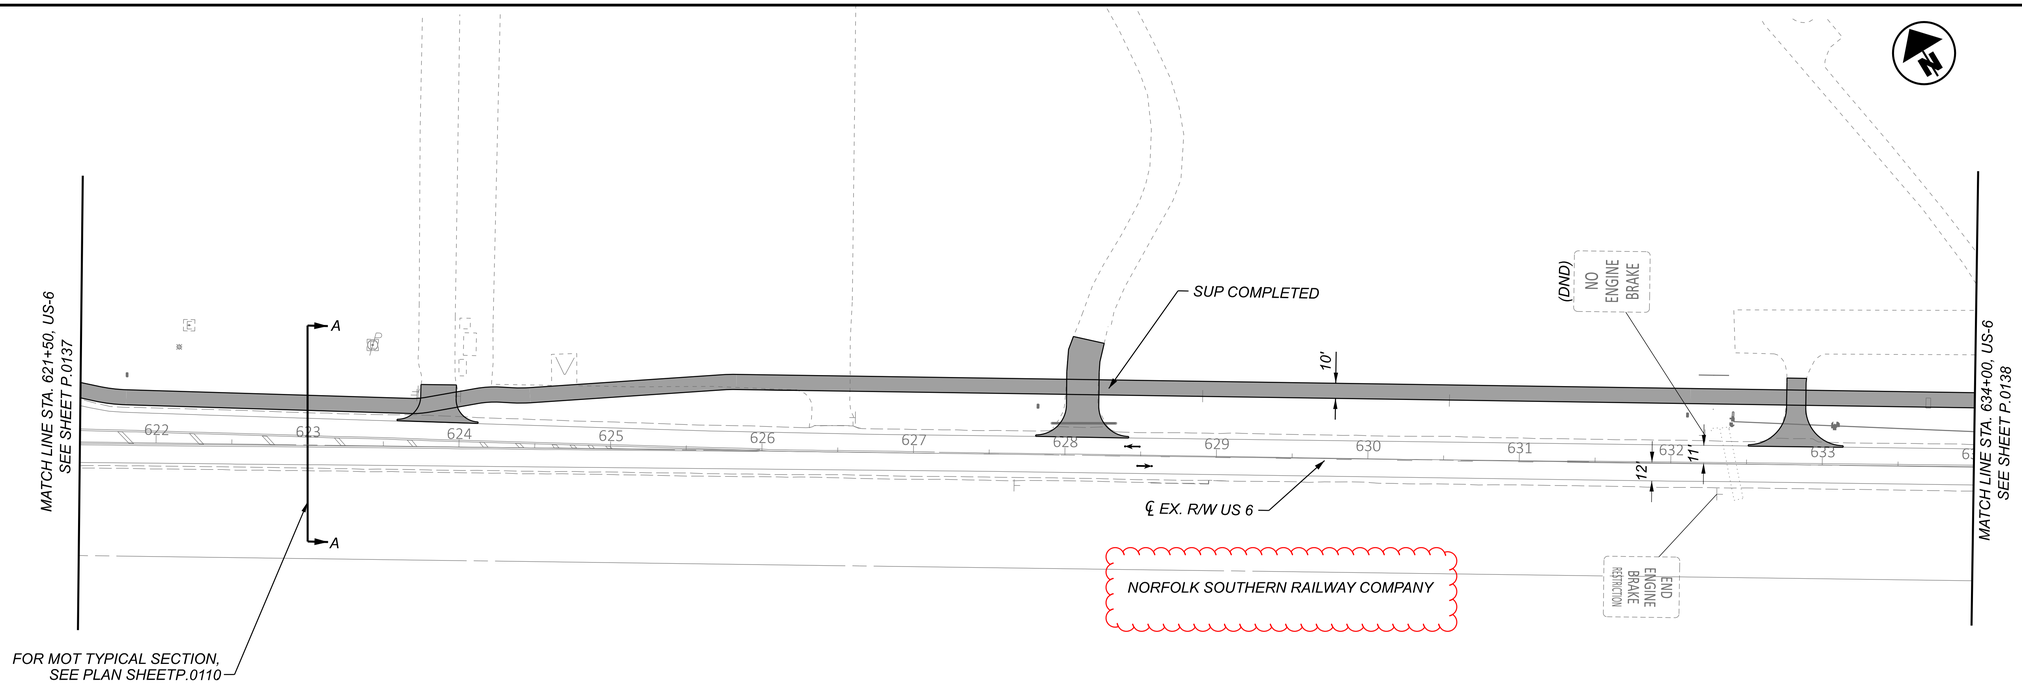

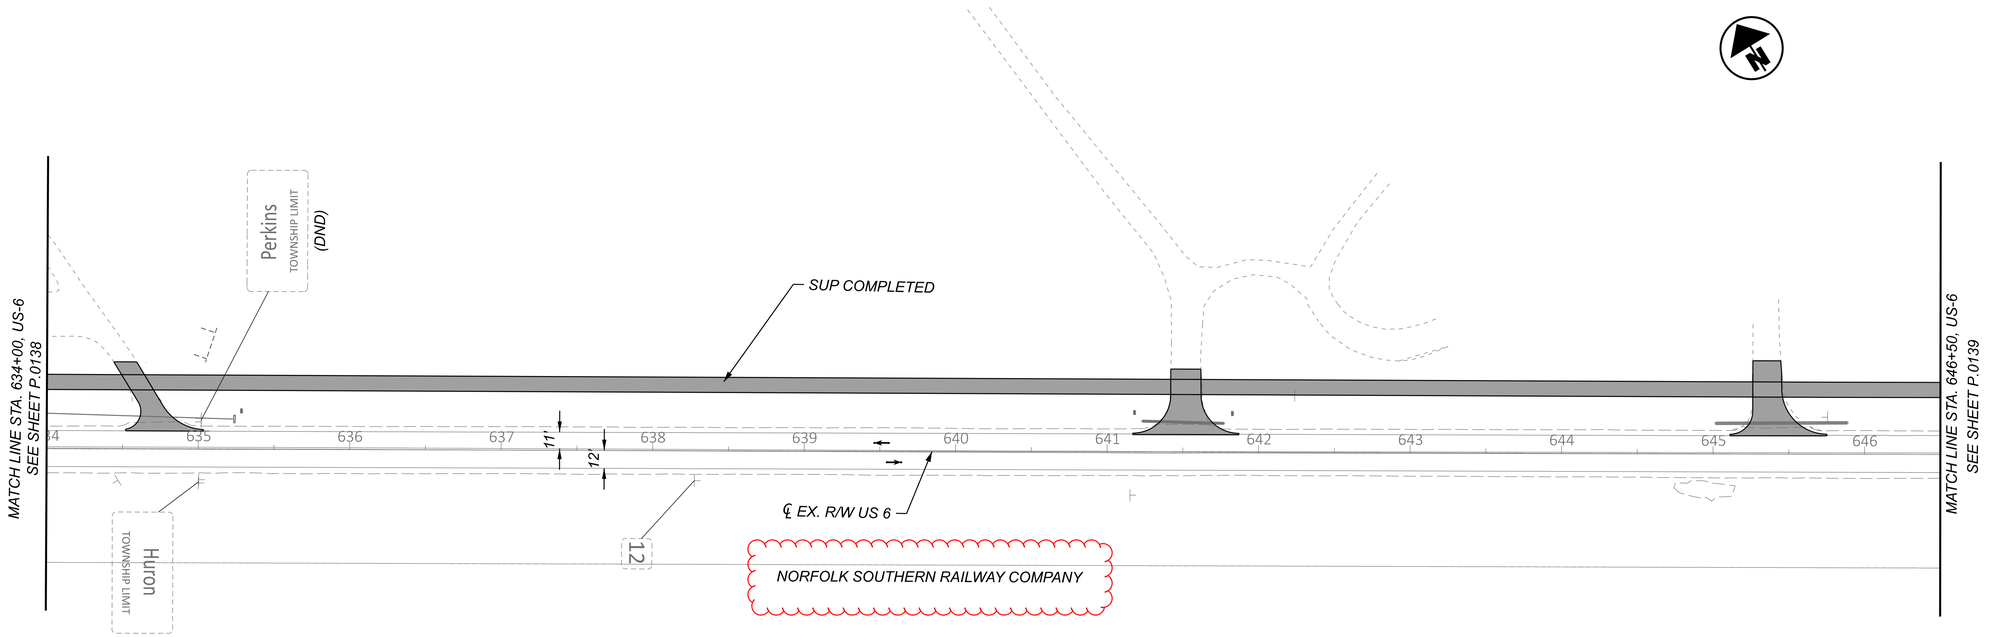

NOTES:

1. FOR MOT LEGEND, SEE SHEET P.0084
2. FOR SIGNING AND PAVEMENT MARKING DETAILS, SEE TRAFFIC CONTROL PLANS.
3. FOR SECTION A-A, SEE SHEET P.0110
4. MAINTAIN ACCESS TO DRIVES OR SIDE ROADS AT ALLTIMES. USE FLAGGING OPERATION AS NECESSARY.

HORIZONTAL SCALE IN FEET
0 25 50 100

MAINTENANCE OF TRAFFIC - PHASE 1 (2026 CONSTRUCTION)
US 6 - STA. 621+50.00 TO STA. 646+50.00


DESIGN AGENCY
TRANSYSTEMS
400 W. NATIONWIDE BLVD., STE 220
COLUMBUS, OHIO 43215

DESIGNER: SSA
REVIEWER: SS 10/27/25
PROJECT ID: 116570
SHEET: P.0139 TOTAL: 1106

ERI-US 0006-CONNECTIVITY CORRIDOR

MODEL: CLP_SUP 1 - Plan 3-4 [Sheet] PAPERSIZE: 34x22 (in.) DATE: 2/25/2026 TIME: 4:52:24 PM PLTDRV: OHDOT_PDF_Levels.pltcfg PENTBL: OHDOT_Pen.tbl USER: hrthornton@gftinc.com WORKSPACE: OHDOTCEv02 WORKSET: 116570 PRODUCT: OpenRoadsDesigner 24.00.02.25
pw:\\ohiodot-pw.bentley.com:ohiodot-pw-02\Documents\01 Active Projects\District 03\Erie\116570\402-Engineering_TranSystems\MOT\Sheets\116570_MP001_CY2026.dgn

MODEL: CLP_SUP 1 - Plan 5-6 [Sheet] PAPERSIZE: 34x22 (in.) DATE: 2/25/2026 TIME: 4:55:41 PM PLTDRV: OHDOT_PDF_Levels.pltcfg PENTBL: OHDOT_Pen.tbl USER: hrthornton@gftinc.com WORKSPACE: OHDOTCEv02 WORKSET: 116570 PRODUCT: OpenRoadsDesigner 24.00.02.25
pw:\\ohiodot-pw.bentley.com:ohiodot-pw-02\Documents\01 Active Projects\District 03\Erie\116570\402-Engineering_TranSystems\MOT\Sheets\116570_MP001_CY2026.dgn

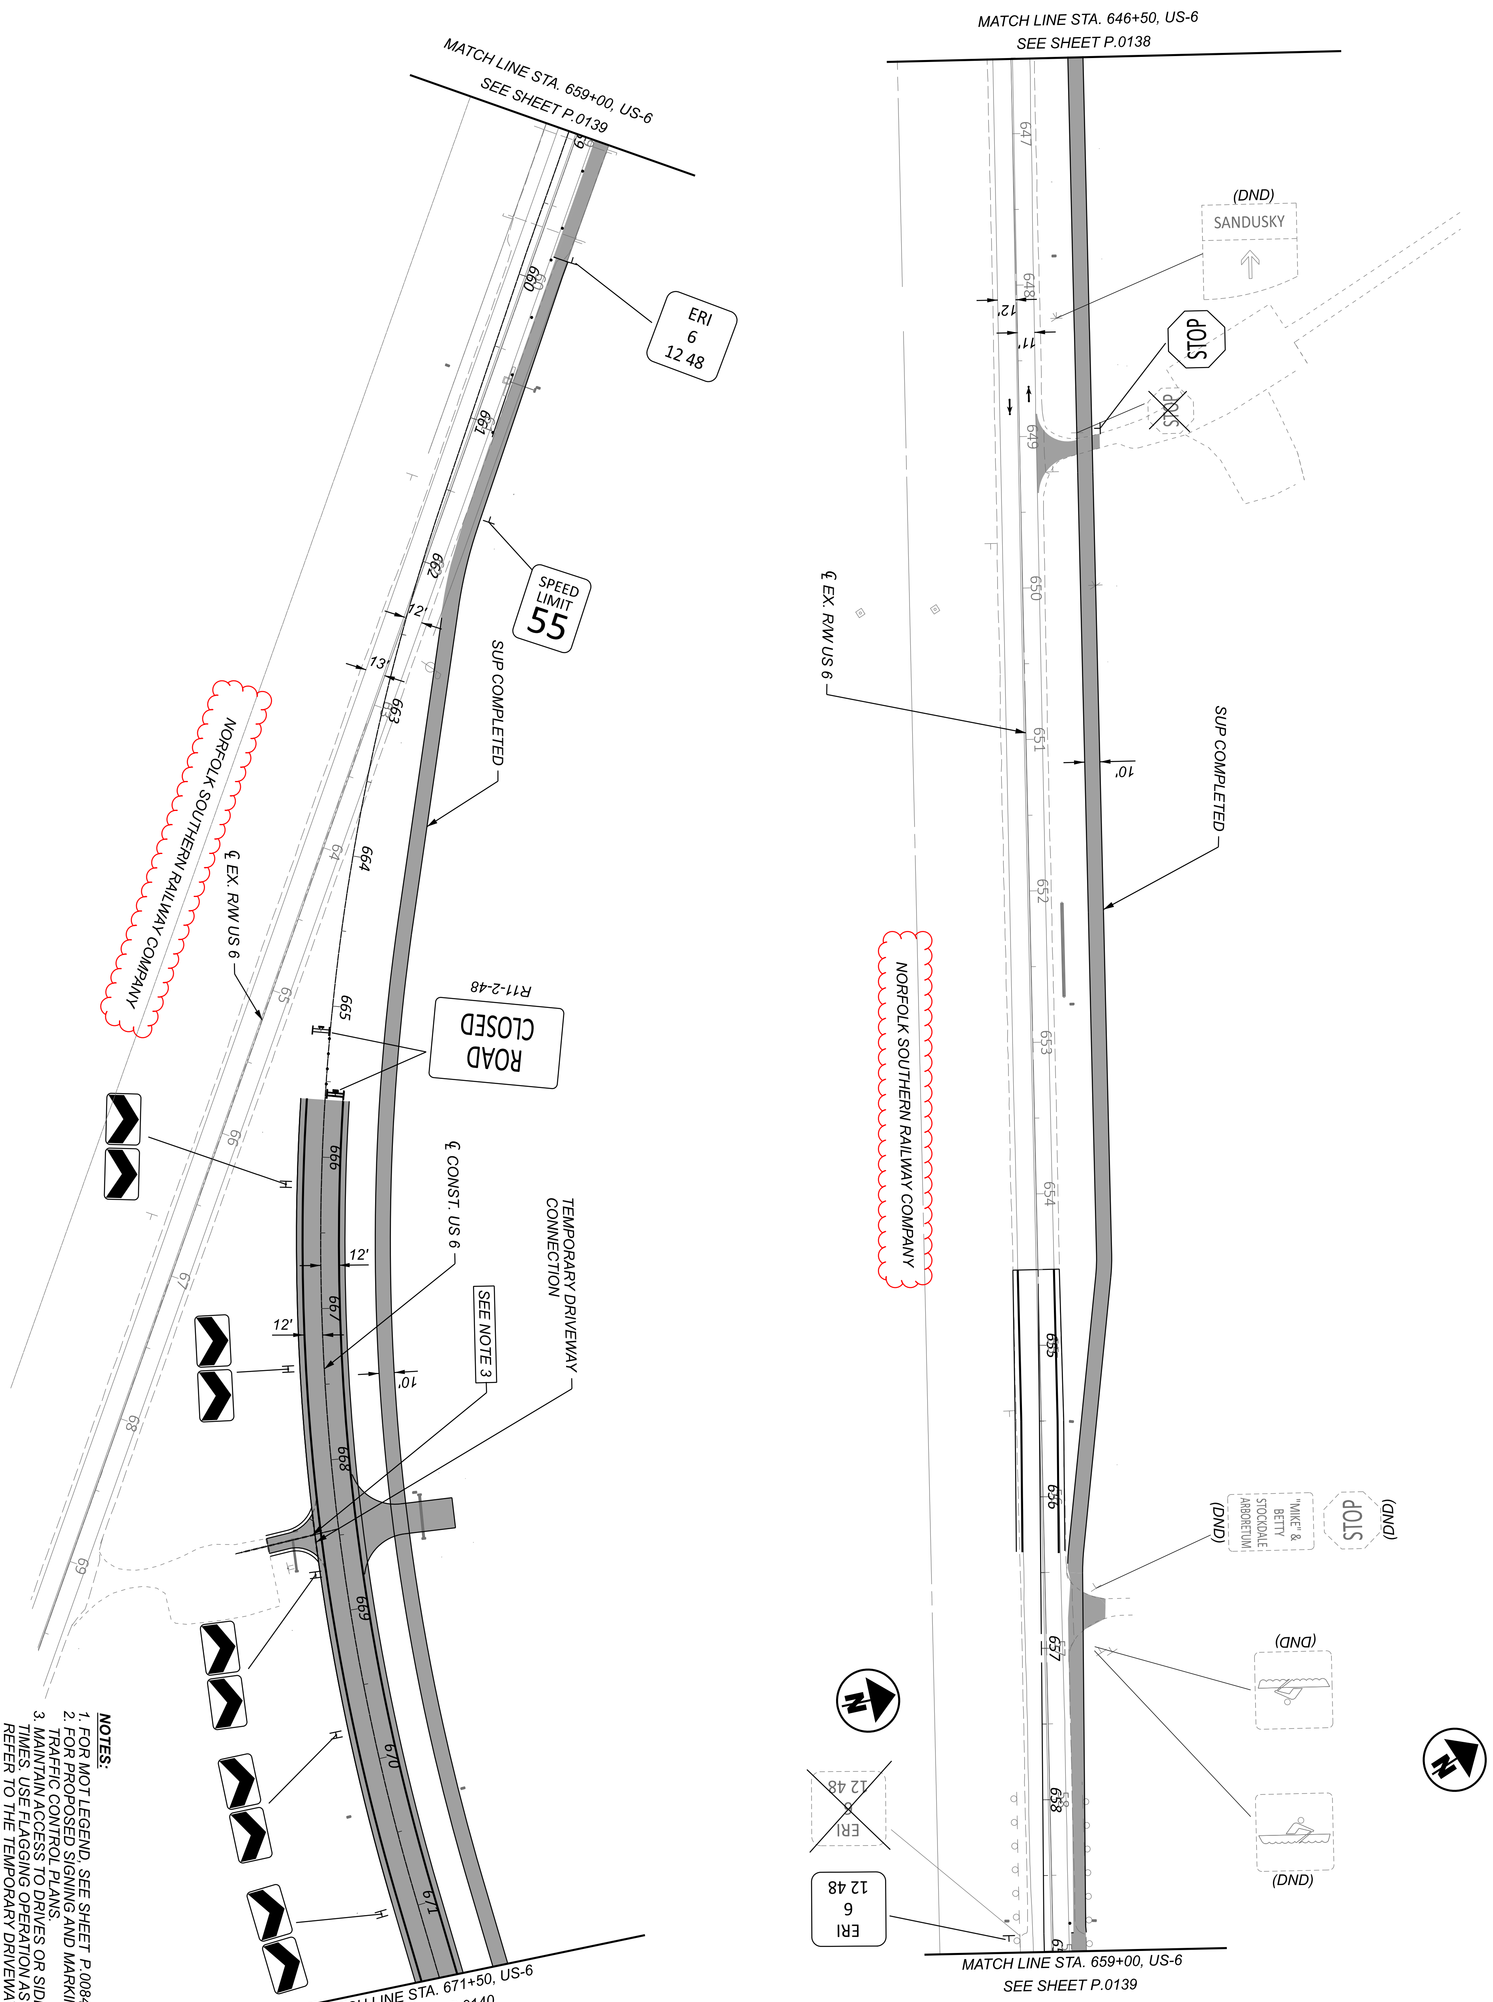

NOTES:

1. FOR MOT LEGEND, SEE SHEET P.0084
2. FOR PROPOSED SIGNING AND MARKING DETAILS, SEE TRAFFIC CONTROL PLANS.
3. MAINTAIN ACCESS TO DRIVES OR SIDE ROADS AT ALL TIMES. USE FLAGGING OPERATION AS NECESSARY. REFER TO THE TEMPORARY DRIVEWAY PLAN & PROFILE SHEETS FOR DETAILS.

SHEET	TOTAL
P.0140	1106

PROJECT ID: 116570

REVIEWER: SS 10/27/25

DESIGNER: SSA


DESIGN AGENCY: TRANSYSTEMS
400 W. NATIONWIDE BLVD., STE 220
COLUMBUS, OHIO 43215

MAINTENANCE OF TRAFFIC - PHASE 1 (2026 CONSTRUCTION)
US 6 - STA. 646+50.00 TO STA. 671+50.00

HORIZONTAL SCALE IN FEET
0 50
25 100

ERI-US 0006-CONNECTIVITY CORRIDOR

MODEL: CLX_RW_ORIG_US006 - Plan 7-8 [Sheet] PAPERSIZE: 34x22 (in.) DATE: 2/25/2026 TIME: 5:09:19 PM PLTDRV: OHDOT_PDF_Levels.pltcfg PENTBL: OHDOT_Pen.tbl USER: hrthornton@gftinc.com WORKSPACE: OHDOTCtv02 WORKSET: 116570 PRODUCT: OpenRoadsDesigner 24.00.02.25
pw:\\ohiodot-pw.bentley.com:ohiodot-pw-02\Documents\01 Active Projects\District 03\Erie\116570\402-Engineering_TranSystems\MOT\Sheets\116570_MP001_CY2026.dgn

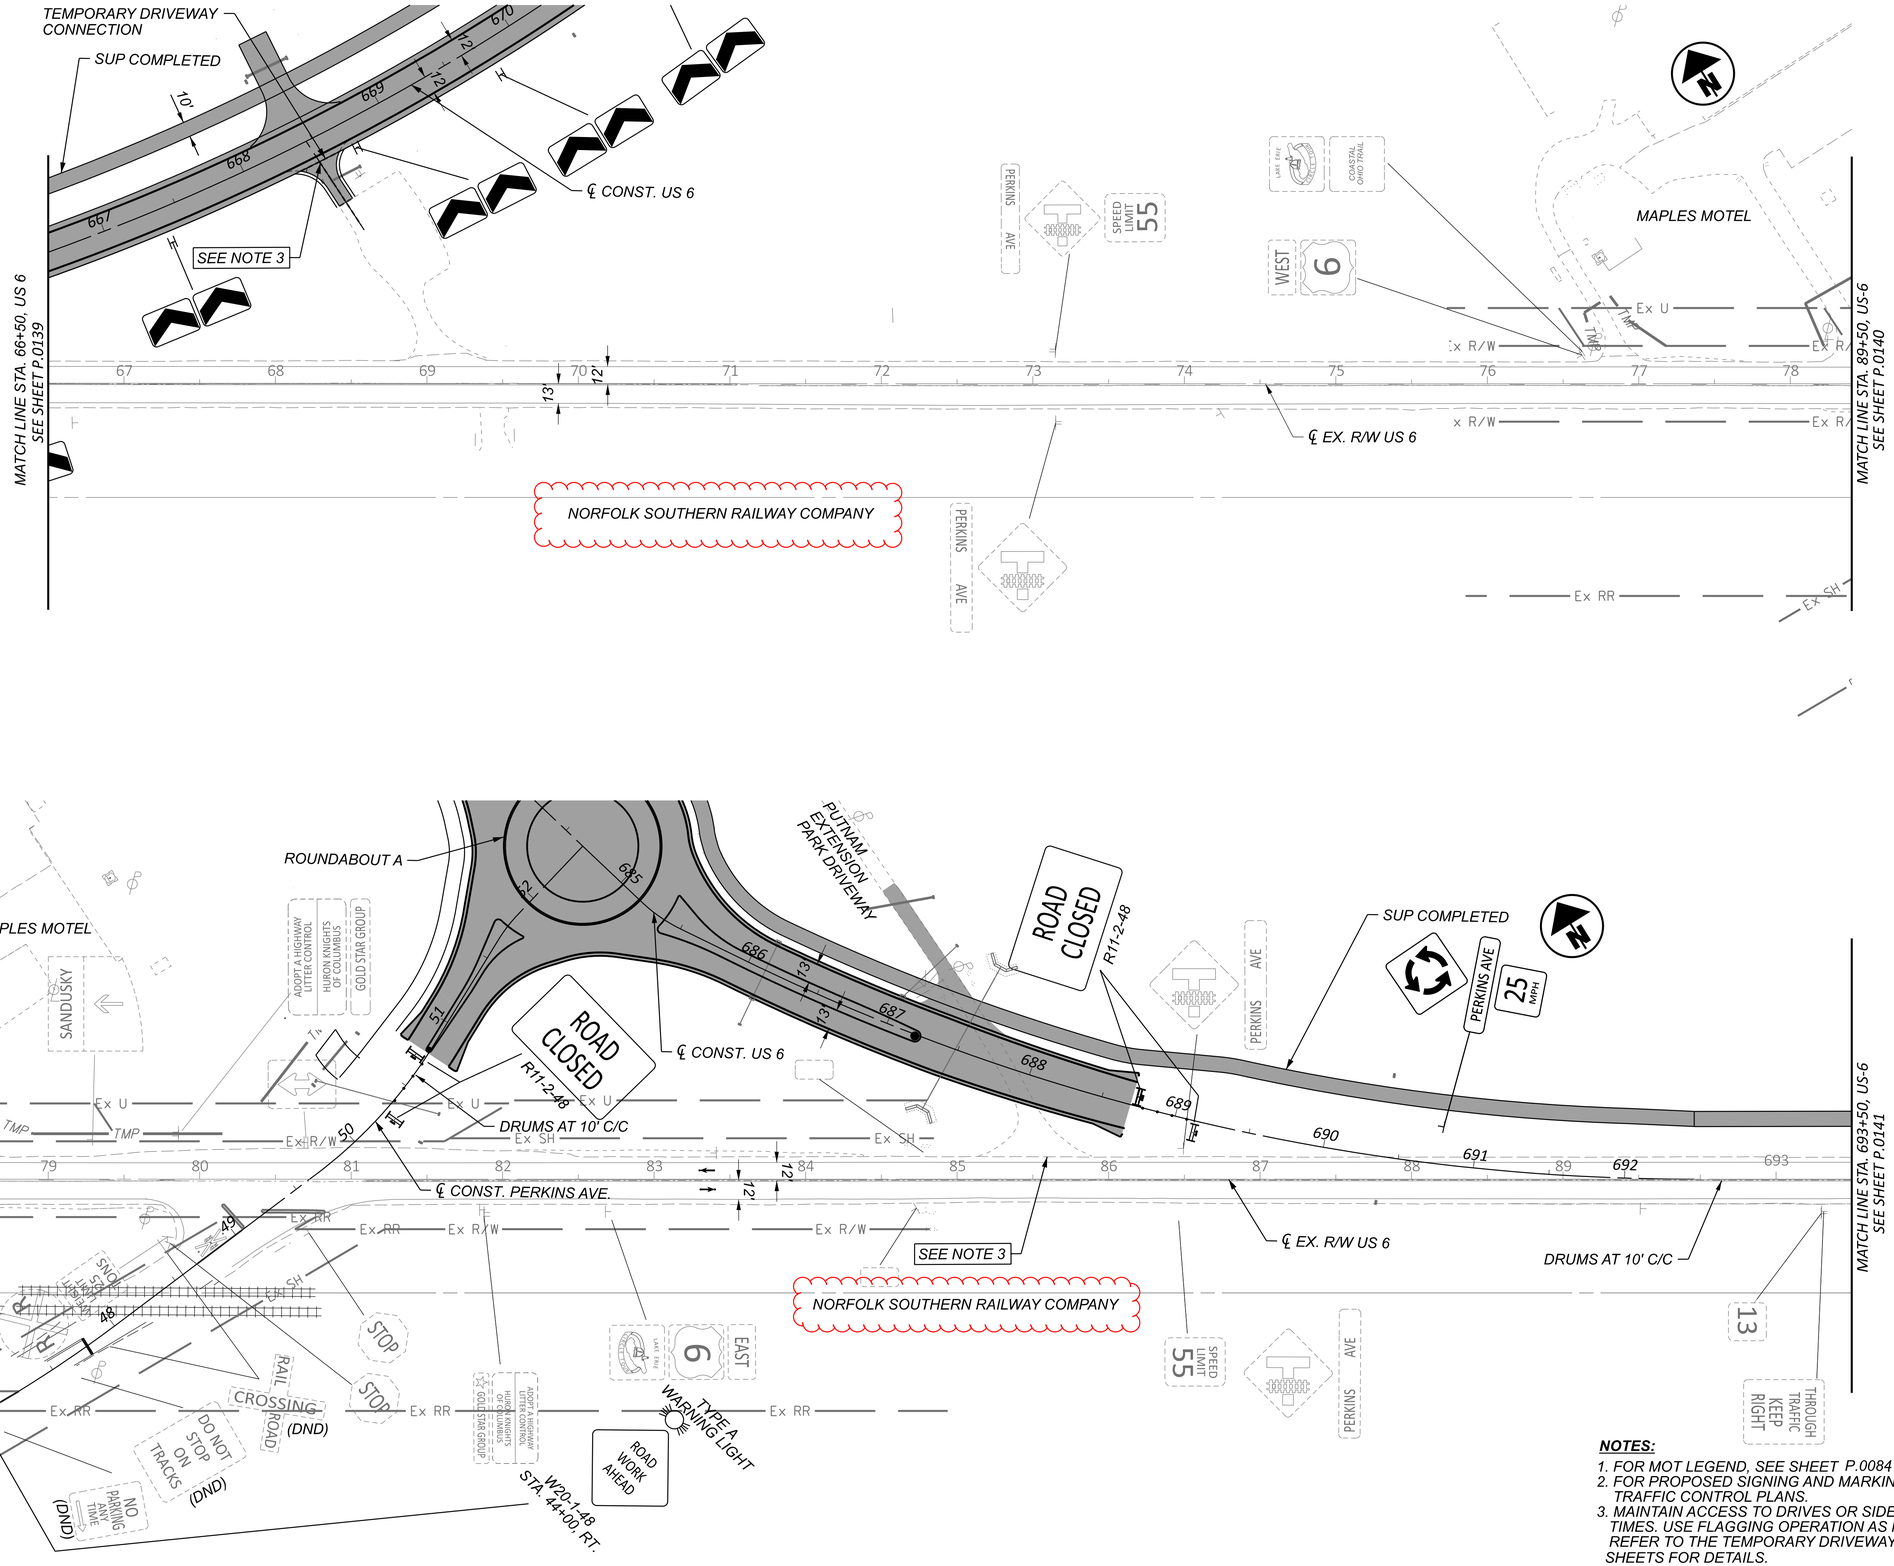

NOTES:

1. FOR MOT LEGEND, SEE SHEET P.0084
2. FOR PROPOSED SIGNING AND MARKING DETAILS, SEE TRAFFIC CONTROL PLANS.
3. MAINTAIN ACCESS TO DRIVES OR SIDE ROADS AT ALL TIMES. USE FLAGGING OPERATION AS NECESSARY. REFER TO THE TEMPORARY DRIVEWAY PLAN & PROFILE SHEETS FOR DETAILS.

HORIZONTAL SCALE IN FEET
0 25 50 100


MAINTENANCE OF TRAFFIC - PHASE 1 (2026 CONSTRUCTION)
US 6 - STA. 67+00.00 EX. US 6 TO 693+50.00 CONST. US 6 SUP

DESIGN AGENCY
TRANSYSTEMS
400 W. NATIONWIDE BLVD., STE 225
COLUMBUS, OHIO 43215

DESIGNER	SSA
REVIEWER	SS 10/27/25
PROJECT ID	116570
SHEET	P.0141
TOTAL	1106

ERI-US 0006-CONNECTIVITY CORRIDOR

MODEL: CLP_SUP 1 - Plan 9-10 [Sheet] PAPERSIZE: 34x22 (in.) DATE: 2/25/2026 TIME: 5:12:37 PM PLTDRV: OHDOT_PDF_Levels.pltcfg PENTBL: OHDOT_Pen.tbl USER: hrthornton@gftinc.com WORKSPACE: OHDOTCEv02 WORKSET: 116570 PRODUCT: OpenRoadsDesigner 24.00.02.25
pw:\\ohiodot-pw.bentley.com:ohiodot-pw-02\Documents\01 Active Projects\District 03\Erie\116570\402-Engineering_TranSystems\MOT\Sheets\116570_MP001_CY2026.dgn

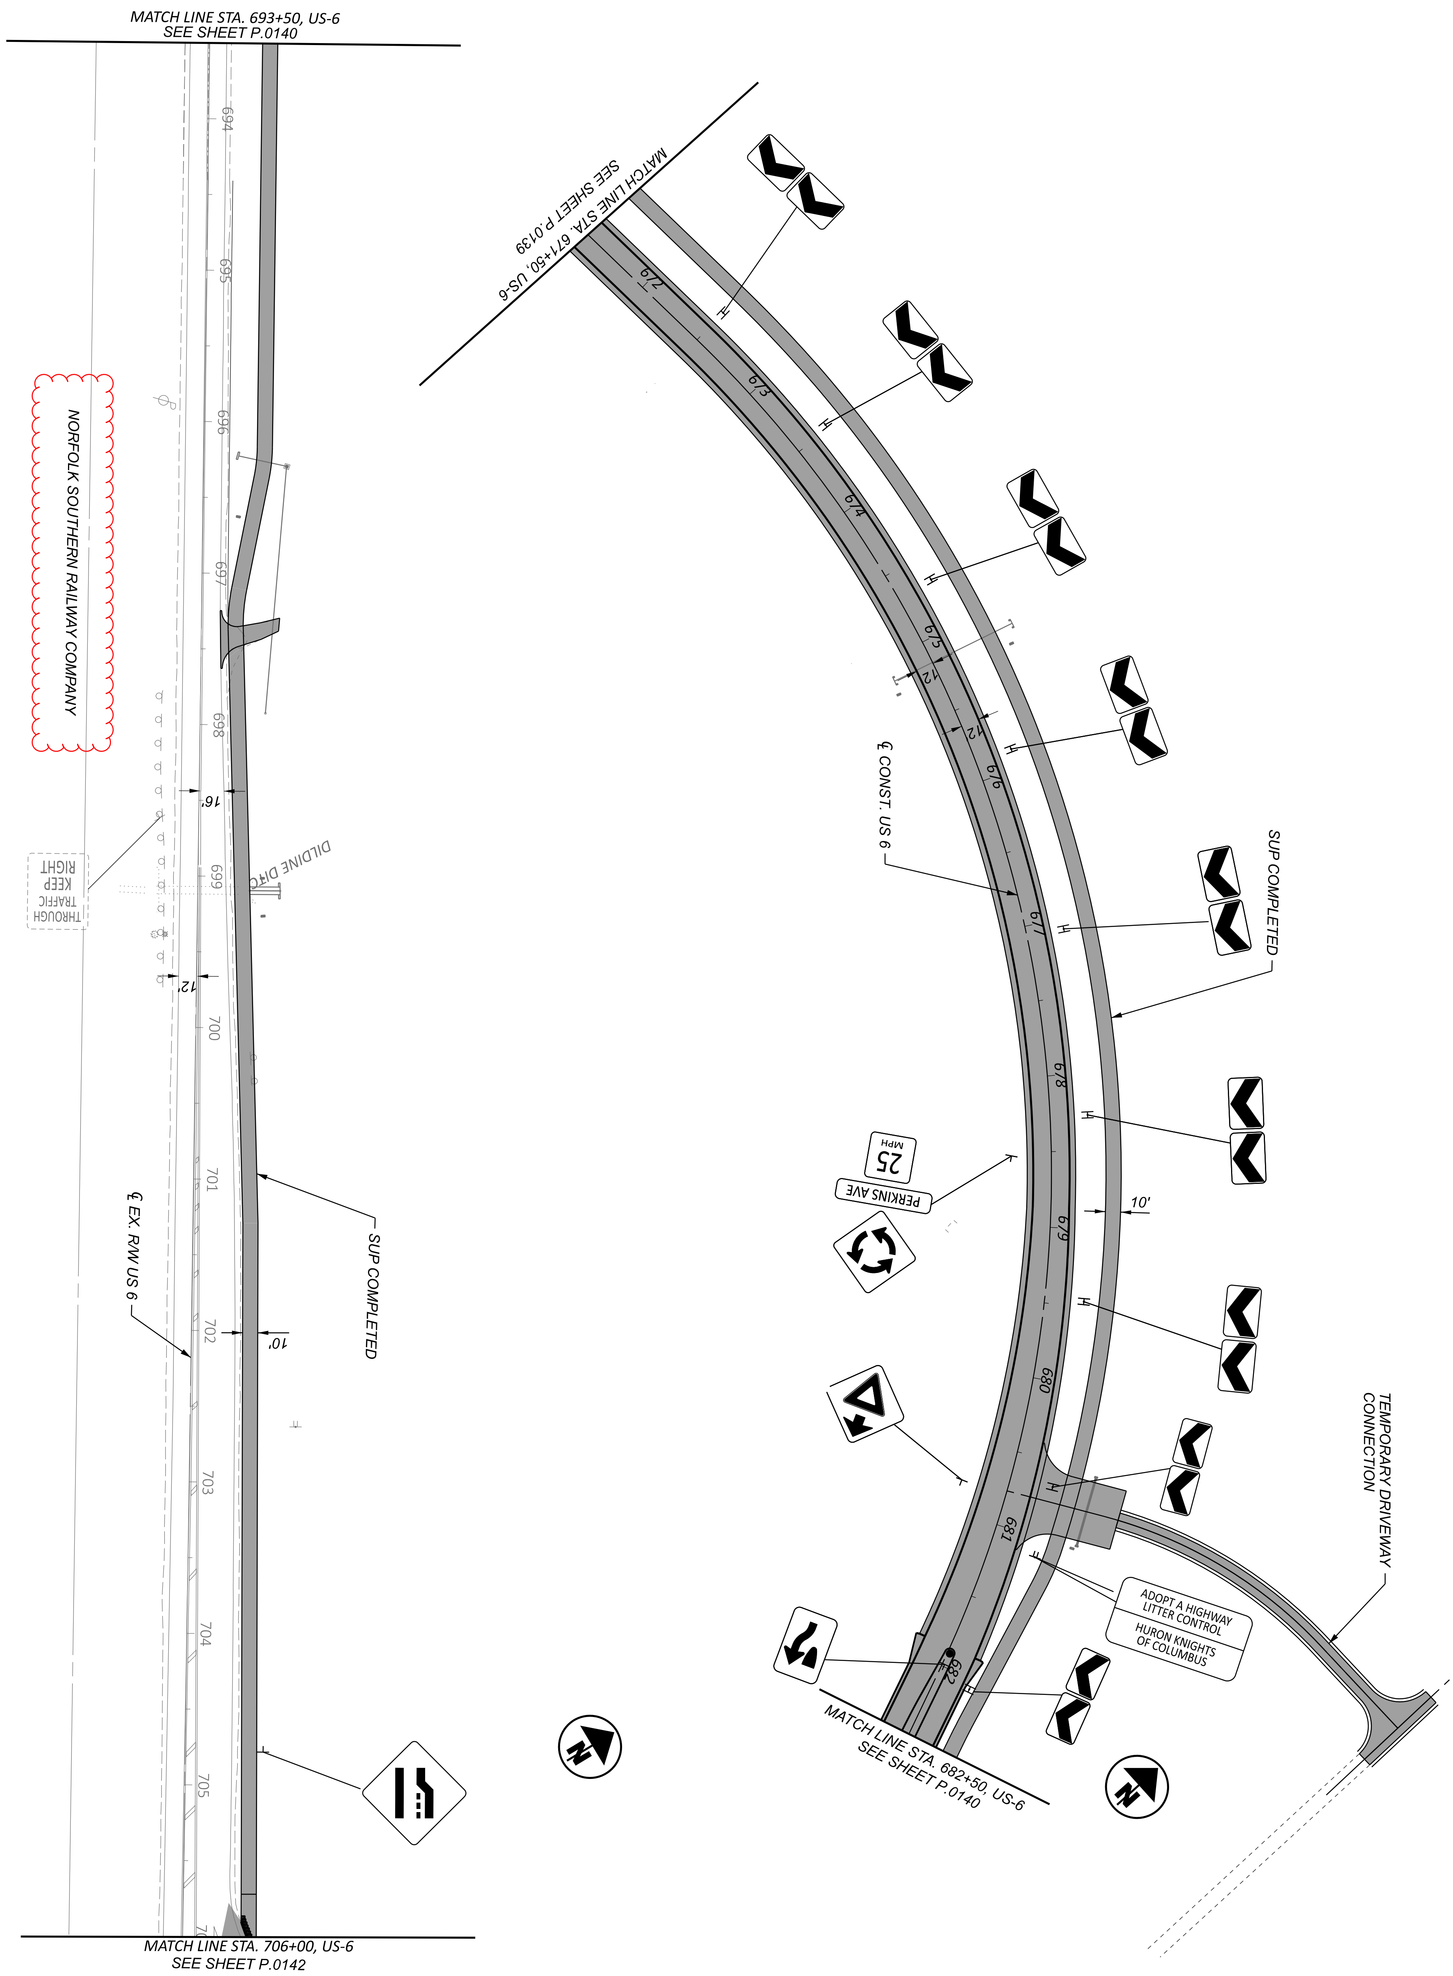

NOTES:

1. FOR MOT LEGEND, SEE SHEET P.0084
2. FOR PROPOSED SIGNING AND MARKING DETAILS, SEE TRAFFIC CONTROL PLANS.
3. MAINTAIN ACCESS TO DRIVES OR SIDE ROADS AT ALL TIMES. USE FLAGGING OPERATION AS NECESSARY.

SHEET	TOTAL
P.0142	1106

PROJECT ID: 116570

REVIEWER: SS 10/27/25


DESIGNER: SSA

DESIGN AGENCY: TRANSYSTEMS
400 W. NATIONWIDE BLVD., STE 220
COLUMBUS, OHIO 43215

MAINTENANCE OF TRAFFIC - PHASE 1 (2026 CONSTRUCTION)
US 6 - STA. 671+50.00 TO STA. 706+00.00

HORIZONTAL SCALE IN FEET
0 50
25 100

2026 UTILITY RELOCATION WORK

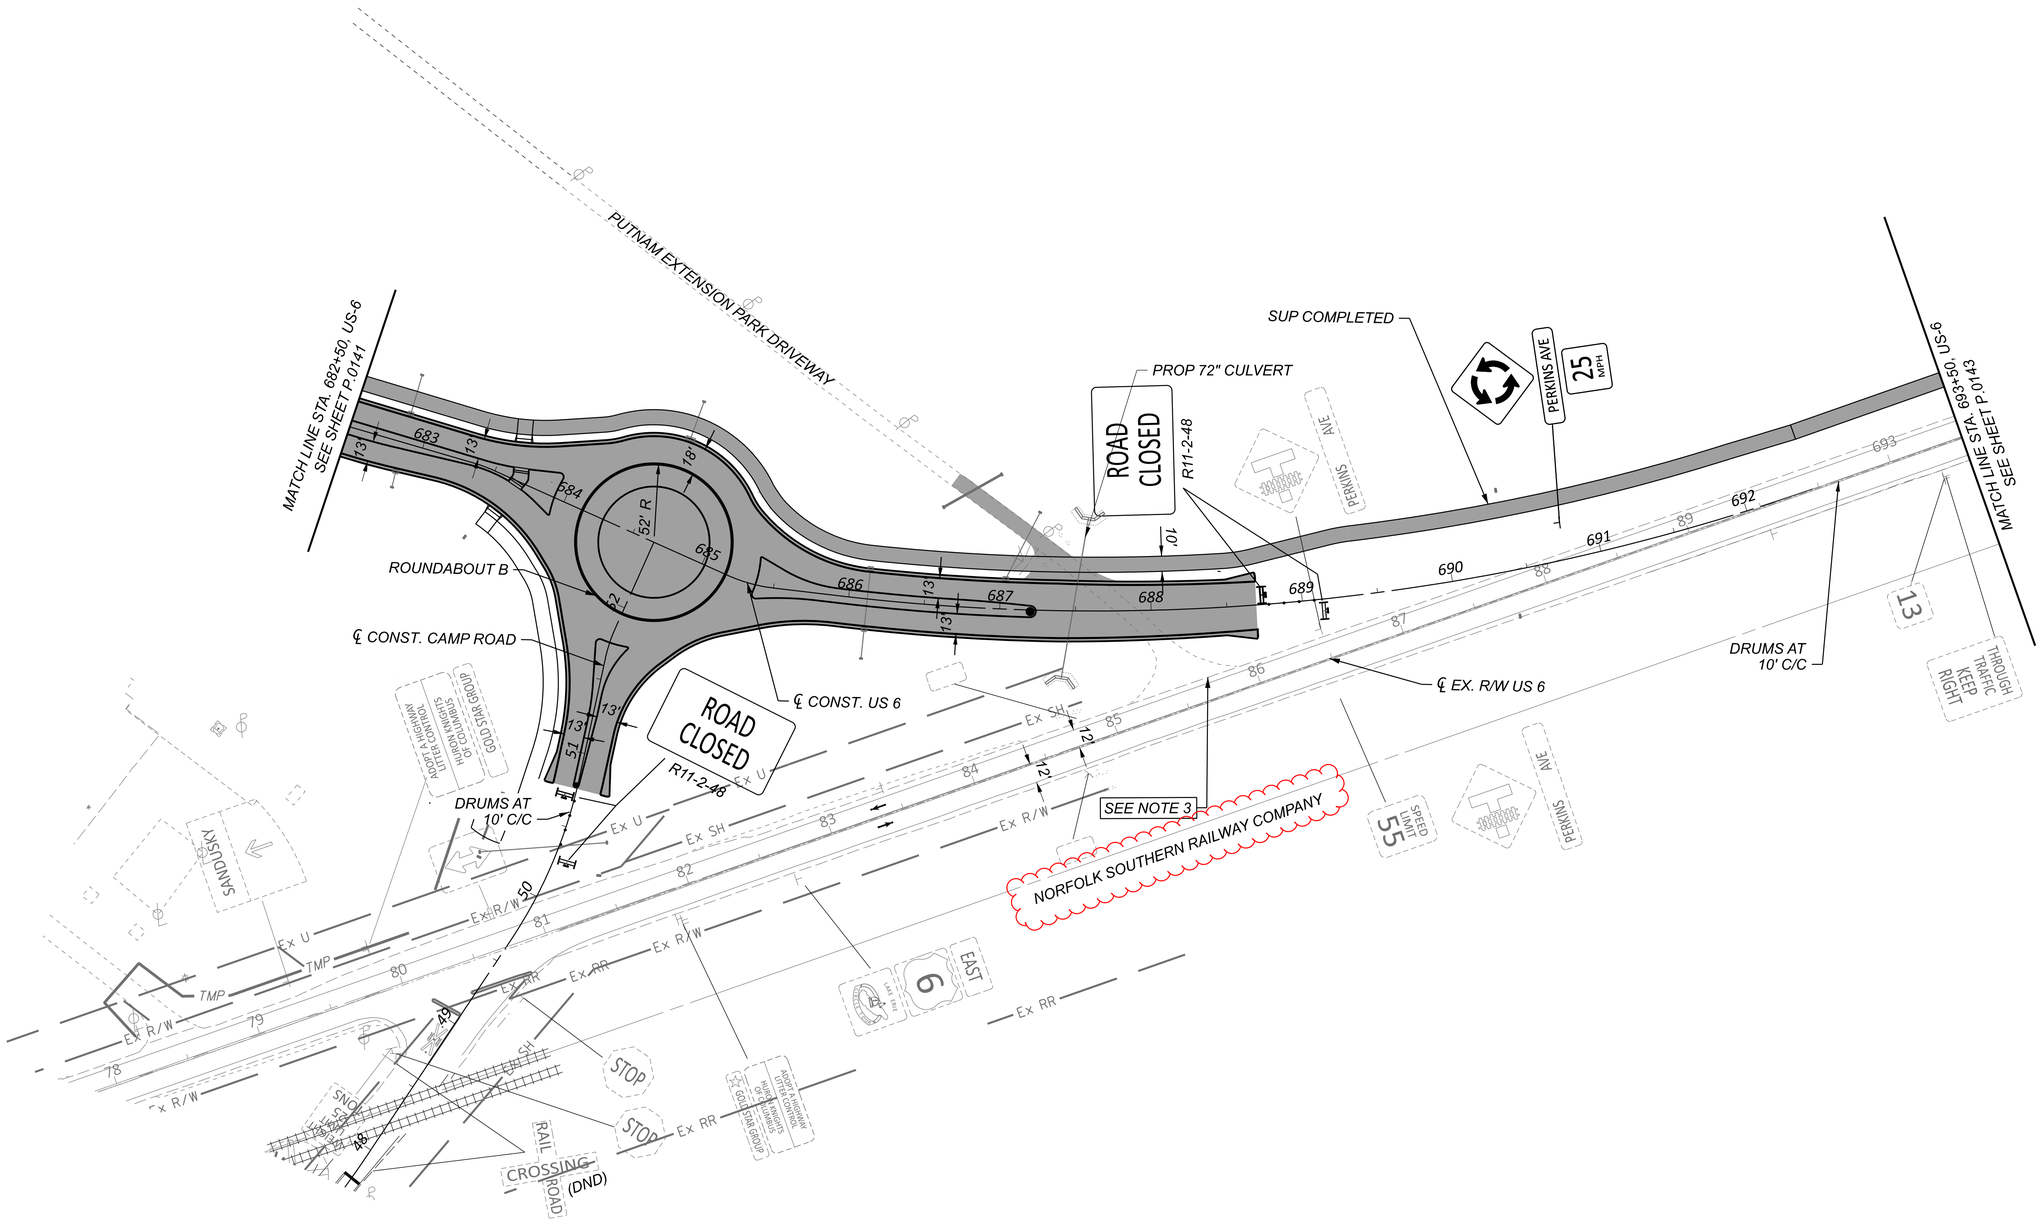

NOTES:

1. FOR MOT LEGEND, SEE SHEET P.0084
2. FOR SIGNING AND PAVEMENT MARKING DETAILS, SEE TRAFFIC CONTROL PLANS.
3. MAINTAIN ACCESS TO DRIVES OR SIDE ROADS AT ALL TIMES. USE FLAGGING OPERATION AS NECESSARY. REFER TO THE TEMPORARY DRIVEWAY PLAN & PROFILE SHEETS FOR DETAILS.

HORIZONTAL SCALE IN FEET
0 25 50 100

MAINTENANCE OF TRAFFIC - PHASE 1 (2026 CONSTRUCTION)
US 6 - STA. 683+00.00 TO STA. 693+50.00

DESIGN AGENCY
TRANSYSTEMS
400 W. NATIONWIDE BLVD., STE 225
COLUMBUS, OHIO 43215

DESIGNER: SSA
REVIEWER: SS 10/27/25
PROJECT ID: 116570
SHEET: P.0143 | TOTAL: 1106


ERI-US 0006-CONNECTIVITY CORRIDOR

MODEL: CLP_SUP 2 - Plan 11 [Sheet] PAPERSIZE: 34x22 (in.) DATE: 2/25/2026 TIME: 5:15:50 PM PLTDRV: OHDOT_PDF_Levels.pltcfg PENTBL: OHDOT_Pen.tbl USER: hrthornton@gfginc.com WORKSPACE: OHDOTCEv02 WORKSET: 116570 PRODUCT: OpenRoadsDesigner 24.00.02.25
pw:\\ohiodot-pw.bentley.com:ohiodot-pw-02\Documents\01 Active Projects\District 03\Erie\116570\402-Engineering_TranSystems\MOT\Sheets\116570_MP001_CY2026.dgn

ERI-US 0006-CONNECTIVITY CORRIDOR

MODEL: CLP_SUP 1 - Plan 12-13 |Sheet| PAPERSIZE: 34x22 (in.) DATE: 2/25/2026 TIME: 5:19:47 PM PLTDRV: OHDOT_PDF_Levels.pltcfg PENTBL: OHDOT_Pen.tbl USER: hrthornton@gftinc.com WORKSPACE: OHDOTCEv02 WORKSET: 116570 PRODUCT: OpenRoadsDesigner 24.00.02.25
pw:\\ohiodot-pw.bentley.com:ohiodot-pw-02\Documents\01 Active Projects\District 03\Erie\116570\402-Engineering_TranSystems\MOT\Sheets\116570_MP001_CY2026.dgn

2026 UTILITY RELOCATION WORK

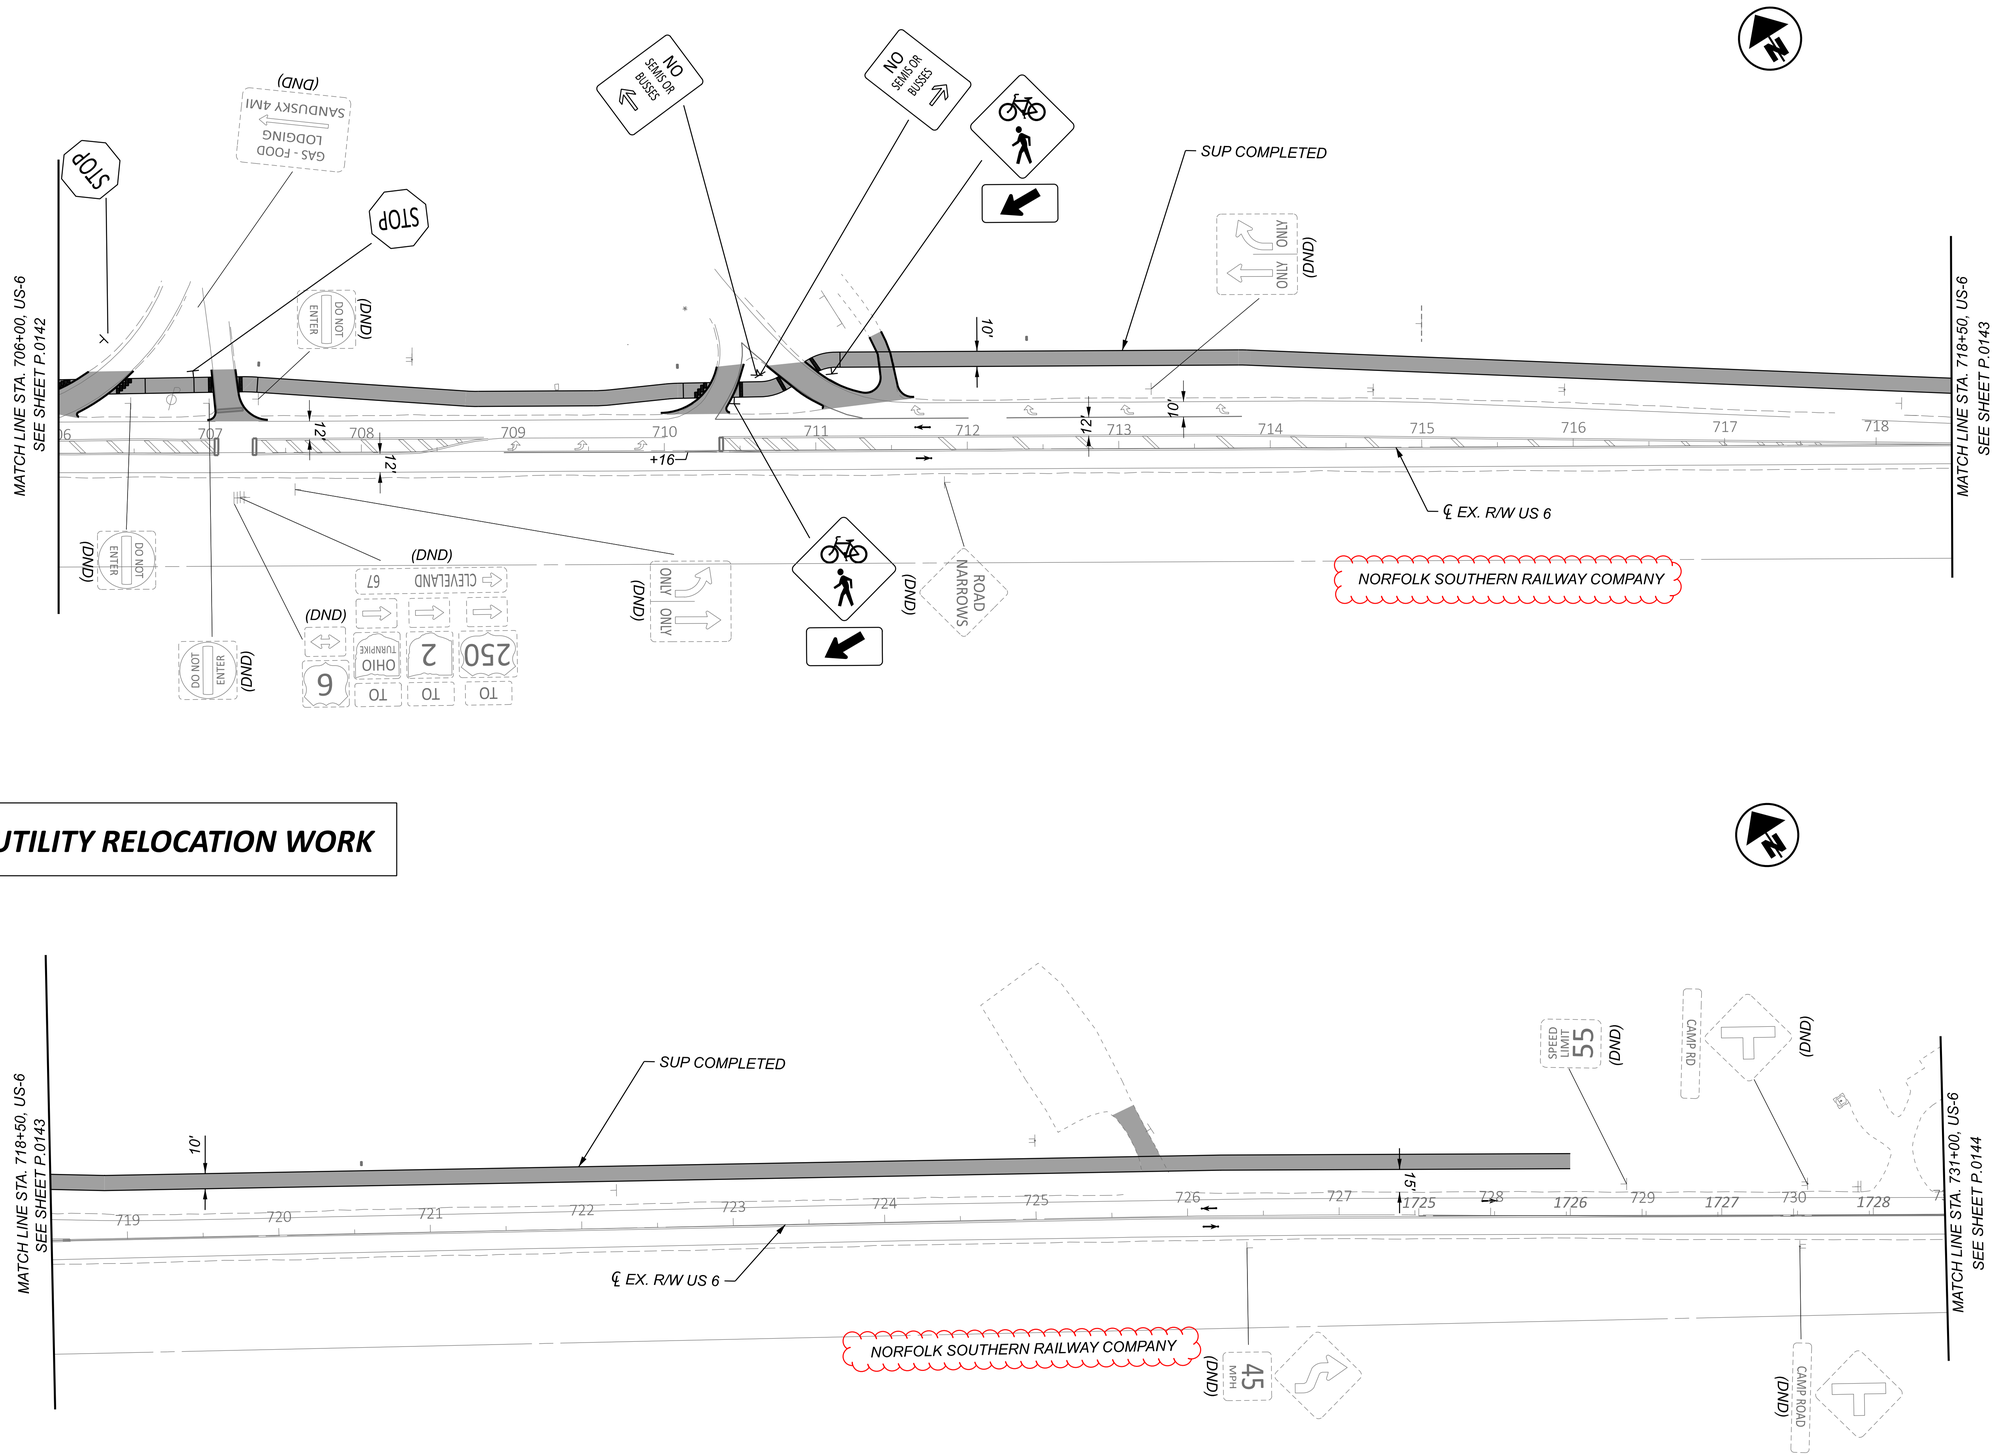

NOTES:

1. FOR MOT LEGEND, SEE SHEET P.0084
2. FOR PROPOSED SIGNING AND MARKING DETAILS, SEE TRAFFIC CONTROL PLANS.
3. MAINTAIN ACCESS TO DRIVES OR SIDE ROADS AT ALL TIMES. USE FLAGGING OPERATION AS NECESSARY.


HORIZONTAL SCALE IN FEET
0 25 50 100

MAINTENANCE OF TRAFFIC - PHASE 1 (2026 CONSTRUCTION)
US 6 - STA. 706+00.00 TO STA. 730+00.00

DESIGN AGENCY
TRANSYSTEMS
400 W. NATIONWIDE BLVD., STE 220
COLUMBUS, OHIO 43215

DESIGNER	SSA
REVIEWER	SS 10/27/25
PROJECT ID	116570
SHEET	P.0144
TOTAL	1106

2026 UTILITY RELOCATION WORK

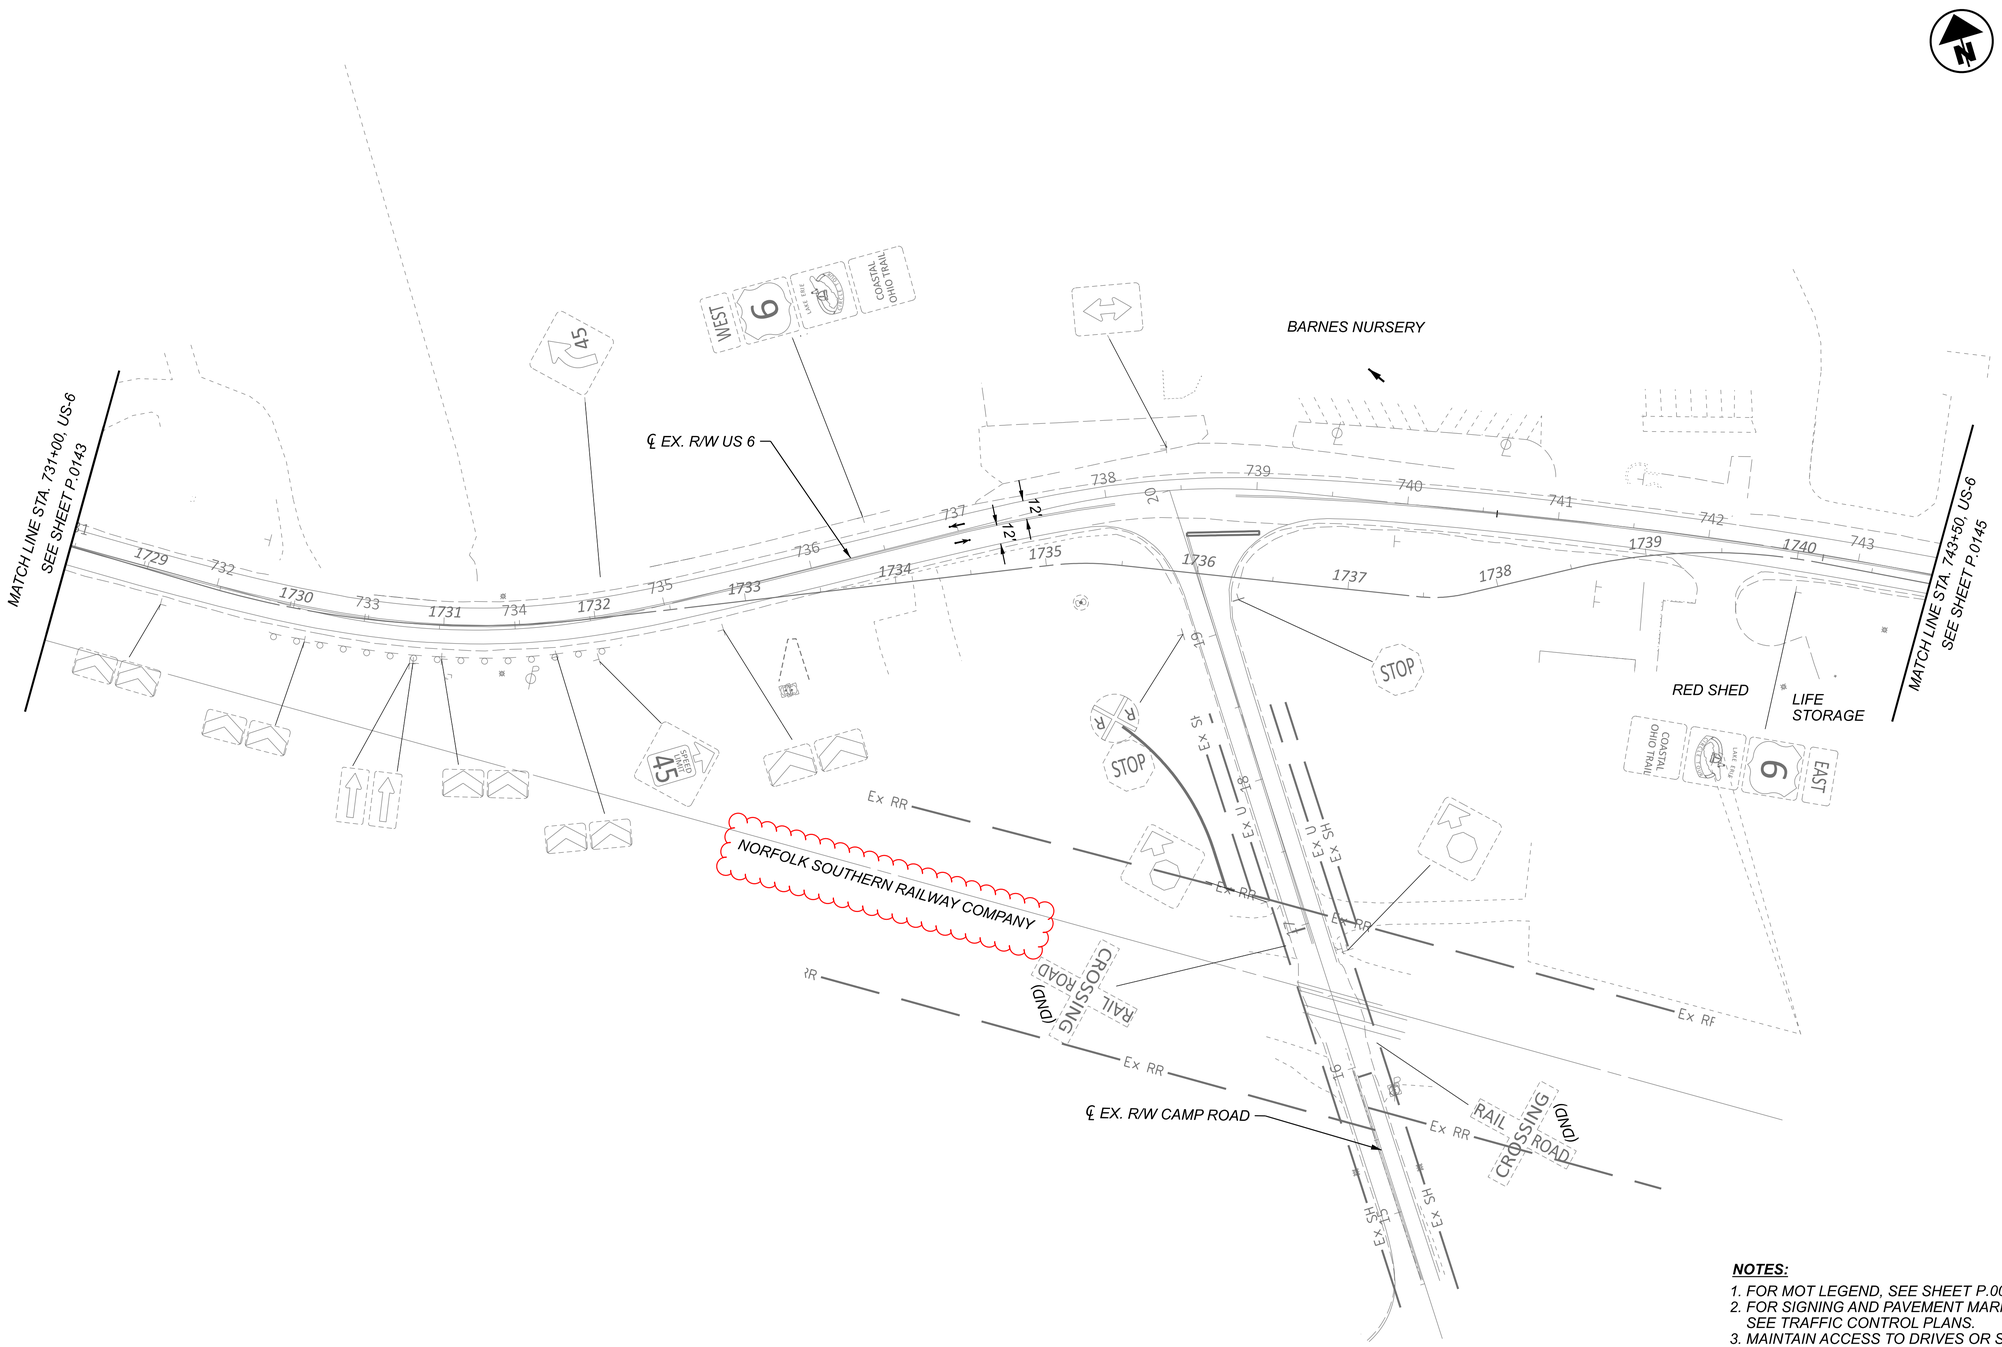

NOTES:

1. *FOR MOT LEGEND, SEE SHEET P.0084.*
2. *FOR SIGNING AND PAVEMENT MARKING DETAILS, SEE TRAFFIC CONTROL PLANS.*
3. *MAINTAIN ACCESS TO DRIVES OR SIDE ROADS AT ALL TIMES. USE FLAGGING OPERATION AS NECESSARY.*

HORIZONTAL SCALE IN FEET
0 25 50 100

MAINTENANCE OF TRAFFIC - PHASE 1 (2026 CONSTRUCTION)
US 6 - STA. 731+00.00 TO STA. 743+50.00


DESIGN AGENCY
TRANSYSTEMS
400 W. NATIONWIDE BLVD., STE 225
COLUMBUS, OHIO 43215

DESIGNER: SSA
REVIEWER: SS 10/27/25
PROJECT ID: 116570
SHEET: P.0145 TOTAL: 1106

ERI-US 0006-CONNECTIVITY CORRIDOR

MODEL: CLP_SUP 2 - Plan 14 [Sheet] PAPERSIZE: 34x22 (in.) DATE: 2/25/2026 TIME: 5:24:25 PM PLTDRV: OHDOT_PDF_Levels.pltcfg PENTBL: OHDOT_Pen.tbl USER: hrthornton@gfginc.com WORKSPACE: OHDOTCEv02 WORKSET: 116570 PRODUCT: OpenRoadsDesigner 24.00.02.25
pw:\\ohiodot-pw.bentley.com:ohiodot-pw-02\Documents\01 Active Projects\District 03\Erie\116570\402-Engineering_TranSystems\MOT\Sheets\116570_MP001_CY2026.dgn

MODEL: CLP_SUP 2 - Plan 21 [Sheet] PAPERSIZE: 34x22 (in.) DATE: 2/25/2026 TIME: 5:30:54 PM PLTDRV: OHDOT_PDF_Levels.pltcfg PENTBL: OHDOT_Pen.tbl USER: hrthornton@gftinc.com WORKSPACE: OHDOTCEv02 WORKSET: 116570 PRODUCT: OpenRoadsDesigner 24.00.02.25
pw:\\ohiodot-pw.bentley.com:ohiodot-pw-02\Documents\01 Active Projects\District 03\Erie\116570\402-Engineering_TranSystems\MOT\Sheets\116570_MP002a_CY_Winter 26_27.dgn

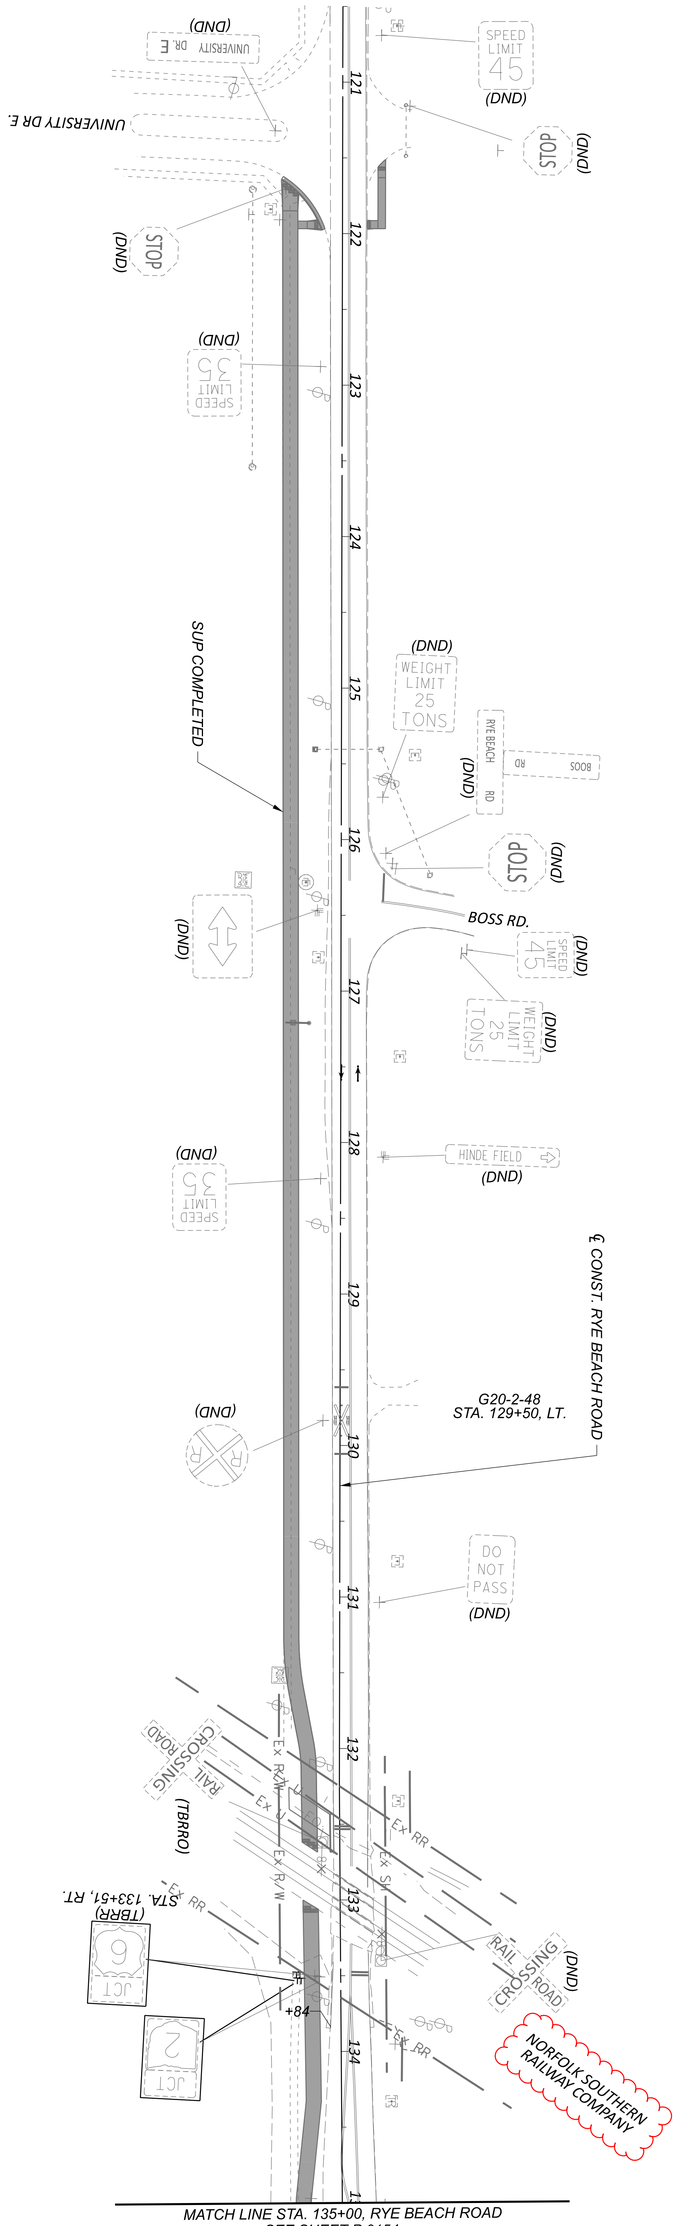

NOTES:

1. FOR MOT LEGEND, SEE SHEET P.0084.


SHEET	TOTAL	PROJECT ID	REVIEWER	DESIGNER	DESIGN AGENCY
P 0153	1106	116570	SS 10/27/25	SSA	TRANSYSTEMS 400 W. NATIONWIDE BLVD., STE 220 COLUMBUS, OHIO 43215

MAINTENANCE OF TRAFFIC - PHASE 2A (WINTER 2026 CONSTRUCTION)
RYE BEACH ROAD - BEGIN PROJECT TO STA. 135+00.00

HORIZONTAL SCALE IN FEET
0 50
25 100

ERI-US 0006-CONNECTIVITY CORRIDOR

MODEL: CLP_SUP 1 - Plan 1-2 [Sheet] PAPERSIZE: 34x22 (in.) DATE: 2/25/2026 TIME: 5:37:21 PM PLTDRV: OHDOT_PDF_Levels.pltcfg PENTBL: OHDOT_Pen.tbl USER: hrthornton@gftinc.com WORKSPACE: OHDOTCEv02 WORKSET: 116570 PRODUCT: OpenRoadsDesigner 24.00.02.25
pw:\\ohiodot-pw.bentley.com:ohiodot-pw-02\Documents\01 Active Projects\District 03\Erie\116570\402-Engineering_TranSystems\MOT\Sheets\116570_MP002_CY2026.dgn

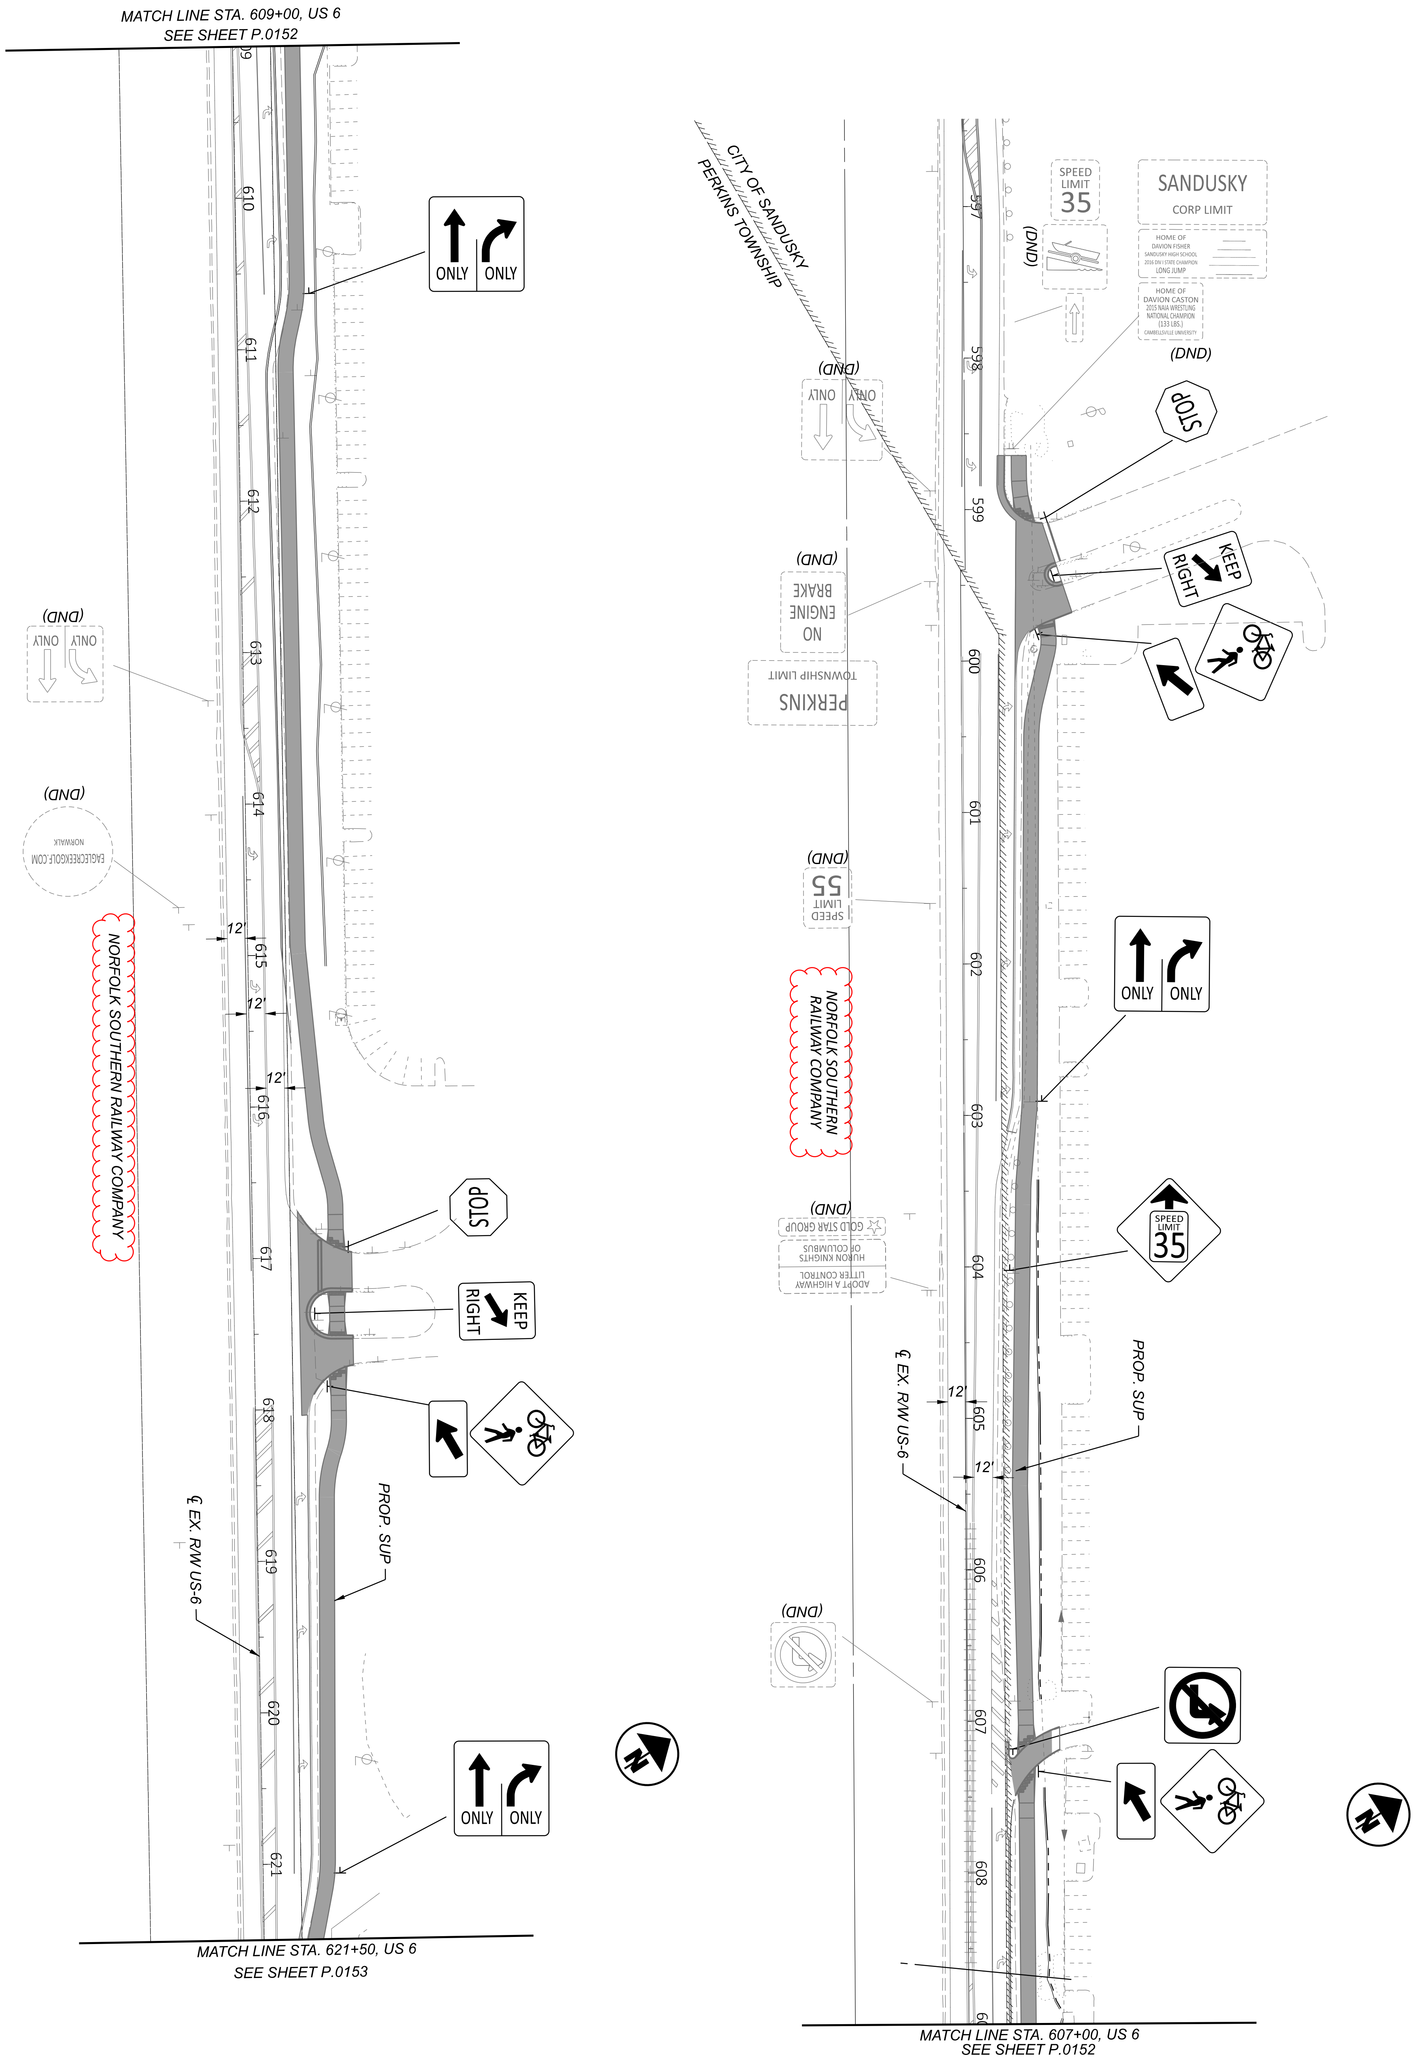

NOTES:

1. FOR MOT LEGEND, SEE SHEET P.0084.

SHEET	TOTAL
P.0157	1106

PROJECT ID	REVIEWER
116570	SS 10/27/25


DESIGNER: SSA


DESIGN AGENCY
TRANSYSTEMS
400 W. NATIONWIDE BLVD., STE 220
COLUMBUS, OHIO 43215

MAINTENANCE OF TRAFFIC - PHASE 2 (2026 CONSTRUCTION)
US 6 - BEGIN PROJECT TO STA. 621+50

HORIZONTAL SCALE IN FEET
0 50
25 100

MODEL: CLP_SUP 1 - Plan 3-4 [Sheet] PAPERSIZE: 34x22 (in.) DATE: 2/25/2026 TIME: 5:41:58 PM PLTDRV: OHDOT_PDF_Levels.pltcfg PENTBL: OHDOT_Pen.tbl USER: hrthornton@gftinc.com WORKSPACE: OHDOTCEv02 WORKSET: 116570 PRODUCT: OpenRoadsDesigner 24.00.02.25
pw:\\ohiodot-pw.bentley.com:ohiodot-pw-02\Documents\01 Active Projects\District 03\Erie\116570\402-Engineering_TranSystems\MOT\Sheets\116570_MP002_CY2026.dgn

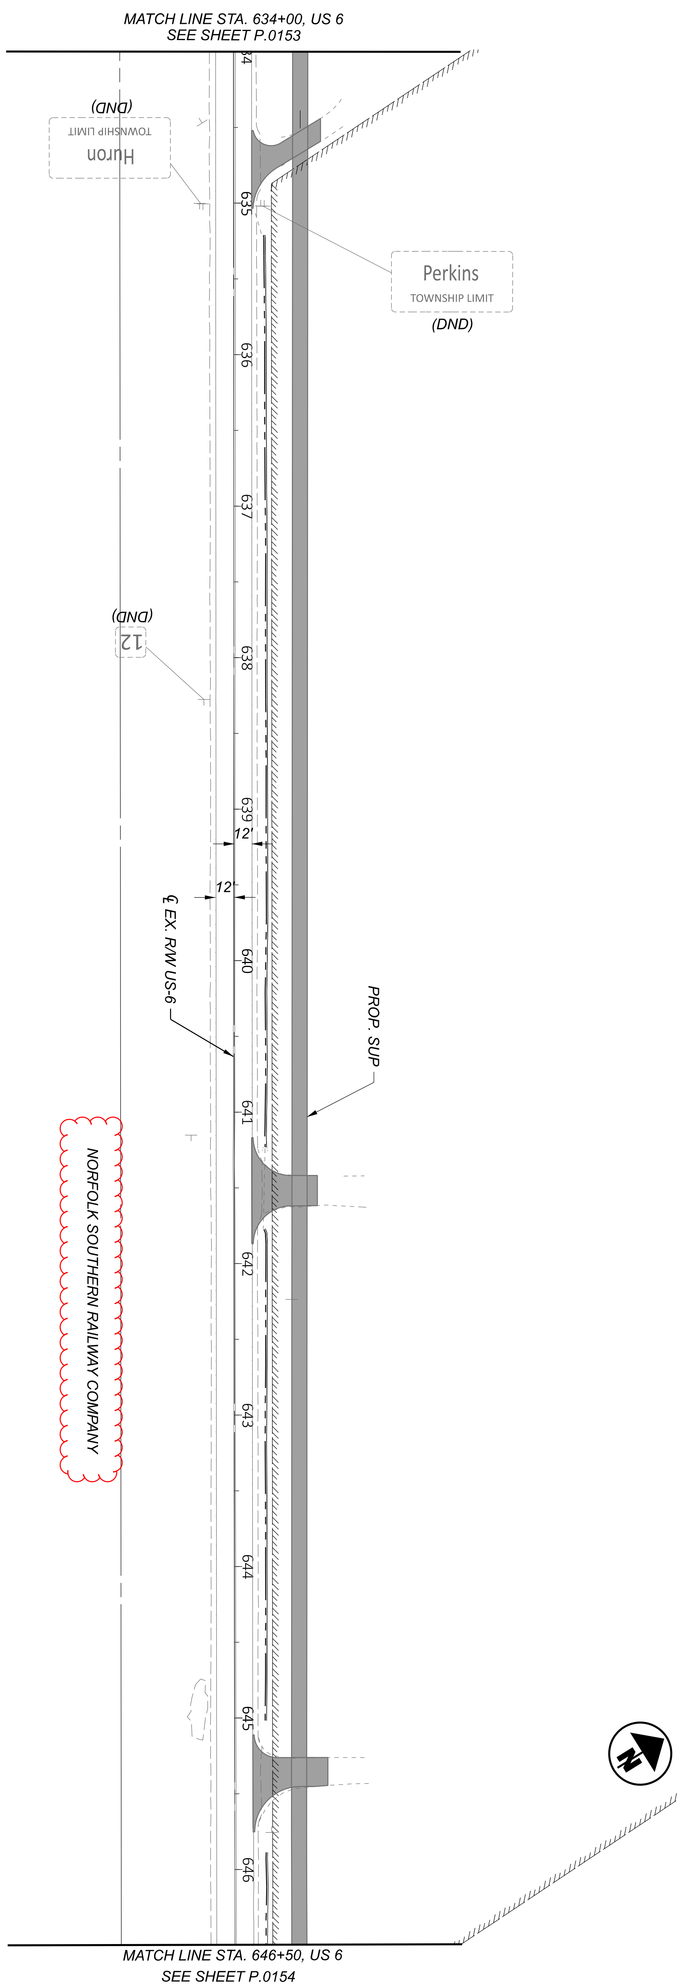

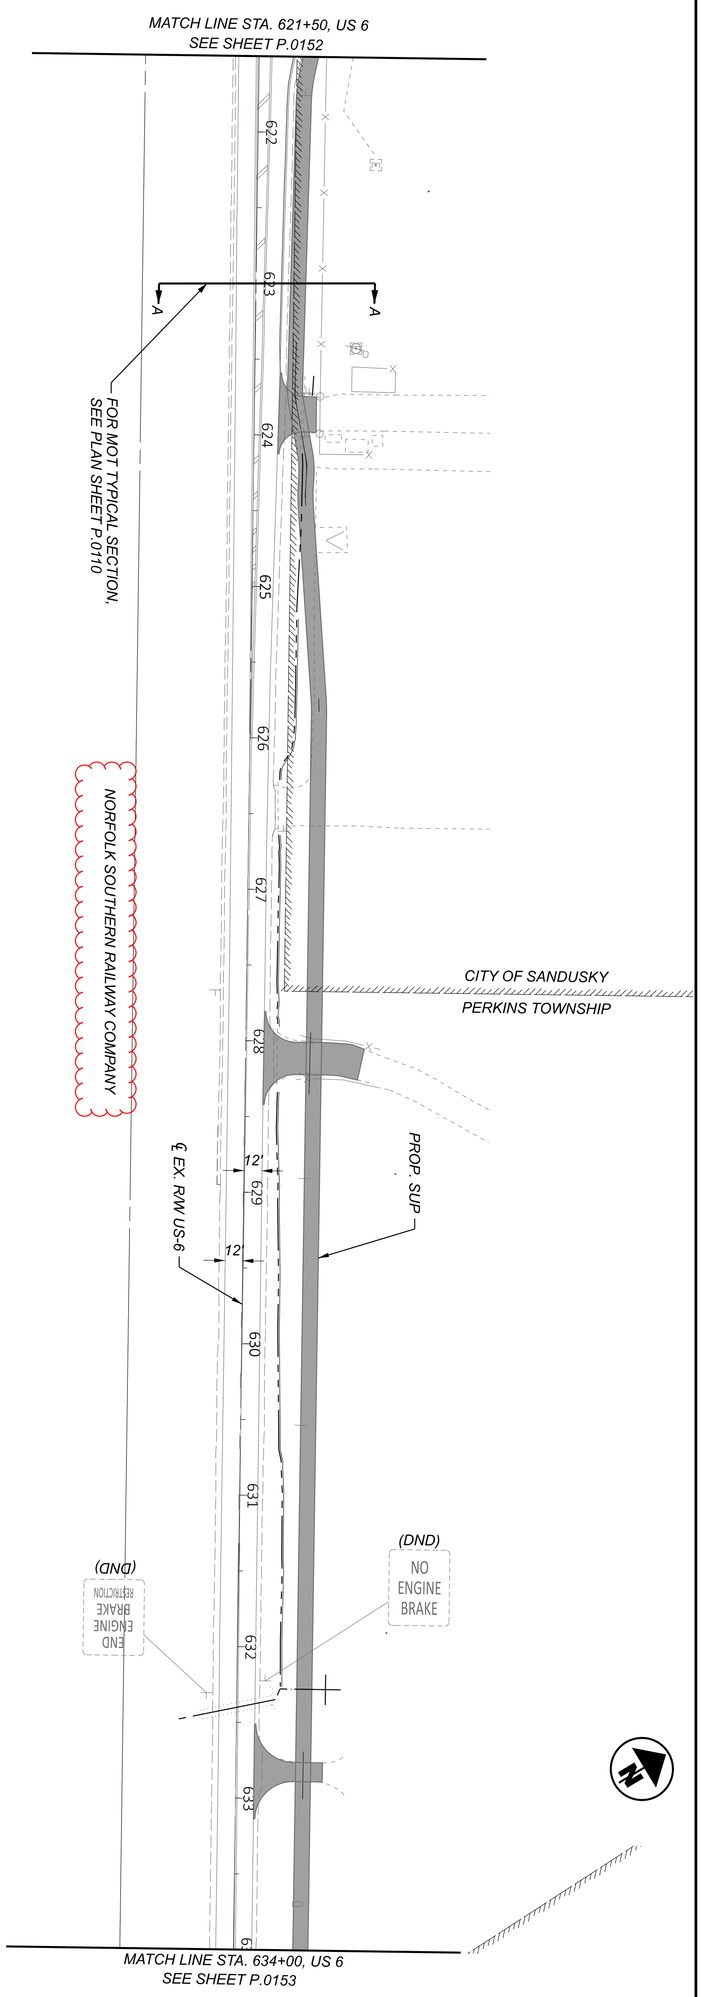

NOTES:


1. FOR MOT LEGEND, SEE SHEET P.0004.

SHEET P.0158	TOTAL 1106	PROJECT ID 116570	REVIEWER SS 10/27/25	DESIGNER SSA	DESIGN AGENCY TRANSYSTEMS 400 W. NATIONWIDE BLVD., STE 220 COLUMBUS, OHIO 43215

MAINTENANCE OF TRAFFIC - PHASE 2 (2026 CONSTRUCTION)
US 6 - STA. 621+50.00 TO STA. 646+50.00

HORIZONTAL SCALE IN FEET
0 50
25 100

MODEL: CLP_SUP 1 - Plan 5-6 [Sheet] PAPERSIZE: 34x22 (in.) DATE: 2/25/2026 TIME: 5:44:34 PM PLTDRV: OHDOT_PDF_Levels.pltcfg PENTBL: OHDOT_Pen.tbl USER: hrthornton@gftinc.com WORKSPACE: OHDOTCEv02 WORKSET: 116570 PRODUCT: OpenRoadsDesigner 24.00.02.25
pw:\\ohiodot-pw.bentley.com:ohiodot-pw-02\Documents\01 Active Projects\District 03\Erie\116570\402-Engineering_TranSystems\MOT\Sheets\116570_MP002_CY2026.dgn

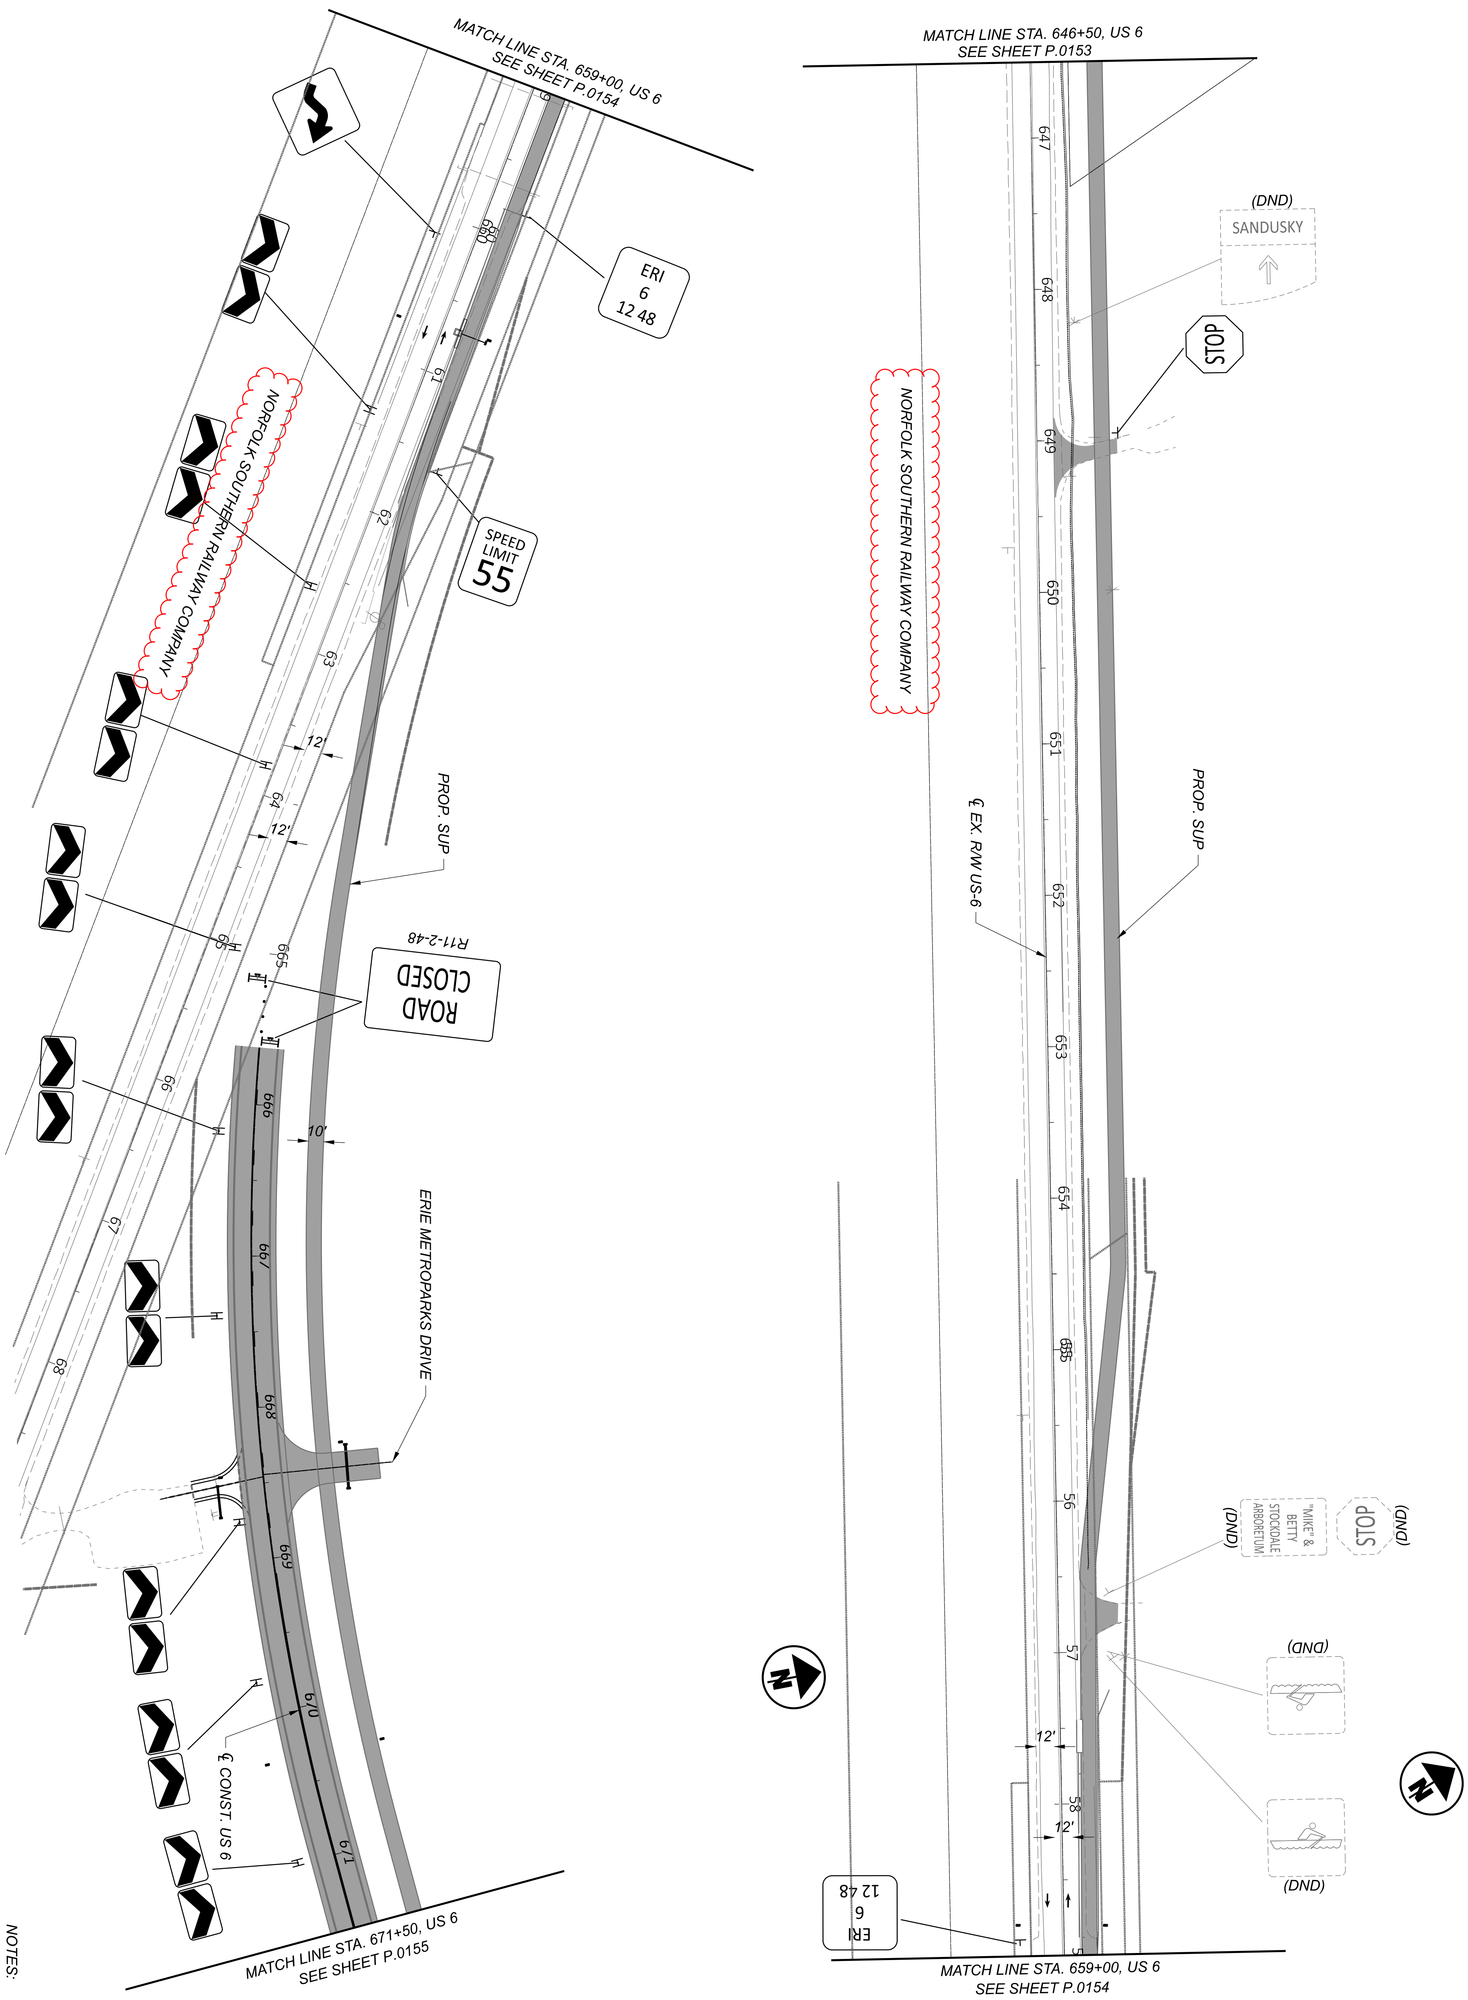

NOTES:

1. FOR MOT LEGEND, SEE SHEET P.0084.

SHEET	TOTAL
P.0159	1106

PROJECT ID	REVIEWER
116570	SS 10/27/25


DESIGNER: SSA

TRANSYSTEMS
400 W. NATIONWIDE BLVD., STE 220
COLUMBUS, OHIO 43215
DESIGN AGENCY

MAINTENANCE OF TRAFFIC - PHASE 2 (2026 CONSTRUCTION)
US 6 - STA. 646+50.00 TO STA. 671+50.00

HORIZONTAL SCALE IN FEET
0 50
25 100

MODEL: CLP_SUP 1 - Plan 9-10 [Sheet] PAPERSIZE: 34x22 (in.) DATE: 2/25/2026 TIME: 5:47:41 PM PLTDRV: OHDOT_PDF_Levels.pltcfg PENTBL: OHDOT_Pen.tbl USER: hrthornton@gftinc.com WORKSPACE: OHDOTCEv02 WORKSET: 116570 PRODUCT: OpenRoadsDesigner 24.00.02.25
pw:\\ohiodot-pw.bentley.com:ohiodot-pw-02\Documents\01 Active Projects\District 03\Erie\116570\402-Engineering_TranSystems\MOT\Sheets\116570_MP002_CY2026.dgn

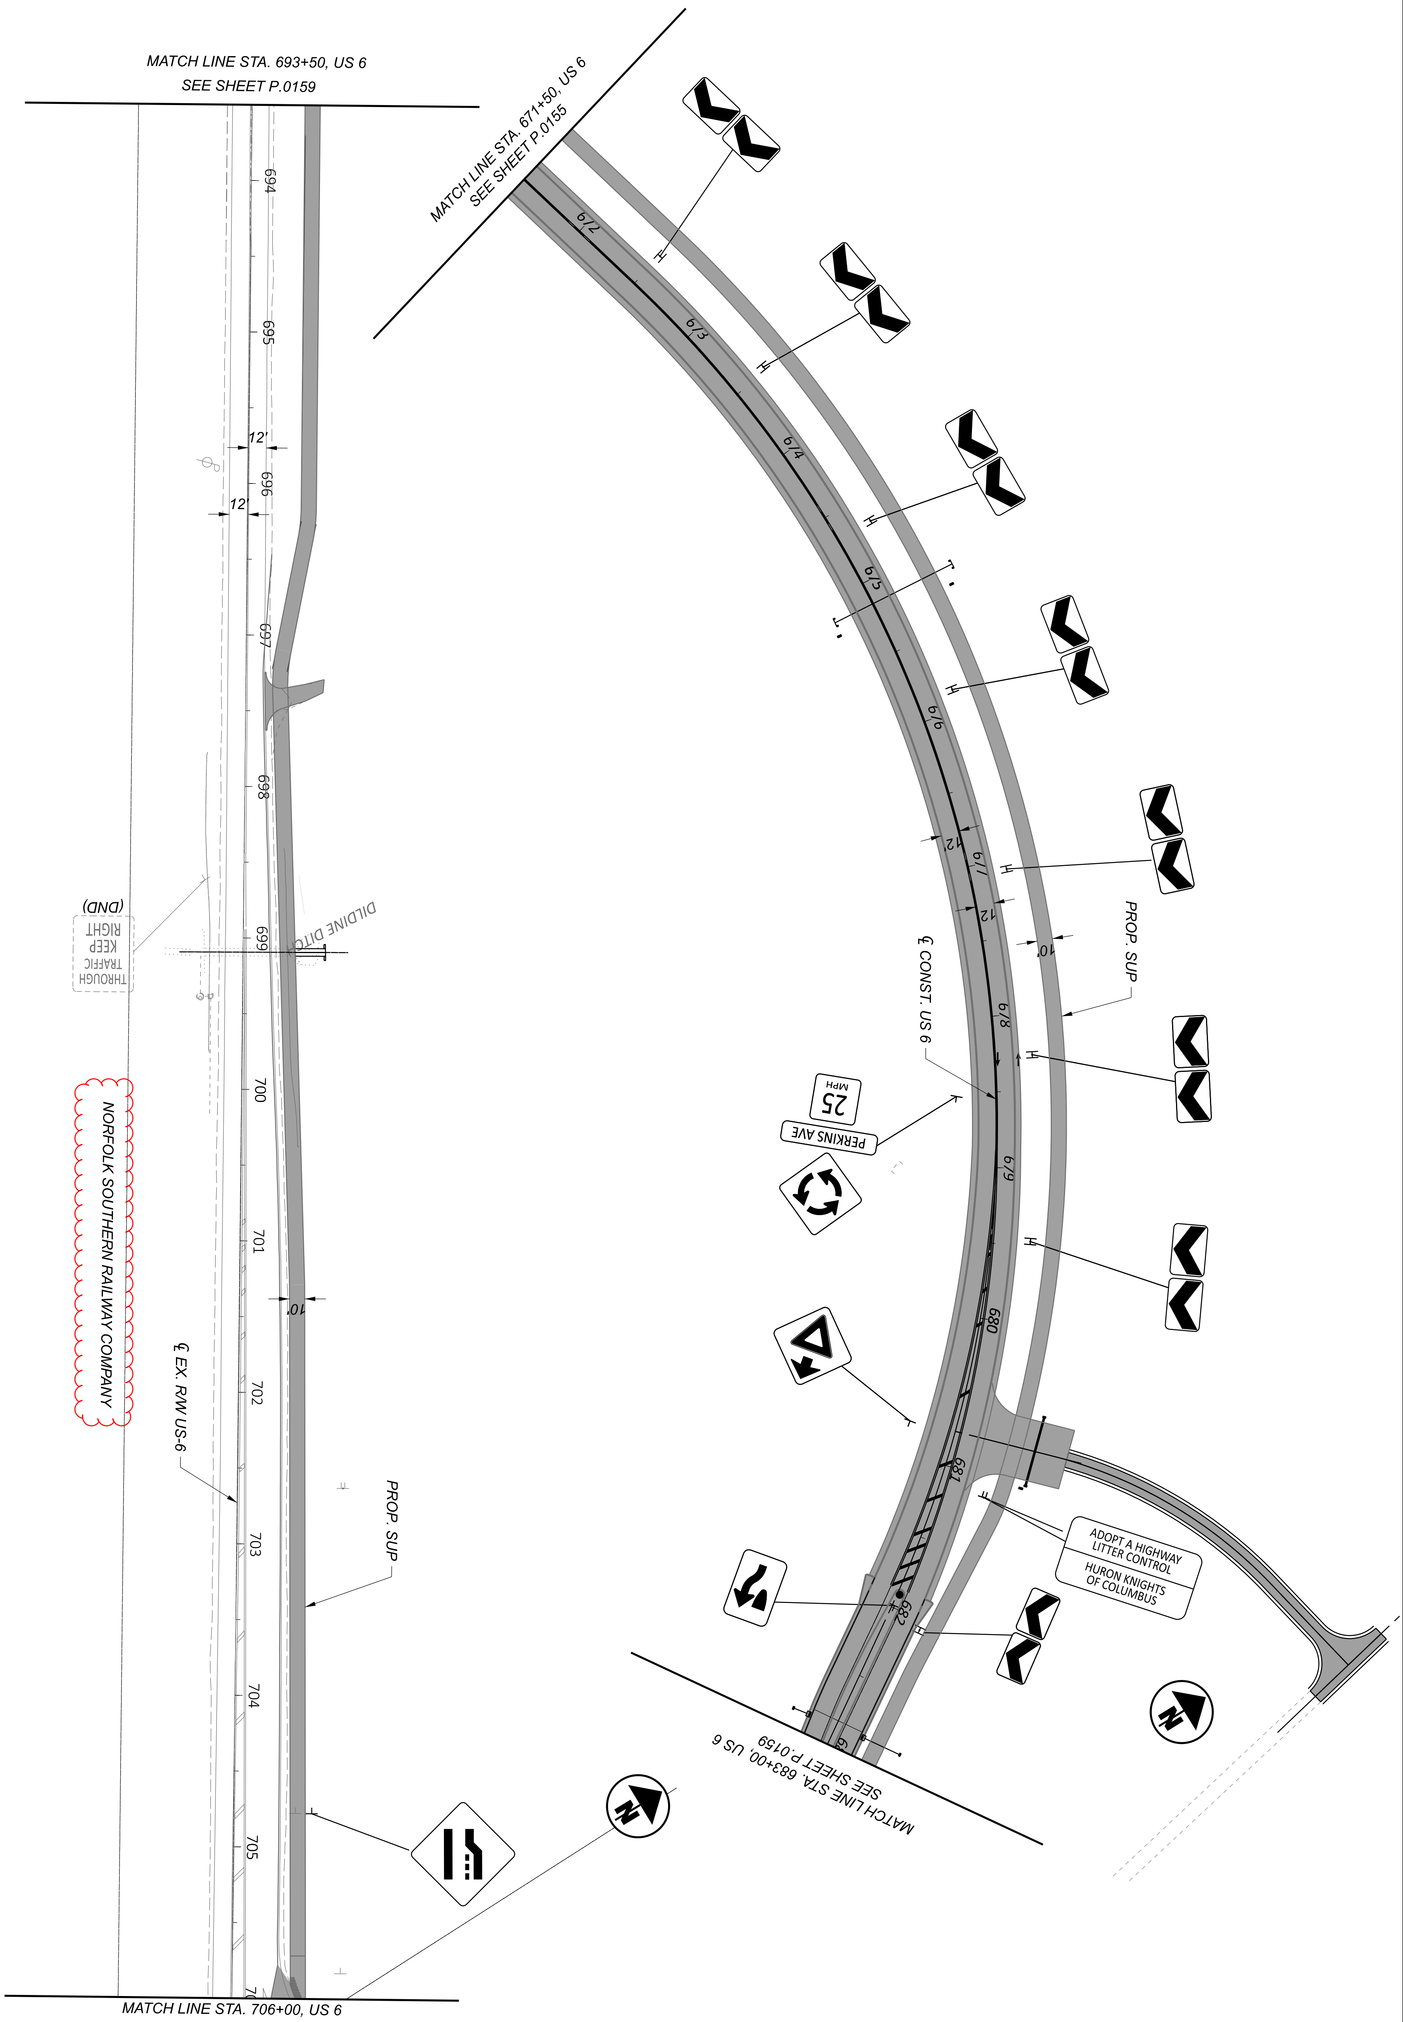

NOTES:

1. FOR MOT LEGEND, SEE SHEET P.0084.

SHEET	TOTAL
P 0161	1106

PROJECT ID: 116570

REVIEWER: SS 10/27/25


DESIGNER: SSA

DESIGN AGENCY: TRANSYSTEMS
400 W. NATIONWIDE BLVD., STE 220
COLUMBUS, OHIO 43215

MAINTENANCE OF TRAFFIC - PHASE 2 (2026 CONSTRUCTION)
US 6 - STA. 671+50.00 TO STA. 706+00.00

HORIZONTAL SCALE IN FEET
0 50
25 100

MODEL: CLP_SUP 2 - Plan 11 [Sheet] PAPERSIZE: 34x22 (in.) DATE: 2/25/2026 TIME: 5:50:37 PM PLTDRV: OHDOT_PDF_Levels.pltcfg PENTBL: OHDOT_Pen.tbl USER: hrthornton@gftinc.com WORKSPACE: OHDOTCEv02 WORKSET: 116570 PRODUCT: OpenRoadsDesigner 24.00.02.25
pw:\\ohiodot-pw.bentley.com:ohiodot-pw-02\Documents\01 Active Projects\District 03\Erie\116570\402-Engineering_TranSystems\MOT\Sheets\116570_MP002_CY2026.dgn

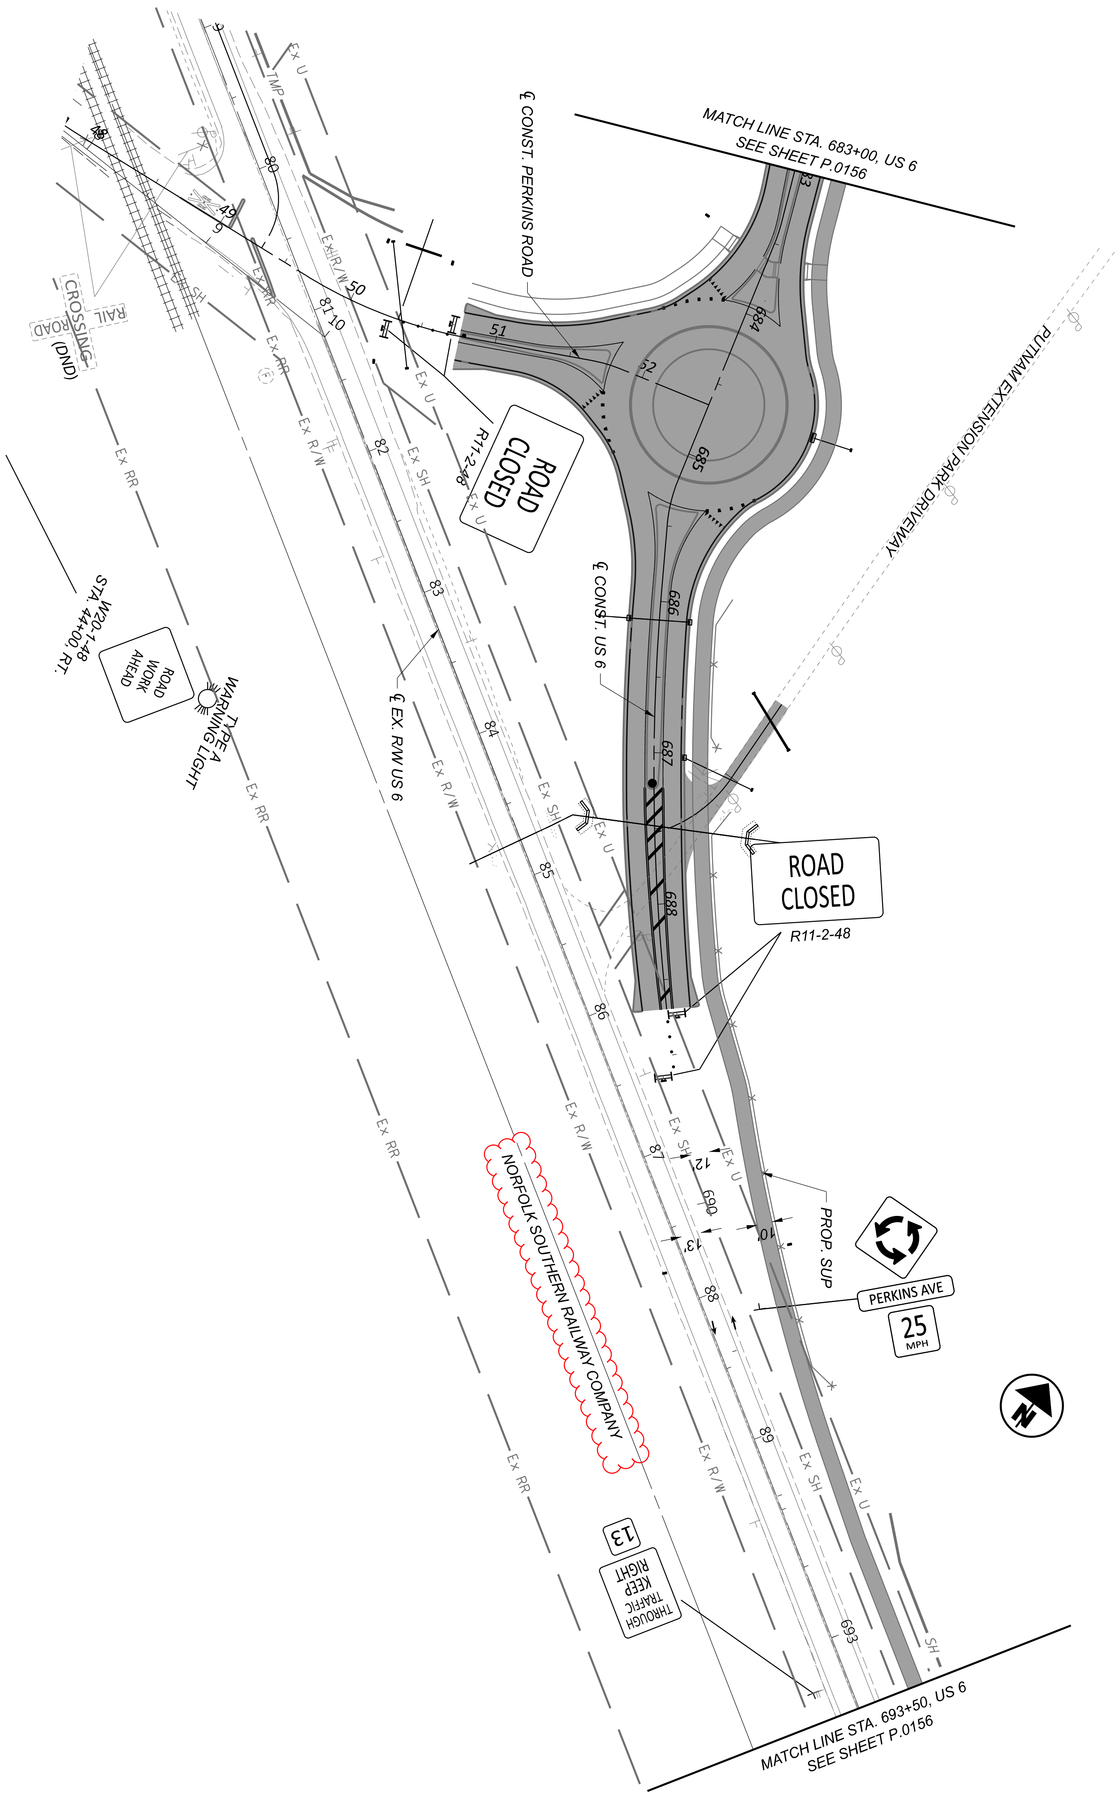

NOTES:

1. FOR MOT LEGEND, SEE SHEET P.0084.

SHEET	TOTAL
P.0162	1106

PROJECT ID	REVIEWER
116570	SS 10/27/25

DESIGNER: SSA


DESIGN AGENCY
TRANSYSTEMS
400 W. NATIONWIDE BLVD., STE 220
COLUMBUS, OHIO 43215

MAINTENANCE OF TRAFFIC - PHASE 2 (2026 CONSTRUCTION)
US 6 - STA. 683+00.00 TO STA. 693+50.00


HORIZONTAL SCALE IN FEET
0 50
25 100

MODEL: CLP_SUP 1 - Plan 12-13 [Sheet] PAPERSIZE: 34x22 (in.) DATE: 2/25/2026 TIME: 5:53:45 PM PLTDRV: OHDOT_PDF_Levels.pltcfg PENTBL: OHDOT_Pen.tbl USER: hrthornton@gftinc.com WORKSPACE: OHDOTCEv02 WORKSET: 116570 PRODUCT: OpenRoadsDesigner 24.00.02.25
pw:\\ohiodot-pw.bentley.com:ohiodot-pw-02\Documents\01 Active Projects\District 03\Erie\116570\402-Engineering_TranSystems\MOT\Sheets\116570_MP002_CY2026.dgn

ERI-US 0006-CONNECTIVITY CORRIDOR

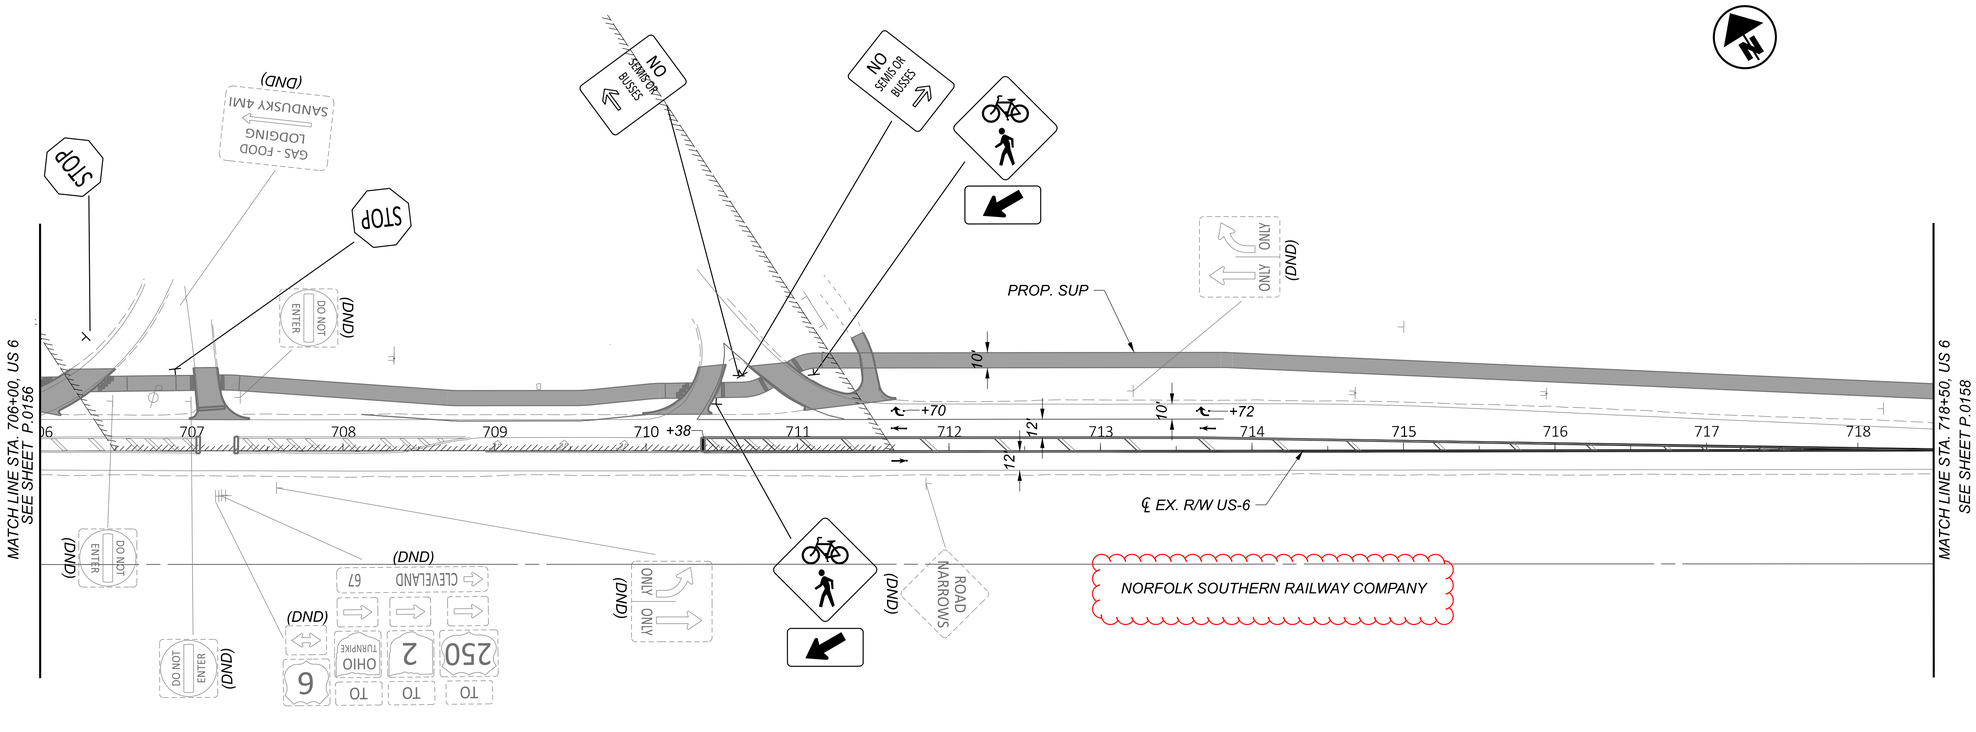

2026 UTILITY RELOCATION WORK

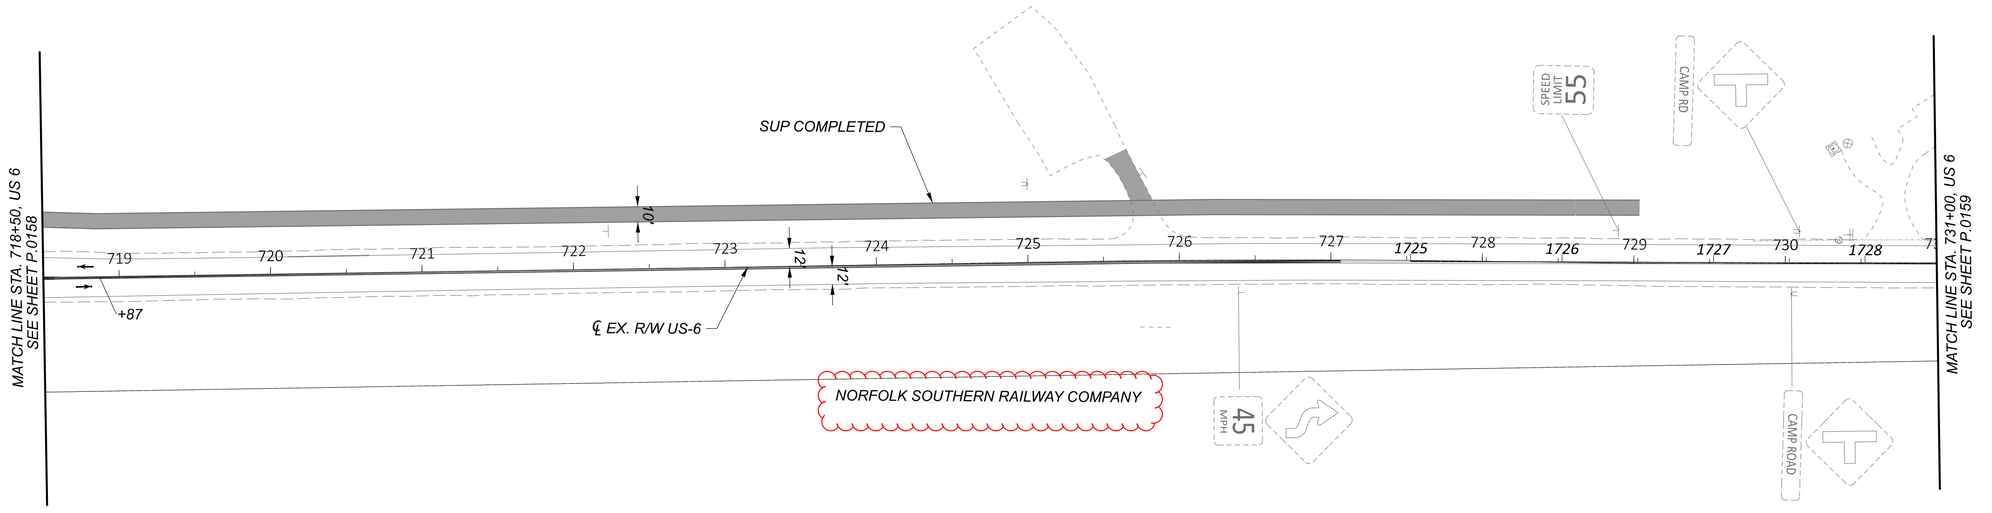

NOTES:

1. FOR MOT LEGEND, SEE SHEET P.0084.

HORIZONTAL SCALE IN FEET
0 25 50 100

MAINTENANCE OF TRAFFIC - PHASE 2 (2026 CONSTRUCTION)


DESIGN AGENCY
TRANSYSTEMS
400 W. NATIONWIDE BLVD., STE 225
COLUMBUS, OHIO 43215

DESIGNER: SSA
REVIEWER: SS 10/27/25
PROJECT ID: 116570
SHEET: P.0163 TOTAL: 1106

MODEL: CLP_SUP 2 - Plan 14 [Sheet] PAPERSIZE: 34x22 (in.) DATE: 2/25/2026 TIME: 5:57:01 PM PLTDRV: OHDOT_PDF_Levels.pltcfg PENTBL: OHDOT_Pen.tbl USER: hrthornton@gfginc.com WORKSPACE: OHDOTCEv02 WORKSET: 116570 PRODUCT: OpenRoadsDesigner 24.00.02.25
pw:\\ohiodot-pw.bentley.com:ohiodot-pw-02\Documents\01 Active Projects\District 03\Erie\116570\402 Engineering_TranSystems\MOT\Sheets\116570_MP002_CY2026.dgn

ERI-US 0006-CONNECTIVITY CORRIDOR

2026 UTILITY RELOCATION WORK

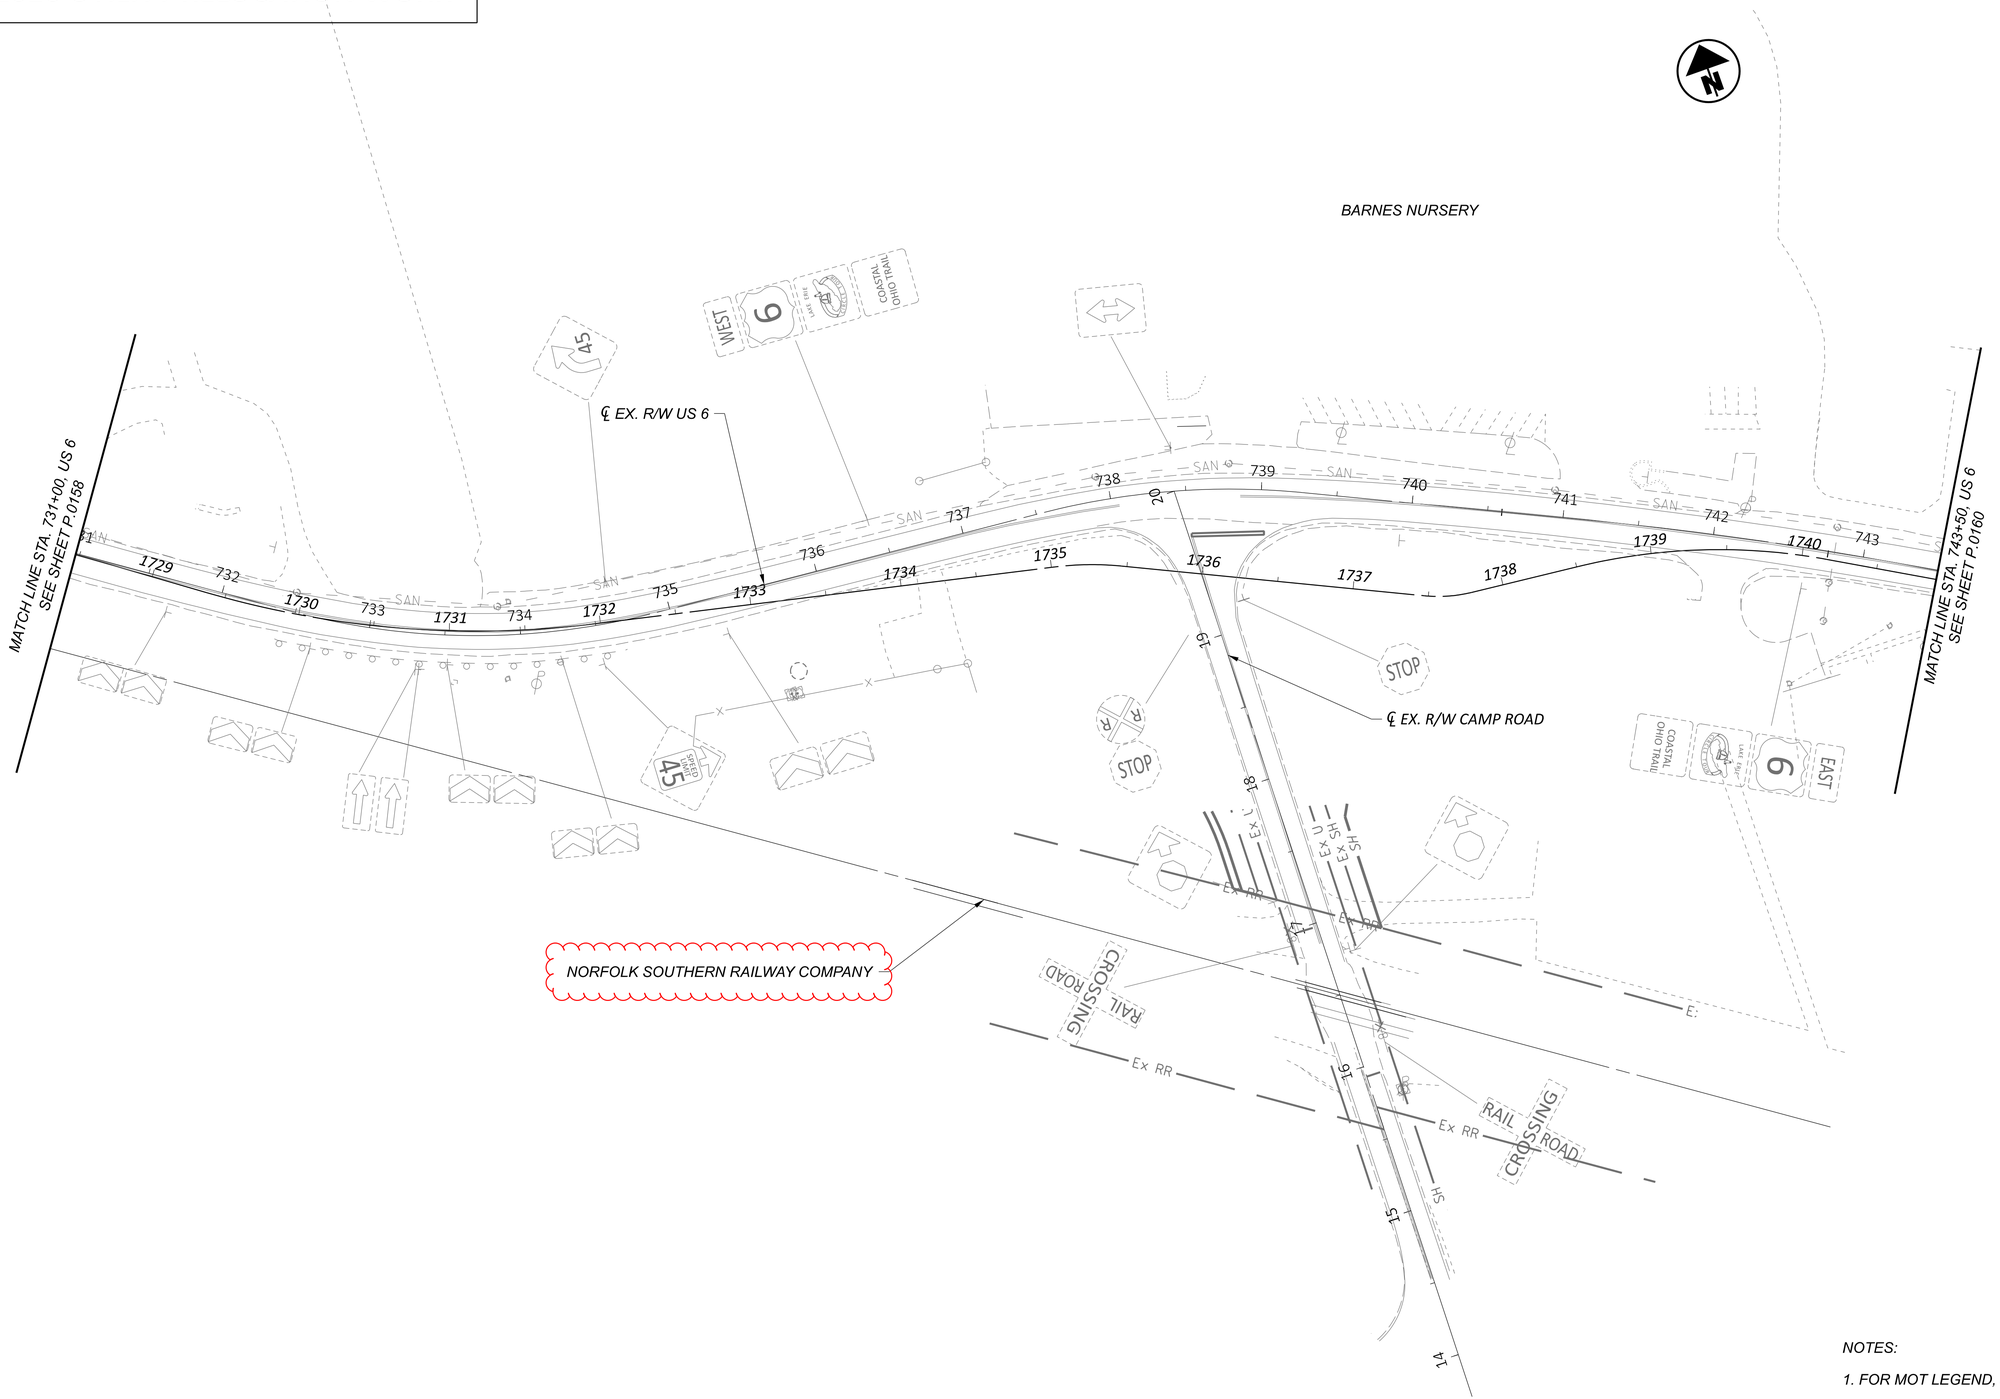

NOTES:

1. FOR MOT LEGEND, SEE SHEET P.0084.


HORIZONTAL SCALE IN FEET
0 25 50 100

MAINTENANCE OF TRAFFIC - PHASE 2 (2026 CONSTRUCTION)
US 6 - STA. 731+00.00 TO STA. 743+50.00

DESIGN AGENCY
TRANSYSTEMS
400 W. NATIONWIDE BLVD., STE 225
COLUMBUS, OHIO 43215

DESIGNER: SSA
REVIEWER: SS 10/27/25
PROJECT ID: 116570
SHEET: P.0164 TOTAL: 1106

MODEL: CLP_SUP 2 - Plan 21 [Sheet] PAPERSIZE: 34x22 (in.) DATE: 2/25/2026 TIME: 5:59:39 PM PLTDRV: OHDOT_PDF_Levels.pltcfg PENTBL: OHDOT_Pen.tbl USER: hrthornton@gftinc.com WORKSPACE: OHDOTCEv02 WORKSET: 116570 PRODUCT: OpenRoadsDesigner 24.00.02.25
pw:\\ohiodot-pw.bentley.com:ohiodot-pw-02\Documents\01 Active Projects\District 03\Erie\116570\402-Engineering_TranSystems\MOT\Sheets\116570_MP002_CY2026.dgn

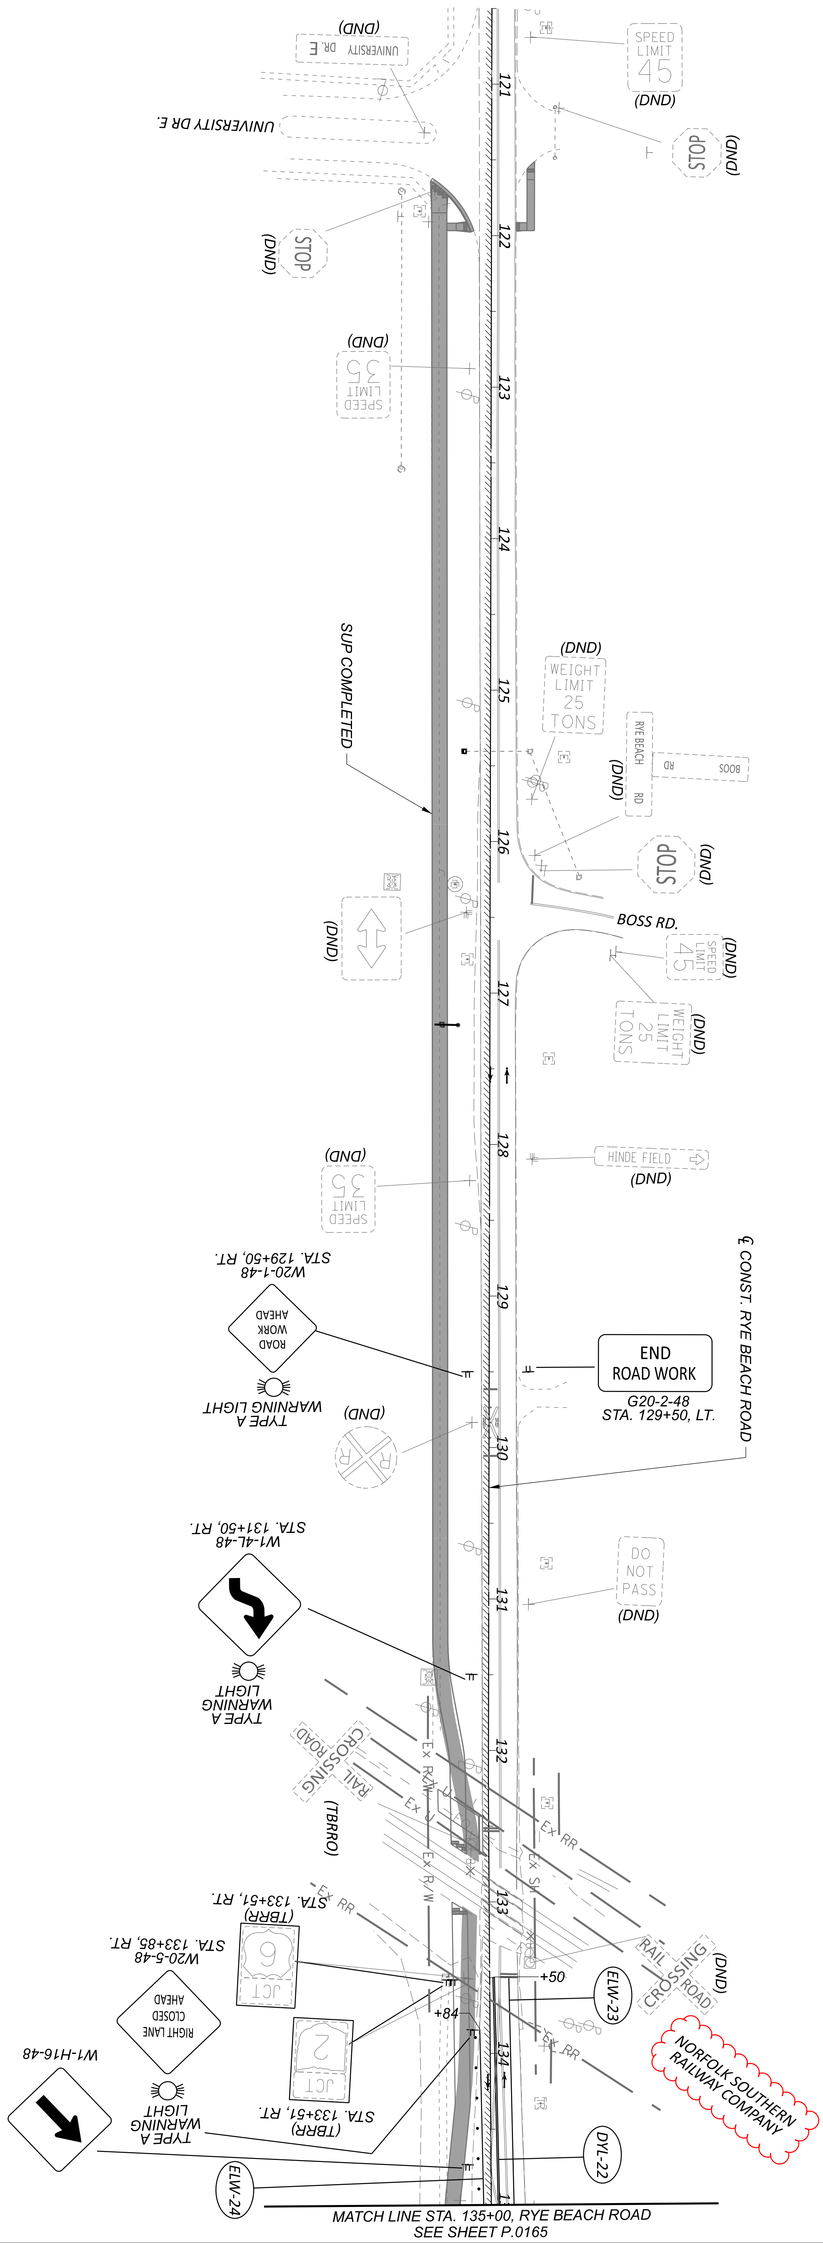

NOTES:

1. FOR MOT LEGEND, SEE SHEET P.0084.

SHEET	TOTAL
P 0169	1106


PROJECT ID	REVIEWER
116570	SS 10/27/25

DESIGNER: SSA

TRANSYSTEMS
400 W. NATIONWIDE BLVD., STE 220
COLUMBUS, OHIO 43215
DESIGN AGENCY

MAINTENANCE OF TRAFFIC - PHASE 2 (2026 CONSTRUCTION)
RYE BEACH ROAD - BEGIN PROJECT TO STA. 135+00.00

HORIZONTAL SCALE IN FEET
0 50
25 100

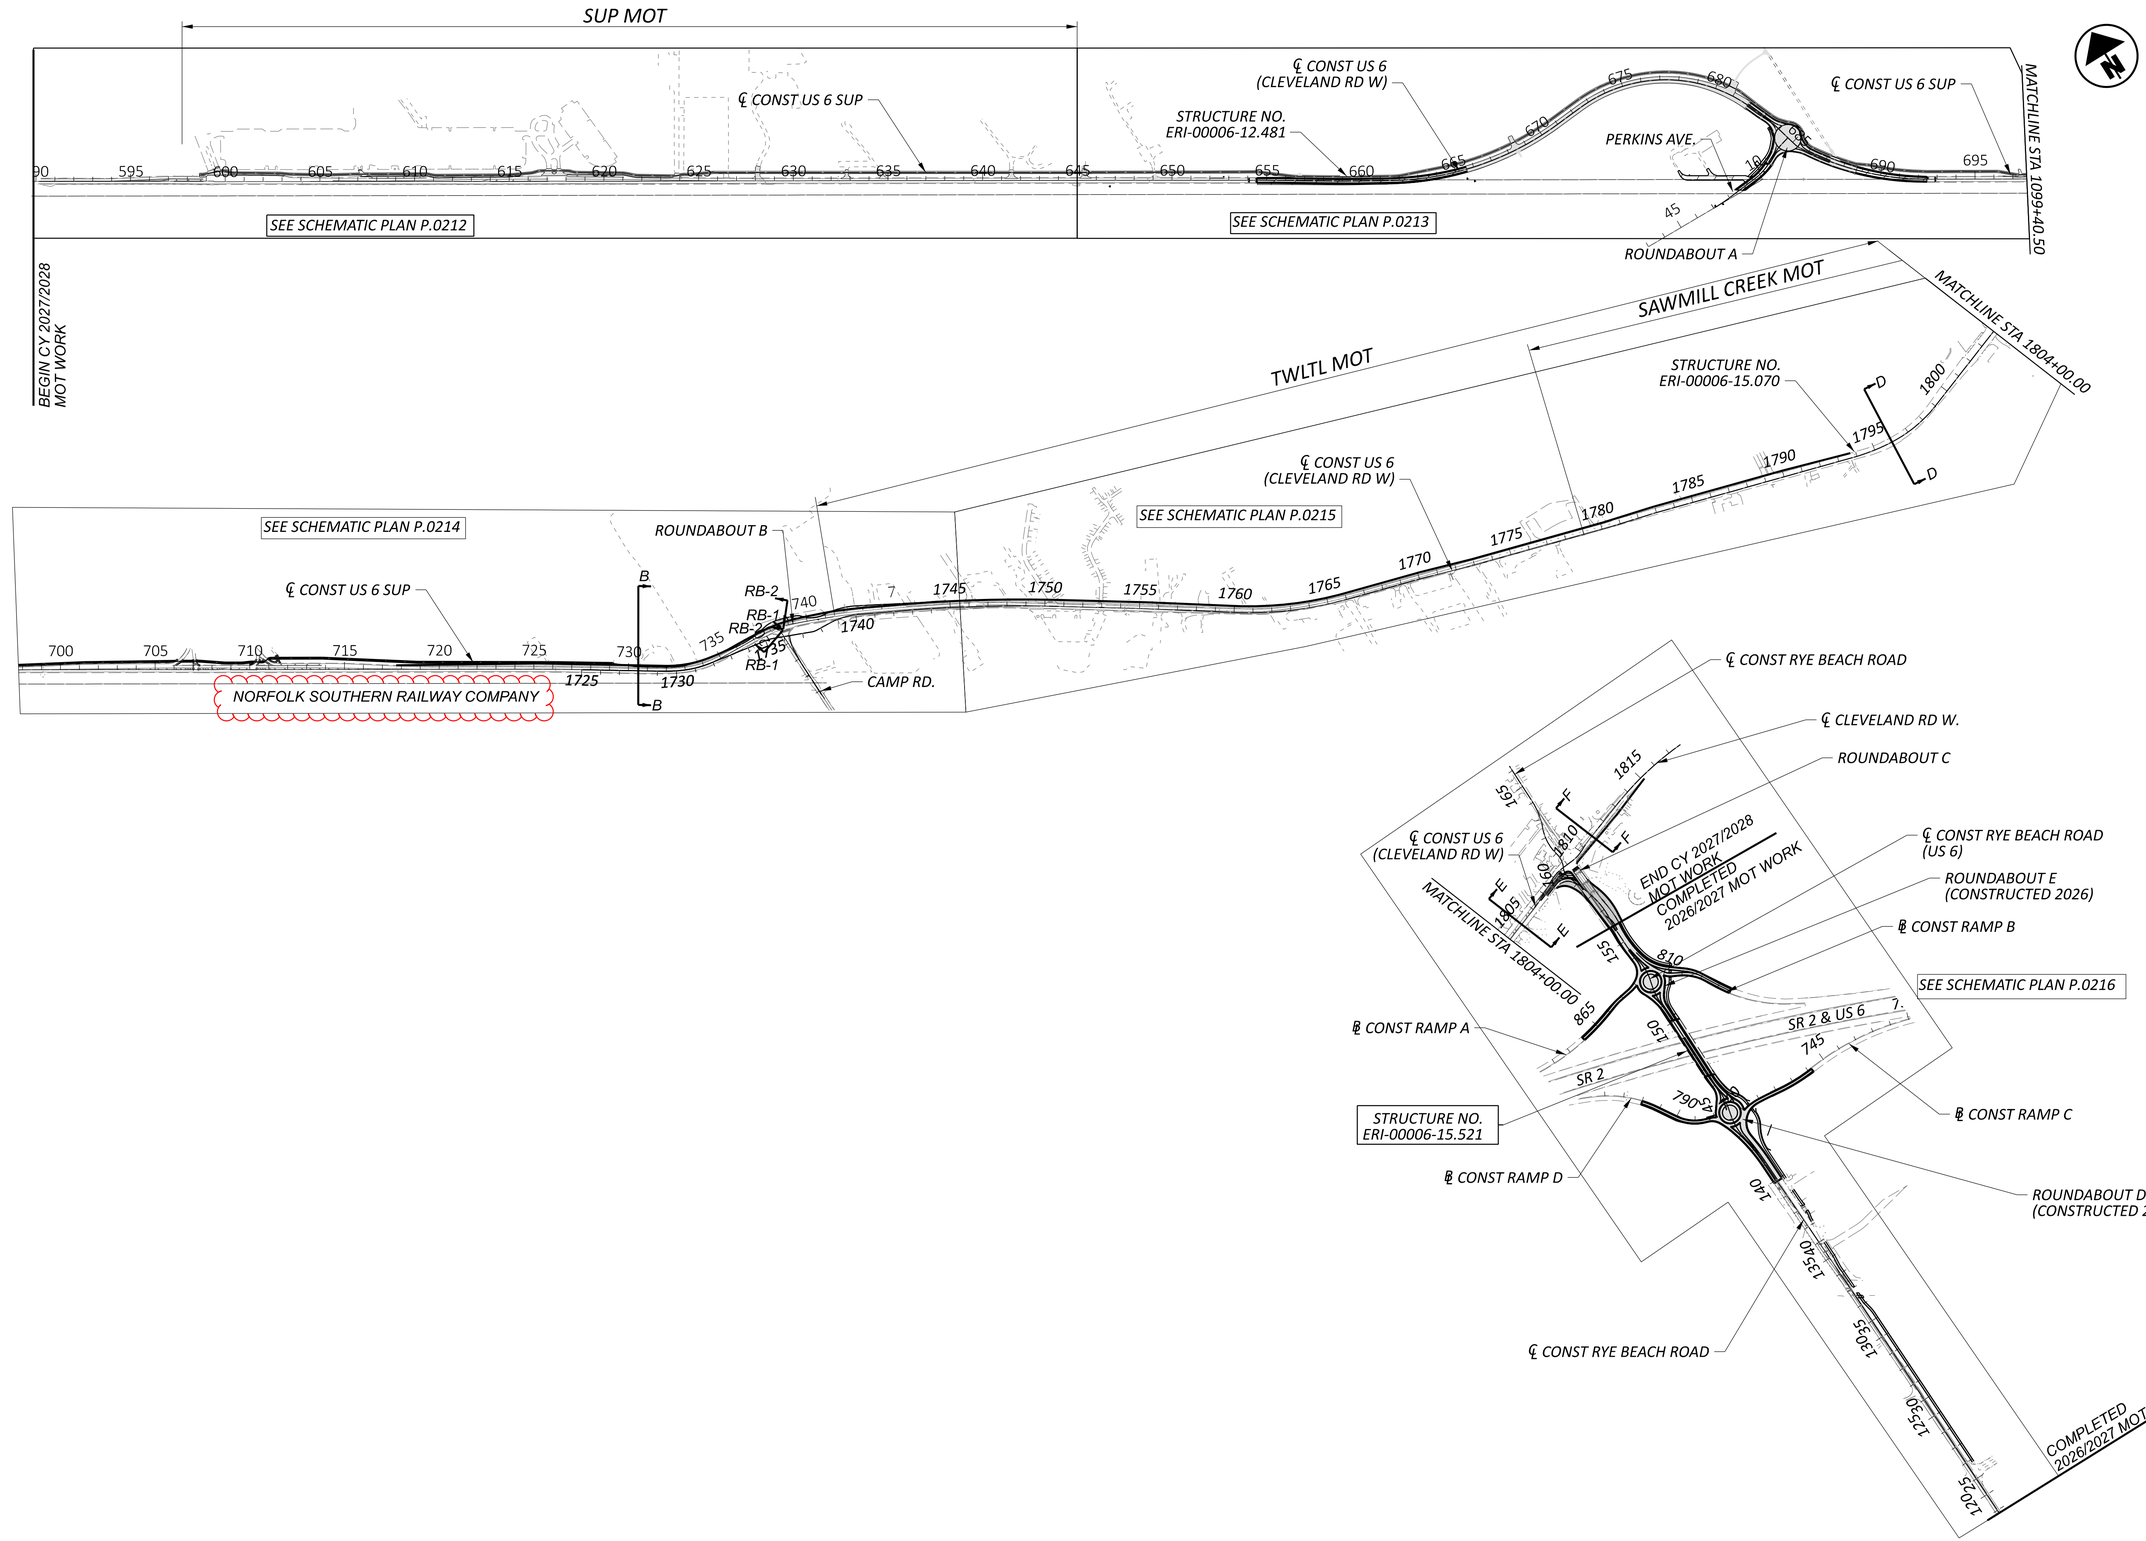

MOT OVERALL SCHEMATIC PLAN - PRE PHASE (2027/2028 CONSTRUCTION)


ERI-US 0006-CONNECTIVITY CORRIDOR

MODEL: 400 Scale PAPERSIZE: 34x22 (in.) DATE: 2/26/2026 TIME: 11:40:03 AM PLTDRV: OHDOT_PDF_Levels.pltcfg PENTBL: OHDOT_Pen.tbl USER: hrthornton@gftinc.com WORKSPACE: OHDOTCEv02 WORKSET: 116570 PRODUCT: OpenRoadsDesigner 24.00.02.25
pw:\\ohiodot-pw.bentley.com:ohiodot-pw-02\Documents\01 Active Projects\District 03\Erie\116570\402-Engineering_TranSystems\MOT\Sheets\116570_MB001_CY2027.dgn

DESIGN AGENCY
TRANSYSTEMS
400 W. NATIONWIDE BLVD., STE 225
COLUMBUS, OHIO 43215

DESIGNER	SSA
REVIEWER	SS 10/27/25
PROJECT ID	116570
SHEET	P.0211
TOTAL	1106

MODEL: GB101 [Sheet] PAPERSIZE: 34x22 (in.) DATE: 2/25/2026 TIME: 6:26:48 PM PLTDRV: OHDOT_PDF_Levels.pltcfg PENTBL: OHDOT_Pen.tbl USER: hrthornton@gftinc.com WORKSPACE: OHDOTCEv02 WORKSET: 116570 PRODUCT: OpenRoadsDesigner 24.00.02.25
pw:\\ohiodot-pw.bentley.com:ohiodot-pw-02\Documents\01 Active Projects\District 03\Erie\116570\402-Engineering_TranSystems\MOT\Sheets\116570_MB002_CY2027.dgn

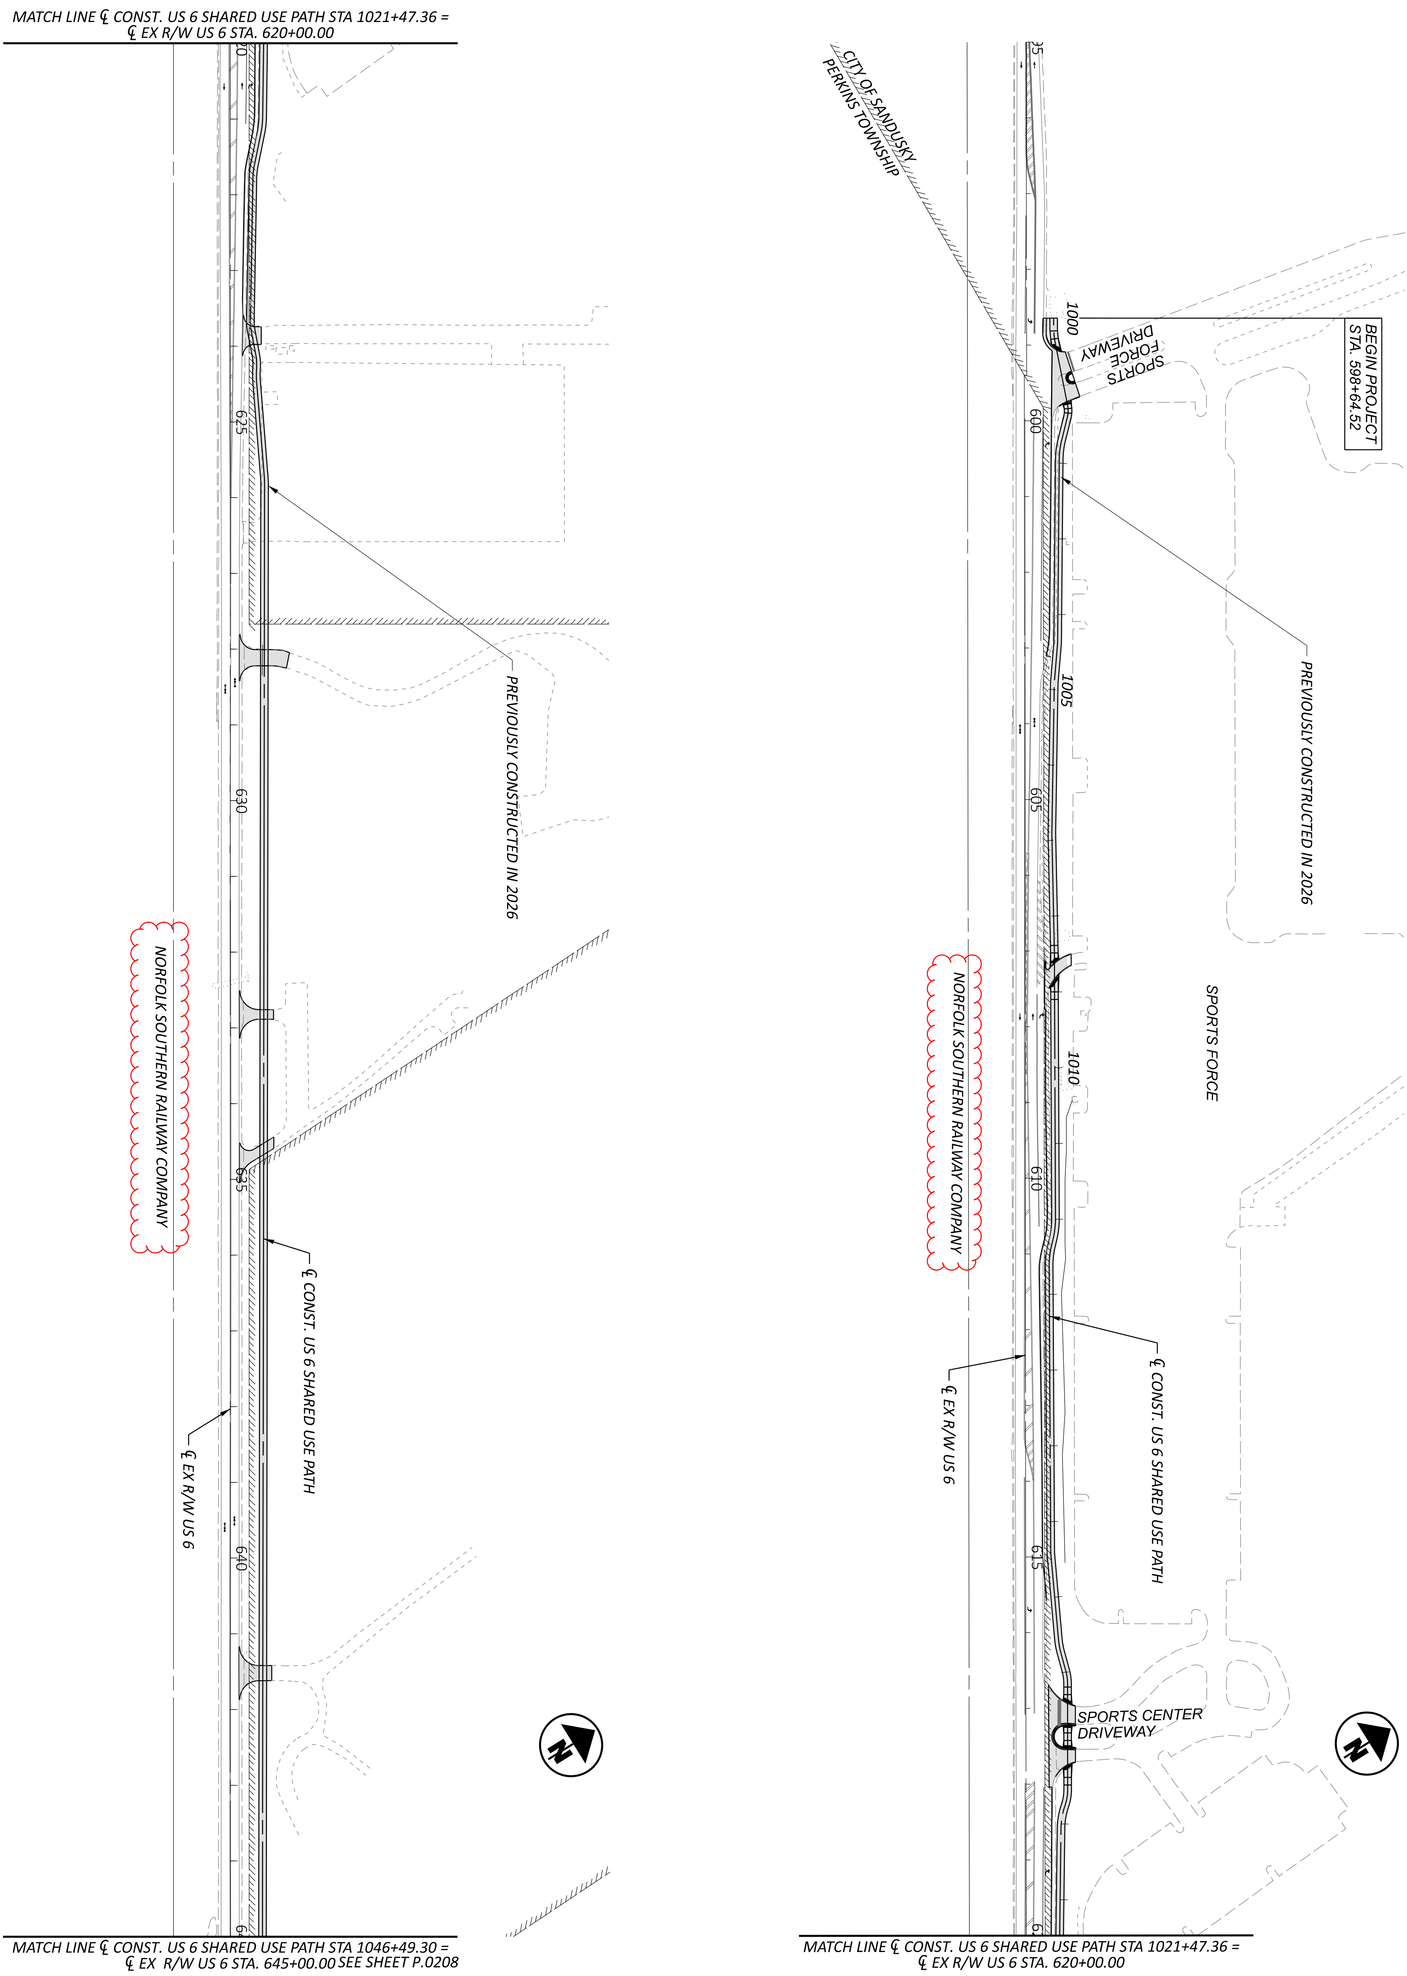

NOTES:

1. FOR MOT OVERALL SCHEMATIC PLAN, SEE SHEET **P.0206.**
2. FOR LEGEND, SEE SHEET P.0084.

SHEET	TOTAL
P.0212	1106

PROJECT ID: 116570

REVIEWER: SS 10/27/25

DESIGNER: SSA


TRANSYSTEMS
400 W. NATIONWIDE BLVD., STE 220
COLUMBUS, OHIO 43215


DESIGN AGENCY

MOT SCHEMATIC PLAN - PRE PHASE (2027/2028 CONSTRUCTION)
US 6 BEGIN PROJECT TO STA 645+00

HORIZONTAL SCALE IN FEET
0 100
50 200

MODEL: GB102 [Sheet] PAPERSIZE: 34x22 (in.) DATE: 2/25/2026 TIME: 6:31:30 PM PLTDRV: OHDOT_PDF_Levels.pltcfg PENTBL: OHDOT_Pen.tbl USER: hrthornton@gftinc.com WORKSPACE: OHDOTCivil02 WORKSET: 116570 PRODUCT: OpenRoadsDesigner 24.00.02.25
pw:\\ohiodot-pw.bentley.com:ohiodot-pw-02\Documents\01 Active Projects\District 03\Erie\116570\402-Engineering_TranSystems\MOT\Sheets\116570_MB002_CY2027.dgn

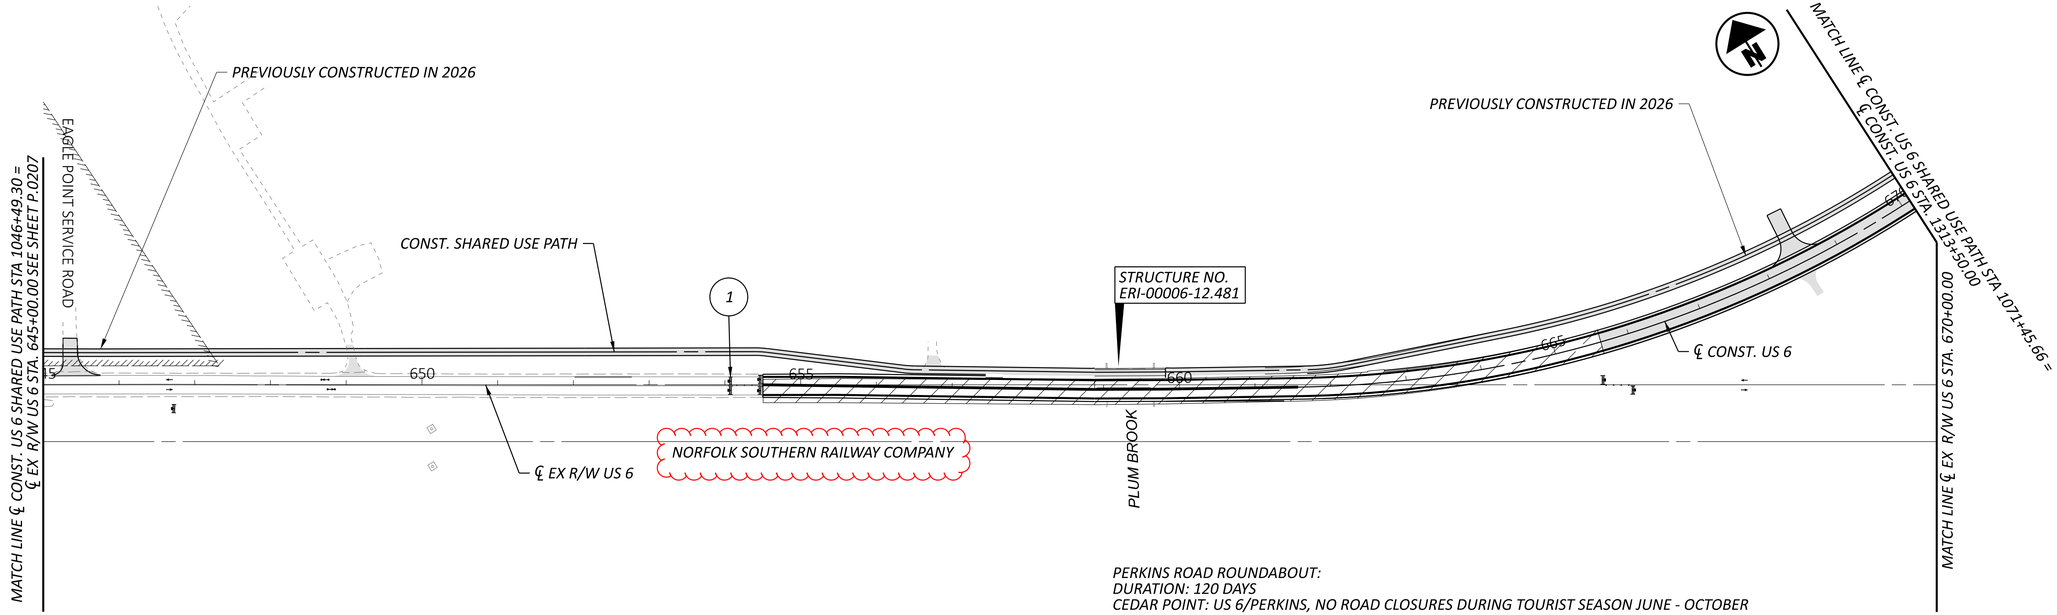

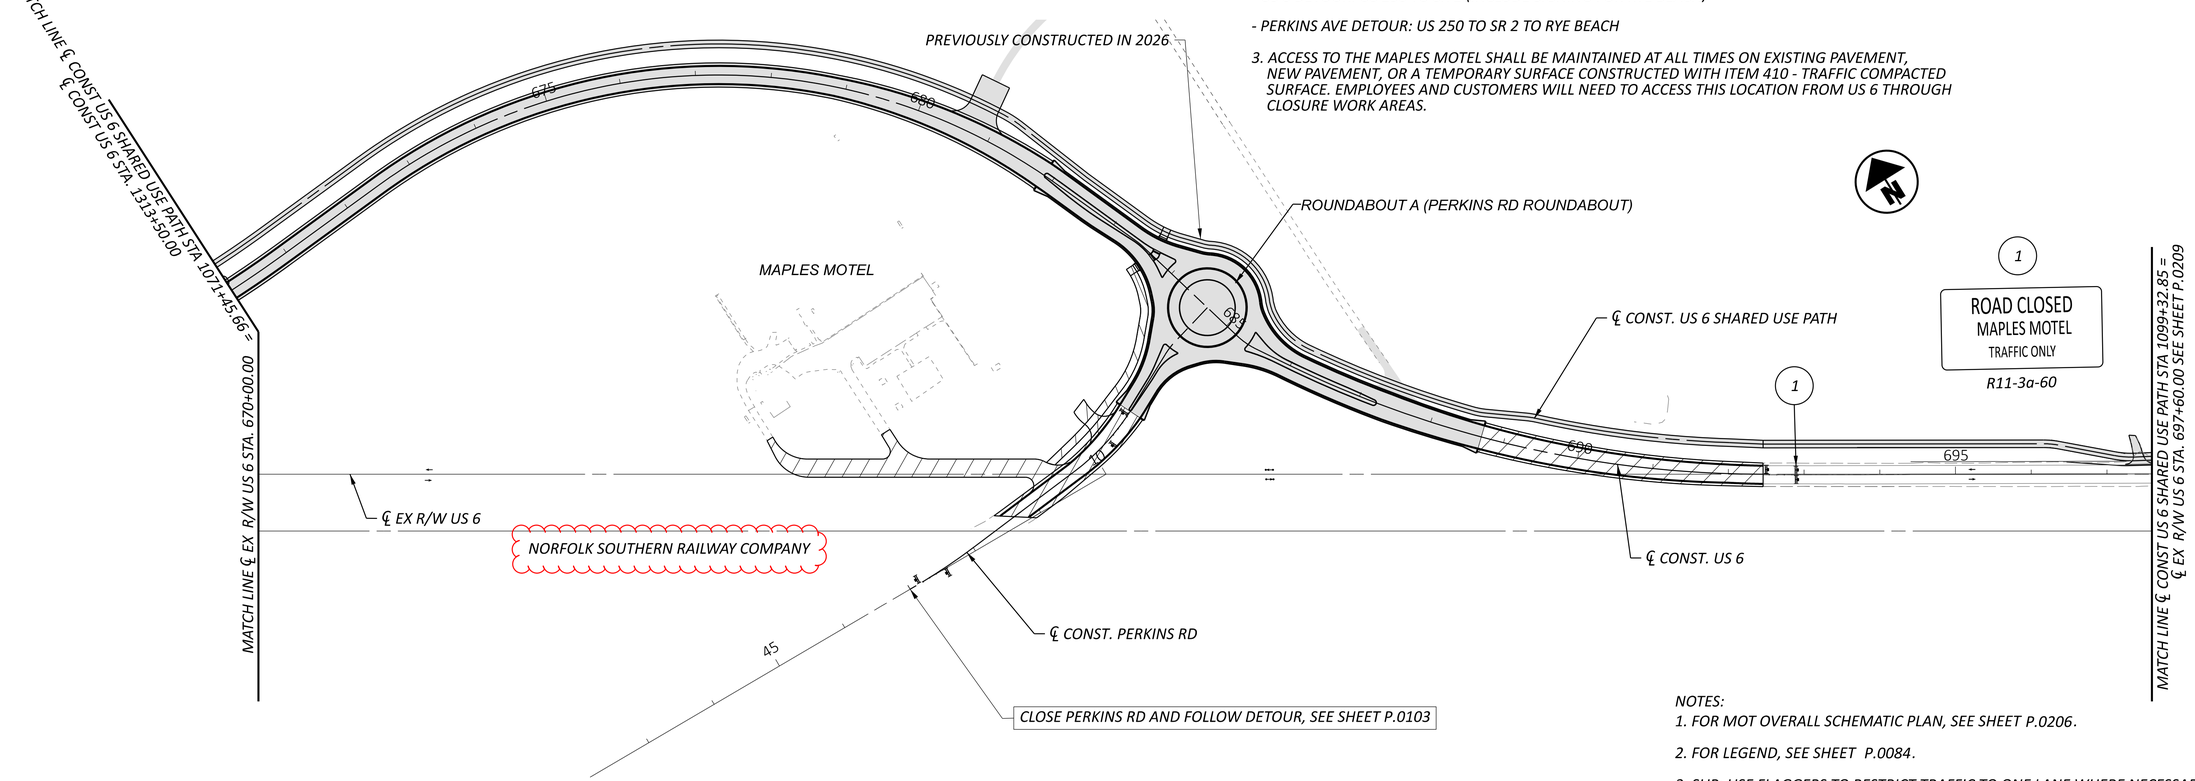

PERKINS ROAD ROUNDABOUT:
DURATION: 120 DAYS
CEDAR POINT: US 6/PERKINS, NO ROAD CLOSURES DURING TOURIST SEASON JUNE - OCTOBER

1. CONSTRUCT ROUNDABOUT WHILE MAINTAINING TRAFFIC ON US 6 (PROPOSED RAB IS NOT ALIGNED WITH EX. US 6)

2. CLOSE US 6 AND PERKINS AVE (CR 5) TO CONSTRUCT TIE-INS (30 DAYS)

- US 6 DETOUR: US 250 TO SR 2 (INCLUDE SIGNING FOR RYE BEACH)

- PERKINS AVE DETOUR: US 250 TO SR 2 TO RYE BEACH

3. ACCESS TO THE MAPLES MOTEL SHALL BE MAINTAINED AT ALL TIMES ON EXISTING PAVEMENT, NEW PAVEMENT, OR A TEMPORARY SURFACE CONSTRUCTED WITH ITEM 410 - TRAFFIC COMPACTED SURFACE. EMPLOYEES AND CUSTOMERS WILL NEED TO ACCESS THIS LOCATION FROM US 6 THROUGH CLOSURE WORK AREAS.

NOTES:
1. FOR MOT OVERALL SCHEMATIC PLAN, SEE SHEET P.0206.

2. FOR LEGEND, SEE SHEET P.0084.


3. SUP: USE FLAGGERS TO RESTRICT TRAFFIC TO ONE LANE WHERE NECESSARY TO CONSTRUCT THE RESURFACING AND MULTI-USE PATH OUTSIDE WIDENING AREAS AND PROPOSED ROUNDABOUTS. USE LEOS TO CONTROL TRAFFIC AT SIGNALIZED INTERSECTIONS WHEN NECESSARY. ASSUME SUP CONSTRUCTION DURATION OF 60 DAYS.

HORIZONTAL SCALE IN FEET
0 50 100 200

MOT SCHEMATIC PLAN - PRE PHASE (2027/2028 CONSTRUCTION)
US 6 STA 645+00 TO STA 695+00

DESIGN AGENCY
TRANSYSTEMS
400 W. NATIONWIDE BLVD., STE 225
COLUMBUS, OHIO 43215

DESIGNER	SSA
REVIEWER	SS 10/27/25
PROJECT ID	116570
SHEET	P.0213
TOTAL	1106

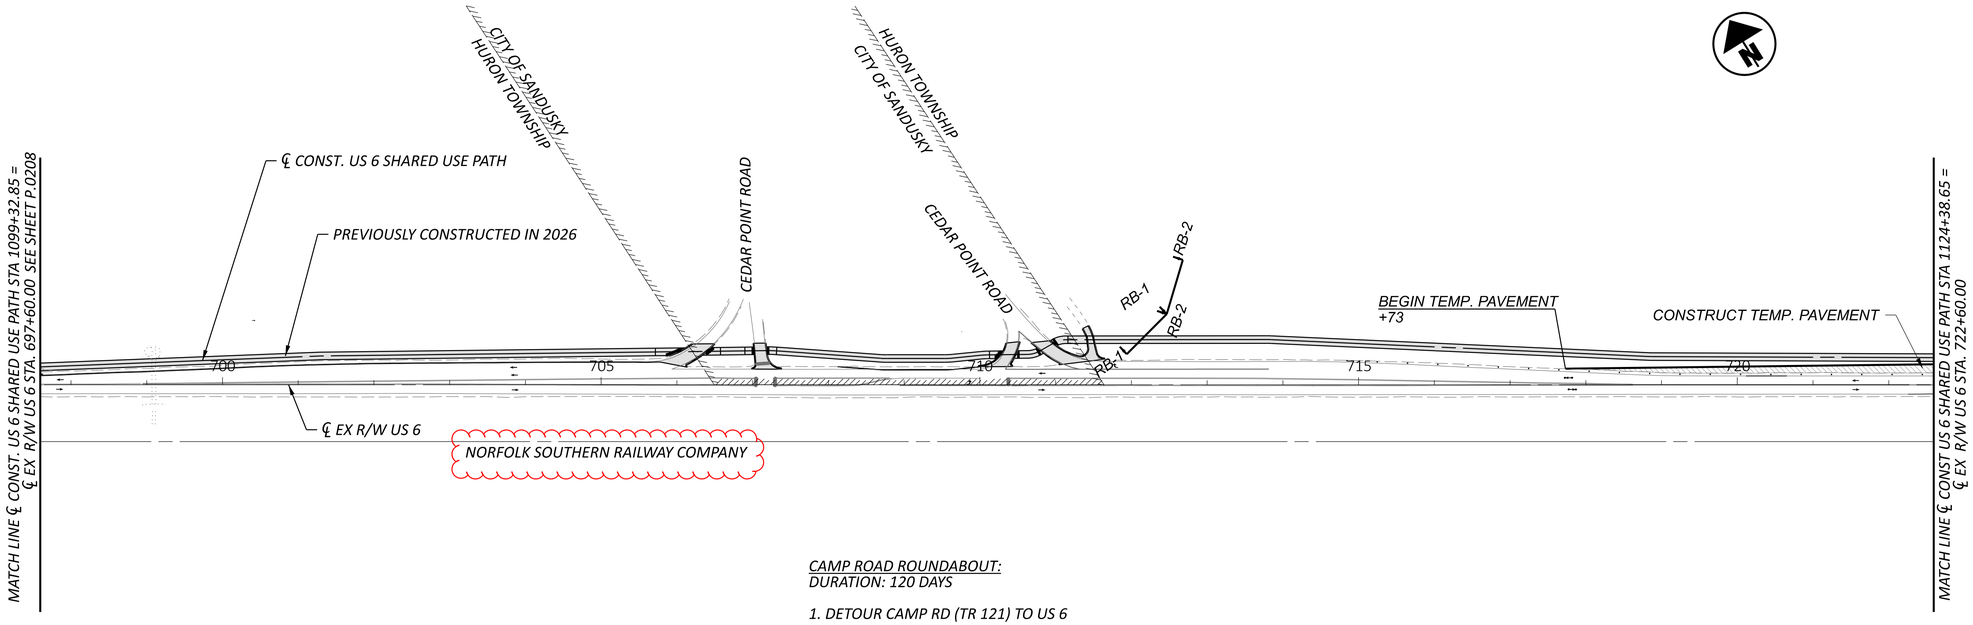

CAMP ROAD ROUNDABOUT:
DURATION: 120 DAYS

1. DETOUR CAMP RD (TR 121) TO US 6

- WEST: HULL TO GALLOWAY TO PERKINS


- EAST: BOOS TO RYE BEACH

2. CONSTRUCT US 6 PORTION OF THE MULTI-LANE ROUNDABOUT IN PHASES WITH THE TWLTL

I. CONSTRUCT TEMPORARY PAVEMENT ON THE NORTH SIDE OF US 6 (FLAGGERS)

II. MAINTAIN TRAFFIC ON TEMPORARY PAVEMENT ON THE NORTH SIDE OF US 6 AND CONSTRUCT THE SOUTH HALF

III. MAINTAIN TRAFFIC ON THE SOUTH SIDE OF US 6 AND CONSTRUCT THE NORTH HALF AND MULTI-USE PATH

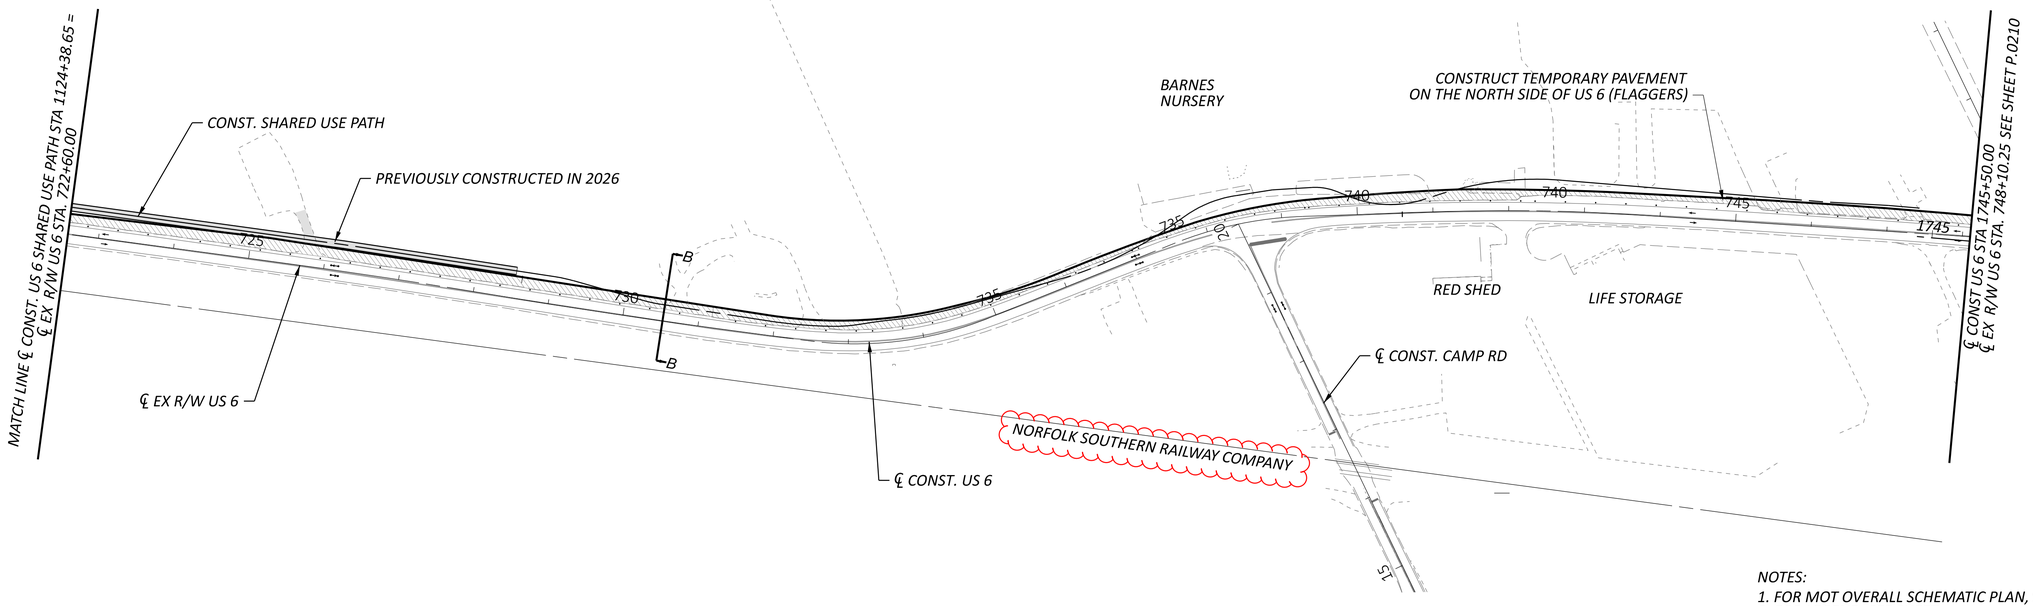

NOTES:
1. FOR MOT OVERALL SCHEMATIC PLAN, SEE SHEET P.0206.
2. FOR LEGEND, SEE SHEET P.0084.

HORIZONTAL SCALE IN FEET
0 50 100 200


MOT SCHEMATIC PLAN - PRE PHASE (2027/2028 CONSTRUCTION)
US 6 STA 695+00 TO STA 745+50

DESIGN AGENCY
TRANSYSTEMS
400 W. NATIONWIDE BLVD., STE 225
COLUMBUS, OHIO 43215

DESIGNER: SSA
REVIEWER: SS 10/27/25
PROJECT ID: 116570
SHEET: P.0214 TOTAL: 1106

ERI-US 0006-CONNECTIVITY CORRIDOR

MODEL: GB103 |Sheet| PAPERSIZE: 34x22 (in.) DATE: 2/25/2026 TIME: 6:36:50 PM PLTDRV: OHDOT_PDF_Levels.pltcfg PENTBL: OHDOT_Pen.tbl USER: hrthornton@gftinc.com WORKSPACE: OHDOTCtx02 WORKSET: 116570 PRODUCT: OpenRoadsDesigner 24.00.02.25
pw:\\ohiodot-pw.bentley.com:ohiodot-pw-02\Documents\01 Active Projects\District 03\Erie\116570\402-Engineering_TranSystems\MOT\Sheets\116570_MB002_CY2027.dgn

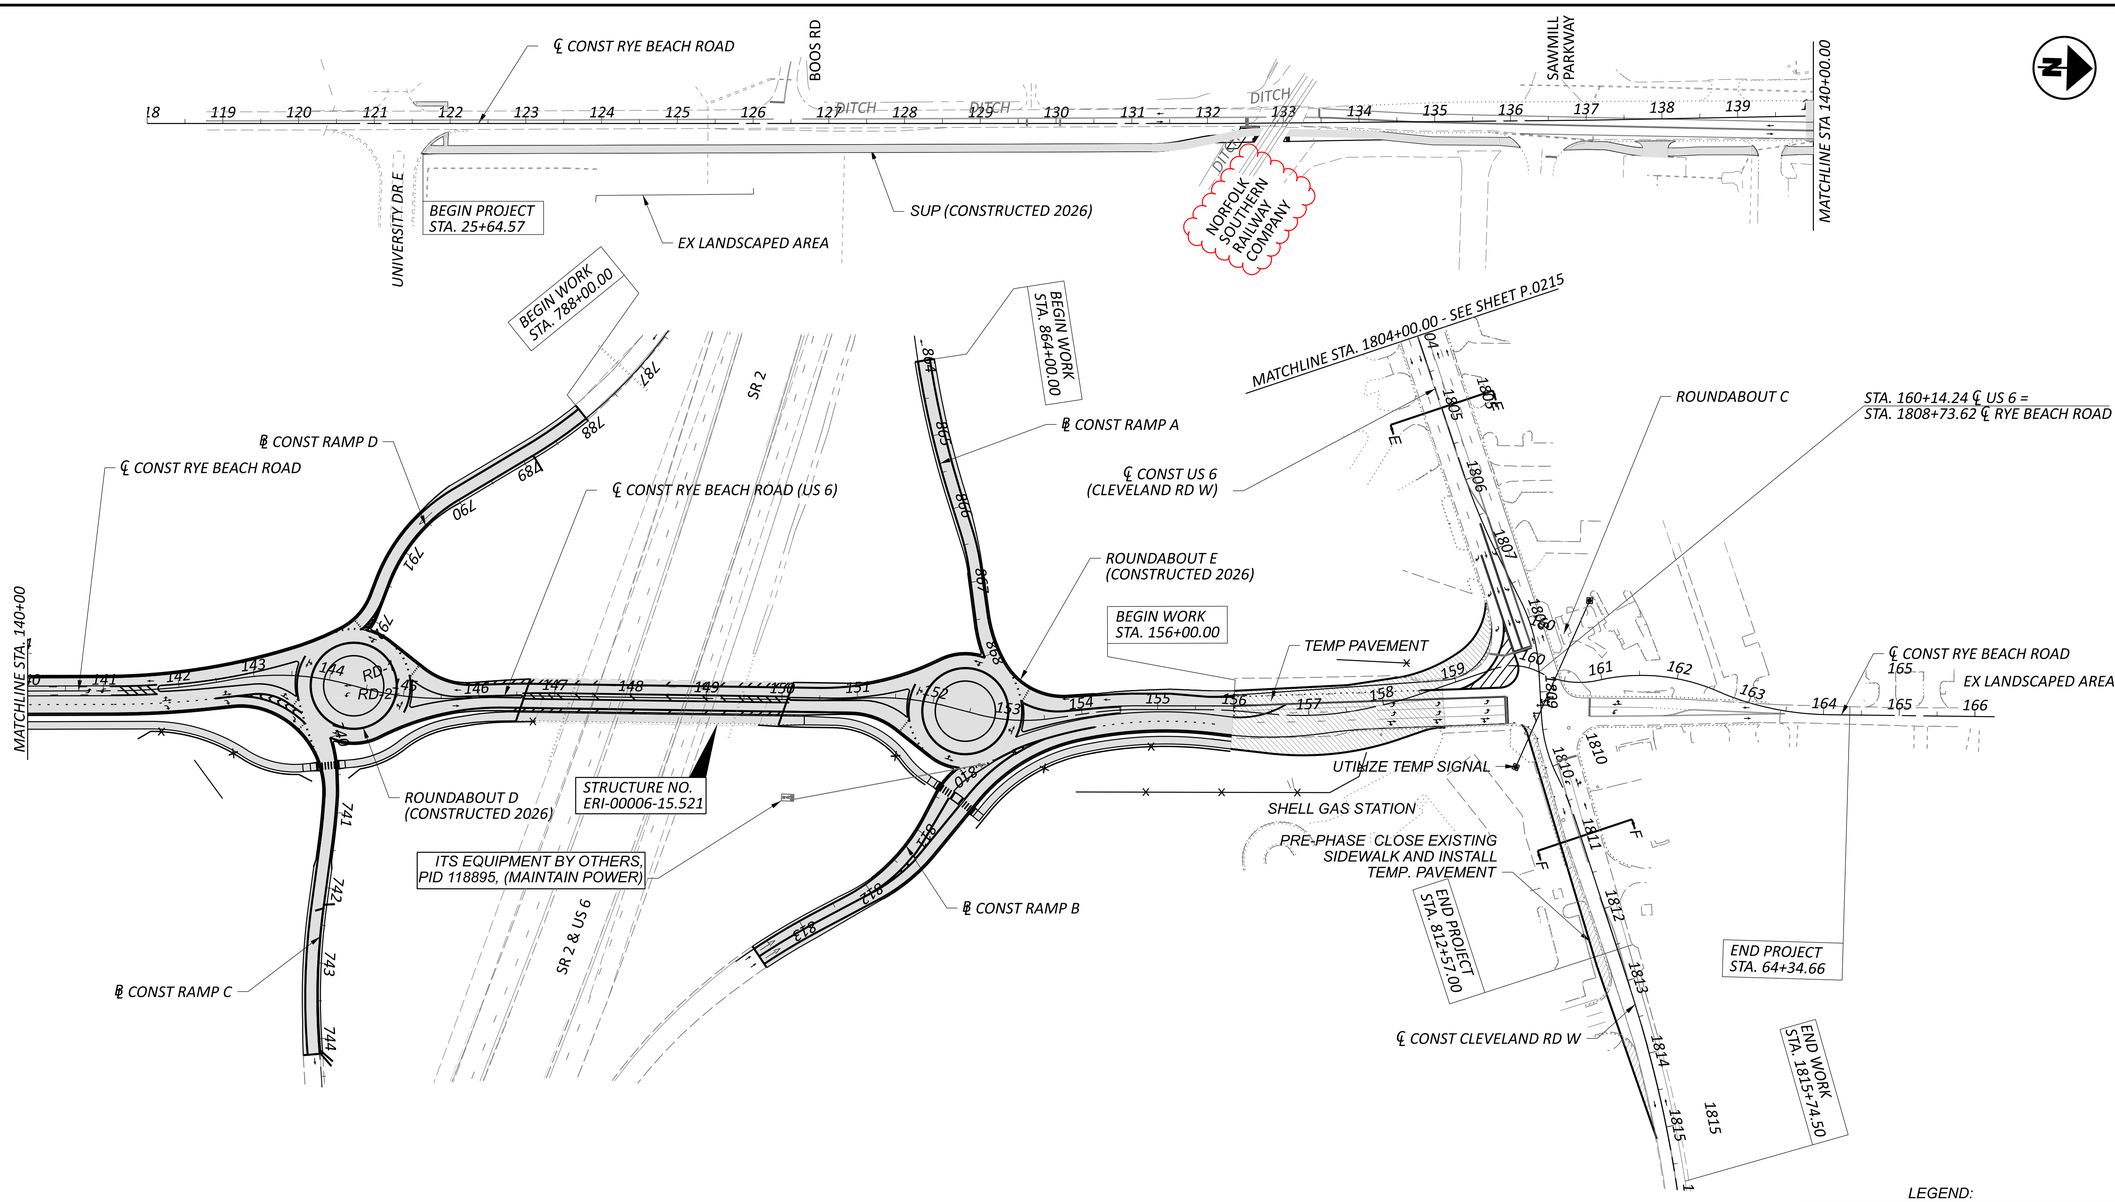

RYE BEACH ROUNDABOUTS:
DURATION: 180 DAYS
CEDAR POINT: NO ROAD CLOSURES ON US 6 DURING TOURIST SEASON IN JUNE - OCTOBER

PRE-PHASE:

CONSTRUCT TEMPERARY ROAD AND GRADING WITH MINIMAL IMPACTS TO EXISTING TRAFFIC.

LEGEND:

- EMBANKMENT AND GRADING CONSTRUCTED IN PRE-PHASE
- PAVEMENT CONSTRUCTED IN PREVIOUS PHASE
- WORK ZONE
- TEMPORARY PAVEMENT
- DIRECTION OF TRAFFIC
- DRUMS

NOTES:

1. FOR MOT OVERALL SCHEMATIC PLAN, SEE SHEET P.0211
2. FOR LEGEND, SEE SHEET P.0085

HORIZONTAL SCALE IN FEET
0 50 100 200


MOT SCHEMATIC PLAN - PRE PHASE (2027/2028 CONSTRUCTION)
RYE BEACH ROAD STA 118+00.00 TO STA 166+00.00

ERI-US 0006-CONNECTIVITY CORRIDOR

DESIGN AGENCY
TRANSYSTEMS
400 W. NATIONWIDE BLVD., STE 225
COLUMBUS, OHIO 43215

DESIGNER	SSA
REVIEWER	SS 10/27/25
PROJECT ID	116570
SHEET	P.0216
TOTAL	1106

MODEL: 100 Scale 2 PAPERSIZE: 34x22 (in.) DATE: 2/26/2026 TIME: 11:45:03 AM PLTDRV: OHDOT_PDF_Levels.pltcfg PENTBL: OHDOT_Pen.tbl USER: hrthornton@gftinc.com WORKSPACE: OHDOTCEv02 WORKSET: 116570 PRODUCT: OpenRoadsDesigner 24.00.02.25
pw:\\ohiodot-pw.bentley.com:ohiodot-pw-02\Documents\01 Active Projects\District 03\Erie\116570\402 Engineering_TranSystems\MOT\Sheets\116570_MB001_CY2027.dgn

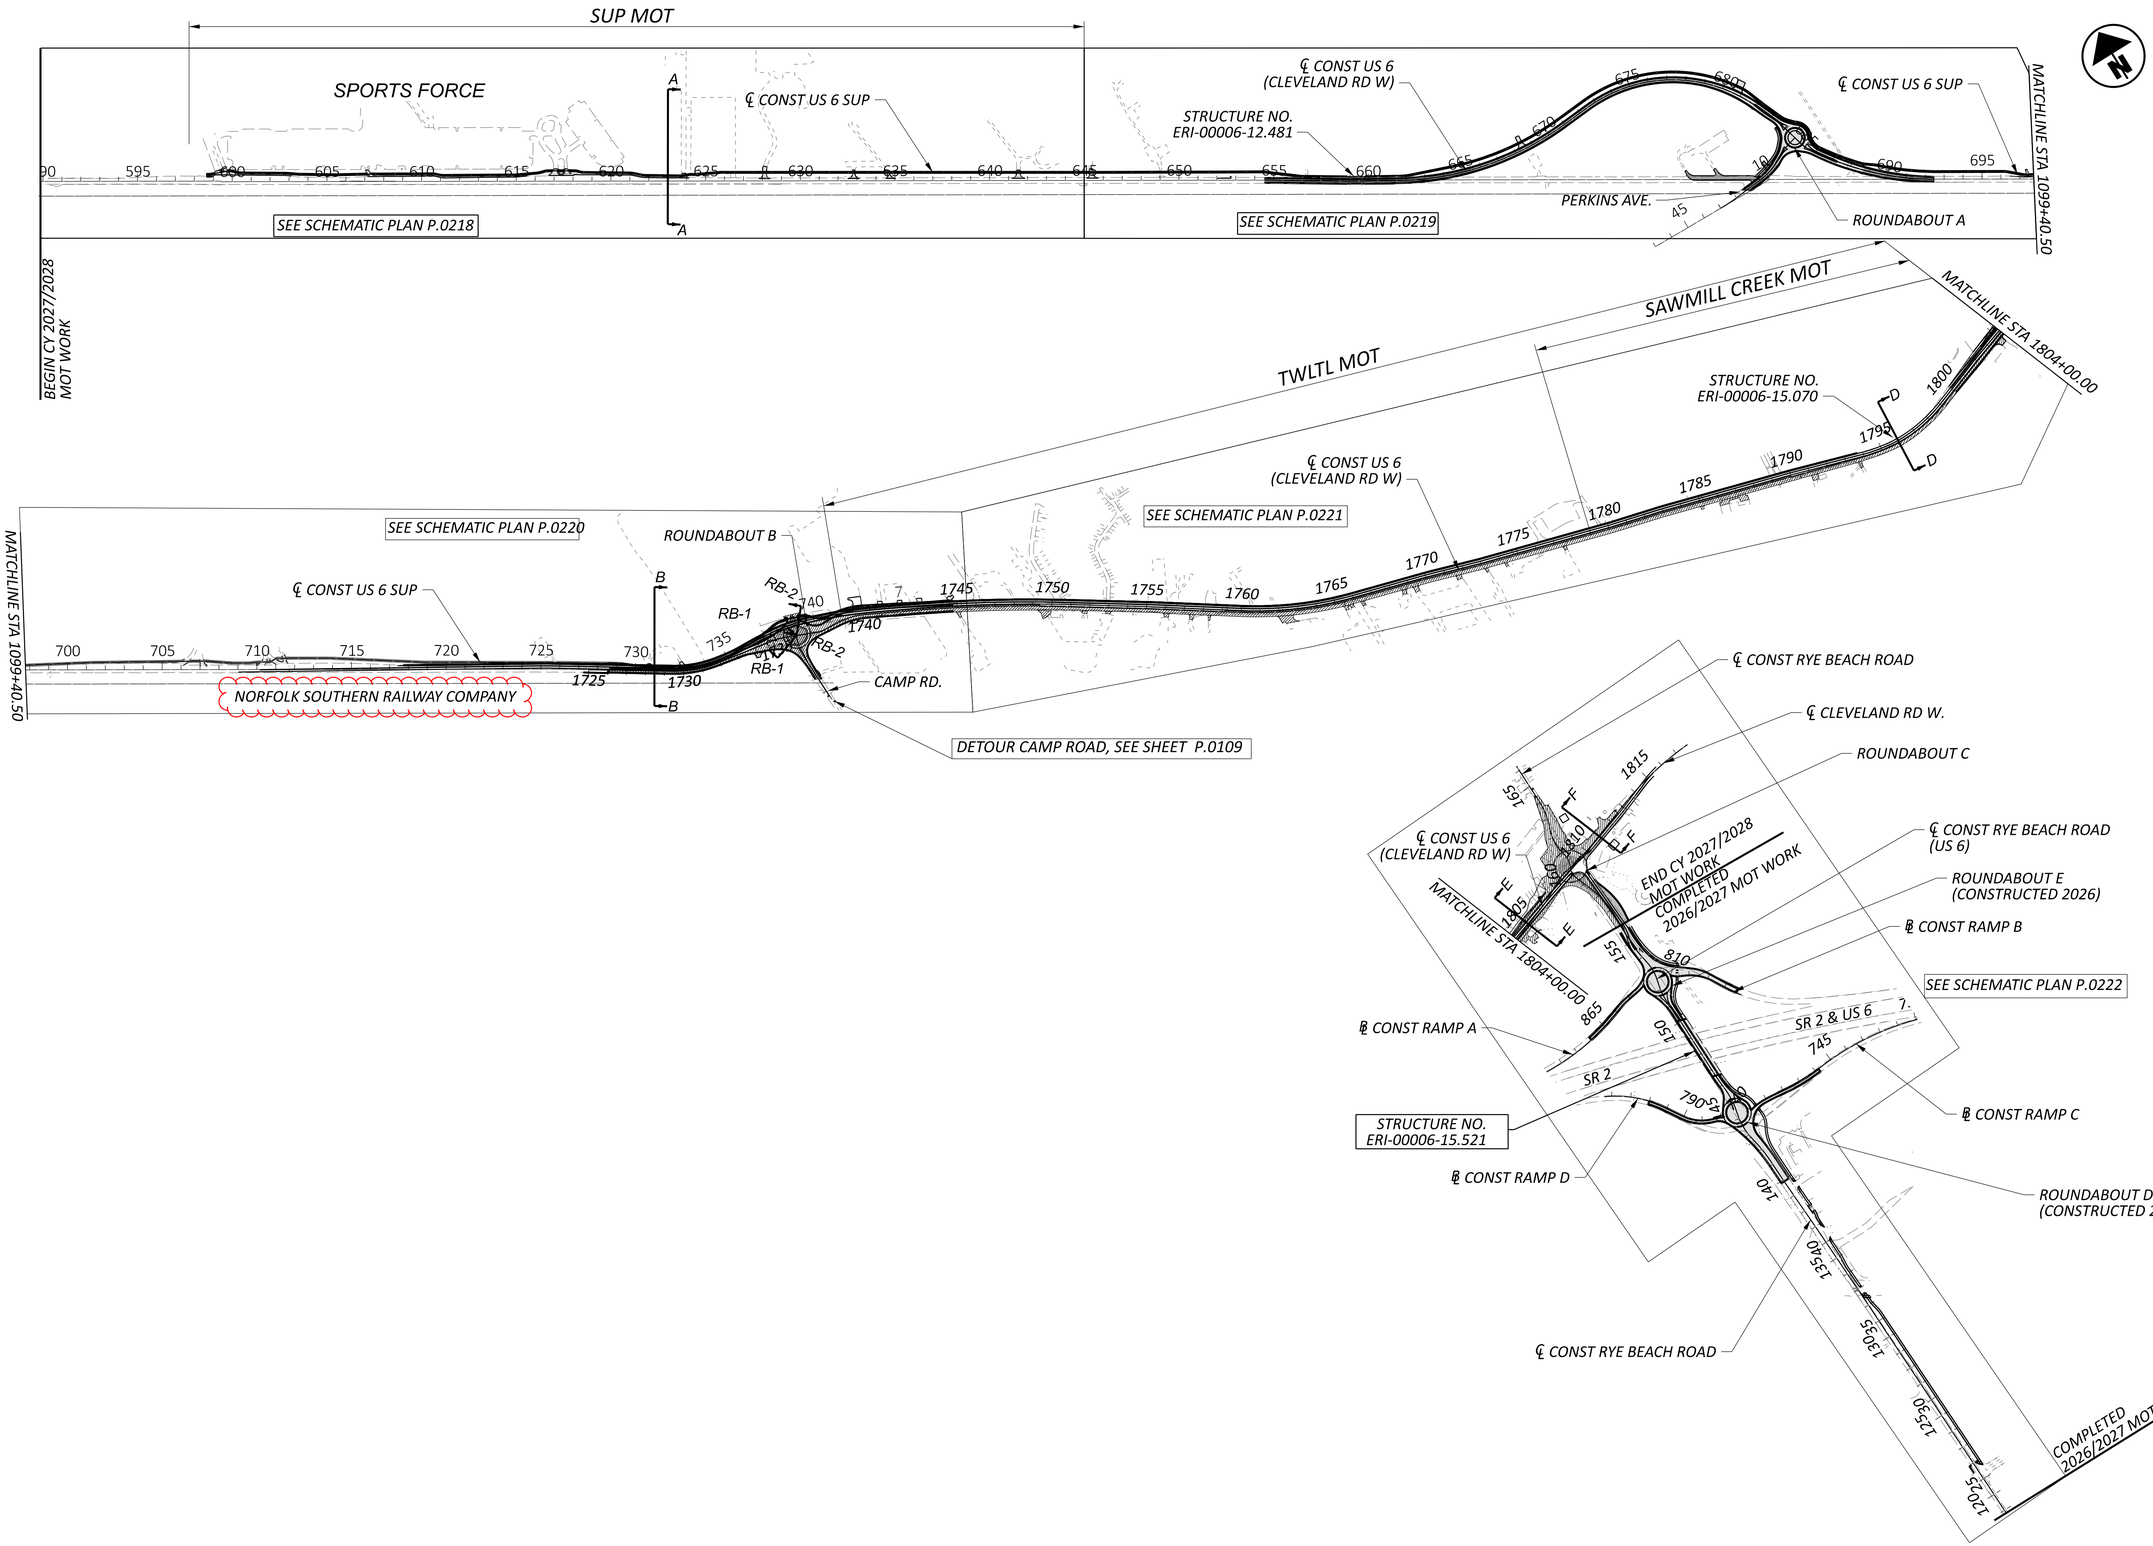

HORIZONTAL SCALE IN FEET
0 200 400 800

MOT OVERALL SCHEMATIC PLAN - PHASE 1 (2027/2028 CONSTRUCTION)


ERI-US 0006-CONNECTIVITY CORRIDOR

MODEL: 400 Scale PAPERSIZE: 34x22 (in.) DATE: 2/25/2026 TIME: 6:45:15 PM PLTDRV: OHDOT_PDF_Levels.plctg PENTBL: OHDOT_Pen.tbl USER: hrthornton@gftinc.com WORKSPACE: OHDOTCEv02 WORKSET: 116570 PRODUCT: OpenRoadsDesigner 24.00.02.25
pw:\\ohiodot-pw.bentley.com:ohiodot-pw-02\Documents\01 Active Projects\District 03\Erie\116570\402-Engineering_TranSystems\MOT\Sheets\116570_MB003_CY2027.dgn

DESIGN AGENCY
TRANSYSTEMS
400 W. NATIONWIDE BLVD, STE 225
COLUMBUS, OHIO 43215

DESIGNER SSA
REVIEWER SS 10/27/25
PROJECT ID 116570
SHEET P.0217 TOTAL 1106

MODEL: GB101 [Sheet] PAPERSIZE: 34x22 (in.) DATE: 2/25/2026 TIME: 7:00:37 PM PLTDRV: OHDOT_PDF_Levels.pltcfg PENTBL: OHDOT_Pen.tbl USER: hrthornton@gftinc.com WORKSPACE: OHDOTCEv02 WORKSET: 116570 PRODUCT: OpenRoadsDesigner 24.00.02.25
pw:\\ohiodot-pw.bentley.com:ohiodot-pw-02\Documents\01 Active Projects\District 03\Erie\116570\402-Engineering_TranSystems\MOT\Sheets\116570_MB004_CY2027.dgn

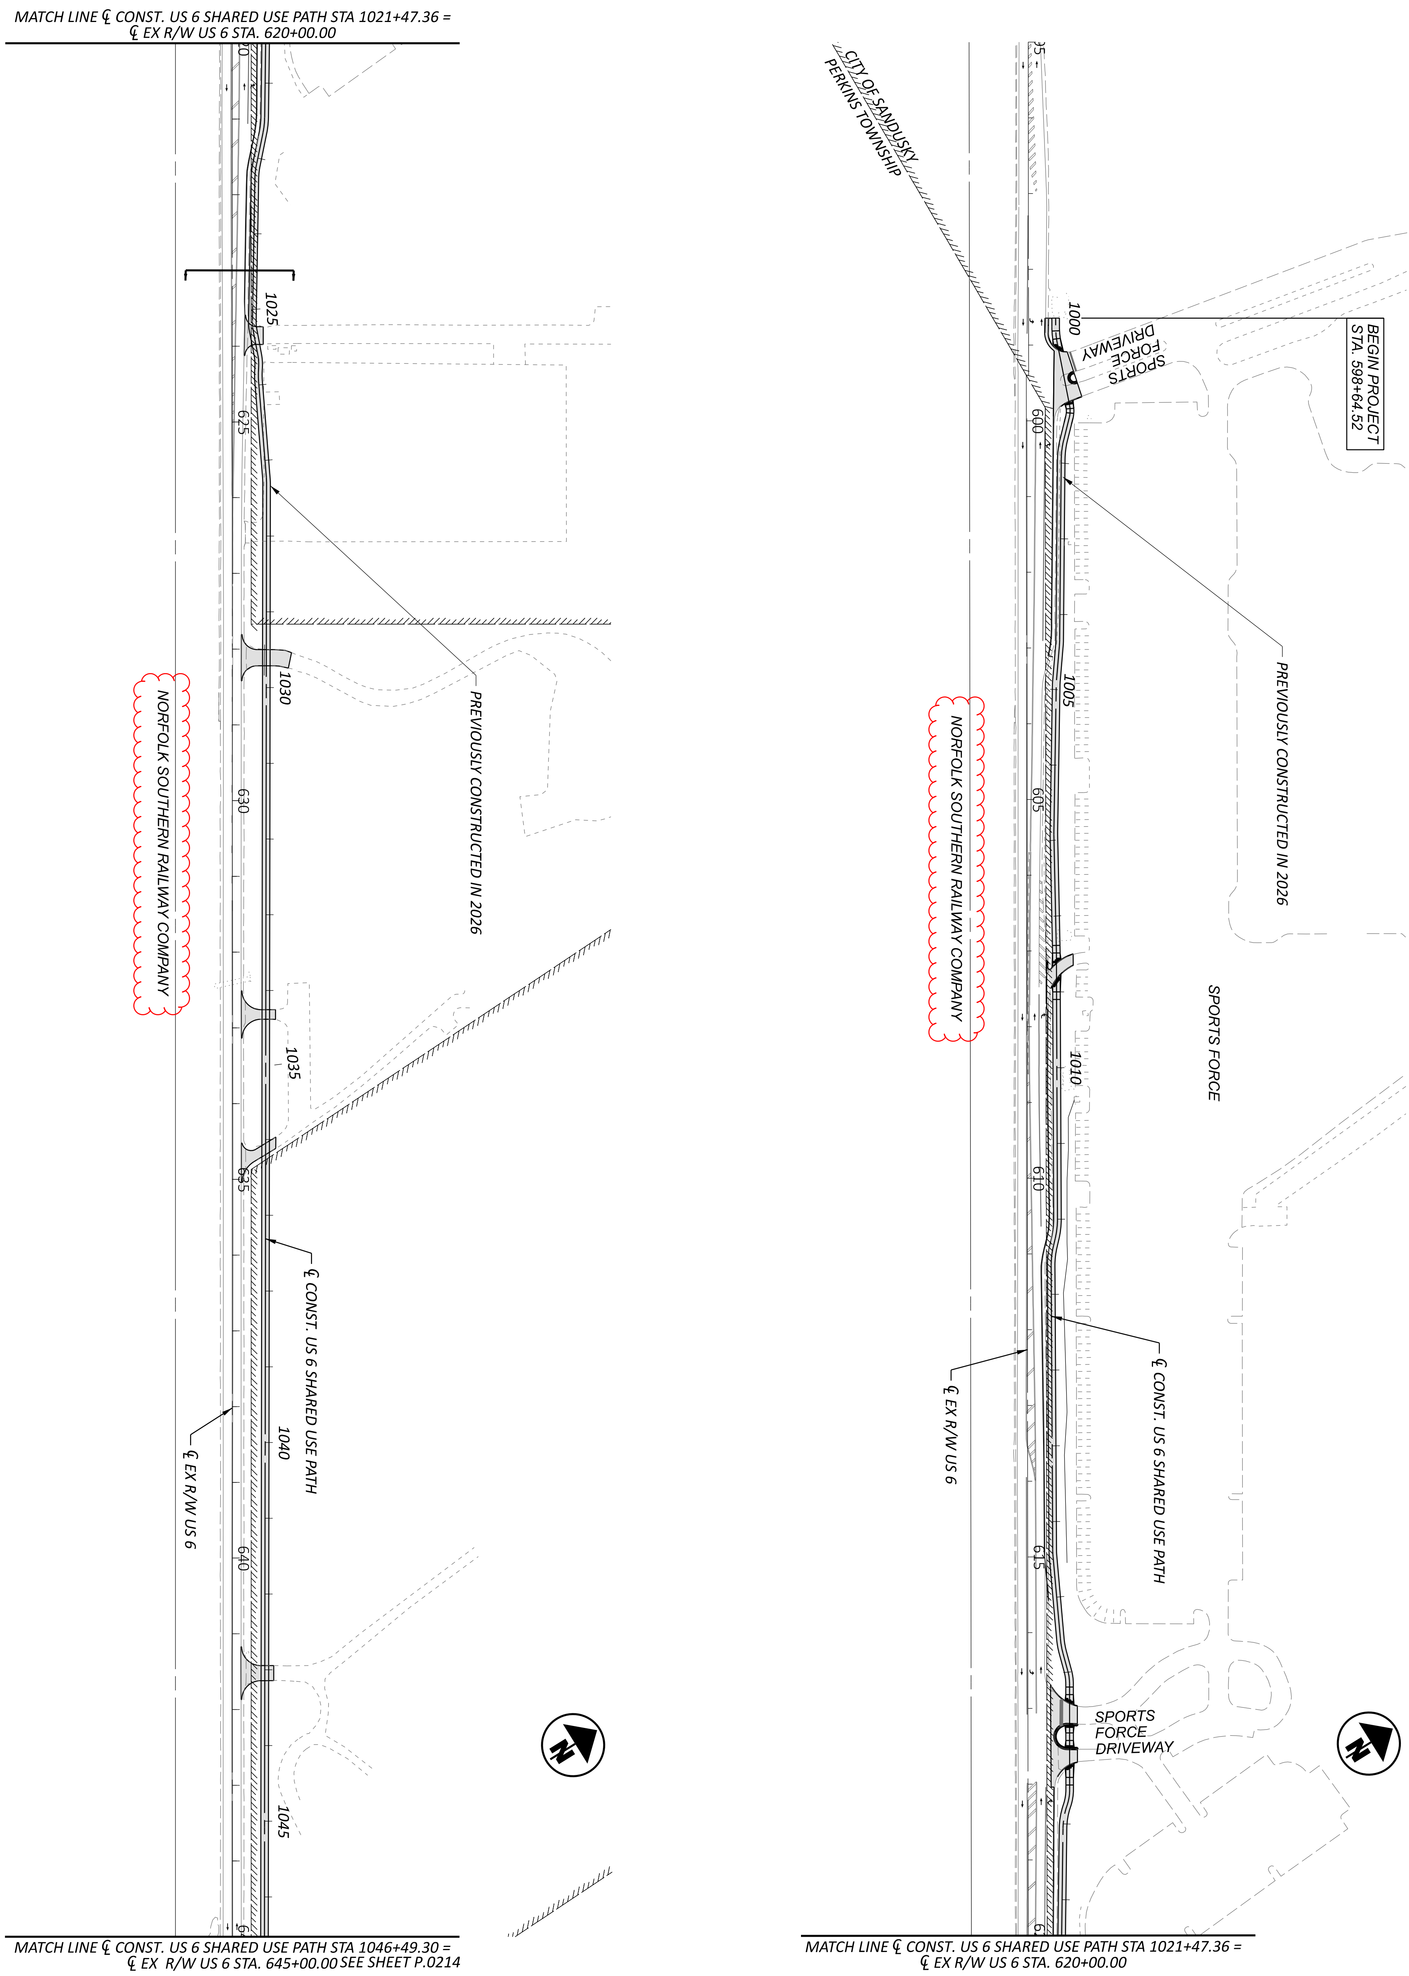

NOTES:
1. FOR MOT OVERALL SCHEMATIC PLAN, SEE SHEET P.0212
2. FOR LEGEND, SEE SHEET P.0084

SHEET	TOTAL
P 0218	1106

PROJECT ID: 116570

REVIEWER: SS 10/27/25


DESIGNER: SSA

TRANSYSTEMS
400 W. NATIONWIDE BLVD., STE 220
COLUMBUS, OHIO 43215
DESIGN AGENCY

MOT SCHEMATIC PLAN - PHASE 1 (2027/2028 CONSTRUCTION)
US 6 BEGIN PROJECT TO STA 645+00

HORIZONTAL SCALE IN FEET
0 100
50 200

MODEL: GB102 [Sheet] PAPERSIZE: 34x22 (in.) DATE: 2/25/2026 TIME: 7:04:10 PM PLTDRV: OHDOT_PDF_Levels.pltcfg PENTBL: OHDOT_Pen.tbl USER: hrthornton@gftinc.com WORKSPACE: OHDOTCEv02 WORKSET: 116570 PRODUCT: OpenRoadsDesigner 24.00.02.25
pw:\\ohiodot-pw.bentley.com:ohiodot-pw-02\Documents\01 Active Projects\District 03\Erie\116570\402-Engineering_TranSystems\MOT\Sheets\116570_MB004_CY2027.dgn

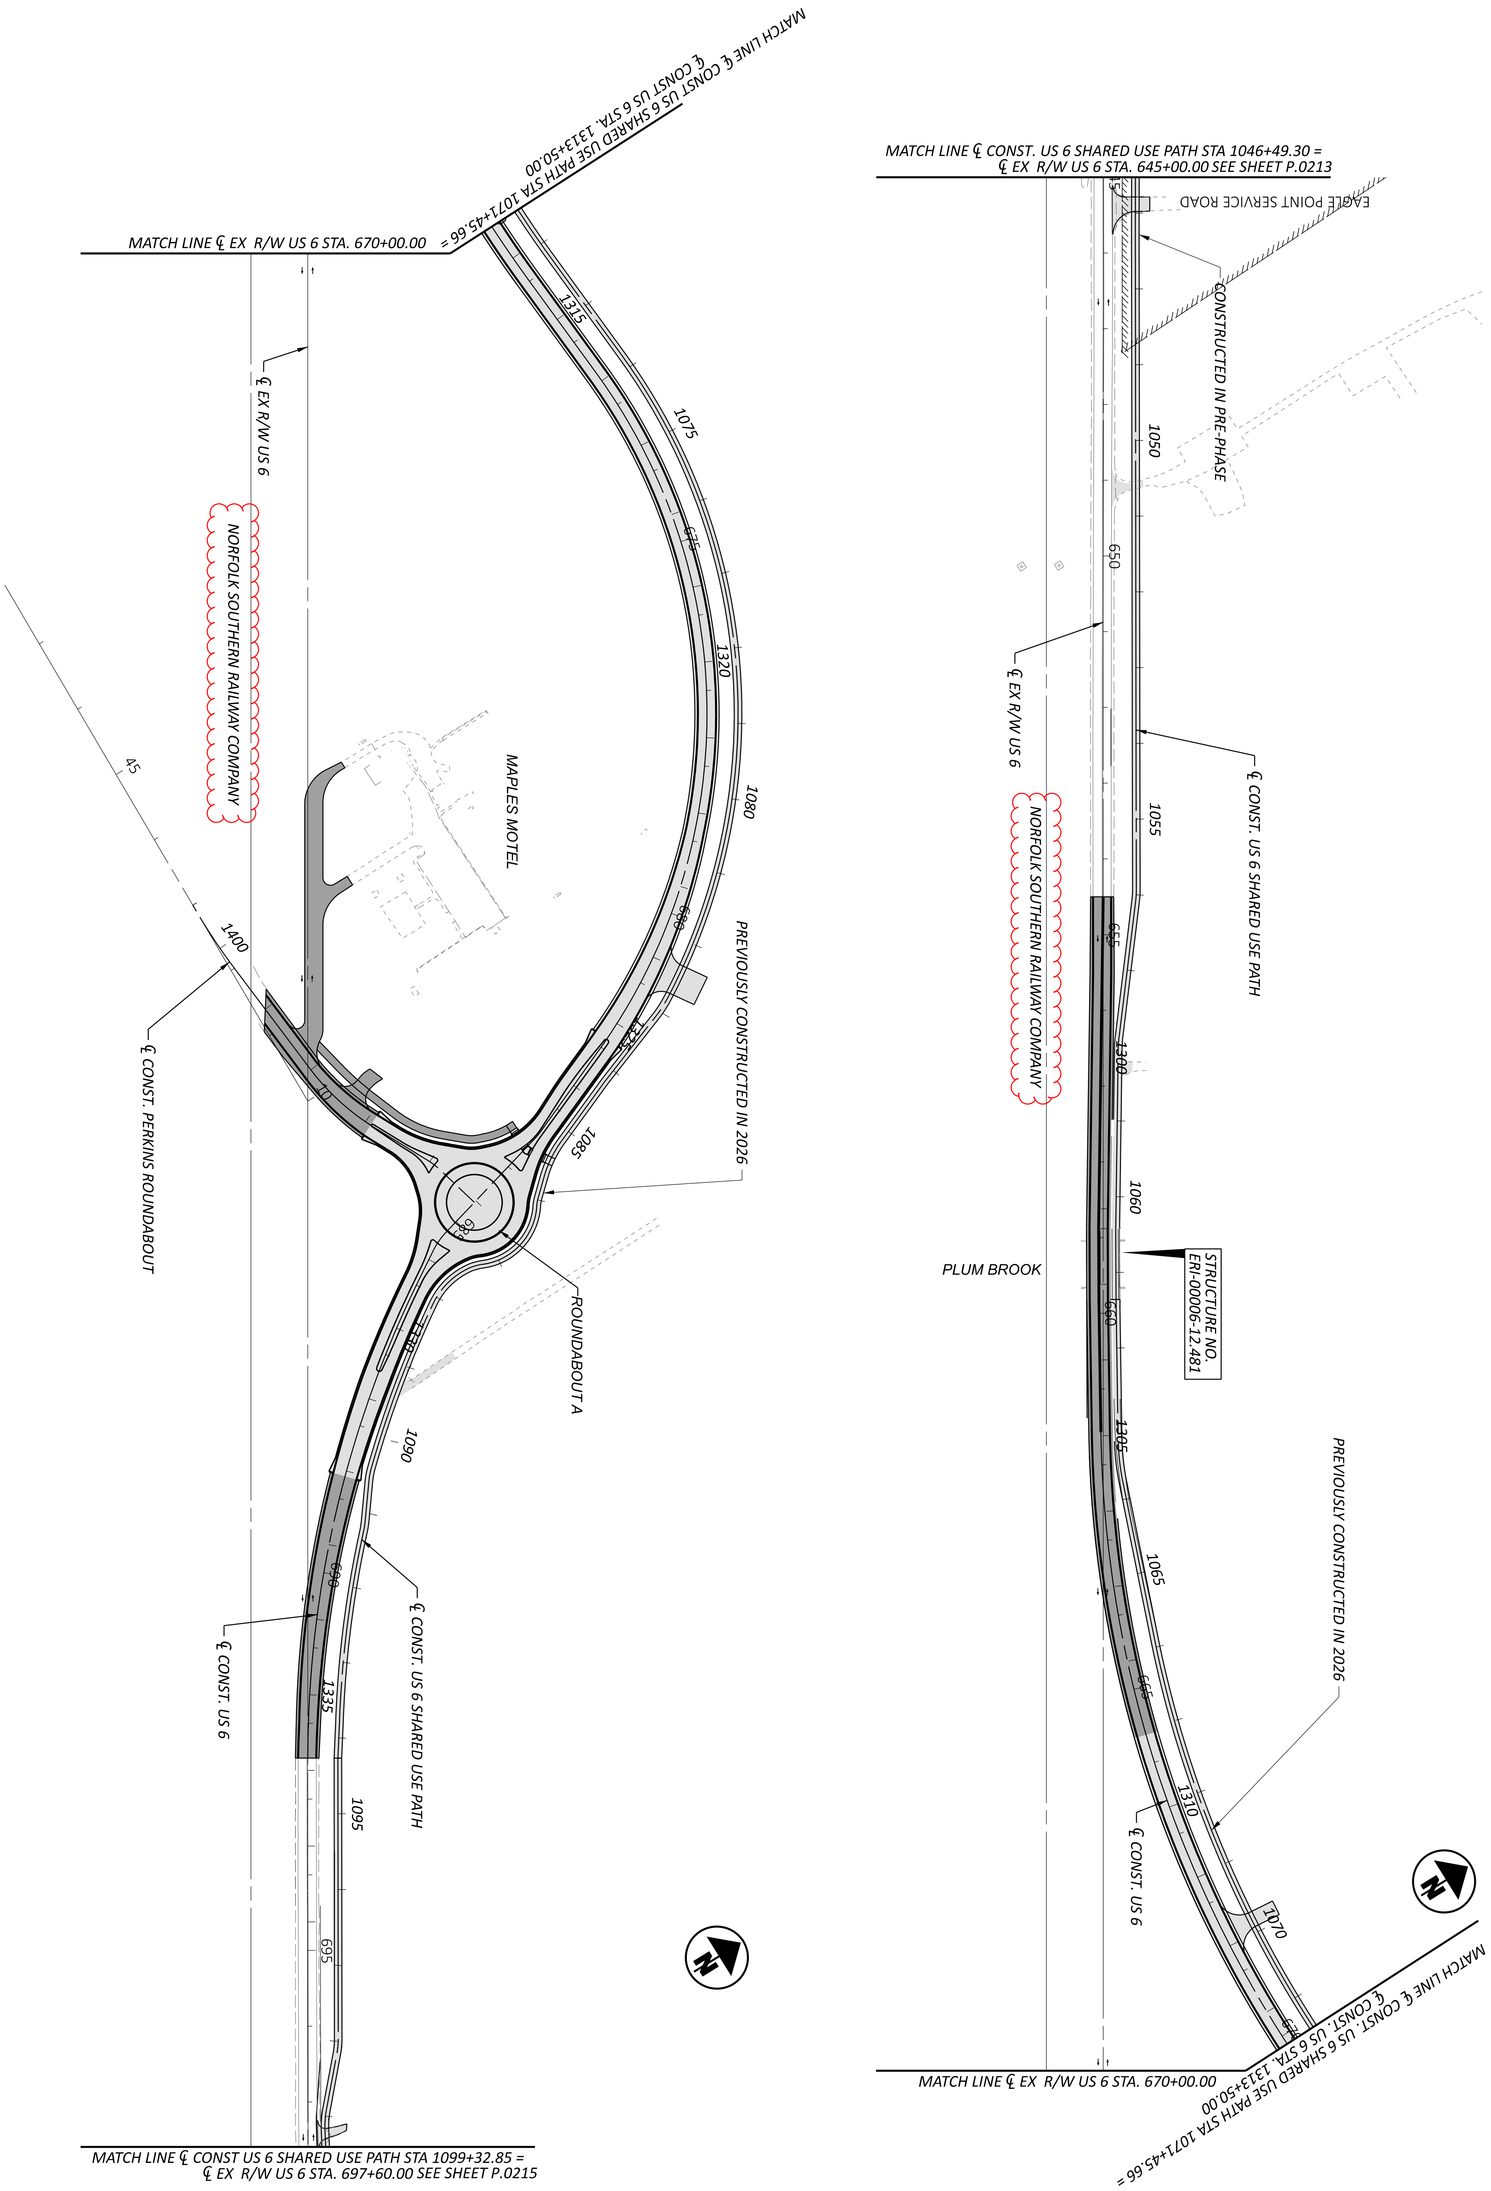


NOTES:
1. FOR MOT OVERALL SCHEMATIC PLAN, SEE SHEET P.0212
2. FOR LEGEND, SEE SHEET P.0084

SHEET P.0219 TOTAL 1106	PROJECT ID 116570	REVIEWER SS 10/27/25	DESIGNER SSA	DESIGN AGENCY TRANSYSTEMS 400 W. NATIONWIDE BLVD., STE 220 COLUMBUS, OHIO 43215

MOT SCHEMATIC PLAN - PHASE 1 (2027/2028 CONSTRUCTION)
US 6 STA 645+00 TO STA 695+00

HORIZONTAL SCALE IN FEET
0 100
50 200

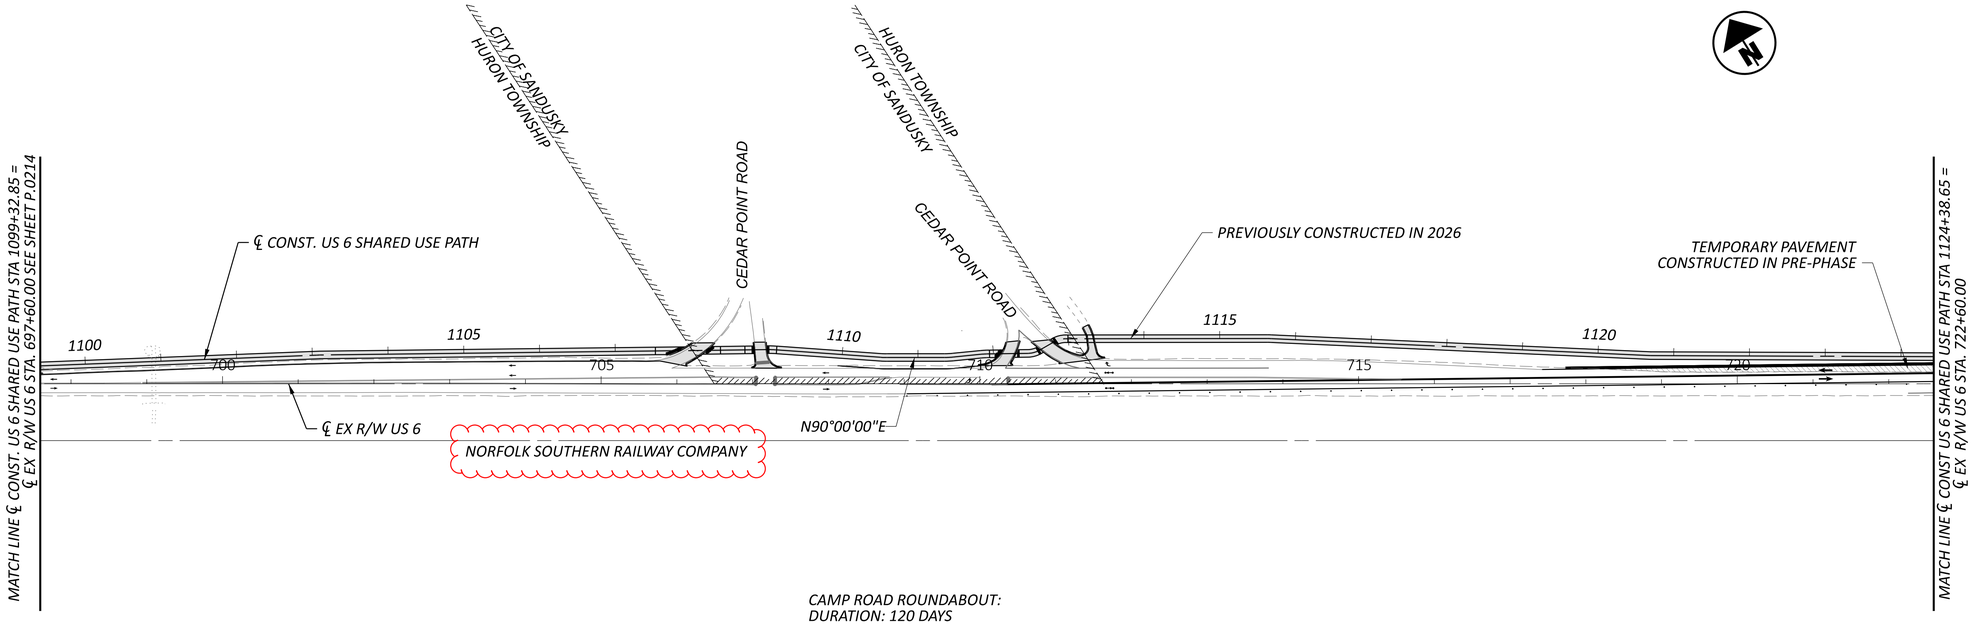

CAMP ROAD ROUNDABOUT:
DURATION: 120 DAYS

1. DETOUR CAMP RD (TR 121) TO US 6


- WEST: HULL TO GALLOWAY TO PERKINS

- EAST: BOOS TO RYE BEACH

2. CONSTRUCT US 6 PORTION OF THE MULTI-LANE ROUNDABOUT IN PHASES WITH THE TWLTL

I. CONSTRUCT TEMPORARY PAVEMENT ON THE NORTH SIDE OF US 6 (FLAGGERS)

II. MAINTAIN TRAFFIC ON TEMPORARY PAVEMENT ON THE NORTH SIDE OF US 6 AND CONSTRUCT THE SOUTH HALF

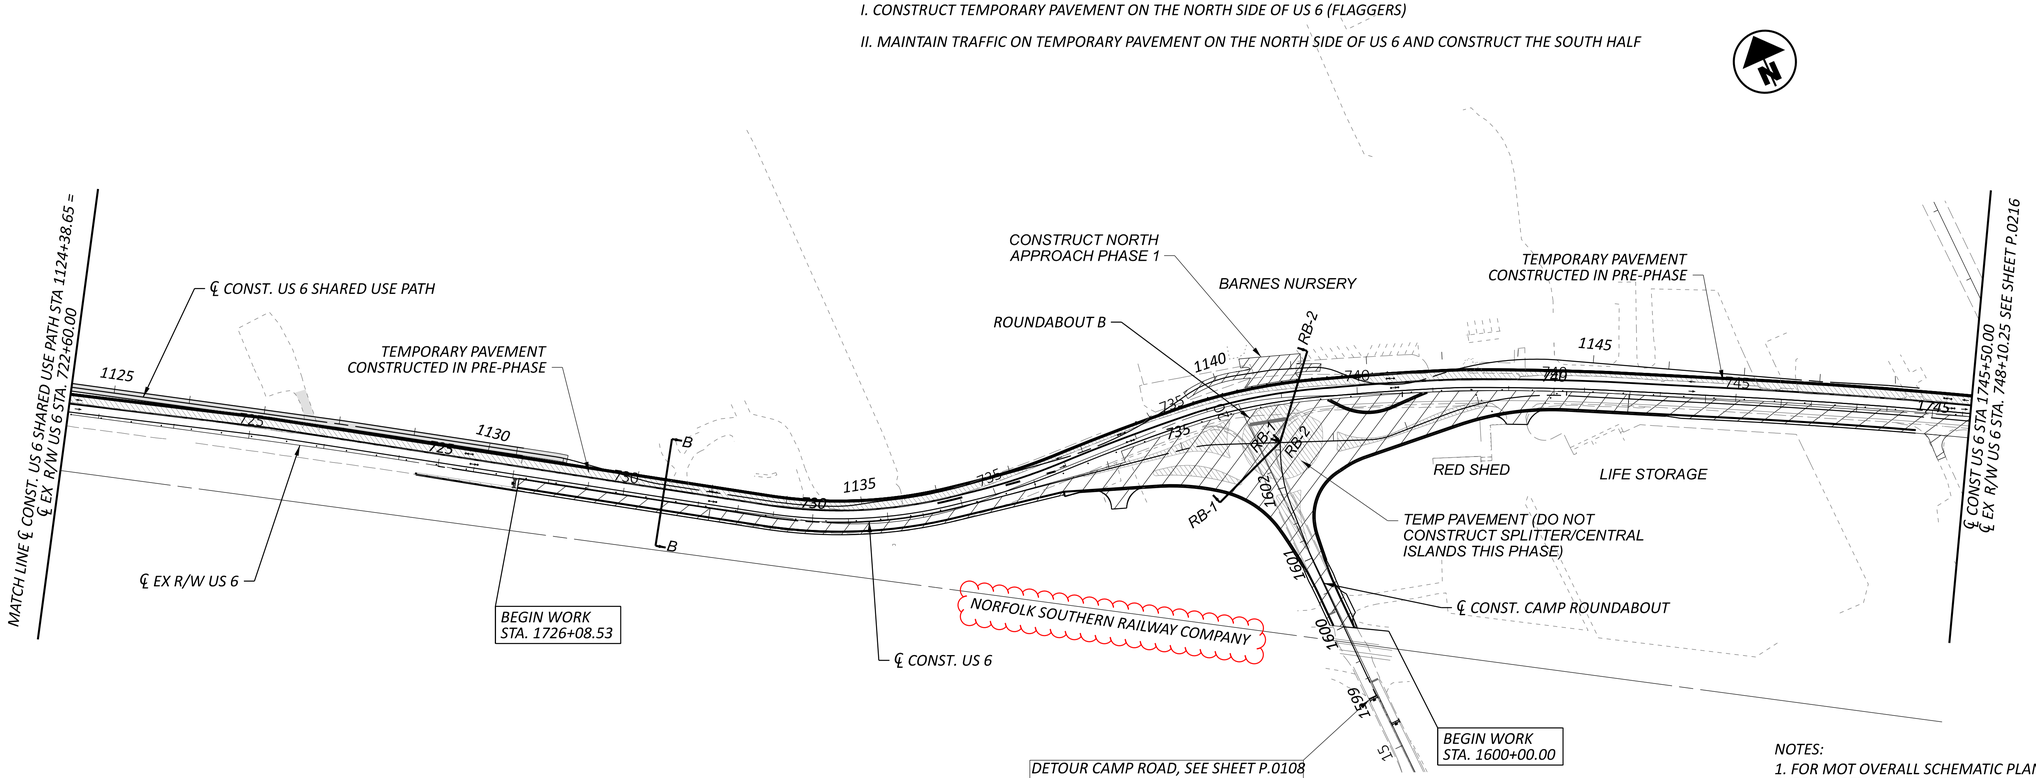

NOTES:
1. FOR MOT OVERALL SCHEMATIC PLAN, SEE SHEET P.0212
2. FOR LEGEND, SEE SHEET P.0084

HORIZONTAL SCALE IN FEET
0 50 100 200


MOT SCHEMATIC PLAN - PHASE 1 (2027/2028 CONSTRUCTION)
US 6 STA 695+00 TO STA 745+50

ERI-US 0006-CONNECTIVITY CORRIDOR

DESIGN AGENCY
TRANSYSTEMS
400 W. NATIONWIDE BLVD., STE 225
COLUMBUS, OHIO 43215

DESIGNER: SSA
REVIEWER: SS 10/27/25
PROJECT ID: 116570
SHEET: P.0220 TOTAL: 1106

MODEL: GB103 [Sheet] PAPERSIZE: 34x22 (in.) DATE: 2/25/2026 TIME: 7:10:11 PM PLTDRV: OHDOT_PDF_Levels.pltcfg PENTBL: OHDOT_Pen.tbl USER: hrthornton@gftinc.com WORKSPACE: OHDOTCEv02 WORKSET: 116570 PRODUCT: OpenRoadsDesigner 24.00.02.25
pw:\\ohiodot-pw.bentley.com:ohiodot-pw-02\Documents\01 Active Projects\District 03\Erie\116570\402-Engineering_TranSystems\MOT\Sheets\116570_MB004_CV2027.dgn

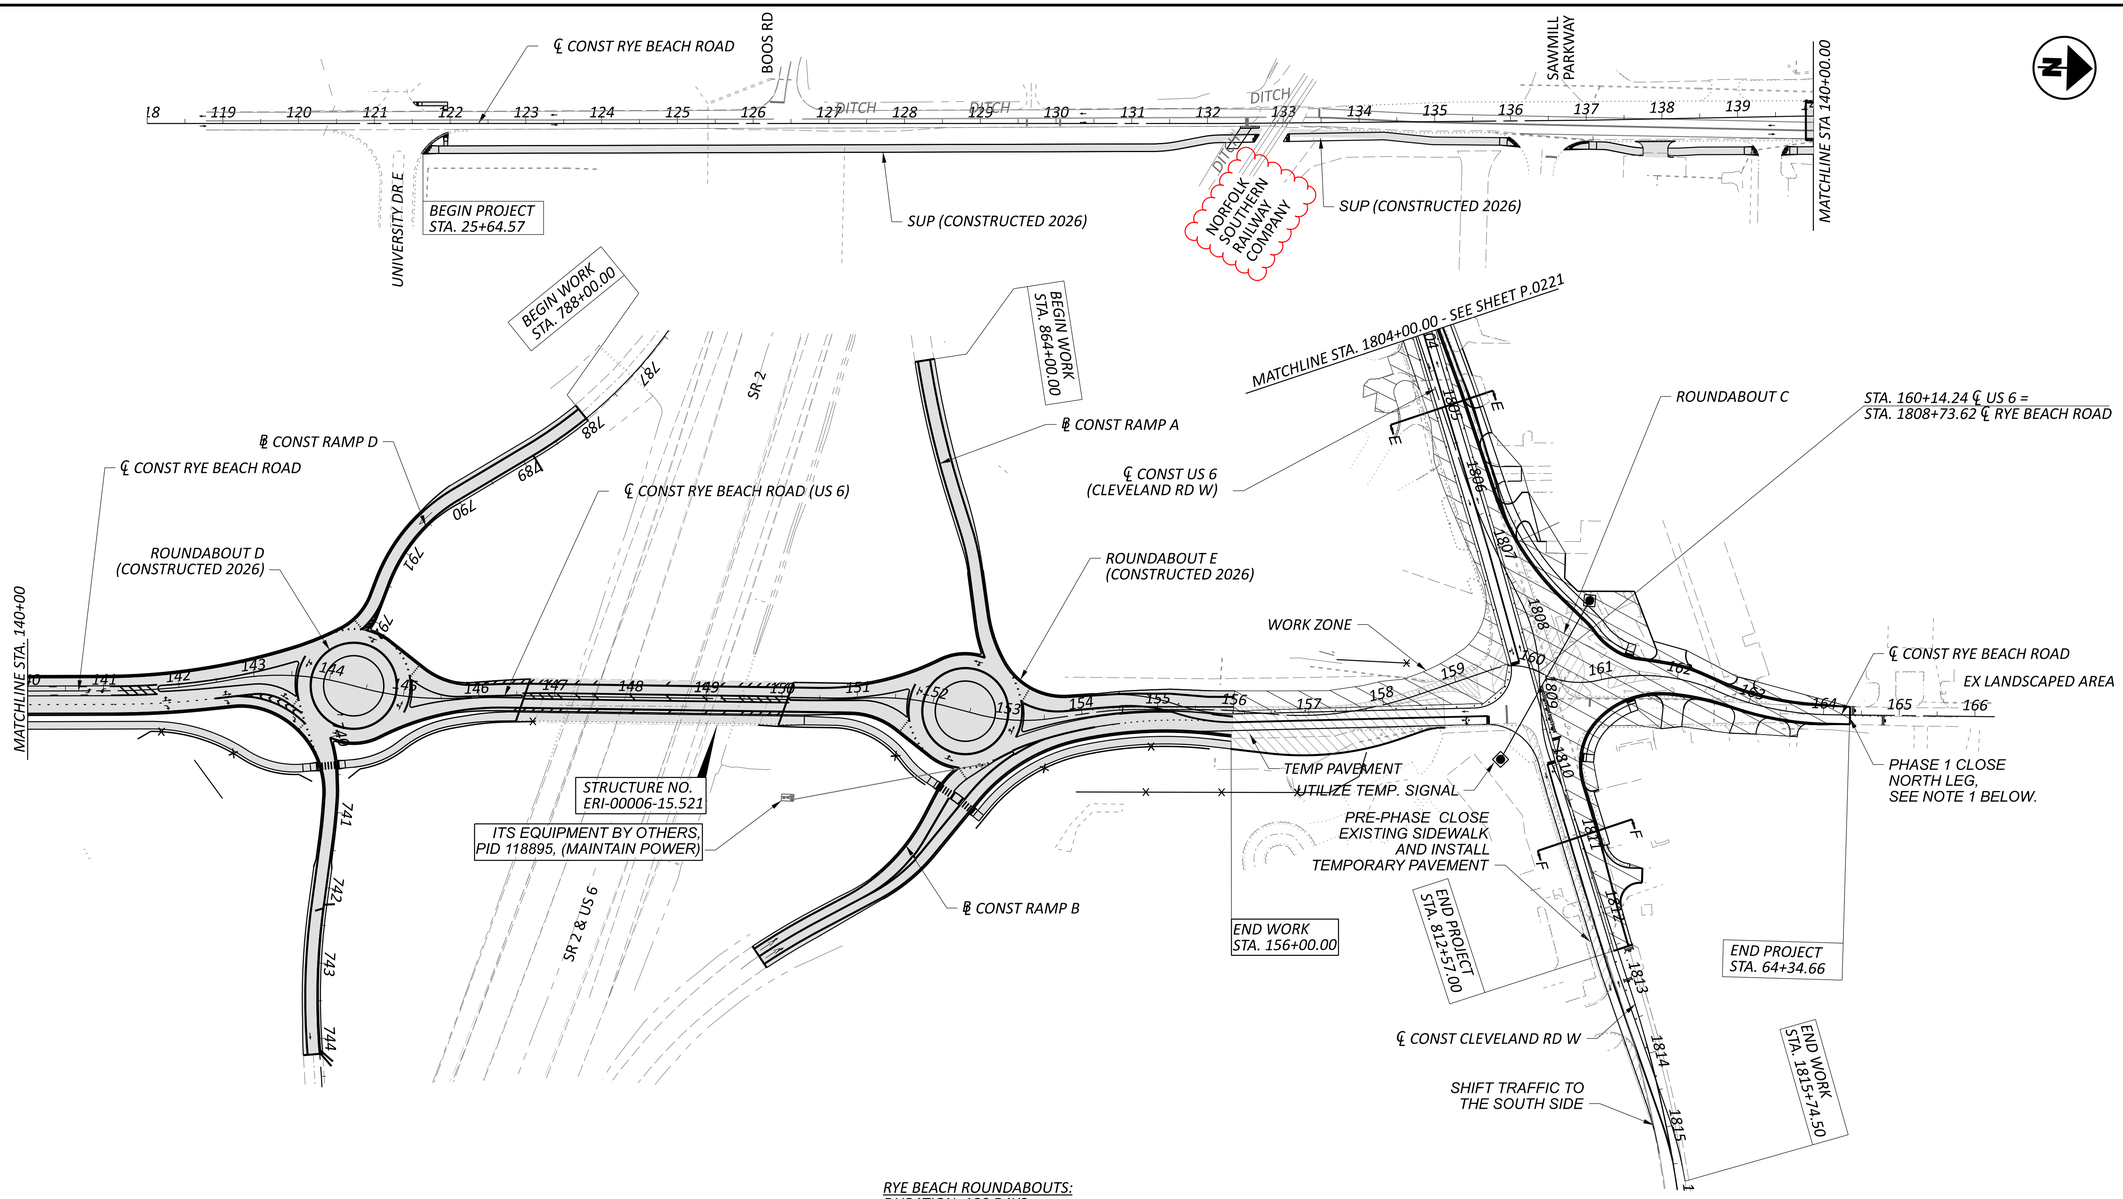

HORIZONTAL SCALE IN FEET
0 50 100 200

MOT SCHEMATIC PLAN - PHASE 1 (2027/2028 CONSTRUCTION)
RYE BEACH ROAD STA 118+00.00 TO STA 166+00.00

RYE BEACH INTERCHANGE:
DURATION: 180 DAYS
CEDAR POINT: NO EAST SIDE ROAD CLOSURES ON US 6 DURING TOURIST SEASON IN JUNE - OCTOBER

PERFORM THESE PHASES WITH CORRESPONDING PHASES AT THE RYE BEACH/US 6 INTERSECTION:

PHASE 1. SHIFT ONE LANE OF TRAFFIC EACH DIRECTION TO THE EAST SIDE OF RYE BEACH RD AND CONSTRUCT THE WEST SIDE. CLOSE AND DETOUR THE RAMPS ON THE WEST SIDE OF THE INTERCHANGE (THESE CLOSURES CAN BE DONE ANYTIME)

- WB ENTRANCE: SR 2 EB TO SR 13 NB TO SR 2 WB

- EB EXIT: SR 2 EB TO SR 13 NB TO SR 2 WB TO RYE BEACH RD

RYE BEACH ROUNDABOUTS:
DURATION: 180 DAYS
CEDAR POINT: NO ROAD CLOSURES ON US 6 DURING TOURIST SEASON IN JUNE - OCTOBER

PRE-PHASE:

CONSTRUCT EMBANKMENT AND GRADING WITH MINIMAL IMPACTS TO EXISTING TRAFFIC

PHASE 1. CLOSE THE CLEVELAND RD AND RYE BEACH NORTH LEG OF THE INTERSECTION EXCEPT TO LOCAL BUSINESSES/RESIDENCES

- CLEVELAND RD: CENTER STREET TO US 6 WB TO RYE BEACH RD NB. FOR DETOUR PLAN, SEE SHEET P.0110

- RYE BEACH RD: SAND DR TO ATWOOD PL THEN FOLLOW CLEVELAND RD DETOUR. FOR DETOUR PLAN, SEE SHEET P.0110


NOTES:
1. FOR MOT OVERALL SCHEMATIC PLAN, SEE SHEET P.0217
2. FOR LEGEND, SEE SHEET P.0085

ERI-US 0006-CONNECTIVITY CORRIDOR

MODEL: 100 Scale 2 PAPERSIZE: 34x22 (in.) DATE: 2/26/2026 TIME: 11:54:02 AM PLTDRV: OHDOT_PDF_Levels.pltcfg PENTBL: OHDOT_Pen.tbl USER: hrthornton@gftinc.com WORKSPACE: OHDOTCEv02 WORKSET: 116570 PRODUCT: OpenRoadsDesigner 24.00.02.25
pw:\\ohiodot-pw.bentley.com:ohiodot-pw-02\Documents\01 Active Projects\District 03\Erie\116570\d02-Engineering_TranSystems\MOT\Sheets\116570_MB003_CY2027.dgn

DESIGN AGENCY
TRANSYSTEMS
400 W. NATIONWIDE BLVD., STE 225
COLUMBUS, OHIO 43215

DESIGNER	
SSA	
REVIEWER	
SS	10/27/25
PROJECT ID	
116570	
SHEET	TOTAL
P.0222	1106

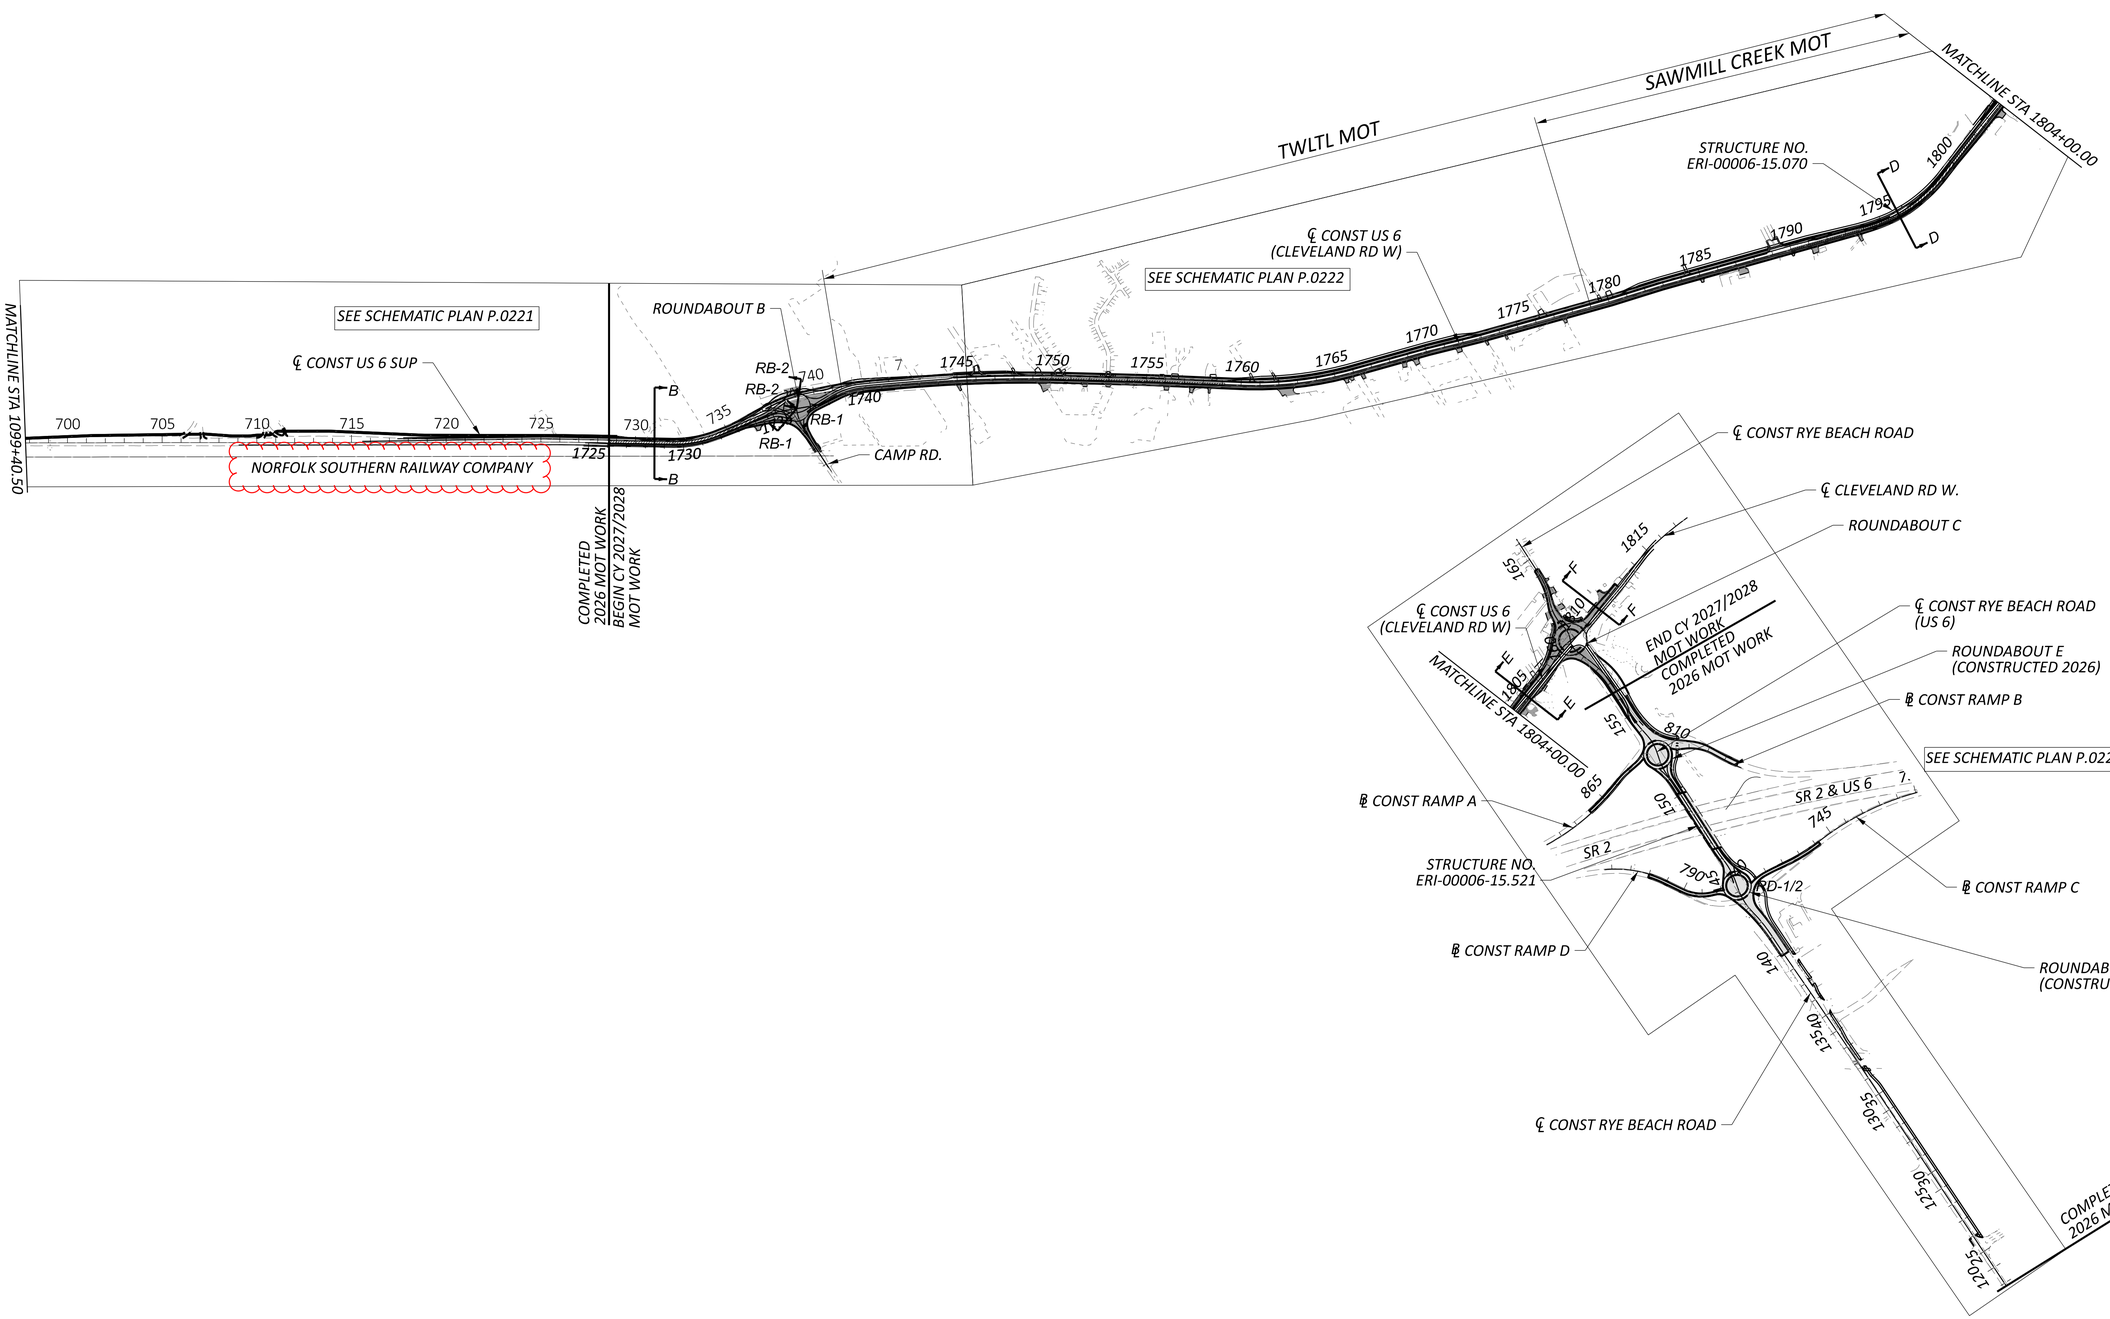

MOT OVERALL SCHEMATIC PLAN - PHASE 2 (2027/2028 CONSTRUCTION)

ERI-US 0006-CONNECTIVITY CORRIDOR


MODEL: 400 Scale PAPERSIZE: 34x22 (in.) DATE: 2/25/2026 TIME: 7:30:06 PM PLTDRV: OHDOT_PDF_Levels.pltcfg PENTBL: OHDOT_Pen.tbl USER: hrthornton@gftinc.com WORKSPACE: OHDOTCEv02 WORKSET: 116570 PRODUCT: OpenRoadsDesigner 24.00.02.25
pw:\\ohiodot-pw.bentley.com:ohiodot-pw-02\Documents\01 Active Projects\District 03\Erie\116570\402-Engineering_TranSystems\MOT\Sheets\116570_MB005_CY2027.dgn

DESIGN AGENCY
TRANSYSTEMS
400 W. NATIONWIDE BLVD., STE 225
COLUMBUS, OHIO 43215

DESIGNER: SSA
REVIEWER: SS 10/27/25
PROJECT ID: 116570
SHEET: P.0223 TOTAL: 1106

ERI-US 0006-CONNECTIVITY CORRIDOR

MODEL: GB101 [Sheet] PAPERSIZE: 34x22 (in.) DATE: 2/26/2026 TIME: 8:56:47 AM PLTDRV: OHDOT_PDF_Levels.pltcfg PENTBL: OHDOT_Pen.tbl USER: hrthornton@gftinc.com WORKSPACE: OHDOTCEv02 WORKSET: 116570 PRODUCT: OpenRoadsDesigner 24.00.02.25
pw:\\ohiodot-pw.bentley.com:ohiodot-pw-02\Documents\01 Active Projects\District 03\Erie\116570\402-Engineering_TranSystems\MOT\Sheets\116570_MB006_CY2027.dgn

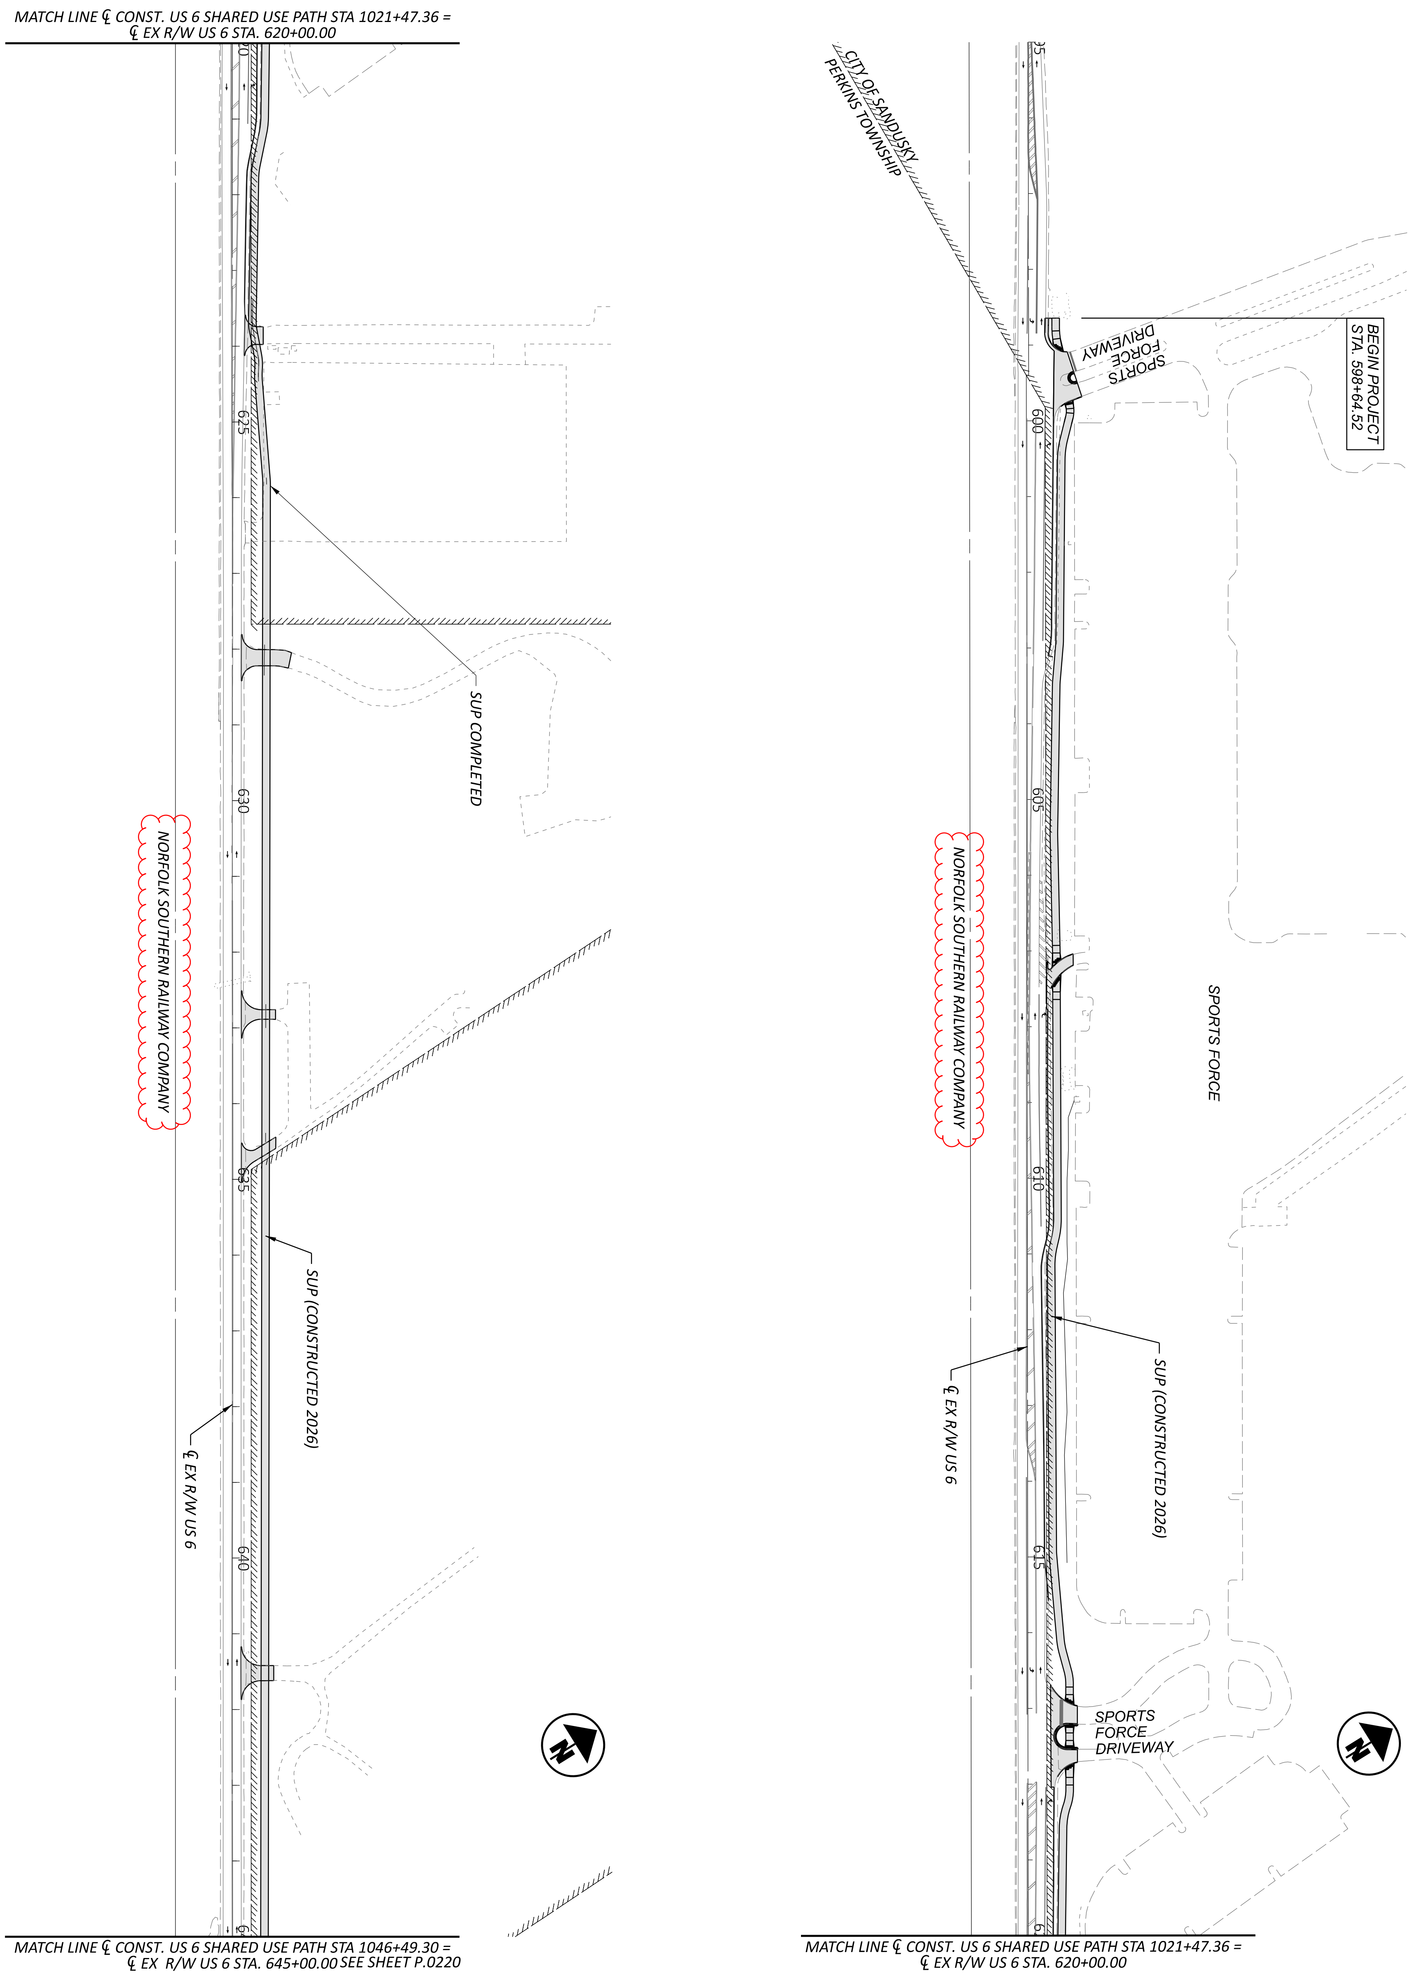

NOTES:
1. FOR MOT OVERALL SCHEMATIC PLAN, SEE SHEET P.0218
2. FOR LEGEND, SEE SHEET P.0084


SHEET	TOTAL	PROJECT ID	REVIEWER	DESIGNER	DESIGN AGENCY
P.0224	1106	116570	SS 10/27/25	SSA	TRANSYSTEMS 400 W. NATIONWIDE BLVD., STE 220 COLUMBUS, OHIO 43215

MOT SCHEMATIC PLAN - PHASE 2 (2027/2028 CONSTRUCTION)
US 6 BEGIN PROJECT TO STA 645+00

HORIZONTAL SCALE IN FEET
0 100
50 200

ERI-US 0006-CONNECTIVITY CORRIDOR

MODEL: GB102 [Sheet] PAPERSIZE: 34x22 (in.) DATE: 2/26/2026 TIME: 9:00:05 AM PLTDRV: OHDOT_PDF_Levels.pltcfg PENTBL: OHDOT_Pen.tbl USER: hrthornton@gftinc.com WORKSPACE: OHDOTCEv02 WORKSET: 116570 PRODUCT: OpenRoadsDesigner 24.00.02.25
pw:\\ohiodot-pw.bentley.com:ohiodot-pw-02\Documents\01 Active Projects\District 03\Erie\116570\402-Engineering_TranSystems\MOT\Sheets\116570_MB006_CY2027.dgn

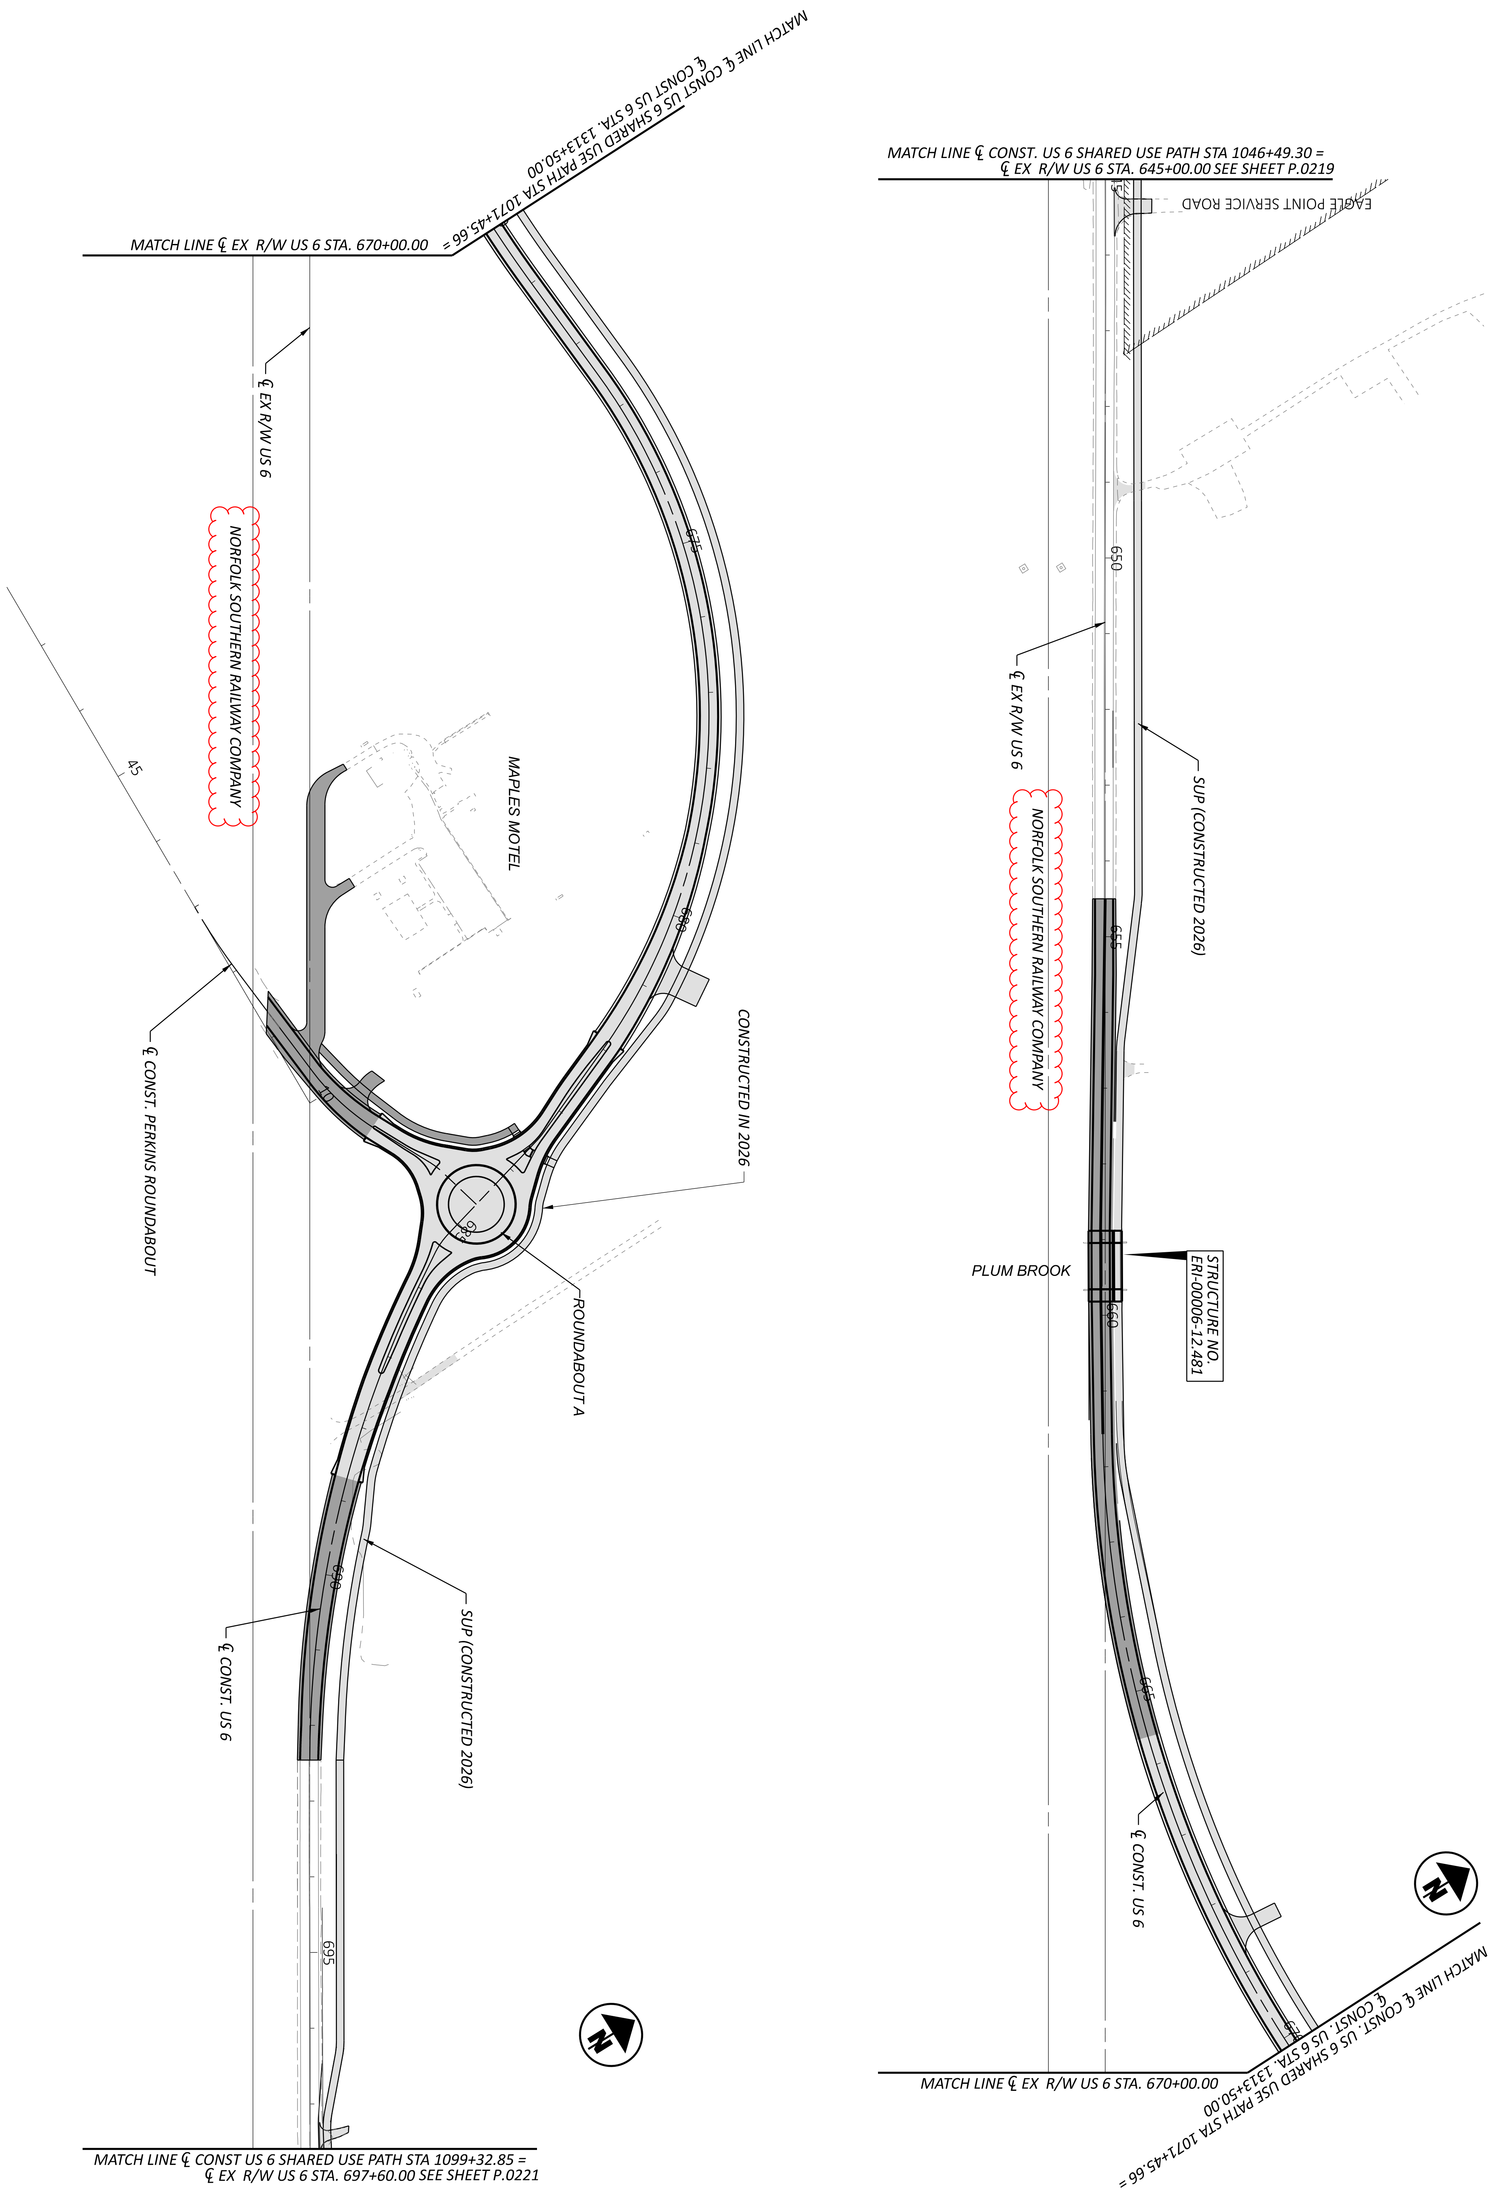

NOTES:
1. FOR MOT OVERALL SCHEMATIC PLAN, SEE SHEET P.0218
2. FOR LEGEND, SEE SHEET P.0084

SHEET	TOTAL
P 0225	1106

PROJECT ID: 116570

REVIEWER: SS 10/27/25

DESIGNER: SSA


TRANSYSTEMS
400 W. NATIONWIDE BLVD., STE 220
COLUMBUS, OHIO 43215
DESIGN AGENCY

MOT SCHEMATIC PLAN - PHASE 2 (2027/2028 CONSTRUCTION)
US 6 STA 645+00 TO STA 695+00

HORIZONTAL SCALE IN FEET
0 100
50 200

ERI-US 0006-CONNECTIVITY CORRIDOR

MODEL: GB103 [Sheet] PAPERSIZE: 34x22 (in.) DATE: 2/26/2026 TIME: 9:02:18 AM PLTDRV: OHDOT_PDF_Levels.pltcfg PENTBL: OHDOT_Pen.tbl USER: hrthornton@gftinc.com WORKSPACE: OHDOTCEv02 WORKSET: 116570 PRODUCT: OpenRoadsDesigner 24.00.02.25
pw:\\ohiodot-pw.bentley.com:ohiodot-pw-02\Documents\01 Active Projects\District 03\Erie\116570\402-Engineering_TranSystems\MOT\Sheets\116570_MB006_CY2027.dgn

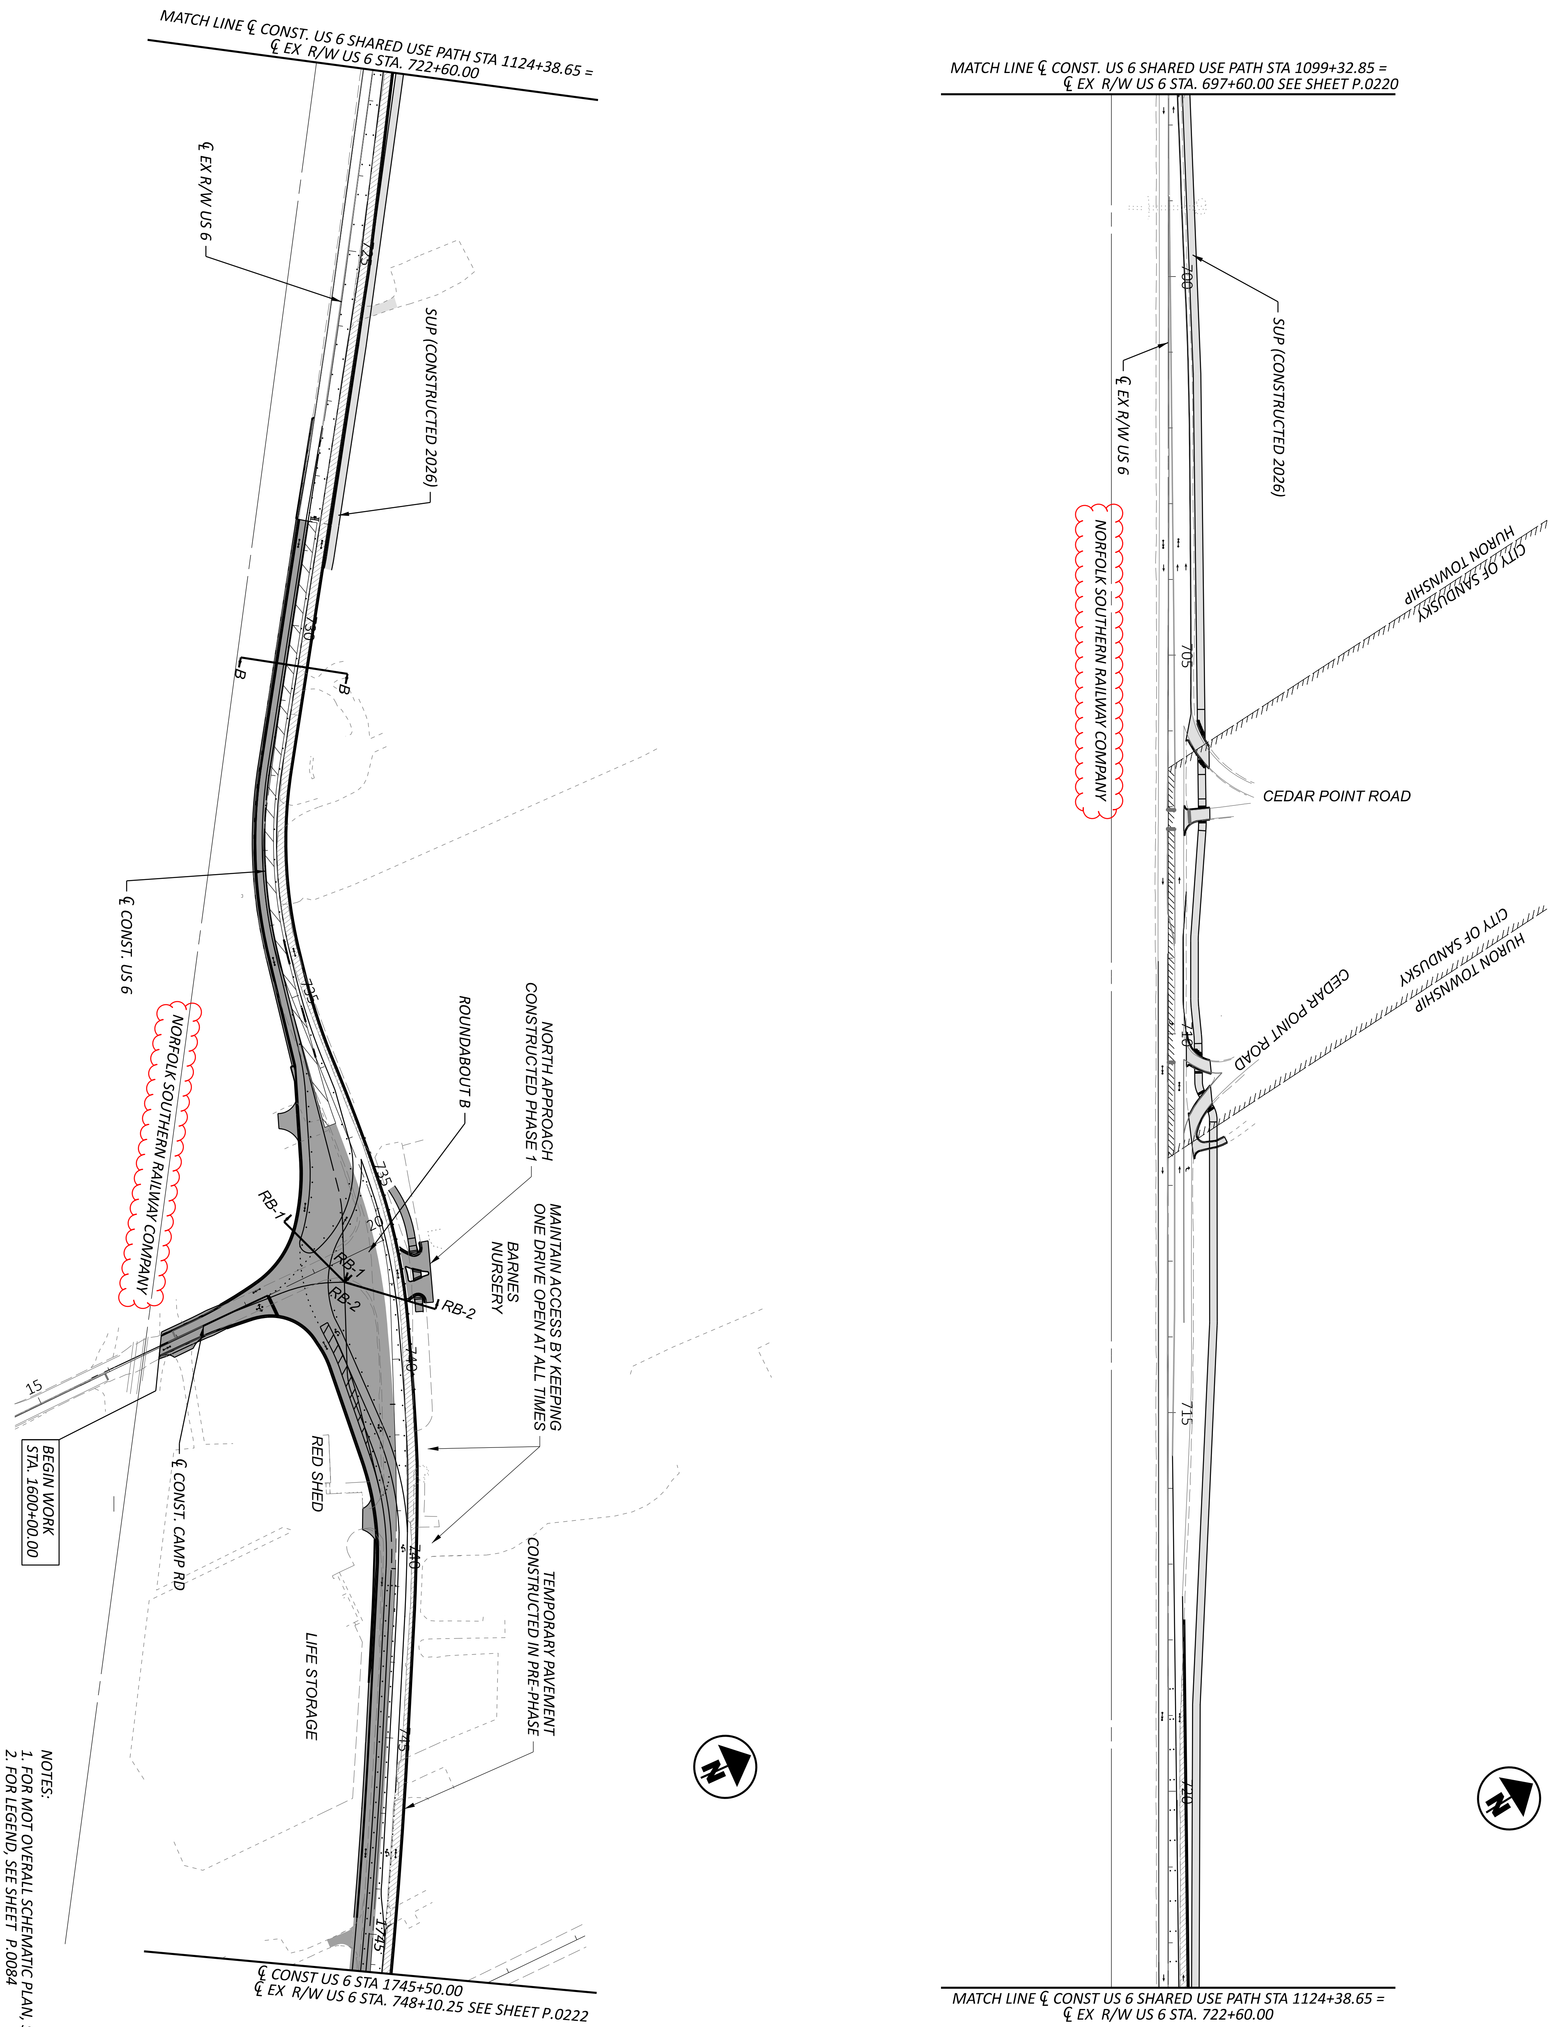


NOTES:
1. FOR MOT OVERALL SCHEMATIC PLAN, SEE SHEET P.0218
2. FOR LEGEND, SEE SHEET P.0084

SHEET	TOTAL	PROJECT ID	REVIEWER	DESIGNER	DESIGN AGENCY
P.0226	1106	116570	SS 10/27/25	SSA	TRANSYSTEMS 400 W. NATIONWIDE BLVD., STE 220 COLUMBUS, OHIO 43215

MOT SCHEMATIC PLAN - PHASE 2 (2027/2028 CONSTRUCTION)
US 6 STA 695+00 TO STA 745+50

HORIZONTAL SCALE IN FEET
0 100
50 200

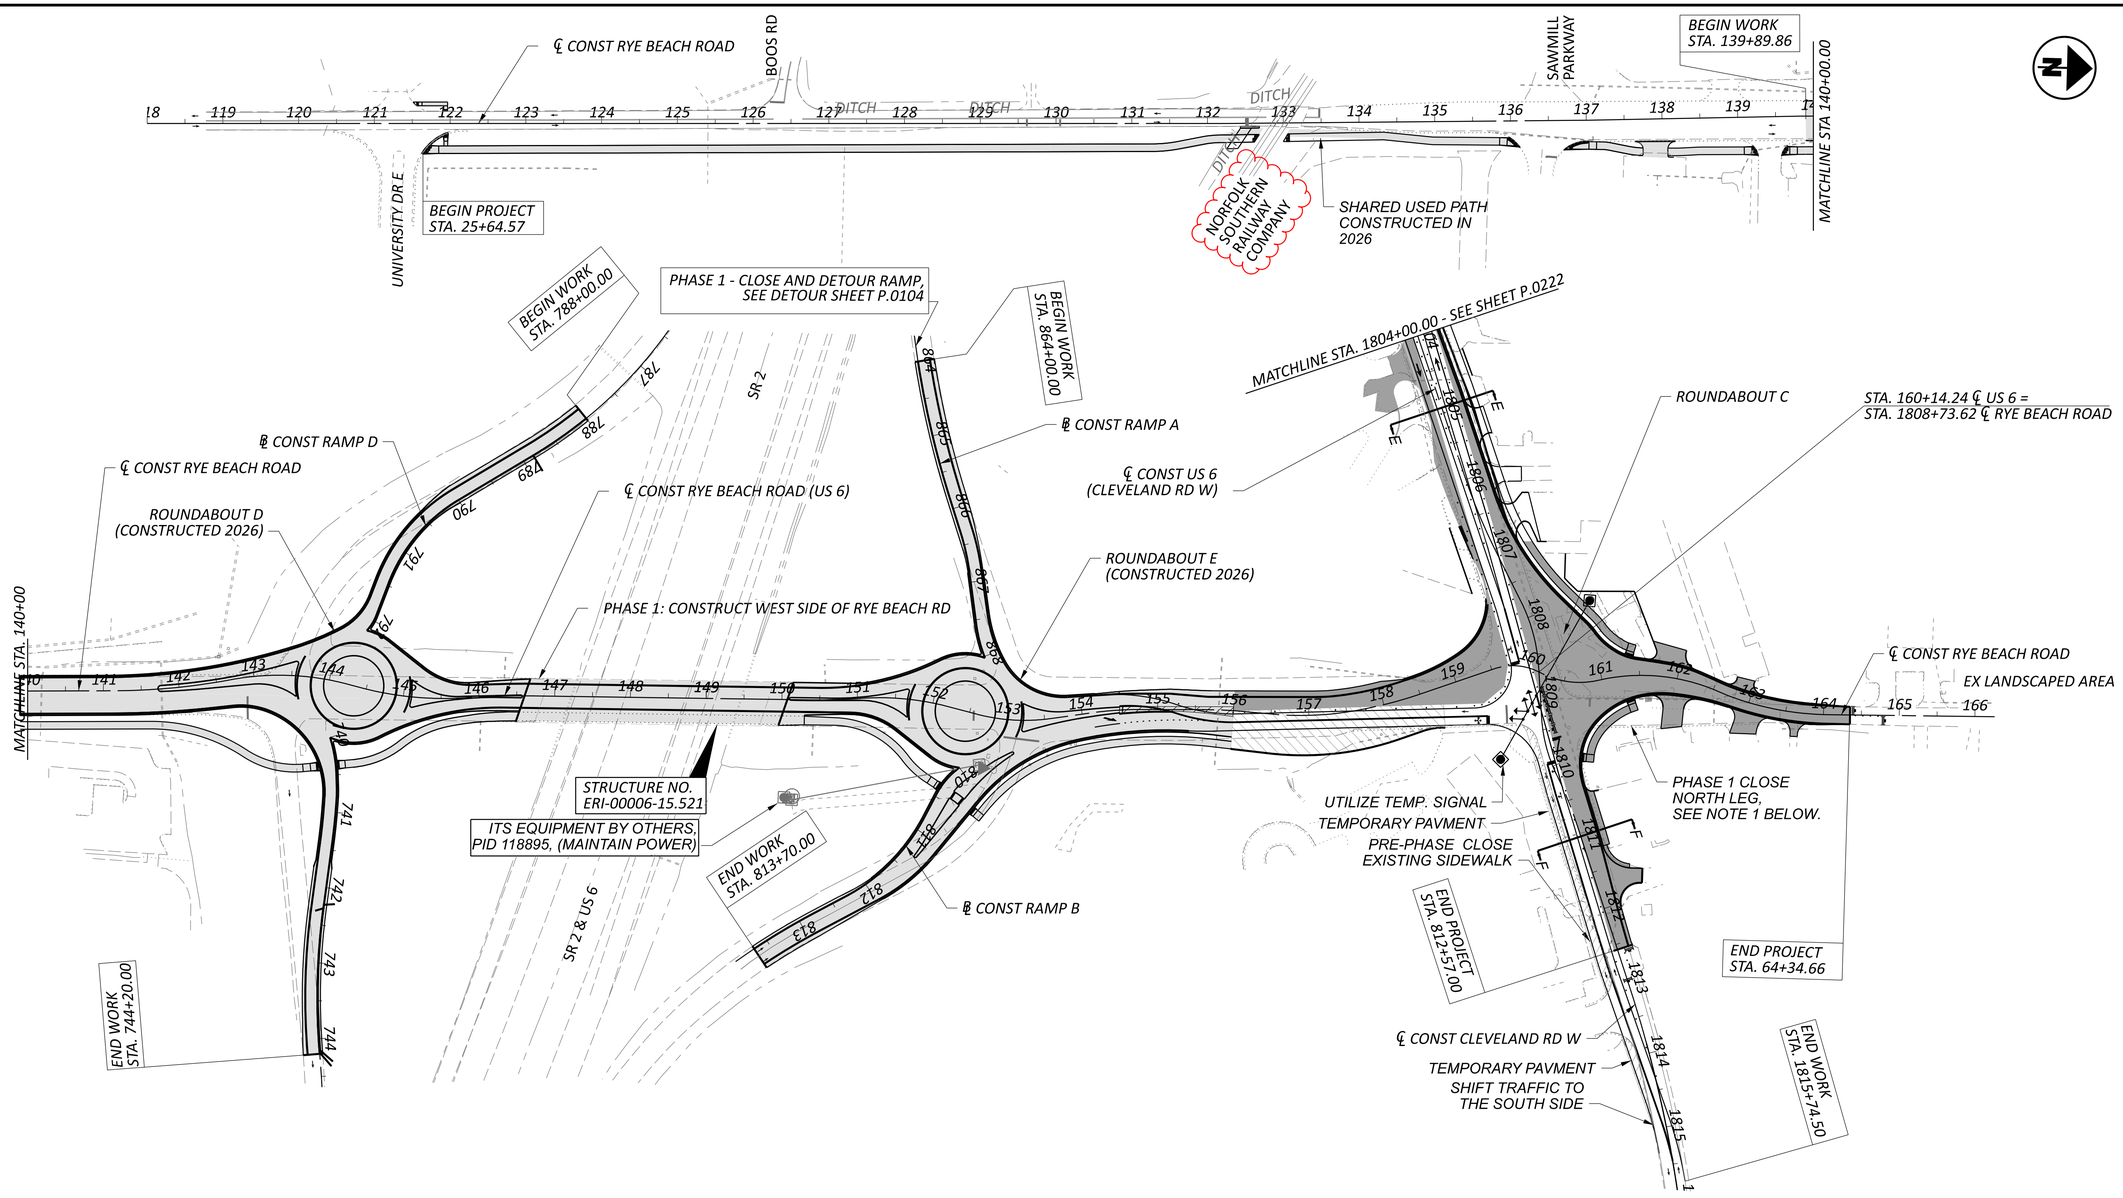

RYE BEACH ROUNDABOUTS:
DURATION: 180 DAYS
CEDAR POINT: NO ROAD CLOSURES ON US 6 DURING TOURIST SEASON IN JUNE - OCTOBER

PHASE 1. CLOSE THE CLEVELAND RD OF THE US-6 INTERSECTION EXCEPT TO LOCAL BUSINESSES/RESIDENCES

- CLEVELAND RD: CENTER STREET TO US 6 WB TO RYE BEACH RD NB. FOR DETOUR PLAN, SEE SHEET P.0109

- RYE BEACH RD: SAND DR TO ATWOOD PL THEN FOLLOW CLEVELAND RD DETOUR. FOR DETOUR PLAN, SEE SHEET P.0109

NOTES:
1. FOR MOT OVERALL SCHEMATIC PLAN, SEE SHEET P.0091
2. FOR LEGEND, SEE SHEET P.0092

HORIZONTAL SCALE IN FEET
0 50 100 200

MOT SCHEMATIC PLAN - PHASE 2 (2027/2028 CONSTRUCTION)
RYE BEACH ROAD STA 118+00.00 TO STA 166+00.00

DESIGN AGENCY
TRANSYSTEMS
400 W. NATIONWIDE BLVD., STE 225
COLUMBUS, OHIO 43215

DESIGNER: SSA
REVIEWER: SS 10/27/25
PROJECT ID: 116570
SHEET: P.0228 TOTAL: 1106

ERI-US 0006-CONNECTIVITY CORRIDOR

MODEL: 100 Scale 2 PAPERSIZE: 34x22 (in.) DATE: 2/26/2026 TIME: 8:46:35 AM PLTDRV: OHDOT_PDF_Levels.pltcfg PENTBL: OHDOT_Pen.tbl USER: hrthornton@gftinc.com WORKSPACE: OHDOTCEx02 WORKSET: 116570 PRODUCT: OpenRoadsDesigner 24.00.02.25
pw:\\ohiodot-pw.bentley.com:ohiodot-pw-02\Documents\01 Active Projects\District 03\Erie\116570\402 Engineering_TranSystems\MOT\Sheets\116570_MB005_CY2027.dgn

HORIZONTAL SCALE IN FEET
0 200 400 800

MOT OVERALL SCHEMATIC PLAN - PHASE 3 (2027/2028 CONSTRUCTION)


ERI-US 0006-CONNECTIVITY CORRIDOR

MODEL: 400 Scale PAPERSIZE: 34x22 (in.) DATE: 2/26/2026 TIME: 9:09:36 AM PLTDRV: OHDOT_PDF_Levels.pltcfg PENTBL: OHDOT_Pen.tbl USER: hrthornton@gfinc.com WORKSPACE: OHDOTCEx02 WORKSET: 116570 PRODUCT: OpenRoadsDesigner 24.00.02.25
pw:\\ohiodot-pw.bentley.com:ohiodot-pw-02\Documents\01 Active Projects\District 03\Erie\116570\402-Engineering_TranSystems\MOT\Sheets\116570_MB007_CY2027.dgn

DESIGN AGENCY
TRANSYSTEMS
400 W. NATIONWIDE BLVD., STE 205
COLUMBUS, OHIO 43215

DESIGNER SSA
REVIEWER SS 10/27/25
PROJECT ID 116570
SHEET P.0229 TOTAL 1106

MODEL: GB101 [Sheet] PAPERSIZE: 34x22 (in.) DATE: 2/26/2026 TIME: 9:17:25 AM PLTDRV: OHDOT_PDF_Levels.pltcfg PENTBL: OHDOT_Pen.tbl USER: hrthornton@gftinc.com WORKSPACE: OHDOTCEv02 WORKSET: 116570 PRODUCT: OpenRoadsDesigner 24.00.02.25
pw:\\ohiodot-pw.bentley.com:ohiodot-pw-02\Documents\01 Active Projects\District 03\Erie\116570\402-Engineering_TranSystems\MOT\Sheets\116570_MB008_CY2027.dgn

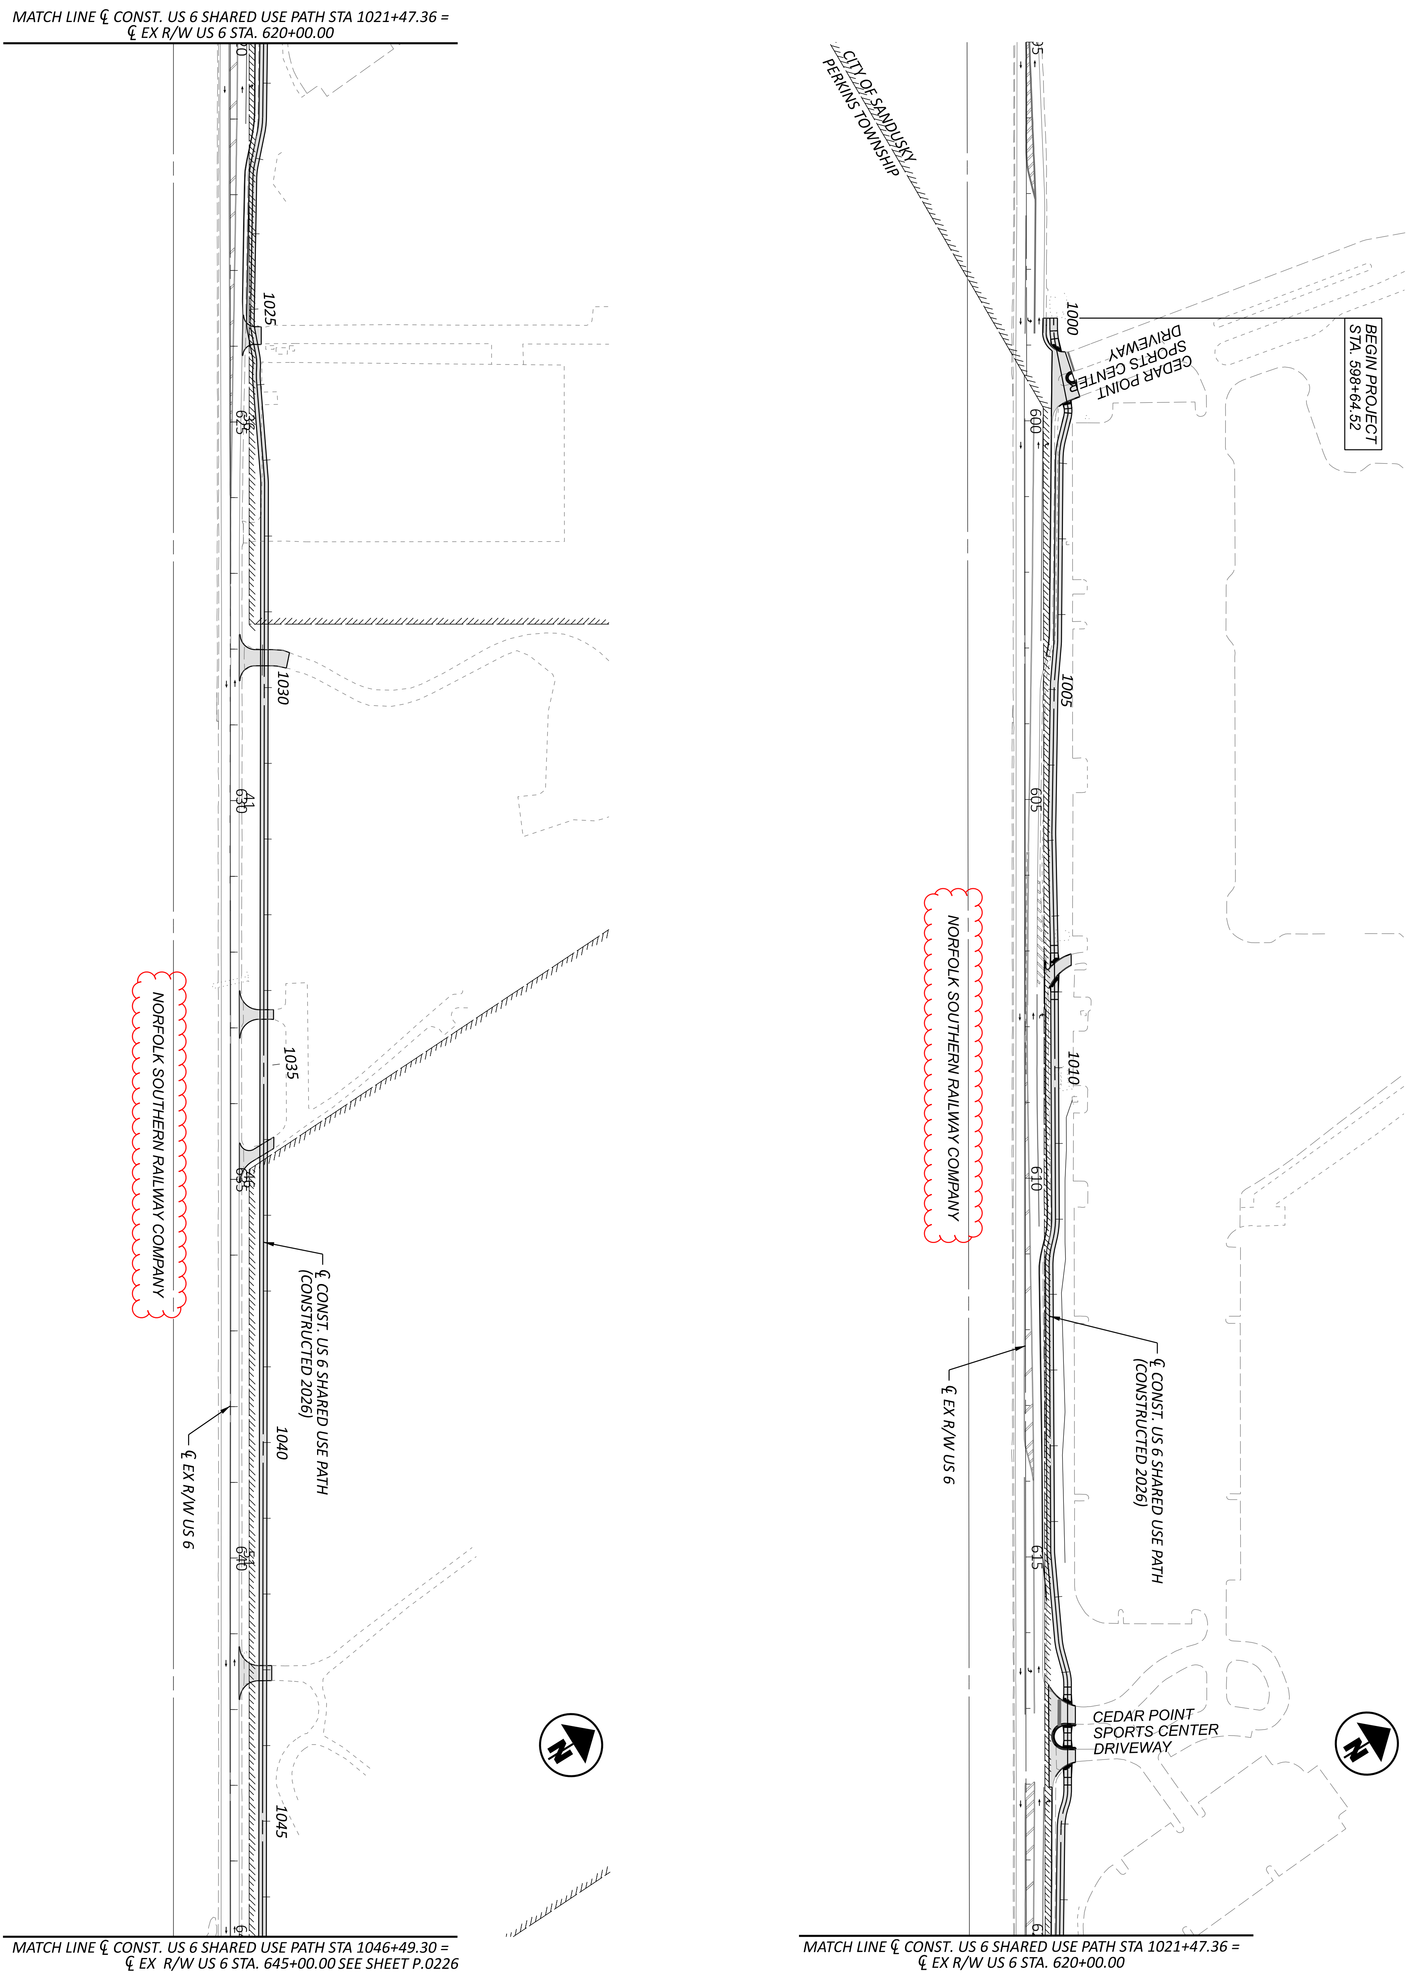

NOTE:
1. FOR MOT OVERALL SCHEMATIC PLAN, SEE SHEET

SHEET	TOTAL
P.0230	1106

PROJECT ID: 116570

REVIEWER: SS 10/27/25

DESIGNER: SSA


DESIGN AGENCY: TRANSYSTEMS
400 W. NATIONWIDE BLVD., STE 220
COLUMBUS, OHIO 43215

MOT SCHEMATIC PLAN - PHASE 3 (2027/2028 CONSTRUCTION)
US 6 BEGIN PROJECT TO STA 645+00

HORIZONTAL SCALE IN FEET
0 100
50 200

ERI-US 0006-CONNECTIVITY CORRIDOR

MODEL: GB102 [Sheet] PAPERSIZE: 34x22 (in.) DATE: 2/26/2026 TIME: 9:20:46 AM PLTDRV: OHDOT_PDF_Levels.pltcfg PENTBL: OHDOT_Pen.tbl USER: hrthornton@gftinc.com WORKSPACE: OHDOTCEv02 WORKSET: 116570 PRODUCT: OpenRoadsDesigner 24.00.02.25
pw:\\ohiodot-pw.bentley.com:ohiodot-pw-02\Documents\01 Active Projects\District 03\Erie\116570\402-Engineering_TranSystems\MOT\Sheets\116570_MB008_CY2027.dgn

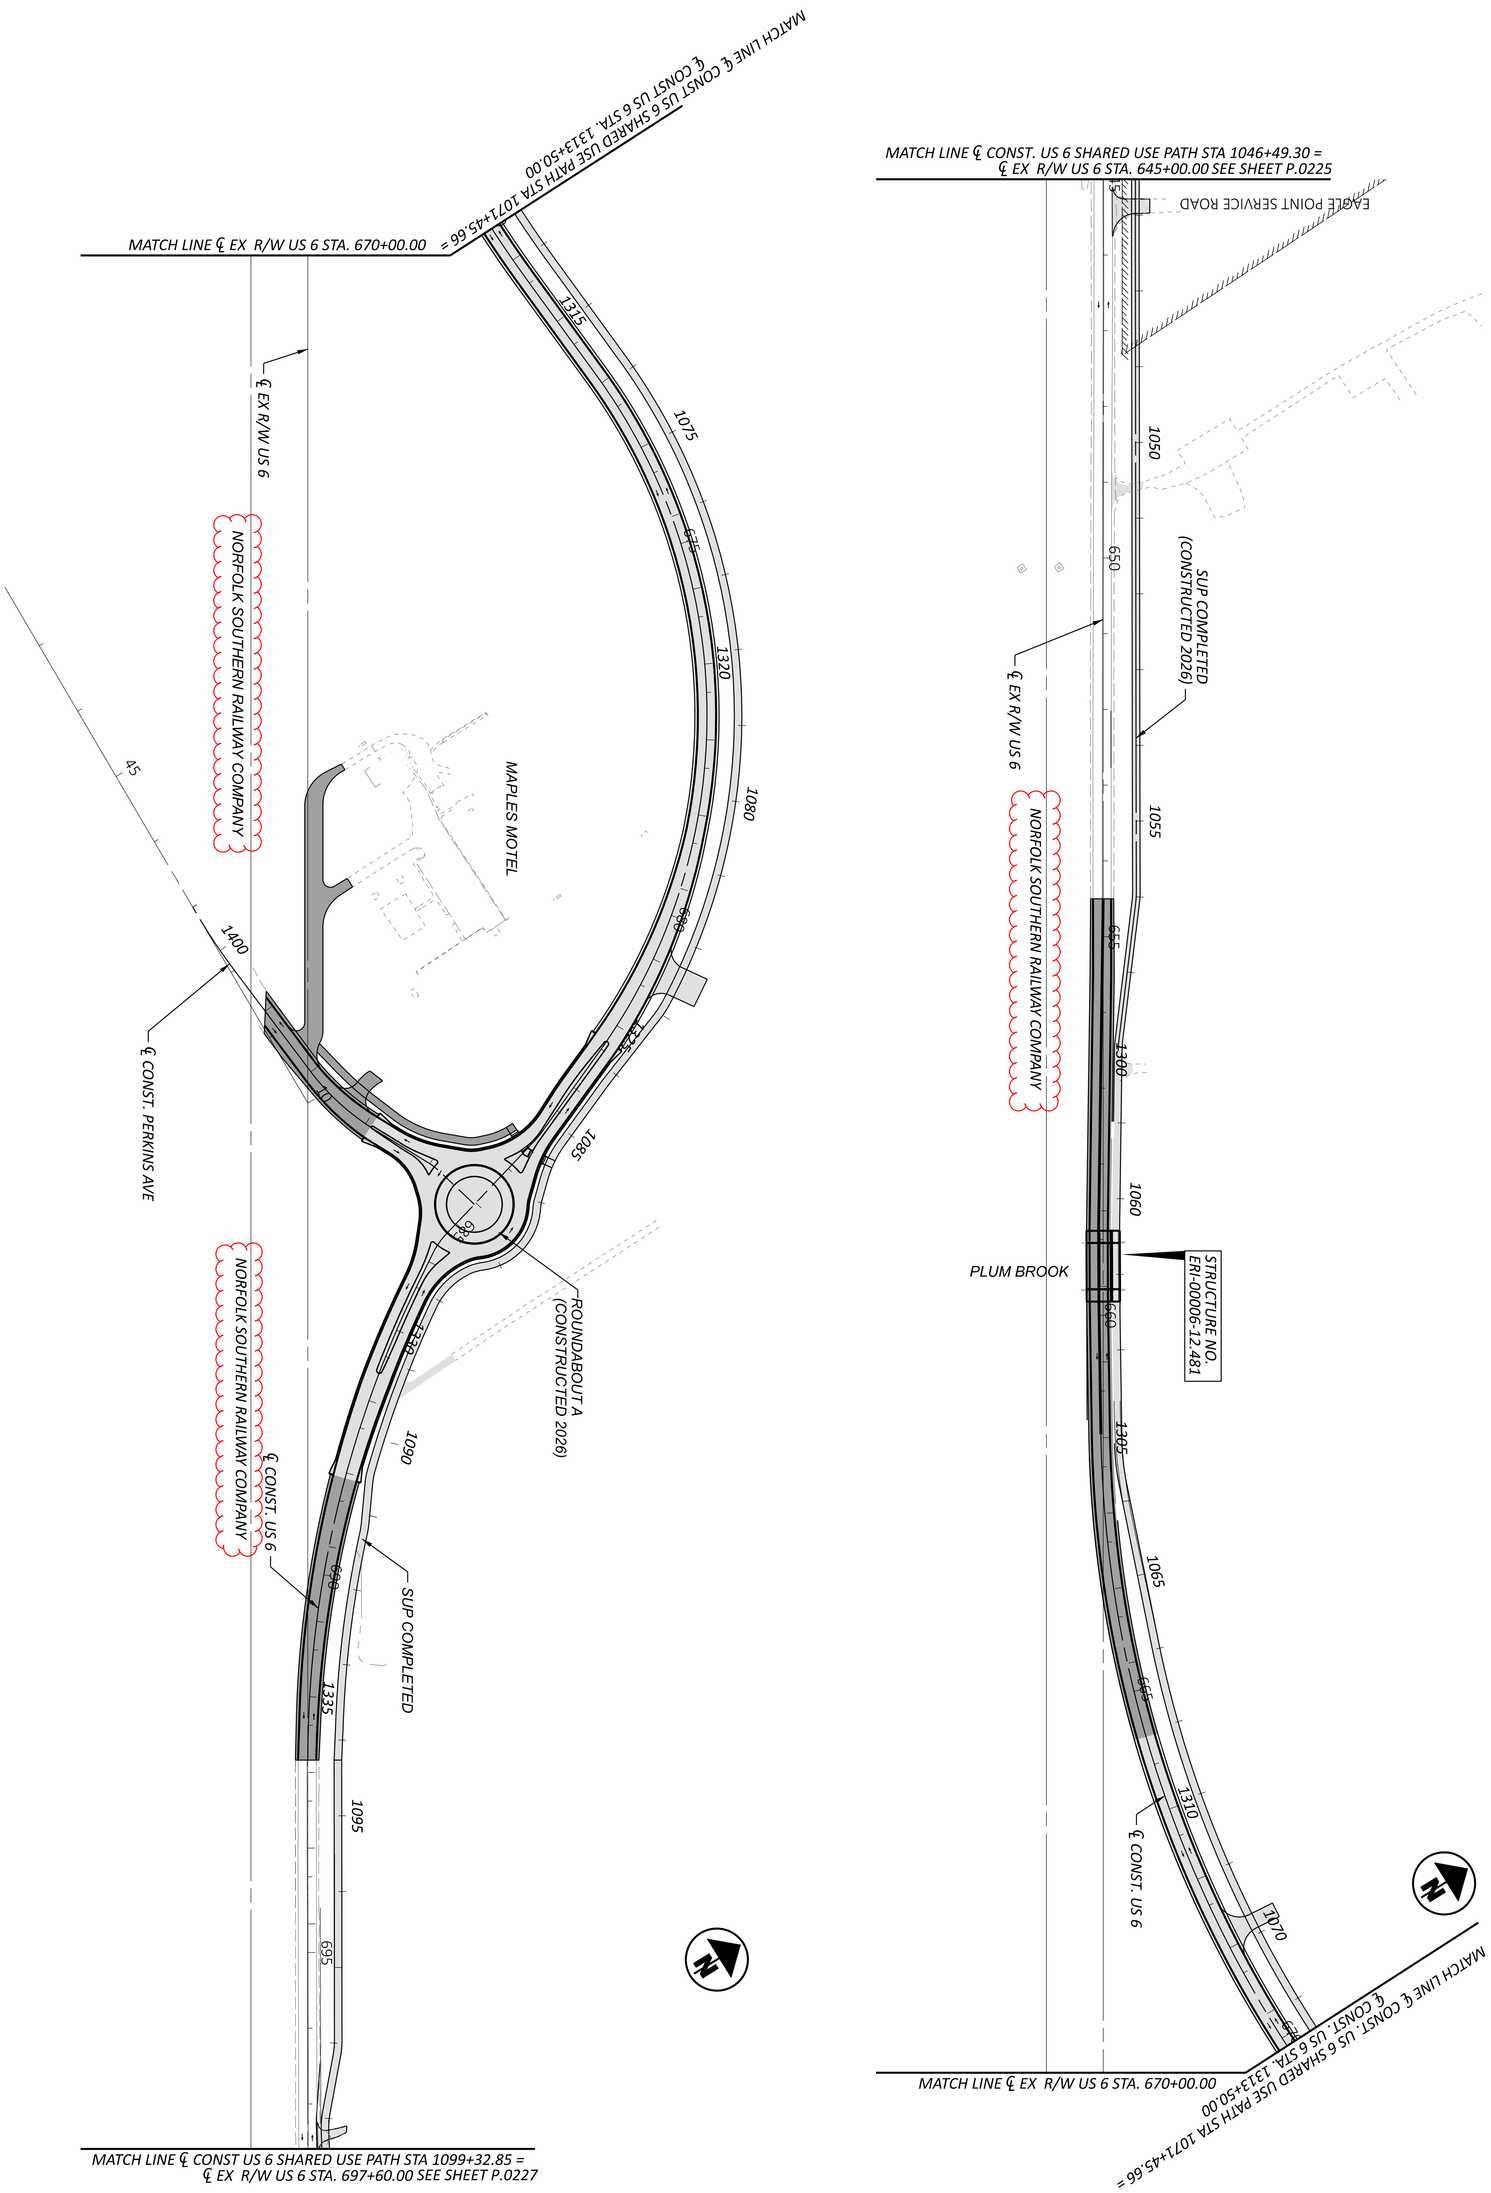

NOTES:
1. FOR MOT OVERALL SCHEMATIC PLAN, SEE SHEET P.0084
2. FOR LEGEND, SEE SHEET P.0084

SHEET	TOTAL
P 0231	1106

PROJECT ID: 116570


REVIEWER: SS 10/27/25

DESIGNER: SSA

TRANSYSTEMS
400 W. NATIONWIDE BLVD., STE 220
COLUMBUS, OHIO 43215
DESIGN AGENCY

MOT SCHEMATIC PLAN - PHASE 3 (2027/2028 CONSTRUCTION)
US 6 STA 645+00 TO STA 695+00

HORIZONTAL SCALE IN FEET
0 100
50 200

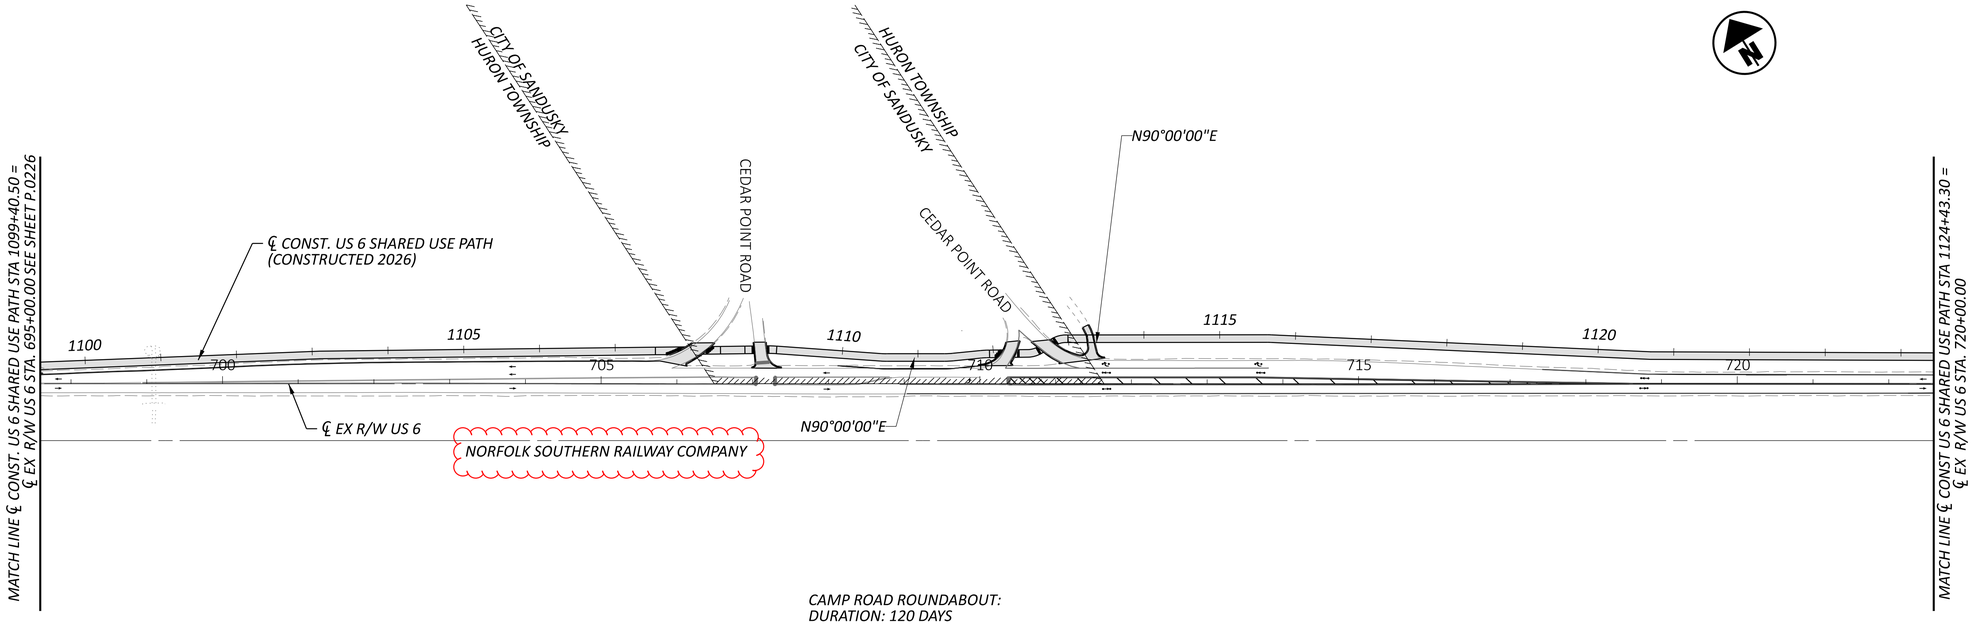


CAMP ROAD ROUNDABOUT:
DURATION: 120 DAYS

1. CONSTRUCT US 6 PORTION OF THE MULTI-LANE ROUNDABOUT IN PHASES WITH THE TWLTL

I. CONSTRUCT TEMPORARY PAVEMENT ON THE NORTH SIDE OF US 6 (FLAGGERS)

II. MAINTAIN TRAFFIC ON TEMPORARY PAVEMENT ON THE NORTH SIDE OF US 6 AND CONSTRUCT THE SOUTH HALF

III. MAINTAIN TRAFFIC ON THE SOUTH SIDE OF US 6 AND CONSTRUCT THE NORTH HALF AND MULTI-USE PATH

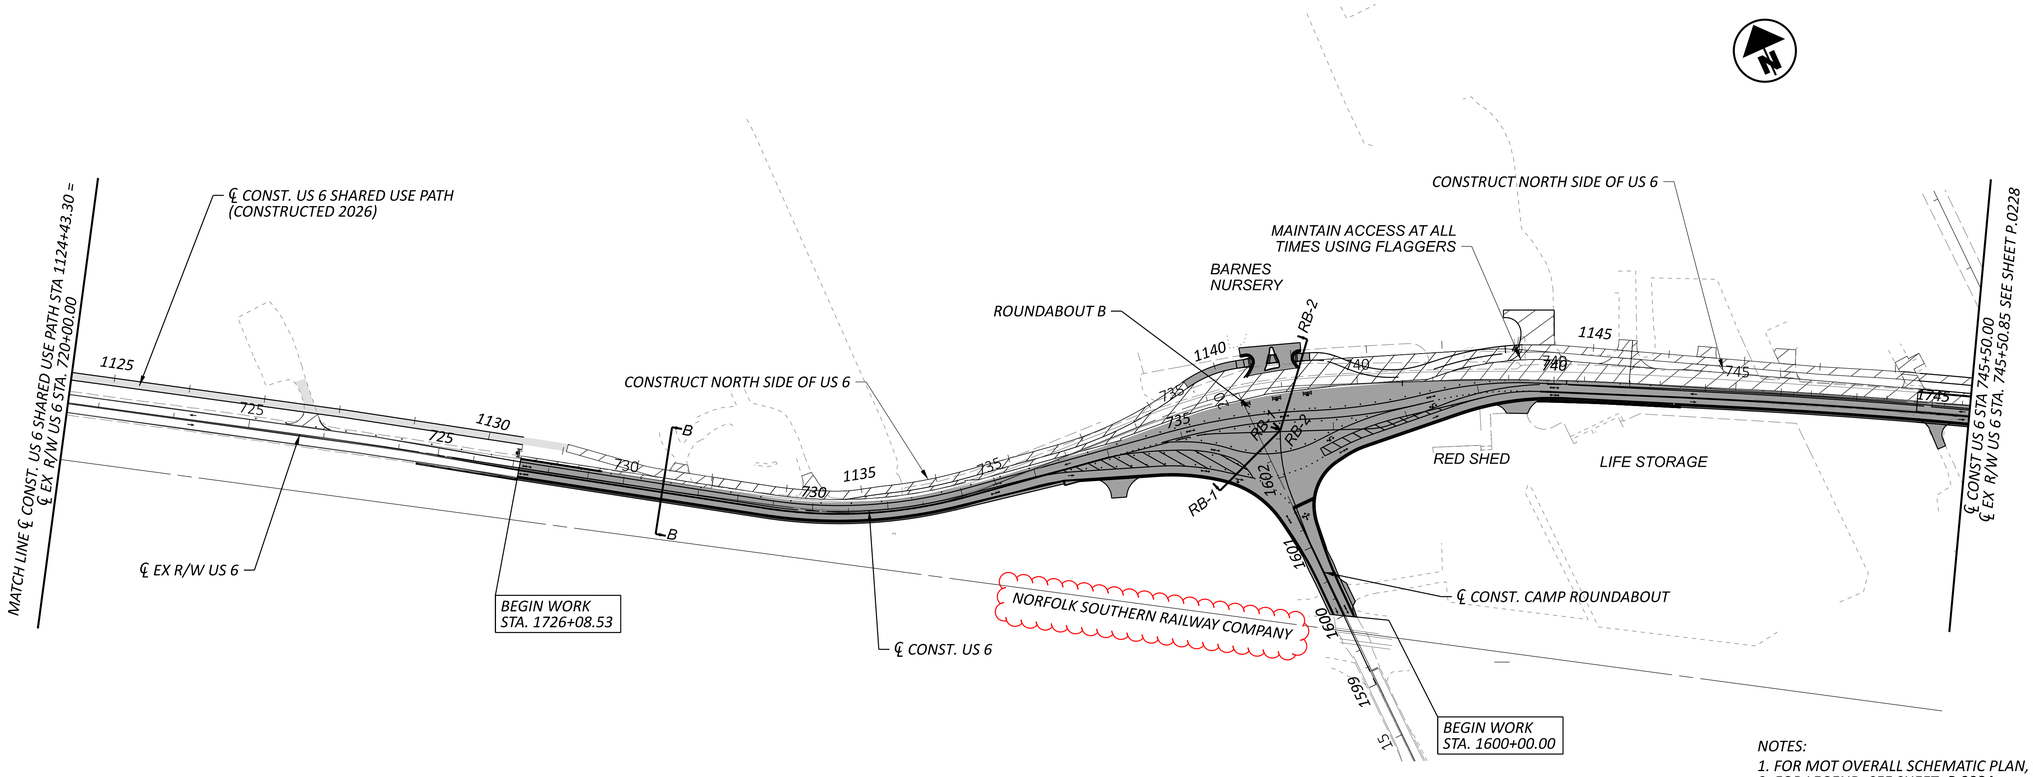

NOTES:
1. FOR MOT OVERALL SCHEMATIC PLAN, SEE SHEET
2. FOR LEGEND, SEE SHEET P.0084

HORIZONTAL SCALE IN FEET
0 50 100 200


MOT SCHEMATIC PLAN - PHASE 3 (2027/2028 CONSTRUCTION)
US 6 STA 695+00 TO STA 745+50

ERI-US 0006-CONNECTIVITY CORRIDOR

DESIGN AGENCY
TRANSYSTEMS
400 W. NATIONWIDE BLVD., STE 225
COLUMBUS, OHIO 43215

DESIGNER	SSA
REVIEWER	SS 10/27/25
PROJECT ID	116570
SHEET	P.0232
TOTAL	1106

MODEL: GB103 [Sheet] PAPERSIZE: 34x22 (in.) DATE: 2/26/2026 TIME: 9:23:14 AM PLTDRV: OHDOT_PDF_Levels.pltcfg PENTBL: OHDOT_Pen.tbl USER: hrthornton@gftinc.com WORKSPACE: OHDOTCtv02 WORKSET: 116570 PRODUCT: OpenRoadsDesigner 24.00.02.25
pw:\\ohiodot-pw.bentley.com:ohiodot-pw-02\Documents\01 Active Projects\District 03\Erie\116570\402-Engineering_TranSystems\MOT\Sheets\116570_MB008_CV2027.dgn

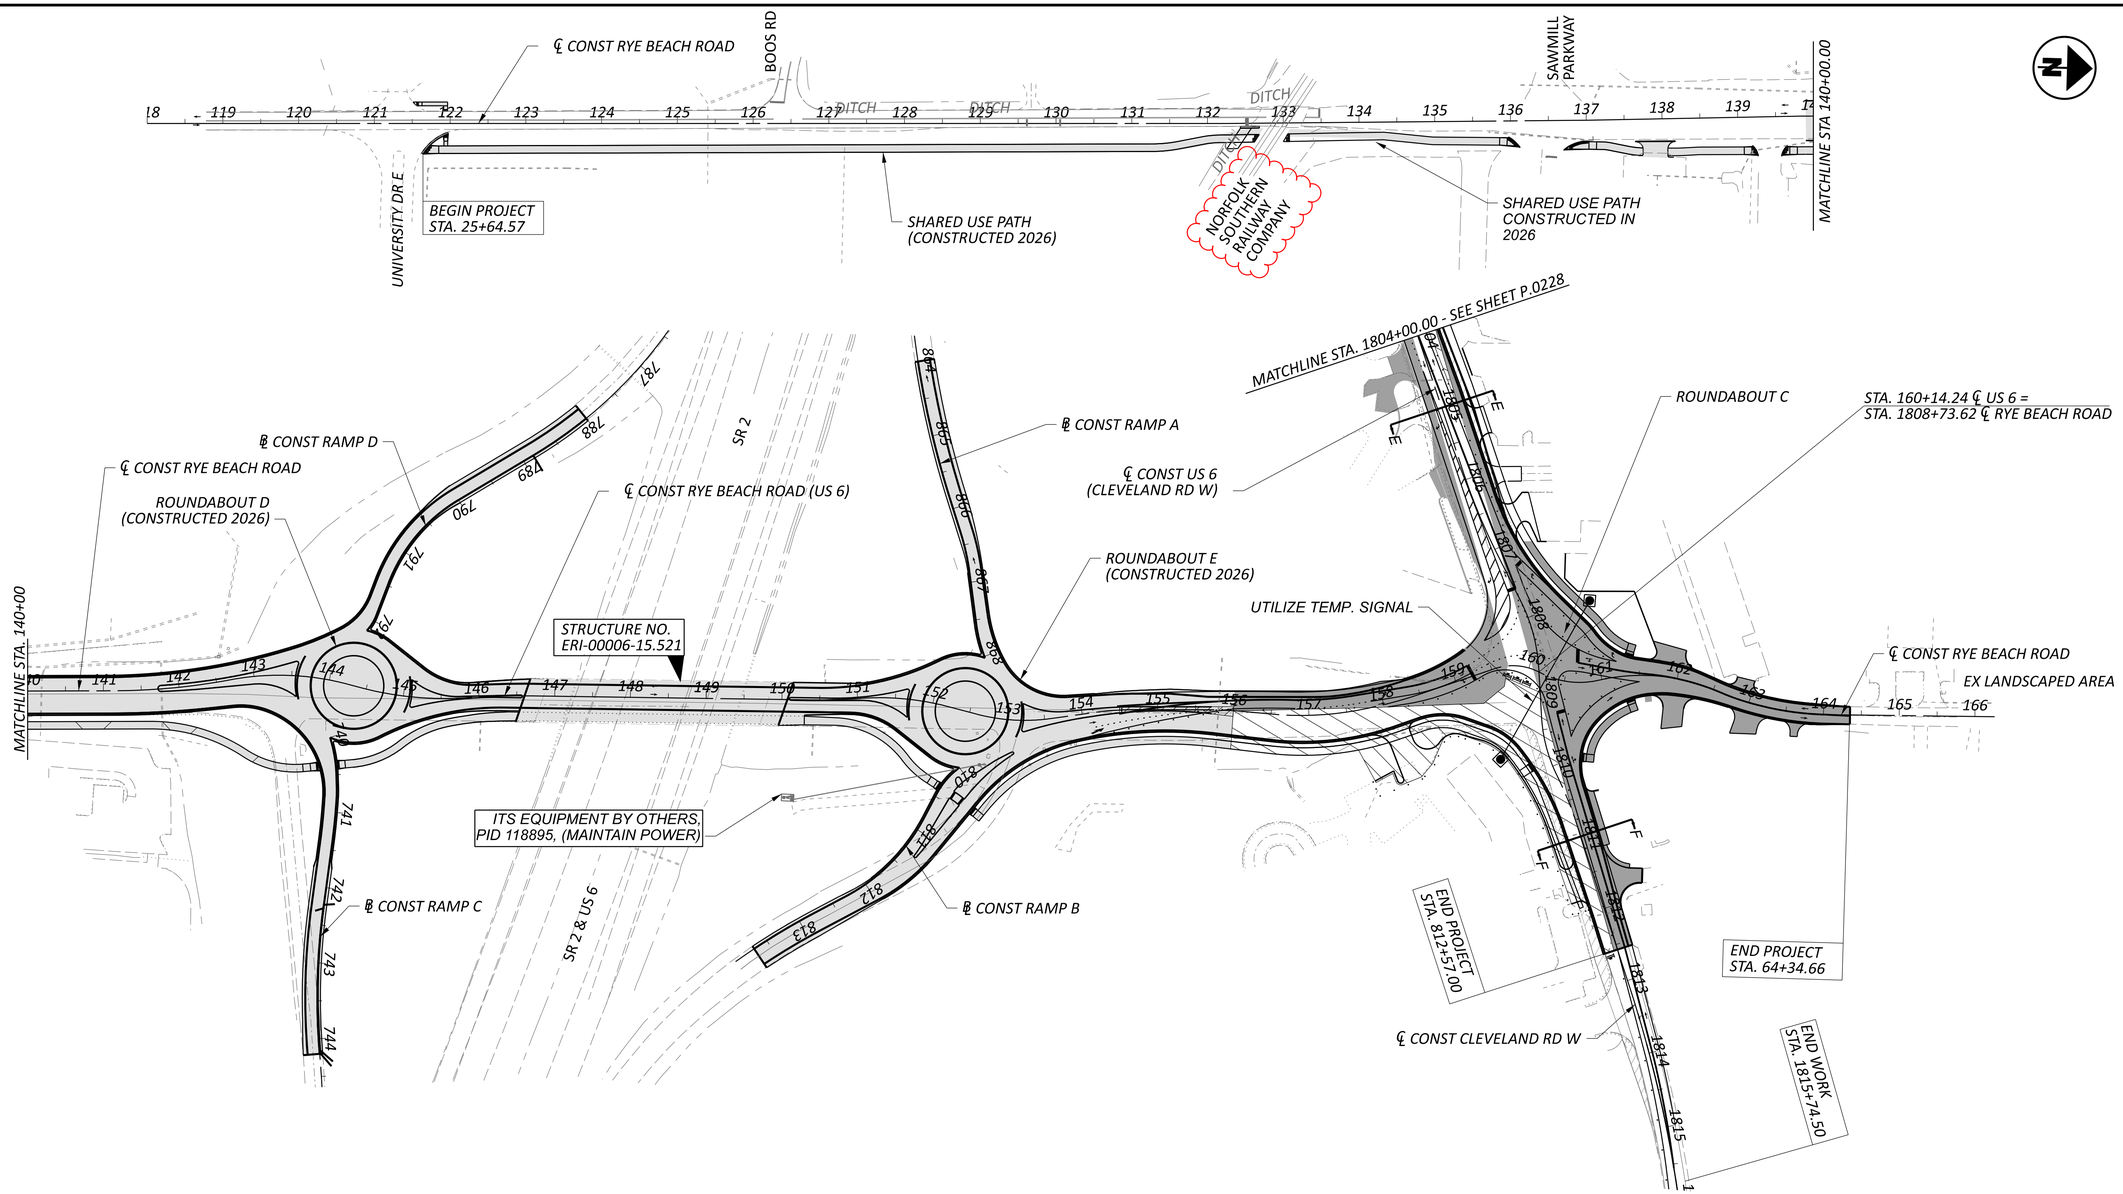

NOTES:
1. FOR MOT OVERALL SCHEMATIC PLAN, SEE SHEET
2. FOR LEGEND, SEE SHEET P.0084

HORIZONTAL SCALE IN FEET
0 50 100 200


MOT SCHEMATIC PLAN - PHASE 3 (2027/2028 CONSTRUCTION)
RYE BEACH ROAD STA 118+00.00 TO STA 166+00.00

DESIGN AGENCY
TRANSYSTEMS
400 W. NATIONWIDE BLVD., STE 225
COLUMBUS, OHIO 43215

DESIGNER	SSA
REVIEWER	SS 10/27/25
PROJECT ID	116570
SHEET	P.0234
TOTAL	1106

ERI-US 0006-CONNECTIVITY CORRIDOR

MODEL: 100 Scale 2 PAPERSIZE: 34x22 (in.) DATE: 2/26/2026 TIME: 9:12:14 AM PLTDRV: OHDOT_PDF_Levels.pltcfg PENTBL: OHDOT_Pen.tbl USER: hrthornton@gftinc.com WORKSPACE: OHDOTCEv02 WORKSET: 116570 PRODUCT: OpenRoadsDesigner 24.00.02.25
pw:\\ohiodot-pw.bentley.com:ohiodot-pw-02\Documents\01 Active Projects\District 03\Erie\116570\402-Engineering_TranSystems\MOT\Sheets\116570_MB007_CY2027.dgn

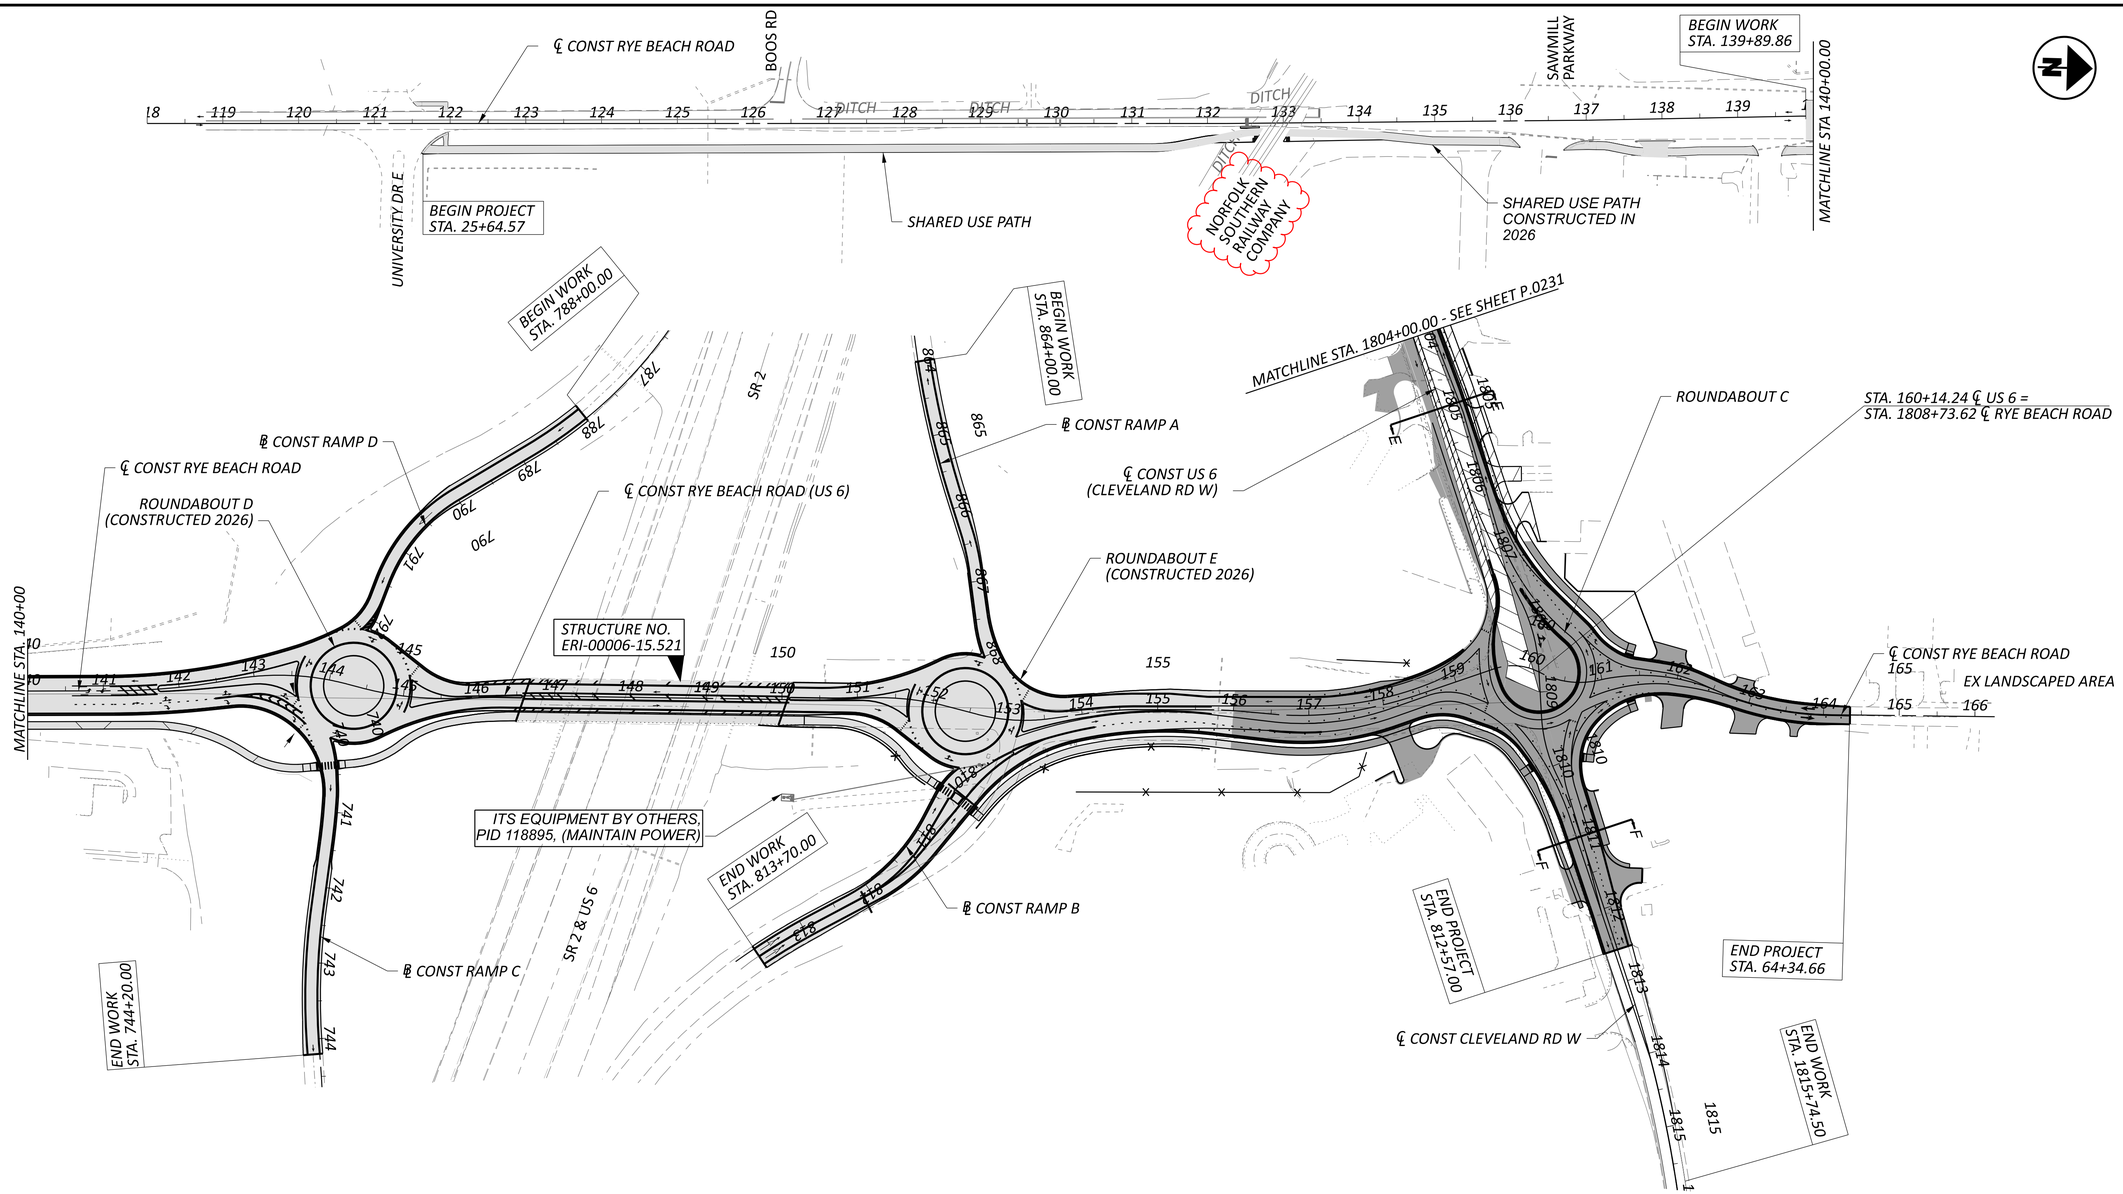

NOTES:

1. FOR MOT OVERALL SCHEMATIC PLAN, SEE SHEET P.0230
2. FOR LEGEND, SEE SHEET P.0084

HORIZONTAL SCALE IN FEET
0 50 100 200

MOT SCHEMATIC PLAN - PHASE 3A (2027/2028 CONSTRUCTION)
RYE BEACH ROAD STA 118+00.00 TO STA 166+00.00


DESIGN AGENCY
TRANSYSTEMS
400 W. NATIONWIDE BLVD., STE 225
COLUMBUS, OHIO 43215


DESIGNER SSA
REVIEWER SS 10/27/25
PROJECT ID 116570
SHEET P.0237 TOTAL 1106

ERI-US 0006-CONNECTIVITY CORRIDOR

MODEL: 100 Scale 2 PAPERSIZE: 34x22 (in.) DATE: 2/26/2026 TIME: 9:30:37 AM PLTDRV: OHDOT_PDF_Levels.pltcfg PENTBL: OHDOT_Pen.tbl USER: hrthornton@gftinc.com WORKSPACE: OHDOTCEv02 WORKSET: 116570 PRODUCT: OpenRoadsDesigner 24.00.02.25
pw:\\ohiodot-pw.bentley.com:ohiodot-pw-02\Documents\01 Active Projects\District 03\Erie\116570\d02-Engineering_TranSystems\MOT\Sheets\116570_MB009_CY2027.dgn
hrthornton@gftinc.com
_MB009_CY2027

MODEL: CLP_SUP 1 - Plan 12-13 [Sheet] PAPERSIZE: 34x22 (in.) DATE: 2/26/2026 TIME: 9:36:06 AM PLTDRV: OHDOT_PDF_Levels.pltcfg PENTBL: OHDOT_Pen.tbl USER: hrthornton@gftinc.com WORKSPACE: OHDOTCEv02 WORKSET: 116570 PRODUCT: OpenRoadsDesigner 24.00.02.25
pw:\\ohiodot-pw.bentley.com:ohiodot-pw-02\Documents\01 Active Projects\District 03\Erie\116570\402-Engineering_TranSystems\MOT\Sheets\116570_MP000_CY2027.dgn

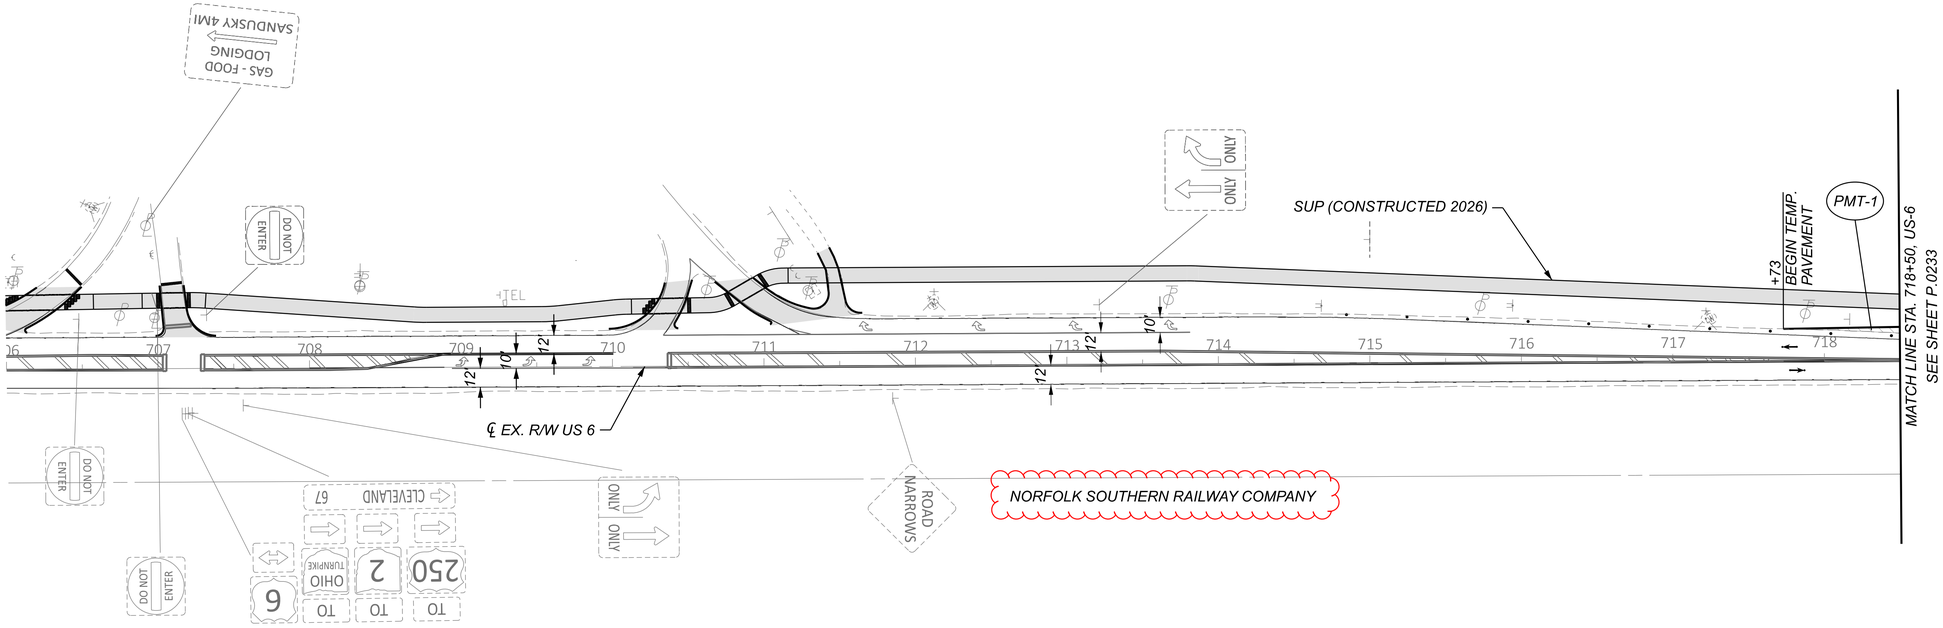

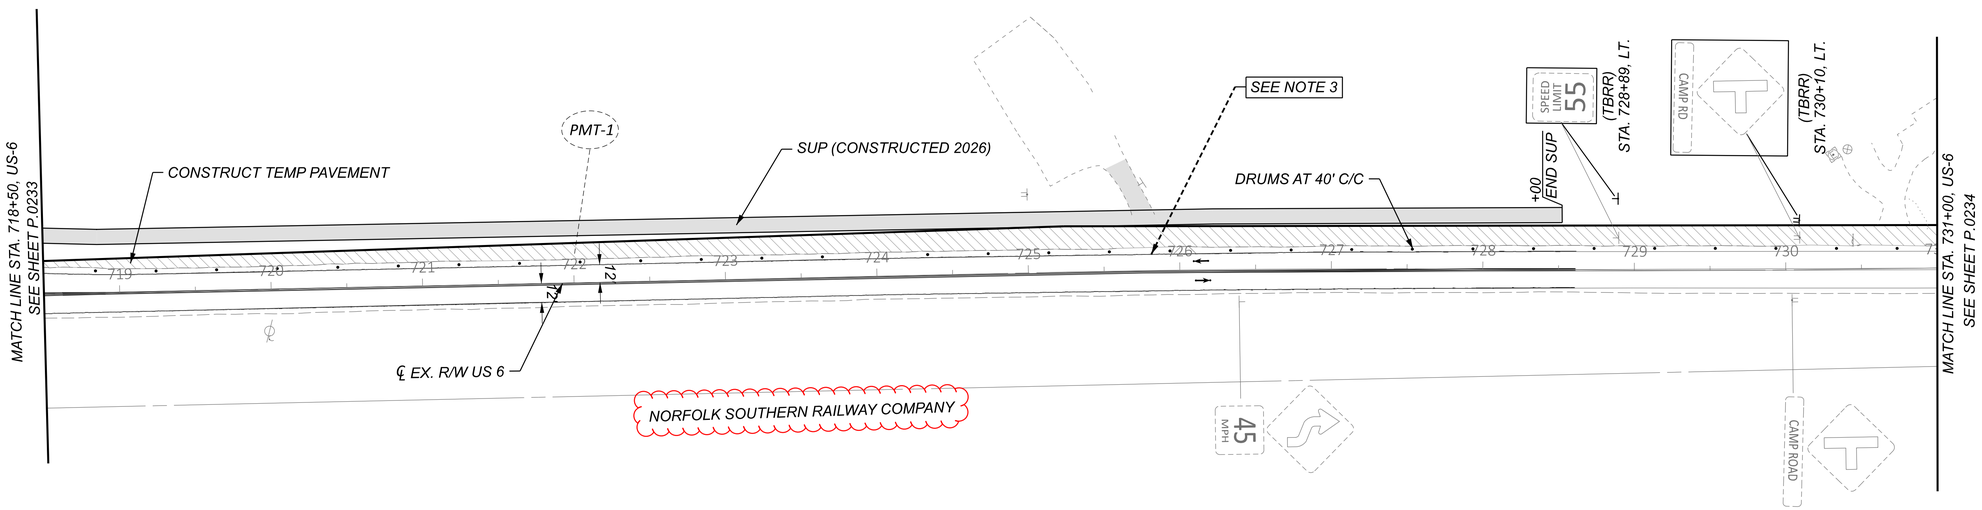

NOTES:

1. FOR MOT LEGEND, SEE SHEET P.0084
2. FOR PROPOSED SIGNING AND MARKING DETAILS, SEE TRAFFIC CONTROL PLANS.
3. MAINTAIN ACCESS TO DRIVES OR SIDE ROADS AT ALL TIMES. USE FLAGGING OPERATION AS NECESSARY.


HORIZONTAL SCALE IN FEET
0 25 50 100


MAINTENANCE OF TRAFFIC - PRE PHASE (2027/2028 CONSTRUCTION)
US 6 - STA. 706+00.00 TO STA. 730+00.00

DESIGN AGENCY
TRANSYSTEMS
400 W. NATIONWIDE BLVD., STE 225
COLUMBUS, OHIO 43215

DESIGNER	SSA
REVIEWER	SS 10/27/25
PROJECT ID	116570
SHEET	P.0238
TOTAL	1106

NOTE: UTILITIES RELOCATED IN CY 2026

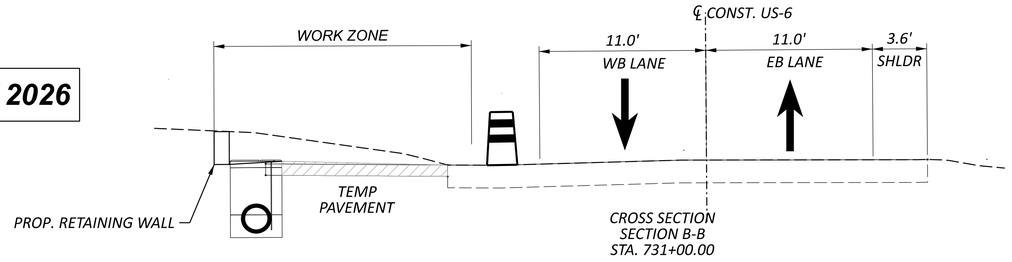

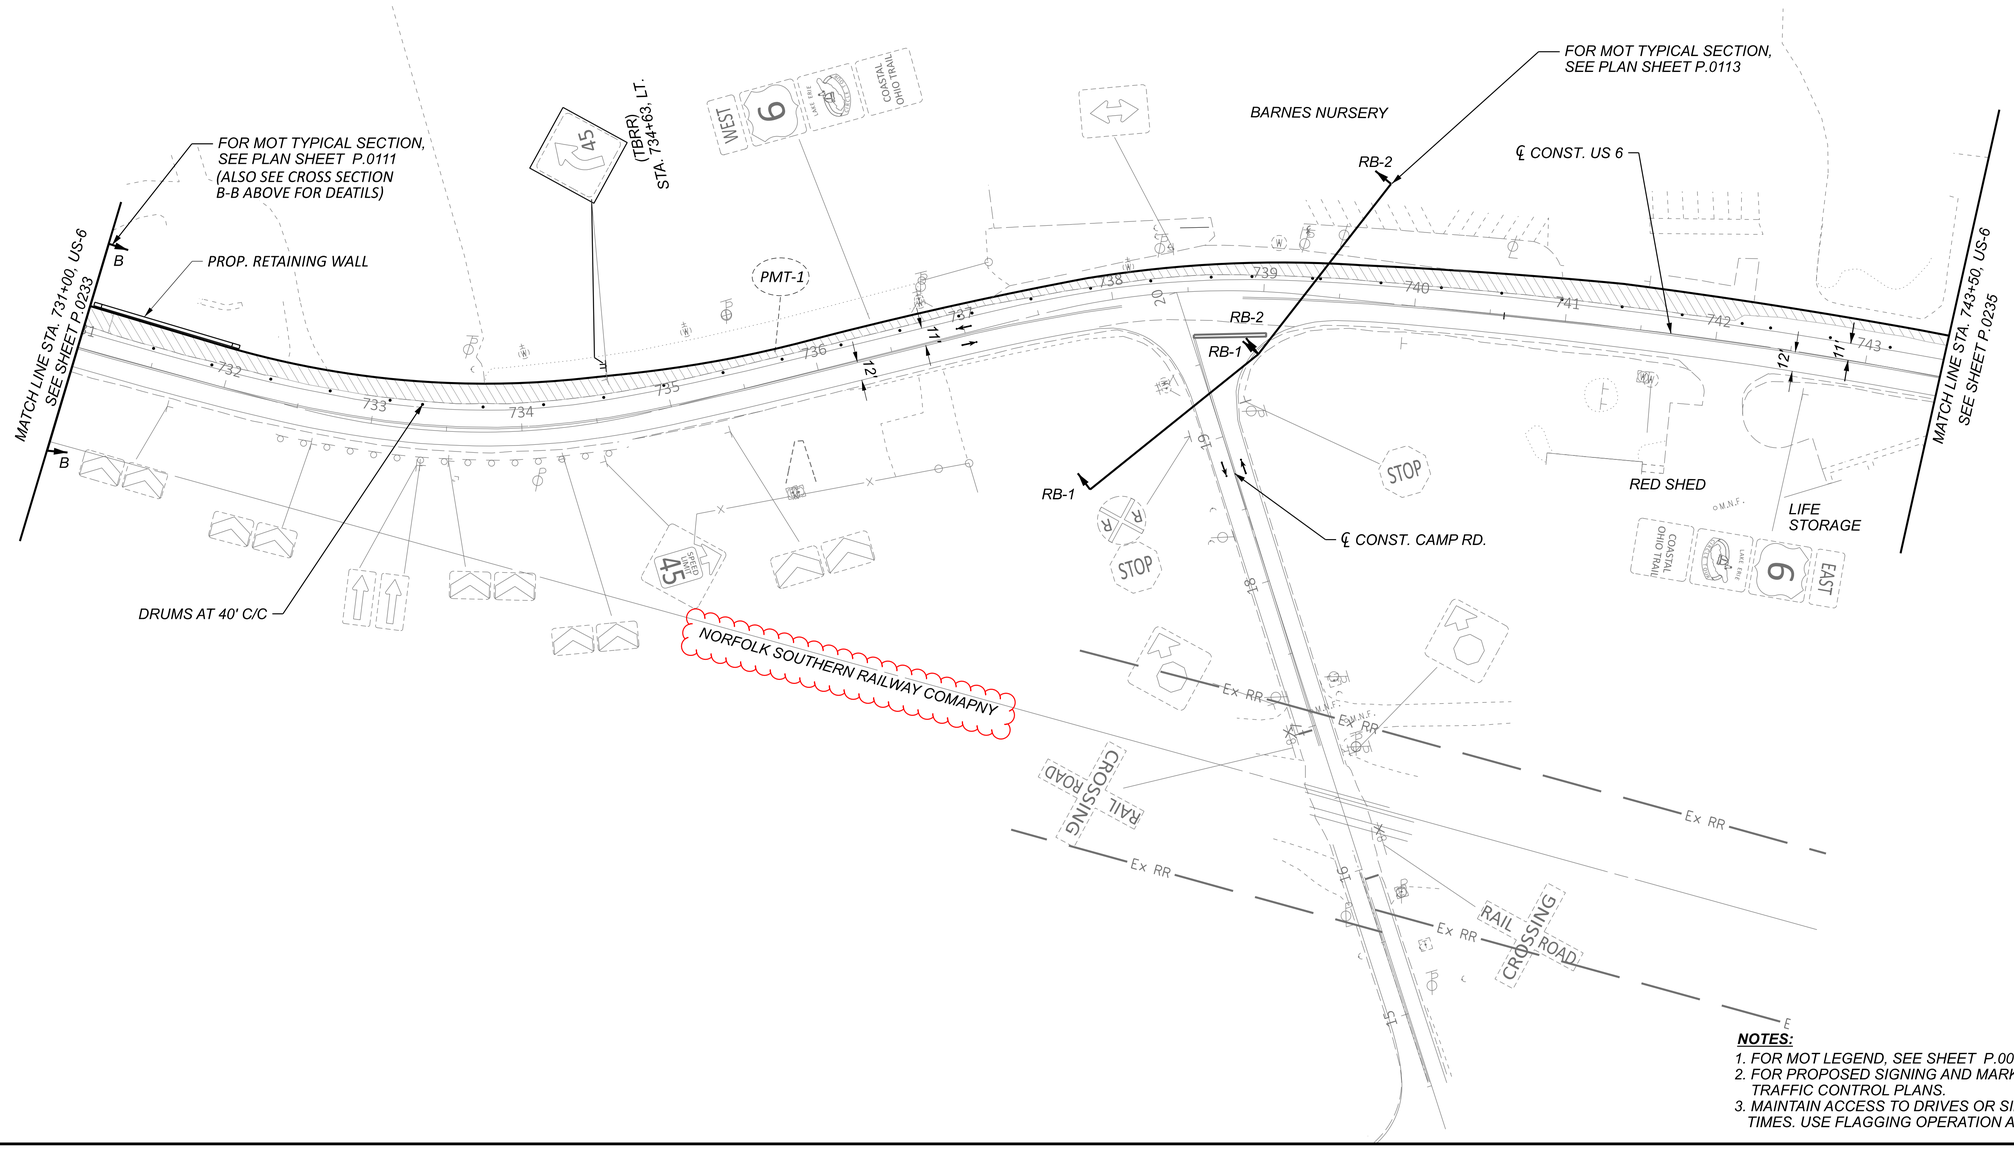

NOTES:

1. *FOR MOT LEGEND, SEE SHEET P.0084*
2. *FOR PROPOSED SIGNING AND MARKING DETAILS, SEE TRAFFIC CONTROL PLANS.*
3. *MAINTAIN ACCESS TO DRIVES OR SIDE ROADS AT ALL TIMES. USE FLAGGING OPERATION AS NECESSARY.*

HORIZONTAL SCALE IN FEET
0 25 50 100

MAINTENANCE OF TRAFFIC - PRE PHASE (2027/2028 CONSTRUCTION)
US 6 - STA. 731+00.00 TO STA. 743+50.00

ERI-US 0006-CONNECTIVITY CORRIDOR


MODEL: CLP_SUP 2 - Plan 14 [Sheet] PAPERSIZE: 34x22 (in.) DATE: 2/26/2026 TIME: 9:39:26 AM PLTDRV: OHDOT_PDF_Levels.pltcfg PENTBL: OHDOT_Pen.tbl USER: hrthornton@gfitinc.com WORKSPACE: OHDOTCEv02 WORKSET: 116570 PRODUCT: OpenRoadsDesigner 24.00.02.25
pw:\\ohiodot-pw.bentley.com:ohiodot-pw-02\Documents\01 Active Projects\District 03\Erie\116570\402 Engineering_TranSystems\MOT\Sheets\116570_MP000_CY2027.dgn

DESIGN AGENCY
TRANSYSTEMS
400 W. NATIONWIDE BLVD., STE 225
COLUMBUS, OHIO 43215

DESIGNER: SSA
REVIEWER: SS 10/27/25
PROJECT ID: 116570
SHEET: P.0239 TOTAL: 1106

ERI-US 0006-CONNECTIVITY CORRIDOR

MODEL: CLP_SUP 1 - Plan 12-13 [Sheet] PAPERSIZE: 34x22 (in.) DATE: 2/26/2026 TIME: 9:52:36 AM PLTDRV: OHDOT_PDF_Levels.pltcfg PENTBL: OHDOT_Pen.tbl USER: hrthornton@gftinc.com WORKSPACE: OHDOTCEv02 WORKSET: 116570 PRODUCT: OpenRoadsDesigner 24.00.02.25
pw:\\ohiodot-pw.bentley.com:ohiodot-pw-02\Documents\01 Active Projects\District 03\Erie\116570\402-Engineering_TranSystems\MOT\Sheets\116570_MP001_CY2027.dgn

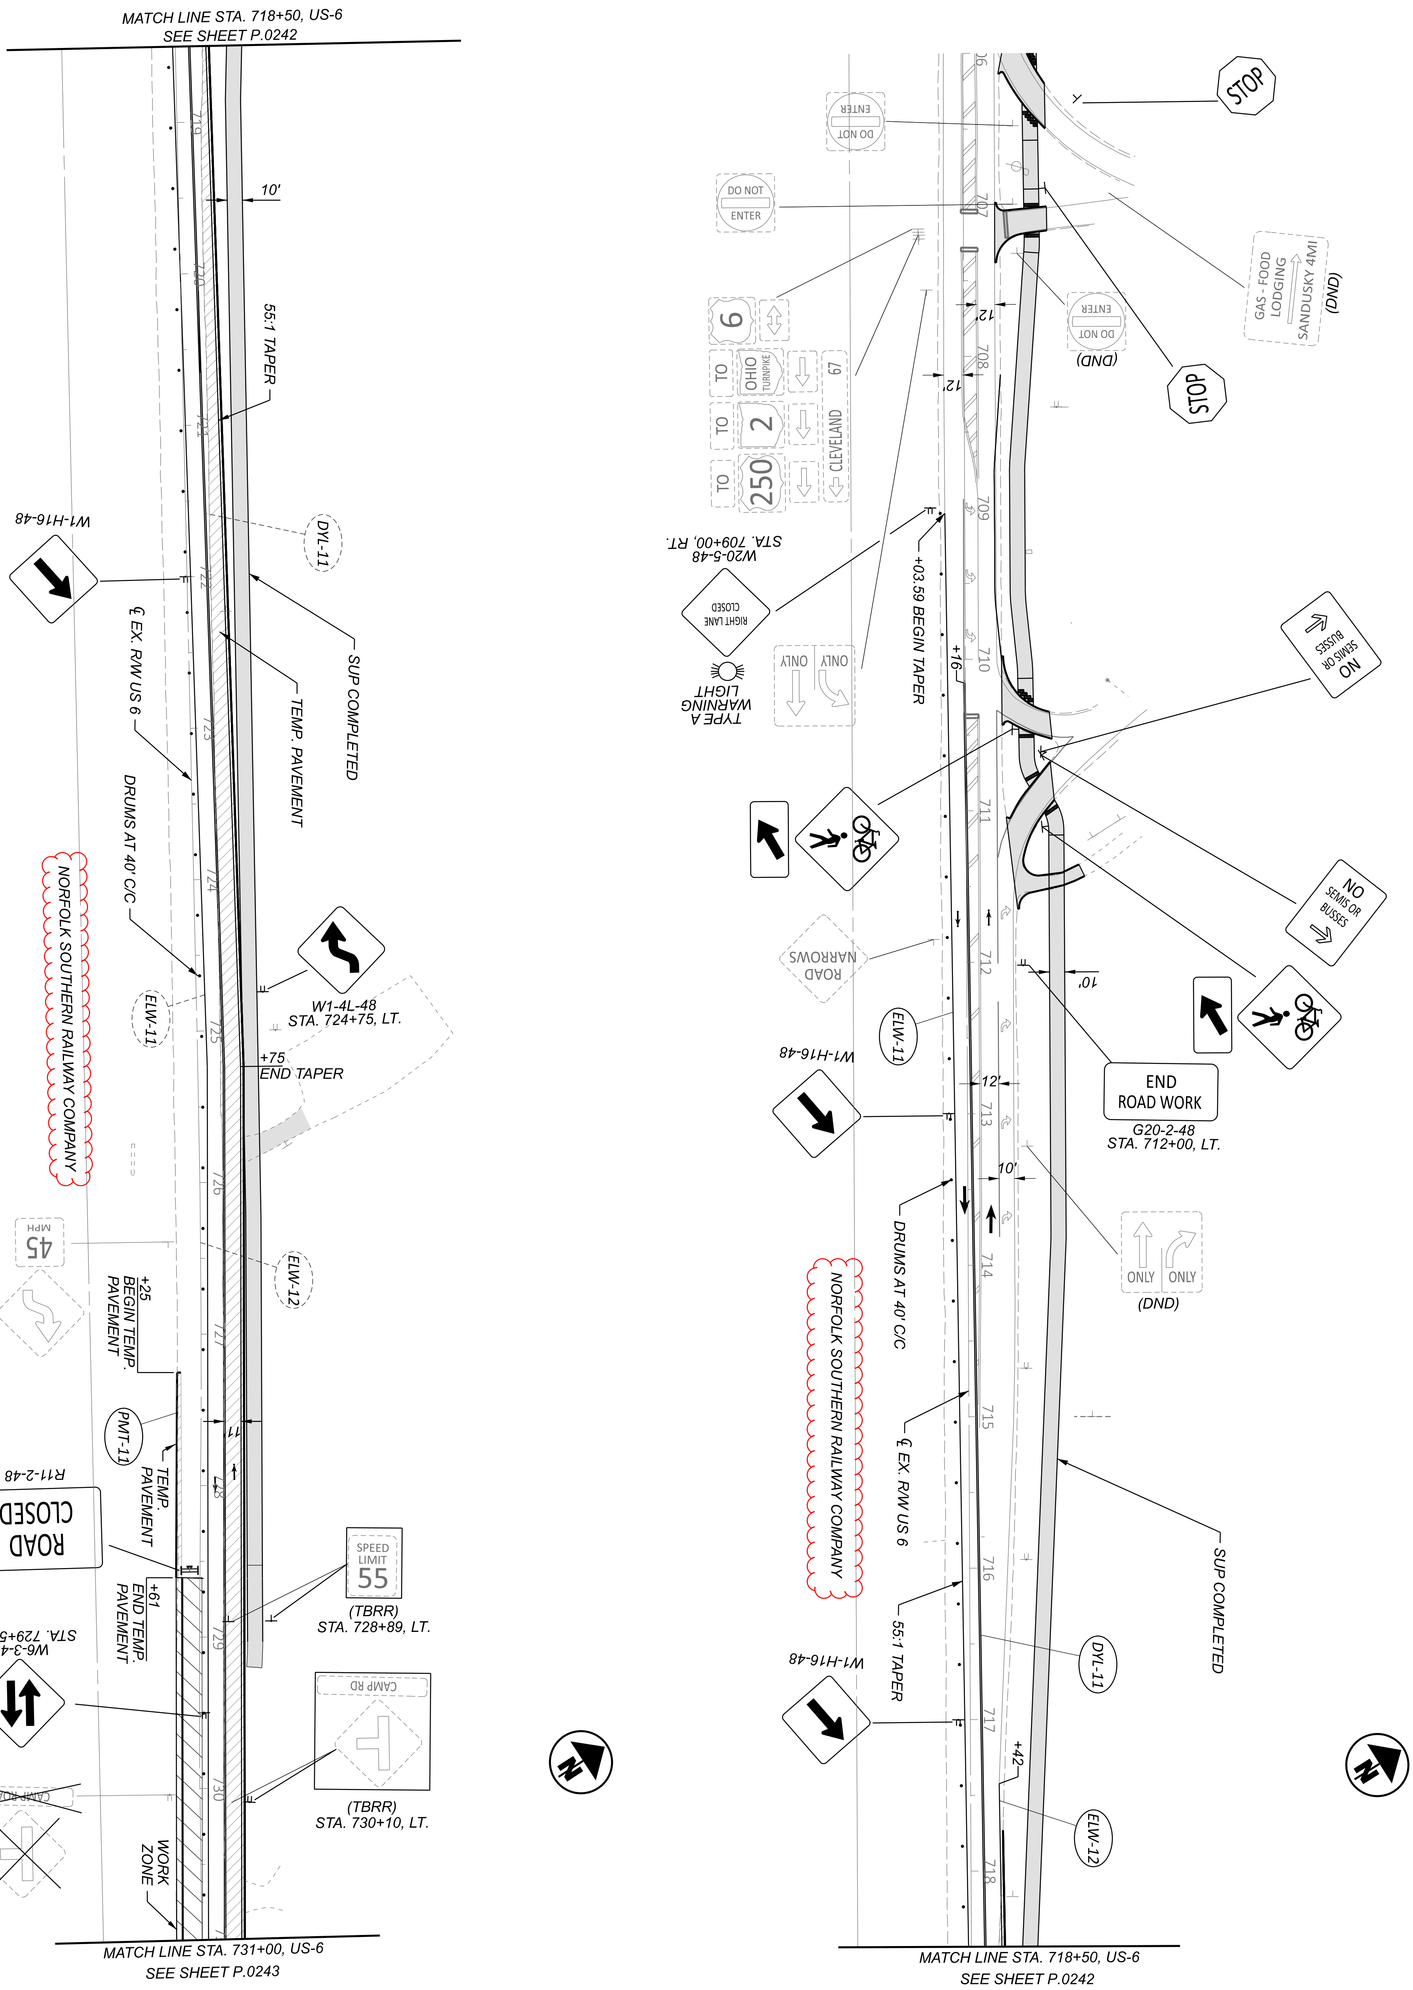

NOTES:

1. FOR MOT LEGEND, SEE SHEET P.0084
2. FOR PROPOSED SIGNING AND MARKING DETAILS, SEE TRAFFIC CONTROL PLANS.
3. MAINTAIN ACCESS TO DRIVES OR SIDE ROADS AT ALL TIMES. USE FLAGGING OPERATION AS NECESSARY.


DESIGNER	DESIGN AGENCY	REVIEWER	PROJECT ID	SHEET	TOTAL
SSA	TRANSYSTEMS 400 W. NATIONWIDE BLVD., STE 225 COLUMBUS, OHIO 43215	SS 10/27/25	116570	P 0247	1106

MAINTENANCE OF TRAFFIC - PHASE 1 (2027/2028 CONSTRUCTION)
US 6 - STA. 706+00.00 TO STA. 730+00.00

HORIZONTAL SCALE IN FEET
0 50
25 100

MODEL: CLP_SUP 2 - Plan 14 [Sheet] PAPERSIZE: 34x22 (in.) DATE: 2/26/2026 TIME: 9:55:14 AM PLTDRV: OHDOT_PDF_Levels.pltcfg PENTBL: OHDOT_Pen.tbl USER: hrthornton@gfginc.com WORKSPACE: OHDOTCEv02 WORKSET: 116570 PRODUCT: OpenRoadsDesigner 24.00.02.25
pw:\\ohiodot-pw.bentley.com:ohiodot-pw-02\Documents\01 Active Projects\District 03\Erie\116570\d02-Engineering_TranSystems\MOT\Sheets\116570_MP001_CY2027.dgn

ERI-US 0006-CONNECTIVITY CORRIDOR

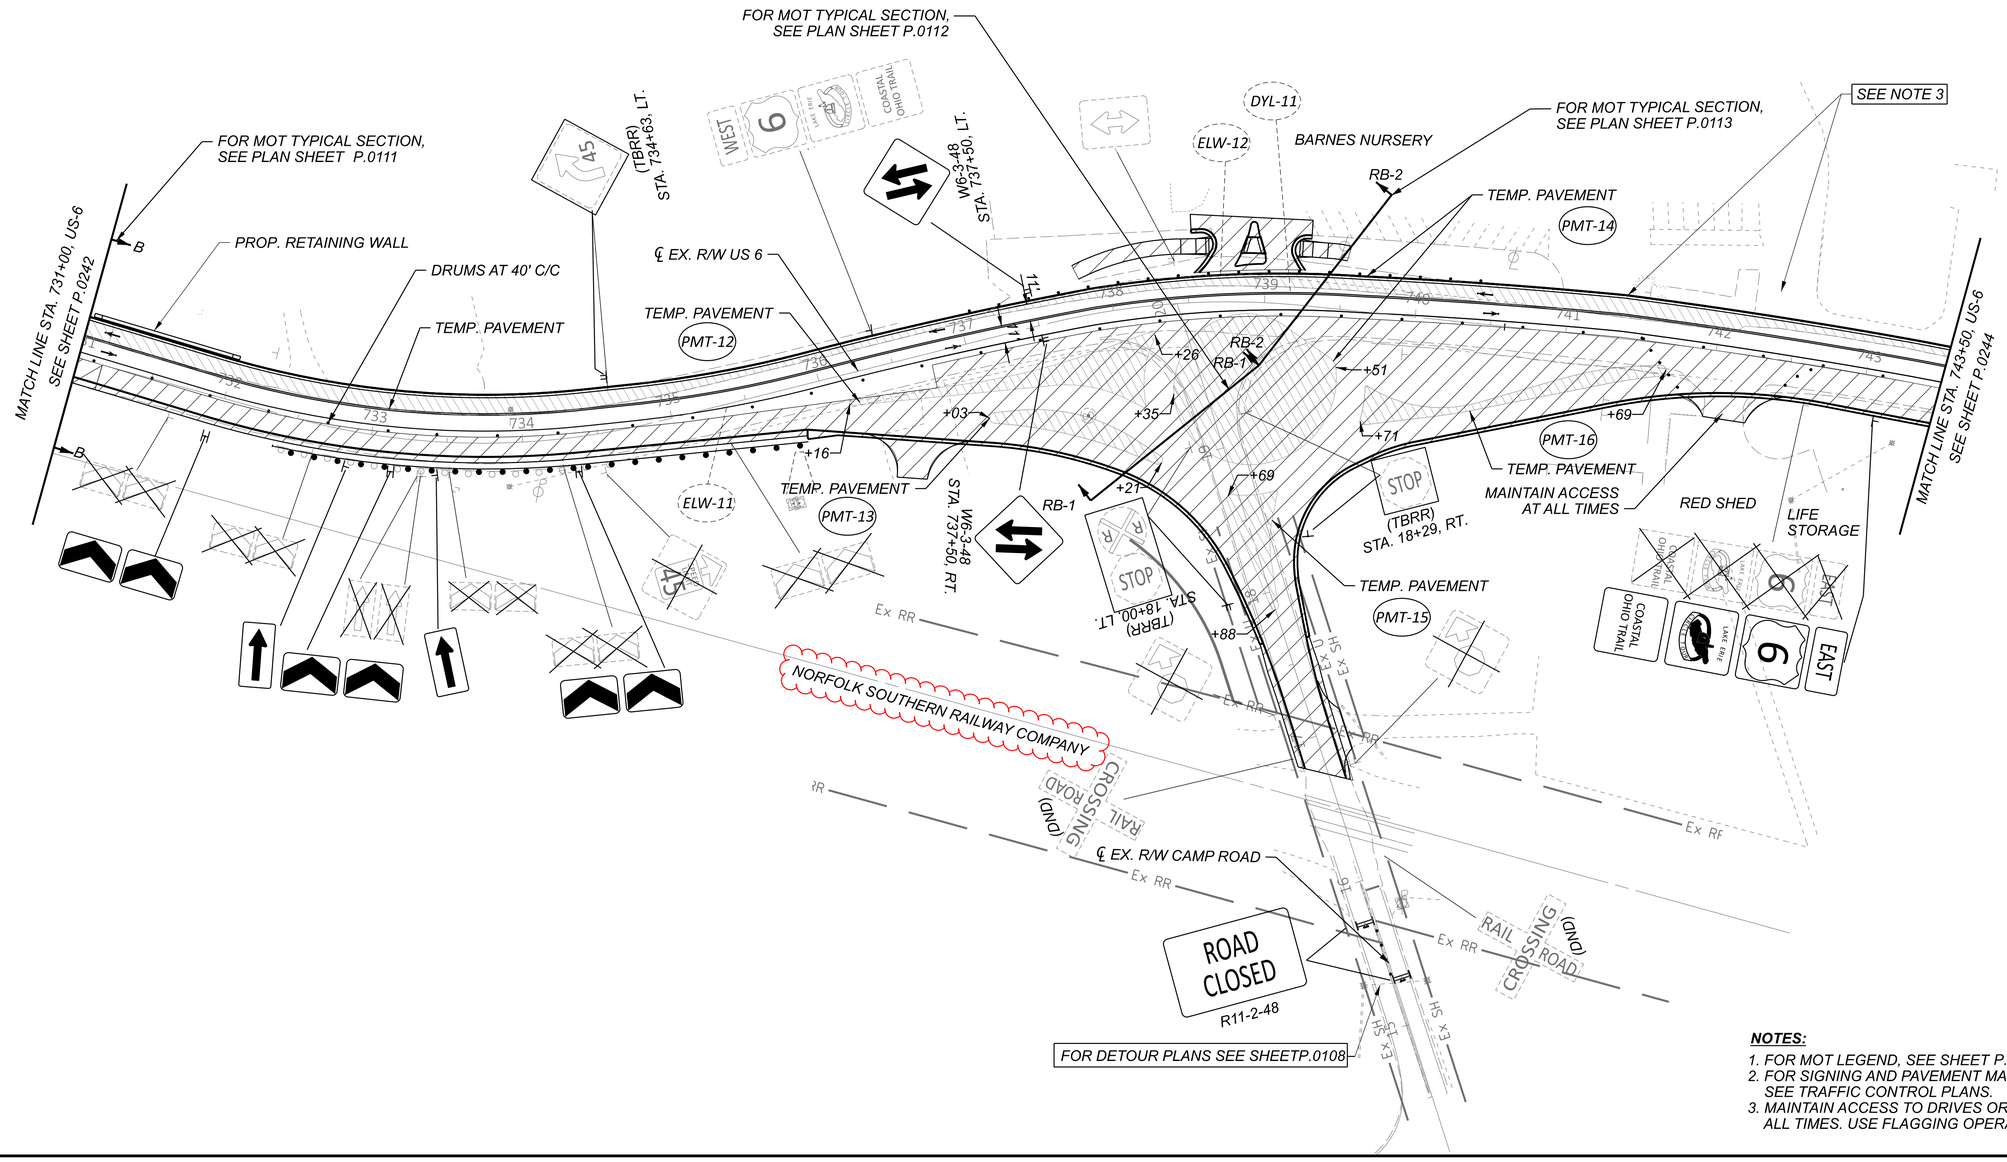

NOTES:

1. FOR MOT LEGEND, SEE SHEET P.0084.
2. FOR SIGNING AND PAVEMENT MARKING DETAILS, SEE TRAFFIC CONTROL PLANS.
3. MAINTAIN ACCESS TO DRIVES OR SIDE ROADS AT ALL TIMES. USE FLAGGING OPERATION AS NECESSARY.


HORIZONTAL SCALE IN FEET
0 25 50 100

MAINTENANCE OF TRAFFIC - PHASE 1 (2027/2028 CONSTRUCTION)
US 6 - STA. 731+00.00 TO STA. 743+50.00

DESIGN AGENCY
TRANSYSTEMS
400 W. NATIONWIDE BLVD., STE 220
COLUMBUS, OHIO 43215

DESIGNER: SSA
REVIEWER: SS 10/27/25
PROJECT ID: 116570
SHEET: P.0248 TOTAL: 1106

MODEL: CLP_SUP 1 - Plan 9-10 [Sheet] PAPERSIZE: 34x22 (in.) DATE: 2/26/2026 TIME: 10:00:20 AM PLTDRV: OHDOT_PDF_Levels.pltcfg PENTBL: OHDOT_Pen.tbl USER: hrthornton@gftinc.com WORKSPACE: OHDOTCEv02 WORKSET: 116570 PRODUCT: OpenRoadsDesigner 24.00.02.25
pw:\\ohiodot-pw.bentley.com:ohiodot-pw-02\Documents\01 Active Projects\District 03\Erie\116570\402-Engineering_TranSystems\MOT\Sheets\116570_MP002_CY2027.dgn

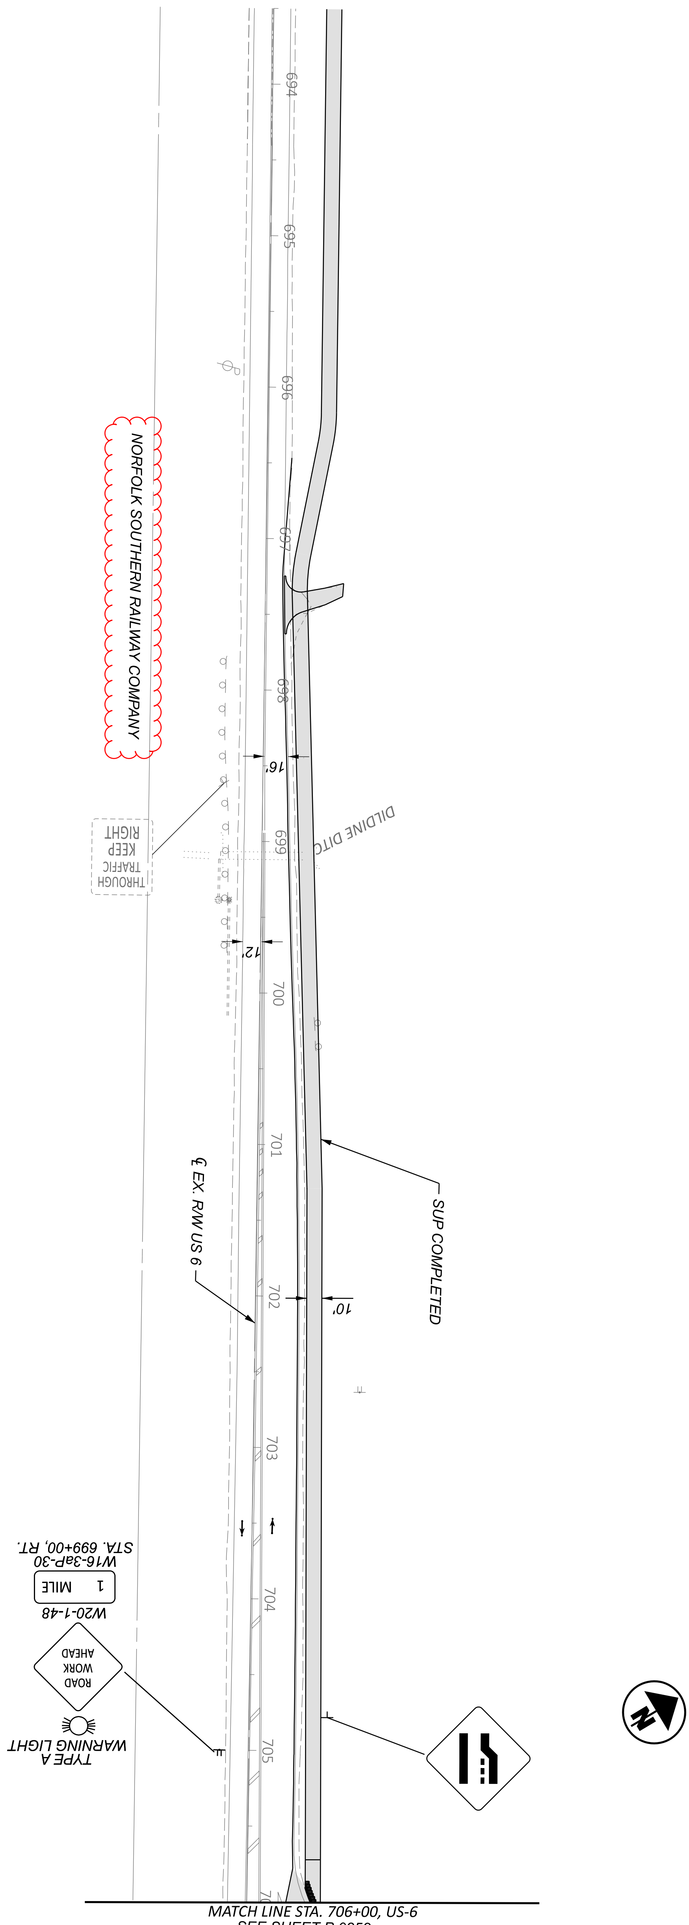

NOTES:

1. *FOR MOT LEGEND, SEE SHEET P.0004*
2. *FOR PROPOSED SIGNING AND MARKING DETAILS, SEE TRAFFIC CONTROL PLANS.*
3. *MAINTAIN ACCESS TO DRIVES OR SIDE ROADS AT ALL TIMES. USE FLAGGING OPERATION AS NECESSARY.*

SHEET	TOTAL
P 0256	1106

PROJECT ID: 116570

REVIEWER: SS 10/27/25

DESIGNER: SSA


DESIGN AGENCY: TRANSYSTEMS
400 W. NATIONWIDE BLVD., STE 220
COLUMBUS, OHIO 43215

MAINTENANCE OF TRAFFIC - PHASE 2 (2027/2028 CONSTRUCTION)
US 6 - STA. 671+50.00 TO STA. 706+00.00

HORIZONTAL SCALE IN FEET
0 50
25 100

ERI-US 0006-CONNECTIVITY CORRIDOR

MODEL: CLP_SUP 1 - Plan 12-13 [Sheet] PAPERSIZE: 34x22 (in.) DATE: 2/26/2026 TIME: 10:03:22 AM PLTDRV: OHDOT_PDF_Levels.pltcfg PENTBL: OHDOT_Pen.tbl USER: hrthornton@gftinc.com WORKSPACE: OHDOTCEv02 WORKSET: 116570 PRODUCT: OpenRoadsDesigner 24.00.02.25
pw:\\ohiodot-pw.bentley.com:ohiodot-pw-02\Documents\01 Active Projects\District 03\Erie\116570\402-Engineering_TranSystems\MOT\Sheets\116570_MP002_CY2027.dgn

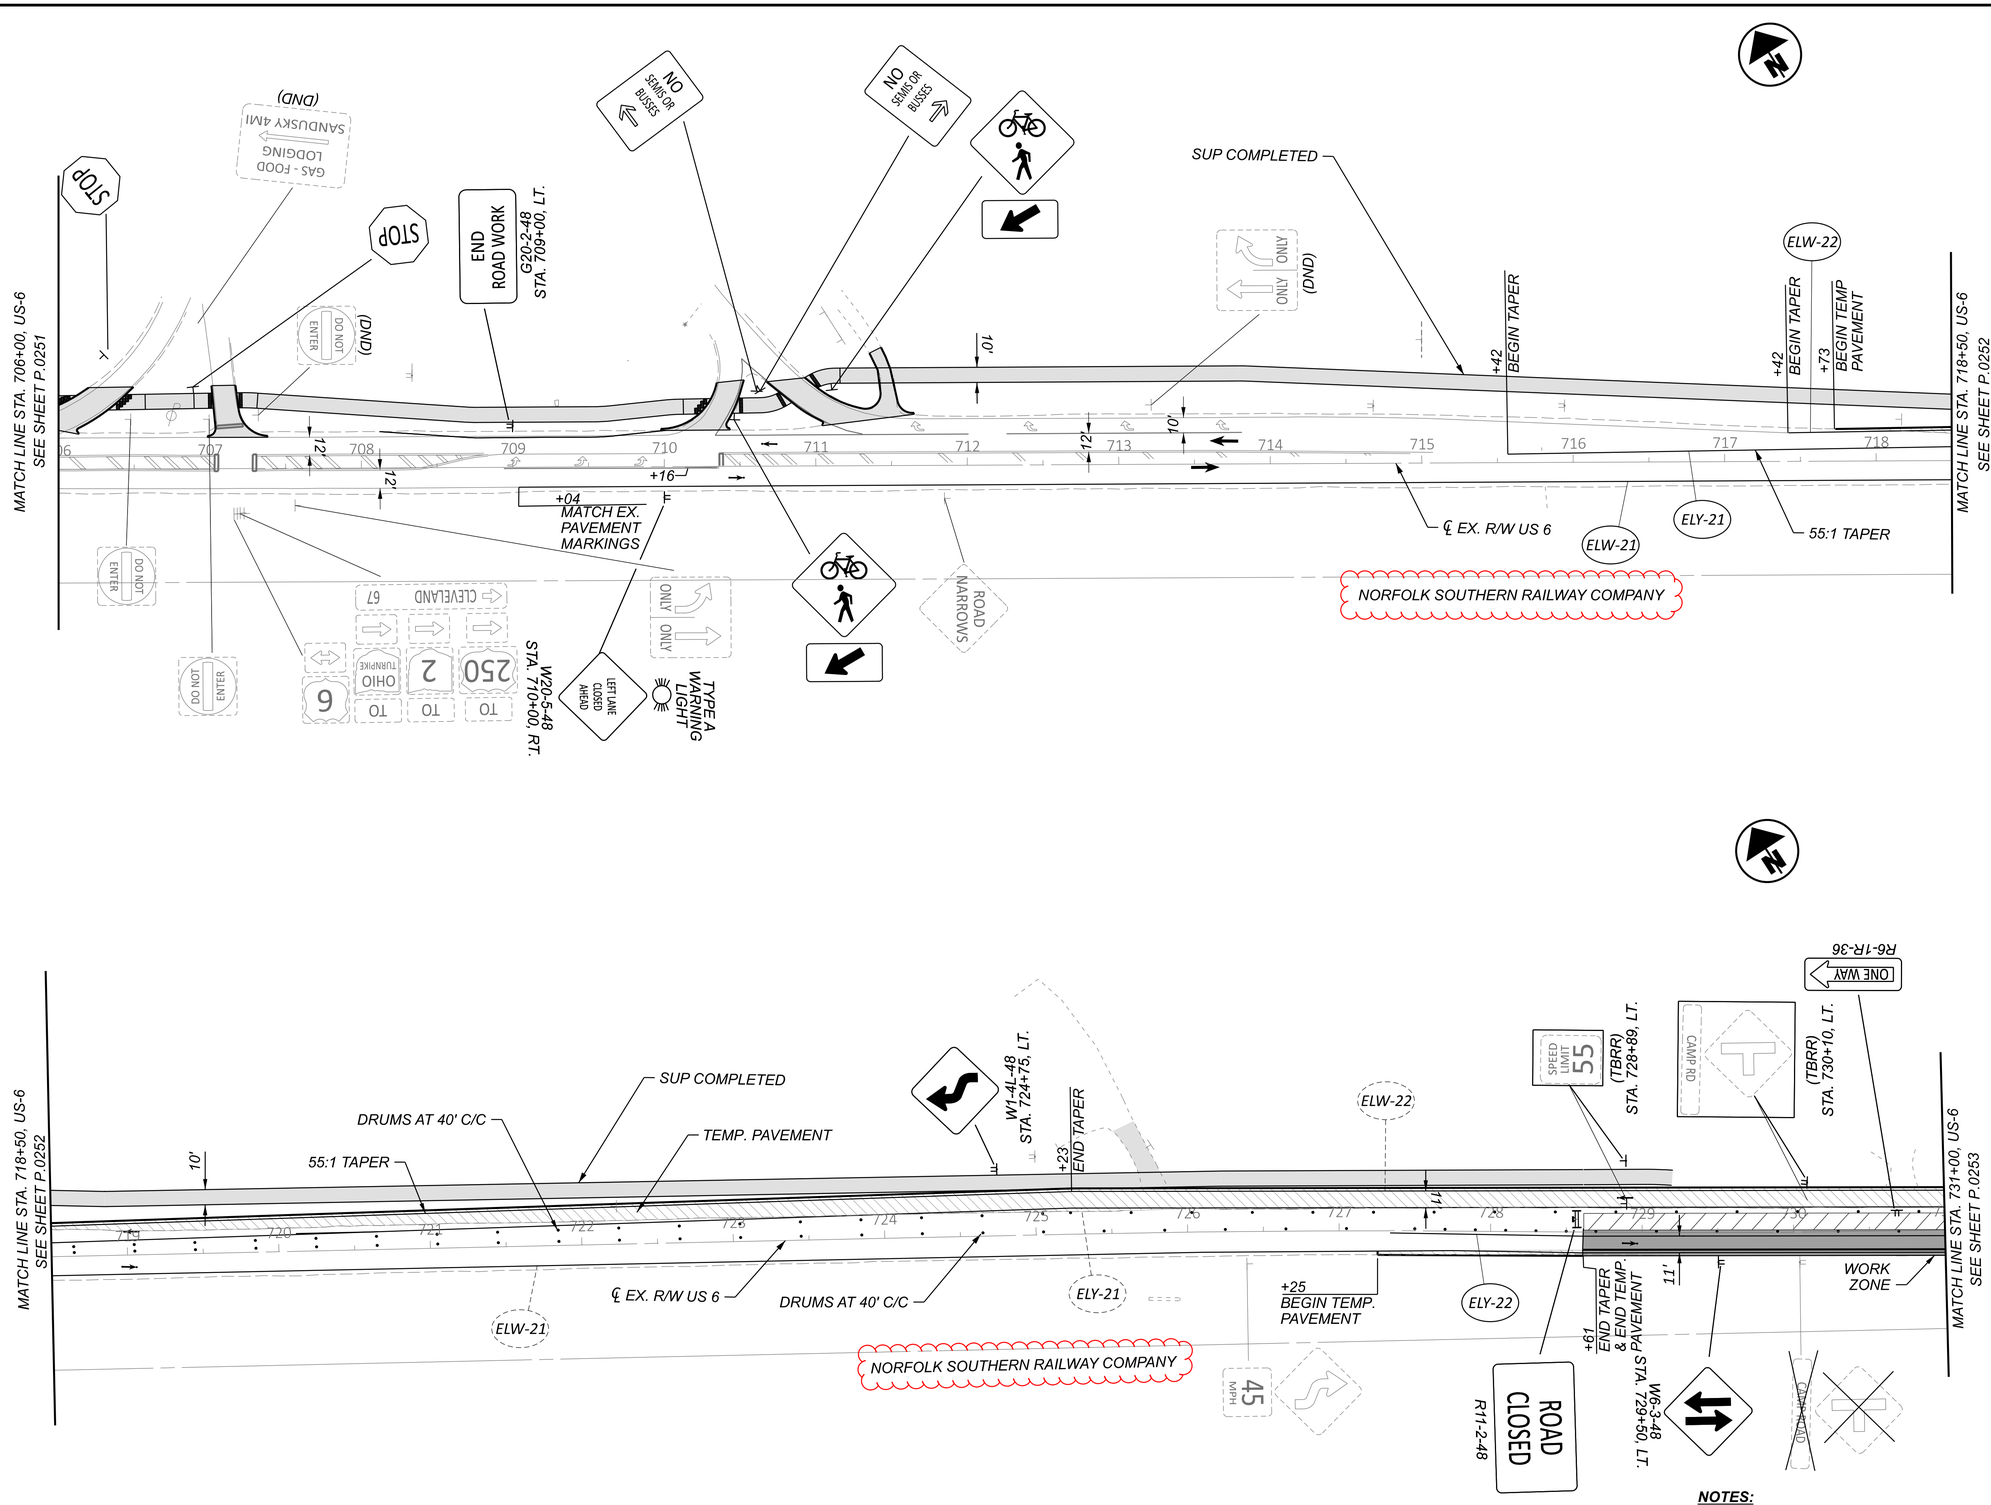

HORIZONTAL SCALE IN FEET
0 25 50 100

MAINTENANCE OF TRAFFIC - PHASE 2 (2027/2028 CONSTRUCTION)
US 6 - STA. 706+00.00 TO STA. 730+00.00

NOTES:

1. FOR MOT LEGEND, SEE SHEET P.0084
2. FOR PROPOSED SIGNING AND MARKING DETAILS, SEE TRAFFIC CONTROL PLANS.
3. MAINTAIN ACCESS TO DRIVES OR SIDE ROADS AT ALL TIMES. USE FLAGGING OPERATION AS NECESSARY.

DESIGN AGENCY
TRANSYSTEMS
400 W. NATIONWIDE BLVD., STE 225
COLUMBUS, OHIO 43215

DESIGNER	SSA
REVIEWER	SS 10/27/25
PROJECT ID	116570
SHEET	P.0257
TOTAL	1106

NOTES:

1. FOR MOT LEGEND, SEE SHEET P.0084.
2. FOR SIGNING AND PAVEMENT MARKING DETAILS, SEE TRAFFIC CONTROL PLANS.
3. MAINTAIN ACCESS TO DRIVES OR SIDE ROADS AT ALL TIMES. USE FLAGGING OPERATION AS NECESSARY.

HORIZONTAL SCALE IN FEET
0 25 50 100

MAINTENANCE OF TRAFFIC - PHASE 2 (2027/2028 CONSTRUCTION)
US 6 - STA. 731+00.00 TO STA. 743+50.00


ERI-US 0006-CONNECTIVITY CORRIDOR

DESIGN AGENCY
TRANSYSTEMS
400 W. NATIONWIDE BLVD., STE 225
COLUMBUS, OHIO 43215

DESIGNER: SSA
REVIEWER: SS 10/27/25
PROJECT ID: 116570
SHEET: P.0258 TOTAL: 1106

MODEL: CLP_SUP 2 - Plan 14 [Sheet] PAPERSIZE: 34x22 (in.) DATE: 2/26/2026 TIME: 10:06:10 AM PLTDRV: OHDOT_PDF_Levels.pltcfg PENTBL: OHDOT_Pen.tbl USER: hrthornton@gftinc.com WORKSPACE: OHDOTCfv02 WORKSET: 116570 PRODUCT: OpenRoadsDesigner 24.00.02.25
pw:\\ohiodot-pw.bentley.com:ohiodot-pw-02\Documents\01 Active Projects\District 03\Erie\116570\402 Engineering_TranSystems\MOT\Sheets\116570_MP002_CY2027.dgn

MODEL: CLP_SUP 1 - Plan 9-10 [Sheet] PAPERSIZE: 34x22 (in.) DATE: 2/26/2026 TIME: 10:10:48 AM PLTDRV: OHDOT_PDF_Levels.pltcfg PENTBL: OHDOT_Pen.tbl USER: hrthornton@gftinc.com WORKSPACE: OHDOTCEv02 WORKSET: 116570 PRODUCT: OpenRoadsDesigner 24.00.02.25
pw:\\ohiodot-pw.bentley.com:ohiodot-pw-02\Documents\01 Active Projects\District 03\Erie\116570\402-Engineering_TranSystems\MOT\Sheets\116570_MP003_CY2027.dgn

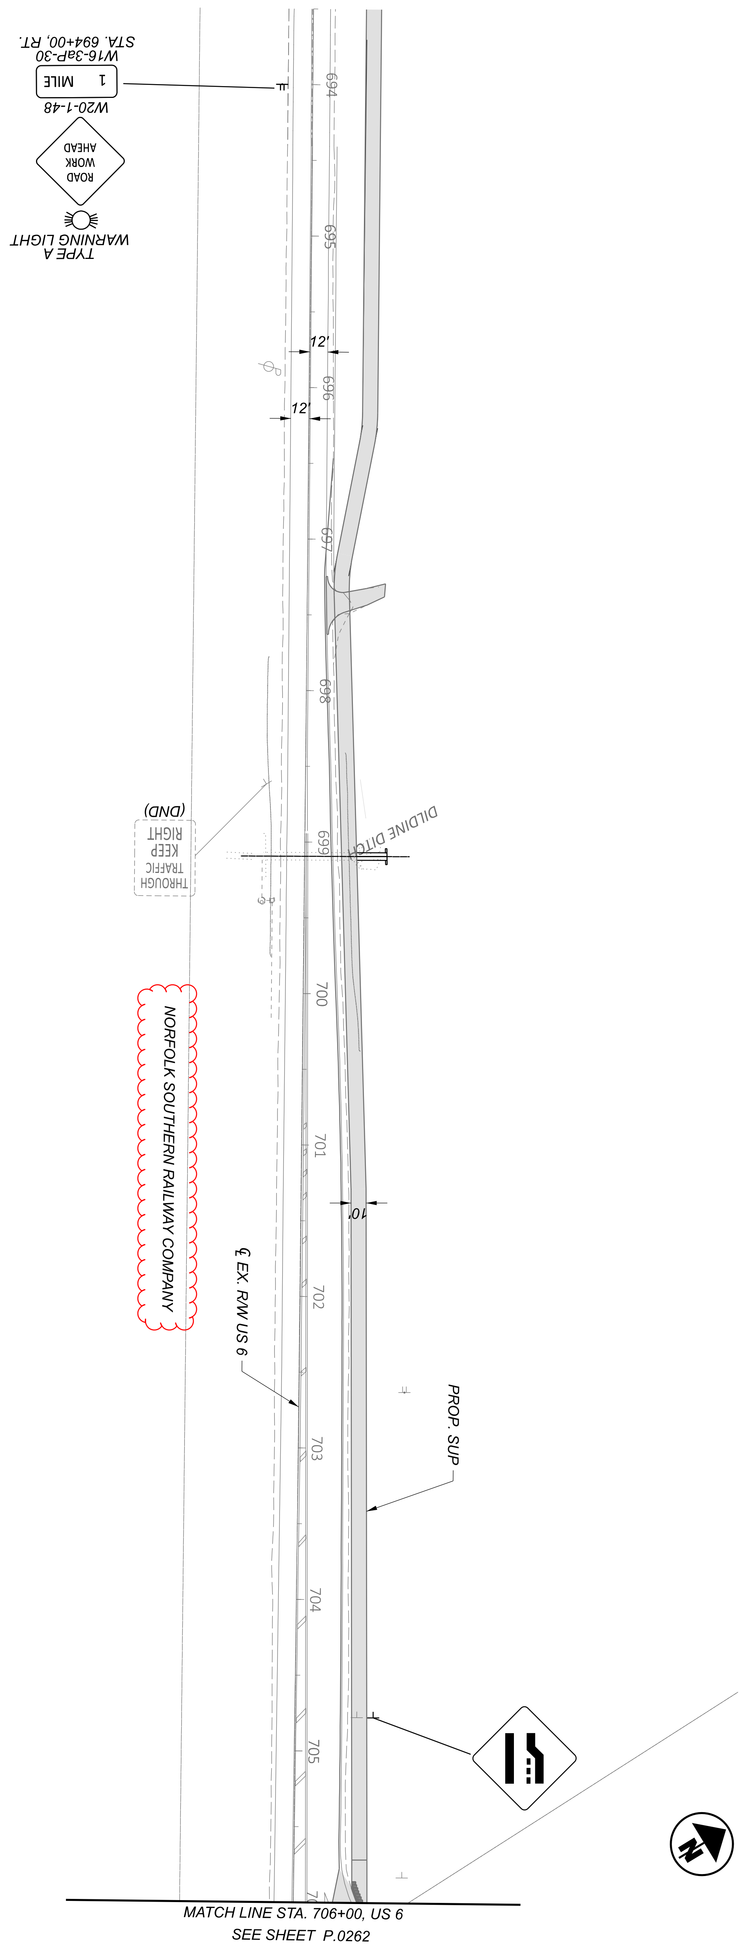

NOTE:

1. FOR MOT LEGEND, SEE SHEET P.0084.

SHEET	TOTAL
P.0266	1106

PROJECT ID: 116570

REVIEWER: SS 10/27/25

DESIGNER: SSA


DESIGN AGENCY: TRANSYSTEMS
400 W. NATIONWIDE BLVD., STE 220
COLUMBUS, OHIO 43215

MAINTENANCE OF TRAFFIC - PHASE 3 (2027/2028 CONSTRUCTION)
US 6 - STA. 671+50.00 TO STA. 706+00.00

HORIZONTAL SCALE IN FEET
0 50
25 100

ERI-US 0006-CONNECTIVITY CORRIDOR

MODEL: CLP_SUP 1 - Plan 12-13 [Sheet] PAPERSIZE: 34x22 (in.) DATE: 2/26/2026 TIME: 10:13:12 AM PLTDRV: OHDOT_PDF_Levels.pltcfg PENTBL: OHDOT_Pen.tbl USER: hrthornton@gftinc.com WORKSPACE: OHDOTCEv02 WORKSET: 116570 PRODUCT: OpenRoadsDesigner 24.00.02.25
pw:\\ohiodot-pw.bentley.com:ohiodot-pw-02\Documents\01 Active Projects\District 03\Erie\116570\402-Engineering_TranSystems\MOT\Sheets\116570_MP003_CY2027.dgn

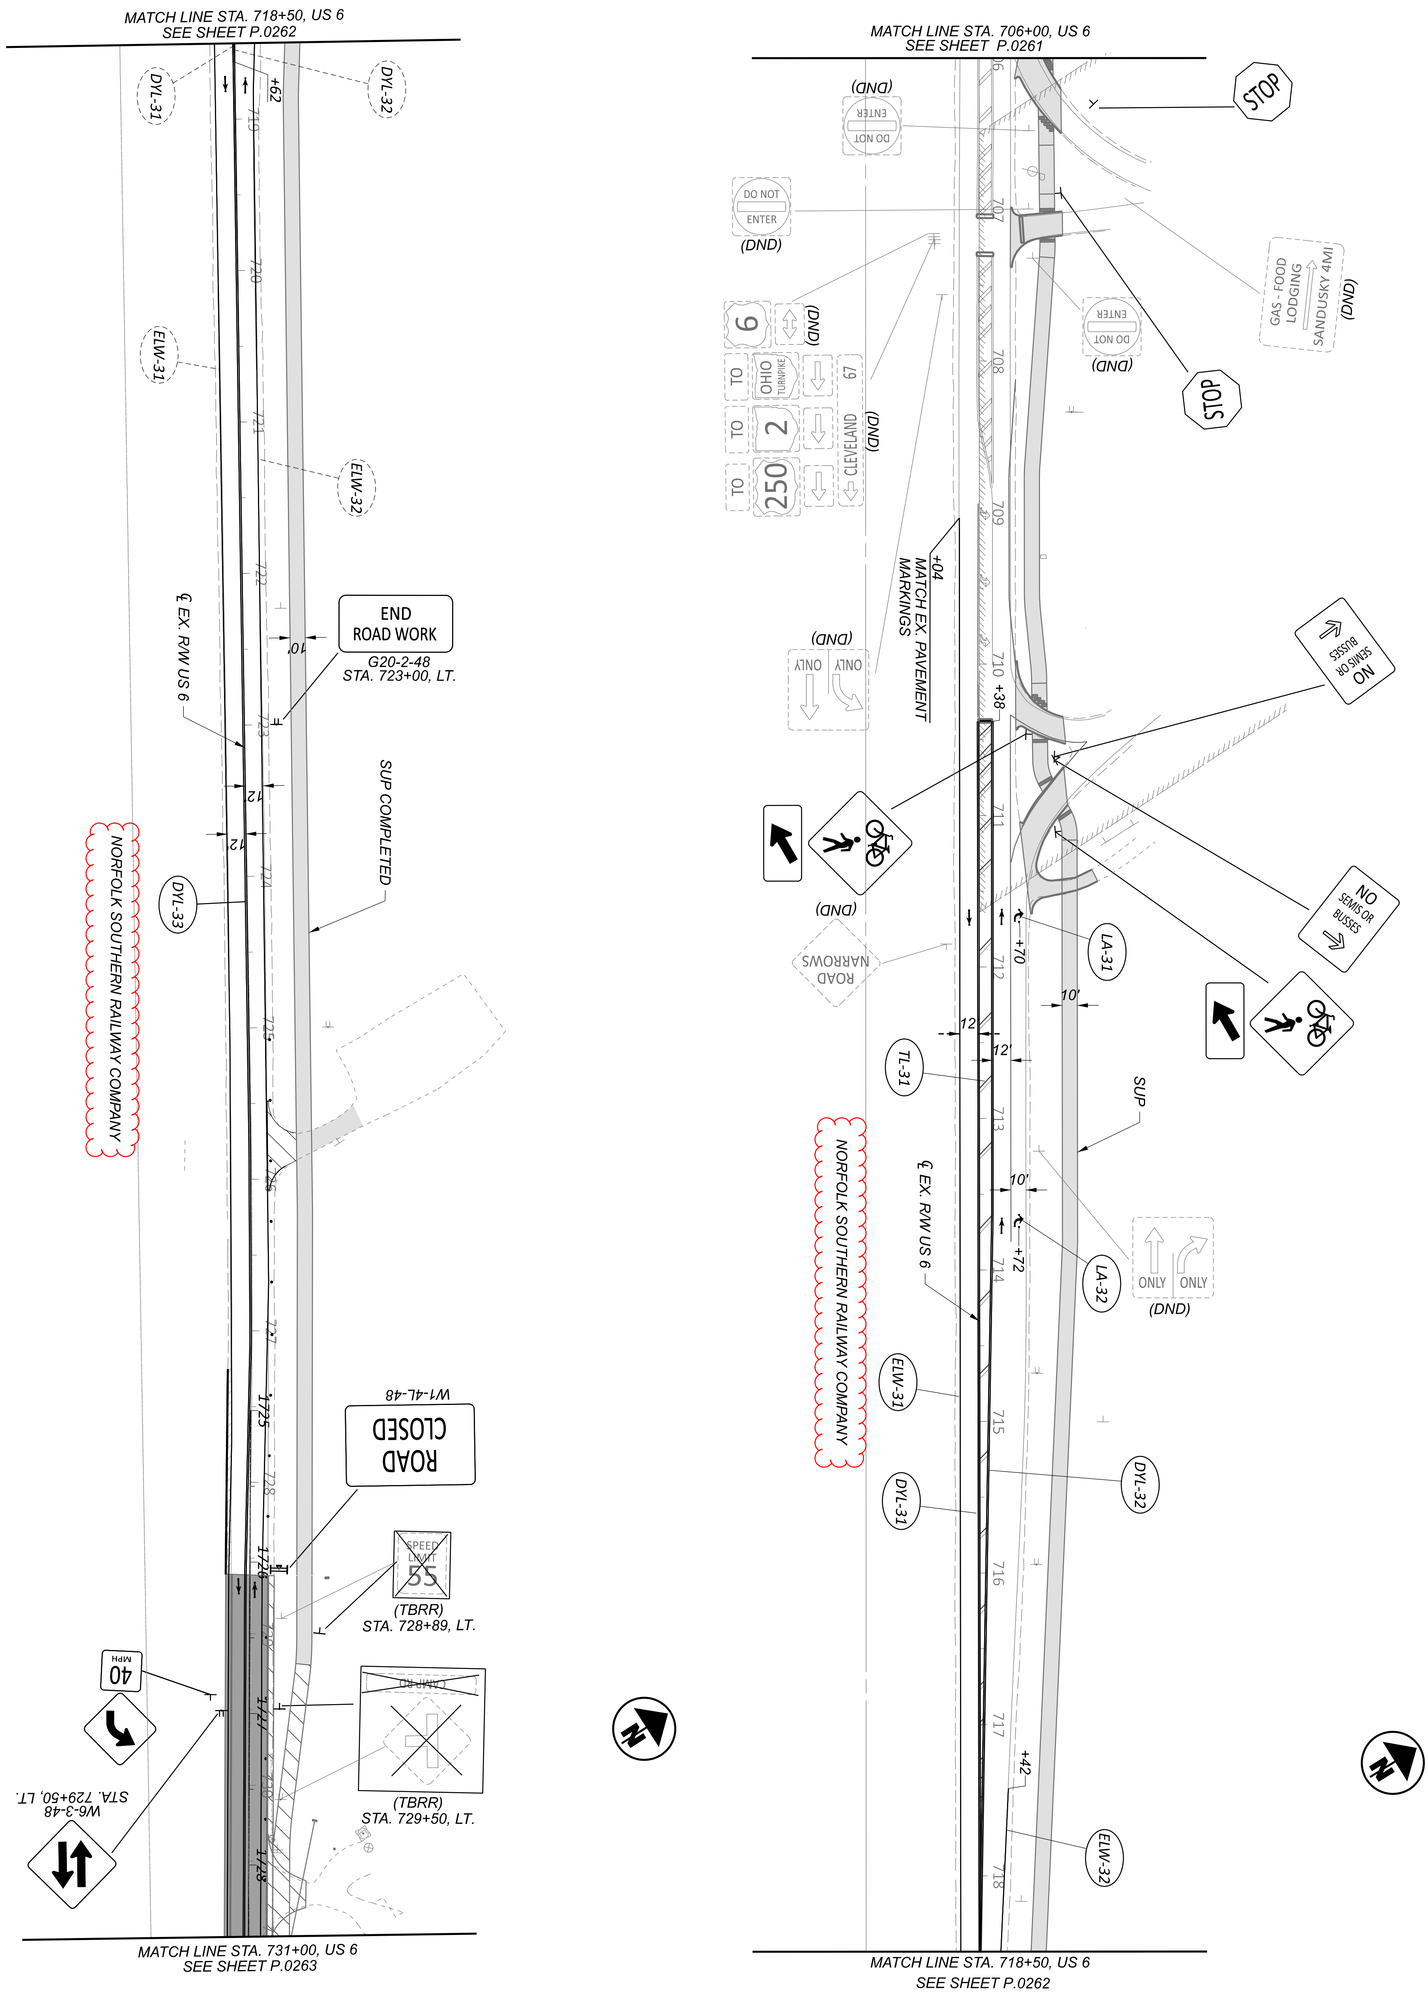

NOTE:
1. FOR MOT LEGEND, SEE SHEET P.0084.


SHEET P.0267	PROJECT ID 116570	REVIEWER SS 10/27/25	DESIGNER SSA	TRANSYSTEMS 400 W. NATIONWIDE BLVD., STE 220 COLUMBUS, OHIO 43215	DESIGN AGENCY
TOTAL 1106					

MAINTENANCE OF TRAFFIC - PHASE 3 (2027/2028 CONSTRUCTION)

HORIZONTAL SCALE IN FEET
0 50
25 100

MODEL: CLP_SUP 2 - Plan 14 [Sheet] PAPERSIZE: 34x22 (in.) DATE: 2/26/2026 TIME: 10:15:19 AM PLTDRV: OHDOT_PDF_Levels.pltcfg PENTBL: OHDOT_Pen.tbl USER: hrthornton@gftinc.com WORKSPACE: OHDOTCfx02 WORKSET: 116570 PRODUCT: OpenRoads Designer 24.00.02.25
pw:\\ohiodot-pw.bentley.com:ohiodot-pw-02\Documents\01 Active Projects\District 03\Erie\116570\402-Engineering_TranSystems\MOT\Sheets\116570_MP003_CY2027.dgn

ERI-US 0006-CONNECTIVITY CORRIDOR

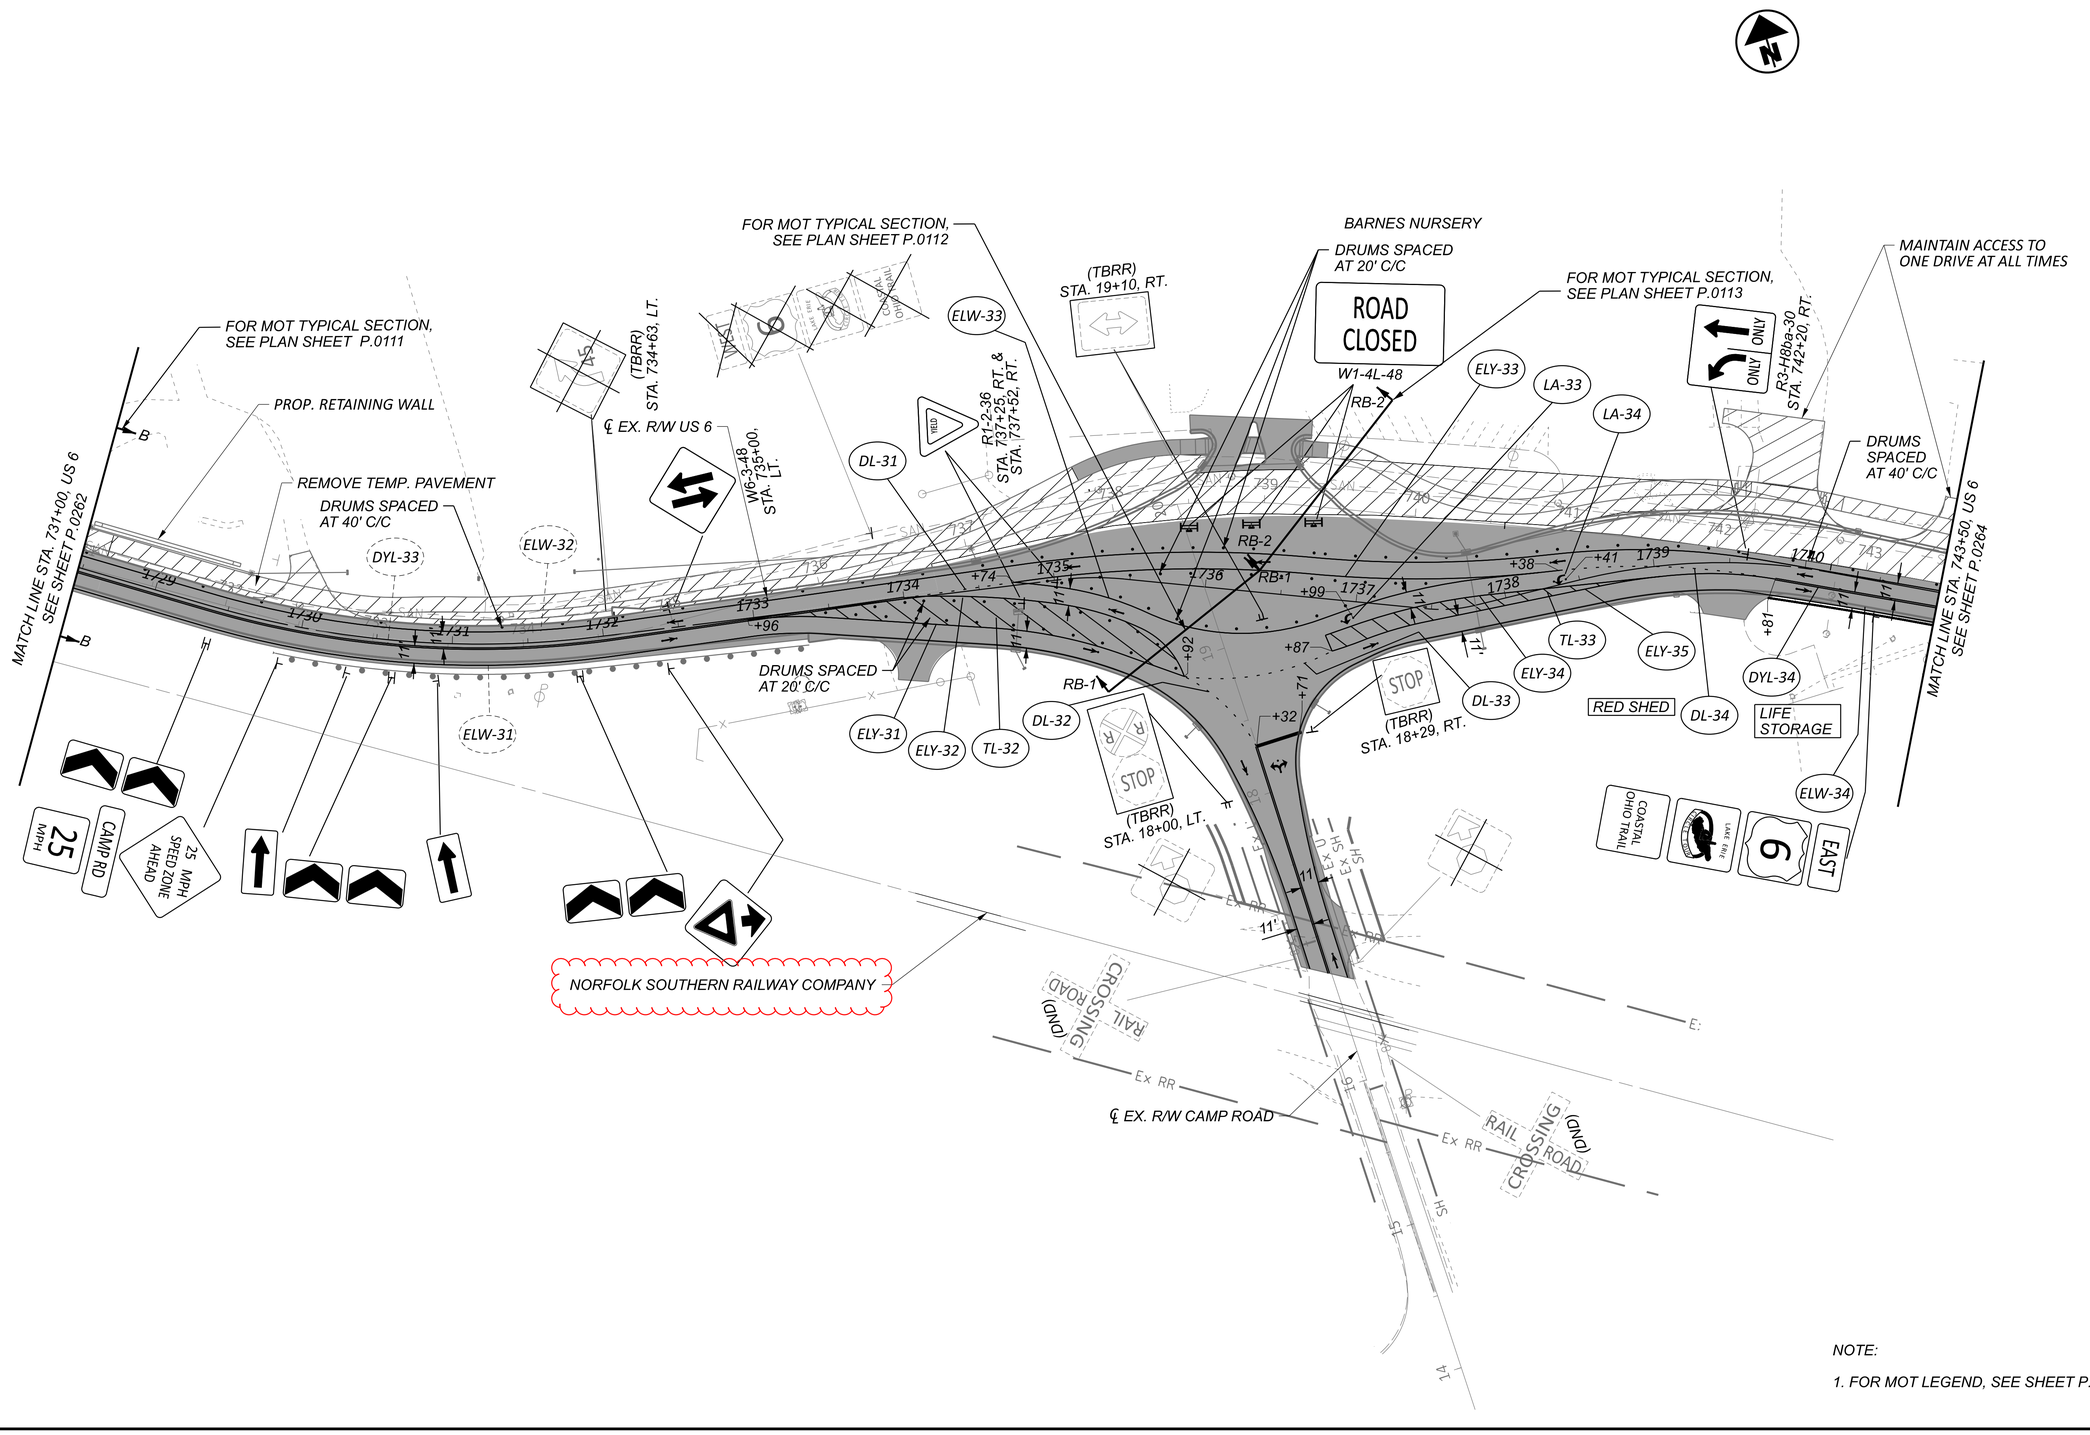

NOTE:

1. FOR MOT LEGEND, SEE SHEET P.0084.

HORIZONTAL SCALE IN FEET
0 25 50 100

MAINTENANCE OF TRAFFIC - PHASE 3 (2027/2028 CONSTRUCTION)
US 6 - STA. 731+00.00 TO STA. 743+50.00

DESIGN AGENCY
TRANSYSTEMS
400 W. NATIONWIDE BLVD., STE 225
COLUMBUS, OHIO 43215

DESIGNER	SSA
REVIEWER	SS 10/27/25
PROJECT ID	116570
SHEET	P.0268
TOTAL	1106

SHEET NUM.																PART.	ITEM	ITEM EXT	GRAND TOTAL	UNIT	DESCRIPTION	SEE SHEET NO.
P.0064	P.0069	P.0077	P.0301	P.0305	P.0312	P.0316	P.0346	P.0353	P.0363	P.0367	P.0371	P.0766	P.0768									
																					ROADWAY	
LS																	201	11000	LS		CLEARING AND GRUBBING	
			2	5													202	20010	7	EACH	HEADWALL REMOVED	
			24,519	41,119													202	23000	65,638	SY	PAVEMENT REMOVED	
				10,599													202	30000	10,599	SF	WALK REMOVED	
			242	1,650													202	32000	1,892	FT	CURB REMOVED	
			131	3,604													202	32500	3,735	FT	CURB AND GUTTER REMOVED	
			121	4,860					746								202	35100	5,727	FT	PIPE REMOVED, 24" DIAMETER AND UNDER	
			57	61													202	35200	118	FT	PIPE REMOVED, OVER 24" DIAMETER	
			1,061	4,320													202	38000	5,381	FT	GUARDRAIL REMOVED	
			11	41													202	53100	52	EACH	MAILBOX REMOVED	
				6													202	58000	6	EACH	MANHOLE REMOVED	
			1	25													202	58100	26	EACH	CATCH BASIN REMOVED	
			768	933													202	75000	1,701	FT	FENCE REMOVED	
			2														202	75250	2	EACH	GATE REMOVED	
									5								202	75600	5	EACH	METER VAULT REMOVED	
									16								202	75610	16	EACH	VALVE BOX REMOVED, INCLUDES VALVE	
				1													202	98100	1	EACH	REMOVAL MISC.: BILLBOARD	P.0069
				35													202	98100	35	EACH	REMOVAL MISC.: BOULDER	P.0068
			4														202	98100	4	EACH	REMOVAL MISC.: CONCRETE POST	P.0069
			2														202	98100	2	EACH	REMOVAL MISC.: ELECTRIC OUTLET	P.0068
				1													202	98100	1	EACH	REMOVAL MISC.: FLAG POLE	P.0069
			1	75													202	98100	76	EACH	REMOVAL MISC.: LANDSCAPE ROCK	P.0068
			3	3													202	98100	6	EACH	REMOVAL MISC.: PRIVATE LIGHT POLE	P.0068
			9	26													202	98100	35	EACH	REMOVAL MISC.: PRIVATE SIGN	P.0069
			9														202	98100	9	EACH	REMOVAL MISC.: STEEL POST	P.0069
			3														202	98100	3	EACH	REMOVAL MISC.: WATER FAUCET	P.0068
			7	2													202	98100	9	EACH	REMOVAL MISC.: WOOD POST	P.0069
				2													202	98100	2	EACH	REMOVAL MISC.: YARD ART	P.0069
			38														202	98200	38	FT	REMOVAL MISC.: LANDSCAPE WALL	P.0069
			4														202	98300	4	SY	REMOVAL MISC.: LANDSCAPE BED	P.0069
		70,400															SPECIAL	20307504	70,400	FT	WICK DRAIN	P.0122
	51,086																203	10000	51,086	CY	EXCAVATION	
										849	2,786						203	10001	3,635	CY	EXCAVATION, AS PER PLAN	P.0840
	106,537						3,158										203	20000	109,695	CY	EMBANKMENT	
		3,260															203	35120	3,260	CY	GRANULAR MATERIAL, TYPE C	P.0122
		2															SPECIAL	20365000	2	EACH	SETTLEMENT PLATFORM	P.0076
							3,140	3,214				4,290	5043				204	10000	15,687	SY	SUBGRADE COMPACTION	
							1,221	1,333									204	13000	2,554	CY	EXCAVATION OF SUBGRADE (14" DEEP)	
							1,221	1,333									204	30010	2,554	CY	GRANULAR MATERIAL, TYPE B	
							16	28									204	45000	44	HOUR	PROOF ROLLING	
							3,140	3,259									204	51000	6,399	SY	GEOGRID	
							1,529	1,577									206	10500	3,106	TON	CEMENT	
							50,661	52,255									206	11000	102,916	SY	CURING COAT	
							50,661	52,255									206	15020	102,916	SY	CEMENT STABILIZED SUBGRADE, 14 INCHES DEEP	
								LS									206	30000	LS		MIXTURE DESIGN FOR CHEMICALLY STABILIZED SOILS	
					626	2,488											606	15050	3,114	FT	GUARDRAIL, TYPE MGS	
					2	7											606	26150	9	EACH	ANCHOR ASSEMBLY, MGS TYPE E [MASH 2016]	
					1	9											606	26550	10	EACH	ANCHOR ASSEMBLY, MGS TYPE T	
						2											606	35002	2	EACH	MGS BRIDGE TERMINAL ASSEMBLY, TYPE 1	
						2											606	35102	2	EACH	MGS BRIDGE TERMINAL ASSEMBLY, TYPE 2	
						4											606	35140	4	EACH	BRIDGE TERMINAL ASSEMBLY, TYPE 4	
					2												606	60028	2	EACH	IMPACT ATTENUATOR, TYPE 2 (BIDIRECTIONAL), (55MPH, 20-IN)	
						573											607	15000	573	FT	FENCE, TYPE 47	
						2,159											607	70000	2,159	FT	FENCELINE SEEDING AND MULCHING	
					1,011	1,586											607	98000	2,597	FT	FENCE, MISC.: WOOD FENCE	P.0068
						1,324											608	10000	1,324	SF	4" CONCRETE WALK	
					4,495	5,038											608	52000	9,533	SF	CURB RAMP	

GENERAL SUMMARY

ERI-US 0006-CONNECTIVITY CORRIDOR

DESIGN AGENCY
TRANSYSTEMS
400 W. NATIONWIDE BLVD., STE 225
COLUMBUS, OHIO 43215

DESIGNER: JIW

REVIEWER: GHM 10/27/25

PROJECT ID: 116570

SHEET: P.0285 TOTAL: 1106

MODEL: Sheet 1 PAPERSIZE: 34x22 (in.) DATE: 2/26/2026 TIME: 11:24:07 AM PLTDRV: OHDOT_PDF.pltcfg PENTBL: OHDOT_Pen.tbl USER: jcolon@gfinc.com WORKSPACE: OHDOTCEv02 WORKSET: 116570 PRODUCT: OpenRoadsDesigner 24.00.00.205
pw:\\ohiodot-pw.bentley.com:ohiodot-pw-02\Documents\01 Active Projects\District 03\Erie\116570\402-Engineering_TranSystems\Roadway\Sheets\116570_GG001.dgn

PART.								ITEM	ITEM EXT	GRAND TOTAL	UNIT	DESCRIPTION	SEE SHEET NO.
01/SAF	02/SAF	03/S50	04/ENH	05/ENH	06/BRO	07/BRO	08/NFA						
												ROADWAY	
LS	LS	LS	LS	LS				201	11000	LS		CLEARING AND GRUBBING	
	2	1	2	2				202	20010	7	EACH	HEADWALL REMOVED	
42,522	8,906	9,020	5,190					202	23000	65,638	SY	PAVEMENT REMOVED	
353			10,246					202	30000	10,599	SF	WALK REMOVED	
942	76		793	81				202	32000	1,892	FT	CURB REMOVED	
3,416			319					202	32500	3,735	FT	CURB AND GUTTER REMOVED	
1,597	54	2,695	1,268	89			24	202	35100	5,727	FT	PIPE REMOVED, 24" DIAMETER AND UNDER	
		61	57					202	35200	118	FT	PIPE REMOVED, OVER 24" DIAMETER	
1,498	1,786	718	1,017	362				202	38000	5,381	FT	GUARDRAIL REMOVED	
13		13	26					202	53100	52	EACH	MAILBOX REMOVED	
1		1	4					202	58000	6	EACH	MANHOLE REMOVED	
14	2	4	4	2				202	58100	26	EACH	CATCH BASIN REMOVED	
437		54	1,210					202	75000	1,701	FT	FENCE REMOVED	
1			1					202	75250	2	EACH	GATE REMOVED	
3		2						202	75600	5	EACH	METER VAULT REMOVED	
3		5	4				4	202	75610	16	EACH	VALVE BOX REMOVED, INCLUDES VALVE	
			1					202	98100	1	EACH	REMOVAL MISC.: BILLBOARD	P.0068
4		13	18					202	98100	35	EACH	REMOVAL MISC.: BOULDER	P.0069
			4					202	98100	4	EACH	REMOVAL MISC.: CONCRETE POST	P.0069
2								202	98100	2	EACH	REMOVAL MISC.: ELECTRIC OUTLET	P.0068
			1					202	98100	1	EACH	REMOVAL MISC.: FLAG POLE	P.0069
1		41	34					202	98100	76	EACH	REMOVAL MISC.: LANDSCAPE ROCK	P.0068
			6					202	98100	6	EACH	REMOVAL MISC.: PRIVATE LIGHT POLE	P.0068
9		7	19					202	98100	35	EACH	REMOVAL MISC.: PRIVATE SIGN	P.0069
			9					202	98100	9	EACH	REMOVAL MISC.: STEEL POST	P.0069
			3					202	98100	3	EACH	REMOVAL MISC.: WATER FAUCET	P.0068
7			2					202	98100	9	EACH	REMOVAL MISC.: WOOD POST	P.0069
		1	1					202	98100	2	EACH	REMOVAL MISC.: YARD ART	P.0069
37			1					202	98200	38	FT	REMOVAL MISC.: LANDSCAPE WALL	P.0069
4								202	98300	4	SY	REMOVAL MISC.: LANDSCAPE BED	P.0069
70,400								SPECIAL	20307504	70,400	FT	WICK DRAIN	P.0122
13,350	6,444	14,125	16,856	311				203	10000	51,086	CY	EXCAVATION	
574	2,786		275					203	10001	3,635	CY	EXCAVATION, AS PER PLAN	P.0840
46,845	31,385	9,906	19,228	2,331				203	20000	109,695	CY	EMBANKMENT	
3,260								203	35120	3,260	CY	GRANULAR MATERIAL, TYPE C	P.0122
2								SPECIAL	20365000	2	EACH	SETTLEMENT PLATFORM	P.0076
5,464		5,808	4,415					204	10000	15,687	SY	SUBGRADE COMPACTION	
		1,328	1,226					204	13000	2,554	CY	EXCAVATION OF SUBGRADE (14" DEEP)	
		1,328	1,226					204	30010	2,554	CY	GRANULAR MATERIAL, TYPE B	
27	3	7	7					204	45000	44	HOUR	PROOF ROLLING	
		3,259	3,140					204	51000	6,399	SY	GEOGRID	
1,605	173	320	983	25				206	10500	3,106	TON	CEMENT	
53,169	5,740	10,612	32,557	838				206	11000	102,916	SY	CURING COAT	
53,169	5,740	10,612	32,557	838				206	15020	102,916	SY	CEMENT STABILIZED SUBGRADE, 14 INCHES DEEP	
LS	LS	LS	LS	LS				206	30000	LS		MIXTURE DESIGN FOR CHEMICALLY STABILIZED SOILS	
1,082	1,295	737						606	15050	3,114	FT	GUARDRAIL, TYPE MGS	
2.7	3.3	3						606	26150	9	EACH	ANCHOR ASSEMBLY, MGS TYPE E [MASH 2016]	
1.7	5.3	3						606	26550	10	EACH	ANCHOR ASSEMBLY, MGS TYPE T	
	2							606	35002	2	EACH	MGS BRIDGE TERMINAL ASSEMBLY, TYPE 1	
	2							606	35102	2	EACH	MGS BRIDGE TERMINAL ASSEMBLY, TYPE 2	
		4						606	35140	4	EACH	BRIDGE TERMINAL ASSEMBLY, TYPE 4	
2								606	60028	2	EACH	IMPACT ATTENUATOR, TYPE 2 (BIDIRECTIONAL), (55MPH, 20-IN)	
510				63				607	15000	573	FT	FENCE, TYPE 47	
510	768		553	328				607	70000	2,159	FT	FENCELINE SEEDING AND MULCHING	
	768		1,564	265				607	98000	2,597	FT	FENCE, MISC.: WOOD FENCE	P.0068
231			1,093					608	10000	1,324	SF	4" CONCRETE WALK	
819	581		7,893	240				608	52000	9,533	SF	CURB RAMP	

ERI-US 0006-CONNECTIVITY CORRIDOR

GENERAL SUMMARY

DESIGN AGENCY
TRANSYSTEMS
400 W. NATIONWIDE BLVD., STE 225
COLUMBUS, OHIO 43215

DESIGNER: JIW
REVIEWER: GHM 10/27/25
PROJECT ID: 116570
SHEET: P.0286 TOTAL: 1106

MODEL: Sheet 1.1 PAPERSIZE: 34x22 (in.) DATE: 2/26/2026 TIME: 12:16:35 PM PLTDRV: OHDOT_PDF.pltcfg PENTBL: OHDOT_Pen.tbl USER: jolon@gfiinc.com WORKSPACE: OHDOTCEv02 WORKSET: 116570 PRODUCT: OpenRoadsDesigner 24.00.00.205
pw:\\ohiodot-pw.bentley.com:ohiodot-pw-02\Documents\01 Active Projects\District 03\Erie\116570\402-Engineering_TranSystems\Roadway\Sheets\116570_GG001.dgn

PART.								ITEM	ITEM EXT	GRAND TOTAL	UNIT	DESCRIPTION	SEE SHEET NO.
01/SAF	02/SAF	03/S50	04/ENH	05/ENH	06/BRO	07/BRO	08/NFA						
												DRAINAGE	
28.52	2.28	2.16	7.23					602	20000	40.19	CY	CONCRETE MASONRY	
		250	250					605	05200	500	FT	4" UNCLASSIFIED PIPE UNDERDRAINS	
192	1,028		195					605	05201	1,415	FT	4" UNCLASSIFIED PIPE UNDERDRAINS, AS PER PLAN	P.0840
21,544	6,810	12,827	23,988	363				605	06000	65,532	FT	4" BASE PIPE UNDERDRAINS	
13		5						611	00100	18	FT	4" CONDUIT, TYPE B, 707.31	
	129							611	00200	129	FT	4" CONDUIT, TYPE C	
125		25	135					611	00406	285	FT	4" CONDUIT, TYPE F	
1,179	273	587	669	29				611	00410	2,737	FT	4" CONDUIT, TYPE F FOR UNDERDRAIN OUTLET	
98								611	00900	98	FT	6" CONDUIT, TYPE B	
			16					611	00900	16	FT	6" CONDUIT, TYPE B, 707.42	
10								611	01800	10	FT	8" CONDUIT, TYPE B, 707.31	
1,169	45	1,724	552					611	04400	3,490	FT	12" CONDUIT, TYPE B	
5	12							611	04400	17	FT	12" CONDUIT, TYPE B, 707.33	
25								611	04401	25	FT	12" CONDUIT, TYPE B, AS PER PLAN, CONCRETE ENCASED, INCLUDES ROCK EXCAVATION	P.0067
687								611	04401	687	FT	12" CONDUIT, TYPE B, AS PER PLAN, INCLUDES ROCK EXCAVATION	P.0067
12								611	04600	12	FT	12" CONDUIT, TYPE C	
141			43					611	04901	184	FT	12" CONDUIT, TYPE D, AS PER PLAN, 706.02	P.0067
86								611	05700	86	FT	15" CONDUIT, TYPE A	
64	380	1,120						611	05900	1,564	FT	15" CONDUIT, TYPE B	
5		5						611	05900	10	FT	15" CONDUIT, TYPE B, 707.42	
52								611	05901	52	FT	15" CONDUIT, TYPE B, AS PER PLAN, CONCRETE ENCASED, INCLUDES ROCK EXCAVATION	P.0067
277		304						611	05901	581	FT	15" CONDUIT, TYPE B, AS PER PLAN, INCLUDES ROCK EXCAVATION	P.0067
44	70		237					611	06100	351	FT	15" CONDUIT, TYPE C	
31								611	06401	31	FT	15" CONDUIT, TYPE D, AS PER PLAN, 706.02	P.0067
24	27							611	06700	51	FT	15" CONDUIT, TYPE F, 707.05 TYPE C, 707.21, OR 707.33	
278		260	283					611	07400	821	FT	18" CONDUIT, TYPE B	
		5						611	07400	5	FT	18" CONDUIT, TYPE B, 706.02	
254								611	07401	254	FT	18" CONDUIT, TYPE B, AS PER PLAN, INCLUDES ROCK EXCAVATION	P.0067
57		480						611	07600	537	FT	18" CONDUIT, TYPE C	
203								611	07901	203	FT	18" CONDUIT, TYPE D, AS PER PLAN, 706.02	P.0067
	100							611	09100	100	FT	21" CONDUIT, TYPE C	
276		1,105	97					611	10400	1,478	FT	24" CONDUIT, TYPE B	
		33						611	11200	33	FT	24" CONDUIT, TYPE F, 707.05 TYPE C, 707.21, OR 707.33	
212		376						611	13400	588	FT	30" CONDUIT, TYPE B	
24								611	13600	24	FT	30" CONDUIT, TYPE C	
		8.5	8.5					611	16400	17	FT	36" CONDUIT, TYPE B	
		78						611	19400	78	FT	42" CONDUIT, TYPE B	
			20					611	23600	20	FT	60" CONDUIT, TYPE A, 707.21 OR 707.22	
108								611	26000	108	FT	72" CONDUIT, TYPE A	
87								611	52700	87	FT	29" X 45" CONDUIT, TYPE A, 706.04	
			525					611	53104	525	FT	43" X 68" CONDUIT, TYPE C, 706.04	
			4					611	94910	4	FT	8' X 6' CONDUIT, TYPE A, 706.05	
			23					611	94936	23	FT	9' X 4' CONDUIT, TYPE A, 706.05	
12	4	3						611	98150	19	EACH	CATCH BASIN, NO. 3	
20	7	6	2					611	98180	35	EACH	CATCH BASIN, NO. 3A	
			2					611	98271	2	EACH	CATCH BASIN, NO. 4A, AS PER PLAN	P.0067
		9						611	98300	9	EACH	CATCH BASIN, NO. 5	
2	1	1	1					611	98370	5	EACH	CATCH BASIN, NO. 6	
6	1	14	3					611	98470	24	EACH	CATCH BASIN, NO. 2-2B	
	1	3						611	98510	4	EACH	CATCH BASIN, NO. 2-3	
4		1	1					611	98630	6	EACH	CATCH BASIN ADJUSTED TO GRADE	
3		2						611	98631	5	EACH	CATCH BASIN ADJUSTED TO GRADE, AS PER PLAN	P.0067
1								611	98635	1	EACH	CATCH BASIN RECONSTRUCTED TO GRADE, AS PER PLAN	P.0067
			1					611	98700	1	EACH	INLET, SIDE DITCH	
1								611	98820	1	EACH	INLET, NO. 3D	
7		1						611	99574	8	EACH	MANHOLE, NO. 3	
13		7	2				3	611	99654	25	EACH	MANHOLE ADJUSTED TO GRADE	
17		2	26					611	99710	45	EACH	PRECAST REINFORCED CONCRETE OUTLET	
			1					611	99731	1	EACH	JUNCTION CHAMBER, AS PER PLAN	P.0833
570	30	80	310	10				SPECIAL	61199820	1,000	LB	MISCELLANEOUS METAL	P.0067

GENERAL SUMMARY

ERI-US 0006-CONNECTIVITY CORRIDOR

DESIGN AGENCY
TRANSYSTEMS
400 W. NATIONWIDE BLVD., STE 225
COLUMBUS, OHIO 43215

DESIGNER JIW

REVIEWER GHM 10/27/25

PROJECT ID 116570

SHEET P.0290 TOTAL 1106

MODEL: Sheet 3.1 PAPERSIZE: 34x22 (in.) DATE: 2/26/2026 TIME: 9:21:39 AM PLTDRV: OHDOT_PDF_Levels.pltcfg PENTBL: OHDOT_Pen.tbl USER: rjgreve@gftinc.com WORKSPACE: OHDOTCEv02 WORKSET: 116570 PRODUCT: OpenRoadsDesigner 24.00.02.25
pw:\\ohiodot-pw.bentley.com:ohiodot-pw-02\Documents\01 Active Projects\District 03\Erie\116570\402-Engineering_TranSystems\Roadway\Sheets\116570_GG001.dgn

SHEET NUM.												PART.	ITEM	ITEM EXT	GRAND TOTAL	UNIT	DESCRIPTION	SEE SHEET NO.
P.0069	P.0071	P.0312	P.0316	P.0346	P.0353	P.0363	P.0766	P.0768	P.0874									
																	PAVEMENT	
	14				14,583								254	01000	14,597	SY	PAVEMENT PLANING, ASPHALT CONCRETE (DEPTH VARIES 0.02' - 0.75')	
				4,690	5,620								301	56000	10,310	CY	ASPHALT CONCRETE BASE, PG64-22, (449)	
				8,671	11,366		840	1,016					304	20000	21,893	CY	AGGREGATE BASE	
				5,029	7,653		194	633					407	20000	13,509	GAL	NON-TRACKING TACK COAT	
							143	154					441	70600	297	CY	ASPHALT CONCRETE INTERMEDIATE COURSE, TYPE 1, (449), (DRIVEWAYS)	
							158	204					441	70700	362	CY	ASPHALT CONCRETE INTERMEDIATE COURSE, TYPE 2, (449), (DRIVEWAYS)	
				1,162	2,001								442	10000	3,163	CY	ASPHALT CONCRETE SURFACE COURSE, 12.5 MM, TYPE A (446)	
				1,356	2,328								442	20171	3,684	CY	ASPHALT CONCRETE INTERMEDIATE COURSE, 12.5 MM, TYPE A (448), AS PER PLAN	P.0067
				687	412								442	22001	1,099	CY	ASPHALT CONCRETE SURFACE COURSE, 9.5 MM, TYPE A (449), AS PER PLAN	P.0066
				1,144	687								442	22401	1,831	CY	ASPHALT CONCRETE INTERMEDIATE COURSE, 19 MM, TYPE A (449), AS PER PLAN	P.0067
				875	1,043								451	13011	1,918	SY	8" REINFORCED CONCRETE PAVEMENT, CLASS QC 1P, AS PER PLAN	P.0068
							53	107					452	10010	160	SY	6" NON-REINFORCED CONCRETE PAVEMENT, CLASS QC 1P	
				1,229	2,058								452	10011	3,287	SY	6" NON-REINFORCED CONCRETE PAVEMENT, CLASS QC 1P, AS PER PLAN	P.0067
							292	265					452	12010	557	SY	8" NON-REINFORCED CONCRETE PAVEMENT, CLASS QC 1P	
		3,733	7,173										609	12000	10,906	FT	COMBINATION CURB AND GUTTER, TYPE 2	
		637	1,099										609	22001	1,736	FT	CURB, TYPE 3-B, AS PER PLAN	P.0067
		453	792										609	24000	1,245	FT	CURB, TYPE 4-A	
		2,567	5,793										609	26000	8,360	FT	CURB, TYPE 6	
			93										609	26001	93	FT	CURB, TYPE 6, AS PER PLAN	P.0792
			303										609	28000	303	FT	CURB, TYPE 7	
									5.08				618	41000	5.08	MILE	RUMBLE STRIPES, EDGE LINE (ASPHALT CONCRETE)	
									0.04				618	42000	0.04	MILE	RUMBLE STRIPES, EDGE LINE (CONCRETE)	
									3.71				618	43000	3.71	MILE	RUMBLE STRIPES, CENTER LINE (ASPHALT CONCRETE)	
									0.02				618	44000	0.02	MILE	RUMBLE STRIPES, CENTER LINE (CONCRETE)	
									3.71				874	21000	3.71	MILE	LONGITUDINAL JOINT PREPARATION	
																	WATER WORK	
						237							638	01130	237	FT	6" WATER MAIN POLYVINYL CHLORIDE PIPE AND FITTINGS, AWWA C900, DR18	
						406							638	01720	406	FT	8" WATER MAIN POLYVINYL CHLORIDE PIPE AND FITTINGS, AWWA C900, DR18	
						82							638	01721	82	FT	8" WATER MAIN POLYVINYL CHLORIDE PIPE AND FITTINGS, AWWA C900, DR18, AS PER PLAN, CONCRETE ENCASED	P.0848
						47							638	03380	47	FT	16" WATER MAIN POLYVINYL CHLORIDE PIPE AND FITTINGS, AWWA CLASS C905	
						38							638	08706	38	EACH	8" CUTTING-IN SLEEVE	
						6							638	09390	6	EACH	8" X 6" TAPPING SLEEVE, VALVE AND VALVE BOX	
						4							638	09910	4	EACH	16" X 16" TAPPING SLEEVE, VALVE AND VALVE BOX	
						6							638	10300	6	EACH	FIRE HYDRANT EXTENDED AND ADJUSTED TO GRADE	
						11							638	10400	11	EACH	FIRE HYDRANT ADJUSTED TO GRADE, INCLUDES VALVE	
						15							638	10480	15	EACH	FIRE HYDRANT REMOVED	
						17							638	10800	17	EACH	VALVE BOX ADJUSTED TO GRADE	
						21							638	11100	21	EACH	METER AND CHAMBER REMOVED AND RESET	
						5							638	11200	5	EACH	METER, SETTING, STOP AND CHAMBER	
						16							SPECIAL	63820538	16	EACH	6" GATE VALVE WITH VALVE BOXRESILIENT WEDGE GATE VALVE	P.0848
						23							SPECIAL	63820554	23	EACH	8" GATE VALVE WITH VALVE BOXRESILIENT WEDGE GATE VALVE	P.0848
						11							SPECIAL	63820750	11	EACH	6" FIRE HYDRANTAMERICAN AVK 2780 OR MUELLER SUPER CENTURION A-423-250	P.0848
						161							SPECIAL	63820826	161	FT	RETAP, RECONNECT AND EXTEND 1" POLYETHYLENE WATER SERVICE CONNECTION, CTS PIPE AND CONSTRUCTED OF HDPE	P.0848
						90							638	06500	90	FT	12" STEEL PIPE ENCASEMENT, OPEN CUT	
						LS							638	98100	LS		WATER WORK, MISC.: AWWA STANDARD TESTING	P.0848
						10							638	98600	10	FT	WATER WORK, MISC.: 16" WATER MAIN POLYVINYL CHLORIDE PIPE AND FITTINGS, AWWA CLASS C905, CONCRETE ENCASED	P.0848
																	SANITARY SEWER	
26		10											611	99654	36	EACH	MANHOLE ADJUSTED TO GRADE	

DESIGN AGENCY
TRANSYSTEMS
400 W. NATIONWIDE BLVD., STE 225
COLUMBUS, OHIO 43215
DESIGNER JIW
REVIEWER GHM 10/27/25
PROJECT ID 116570
SHEET P.0291 TOTAL 1106

ERI-US 0006-CONNECTIVITY CORRIDOR
MODEL: Sheet 4 PAPERSIZE: 34x22 (in.) DATE: 2/26/2026 TIME: 12:03:29 PM PLTDRV: OHDOT_PDF.pltcfg PENTBL: OHDOT_Pen.tbl USER: jcolon@gfiinc.com WORKSPACE: OHDOTCEv02 WORKSET: 116570 PRODUCT: OpenRoadsDesigner 24.00.00.205
pw:\ohiodot-pw.bentley.com:ohiodot-pw-02\Documents\01 Active Projects\District 03\Erie\116570\402-Engineering_TranSystems\Roadway\Sheets\116570_GG001.dgn

PART.								ITEM	ITEM EXT	GRAND TOTAL	UNIT	DESCRIPTION	SEE SHEET NO.
01/SAF	02/SAF	03/S50	04/ENH	05/ENH	06/BRO	07/BRO	08/NFA						
												PAVEMENT	
8	1	14,584	4					254	01000	14,597	SY	PAVEMENT PLANING, ASPHALT CONCRETE (DEPTH VARIES 0.02' - 0.75')	
7,176	589	2,022	523					301	56000	10,310	CY	ASPHALT CONCRETE BASE, PG64-22, (449)	
10,448	1,080	4,781	5,465	119				304	20000	21,893	CY	AGGREGATE BASE	
6,971	425	4,887	1,187	39				407	20000	13,509	GAL	NON-TRACKING TACK COAT	
173		85	39					441	70600	297	CY	ASPHALT CONCRETE INTERMEDIATE COURSE, TYPE 1, (449), (DRIVEWAYS)	
194		112	56					441	70700	362	CY	ASPHALT CONCRETE INTERMEDIATE COURSE, TYPE 2, (449), (DRIVEWAYS)	
1,780	148	1,104	131					442	10000	3,163	CY	ASPHALT CONCRETE SURFACE COURSE, 12.5 MM, TYPE A (446)	
2,074	172	1,285	153					442	20171	3,684	CY	ASPHALT CONCRETE INTERMEDIATE COURSE, 12.5 MM, TYPE A (448), AS PER PLAN	P.0067
1			1,071	27				442	22001	1,099	CY	ASPHALT CONCRETE SURFACE COURSE, 9.5 MM, TYPE A (449), AS PER PLAN	P.0066
2			1,784	45				442	22401	1,831	CY	ASPHALT CONCRETE INTERMEDIATE COURSE, 19 MM, TYPE A (449), AS PER PLAN	P.0067
1,382	536							451	13011	1,918	SY	8" REINFORCED CONCRETE PAVEMENT, CLASS QC 1P, AS PER PLAN	P.0068
160								452	10010	160	SY	6" NON-REINFORCED CONCRETE PAVEMENT, CLASS QC 1P	
2,827	460							452	10011	3,287	SY	6" NON-REINFORCED CONCRETE PAVEMENT, CLASS QC 1P, AS PER PLAN	P.0067
499		58						452	12010	557	SY	8" NON-REINFORCED CONCRETE PAVEMENT, CLASS QC 1P	
6,636	1,873	2,021	376					609	12000	10,906	FT	COMBINATION CURB AND GUTTER, TYPE 2	
1,020	716							609	22001	1,736	FT	CURB, TYPE 3-B, AS PER PLAN	P.0067
742	503							609	24000	1,245	FT	CURB, TYPE 4-A	
6,099	1,428	185	648					609	26000	8,360	FT	CURB, TYPE 6	
93								609	26001	93	FT	CURB, TYPE 6, AS PER PLAN	P.0792
			303					609	28000	303	FT	CURB, TYPE 7	
1.55			3.53					618	41000	5.08	MILE	RUMBLE STRIPES, EDGE LINE (ASPHALT CONCRETE)	
					0.04			618	42000	0.04	MILE	RUMBLE STRIPES, EDGE LINE (CONCRETE)	
1.03			2.68					618	43000	3.71	MILE	RUMBLE STRIPES, CENTER LINE (ASPHALT CONCRETE)	
0.02								618	44000	0.02	MILE	RUMBLE STRIPES, CENTER LINE (CONCRETE)	
1.03			2.68					874	21000	3.71	MILE	LONGITUDINAL JOINT PREPARATION	
												WATER WORK	
50		83	58				46	638	01130	237	FT	6" WATER MAIN POLYVINYL CHLORIDE PIPE AND FITTINGS, AWWA C900, DR18	
273		133						638	01720	406	FT	8" WATER MAIN POLYVINYL CHLORIDE PIPE AND FITTINGS, AWWA C900, DR18	
12		70						638	01721	82	FT	8" WATER MAIN POLYVINYL CHLORIDE PIPE AND FITTINGS, AWWA C900, DR18, AS PER PLAN, CONCRETE ENCASED	P.0848
47								638	03380	47	FT	16" WATER MAIN POLYVINYL CHLORIDE PIPE AND FITTINGS, AWWA CLASS C905	
18		18					2	638	08706	38	EACH	8" CUTTING-IN SLEEVE	
			4				2	638	09390	6	EACH	8" X 6" TAPPING SLEEVE, VALVE AND VALVE BOX	
4								638	09910	4	EACH	16" X 16" TAPPING SLEEVE, VALVE AND VALVE BOX	
1		1	4					638	10300	6	EACH	FIRE HYDRANT EXTENDED AND ADJUSTED TO GRADE	
6		4	1					638	10400	11	EACH	FIRE HYDRANT ADJUSTED TO GRADE, INCLUDES VALVE	
2		5	4				4	638	10480	15	EACH	FIRE HYDRANT REMOVED	
8		6	2				1	638	10800	17	EACH	VALVE BOX ADJUSTED TO GRADE	
10		11						638	11100	21	EACH	METER AND CHAMBER REMOVED AND RESET	
3		2						638	11200	5	EACH	METER, SETTING, STOP AND CHAMBER	
3		5	4				4	SPECIAL	63820538	16	EACH	6" GATE VALVE WITH VALVE BOXRESILIENT WEDGE GATE VALVE	P.0848
11		12						SPECIAL	63820554	23	EACH	8" GATE VALVE WITH VALVE BOXRESILIENT WEDGE GATE VALVE	P.0848
2		5					4	SPECIAL	63820750	11	EACH	6" FIRE HYDRANTAMERICAN AVK 2780 OR MUELLER SUPER CENTURION A-423-250	P.0848
36		125						SPECIAL	63820826	161	FT	RETAP, RECONNECT AND EXTEND 1" POLYETHYLENE WATER SERVICE CONNECTION, CTS PIPE AND CONSTRUCTED OF HDPE	P.0848
46		44						638	06500	90	FT	12" STEEL PIPE ENCASEMENT, OPEN CUT	
LS		LS	LS				LS	638	98100	LS		WATER WORK, MISC.: AWWA STANDARD TESTING	P.0848
10								638	98600	10	FT	WATER WORK, MISC.: 16" WATER MAIN POLYVINYL CHLORIDE PIPE AND FITTINGS, AWWA CLASS C905, CONCRETE ENCASED	P.0848
												SANITARY SEWER	
11		17	8					611	99654	36	EACH	MANHOLE ADJUSTED TO GRADE	

ERI-US 0006-CONNECTIVITY CORRIDOR

GENERAL SUMMARY

DESIGN AGENCY
TRANSYSTEMS
400 W. NATIONWIDE BLVD., STE 225
COLUMBUS, OHIO 43215

DESIGNER: JIW
REVIEWER: GHM 10/27/25
PROJECT ID: 116570
SHEET: P.0292 TOTAL: 1106

MODEL: Sheet 4:1 PAPERSIZE: 34x22 (in.) DATE: 2/26/2026 TIME: 12:07:06 PM PLTDRV: OHDOT_PDF.pltcfg PENTBL: OHDOT_Pen.tbl USER: jolon@gfiinc.com WORKSPACE: OHDOTCEv02 WORKSET: 116570 PRODUCT: OpenRoadsDesigner 24.00.00.205
pw:\\ohiodot-pw.bentley.com:ohiodot-pw-02\Documents\01 Active Projects\District 03\Erie\116570\402-Engineering_TranSystems\Roadway\Sheets\116570_GG001.dgn

SHEET NUM.															PART.	ITEM	ITEM EXT	GRAND TOTAL	UNIT	DESCRIPTION	SEE SHEET NO.
P.0065	P.0070	P.0071	P.0072	P.0073	P.0074	P.0077	P.0815	P.0823													
																				MISCELLANEOUS STRUCTURE	
								LS								202	11000	LS		STRUCTURE REMOVED	
							81.5									203	35000	81.5	CY	GRANULAR EMBANKMENT	
							LS	LS								503	11100	LS		COFFERDAMS AND EXCAVATION BRACING	
							LS	LS								503	21300	LS		UNCLASSIFIED EXCAVATION	
							3,428	2,390								509	10000	5,818	LB	EPOXY COATED STEEL REINFORCEMENT	
							10.4	25								511	46000	35.4	SY	CLASS QC1 CONCRETE, RETAINING/WINGWALL NOT INCLUDING FOOTING	
							27.1	18								511	46510	45.1	CY	CLASS QC1 CONCRETE, FOOTING	
								1								511	46611	1	CY	CLASS QC1 CONCRETE, HEADWALL, AS PER PLAN	P.0825
							69	20								512	10100	89	SY	SEALING OF CONCRETE SURFACES (EPOXY-URETHANE)	
							62	11								512	33000	73	SY	TYPE 2 WATERPROOFING	
							33	17								516	13600	50	SF	1" PREFORMED EXPANSION JOINT FILLER	
							LS	LS								518	21230	LS		POROUS BACKFILL WITH GEOTEXTILE FABRIC	
																				MAINTENANCE OF TRAFFIC	
	500															410	12000	500	CY	TRAFFIC COMPACTED SURFACE, TYPE A OR B	
					800											614	11110	800	HOUR	LAW ENFORCEMENT OFFICER WITH PATROL CAR FOR ASSISTANCE	
				3												SPECIAL	61411300	3	EACH	WORK ZONE TRAFFIC SIGNAL	P.0073
						696										614	11630	696	FT	INCREASED BARRIER DELINEATION	
						38										614	12380	38	EACH	WORK ZONE IMPACT ATTENUATOR, 24" WIDE HAZARDS, (UNIDIRECTIONAL)	
				LS												614	12420	LS		DETOUR SIGNING	
		497														614	12801	497	EACH	WORK ZONE RAISED PAVEMENT MARKER, AS PER PLAN	P.0071
						340										614	13000	340	CY	ASPHALT CONCRETE FOR MAINTAINING TRAFFIC	
						28										614	13310	28	EACH	BARRIER REFLECTOR, TYPE 1 (ONE WAY)	
			84			28										614	13350	112	EACH	OBJECT MARKER, ONE WAY	
					5											614	18000	5	EACH	MAINTAINING TRAFFIC, MISC.: TEMPORARY LIGHTING (BY ROUNDABOUT LOCATION)	P.0074
				288												614	18601	288	SNMT	PORTABLE CHANGEABLE MESSAGE SIGN, AS PER PLAN	P.0072
						1										614	20010	1	MILE	WORK ZONE LANE LINE, CLASS I, 6"	
						7										614	21000	7	MILE	WORK ZONE CENTER LINE, CLASS I	
						22										614	22010	22	MILE	WORK ZONE EDGE LINE, CLASS I, 6"	
						2,224										614	23010	2,224	FT	WORK ZONE CHANNELIZING LINE, CLASS I, 12"	
						6,128										614	24000	6,128	FT	WORK ZONE DOTTED LINE, CLASS I	
						3,618										614	25000	3,618	FT	WORK ZONE TRANSVERSE/DIAGONAL LINE, CLASS I	
					LS											614	18002	LS		MAINTAINING TRAFFIC, MISC.:METER BASE, NON-FUSED SERVICE DISCONNECT SWITCH, AND RISER	P.0074
						519										614	26000	519	FT	WORK ZONE STOP LINE, CLASS I	
						86										614	30000	86	EACH	WORK ZONE ARROW, CLASS I	
					10											614	40050	10	EACH	BUSINESS ENTRANCE SIGN	
						LS										615	10000	LS		ROADS FOR MAINTAINING TRAFFIC	
						17,669										615	20000	17,669	SY	PAVEMENT FOR MAINTAINING TRAFFIC, CLASS A	
			657													616	10000	657	MGAL	WATER	
						8,979										622	41100	8,979	FT	PORTABLE BARRIER, UNANCHORED	
			75,000													SPECIAL	90000100	75,000	EACH	RAILROAD FLAGGING SERVICES	P.0072
																				INCIDENTALS	
LS																614	11000	LS		MAINTAINING TRAFFIC	
36																619	16020	36	MNTH	FIELD OFFICE, TYPE C	
LS																623	10000	LS		CONSTRUCTION LAYOUT STAKES AND SURVEYING	
LS																624	10000	LS		MOBILIZATION	

ERI-US 0006-CONNECTIVITY CORRIDOR

GENERAL SUMMARY

MODEL: Sheet 8 PAPERSIZE: 34x22 (in.) DATE: 3/6/2026 TIME: 1:36:48 PM PLTDRV: OHDOT_PDF.pltcfg PENTBL: OHDOT_Pen.tbl USER: rjgreve@gfiinc.com WORKSPACE: OHDOTCEv02 WORKSET: 116570 PRODUCT: OpenRoadsDesigner 24.00.02.25
pw:\\ohiodot-pw.bentley.com:ohiodot-pw-02\Documents\01 Active Projects\District 03\Eria\116570\402-Engineering_TranSystems\RoadwaySheets\116570_GG001.dgn

DESIGN AGENCY
TRANSYSTEMS
400 W. NATIONWIDE BLVD., STE 225
COLUMBUS, OHIO 43215

DESIGNER JIW

REVIEWER GHM 10/27/25

PROJECT ID 116570

SHEET P.0299 TOTAL 1106

PART.								ITEM	ITEM EXT	GRAND TOTAL	UNIT	DESCRIPTION	SEE SHEET NO.
01/SAF	02/SAF	03/S50	04/ENH	05/ENH	06/BRO	07/BRO	08/NFA						
												MISCELLANEOUS STRUCTURE	
			LS					202	11000	LS		STRUCTURE REMOVED	
66.9			14.6					203	35000	81.5	CY	GRANULAR EMBANKMENT	
			LS					503	11100	LS		COFFERDAMS AND EXCAVATION BRACING	
			LS					503	21300	LS		UNCLASSIFIED EXCAVATION	
			5,818					509	10000	5,818	LB	EPOXY COATED STEEL REINFORCEMENT	
			35.4					511	46000	35.4	SY	CLASS QC1 CONCRETE, RETAINING/WINGWALL NOT INCLUDING FOOTING	
			45.1					511	46510	45.1	CY	CLASS QC1 CONCRETE, FOOTING	
			1					511	46611	1	CY	CLASS QC1 CONCRETE, HEADWALL, AS PER PLAN	P.0825
			89					512	10100	89	SY	SEALING OF CONCRETE SURFACES (EPOXY-URETHANE)	
			73					512	33000	73	SY	TYPE 2 WATERPROOFING	
			50					516	13600	50	SF	1" PREFORMED EXPANSION JOINT FILLER	
			LS					518	21230	LS		POROUS BACKFILL WITH GEOTEXTILE FABRIC	
												MAINTENANCE OF TRAFFIC	
285	15	40	155	5				410	12000	500	CY	TRAFFIC COMPACTED SURFACE, TYPE A OR B	
456.0	24	64	248	8				614	11110	800	HOUR	LAW ENFORCEMENT OFFICER WITH PATROL CAR FOR ASSISTANCE	
2	1							SPECIAL	61411300	3	EACH	WORK ZONE TRAFFIC SIGNAL	P.0073
696								614	11630	696	FT	INCREASED BARRIER DELINEATION	
22	14	2						614	12380	38	EACH	WORK ZONE IMPACT ATTENUATOR, 24" WIDE HAZARDS, (UNIDIRECTIONAL)	
LS	LS	LS						614	12420	LS		DETOUR SIGNING	
284	15	39	154	5				614	12801	497	EACH	WORK ZONE RAISED PAVEMENT MARKER, AS PER PLAN	P.0071
193.8	10.2	27.2	105.4	3.4				614	13000	340	CY	ASPHALT CONCRETE FOR MAINTAINING TRAFFIC	
23		5						614	13310	28	EACH	BARRIER REFLECTOR, TYPE 1 (ONE WAY)	
71	2	12	26	1				614	13350	112	EACH	OBJECT MARKER, ONE WAY	
3	2							614	18000	5	EACH	MAINTAINING TRAFFIC, MISC.: TEMPORARY LIGHTING (BY ROUNDABOUT LOCATION)	P.0074
165	8	23	89	3				614	18601	288	SNMT	PORTABLE CHANGEABLE MESSAGE SIGN, AS PER PLAN	P.0072
1								614	20010	1	MILE	WORK ZONE LANE LINE, CLASS I, 6"	
5		2						614	21000	7	MILE	WORK ZONE CENTER LINE, CLASS I	
20	2							614	22010	22	MILE	WORK ZONE EDGE LINE, CLASS I, 6"	
1,981	243							614	23010	2,224	FT	WORK ZONE CHANNELIZING LINE, CLASS I, 12"	
4,759	1,121	248						614	24000	6,128	FT	WORK ZONE DOTTED LINE, CLASS I	
2,582	1,036							614	25000	3,618	FT	WORK ZONE TRANSVERSE/DIAGONAL LINE, CLASS I	
LS	LS							614	18002	LS		MAINTAINING TRAFFIC, MISC.:METER BASE, NON FUSED SERVICE DISCONNECT SWITCH, AND RISER	P.0074
339	180							614	26000	519	FT	WORK ZONE STOP LINE, CLASS I	
72	14							614	30000	86	EACH	WORK ZONE ARROW, CLASS I	
6		1	3					614	40050	10	EACH	BUSINESS ENTRANCE SIGN	
LS	LS	LS						615	10000	LS		ROADS FOR MAINTAINING TRAFFIC	
7,420	1,615	8,634						615	20000	17,669	SY	PAVEMENT FOR MAINTAINING TRAFFIC, CLASS A	
374	20	52	204	7				616	10000	657	MGAL	WATER	
5,891	2,828	260						622	41100	8,979	FT	PORTABLE BARRIER, UNANCHORED	
75000								SPECIAL	90000100	75000	EACH	RAILROAD FLAGGING SERVICES	P.0072
												INCIDENTALS	
LS	LS	LS	LS	LS				614	11000	LS		MAINTAINING TRAFFIC	
20.52	1.08	2.88	11.16	0.36				619	16020	36	MNTH	FIELD OFFICE, TYPE C	
LS	LS	LS	LS	LS				623	10000	LS		CONSTRUCTION LAYOUT STAKES AND SURVEYING	
LS	LS	LS	LS	LS				624	10000	LS		MOBILIZATION	

ERI-US 0006-CONNECTIVITY CORRIDOR

MODEL: Sheet 8.1 PAPERSIZE: 34x22 (in.) DATE: 3/6/2026 TIME: 1:07:21 PM PLTDRV: OHDOT_PDF.pltcfg PENTBL: OHDOT_Pen.tbl USER: rgreve@gftinc.com WORKSPACE: OHDOTCEv02 WORKSET: 116570 PRODUCT: OpenRoadsDesigner 24.00.02.25
pw:\\ohiodot-pw.bentley.com:ohiodot-pw-02\Documents\01 Active Projects\District 03\Erie\116570\0422-Engineering_TranSystems\Roadway\Sheets\116570_GG001.dgn

GENERAL SUMMARY

DESIGN AGENCY
TRANSYSTEMS
400 W. NATIONWIDE BLVD., STE 225
COLUMBUS, OHIO 43215

DESIGNER
JIW

REVIEWER
GHM 10/27/25

PROJECT ID
116570

SHEET P.0300 TOTAL 1106

WATER SUBSUMMARY

ESTIMATED QUANTITIES SHEET NO.	202	202	202	611	638	638	638	638	638	638	638	638	638	638	638	SPECIAL	SPECIAL	SPECIAL	SPECIAL	638	638	638	638
	PIPE REMOVED, 24" AND UNDER	METER VAULT REMOVED	VALVE BOX REMOVED, INCLUDES VALVE	MANHOLE ADJUSTED TO GRADE	6" WATER MAIN POLYVINYL CHLORIDE PIPE AND FITTINGS, AWWA C900, DR18	8" WATER MAIN POLYVINYL CHLORIDE PIPE AND FITTINGS, AWWA C900, DR18	16" WATER MAIN POLYVINYL CHLORIDE PIPE AND FITTINGS, AWWA CLASS C905	8" CUTTING-IN SLEEVE	8" X 6" TAPPING SLEEVE, VALVE AND VALVE BOX	16" X 16" TAPPING SLEEVE, VALVE AND VALVE BOX	FIRE HYDRANT EXTENDED AND ADJUSTED TO GRADE	FIRE HYDRANT ADJUSTED TO GRADE, INCLUDES VALVE	FIRE HYDRANT REMOVED	VALVE BOX ADJUSTED TO GRADE	METER AND CHAMBER REMOVED AND RESET	METER, SETTING, STOP AND CHAMBER	6" GATE VALVE WITH VALVE BOX, RESILIENT WEDGE GATE VALVE	8" GATE VALVE WITH VALVE BOX, RESILIENT WEDGE GATE VALVE	6" FIRE HYDRANT, AMERICAN AVK 2780 OR MUELLER SUPER CENTURION A-423-250	RETAP, RECONNECT AND EXTEND 1" POLYETHYLENE WATER SERVICE CONNECTION, CTS PIPE AND CONSTRUCTED OF HDPE	12" STEEL PIPE ENCASEMENT, OPEN CUT	WATER WORK, MISC..AWWA STANDARD TESTING	8" WATER MAIN POLYVINYL CHLORIDE PIPE AND FITTINGS, AWWA C900, DR18, AS PER PLANCONCRETE ENCASED	WATER WORK, MISC..16" WATER MAIN POLYVINYL CHLORIDE PIPE AND FITTINGS, AWWA CLASS C905, CONCRETE ENCASED
	FT	EACH	EACH	EACH	FT	FT	FT	EACH	EACH	EACH	EACH	EACH	EACH	EACH	EACH	EACH	EACH	EACH	EACH	FT	FT		FT	FT
P.0364	393	3	5	6	71	225		21			1	6	4	4	7	3	5	12	4	150	42	LS	22	
P.0365	272	1	3	7	62	181		15			1	4	3	5	12	1	3	11	3	11	48	LS	60	
P.0366	81	1	8	7	104		47	2	6	4	4	1	8	8	2	1	8		4			LS		10
SUBTOTAL FOR PARTICIPATION 01/SAF	372.00	3.00	3.00	11.00	50.00	273.00	47.00	18.00		4.00	1.00	6.00	2.00	8.00	10.00	3.00	3.00	11.00	2.00	36.00	46.00	LS	12.00	10.00
SUBTOTAL FOR PARTICIPATION 03/S50	328.00	2.00	5.00	5.00	82.50	133.00		18.00			1.00	4.00	5.00	6.00	11.00	2.00	5.00	12.00	5.00	125.00	44.00	LS	70.00	
SUBTOTAL FOR PARTICIPATION 04/ENH	22.00		4.00	1.00	58.00				4.00		4.00	1.00	4.00	2.00			4.00					LS		
SUBTOTAL FOR PARTICIPATION 08/NFA	24.00		4.00	3.00	46.00			2.00	2.00				4.00	1.00			4.00		4.00			LS		
TOTALS CARRIED TO GENERAL SUMMARY	746	5	16	20	237	406	47	38	6	4	6	11	15	17	21	5	16	23	11	161	90	LS	82	10

DESIGN AGENCY
TRANSYSTEMS
400 W. NATIONWIDE BLVD., STE 225
COLUMBUS, OHIO 43215

DESIGNER
RJG

REVIEWER
GHM 10/27/25

PROJECT ID
116570

SHEET P.0363 TOTAL 1106

ERI-US 0006-CONNECTIVITY CORRIDOR

MODEL: Sheet 4 PAPERSIZE: 34x22 (in.) DATE: 2/25/2026 TIME: 12:13:51 PM PLTDRV: OHDOT_PDF.pltcfg PENTBL: OHDOT_Pen.tbl USER: rjgreve@gftinc.com WORKSPACE: OHDOTCEv02 WORKSET: 116570 PRODUCT: OpenRoadsDesigner 24.00.02.25
pw:\\ohiodot-pw.bentley.com:ohiodot-pw-02\Documents\01 Active Projects\District 03\Erie\116570\402-Engineering_TranSystems\Utilities\Sheets\116570_US001.dgn


PROJECT DATA	
Total Area (Right-Of-Way) ---------- 55.71 ac	Runoff Coefficient for Pre-Construction Site ---------- 0.67
Project Earth Disturbed Area ---------- 50.18 ac	Runoff Coefficient for Post Construction Site ---------- 0.71
Estimated Contractor Earth Disturbed Area ---------- 9.00 ac	Post Construction BMP: Amended Vegetated Filter Strips, Linear Bioretention Cells and Bioretention Cells were Provided to Meet NPDES Post-Construction Requirements. See Cross Section Sheets for Locations.
Notice of Intent Earth Disturbed Area ---------- 59.18 ac	
Impervious (Paved) Area for Pre-Construction Site ---------- 18.71 ac	Immediate Receiving Waters ------ Pipe Creek, Plum Brook, Dildine Ditch, Boo's Ditch, Sawmill Creek
Impervious (Paved) Area for Post Construction Site ---------- 25.46 ac	Subsequent Receiving water ---------- Sandusky Bay and Lake Erie

Total Treatment Provided: 19.27 ac

Total Treatment Required: 18.90 ac

PROJECT DESCRIPTION


THIS PROJECT INCLUDES THE CONSTRUCTION OF FIVE NEW ROUNDABOUTS ALONG US ROUTE 6 IN ERIE COUNTY AT PERKINS AVE, CAMP RD, RYE BEACH RD, AND THE EASTBOUND AND WESTBOUND RAMP TERMINALS AT THE INTERCHANGE OF US 6, SR 2, AND RYE BEACH RD. US 6 IS ALSO BEING RESURFACED AND WIDENED (ALONG CLEVELAND RD W) BETWEEN CAMP RD AND RYE BEACH RD TO ACCOMODATE A TWO-WAY LEFT TURN LANE. MULTI-MODEL CONNECTIVITY IS BEING IMPROVED THROUGHOUT THE PROJECT BY EXTENDING THE SANDUSKY BAY PATHWAY FROM CEDAR POINT DRIVE TO SPORTS FORCE PARK, THEN ALONG US 6 (CLEVELAND RD W) TO RYE BEACH RD, THEN SOUTH ALONG RYE BEACH RD TO UNIVERSITY DR. A NEW PEDESTRIAN BRIDGE OVER SAWMILL CREEK IS BEING ADDED TO ACCOMODATE THE SHARED USE PATH.

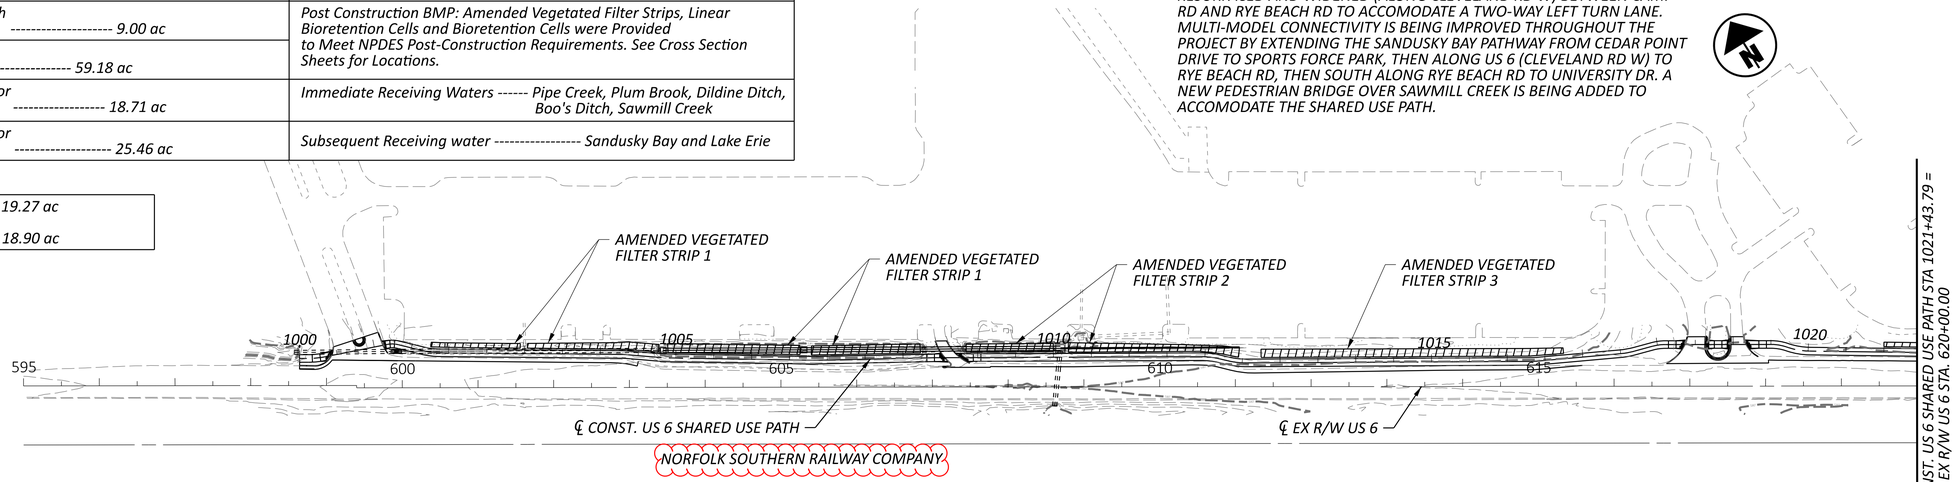

BMP Type	Latitude/Longitude				BMP Width	EDA Treatment Credit	Item 654 Renovating Existing Soil, APP	Item 671 Erosion Control Mats
	Begin		End		(Feet)	(Acres)	(MSF)	(SY)
Amended Vegetated Filter Strips 1	41.432100° N	82.658286° W	41.431097° N	82.656189° W	9.5	0.198	5.9	657
Amended Vegetated Filter Strips 2	41.431017° N	82.656017° W	41.430447° N	82.654897° W	10.5	0.119	3.6	397
Amended Vegetated Filter Strips 3	41.430414° N	82.654828° W	41.429842° N	82.653561° W	10.0	0.133	4.0	444
					Total:	0.450	13.5	1498

THE FOLLOWING ITEMS HAVE BEEN CARRIED TO THE GENERAL SUMMARY FOR PAYMENT:

ITEM 832 - EROSION CONTROL 744,879 EACH
ITEM 832 - STORM WATER POLLUTION PREVENTION PLAN LUMP SUM
ITEM 832 - STORM WATER POLLUTION PREVENTION INSPECTIONS LUMP SUM
ITEM 832 - STORM WATER POLLUTION PREVENTION INSPECTIONS SOFTWARE LUMP SUM

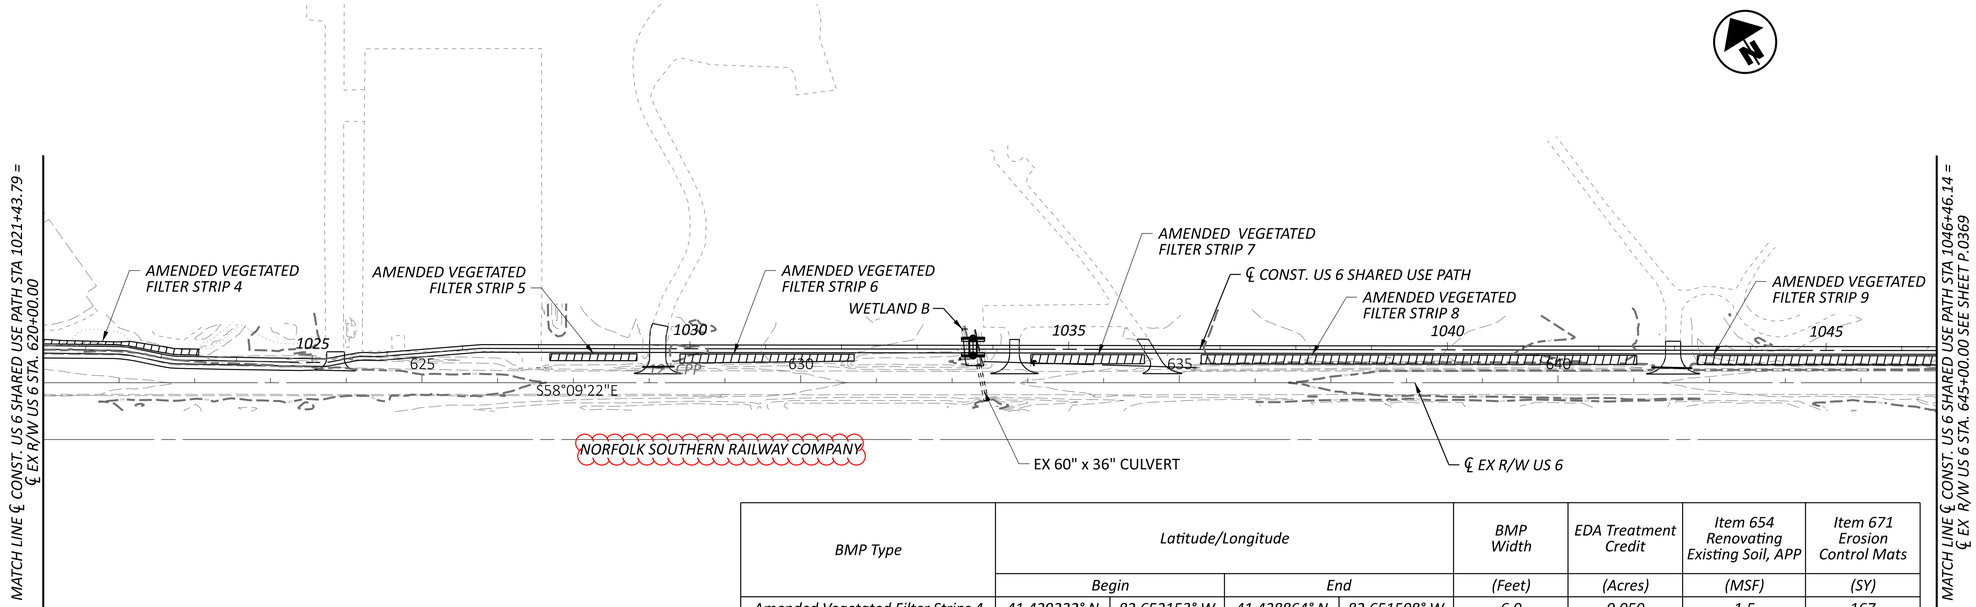

BMP Type	Latitude/Longitude				BMP Width	EDA Treatment Credit	Item 654 Renovating Existing Soil, APP	Item 671 Erosion Control Mats
	Begin		End		(Feet)	(Acres)	(MSF)	(SY)
Amended Vegetated Filter Strips 4	41.429222° N	82.652153° W	41.428864° N	82.651508° W	6.0	0.050	1.5	167
Amended Vegetated Filter Strips 5	41.428197° N	82.650086° W	41.428017° N	82.649717° W	9.0	0.034	1.0	115
Amended Vegetated Filter Strips 6	41.427944° N	82.649567° W	41.427539° N	82.648675° W	10.5	0.080	2.4	268
Amended Vegetated Filter Strips 7	41.427281° N	82.648136° W	41.427058° N	82.647658° W	12.0	0.060	1.8	200
Amended Vegetated Filter Strips 8	41.426967° N	82.647444° W	41.426097° N	82.645592° W	12.0	0.230	6.9	767
Amended Vegetated Filter Strips 9	41.426000° N	82.645411° W	41.425525° N	82.644383° W	12.0	0.128	3.8	427
					Total:	0.582	17.4	1944

USGS MAP: HURON QUADRANGLE
HURON, OHIO
SANDUSKY QUADRANGLE
SANDUSKY OHIO

LATITIUDE: 41°25'22" N LONGITUDE: 82°38'19" W

*LONGITUDE AND LATITUDE TO APPROX. CENTER OF PROJECT

HORIZONTAL SCALE IN FEET
0 50 100 200

PROJECT SITE PLAN


EX R/W US 6 STA. 596+00 TO STA. 645+00/CL CONST. US 6 SUP STA. 1000+00 TO STA. 1046+46.14

ERI-US 0006-CONNECTIVITY CORRIDOR


DESIGN AGENCY: OHM

DESIGNER: ZR
REVIEWER: BLS 10/27/25
PROJECT ID: 116570
SHEET: P.0368 TOTAL: 1106

MODEL: GB101 [Sheet] PAPERSIZE: 34x22 (in.) DATE: 2/26/2026 TIME: 10:10:29 AM PLTDRV: OHDOT_PDF_Levels.pltcfg PENTBL: OHDOT_Pen.tbl USER: Brennon.Cain@ohm-advisors.com WORKSPACE: OHDOTCEv02 WORKSET: 116570 PRODUCT: OpenRoadsDesigner 24.00.00.205
pw:\\ohiodot-pw.bentley.com:ohiodot-pw-02\Documents\01 Active Projects\District 03\Erie\116570\403-Engineering_OHMAdvisors\Drainage\Sheets\116570_DB101.dgn

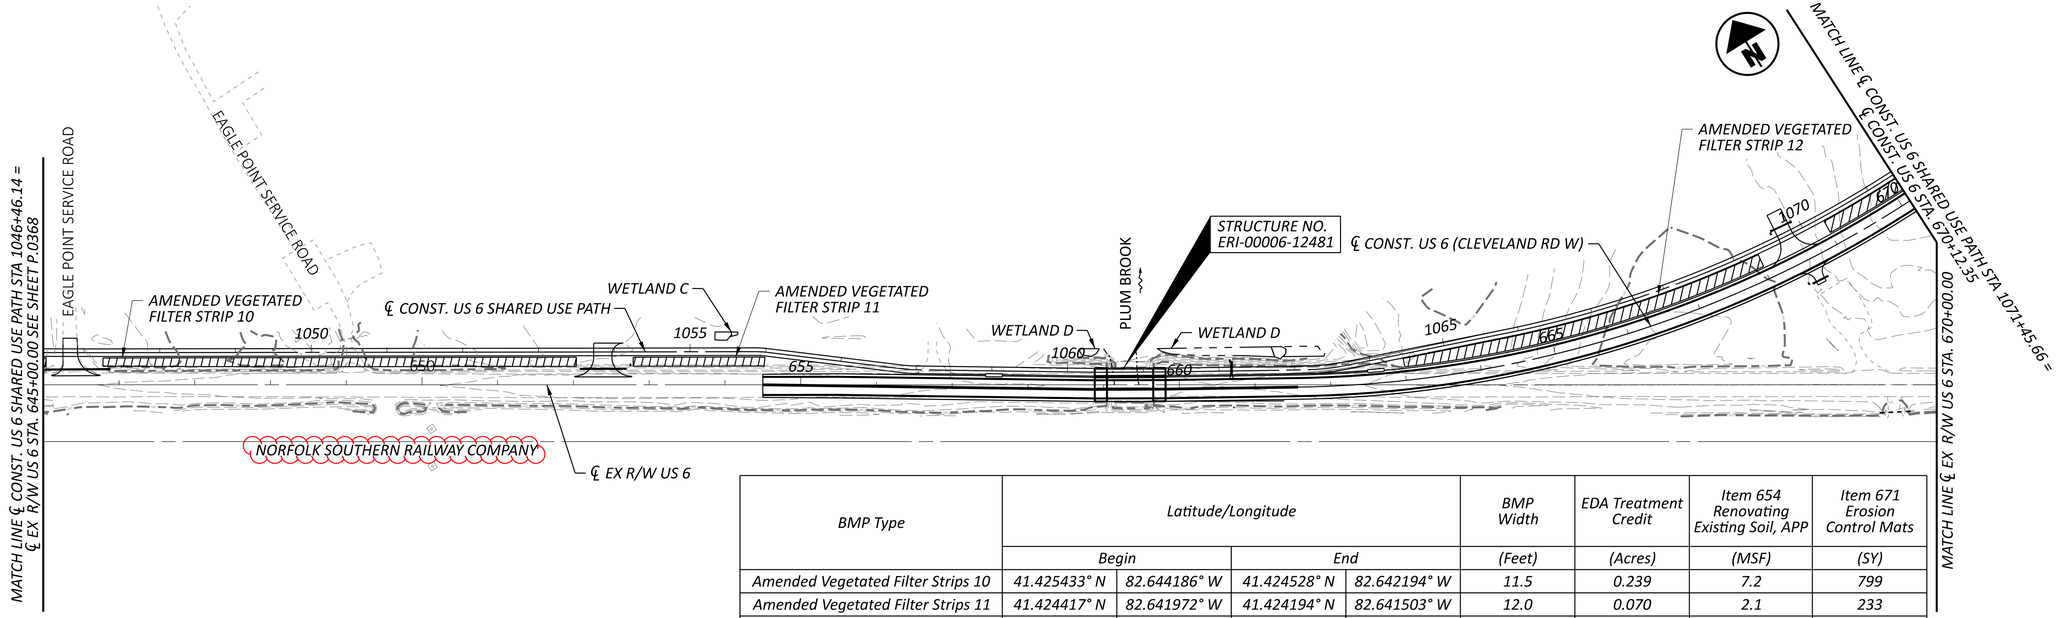

BMP Type	Latitude/Longitude				BMP Width	EDA Treatment Credit	Item 654 Renovating Existing Soil, APP	Item 671 Erosion Control Mats
	Begin		End		(Feet)	(Acres)	(MSF)	(SY)
Amended Vegetated Filter Strips 10	41.425433° N	82.644186° W	41.424528° N	82.642194° W	11.5	0.239	7.2	799
Amended Vegetated Filter Strips 11	41.424417° N	82.641972° W	41.424194° N	82.641503° W	12.0	0.070	2.1	233
Amended Vegetated Filter Strips 12	41.422917° N	82.638772° W	41.422511° N	82.637011° W	16.0	0.266	8.0	889
					Total:	0.575	17.3	1921

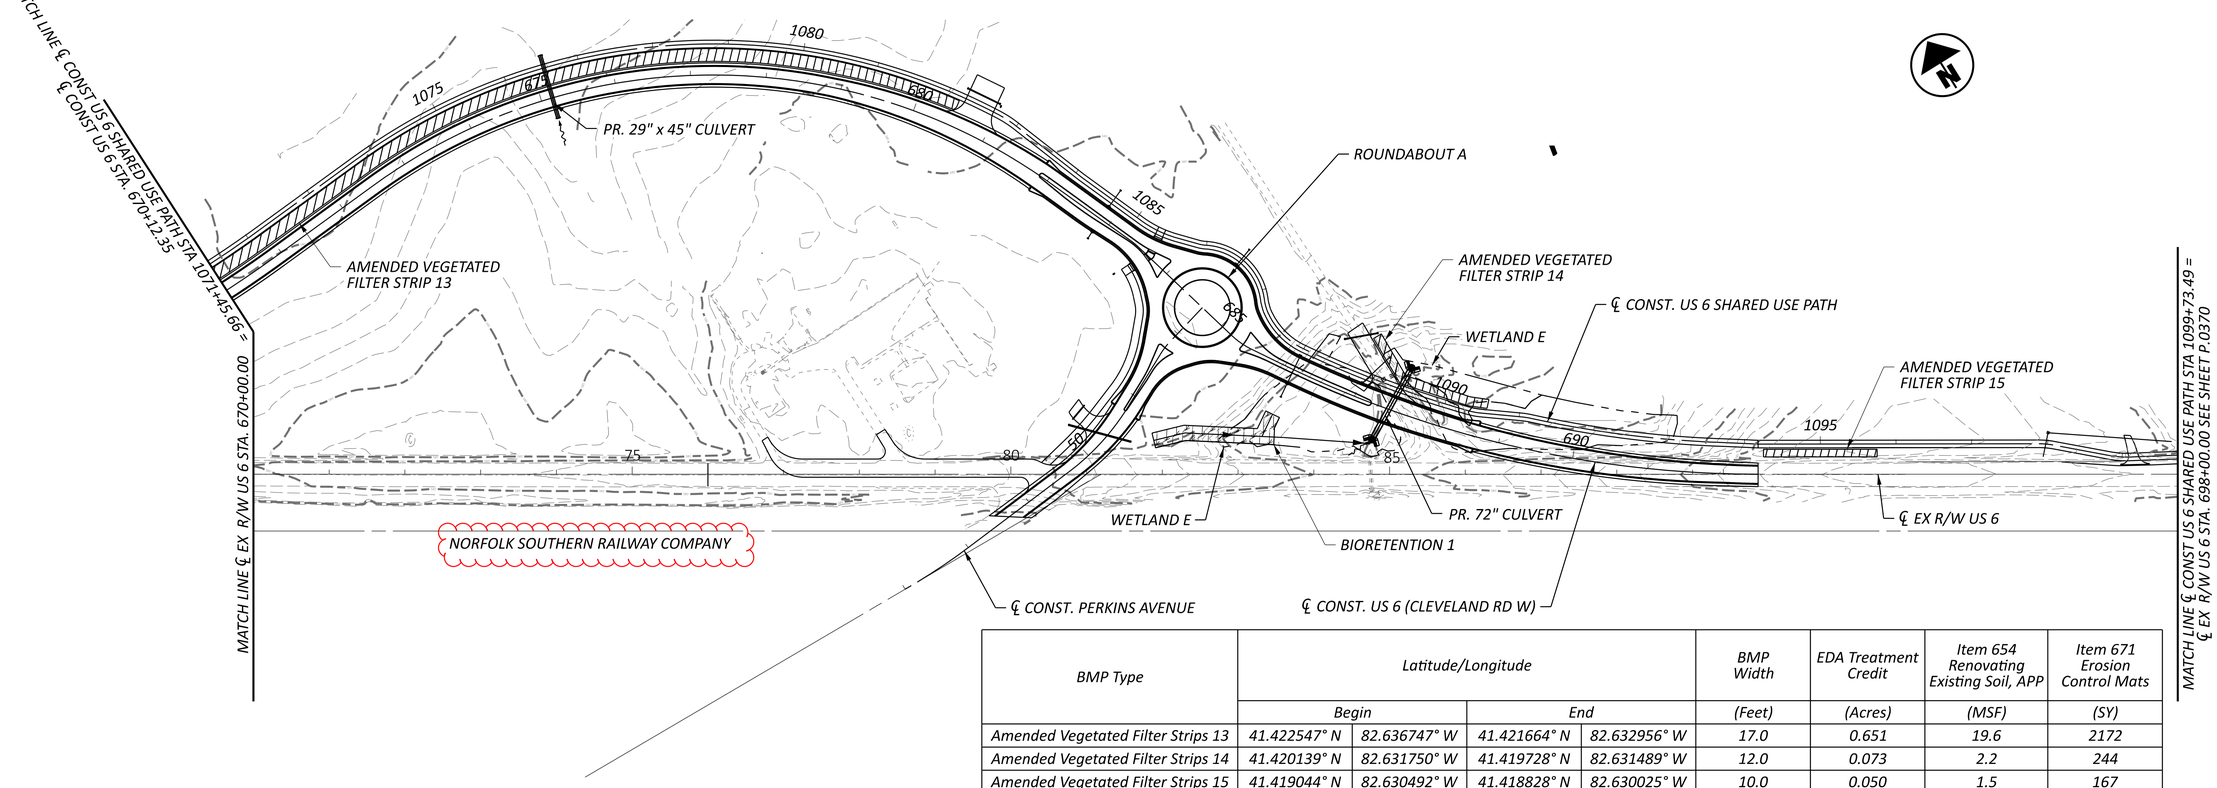

BMP Type	Latitude/Longitude				BMP Width	EDA Treatment Credit	Item 654 Renovating Existing Soil, APP	Item 671 Erosion Control Mats
	Begin		End		(Feet)	(Acres)	(MSF)	(SY)
Amended Vegetated Filter Strips 13	41.422547° N	82.636747° W	41.421664° N	82.632956° W	17.0	0.651	19.6	2172
Amended Vegetated Filter Strips 14	41.420139° N	82.631750° W	41.419728° N	82.631489° W	12.0	0.073	2.2	244
Amended Vegetated Filter Strips 15	41.419044° N	82.630492° W	41.418828° N	82.630025° W	10.0	0.050	1.5	167
Bioretention 1			41.419900° N	82.632042° W		1.52		
					Total:	2.294	23.3	2583

HORIZONTAL SCALE IN FEET
0 50 100 200

PROJECT SITE PLAN


EX R/W US 6 STA. 645+00 TO STA. 698+00/CL CONST. US 6 SUP STA. 1046+46.14 TO STA. 1099+73.49


ERI-US 0006-CONNECTIVITY CORRIDOR

DESIGN AGENCY OHM

DESIGNER ZR
REVIEWER BLS 10/27/25
PROJECT ID 116570
SHEET P.0369 TOTAL 1106

MODEL: GB102 [Sheet] PAPERSIZE: 34x22 (in.) DATE: 2/26/2026 TIME: 10:10:33 AM PLTDRV: OHDOT_PDF_Levels.pltcfg PENTBL: OHDOT_Pen.tbl USER: Brennon.Cain@ohm-advisors.com WORKSPACE: OHDOTCEv02 WORKSET: 116570 PRODUCT: OpenRoadsDesigner 24.00.00.205
pw:\\ohiodot-pw.bentley.com:ohiodot-pw-02\Documents\01 Active Projects\District 03\Erie\116570\403-Engineering_OHMAdvisors\Drainage\Sheets\116570_DB101.dgn

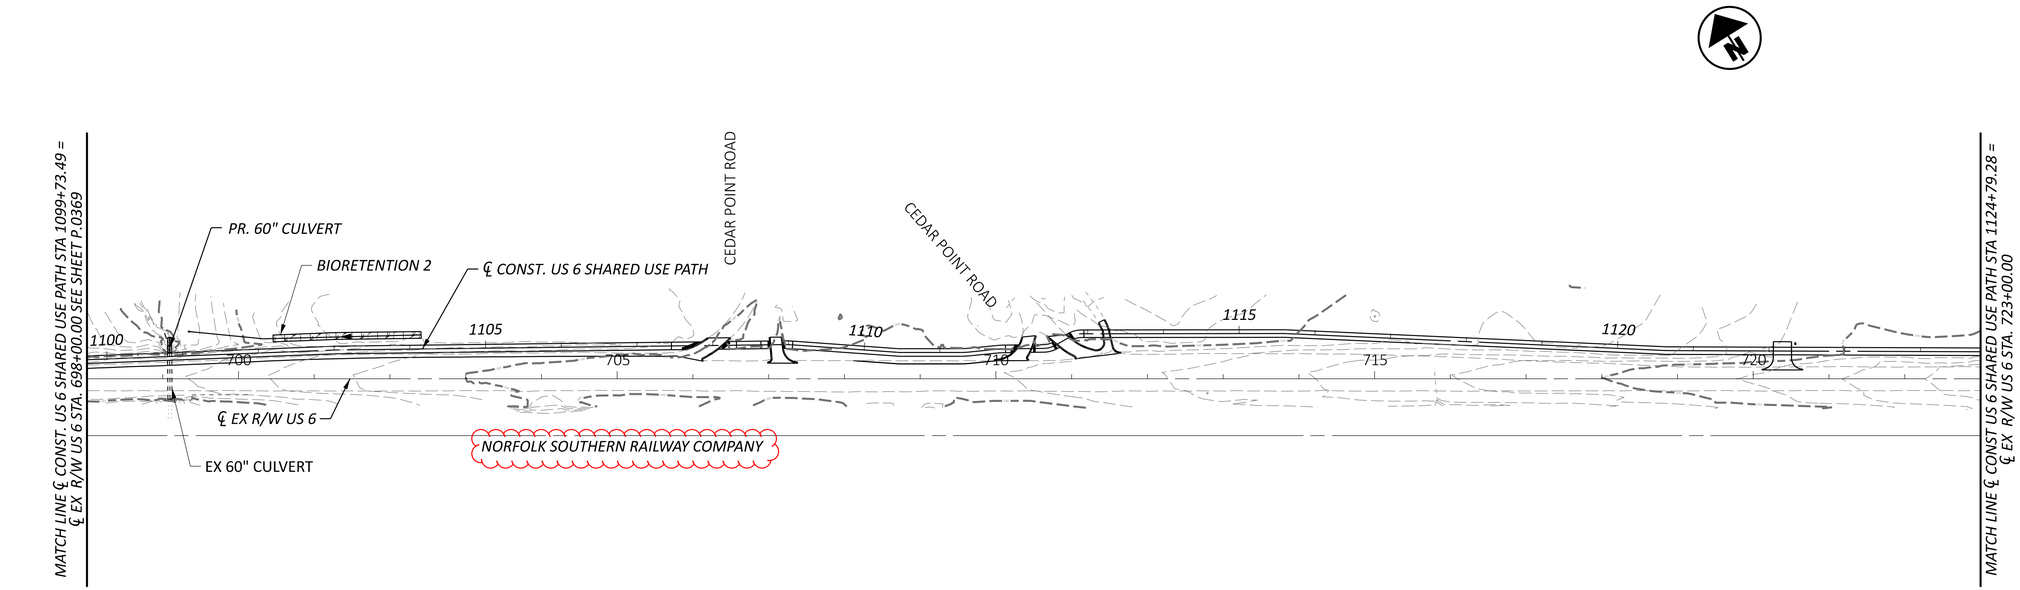

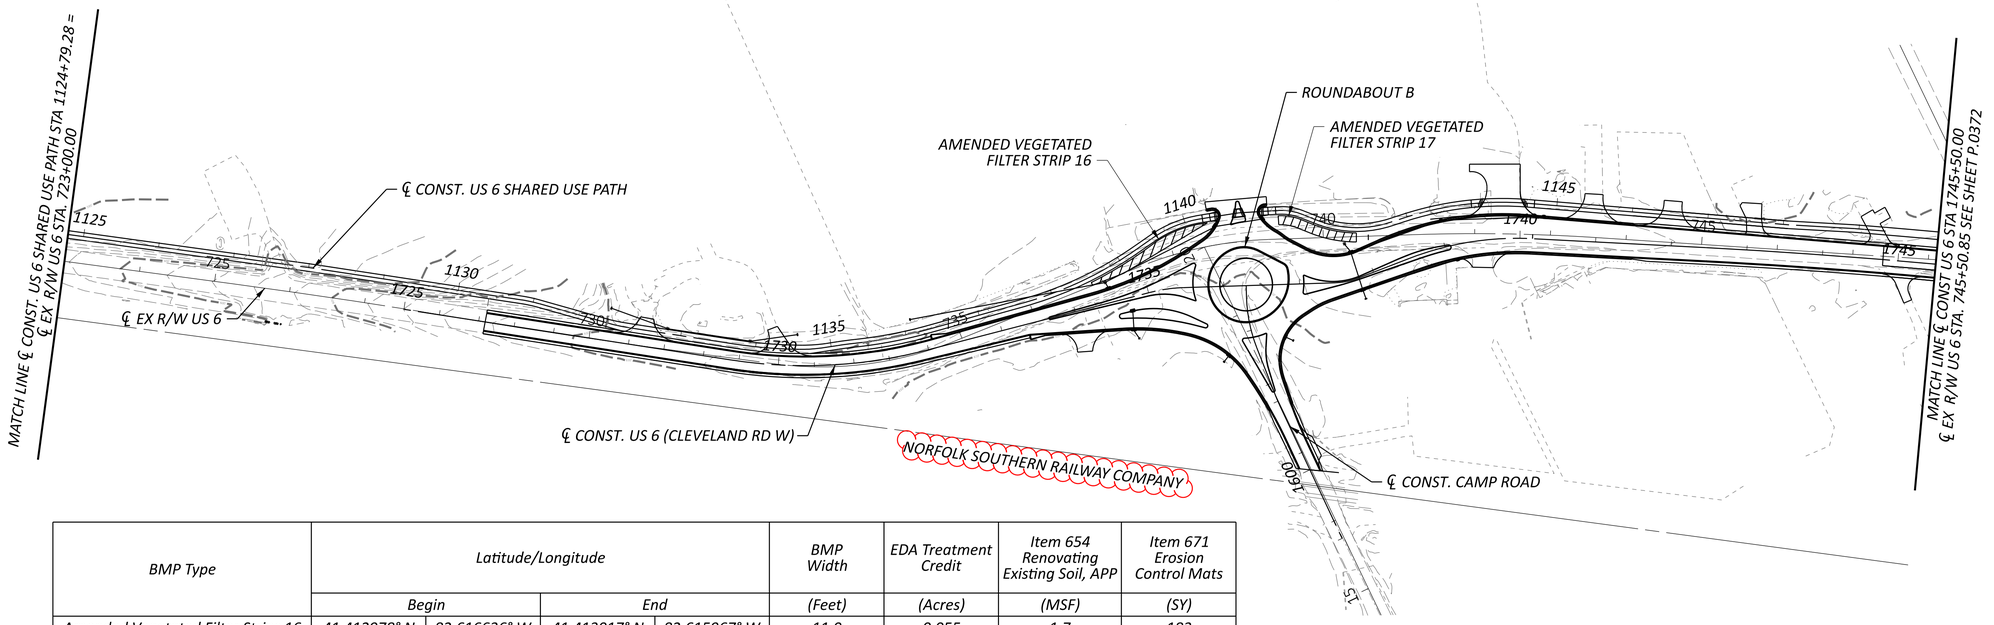

BMP Type	Latitude/Longitude				BMP Width	EDA Treatment Credit	Item 654 Renovating Existing Soil, APP	Item 671 Erosion Control Mats
	Begin		End		(Feet)	(Acres)	(MSF)	(SY)
Amended Vegetated Filter Strips 16	41.412978° N	82.616636° W	41.413017° N	82.615967° W	11.0	0.055	1.7	183
Amended Vegetated Filter Strips 17	41.412903° N	82.615703° W	41.412739° N	82.615392° W	12.0	0.042	1.3	140
Bioretention 2			41.418135° N	82.628301° W		0.810		
					Total:	0.907	3.0	323

HORIZONTAL SCALE IN FEET
0 50 100 200

PROJECT SITE PLAN

EX R/W US 6 STA. 698+00 TO US 6 STA. 745+50/CL CONST. US 6 SUP STA. 1099+73.49 TO STA. 1149+29.73

DESIGN AGENCY
OHM

DESIGNER ZR
REVIEWER BLS 10/27/25
PROJECT ID 116570
SHEET P.0370 TOTAL 1106

ERI-US 0006-CONNECTIVITY CORRIDOR

MODEL: GB103 [Sheet] PAPERSIZE: 34x22 (in.) DATE: 2/26/2026 TIME: 10:10:34 AM PLTDRV: OHDOT_PDF_Levels.pltcfg PENTBL: OHDOT_Pen.tbl USER: Brennon.Cain@ohm-advisors.com WORKSPACE: OHDOTCEv02 WORKSET: 116570 PRODUCT: OpenRoadsDesigner 24.00.00.205
pw:\\ohiodot-pw.bentley.com:ohiodot-pw-02\Documents\01 Active Projects\District 03\Erie\116570\403-Engineering_OHMAdvisors\Drainage\Sheets\116570_DB101.dgn

FOR ADDITIONAL DETAILS AND NOTES SEE AMENDED VEGETATED FILTER STRIP PLAN INSERT SHEETS P.0834 AND P.0835

BOOS RD

℄ CONST RYE BEACH ROAD

SUSPEND WORK STA. 132+65.68

RESUME WORK STA. 133+00.97

SAWMILL PARKWAY

MATCH LINE ℄ CONST RYE BEACH ROAD STA 140+00.00 ℄ EX R/W RYE BEACH ROAD STA. 39+99.97 SEE BELOW LEFT

UNIVERSITY DR E

BEGIN WORK STA. 25+72.63

℄ CONST RYE BEACH RD SHARED USE PATH

NORFOLK SOUTHERN RAILWAY COMPANY

BIORETENTION CELL 4, RAMP D FOR DETAILS SEE SHEET P.0842

AMENDED VEGETATED FILTER STRIP 18

AMENDED VEGETATED FILTER STRIP 19

AMENDED VEGETATED FILTER STRIP 22

℄ CONST RAMP D

BEGIN WORK STA. 787+60.00

MATCHLINE ℄ CONST. SR-2 STA. 1033+00.00 - SEE NEXT SHEET

BEGIN WORK STA. 863+60.00

℄ CONST SR-2

AMENDED VEGETATED FILTER STRIP 20

℄ CONST RAMP A

℄ CONST US 6 (CLEVELAND RD W)

BIORETENTION CELL 3, RAMP A FOR DETAILS SEE SHEET P.0841

ROUNDABOUT E

MATCH LINE ℄ CONST US 6 STA 1804+00.00 ℄ EX R/W US 6 STA. 806+54.73 SEE SHEET P.0010

ROUNDABOUT C

STA. 160+14.24 ℄ US 6 = STA. 1808+73.62 ℄ RYE BEACH ROAD

N24°37'24"E

℄ CONST RYE BEACH ROAD

EX LANDSCAPED AREA

℄ CONST RYE BEACH ROAD (US 6)

℄ CONST RYE BEACH ROAD

ROUNDABOUT D

MATCH LINE ℄ CONST RYE BEACH ROAD STA 140+00.00 ℄ EX R/W RYE BEACH ROAD STA. 39+99.97 SEE ABOVE RIGHT

STRUCTURE NO. ERI-00006-15.521

SR-2 & US 6

℄ CONST RAMP C

END PROJECT STA. 744+20.00 SLM = 15.81

E220 (276)

END WORK STA. 744+40.00

AMENDED VEGETATED FILTER STRIP 23

AMENDED VEGETATED FILTER STRIP 24

MATCHLINE ℄ CONST. SR-2 STA. 1049+00.00 SEE NEXT SHEET

AMENDED VEGETATED FILTER STRIP 21

℄ CONST RAMP B

END WORK STA. 814+10.00

℄ CONST CLEVELAND RD W

END WORK STA. 1814+20.00

END WORK STA. 164+75.00

*NOTE: Latitude and Longitude were measured closest to EOP for Filter Strips

BMP Type	Latitude/Longitude* Begin		End		BMP Width	EDA Treatment Credit	Item 654 Renovating Existing Soil, APP	Item 671 Erosion Control Mats
					(Feet)	(Acres)	(MSF)	(SY)
Amended Vegetated Filter Strip 18	41.405417°N	82.595167°W	41.401944°N	82.582750°W	33	3.335	121	13,402
Amended Vegetated Filter Strip 19	41.405222°N	82.595222°W	41.401778°N	82.582833°W	35	3.579	128	14,214
Amended Vegetated Filter Strip 20	41.405250°N	82.593556°W	41.404806°N	82.591444°W	20	0.403	12	1,344
Amended Vegetated Filter Strip 21	41.404750°N	82.591167°W	41.404333°N	82.589556°W	20	0.305	9	1,018
Amended Vegetated Filter Strip 22	41.404806°N	82.593528°W	41.404361°N	82.591444°W	20	0.399	12	1,331
Amended Vegetated Filter Strip 23	41.404278°N	82.591139°W	41.403417°N	82.587944°W	23	0.722	22	2,410
Amended Vegetated Filter Strip 24	41.403333°N	82.590417°W	41.401694°N	82.583167°W	30	2.074	64	7,070
Bioretention Cell 3			41.405389°N	82.592361°W		1.63		
Bioretention Cell 4			41.404306°N	82.592472°W		1.89		
TOTALS CARRIED TO BMP SUBSUMMARY P.0371						14.337	367	40,789

HORIZONTAL SCALE IN FEET 0 50 100 200

PROJECT SITE PLAN
RYE BEACH ROAD STA 118+00.00 TO STA 166+00.00

ERI-US 0006-CONNECTIVITY CORRIDOR

DESIGN AGENCY
TRANSYSTEMS
400 W. NATIONWIDE BLVD., STE 225
COLUMBUS, OHIO 43215

DESIGNER MHT


REVIEWER GHM 10/27/25


PROJECT ID 116570

SHEET P.0373 TOTAL 1106

MODEL: Sheet02 - 100 Scale PAPERSIZE: 34x22 (in.) DATE: 2/26/2026 TIME: 12:29:18 PM PLTDRV: OHDOT_PDF.pltcfg PENTBL: OHDOT_Pen.tbl USER: hrthornton@gfinc.com WORKSPACE: OHDOTCEv02 WORKSET: 116570 PRODUCT: OpenRoadsDesigner 24.00.02.25
pw:\\ohiodot-pw.bentley.com:ohiodot-pw-02\Documents\01 Active Projects\District 03\Erie\116570\402 Engineering_TranSystems\Drainage\Sheets\116570_DB001.dgn

MODEL: CLP_SUP_1 - Plan 001 [Sheet] PAPERSIZE: 34x22 (in.) DATE: 2/26/2026 TIME: 10:11:28 AM PLTDRV: OHDOT_PDF_Levels.pltcfg PENTBL: OHDOT_Pen.tbl USER: Brennon.Cain@ohm-advisors.com WORKSPACE: OHDOTCEv02 WORKSET: 116570 PRODUCT: OpenRoadsDesigner 24.00.00.205
pw:\\ohiodot-pw.bentley.com:ohiodot-pw-02\Documents\01 Active Projects\District 03\Erie\116570\403-Engineering_OHMAdvisors\Roadway\Sheets\116570_GP101.dgn

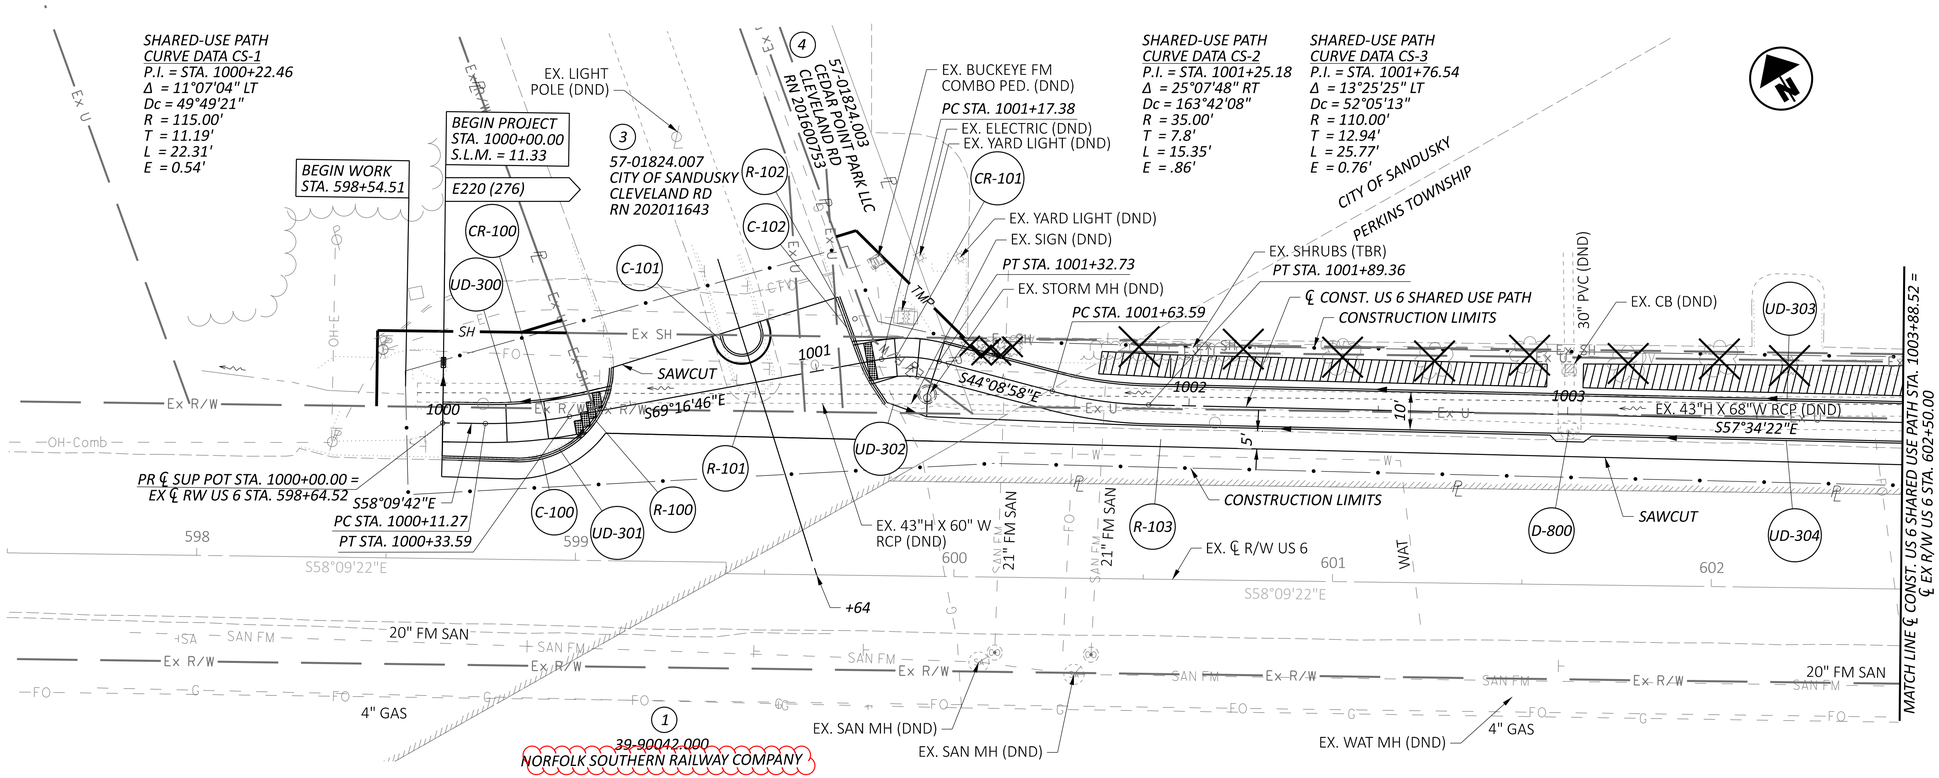

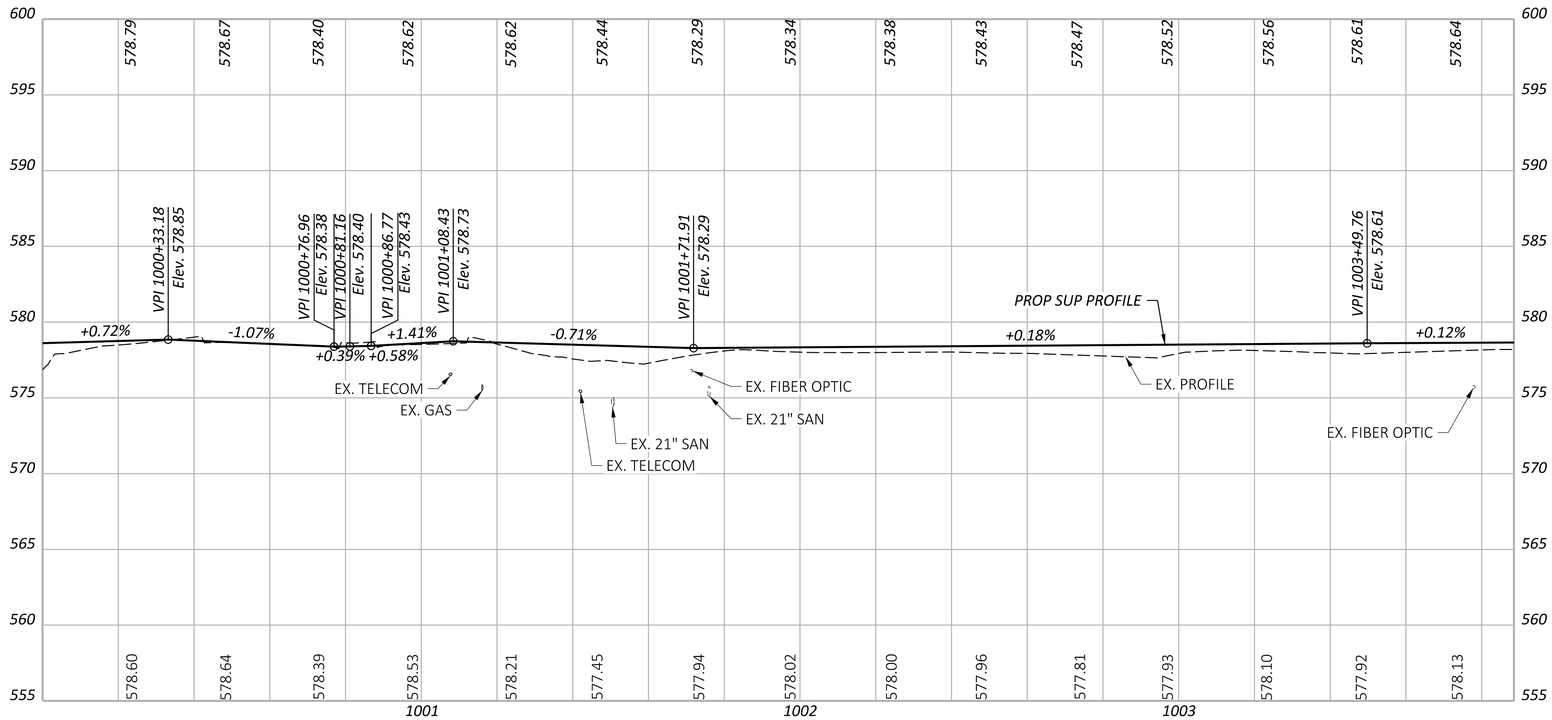

HORIZONTAL SCALE IN FEET
0 10 20 40

PLAN AND PROFILE - US 6 SUP
BEGIN TO EX R/W STA. 602+50.00/US 6 SUP STA. 1000+00.00 TO STA. 1003+88.52

DESIGN AGENCY
OHM

DESIGNER	SDH
REVIEWER	AHC 10/27/25
PROJECT ID	116570
SHEET	P.0375
TOTAL	1106

ERI-US 0006-CONNECTIVITY CORRIDOR

MODEL: CLP_SUP_1 - Plan 002 [Sheet] PAPERSIZE: 34x22 (in.) DATE: 2/26/2026 TIME: 10:11:31 AM PLTDRV: OHDOT_PDF_Levels.pltcfg PENTBL: OHDOT_Pen.tbl USER: Brennon.Cain@ohm-advisors.com WORKSPACE: OHDOTCEv02 WORKSET: 116570 PRODUCT: OpenRoadsDesigner 24.00.00.205
pw:\\ohiodot-pw.bentley.com:ohiodot-pw-02\Documents\01 Active Projects\District 03\Erie\116570\403-Engineering_OHMAdvisors\Roadway\Sheets\116570_GP101.dgn

CURVE DATA CS-4
P.I. = STA. 1004+31.99
Δ = 04°18'53" RT
Dc = 52°05'13"
R = 110.00'
T = 4.14'
L = 8.28'
E = .08'

CURVE DATA CS-5
P.I. = STA. 1004+84.92
Δ = 03°55'26" LT
Dc = 52°05'13"
R = 110.00'
T = 3.77'
L = 7.53'
E = 0.06'


CURVE DATA CS-6
P.I. = STA. 1006+83.26
Δ = 02°05'21" LT
Dc = 52°05'13"
R = 110.00'
T = 2.01'
L = 4.01'
E = 0.02'

CURVE DATA CS-7
P.I. = STA. 1008+43.06
Δ = 00°57'06" RT
Dc = 52°05'13"
R = 110.00'
T = .91'
L = 1.83'
E = 0'


AMENDED VEGETATED FILTER STRIP

HORIZONTAL SCALE IN FEET
0 10 20 40

(4)
32-01427.001
32-01427.500
CEDAR POINT PARK LLC
CLEVELAND RD
RN 201600753

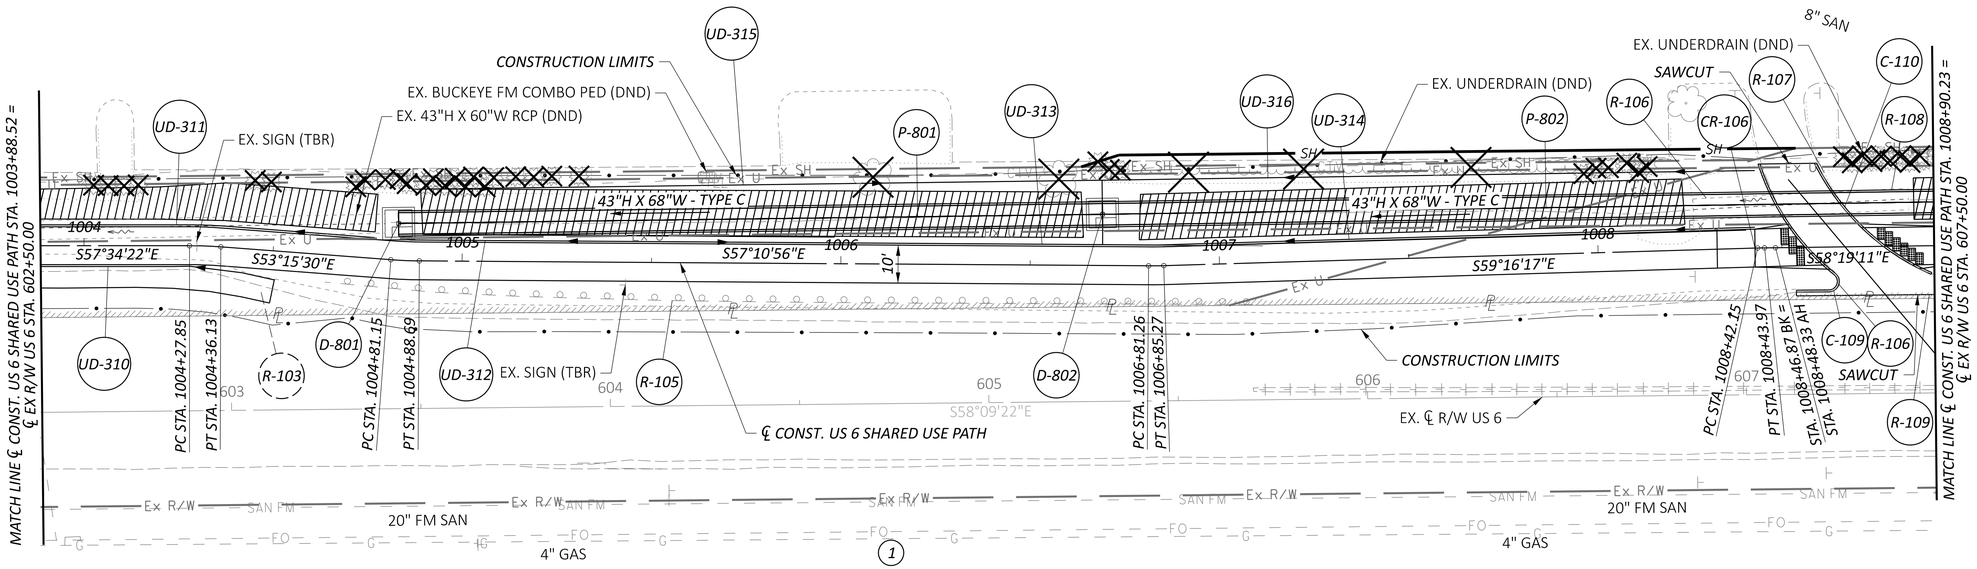

(1)
39-90042.000
NORFOLK SOUTHERN RAILWAY COMPANY

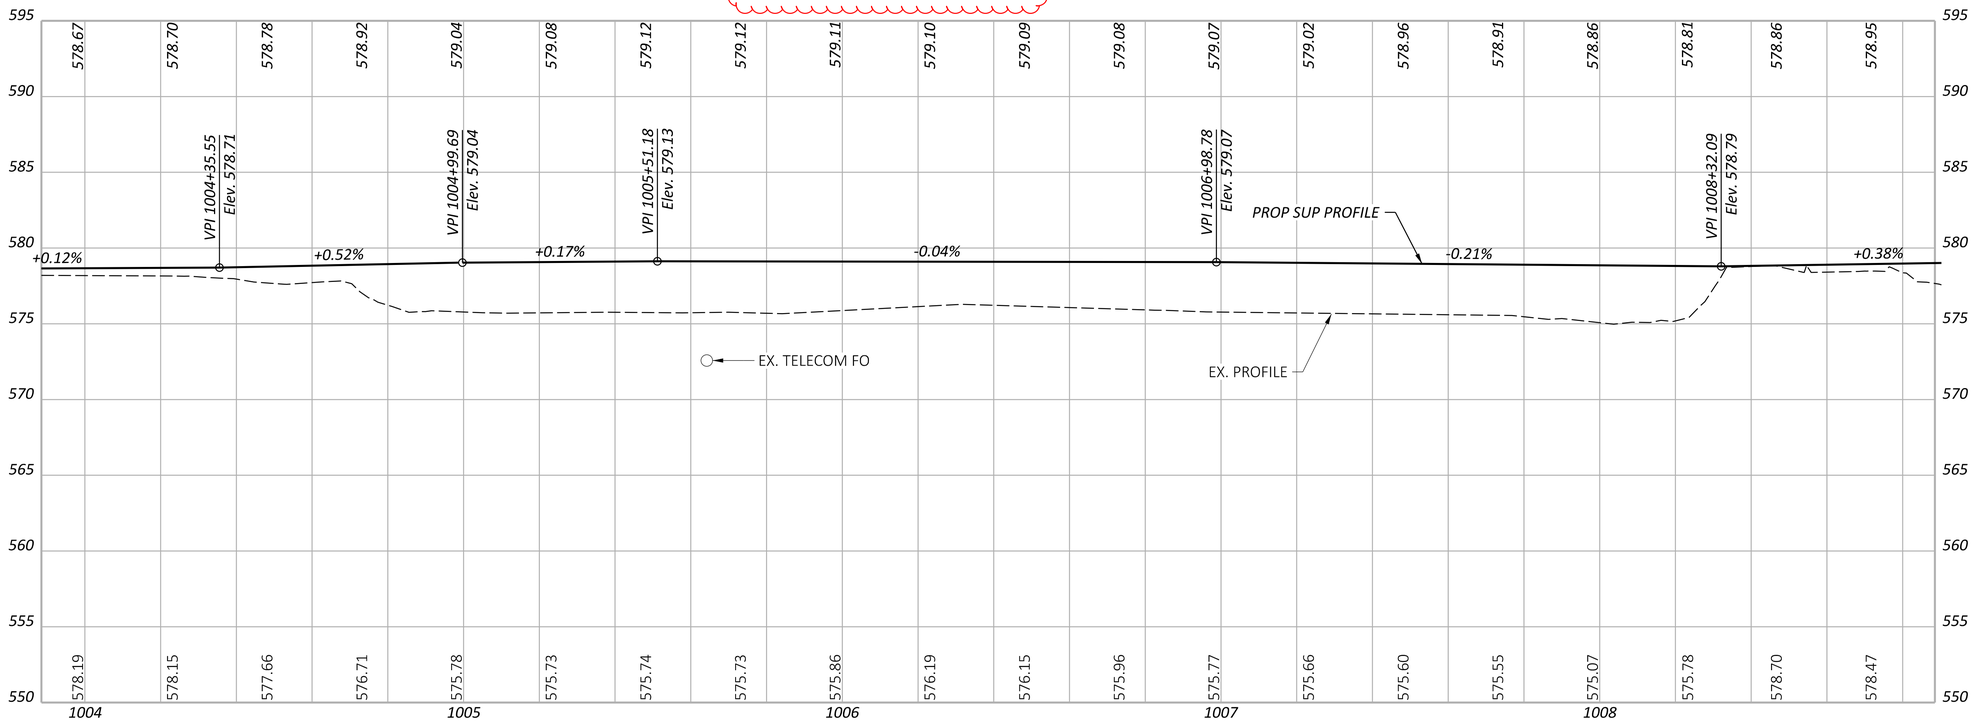


PLAN AND PROFILE - US 6 SUP
EX R/W STA. 602+50.00 TO STA. 607+50.00/US 6 SUP STA. 1003+88.52 TO STA. 1008+90.23


DESIGN AGENCY
OHM

DESIGNER	SDH
REVIEWER	AHC 10/27/25
PROJECT ID	116570
SHEET	P.0376
TOTAL	1106

ERI-US 0006-CONNECTIVITY CORRIDOR

MODEL: CLP_SUP_1 - Plan 003 [Sheet] PAPERSIZE: 34x22 (in.) DATE: 2/26/2026 TIME: 10:11:32 AM PLTDRV: OHDOT_PDF_Levels.pltcfg PENTBL: OHDOT_Pen.tbl USER: Brennon.Cain@ohm-advisors.com WORKSPACE: OHDOTCEv02 WORKSET: 116570 PRODUCT: OpenRoadsDesigner 24.00.00.205
pw:\\ohiodot-pw.bentley.com:ohiodot-pw-02\Documents\01 Active Projects\District 03\Erie\116570\403-Engineering_OHMAdvisors\Roadway\Sheets\116570_GP101.dgn

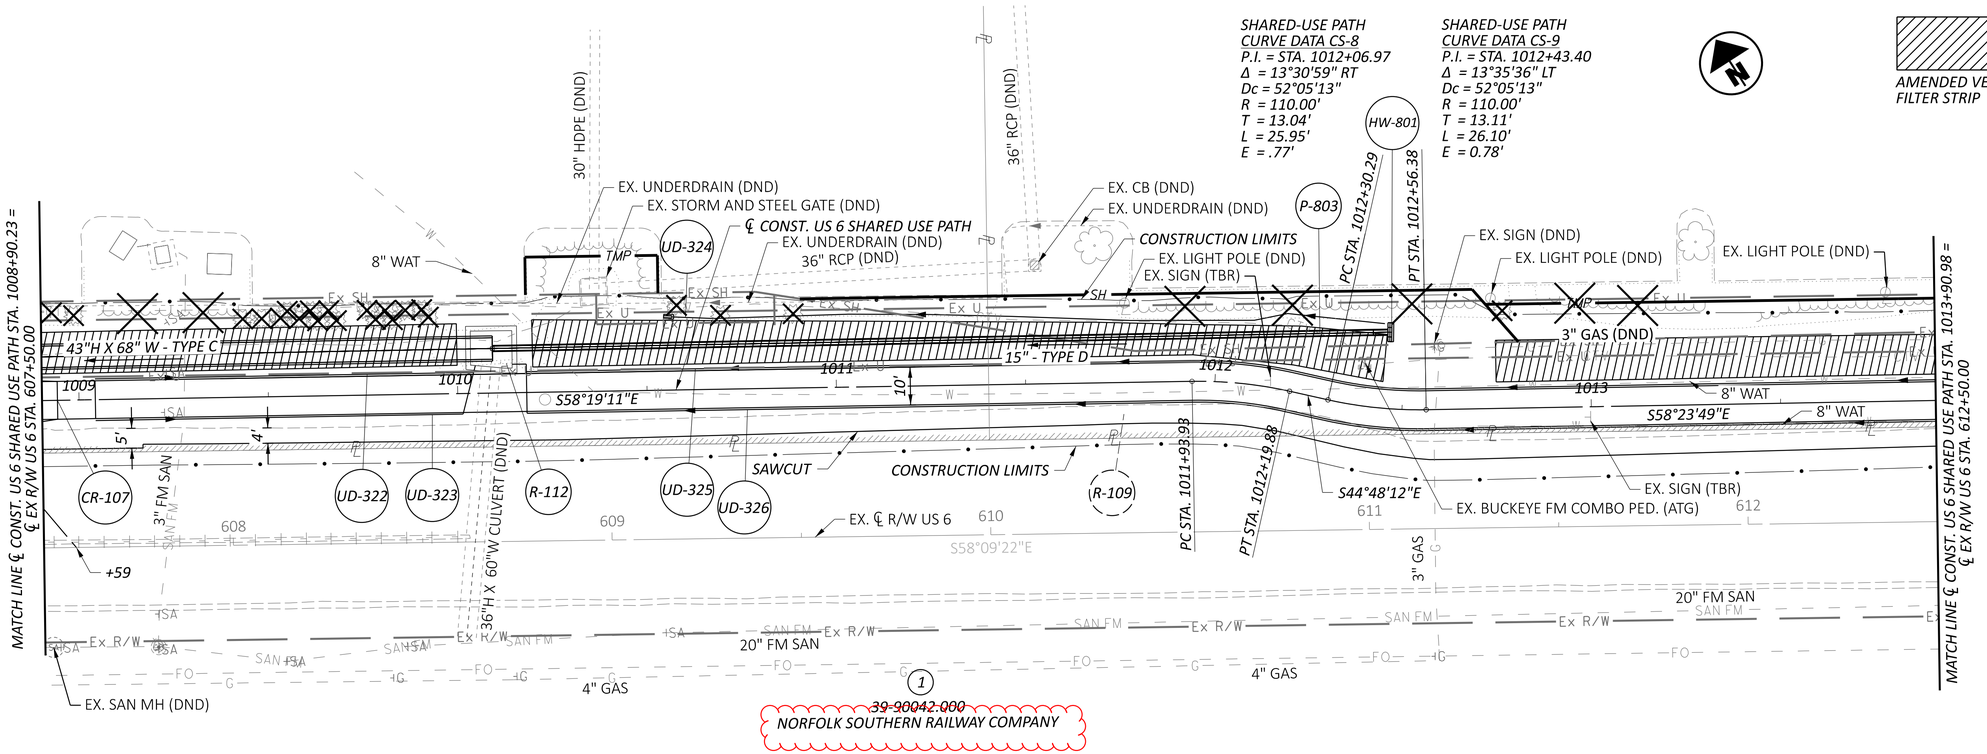

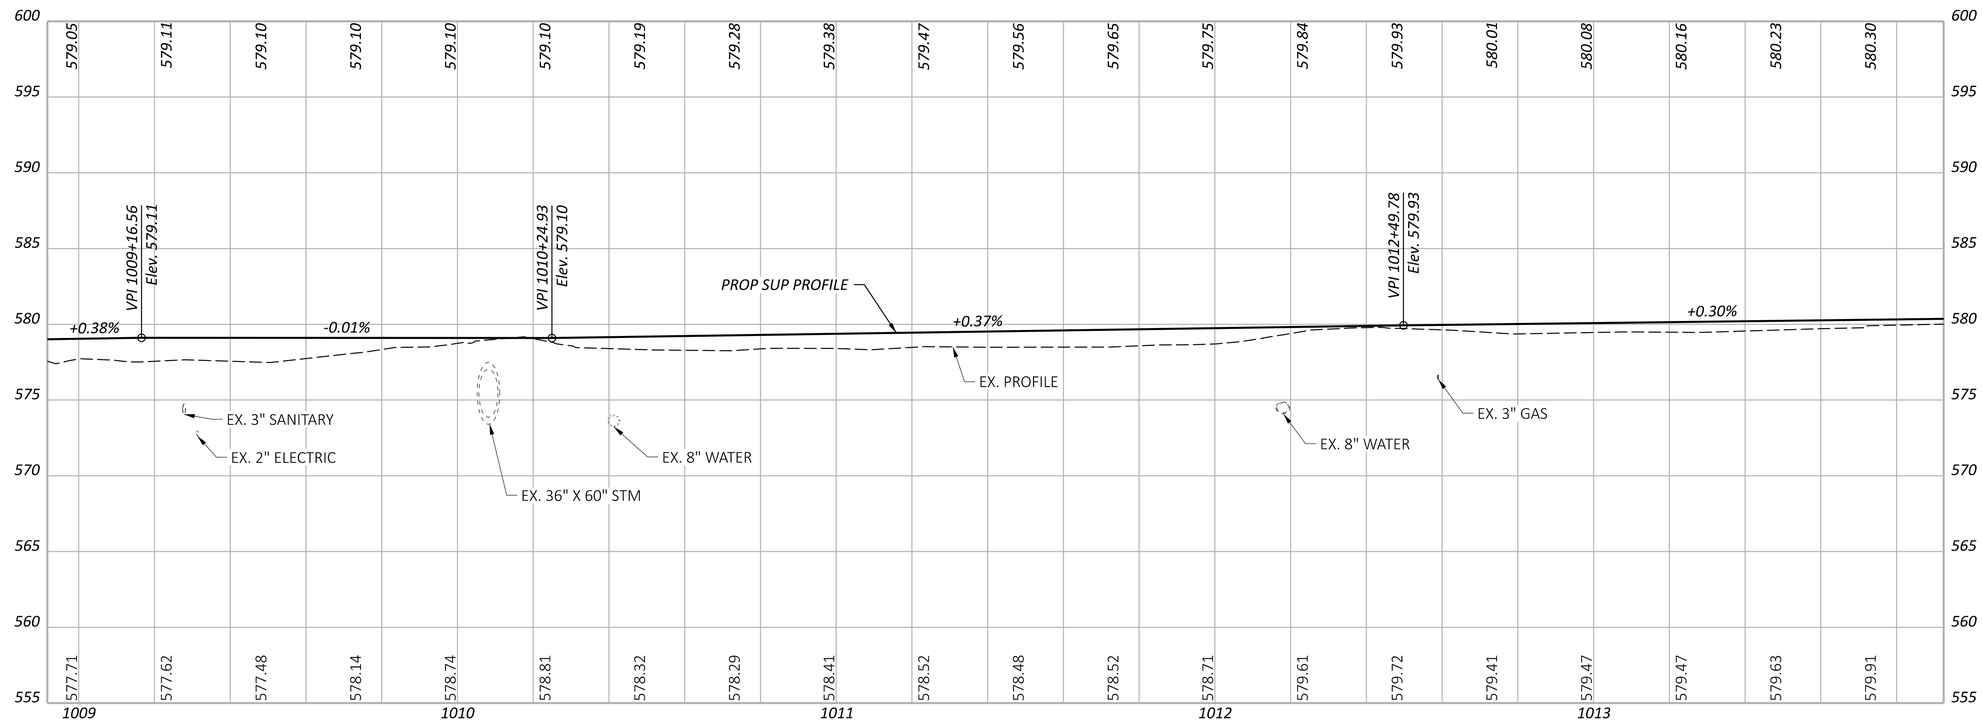

HORIZONTAL SCALE IN FEET
0 10 20 40


PLAN AND PROFILE - US 6 SUP
EX R/W STA. 607+50.00 TO STA. 612+50.00/US 6 SUP STA. 1008+90.23 TO STA. 1013+90.98


DESIGN AGENCY
OHM

DESIGNER	SDH
REVIEWER	AHC 10/27/25
PROJECT ID	116570
SHEET	P.0377
TOTAL	1106

MODEL: CLP_SUP_1 - Plan 004 [Sheet] PAPERSIZE: 34x22 (in.) DATE: 2/26/2026 TIME: 10:11:34 AM PLTDRV: OHDOT_PDF_Levels.pltcfg PENTBL: OHDOT_Pen.tbl USER: Brennon.Cain@ohm-advisors.com WORKSPACE: OHDOTCEv02 WORKSET: 116570 PRODUCT: OpenRoadsDesigner 24.00.00.205
pw:\\ohiodot-pw.bentley.com:ohiodot-pw-02\Documents\01 Active Projects\District 03\Erie\116570\403-Engineering_OHMAdvisors\Roadway\Sheets\116570_GP101.dgn

ERI-US 0006-CONNECTIVITY CORRIDOR

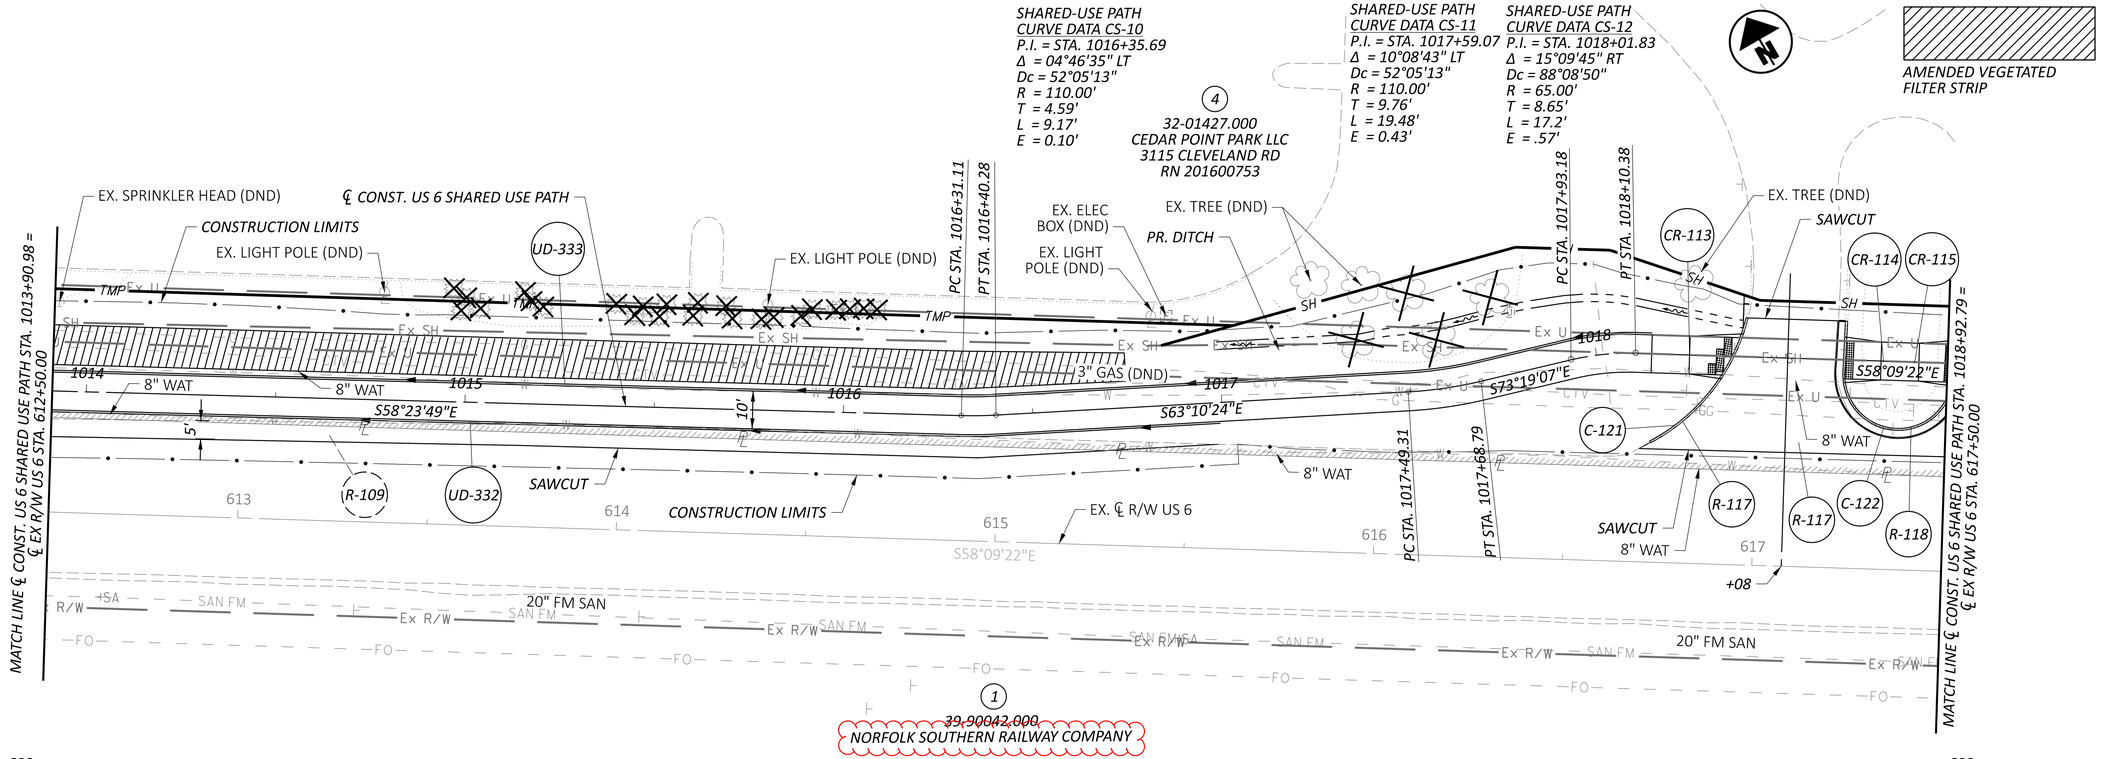

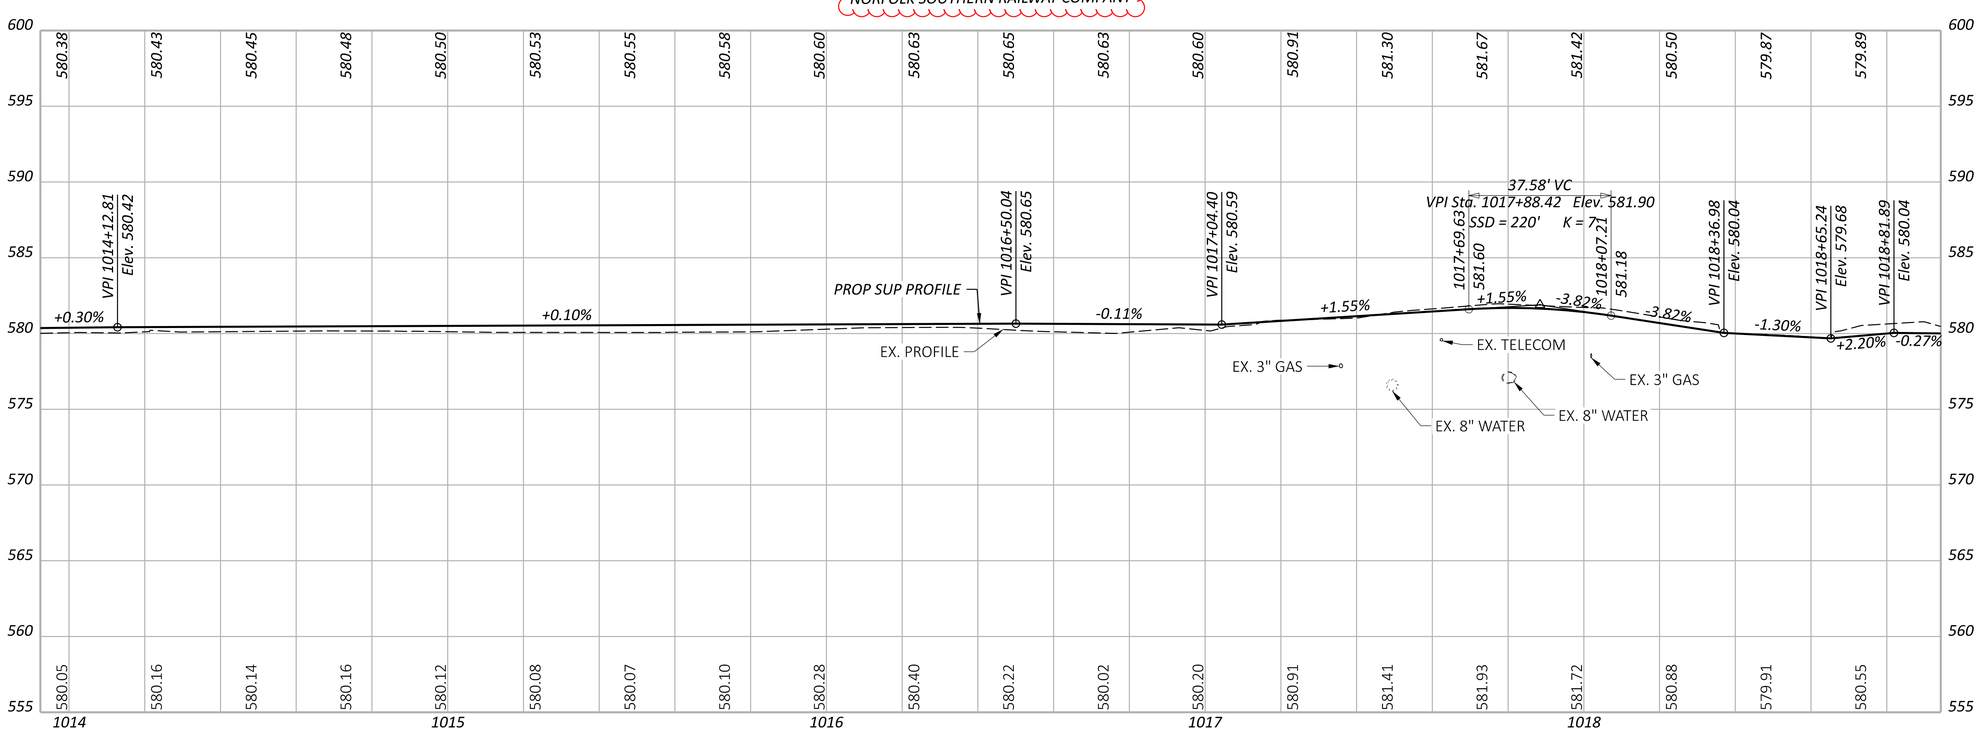



PLAN AND PROFILE - US 6 SUP
EX R/W STA. 612+50.00 TO STA. 617+50.00/PR SUP STA. 1013+90.98 TO STA. 1018+92.79

DESIGN AGENCY
OHM

DESIGNER	SDH
REVIEWER	AHC 10/27/25
PROJECT ID	116570
SHEET	P.0378
TOTAL	1106

MODEL: CLP_SUP_1 - Plan 005 [Sheet] PAPERSIZE: 34x22 (in.) DATE: 2/26/2026 TIME: 10:11:36 AM PLTDRV: OHDOT_PDF_Levels.pltcfg PENTBL: OHDOT_Pen.tbl USER: Brennon.Cain@ohm-advisors.com WORKSPACE: OHDOTCEv02 WORKSET: 116570 PRODUCT: OpenRoadsDesigner 24.00.00.205
pw:\\ohiodot-pw.bentley.com:ohiodot-pw-02\Documents\01 Active Projects\District 03\Erie\116570\403-Engineering_OHMAdvisors\Roadway\Sheets\116570_GP101.dgn

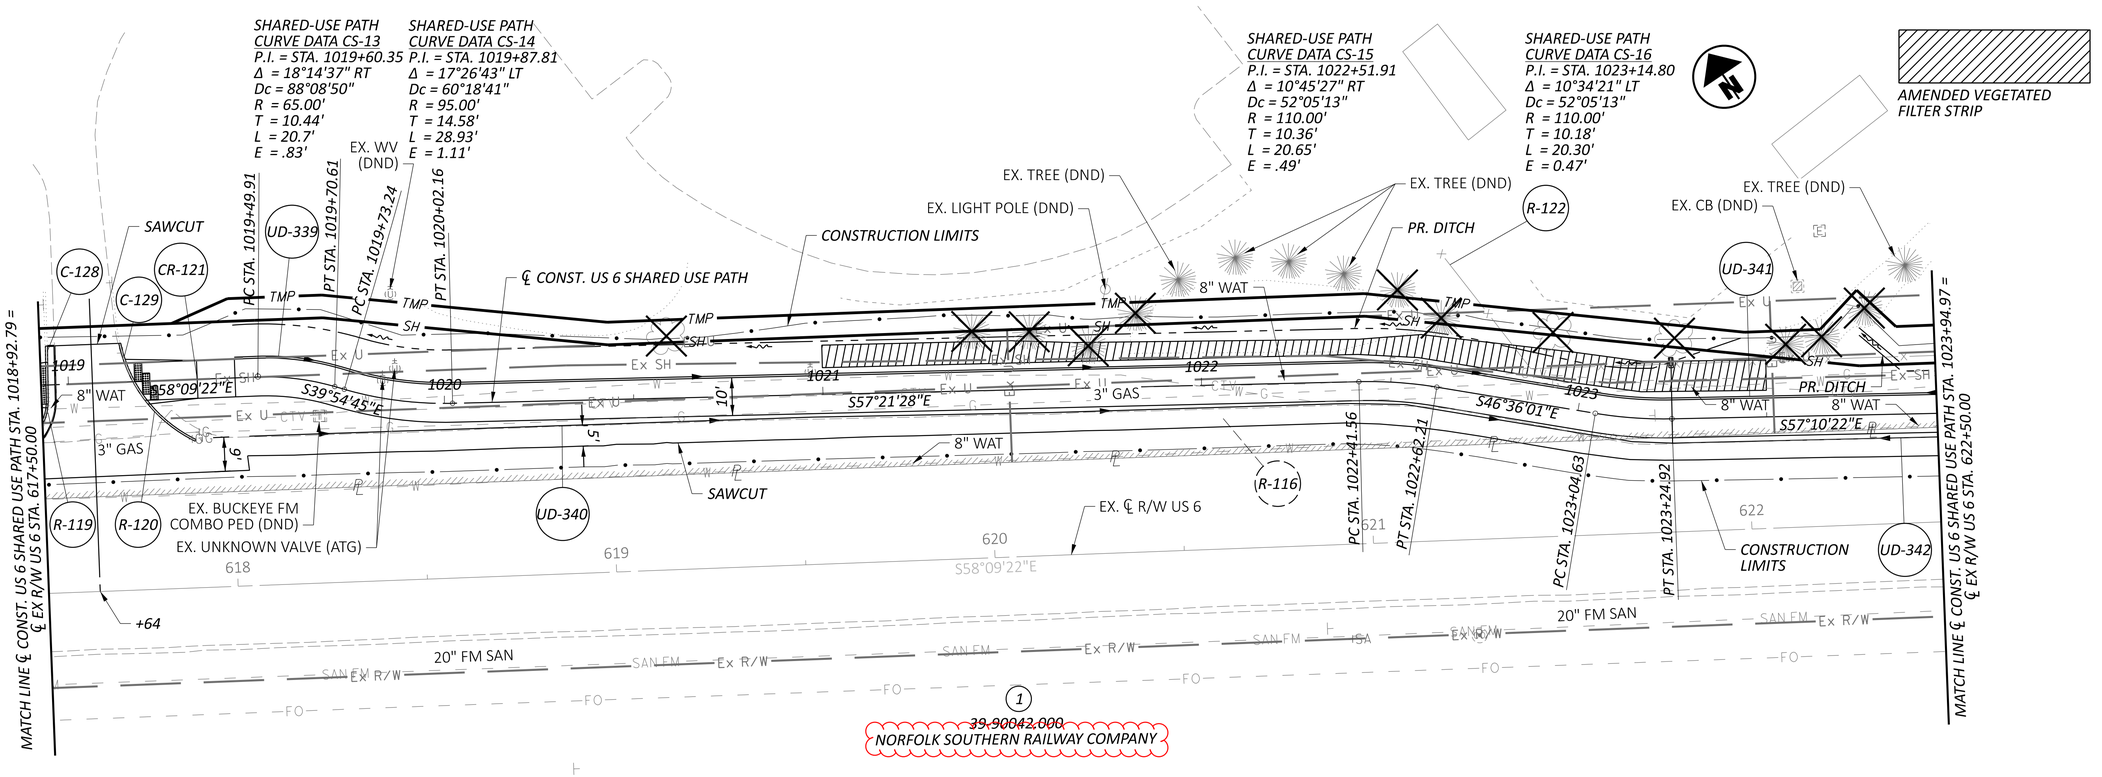

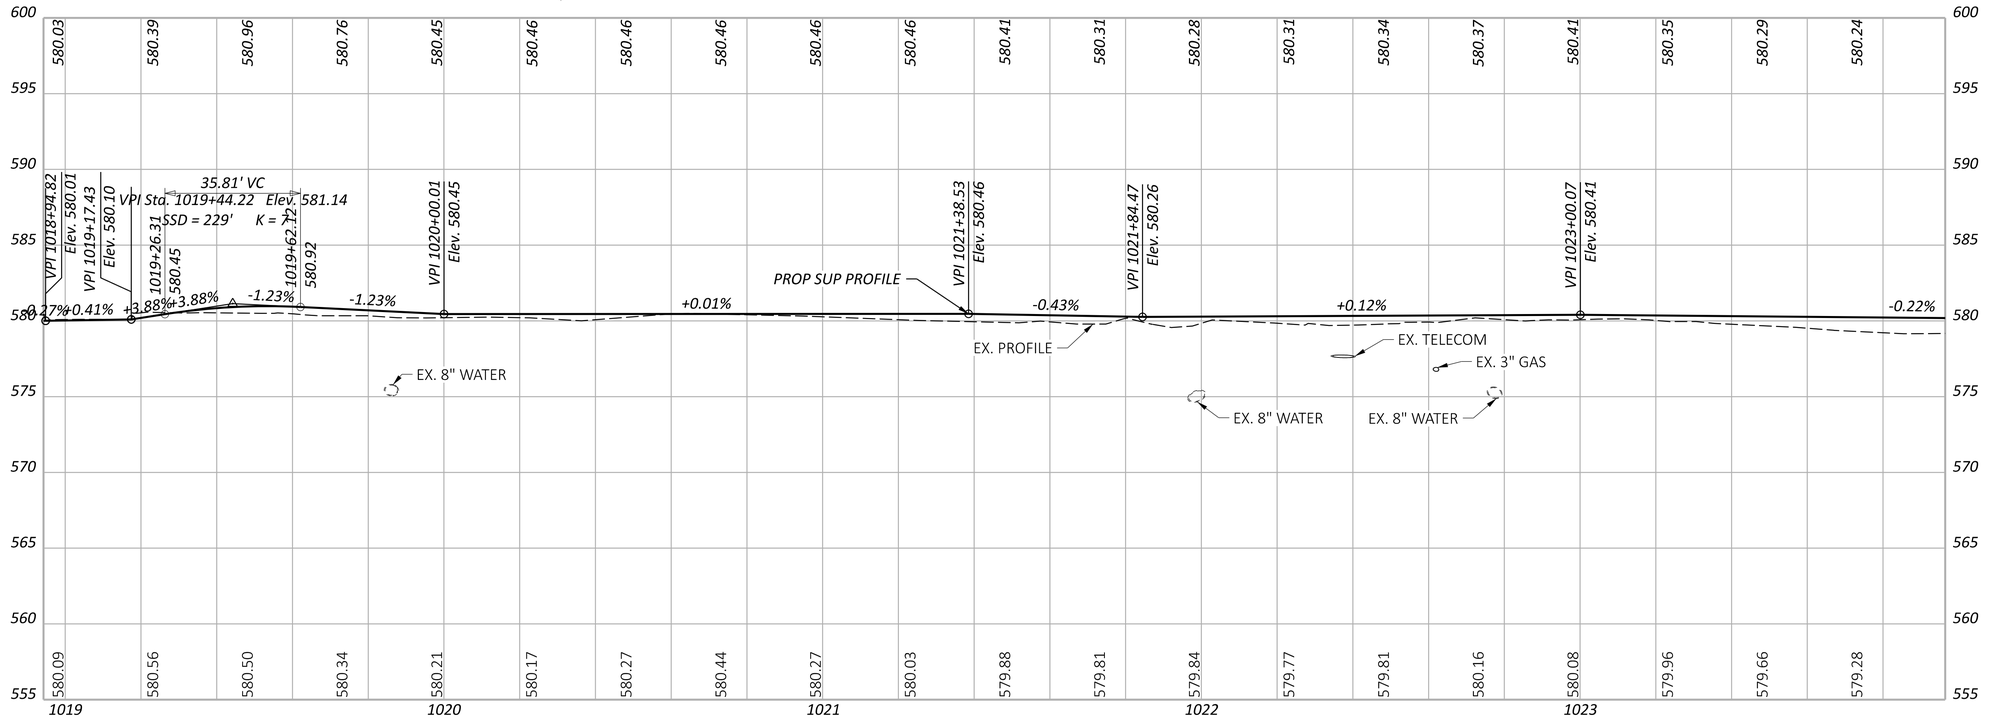

HORIZONTAL SCALE IN FEET
0 10 20 40

PLAN AND PROFILE - US 6 SUP
EX R/W STA. 617+50.00 TO STA. 622+50.00/US 6 SUP STA. 1018+92.79 TO STA. 1023+94.97

DESIGN AGENCY
OHM

DESIGNER	SDH
REVIEWER	AHC 10/27/25
PROJECT ID	116570
SHEET	P.0379
TOTAL	1106

SHARED-USE PATH
CURVE DATA CS-17
P.I. = STA. 1025+18.47
Δ = 11°46'38" LT
Dc = 104°10'27"
R = 55.00'
T = 5.67'
L = 11.31'
E = 0.29'

SHARED-USE PATH
CURVE DATA CS-18
P.I. = STA. 1025+64.66
Δ = 13°03'47" RT
Dc = 88°08'50"
R = 65.00'
T = 7.44'
L = 14.82'
E = .42'

SHARED-USE PATH
CURVE DATA CS-19
P.I. = STA. 1025+86.48
Δ = 06°51'46" LT
Dc = 60°18'41"
R = 95.00'
T = 5.70'
L = 11.38'
E = 0.17'

(4)
32-02214.000
CEDAR POINT PARK LLC
CLEVELAND RD
RN 201603072

SHARED-USE PATH
CURVE DATA CS-20
P.I. = STA. 1027+24.19
Δ = 04°40'43" RT
Dc = 52°05'13"
R = 110.00'
T = 4.49'
L = 8.98'
E = .09'

AMENDED VEGETATED FILTER STRIP

HORIZONTAL SCALE IN FEET
0 10 20 40

MATCH LINE ℄ CONST. US 6 SHARED USE PATH STA. 1023+94.97 = ℄ EX R/W US 6 STA. 622+50.00

MATCH LINE ℄ CONST. US 6 SHARED USE PATH STA. 1028+96.14 = ℄ EX R/W US 6 STA. 627+50.00

R-128 R-129 DR-01 UD-349 UD-350 R-116 UD-351


EX. SAN MH (DND)
EX. GATE (DND)
EX. HATCHES (DND)
EX. FH (DND)
EX. WV (DND)
EX. GUY ANCHOR (DND)
PR. DITCH
8" WAT
3" GAS
SAWCUT
CONSTRUCTION LIMITS
EX. GATE KEYPAD (TBRL)
EX. BUCKEYE PED (DND)
EX. WV (ATG)
EX. ℄ R/W US 6
℄ CONST. US 6 SHARED USE PATH
3" GAS (DND)
EX. 10" RCP (DND)
PR. WATER
EX. SAN MH (DND)
20" FM SAN
3" FM SAN

PC STA. 1025+12.80
PT STA. 1025+24.10
PC STA. 1025+72.03
PT STA. 1025+80.79
PC STA. 1025+92.16
PT STA. 1026
PC STA. 1025+57.21
PC STA. 1027+19.70
PT STA. 1027+28.68

S57°10'22"E
S68°57'01"E
S55°53'14"E
S62°45'00"E
S58°04'17"E
S58°09'22"E

1024 1025 1026 1027 1028
623 624 625 626 627

(1)
39-90042.000
NORFOLK SOUTHERN RAILWAY COMPANY

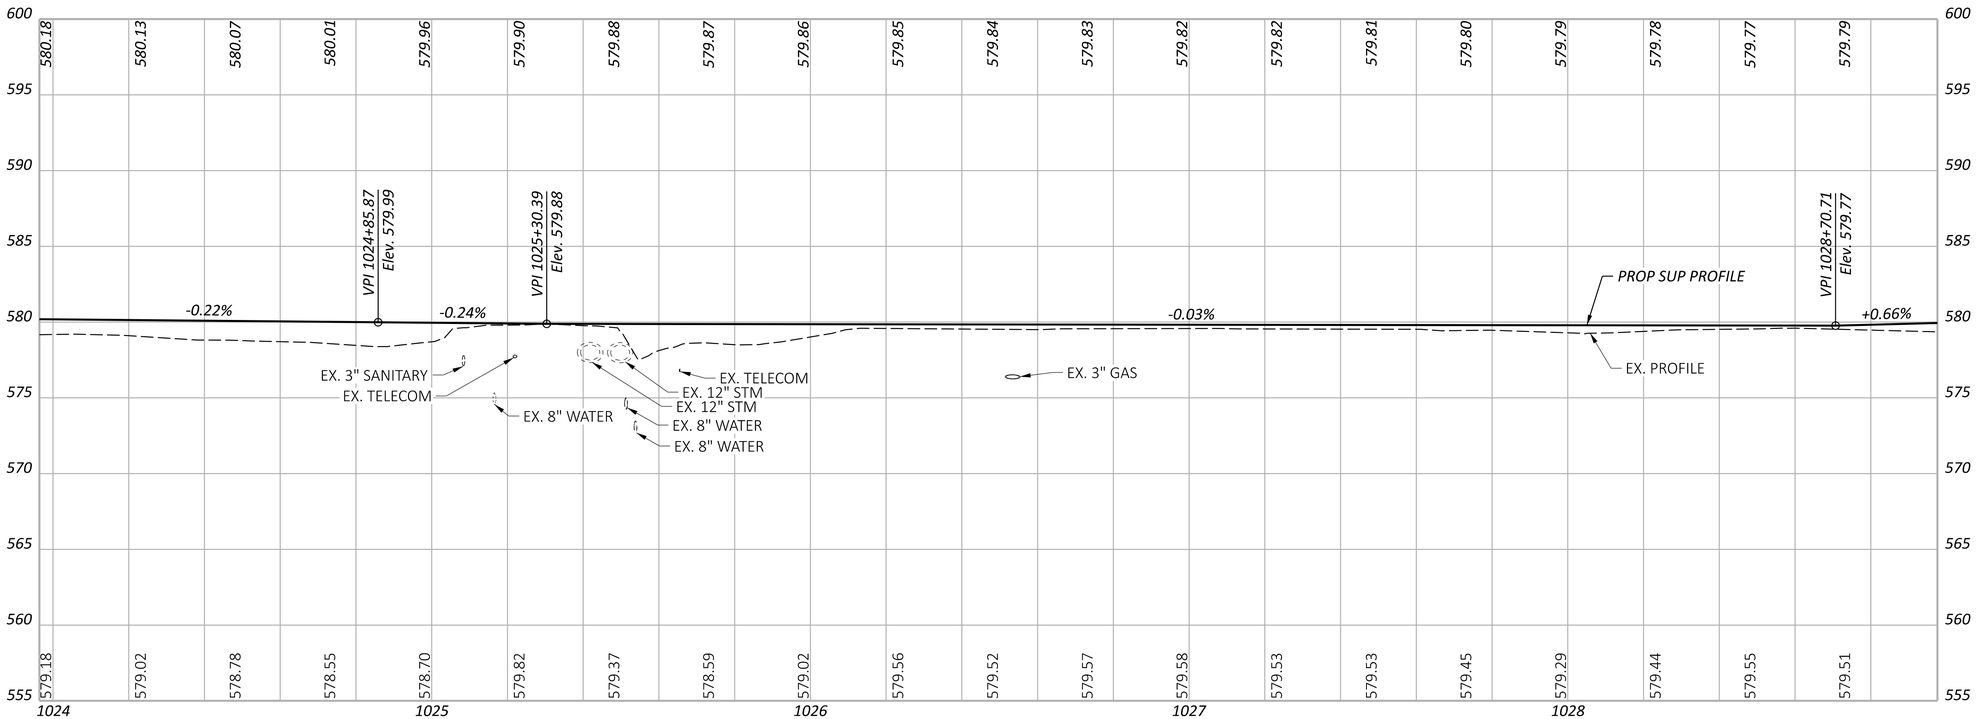

PLAN AND PROFILE - US 6 SUP

EX R/W STA. 622+50.00 TO STA. 627+50.00/US 6 SUP STA. 1023+94.97 TO STA. 1028+96.14

ERI-US 0006-CONNECTIVITY CORRIDOR


DESIGN AGENCY
OHM

DESIGNER	SDH
REVIEWER	AHC 10/27/25
PROJECT ID	116570
SHEET	P.0380
TOTAL	1106

MODEL: CLP_SUP_1 - Plan 006 [Sheet] PAPERSIZE: 34x22 (in.) DATE: 2/26/2026 TIME: 10:11:37 AM PLTDRV: OHDOT_PDF_Levels.pltcfg PENTBL: OHDOT_Pen.tbl USER: Brennon.Cain@ohm-advisors.com WORKSPACE: OHDOTCEv02 WORKSET: 116570 PRODUCT: OpenRoadsDesigner 24.00.00.205
pw:\\ohiodot-pw.bentley.com:ohiodot-pw-02\Documents\01 Active Projects\District 03\Erie\116570\403-Engineering_OHMAdvisors\Roadway\Sheets\116570_GP101.dgn

ERI-US 0006-CONNECTIVITY CORRIDOR

MODEL: CLP_SUP_1 - Plan 007 [Sheet] PAPERSIZE: 34x22 (in.) DATE: 2/26/2026 TIME: 10:11:39 AM PLTDRV: OHDOT_PDF_Levels.pltcfg PENTBL: OHDOT_Pen.tbl USER: Brennon.Cain@ohm-advisors.com WORKSPACE: OHDOTCEv02 WORKSET: 116570 PRODUCT: OpenRoadsDesigner 24.00.00.205
pw:\\ohiodot-pw.bentley.com:ohiodot-pw-02\Documents\01 Active Projects\District 03\Erie\116570\403-Engineering_OHMAdvisors\Roadway\Sheets\116570_GP101.dgn

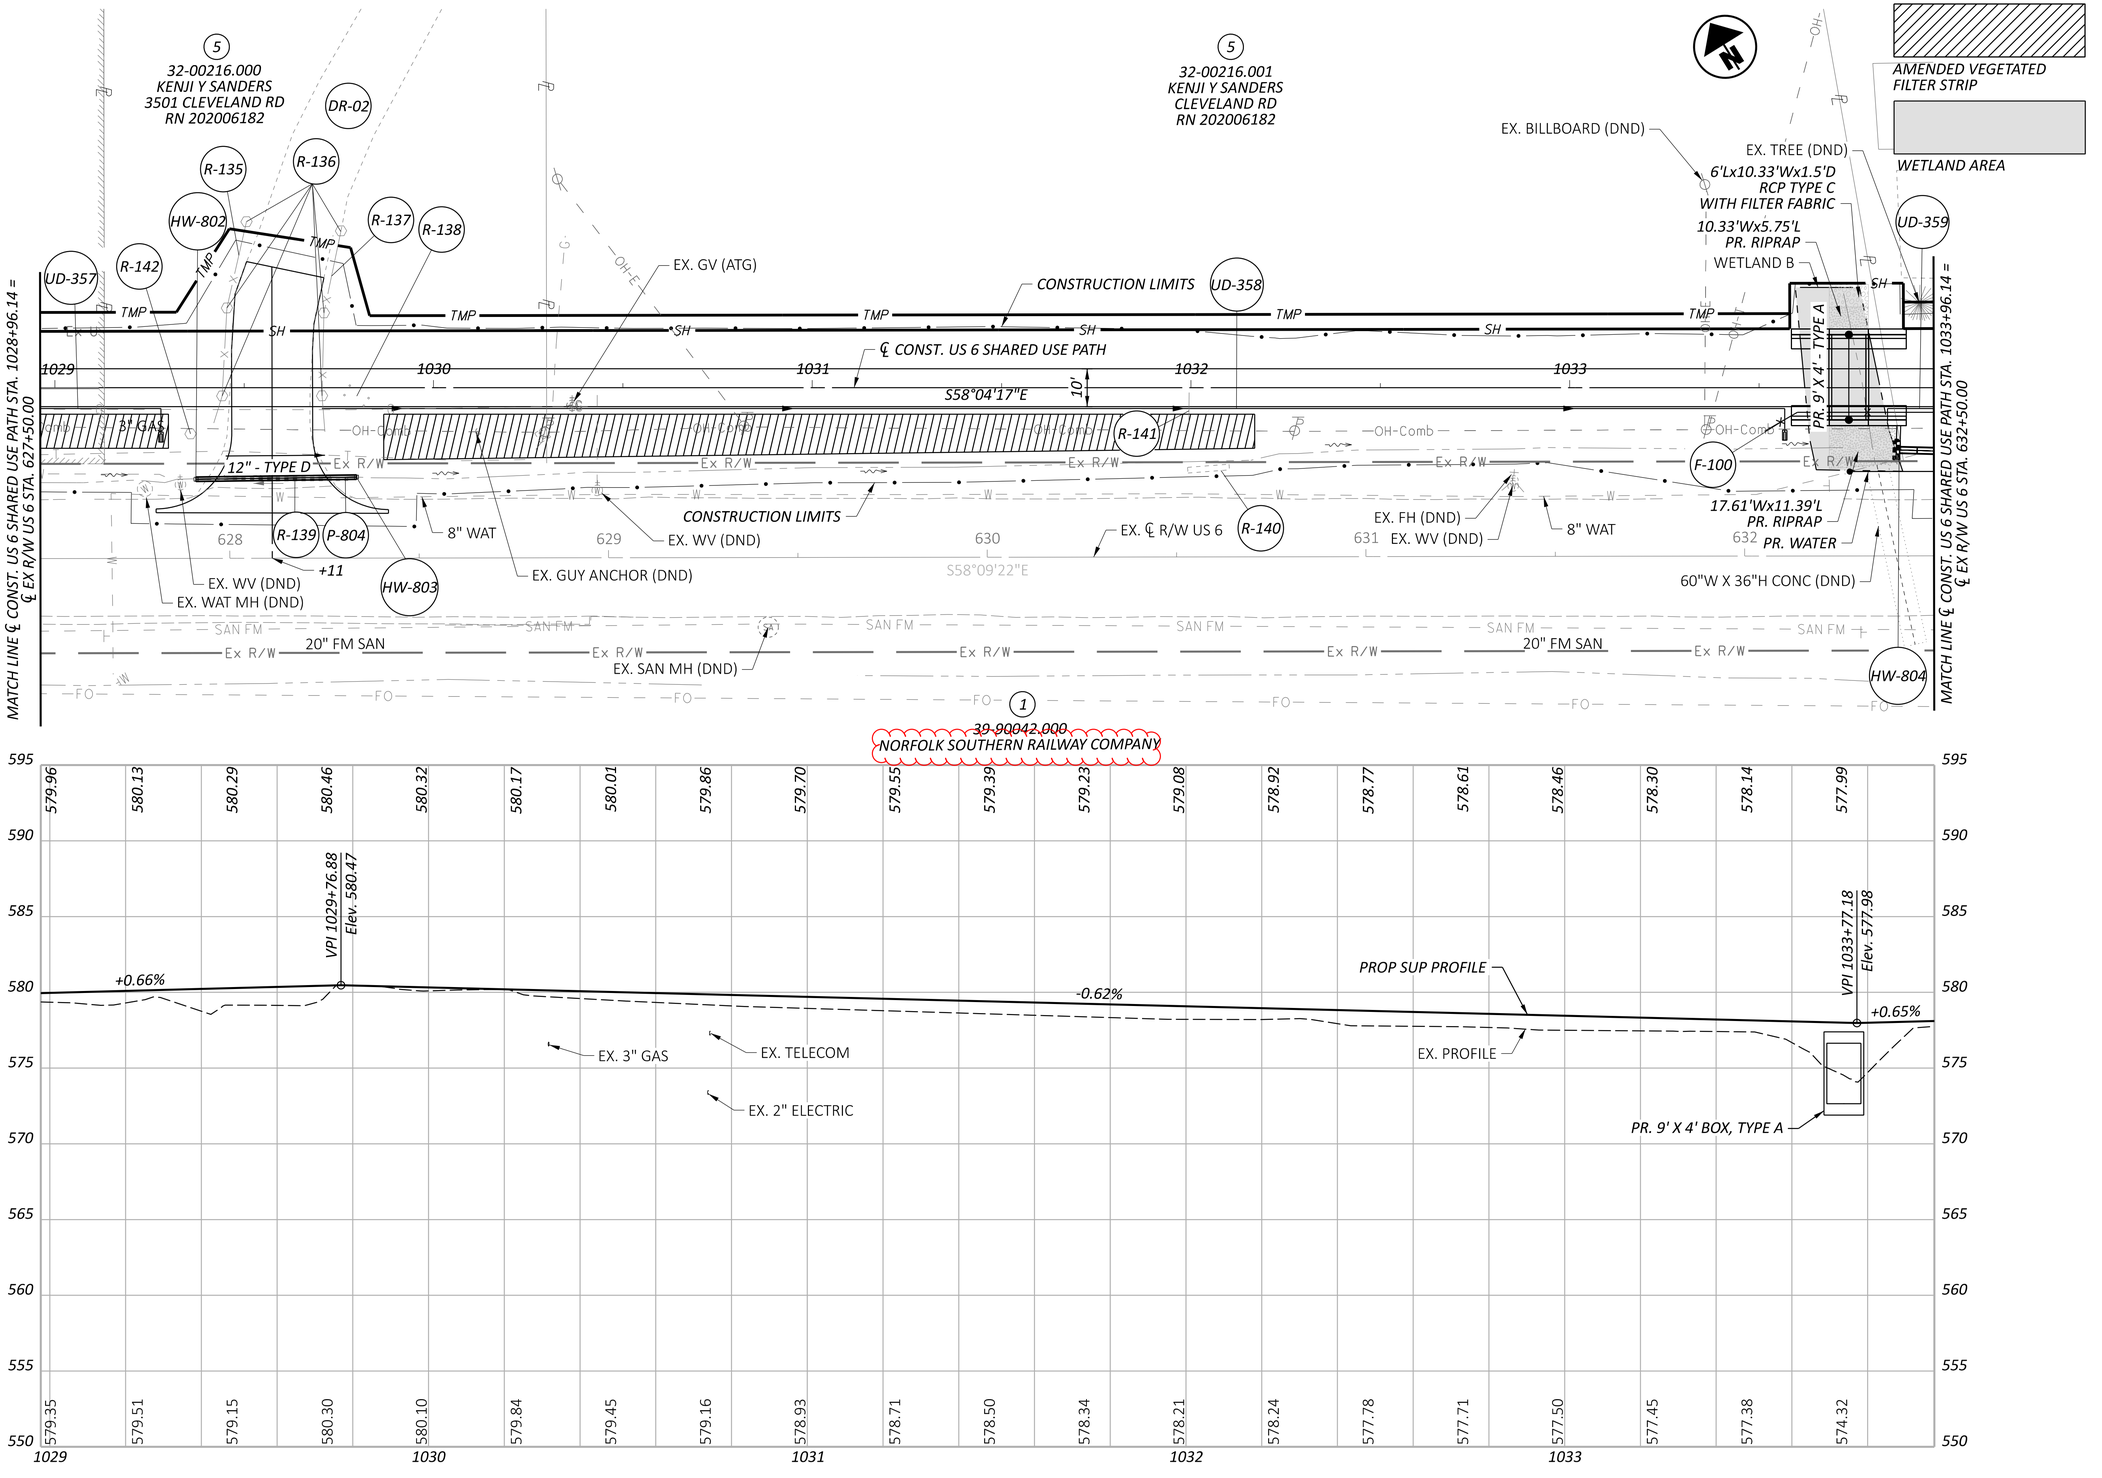


HORIZONTAL SCALE IN FEET
0 10 20 40

PLAN AND PROFILE - US 6 SUP
EX R/W STA. 627+50.00 TO STA. 632+50.00/US 6 SUP STA. 1028+96.14 TO STA. 1033+96.14

DESIGN AGENCY
OHM

DESIGNER	SDH
REVIEWER	AHC 10/27/25
PROJECT ID	116570
SHEET	P.0381
TOTAL	1106

MODEL: CLP_SUP_1 - Plan 008 [Sheet] PAPERSIZE: 34x22 (in.) DATE: 2/26/2026 TIME: 10:11:41 AM PLTDRV: OHDOT_PDF_Levels.pltcfg PENTBL: OHDOT_Pen.tbl USER: Brennon.Cain@ohm-advisors.com WORKSPACE: OHDOTCEv02 WORKSET: 116570 PRODUCT: OpenRoadsDesigner 24.00.00.205
pw:\\ohiodot-pw.bentley.com:ohiodot-pw-02\Documents\01 Active Projects\District 03\Erie\116570\403-Engineering_OHMAdvisors\Roadway\Sheets\116570_GP101.dgn

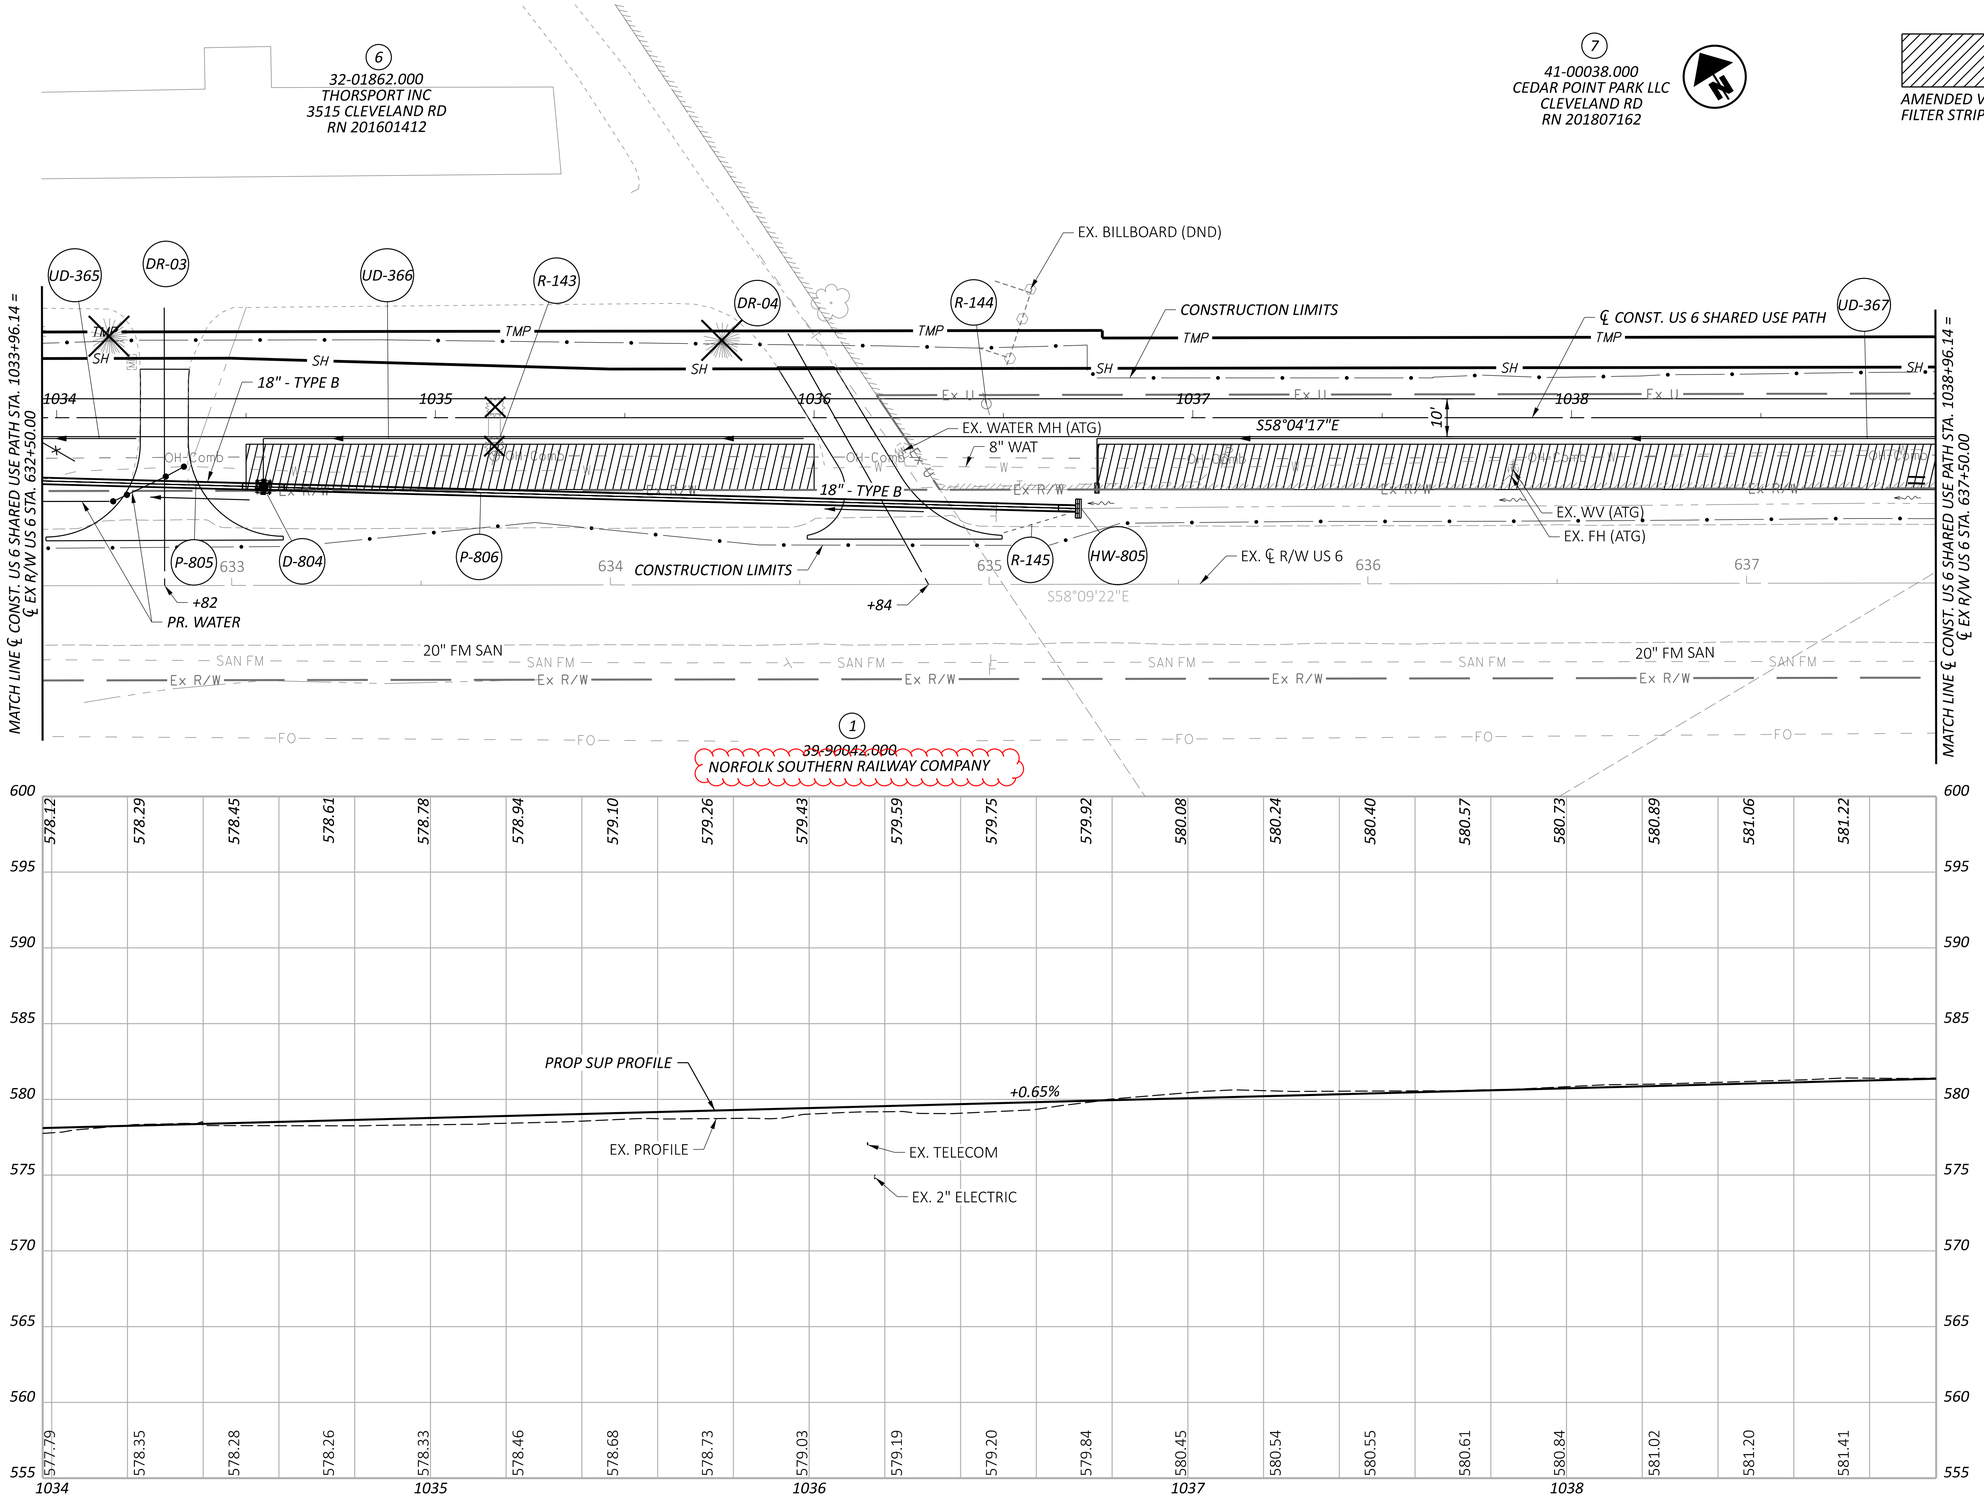

HORIZONTAL SCALE IN FEET
0 10 20 40


PLAN AND PROFILE - US 6 SUP
EX R/W STA. 632+50.00 TO STA. 637+50.00/US 6 SUP STA. 1033+96.14 TO STA. 1038+96.14

DESIGN AGENCY
OHM

DESIGNER	SDH
REVIEWER	AHC 10/27/25
PROJECT ID	116570
SHEET	P.0382
TOTAL	1106

ERI-US 0006-CONNECTIVITY CORRIDOR

MODEL: CLP_SUP_1 - Plan 009 [Sheet] PAPERSIZE: 34x22 (in.) DATE: 2/26/2026 TIME: 10:11:42 AM PLTDRV: OHDOT_PDF_Levels.pltcfg PENTBL: OHDOT_Pen.tbl USER: Brennon.Cain@ohm-advisors.com WORKSPACE: OHDOTCEv02 WORKSET: 116570 PRODUCT: OpenRoadsDesigner 24.00.00.205
pw:\\ohiodot-pw.bentley.com:ohiodot-pw-02\Documents\01 Active Projects\District 03\Erie\116570\403-Engineering_OHMAdvisors\Roadway\Sheets\116570_GP101.dgn

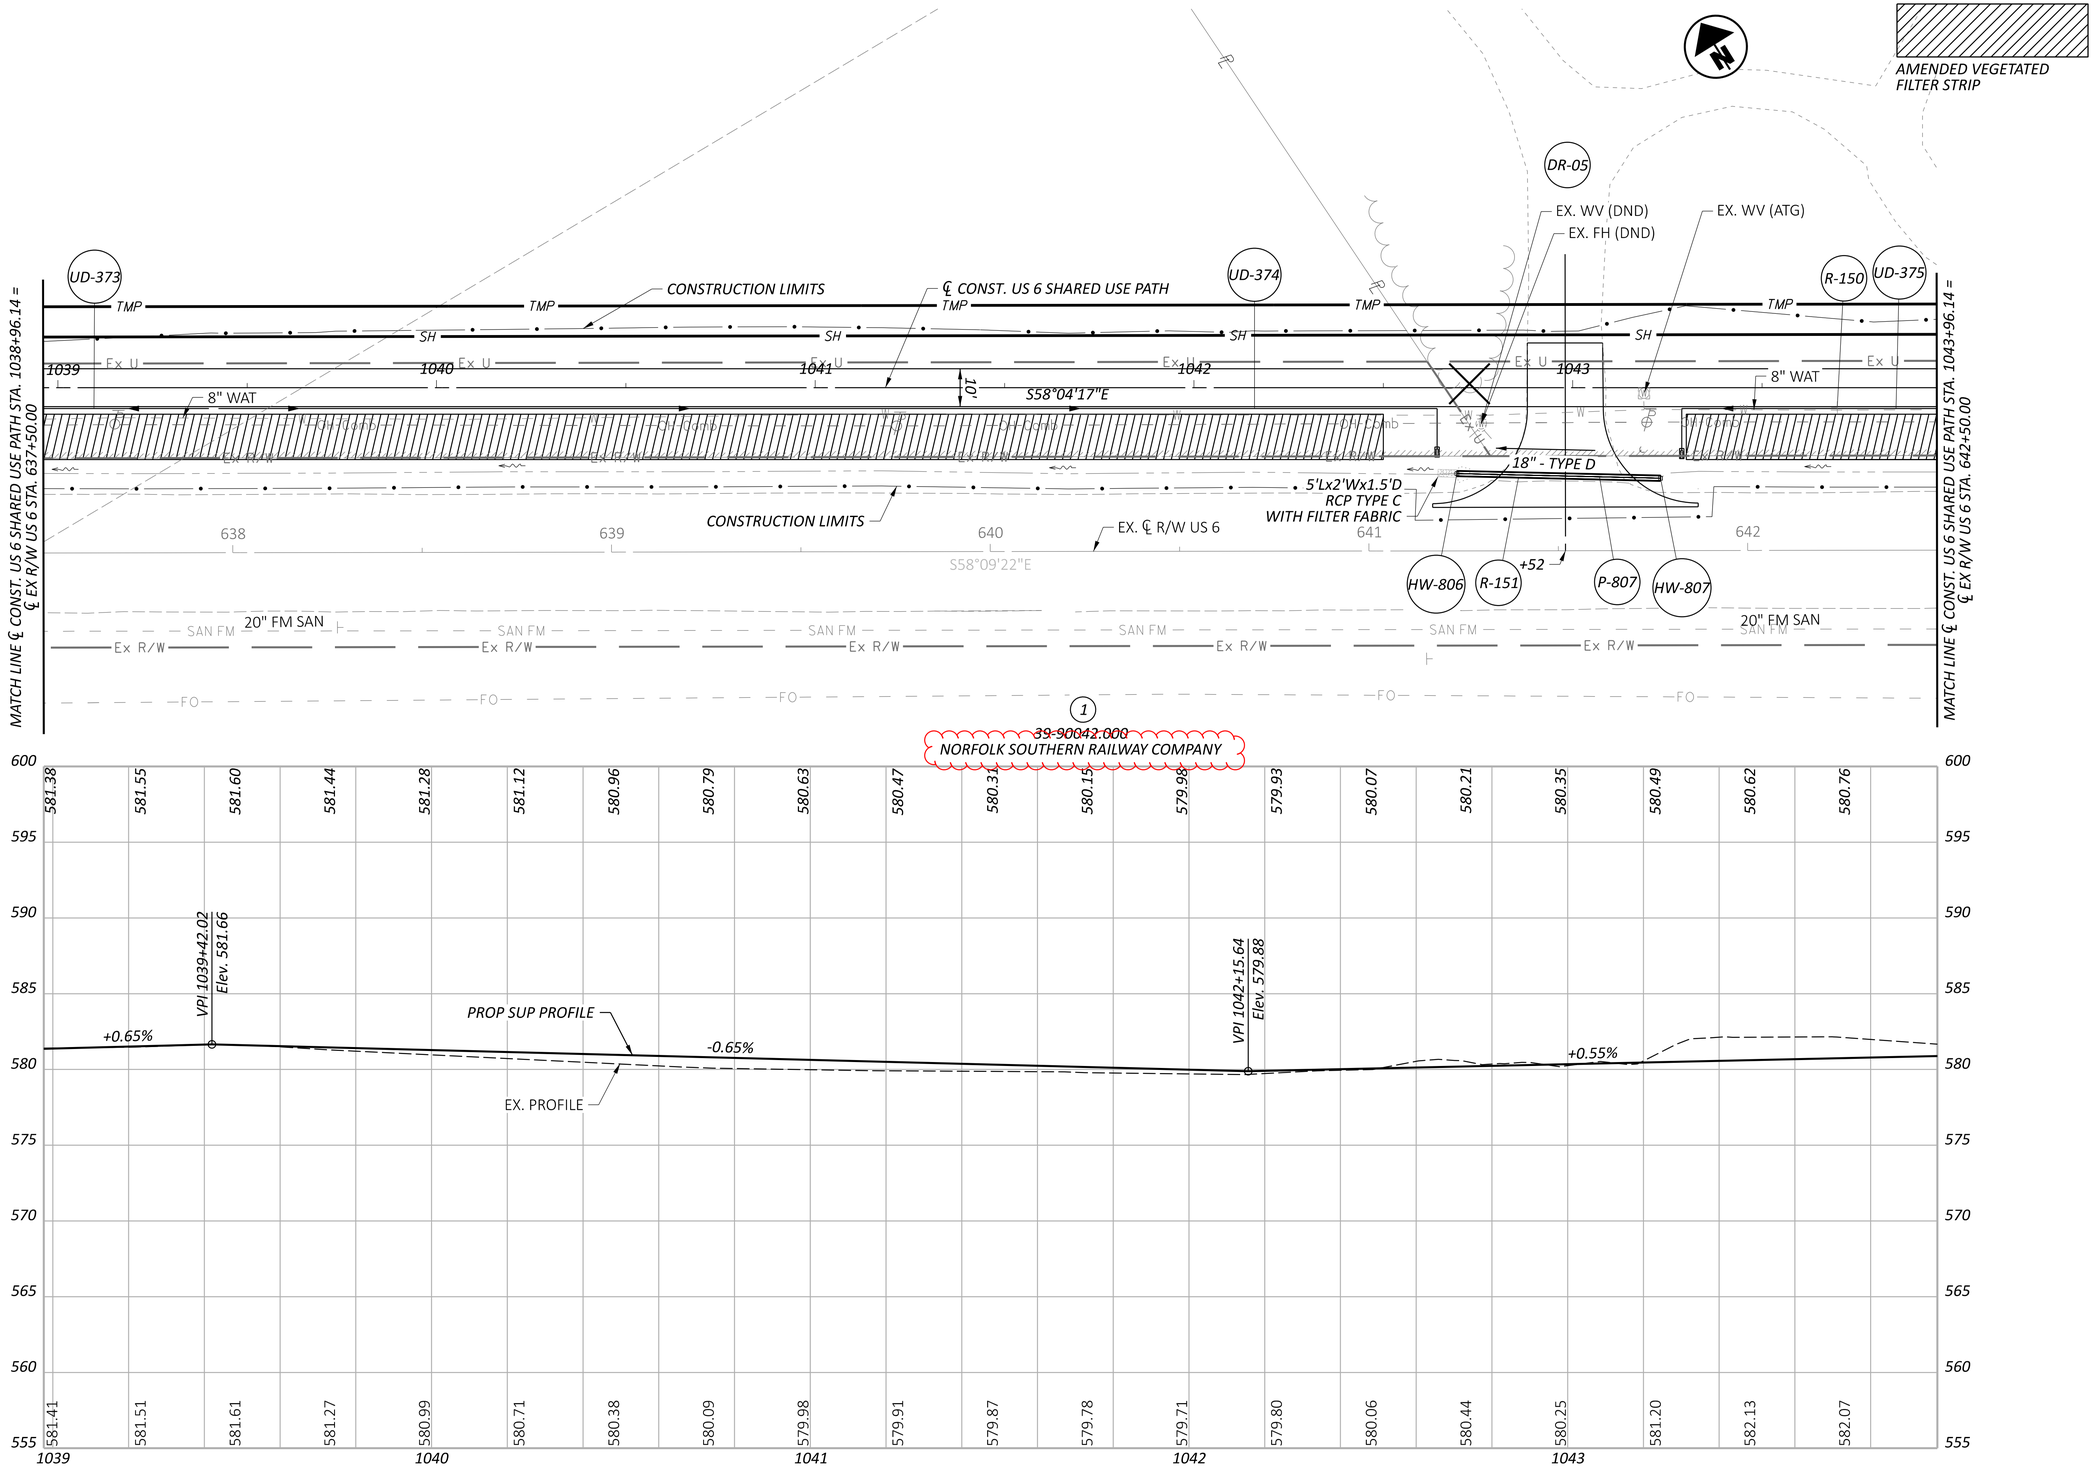

HORIZONTAL SCALE IN FEET
0 10 20 40


PLAN AND PROFILE - US 6 SUP
EX R/W STA. 637+50.00 TO STA. 642+50.00/US 6 SUP STA.1038+96.14 TO STA. 1043+96.14

DESIGN AGENCY
OHM

DESIGNER	SDH
REVIEWER	AHC 10/27/25
PROJECT ID	116570
SHEET	P.0383
TOTAL	1106

MODEL: CLP_SUP_1 - Plan 010 [Sheet] PAPERSIZE: 34x22 (in.) DATE: 2/26/2026 TIME: 10:11:43 AM PLTDRV: OHDOT_PDF_Levels.pltcfg PENTBL: OHDOT_Pen.tbl USER: Brennon.Cain@ohm-advisors.com WORKSPACE: OHDOTCEv02 WORKSET: 116570 PRODUCT: OpenRoadsDesigner 24.00.00.205
pw:\\ohiodot-pw.bentley.com:ohiodot-pw-02\Documents\01 Active Projects\District 03\Erie\116570\403-Engineering_OHMAdvisors\Roadway\Sheets\116570_GP101.dgn

ERI-US 0006-CONNECTIVITY CORRIDOR

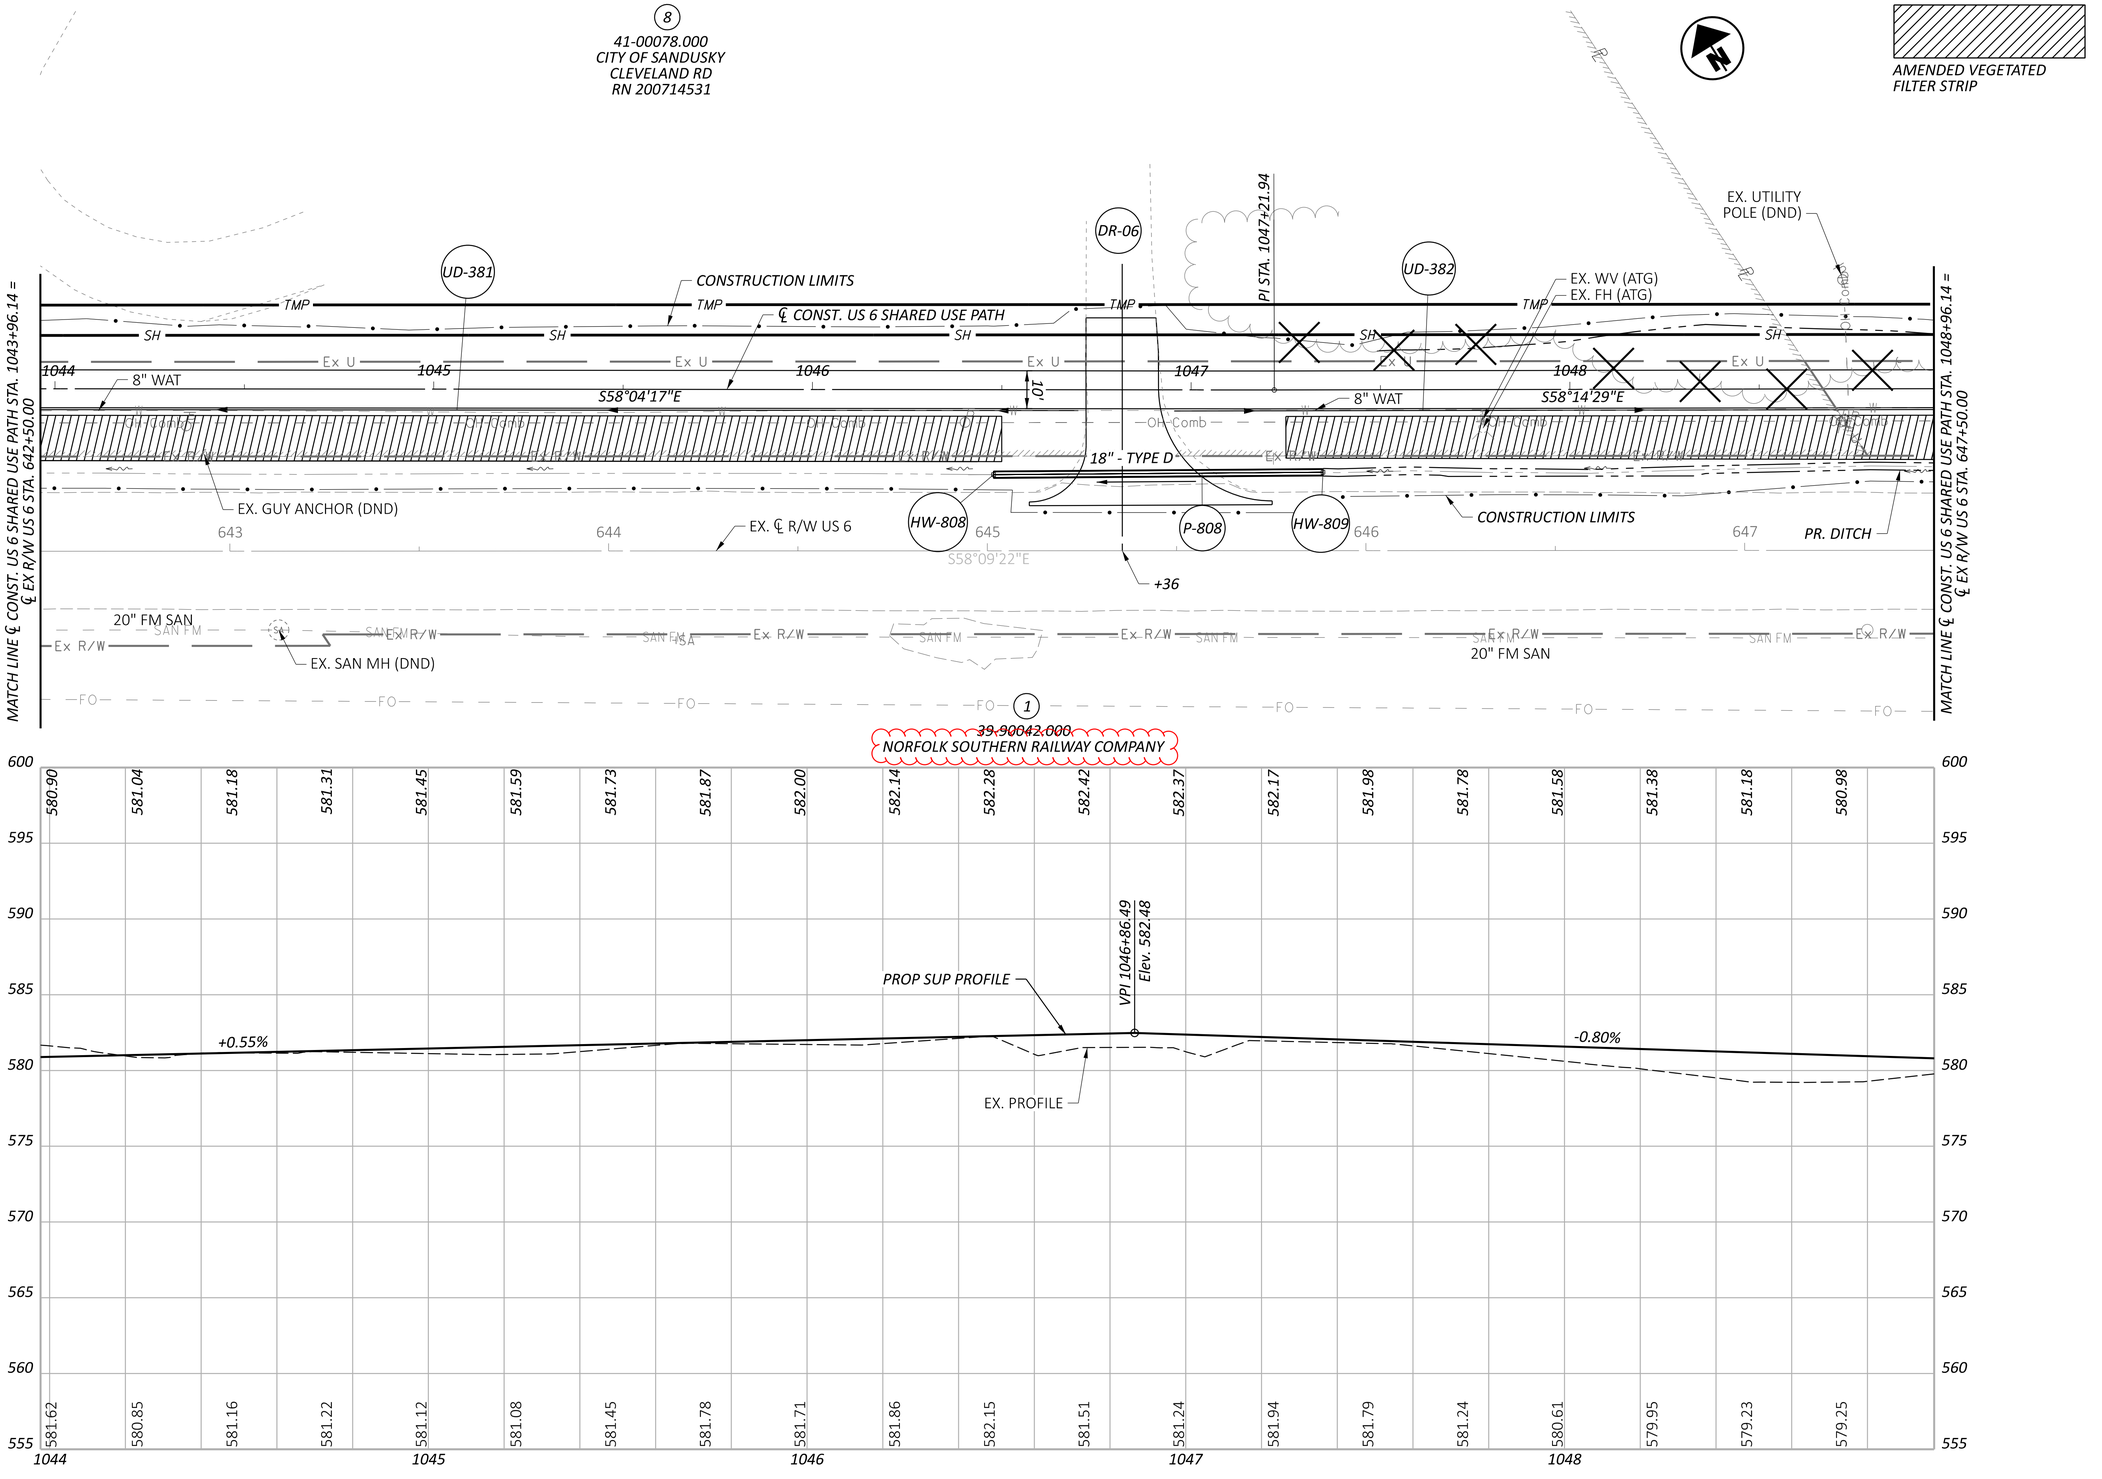

HORIZONTAL SCALE IN FEET
0 10 20 40

PLAN AND PROFILE - US 6 SUP
EX R/W STA. 642+50.00 TO STA. 647+50.00/US 6 SUP STA. 1043+96.14 TO STA. 1048+96.14

DESIGN AGENCY
OHM

DESIGNER SDH
REVIEWER AHC 10/27/25
PROJECT ID 116570
SHEET P.0384 TOTAL 1106

MODEL: CLP_SUP_1 - Plan 011 [Sheet] PAPERSIZE: 34x22 (in.) DATE: 2/26/2026 TIME: 10:11:45 AM PLTDRV: OHDOT_PDF_Levels.pltcfg PENTBL: OHDOT_Pen.tbl USER: Brennon.Cain@ohm-advisors.com WORKSPACE: OHDOTCEv02 WORKSET: 116570 PRODUCT: OpenRoadsDesigner 24.00.00.205
pw:\\ohiodot-pw.bentley.com:ohiodot-pw-02\Documents\01 Active Projects\District 03\Erie\116570\403-Engineering_OHMAdvisors\Roadway\Sheets\116570_GP101.dgn

ERI-US 0006-CONNECTIVITY CORRIDOR

9
41-00097.000
ERIE METROPARKS
3819 CLEVELAND RD
RN 200322579

9
41-00003.000
ERIE METROPARKS
3819 CLEVELAND RD
RN 200322579

AMENDED VEGETATED FILTER STRIP

HORIZONTAL SCALE IN FEET
0 10 20 40

EAGLE POINT SERVICE ROAD

EX. CULVERT (DND)

UD-388 UD-389 R-161 R-162 R-163 R-164 R-165 DR-07 HW-810 P-809

EX. WV (ATG) EX. FH (ATG) EX. WV (ATG)

CONSTRUCTION LIMITS CONSTRUCTION LIMITS

℄ CONST. US 6 SHARED USE PATH

TMP SH Ex U 8" WAT

1049 1050 1051 1052 1053

S58°14'29"E 10' S58°09'22"E

EX. ℄ R/W US 6

PR. DITCH

18" - TYPE D

SAWCUT +38.80

MATCH LINE ℄ CONST. US 6 SHARED USE PATH STA. 1048+96.14 = ℄ EX R/W US 6 STA. 647+50.00

MATCH LINE ℄ CONST. US 6 SHARED USE PATH STA. 1053+96.14 = ℄ EX R/W US 6 STA. 652+50.00

648 649 650 651 652

SAN FM Ex R/W

20" FM SAN 24" CMP 20" FM SAN

FO

1
39-90042.000
NORFOLK SOUTHERN RAILWAY COMPANY

600 595 590 585 580 575 570 565 560 555

580.78 580.58 580.64 580.77 580.90 581.03 581.19 581.18 581.01 580.84 580.75 580.98 581.22 581.46 581.70 581.94 582.18 582.42 582.66 582.90

579.84 580.47 580.05 579.57 578.21 578.77 581.20 579.46 579.23 579.72 580.38 580.51 580.81 581.10 581.30 581.59 581.98 582.30 582.52 582.72

1049 1050 1051 1052 1053

VPI 1049+30.74 Elev. 580.54
VPI 1050+47.46 Elev. 581.15
VPI 1050+57.35 Elev. 581.30
VPI 1051+45.26 Elev. 580.70


-0.80% +0.53% +1.45% -0.68% +0.96%

PROP SUP PROFILE
EX. PROFILE

PLAN AND PROFILE - US 6 SUP
EX R/W STA. 647+50.00 TO STA. 652+50.00/US 6 SUP STA. 1048+96.14 TO STA. 1053+96.14

DESIGN AGENCY
OHM

DESIGNER SDH
REVIEWER AHC 10/27/25
PROJECT ID 116570
SHEET P.0385 TOTAL 1106

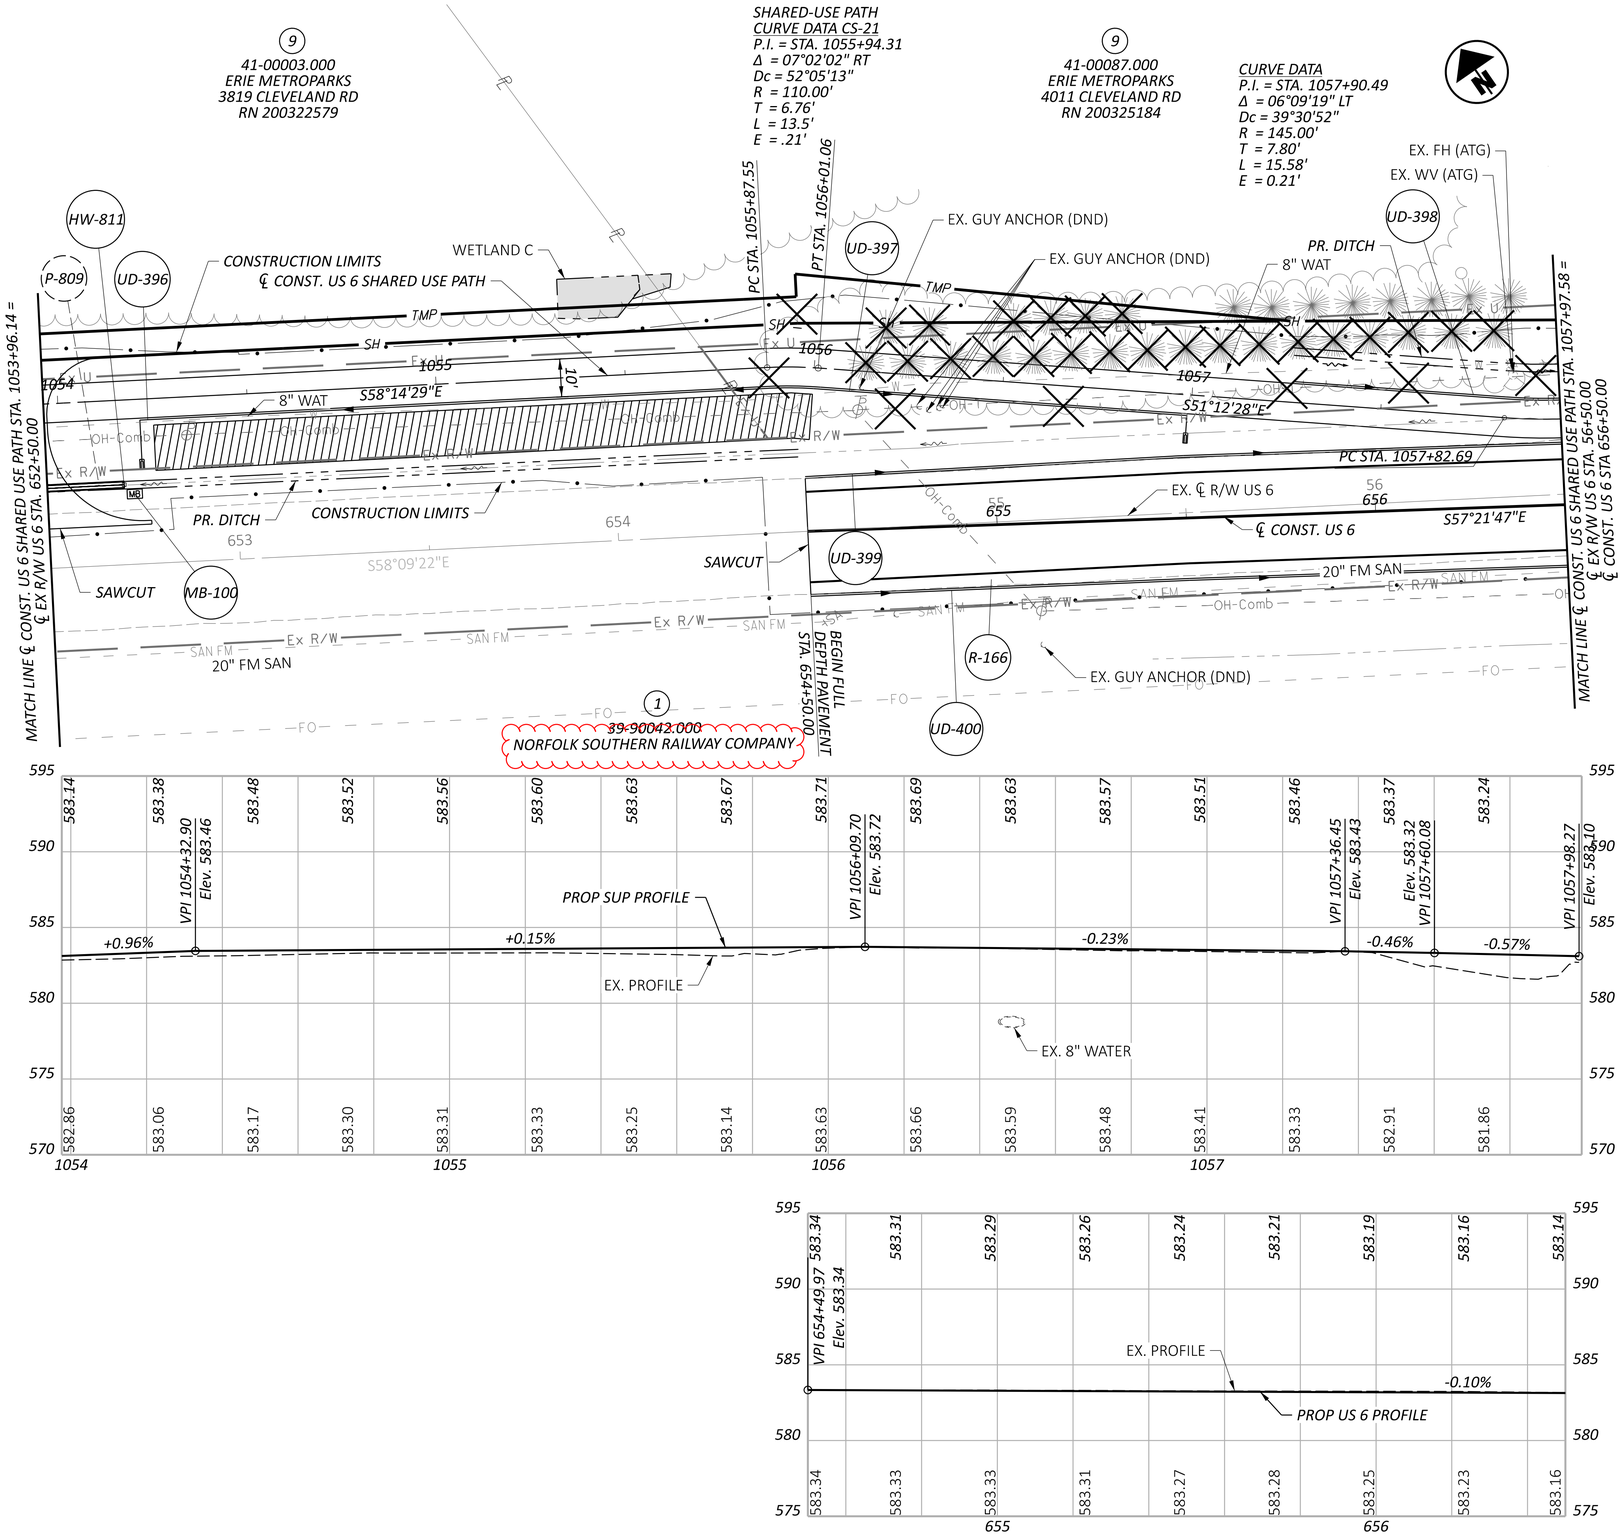

PLAN AND PROFILE - US 6 SUP

EX R/W STA. 652+50.00 TO STA. 656+50.00/US 6 SUP STA. 1053+96.14 TO STA. 1057+97.50

ERI-US 0006-CONNECTIVITY CORRIDOR

DESIGN AGENCY


OHM

DESIGNER	SDH
REVIEWER	AHC 10/27/25
PROJECT ID	116570
SHEET	P.0386
TOTAL	1106

MODEL: CLP_SUP_1 - Plan 012 [Sheet] PAPERSIZE: 34x22 (in.) DATE: 2/26/2026 TIME: 10:11:46 AM PLTDRV: OHDOT_PDF_Levels.pltcfg PENTBL: OHDOT_Pen.tbl USER: Brennon.Cain@ohm-advisors.com WORKSPACE: OHDOTCEv02 WORKSET: 116570 PRODUCT: OpenRoadsDesigner 24.00.00.205
pw:\\ohiodot-pw.bentley.com:ohiodot-pw-02\Documents\01 Active Projects\District 03\Erie\116570\403-Engineering_OHMAdvisors\Roadway\Sheets\116570_GP101.dgn

ERI-US 0006-CONNECTIVITY CORRIDOR

MODEL: CLP_U006_PERKINS - Plan 1 [Sheet] PAPERSIZE: 34x22 (in.) DATE: 2/26/2026 TIME: 10:11:54 AM PLTDRV: OHDOT_PDF_Levels.pltcfg PENTBL: OHDOT_Pen.tbl USER: Brennon.Cain@ohm-advisors.com WORKSPACE: OHDOTCEv02 WORKSET: 116570 PRODUCT: OpenRoadsDesigner 24.00.00.205
pw:\\ohiodot-pw.bentley.com:ohiodot-pw-02\Documents\01 Active Projects\District 03\Erie\116570\403-Engineering_OHMAdvisors\Roadway\Sheets\116570_GP201.dgn

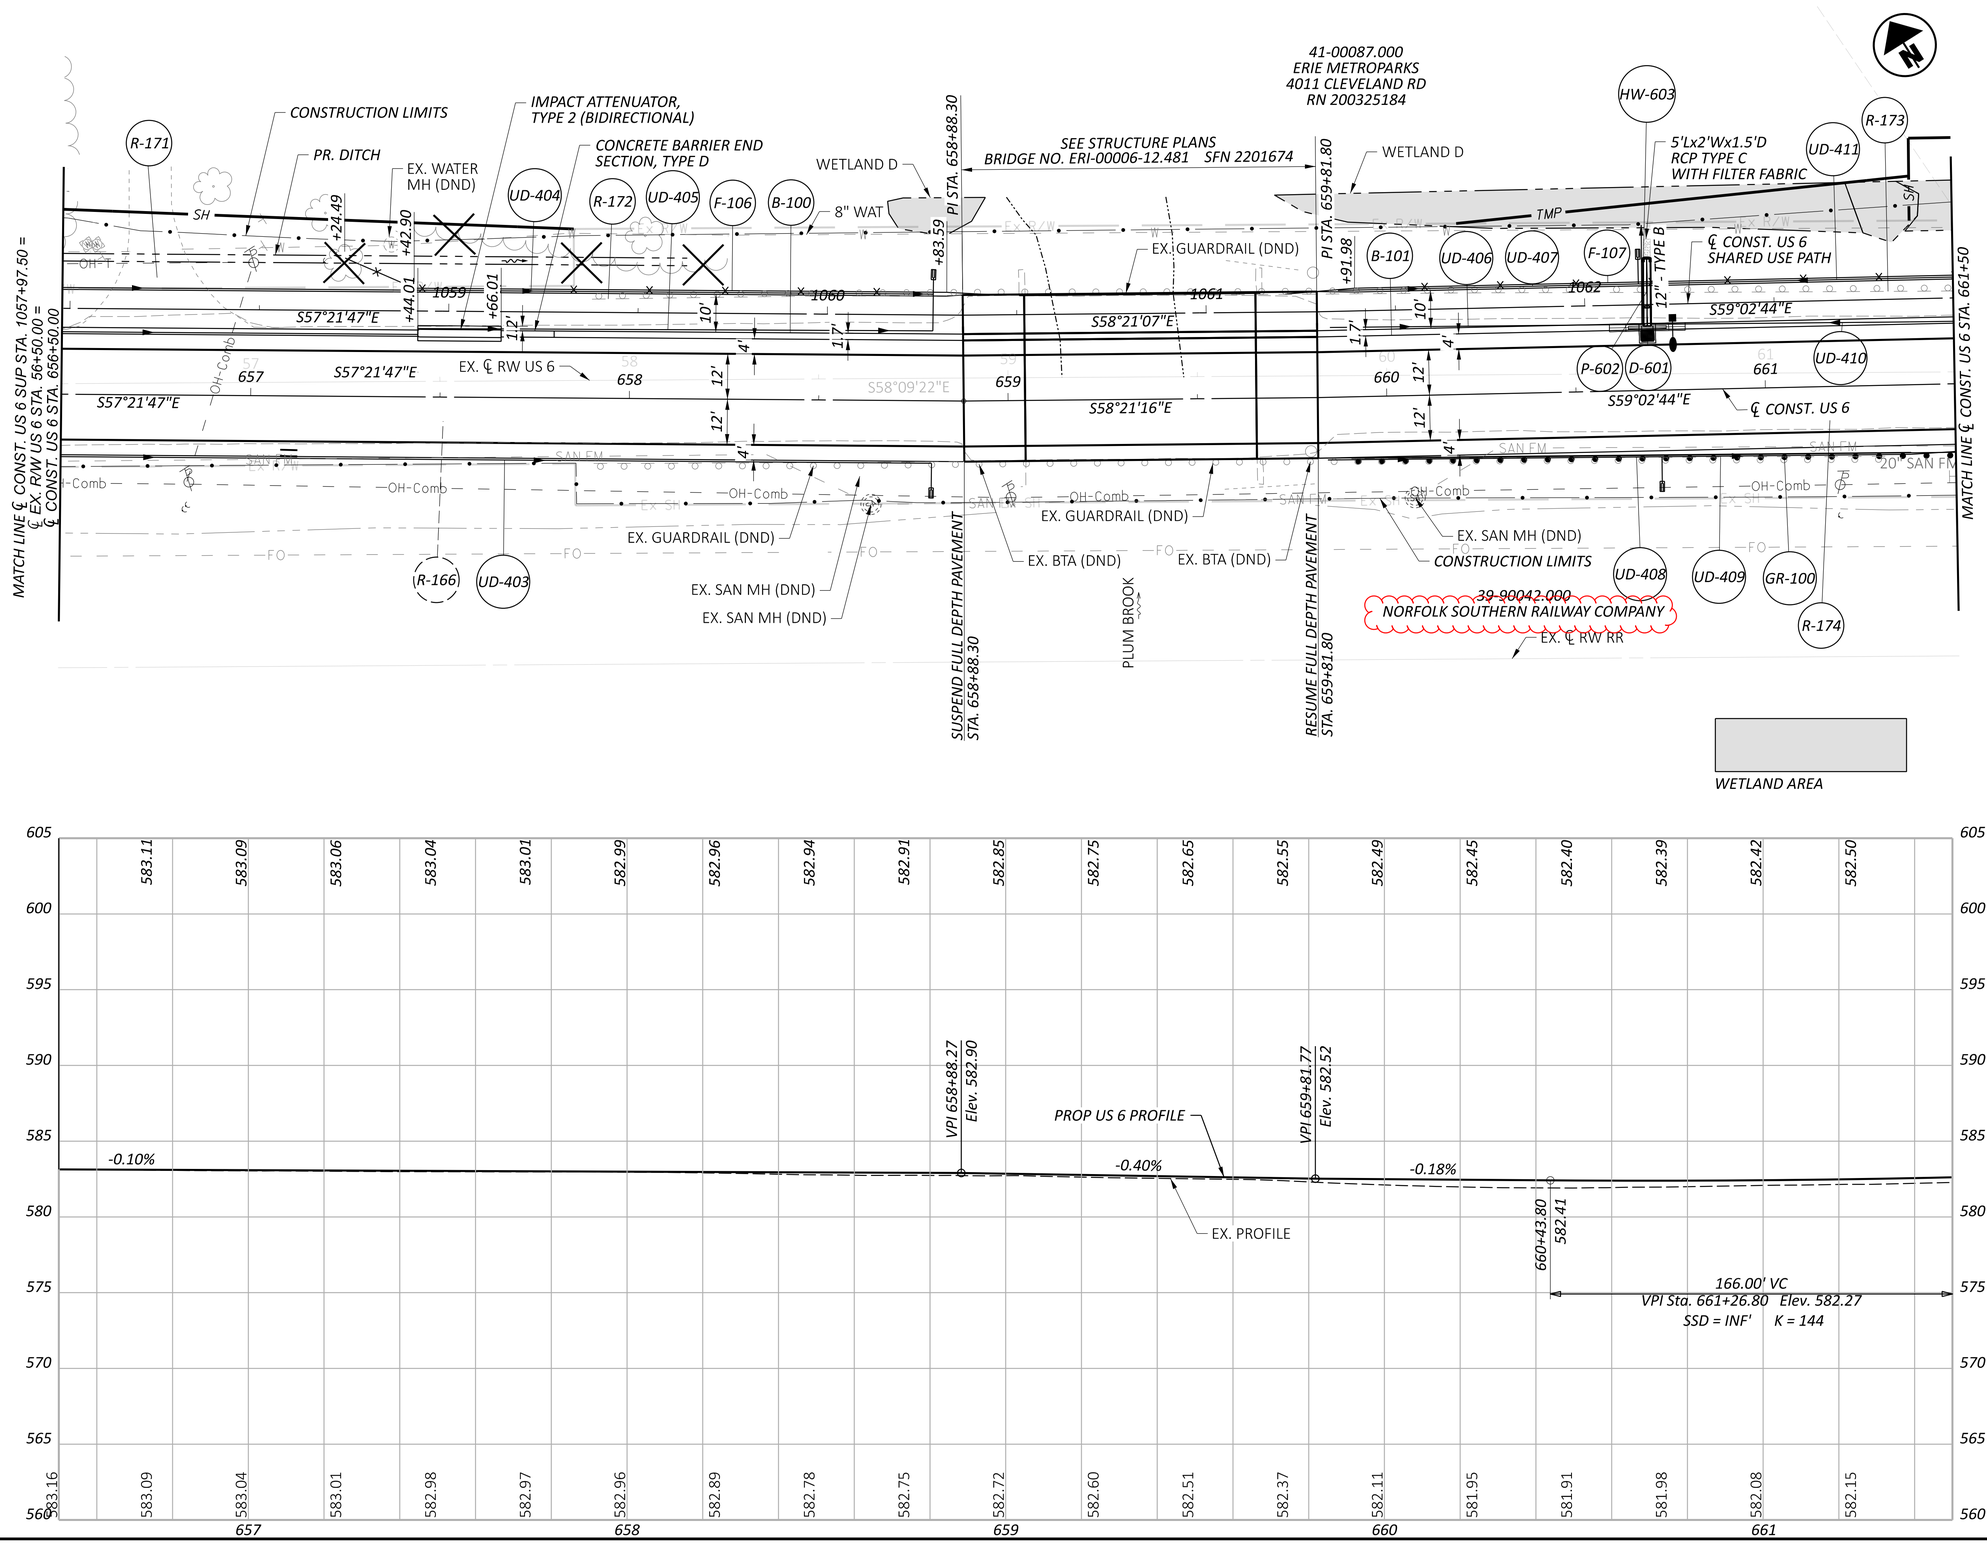

HORIZONTAL SCALE IN FEET
0 10 20 40

PLAN AND PROFILE - US 6
STA. 656+50.00 TO STA. 661+50.00

DESIGN AGENCY
OHM

DESIGNER	KAH
REVIEWER	SEO 10/27/25
PROJECT ID	116570
SHEET	P.0387
TOTAL	1106

MODEL: CLP_U006_PERKINS - Plan 2 [Sheet] PAPERSIZE: 34x22 (in.) DATE: 2/26/2026 TIME: 10:11:58 AM PLTDRV: OHDOT_PDF_Levels.pltclp PENTBL: OHDOT_Pen.tbl USER: Brennon.Cain@ohm-advisors.com WORKSPACE: OHDOTCEv02 WORKSET: 116570 PRODUCT: OpenRoadsDesigner 24.00.00.205
pw:\\ohiodot-pw.bentley.com:ohiodot-pw-02\Documents\01 Active Projects\District 03\Erie\116570\403-Engineering_OHMAdvisors\Roadway\Sheets\116570_GP201.dgn

ERI-US 0006-CONNECTIVITY CORRIDOR

SHARED-USE PATH
CURVE DATA CS-23
P.I. = STA. 1063+10.17
Δ = 00°28'07" LT
Dc = 03°48'22"
R = 1,505.33'
T = 6.16'
L = 12.31'
E = 0.01'

SHARED-USE PATH
CURVE DATA CS-24
P.I. = STA. 1063+43.10
Δ = 10°02'03" LT
Dc = 18°47'08"
R = 305.00'
T = 26.78'
L = 53.41'
E = 1.17'


SHARED-USE PATH
CURVE DATA CS-25
P.I. = STA. 1069+07.64
Δ = 24°17'04" LT
Dc = 03°51'11"
R = 1,487.00'
T = 319.93'
L = 630.26'
E = 34.03'

US-6
CURVE DATA CM-1
P.I. = STA. 666+40.52
Δ = 35°07'56" LT
Dc = 03°44'59"
R = 1,528.00'
T = 483.72'
L = 936.93'
E = 74.74'

41-60146.000
ERIE METROPARKS
PERKINS RD
RN 200404359

STA. 1065+87.86 BK =
STA. 1065+87.70 AH

PC STA. 1063+16.32
PC STA. 1059+55.80
PT STA. 1063+69.74
8" WAT
WETLAND D
F-111
R-181
B-106
R-182
+34.60
+52.98
IMPACT ATTENUATOR,
TYPE 2 (BIDIRECTIONAL)
UD-417
UD-418
PR. DITCH
CONSTRUCTION LIMITS
℄ CONST. US 6 SHARED USE PATH
UD-420
UD-421
TMP
S59°02'44"E
S69°32'55"E
1063
1064
1065
1066
1067
10'
20'
4'
12'
12'
4'
662
663
664
665
666
+50.00
+72.00
CONCRETE BARRIER END
SECTION, TYPE D
℄ CONST. US 6
MATCH LINE ℄ CONST. US 6 STA. 661+50
MATCH LINE ℄ CONST. US 6 STA. 666+50
S58°09'22"E
ERIE COUNTY, GL "D"
+25.00
MGS TYPE E AA
MGS TYPE E
ANCHOR ASSEMBLY
GR-106
UD-419
UD-422
PR. DITCH
EX. ℄ RW US 6
R-174
39-90042.000
NORFOLK SOUTHERN RAILWAY COMPANY
20" FM SAN
CONSTRUCTION LIMITS
MATCH LINE ℄ R/W US 6 STA. 66+00
SEE SHEET P.0461
EX. ℄ RW RR
WETLAND AREA
ITEM 202 - PAVEMENT REMOVED
AMENDED VEGETATED FILTER STRIP
ITEM 202 - PAVEMENT REMOVED
ITEM 690 - GRASS PAVERS

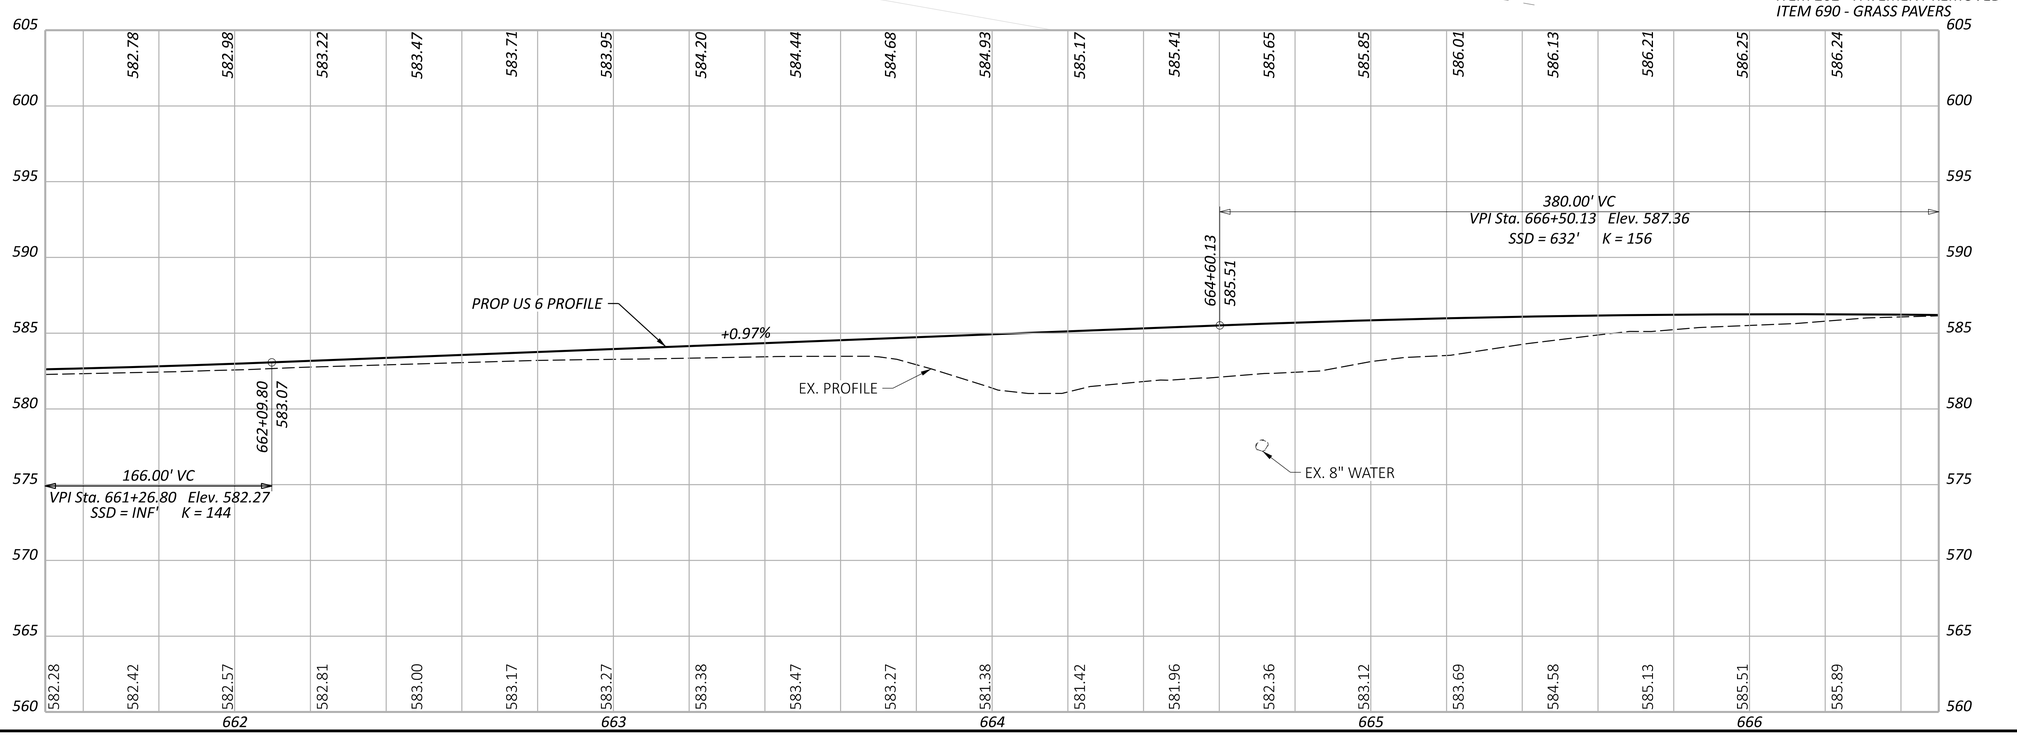


HORIZONTAL
SCALE IN FEET
0 10 20 40

PLAN AND PROFILE - US 6
STA. 661+50.00 TO STA. 666+50.00

DESIGN AGENCY
OHM

DESIGNER	KAH
REVIEWER	SEO 10/27/25
PROJECT ID	116570
SHEET	P.0388
TOTAL	1106

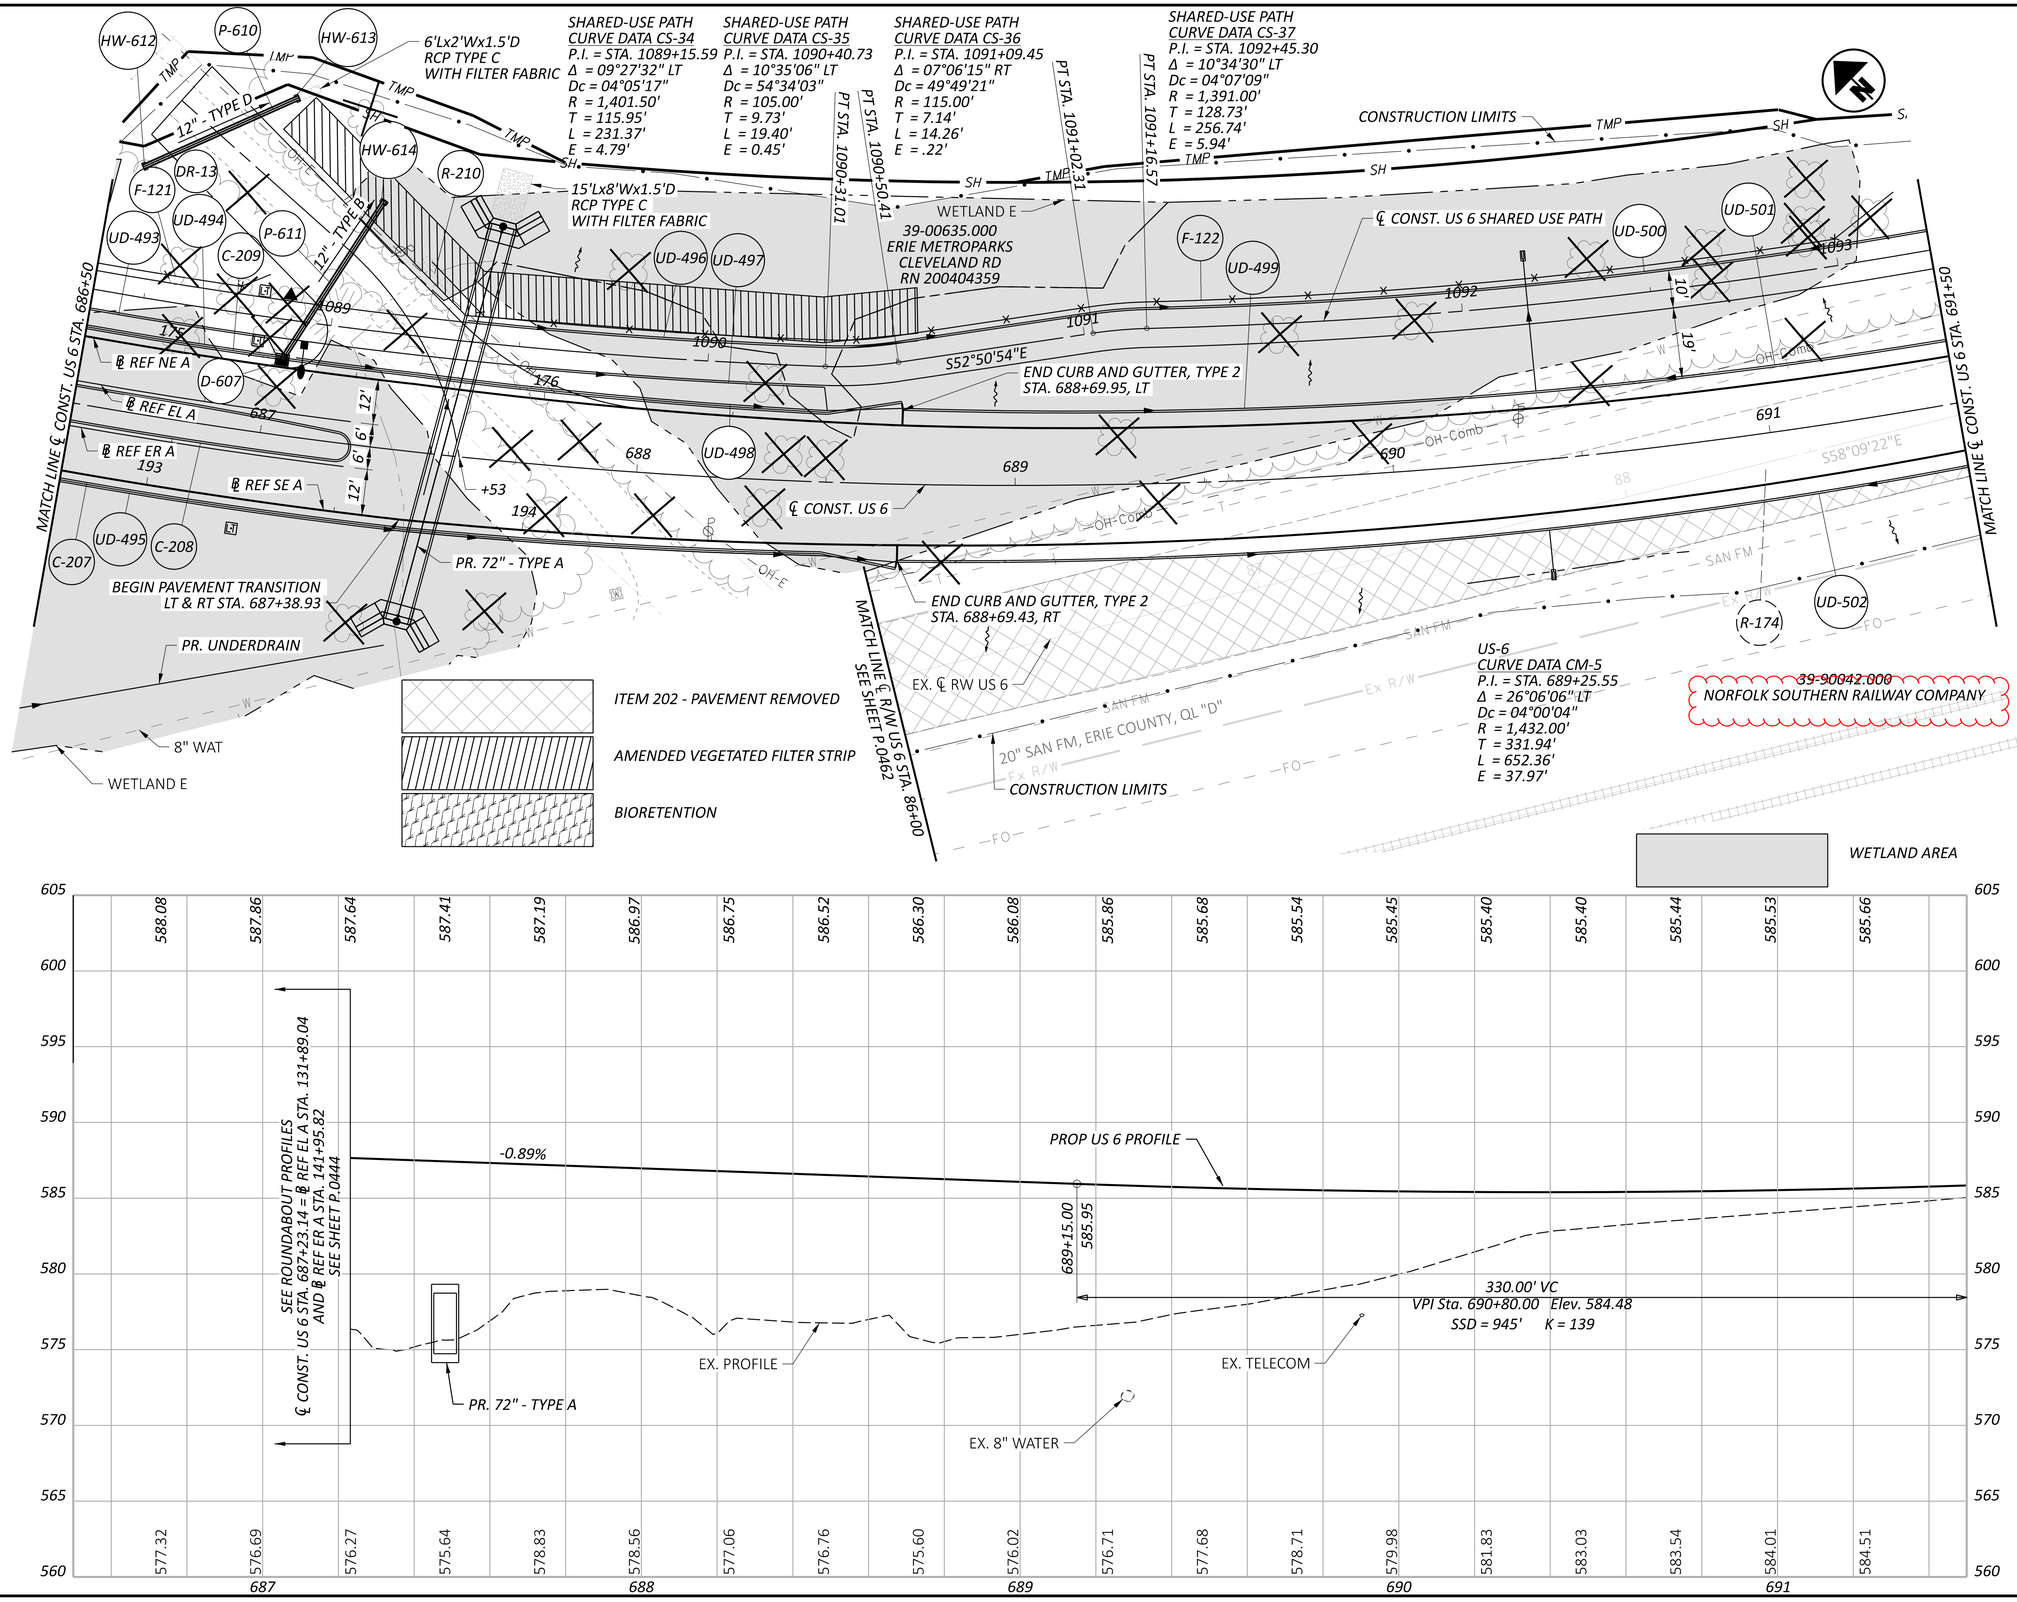

PLAN AND PROFILE - US 6
STA. 686+50.00 TO STA. 691+50.00

DESIGN AGENCY
OHM


DESIGNER	KAH
REVIEWER	SEO 10/27/25
PROJECT ID	116570
SHEET	P.0393
TOTAL	1106

ERI-US 0006-CONNECTIVITY CORRIDOR

MODEL: CLP_U006_PERKINS - Plan 7 [Sheet] PAPERSIZE: 34x22 (in.) DATE: 2/26/2026 TIME: 10:12:06 AM PLTDRV: OHDOT_PDF_Levels.pltcfg PENTBL: OHDOT_Pen.tbl USER: Brennon.Cain@ohm-advisors.com WORKSPACE: OHDOTCEv02 WORKSET: 116570 PRODUCT: OpenRoadsDesigner 24.00.00.205
pw:\\ohiodot-pw.bentley.com:ohiodot-pw-02\Documents\01 Active Projects\District 03\Erie\116570\403-Engineering_OHMAdvisors\Roadway\Sheets\116570_GP201.dgn

MODEL: CLP_U006_PERKINS - Plan & [Sheet] PAPERSIZE: 34x22 (in.) DATE: 2/26/2026 TIME: 10:27:07 AM PLTDRV: OHDOT_PDF_Levels.pltcfg PENTBL: OHDOT_Pen.tbl USER: Brennon.Cain@ohm-advisors.com WORKSPACE: OHDOTCEv02 WORKSET: 116570 PRODUCT: OpenRoadsDesigner 24.00.00.205
pw:\\ohiodot-pw.bentley.com:ohiodot-pw-02\Documents\01 Active Projects\District 03\Erie\116570\403-Engineering_OHMAdvisors\Roadway\Sheets\116570_GP201.dgn

ERI-US 0006-CONNECTIVITY CORRIDOR

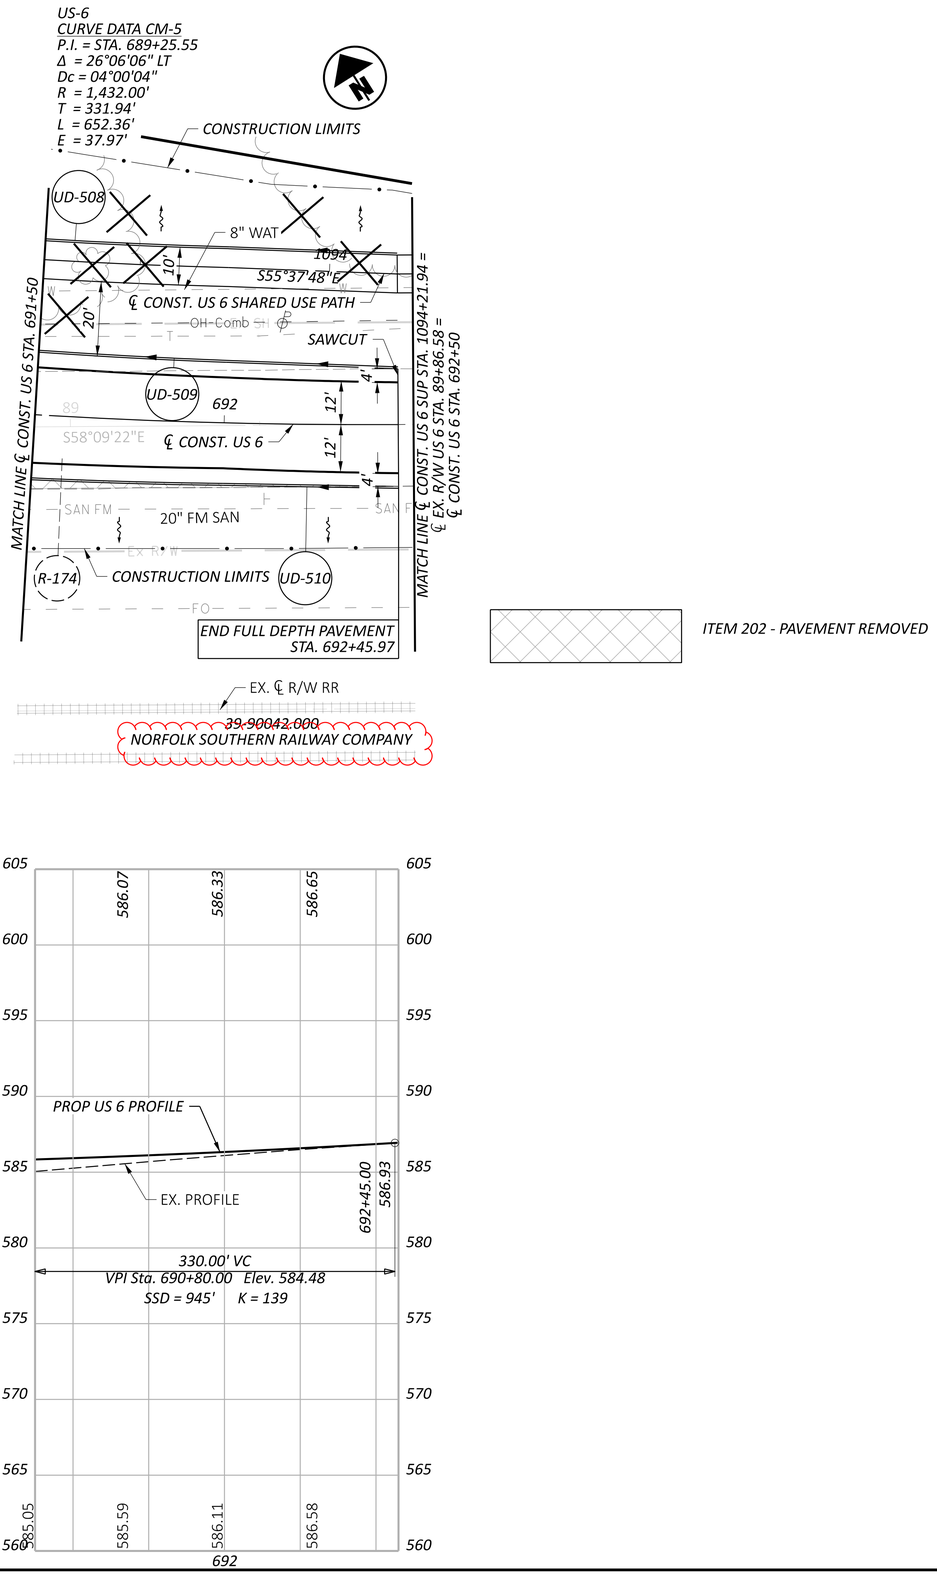


ITEM 202 - PAVEMENT REMOVED

HORIZONTAL SCALE IN FEET
0 10 20 40

PLAN AND PROFILE - US 6
STA. 691+50.00 TO STA. 692+50.00

DESIGN AGENCY
OHM

DESIGNER	KAH
REVIEWER	SEO 10/27/25
PROJECT ID	116570
SHEET	P.0394
TOTAL	1106

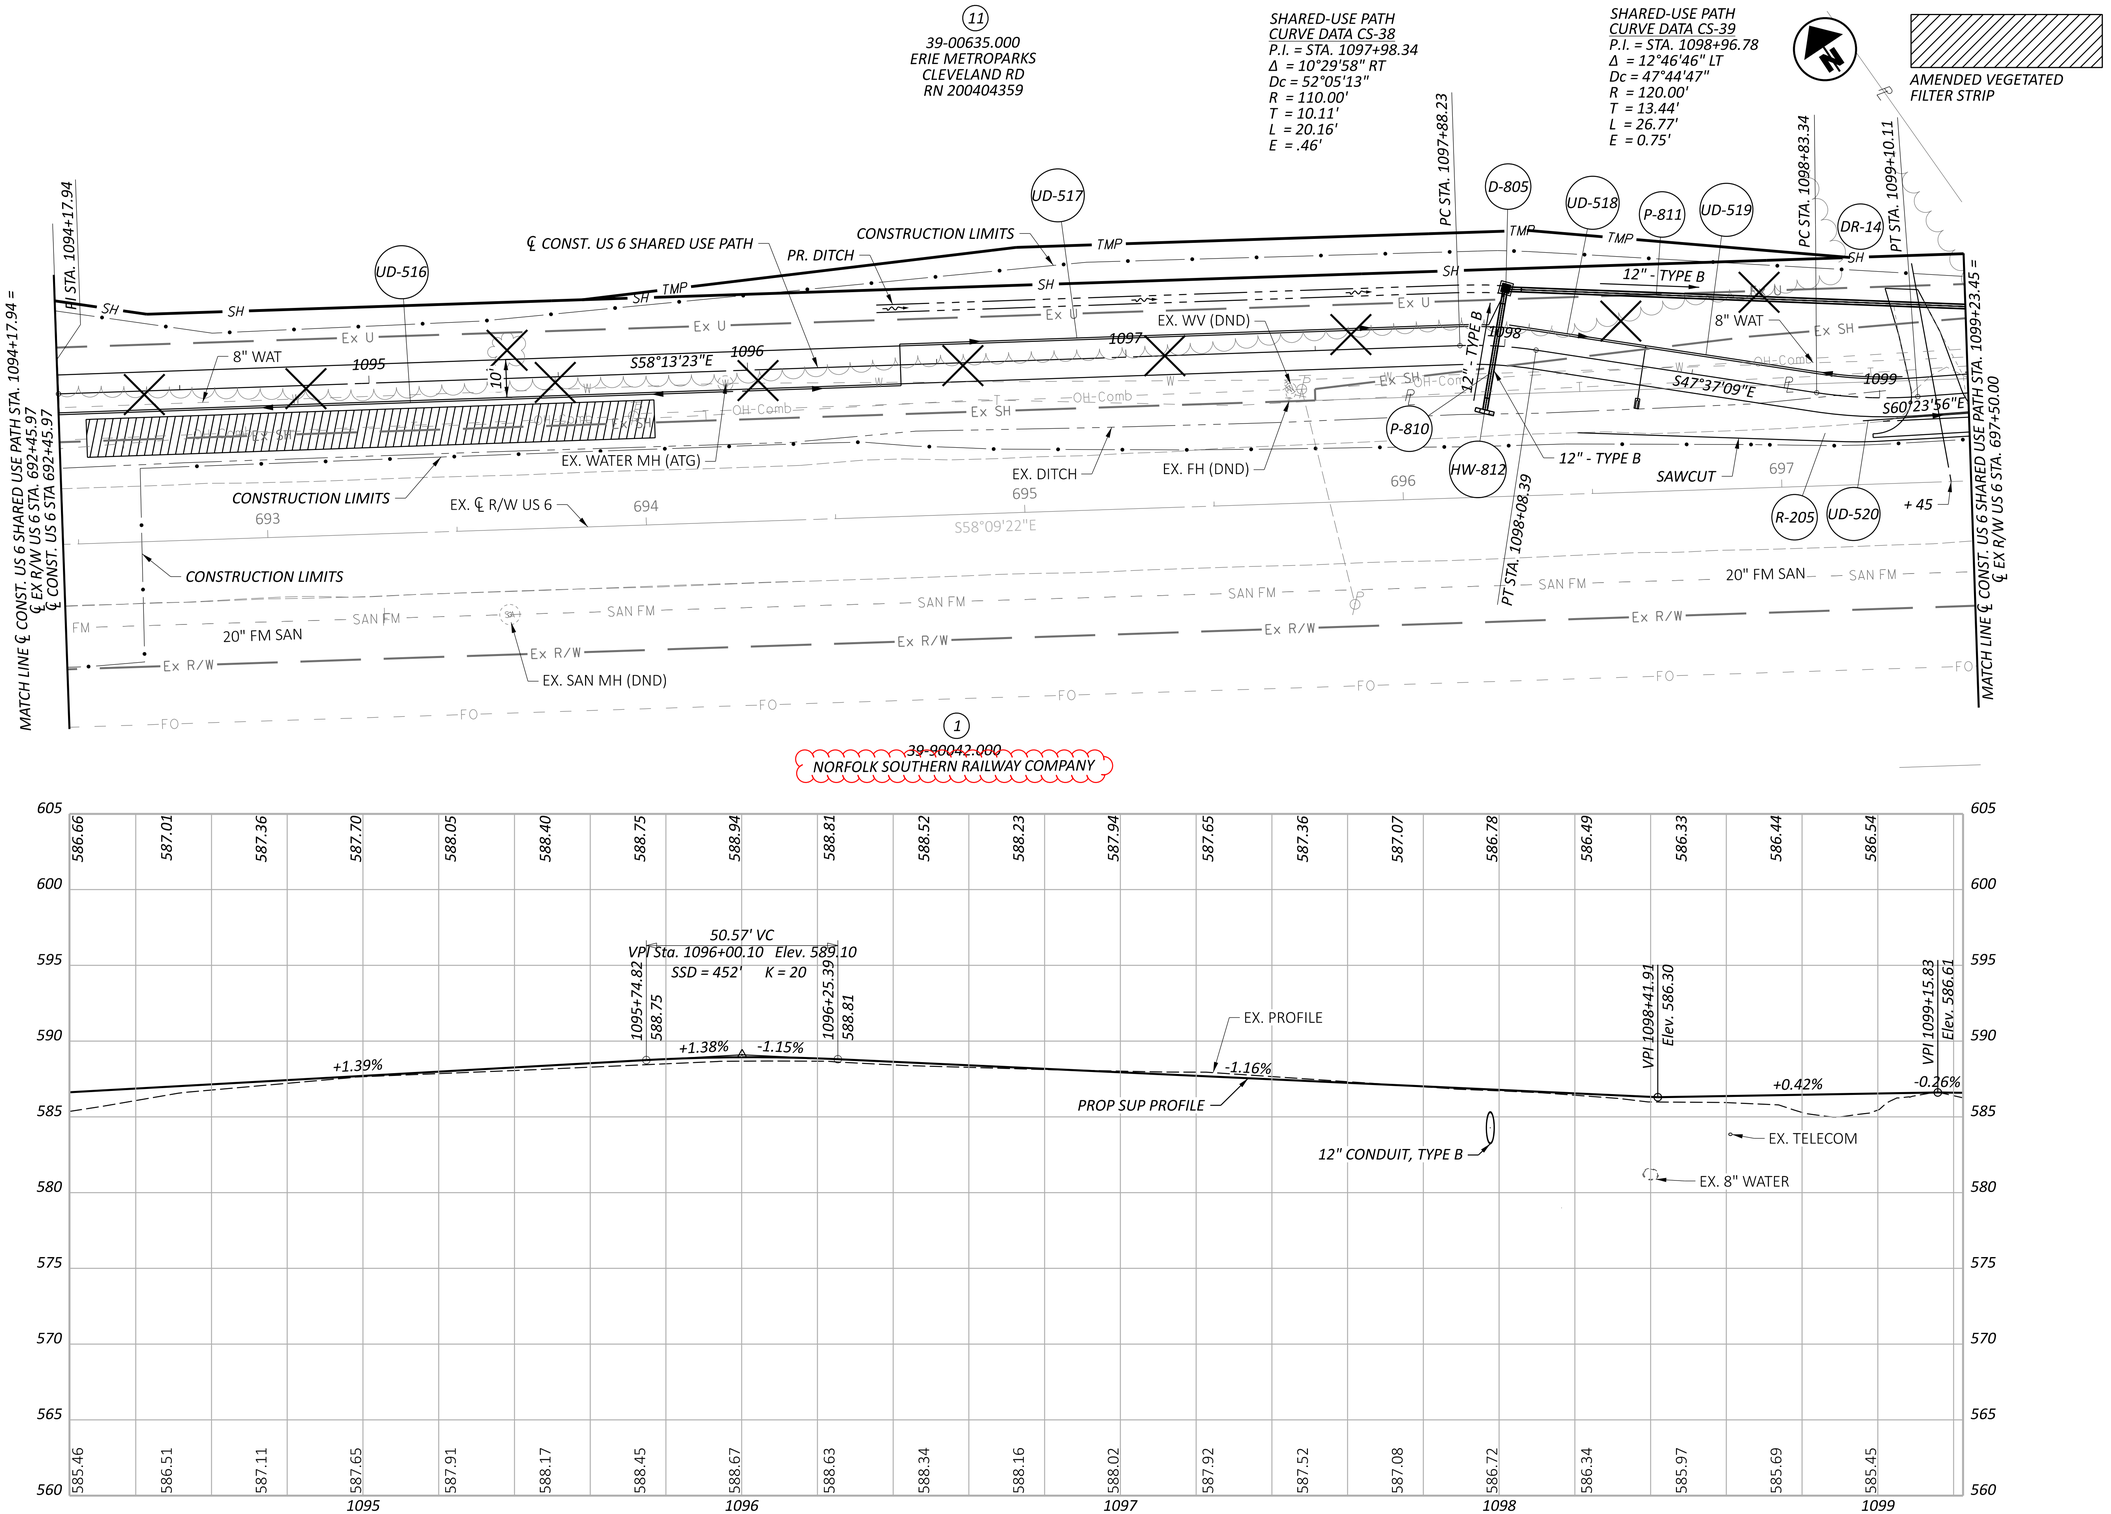

ERI-US 0006-CONNECTIVITY CORRIDOR

PLAN AND PROFILE - US 6 SUP

EX R/W STA. 692+45.97 TO STA. 697+50.00/US 6 SUP STA. 1094+17.97 TO STA. 1099+23.45

DESIGN AGENCY

OHM

DESIGNER	BLC
REVIEWER	SEO 10/27/25
PROJECT ID	116570
SHEET	P.0395
TOTAL	1106

MODEL: CLP_SUP 2 - Plan 13 [Sheet] PAPERSIZE: 34x22 (in.) DATE: 2/26/2026 TIME: 10:12:17 AM PLTDRV: OHDOT_PDF_Levels.pltcfg PENTBL: OHDOT_Pen.tbl USER: Brennon.Cain@ohm-advisors.com WORKSPACE: OHDOTCEv02 WORKSET: 116570 PRODUCT: OpenRoadsDesigner 24.00.00.205
pw:\\ohiodot-pw.bentley.com:ohiodot-pw-02\Documents\01 Active Projects\District 03\Erie\116570\403-Engineering_OHMAdvisors\Roadway\Sheets\116570_GP102.dgn

MODEL: CLP_SUP 2 - Plan 14 [Sheet] PAPERSIZE: 34x22 (in.) DATE: 2/26/2026 TIME: 10:12:19 AM PLTDRV: OHDOT_PDF_Levels.pltcfg PENTBL: OHDOT_Pen.tbl USER: Brennon.Cain@ohm-advisors.com WORKSPACE: OHDOTCEv02 WORKSET: 116570 PRODUCT: OpenRoadsDesigner 24.00.00.205
pw:\\ohiodot-pw.bentley.com:ohiodot-pw-02\Documents\01 Active Projects\District 03\Erie\116570\403-Engineering_OHMAdvisors\Roadway\Sheets\116570_GP102.dgn

ERI-US 0006-CONNECTIVITY CORRIDOR

11
39-60533.000
ERIE METROPARKS
CLEVELAND RD
RN 200322577

UNT 1
TO DILDINE DITCH

WETLAND I

CONSTRUCTION LIMITS

PR. 60" - TYPE A

HW-813 UD-527 D-1 D-7 UD-528 UD-529 R-226 UD-530

PI STA. 1103+02.39

℄ CONST. US 6 SHARED USE PATH

PR. FH
PR. WV

12" - TYPE B

8" WAT

Ex SH

SH

OH-Comb

1100 1101 1102 1103 1104

S60°23'56"E

S58°50'23"E

8" WAT

10'

4'

D-8

R-225

UD-526

R-205

698 699 700 701 702

S58°09'22"E

EX. FH (TBR)
EX. WV (TBR)
PR. WATER

SAWCUT

CONSTRUCTION LIMITS

EX. ℄ R/W US 6

MATCH LINE ℄ CONST. US 6 SHARED USE PATH STA. 1099+23.45 = ℄ EX R/W US 6 STA. 697+50.00

MATCH LINE ℄ CONST. US 6 SHARED USE PATH STA. 1104+23.28 = ℄ EX R/W US 6 STA. 702+50.00

EX. GUARDRAIL (DND)

60" CMP (DND)

EX. CB (DND)

12" PVC

12" HDPE

12" HDPE AN FM, ERIE COUNTY, QL "D"

EX. STM MH (DND)

20" FM SAN

SAN FM

Ex R/W


FO

1
39-90042.000
NORFOLK SOUTHERN RAILWAY COMPANY

BIORETENTION

HORIZONTAL SCALE IN FEET
0 10 20 40

PLAN AND PROFILE - US 6 SUP
EX R/W STA. 697+50.00 TO STA. 702+50.00/US 6 SUP STA. 1099+23.45 TO STA. 1104+23.28

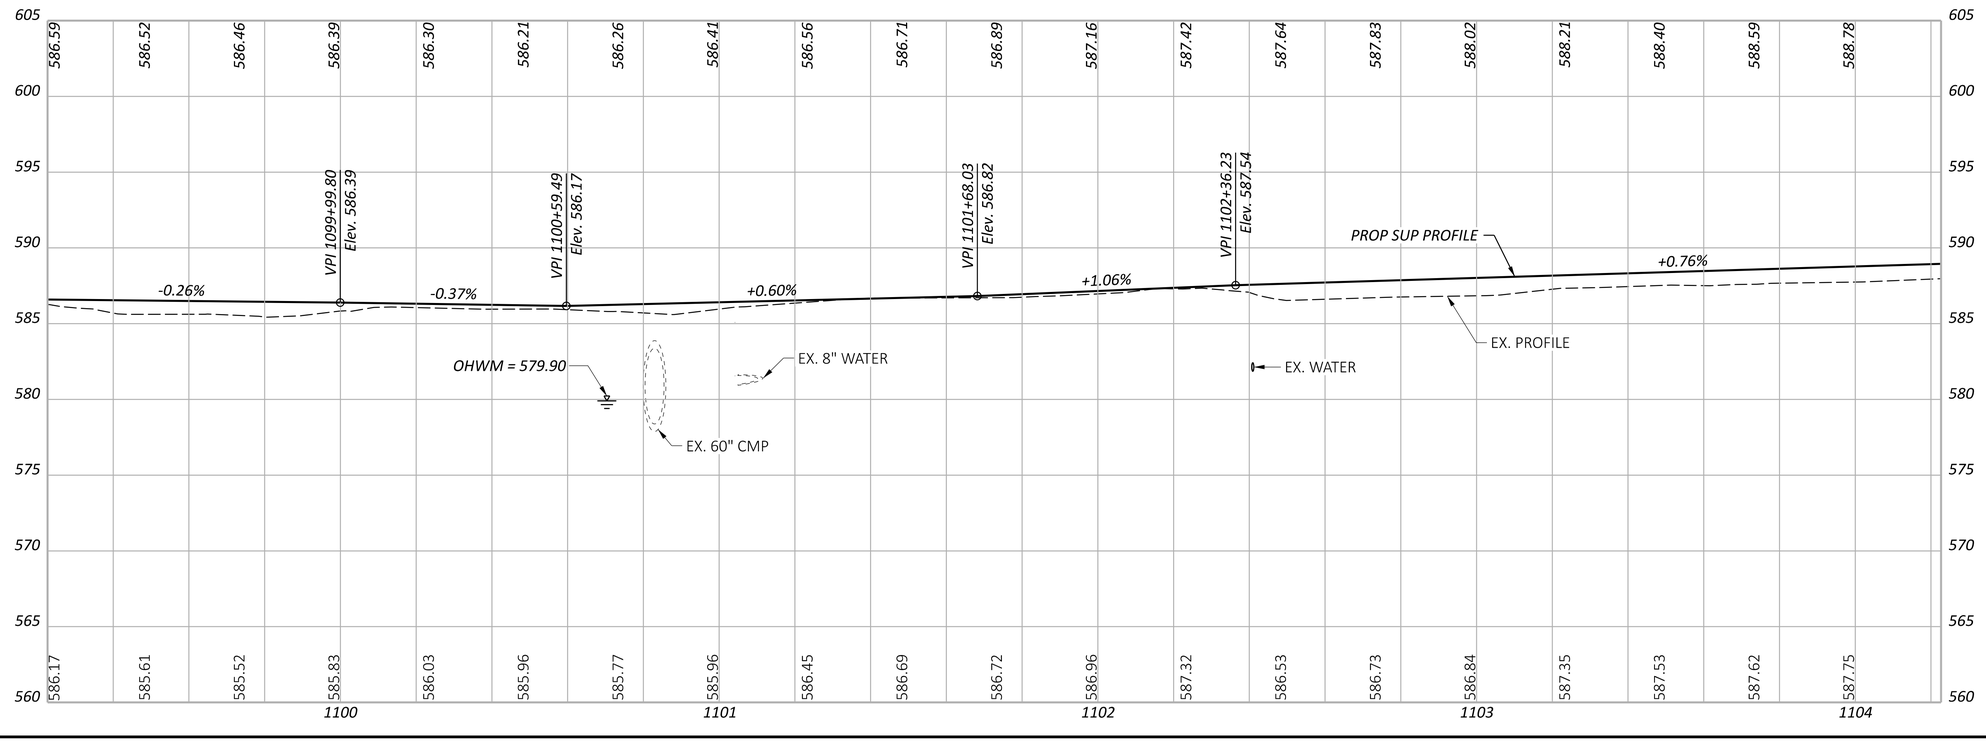


DESIGN AGENCY
OHM

DESIGNER BLC
REVIEWER SEO 10/27/25
PROJECT ID 116570
SHEET P.0396 TOTAL 1106

MODEL: CLP_SUP 2 - Plan 15 [Sheet] PAPERSIZE: 34x22 (in.) DATE: 2/26/2026 TIME: 10:12:21 AM PLTDRV: OHDOT_PDF_Levels.pltcfg PENTBL: OHDOT_Pen.tbl USER: Brennon.Cain@ohm-advisors.com WORKSPACE: OHDOTCEv02 WORKSET: 116570 PRODUCT: OpenRoadsDesigner 24.00.00.205
pw:\\ohiodot-pw.bentley.com:ohiodot-pw-02\Documents\01 Active Projects\District 03\Erie\116570\403-Engineering_OHMAdvisors\Roadway\Sheets\116570_GP102.dgn

ERI-US 0006-CONNECTIVITY CORRIDOR

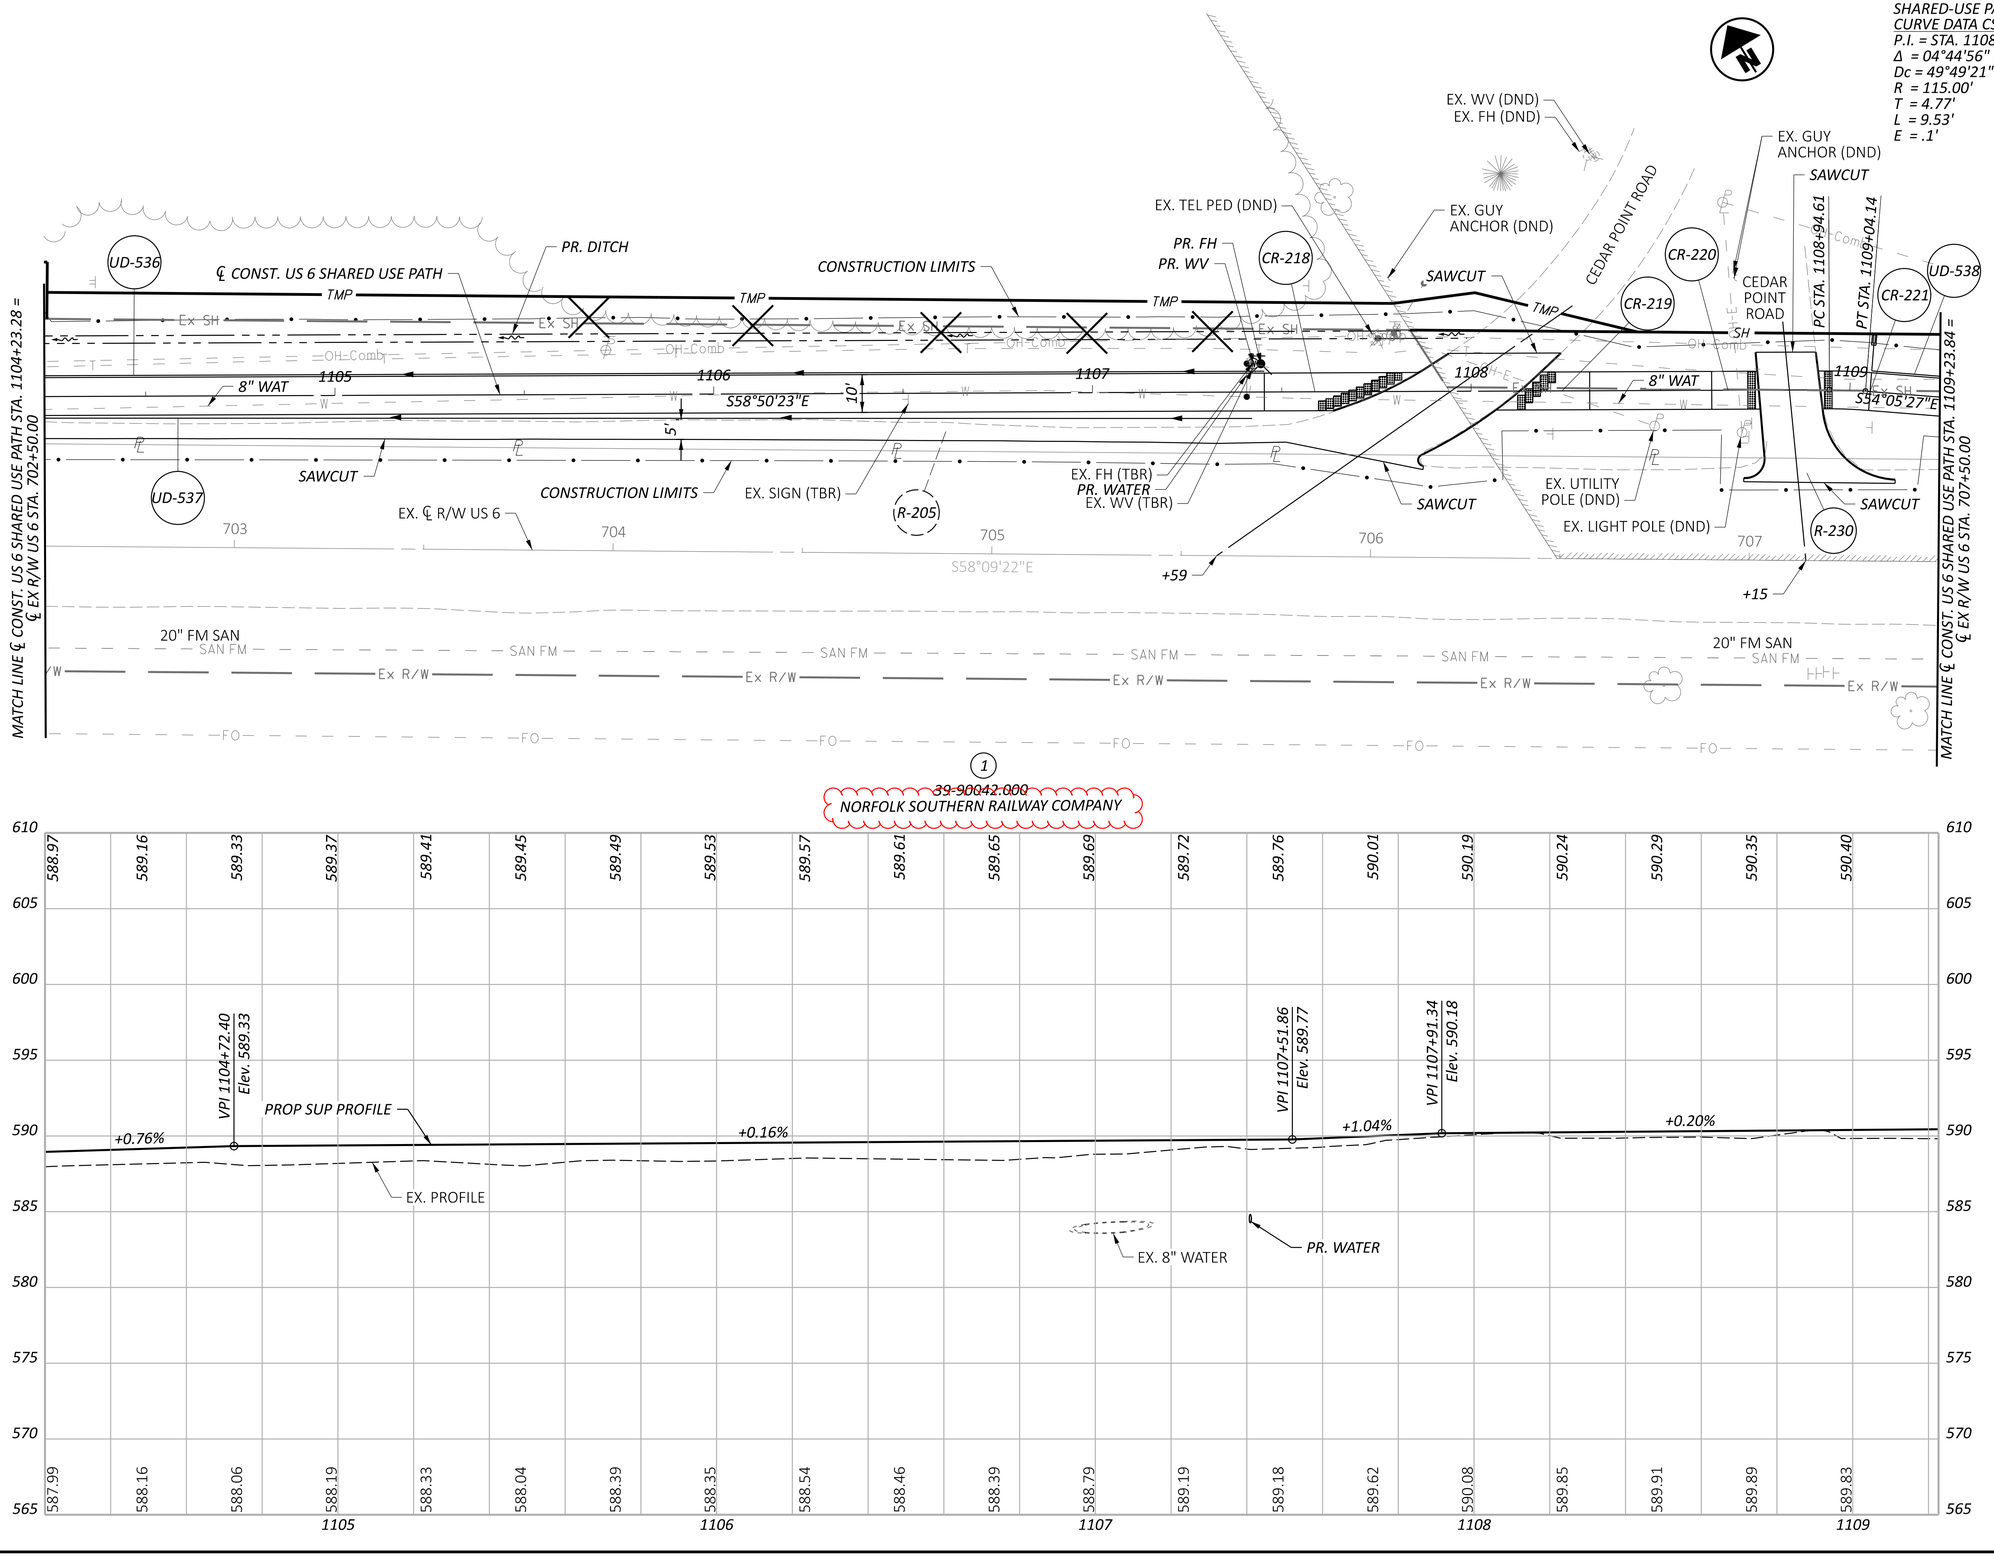

HORIZONTAL SCALE IN FEET
0 10 20 40

PLAN AND PROFILE - US 6 SUP
EX R/W STA. 702+50.00 TO STA. 707+50.00/US 6 SUP STA. 1104+23.28 TO STA. 1109+23.84

DESIGN AGENCY
OHM

DESIGNER	BLC
REVIEWER	SEO 10/27/25
PROJECT ID	116570
SHEET	P.0397
TOTAL	1106

MODEL: CLP_SUP 2 - Plan 16 [Sheet] PAPERSIZE: 34x22 (in.) DATE: 2/26/2026 TIME: 10:12:23 AM PLTDRV: OHDOT_PDF_Levels.pltcfg PENTBL: OHDOT_Pen.tbl USER: Brennon.Cain@ohm-advisors.com WORKSPACE: OHDOTCEv02 WORKSET: 116570 PRODUCT: OpenRoadsDesigner 24.00.00.205
pw:\\ohiodot-pw.bentley.com:ohiodot-pw-02\Documents\01 Active Projects\District 03\Erie\116570\403-Engineering_OHMAdvisors\Roadway\Sheets\116570_GP102.dgn

ERI-US 0006-CONNECTIVITY CORRIDOR

SHARED-USE PATH
CURVE DATA CS-41
P.I. = STA. 1110+47.34
Δ = 04°07'15" LT
Dc = 49°49'21"
R = 115.00'
T = 4.14'
L = 8.27'
E = 0.07'

(12)
55-00070.000
55-00071.000
CEDAR POINT PARK LLC
CEDAR POINT RD
RN 201410099


SHARED-USE PATH
CURVE DATA CS-42
P.I. = STA. 1111+33.22
Δ = 05°39'08" LT
Dc = 49°49'21"
R = 115.00'
T = 5.68'
L = 11.34'
E = 0.14'


SHARED-USE PATH
CURVE DATA CS-43
P.I. = STA. 1111+79.65
Δ = 04°52'17" RT
Dc = 63°39'43"
R = 90.00'
T = 3.83'
L = 7.65'
E = .08'

SHARED-USE PATH
CURVE DATA CS-44
P.I. = STA. 1112+46.02
Δ = 29°01'41" LT
Dc = 190°59'09"
R = 30.00'
T = 7.77'
L = 15.20'
E = 0.99'

SHARED-USE PATH
CURVE DATA CS-45
P.I. = STA. 1112+84.11
Δ = 29°48'28" RT
Dc = 190°59'09"
R = 30.00'
T = 7.98'
L = 15.61'
E = 1.04'

(13)
39-00910.000
JUDITH A CORSO, TRUSTEE
CLEVELAND RD
RN 200003378

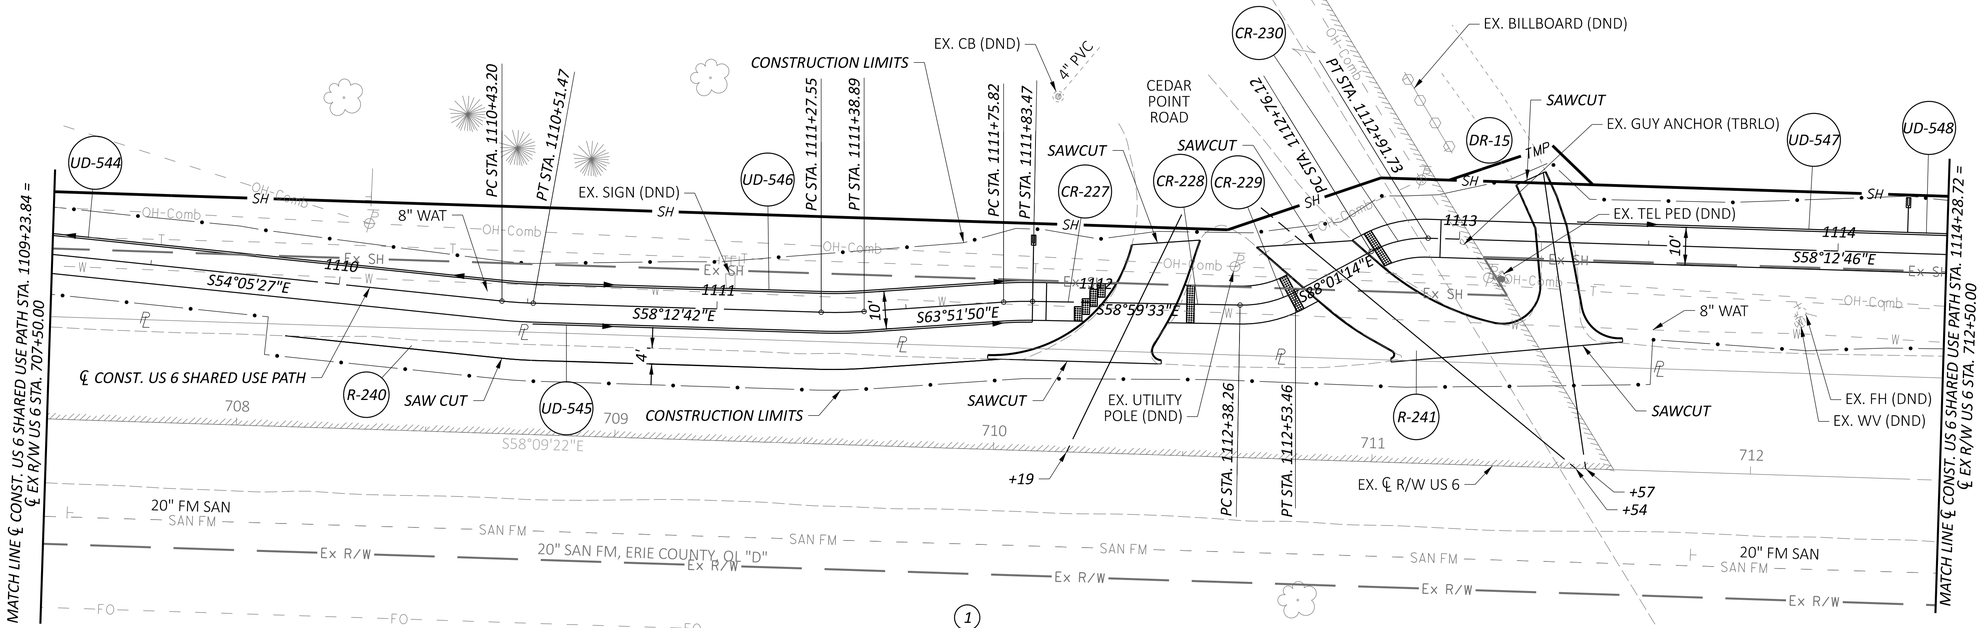

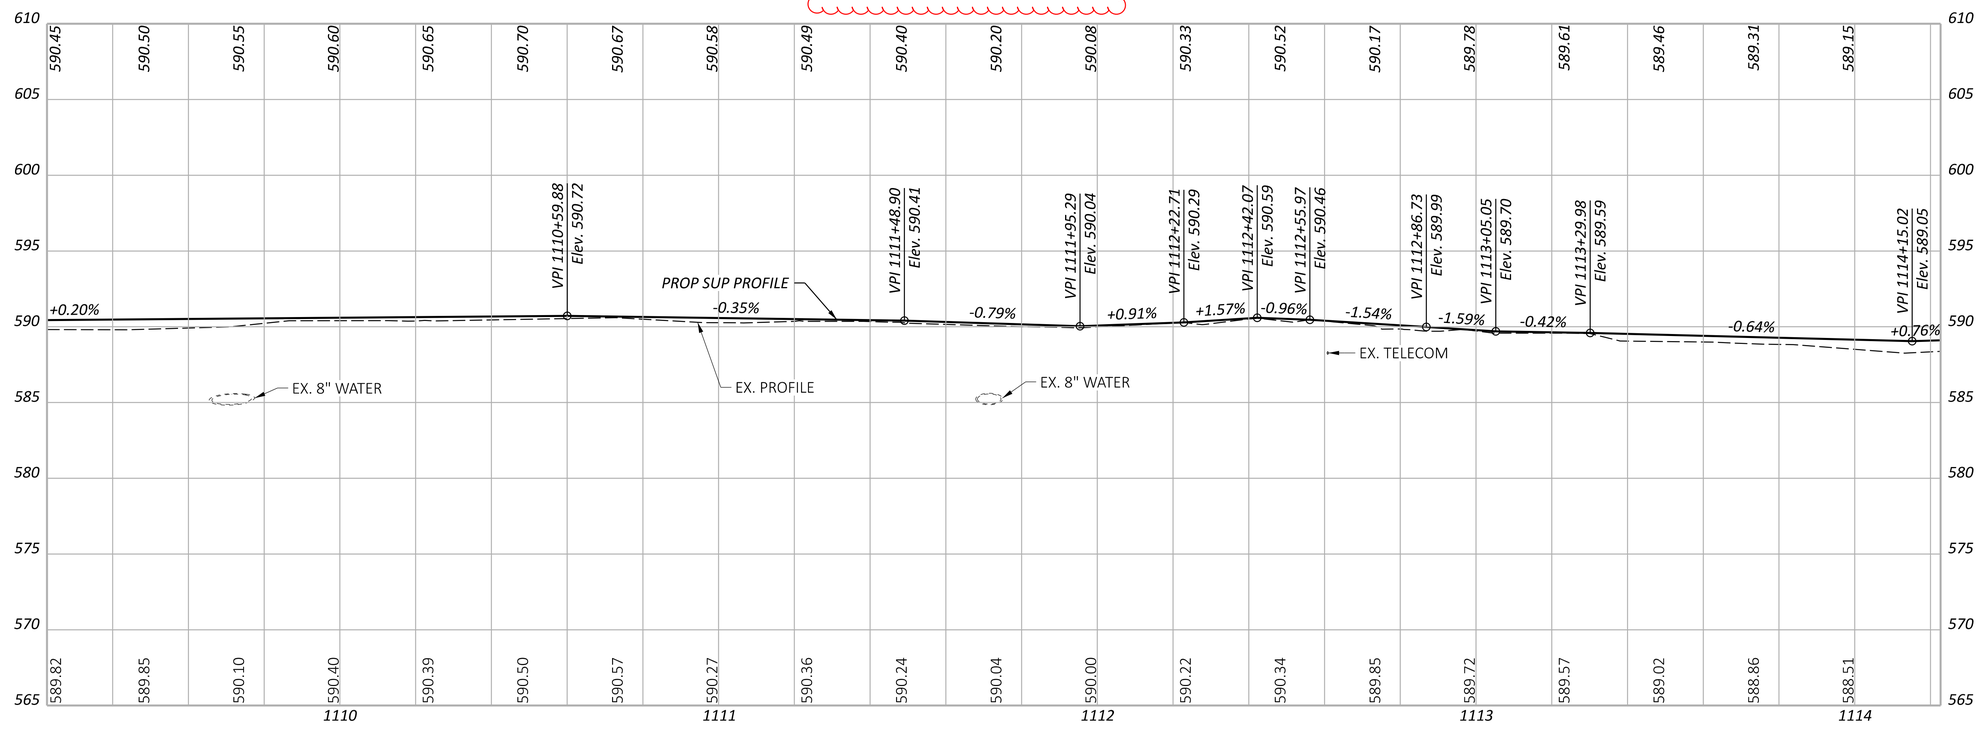

HORIZONTAL SCALE IN FEET
0 10 20 40


PLAN AND PROFILE - US 6 SUP
EX R/W STA. 707+50.00 TO STA. 712+50.00/US 6 SUP STA. 1109+23.84 TO STA. 1114+28.72


DESIGN AGENCY
OHM

DESIGNER	BLC
REVIEWER	SEO 10/27/25
PROJECT ID	116570
SHEET	P.0398
TOTAL	1106

MODEL: CLP_SUP 2 - Plan 17 [Sheet] PAPERSIZE: 34x22 (in.) DATE: 2/26/2026 TIME: 10:12:24 AM PLTDRV: OHDOT_PDF_Levels.pltcfg PENTBL: OHDOT_Pen.tbl USER: Brennon.Cain@ohm-advisors.com WORKSPACE: OHDOTCEv02 WORKSET: 116570 PRODUCT: OpenRoadsDesigner 24.00.00.205
pw:\\ohiodot-pw.bentley.com:ohiodot-pw-02\Documents\01 Active Projects\District 03\Erie\116570\403-Engineering_OHMAdvisors\Roadway\Sheets\116570_GP102.dgn

ERI-US 0006-CONNECTIVITY CORRIDOR

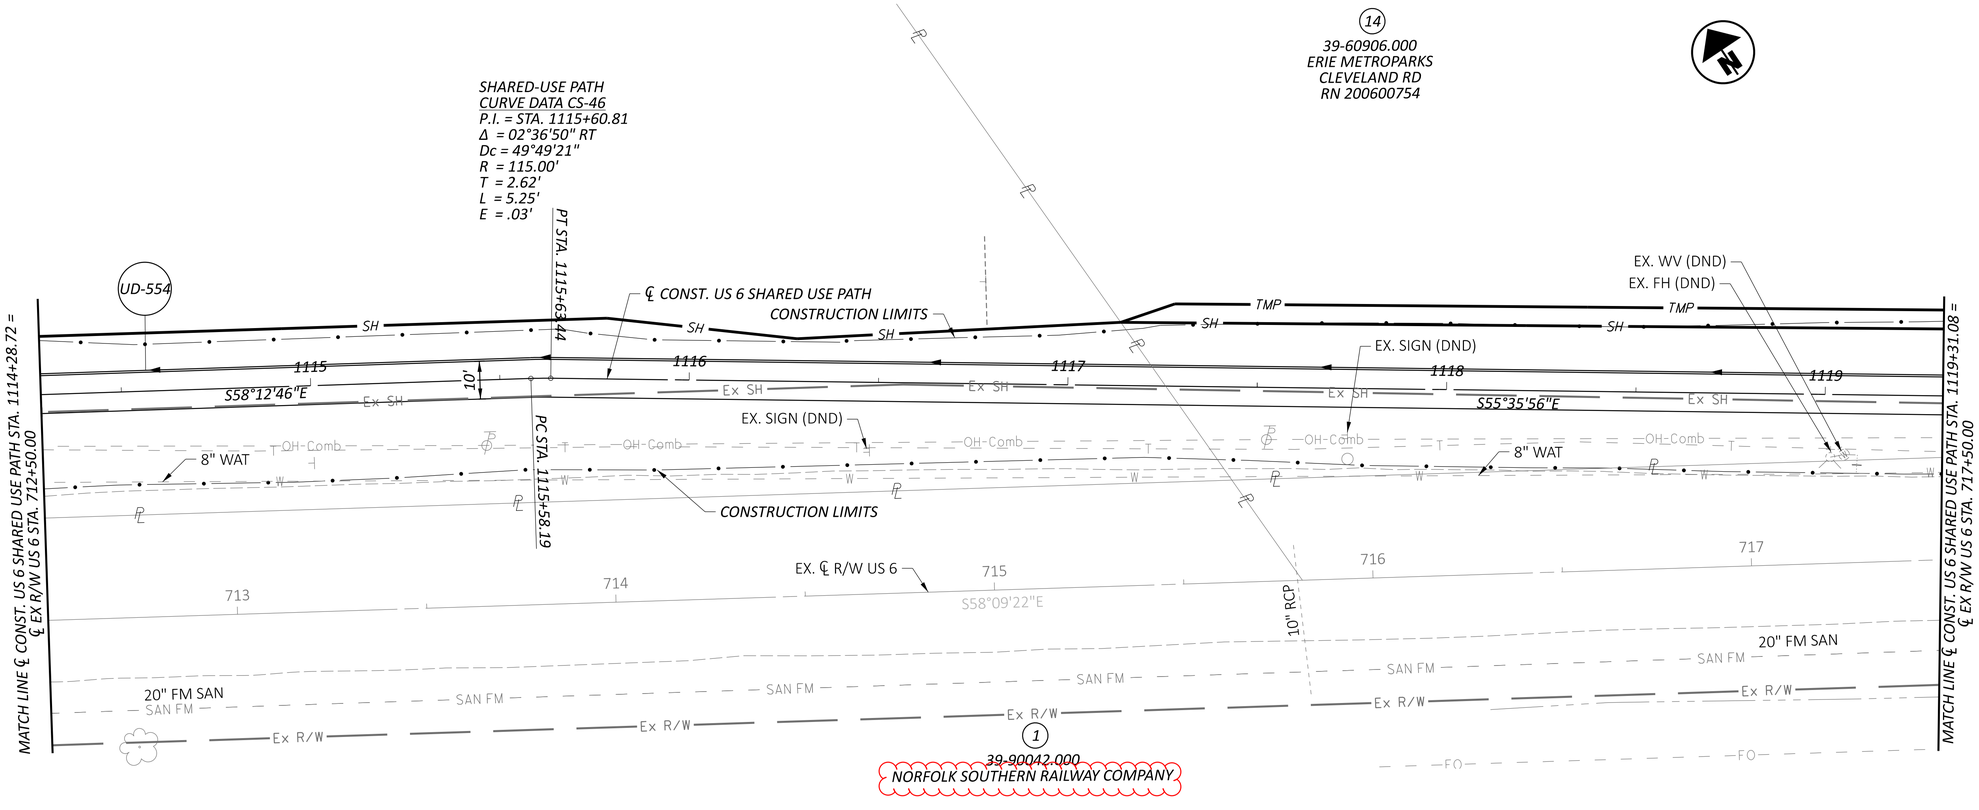

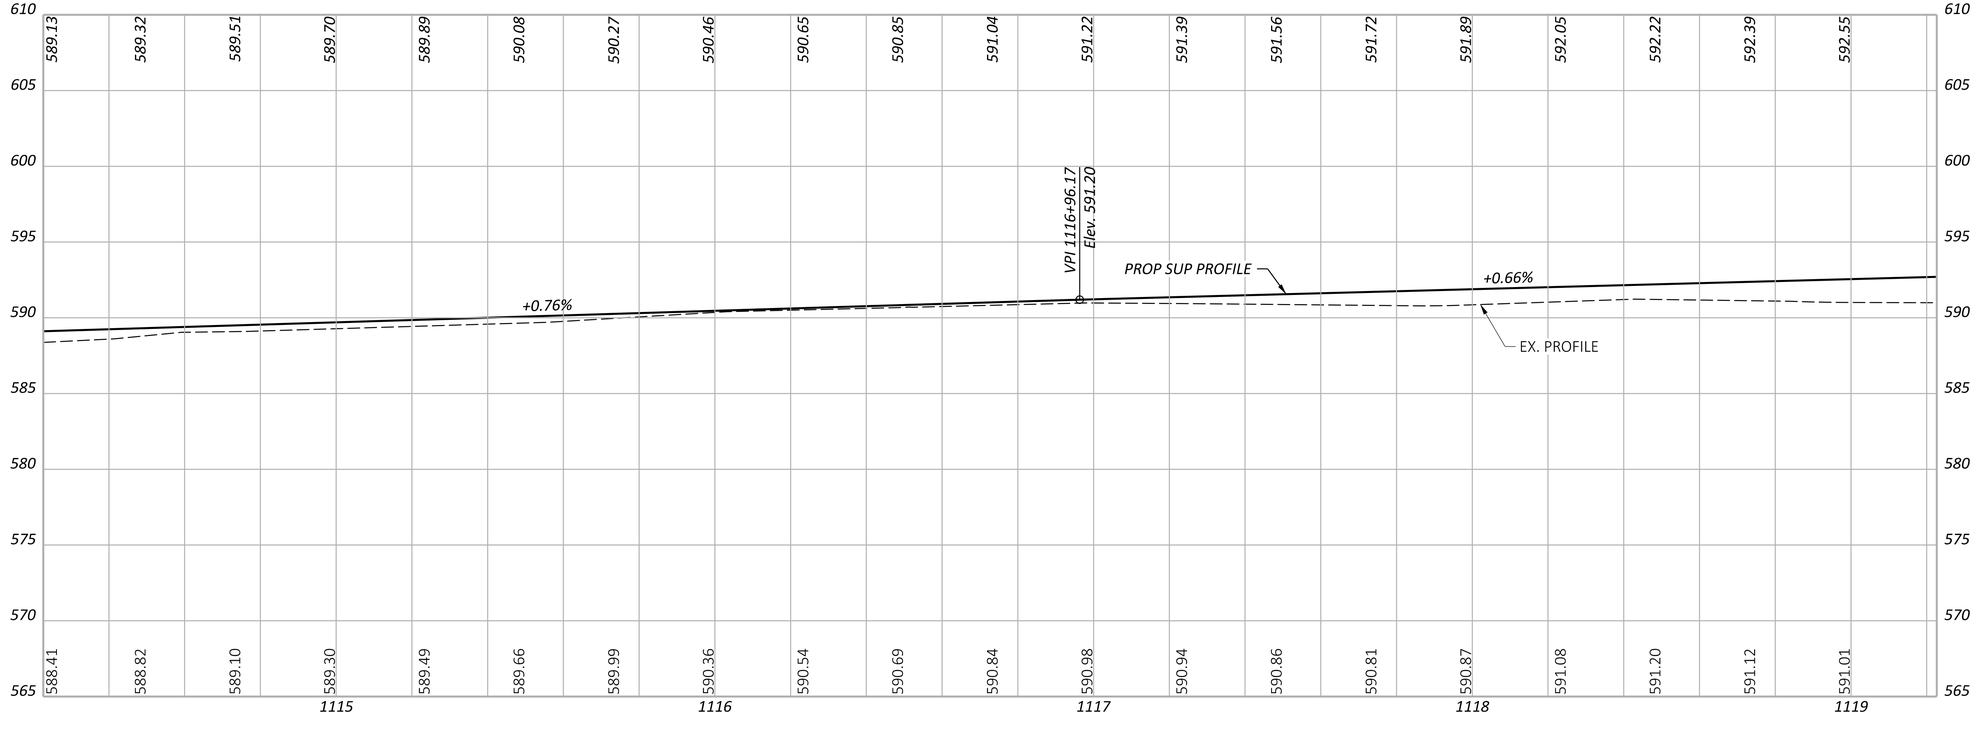

HORIZONTAL SCALE IN FEET
0 10 20 40


PLAN AND PROFILE - US 6 SUP
EX R/W STA. 712+50.00 TO STA. 717+50.00/US 6 SUP STA. 1114+28.72 TO STA. 1119+31.08

DESIGN AGENCY
OHM

DESIGNER	BLC
REVIEWER	SEO 10/27/25
PROJECT ID	116570
SHEET	P.0399
TOTAL	1106

MODEL: CLP_SUP 2 - Plan 18 [Sheet] PAPERSIZE: 34x22 (in.) DATE: 2/26/2026 TIME: 10:12:25 AM PLTDRV: OHDOT_PDF_Levels.pltcfg PENTBL: OHDOT_Pen.tbl USER: Brennon.Cain@ohm-advisors.com WORKSPACE: OHDOTCEv02 WORKSET: 116570 PRODUCT: OpenRoadsDesigner 24.00.00.205
pw:\\ohiodot-pw.bentley.com:ohiodot-pw-02\Documents\01 Active Projects\District 03\Erie\116570\403-Engineering_OHMAdvisors\Roadway\Sheets\116570_GP102.dgn

ERI-US 0006-CONNECTIVITY CORRIDOR

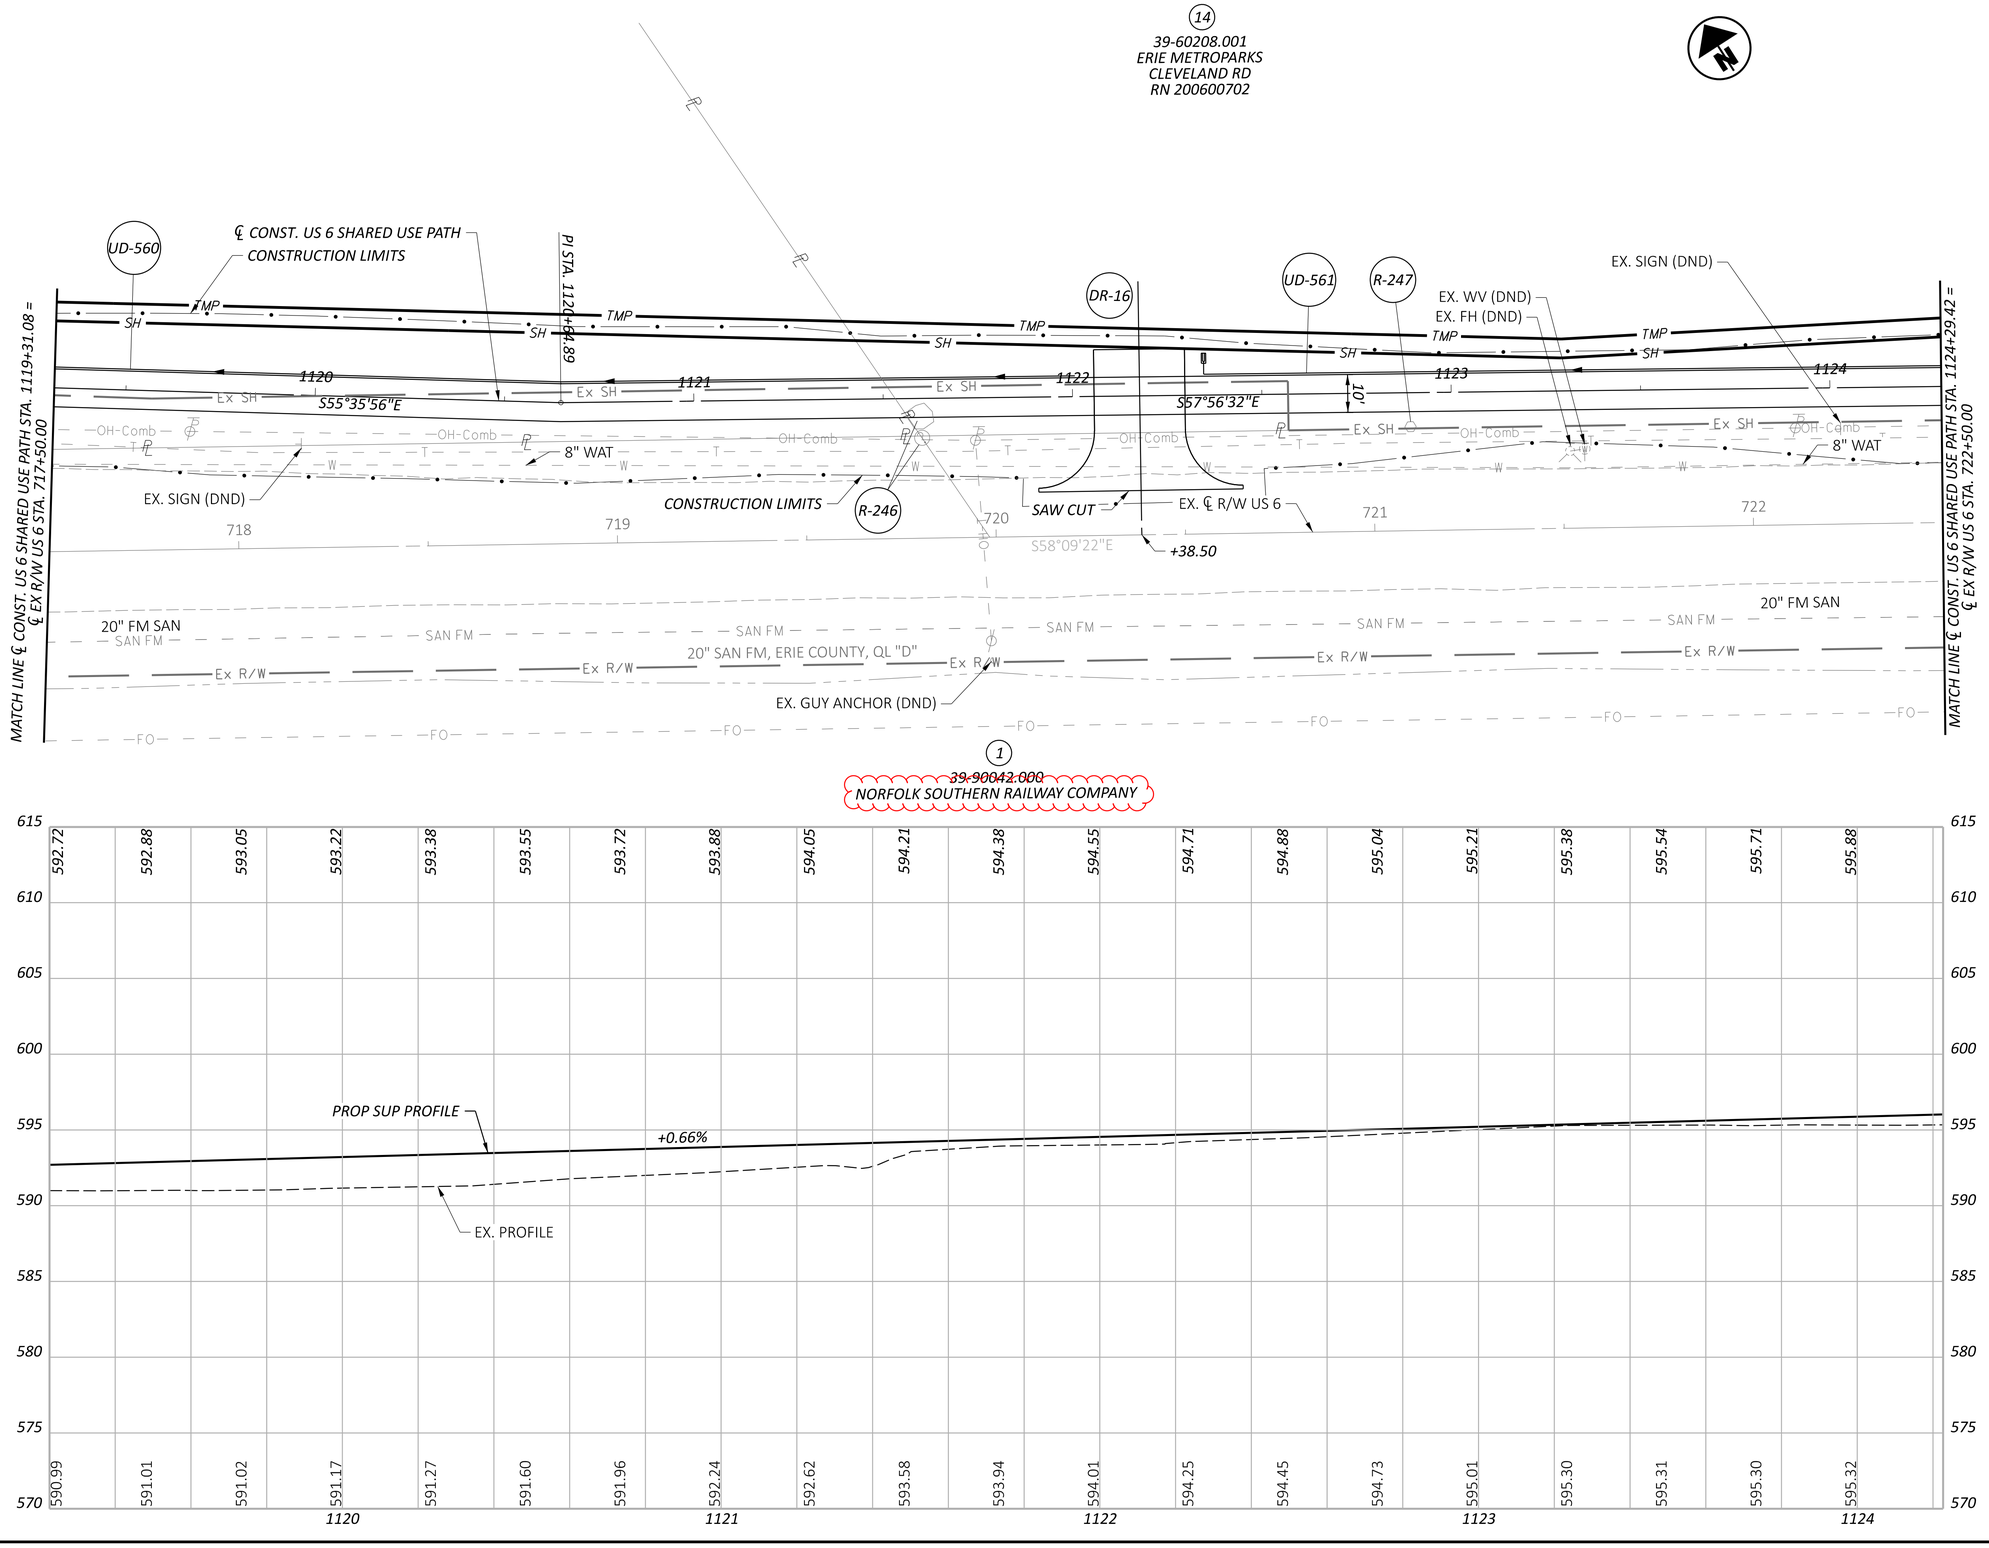

HORIZONTAL SCALE IN FEET
0 10 20 40


PLAN AND PROFILE - US 6 SUP
EX R/W STA. 717+50.00 TO STA. 722+50.00/US 6 SUP STA. 1119+31.08 TO STA. 1124+29.42


DESIGN AGENCY
OHM

DESIGNER	BLC
REVIEWER	SEO 10/27/25
PROJECT ID	116570
SHEET	P.0400
TOTAL	1106

ERI-US 0006-CONNECTIVITY CORRIDOR

MODEL: CLP_SUP 2 - Plan 19 [Sheet] PAPERSIZE: 34x22 (in.) DATE: 2/26/2026 TIME: 10:12:26 AM PLTDRV: OHDOT_PDF_Levels.pltcfg PENTBL: OHDOT_Pen.tbl USER: Brennon.Cain@ohm-advisors.com WORKSPACE: OHDOTCEv02 WORKSET: 116570 PRODUCT: OpenRoadsDesigner 24.00.00.205
pw:\\ohiodot-pw.bentley.com:ohiodot-pw-02\Documents\01 Active Projects\District 03\Erie\116570\403-Engineering_OHMAdvisors\Roadway\Sheets\116570_GP102.dgn

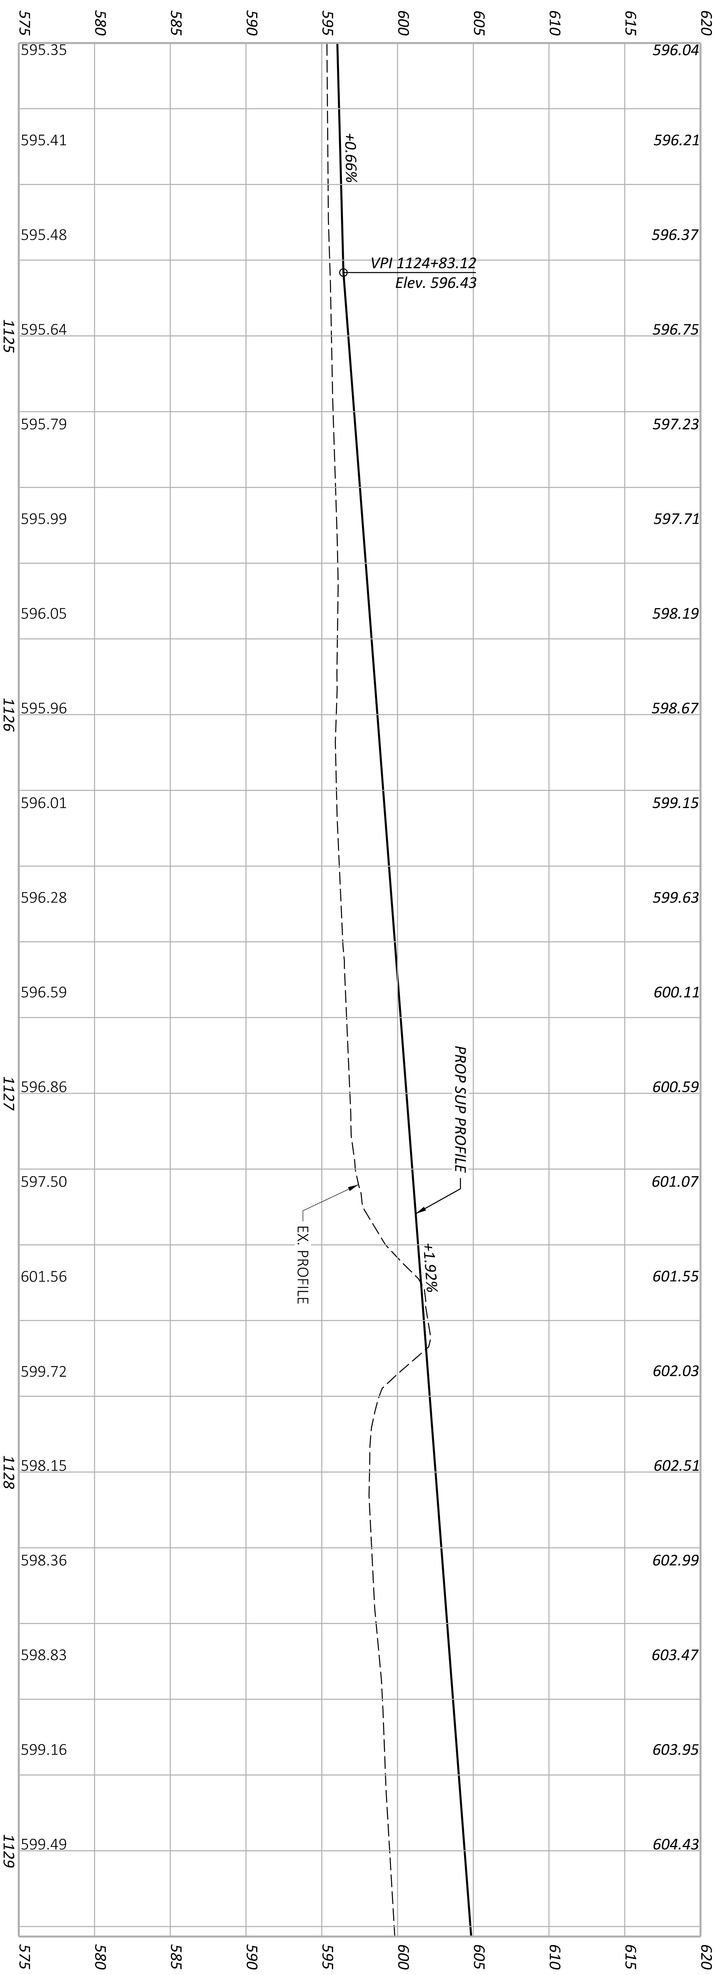

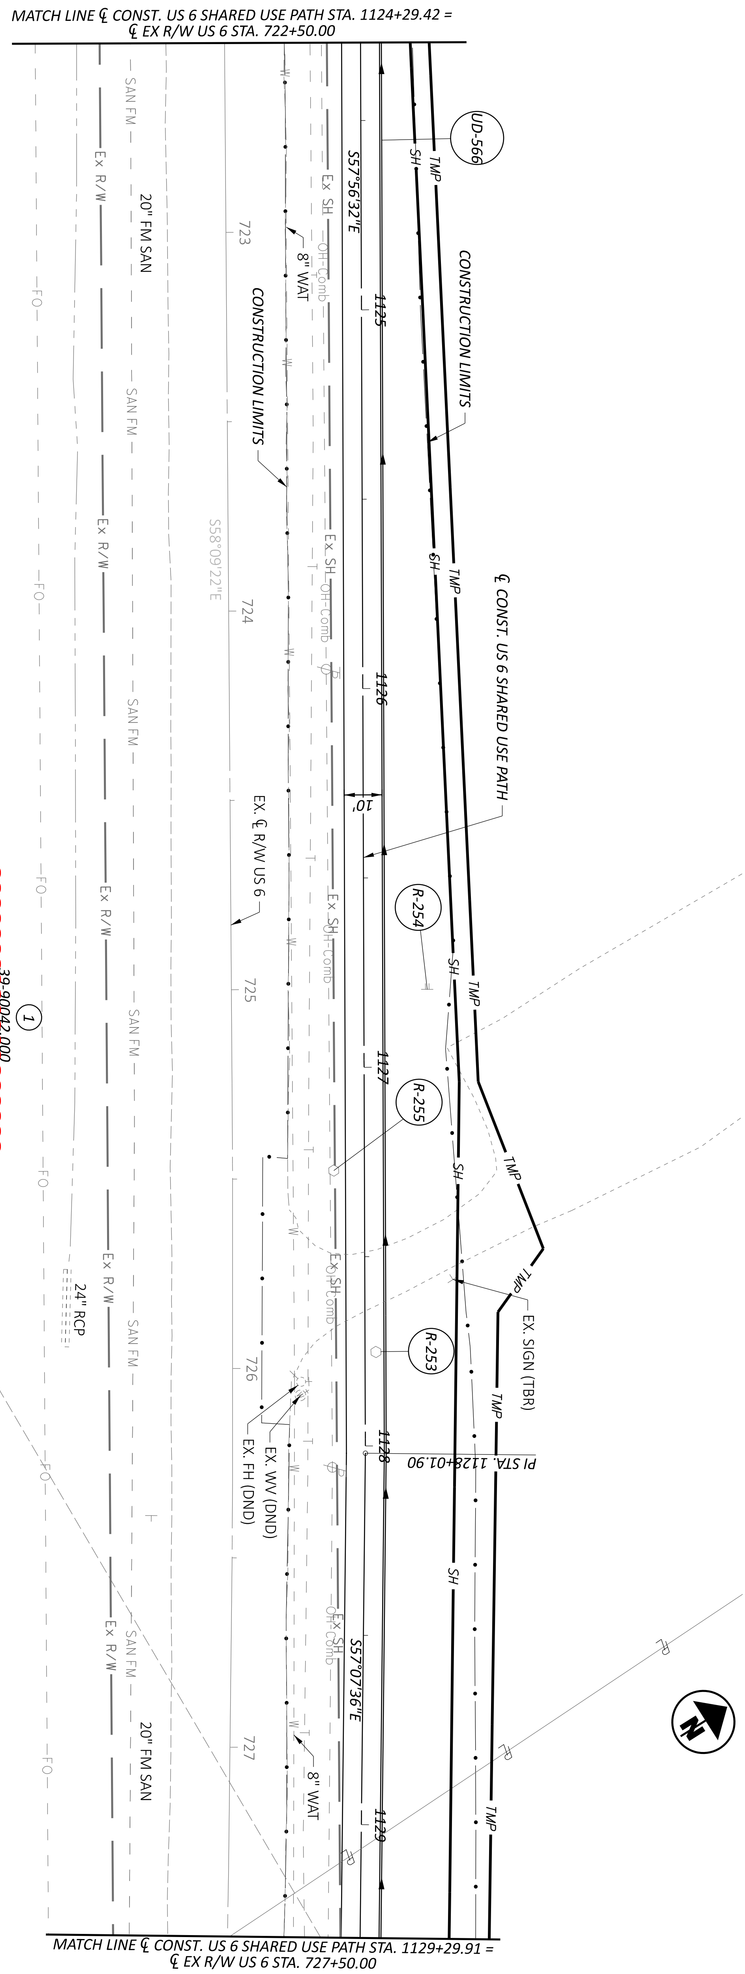

PLAN AND PROFILE - US 6 SUP

EX R/W STA. 722+50.00 TO STA. 727+50.00/US 6 SUP STA. 1124+29.42 TO STA. 1129+29.91

HORIZONTAL SCALE IN FEET

0 20 10 40

SHEET	TOTAL
P 0401	1106


PROJECT ID: 116570


REVIEWER: SEO 10/27/25

DESIGNER: BLC

DESIGN AGENCY: OHM

MODEL: CLP_SUP 2 - Plan 20 [Sheet] PAPERSIZE: 34x22 (in.) DATE: 2/26/2026 TIME: 10:12:28 AM PLTDRV: OHDOT_PDF_Levels.pltcfg PENTBL: OHDOT_Pen.tbl USER: Brennon.Cain@ohm-advisors.com WORKSPACE: OHDOTCEv02 WORKSET: 116570 PRODUCT: OpenRoadsDesigner 24.00.00.205
pw:\\ohiodot-pw.bentley.com:ohiodot-pw-02\Documents\01 Active Projects\District 03\Erie\116570\403-Engineering_OHMAdvisors\Roadway\Sheets\116570_GP102.dgn

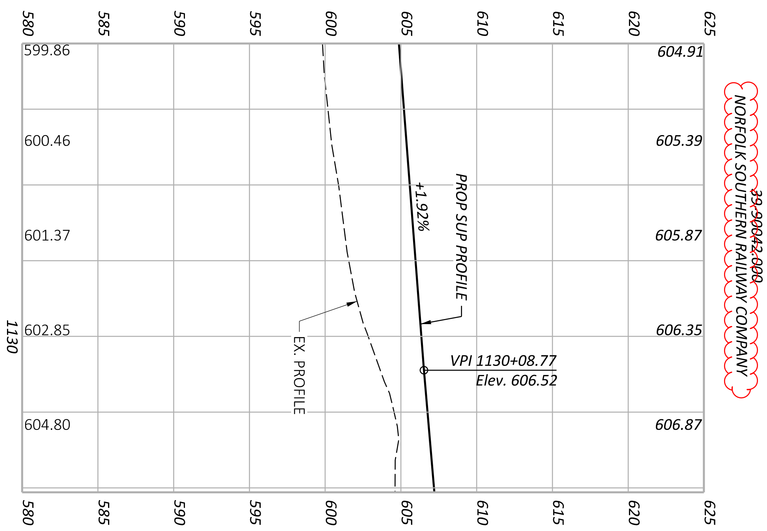

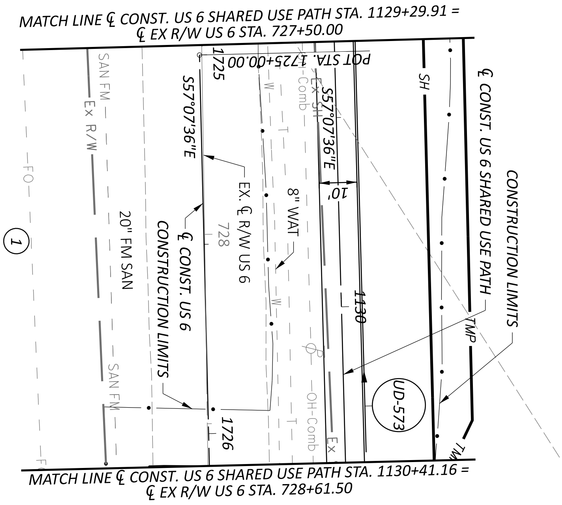


39-60209.000
ERIE METROPARKS
3910 PERKINS AVE
HURON OH 44839
20.630 AC.
15




SHEET P 0402 | TOTAL 1106	PROJECT ID 116570	REVIEWER SEO 10/27/25	DESIGNER BLC	OHM	DESIGN AGENCY

PLAN AND PROFILE - US 6 SUP
EX R/W STA. 727+50.00 TO STA. 728+61.15/US 6 SUP STA. 1129+29.91 TO STA. 1130+41.16

HORIZONTAL SCALE IN FEET
0 20
10 40

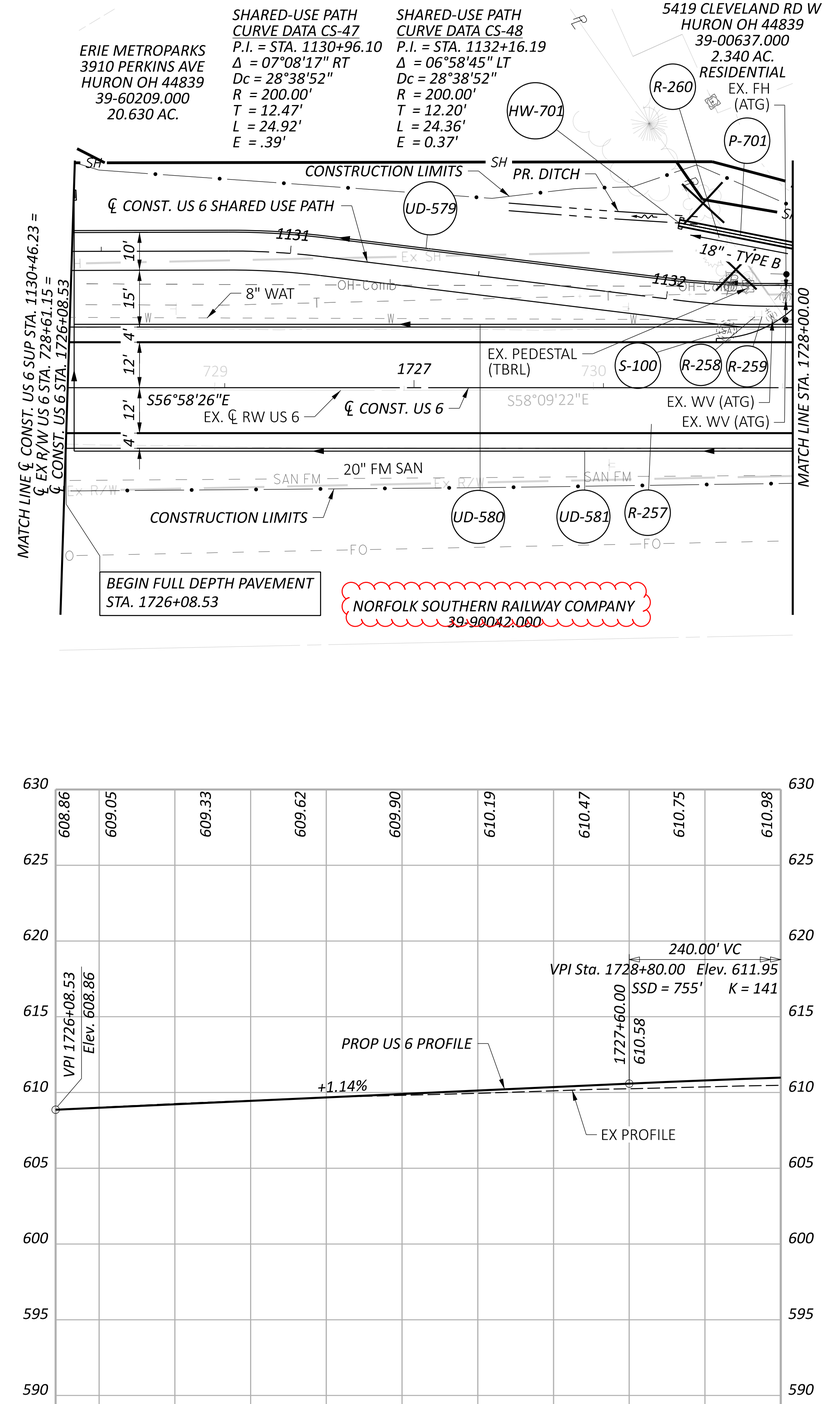

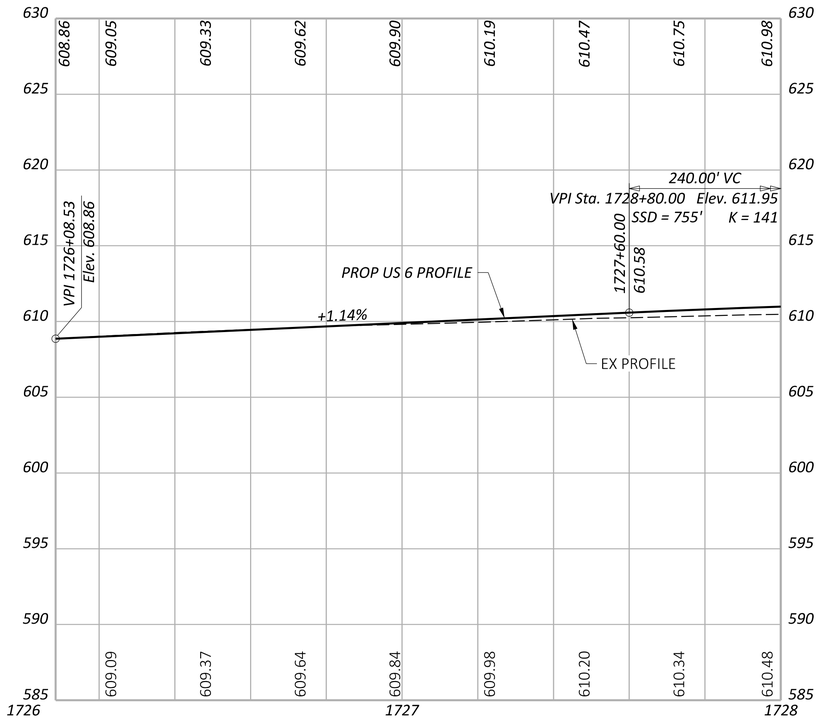

HORIZONTAL SCALE IN FEET
0 10 20 40

PLAN AND PROFILE - US 6
STA. 1726+08.53 TO STA. 1728+00.00

DESIGN AGENCY
OHM

DESIGNER	CLD
REVIEWER	SEO 10/27/25
PROJECT ID	116570
SHEET	P.0403
TOTAL	1106

ERI-US 0006-CONNECTIVITY CORRIDOR

MODEL: CLP_U006_CAMP-1 - Plan 1 [Sheet] PAPERSIZE: 34x22 (in.) DATE: 2/26/2026 TIME: 10:12:39 AM PLTDRV: OHDOT_PDF_Levels.pltcfg PENTBL: OHDOT_Pen.tbl USER: Brennon.Cain@ohm-advisors.com WORKSPACE: OHDOTCEv02 WORKSET: 116570 PRODUCT: OpenRoadsDesigner 24.00.00.205
pw:\\ohiodot-pw.bentley.com:ohiodot-pw-02\Documents\01 Active Projects\District 03\Erie\116570\403-Engineering_OHMAdvisors\Roadway\Sheets\116570_GP301.dgn

HESSLER JEFFRY C
5419 CLEVELAND RD W
HURON OH 44839
39-00637.000
2.340 AC.
RESIDENTIAL

STEINMETZ BENJAMIN P
5501 CLEVELAND RD W
HURON OH 44839
39-00346.000
1.153 AC.
RESIDENTIAL

BARNES NURSERY INC.
3511 CLEVELAND RD W
HURON OH 44839
39-00045.500
4.500 AC.
COMMERCIAL

HURON LIGHTHOUSE LTD
CLEVELAND RD W
HURON OH 44839
39-00524.000
1.706 AC.
RESIDENTIAL

NORFOLK SOUTHERN RAILWAY COMPANY
39-90042.000

MATCH LINE STA. 1728+00.00

MATCH LINE STA. 1733+00.00

BEGIN C&G TYPE 2 STA. 1732+07.80, LT

BEGIN WALL +50.00

END WALL +50.00

PR. RETAINING WALL

EX. WV (ATG)

EX. GUY WIRES (TBRL)

CONSTRUCTION LIMITS

EX. WATER FAUCETS (DND)

ELEC OUTLET (TBR)

PR. DITCH

℄ CONST. US 6 SHARED USE PATH

℄ CONST. US 6

EX. ℄ RW US 6

8" WAT

EX. WATER MH (ATG)

20" SAN FM, ERIE COUNTY, QL "D"

MGS TYPE E

PC STA. 1729+37.61

PT STA. 1731+96.37

℄ REF WL_B

℄ REF NW_B

℄ REF SW_B

℄ REF WR1_B

EX. CB (DND)

18" - TYPE B

18"-B

15" - TYPE B


R-266 R-267 DR-17 D-701 UD-587 P-702 UD-590 D-702 DR-18 P-703 HW-702 R-261 UD-592 R-268 HW-703 R-262 UD-593 R-263 P-704 UD-594 C-260 R-265 S-106 S-107 UD-588 UD-589 UD-591 GR-111 R-257 R-264 MB-101

+19.44 +04.98 +88.48 +38.48

1729 S58°09'22"E

S87°40'26"E 221

1730 1731 1732 1733 1134 1135 1136 1137 220 210

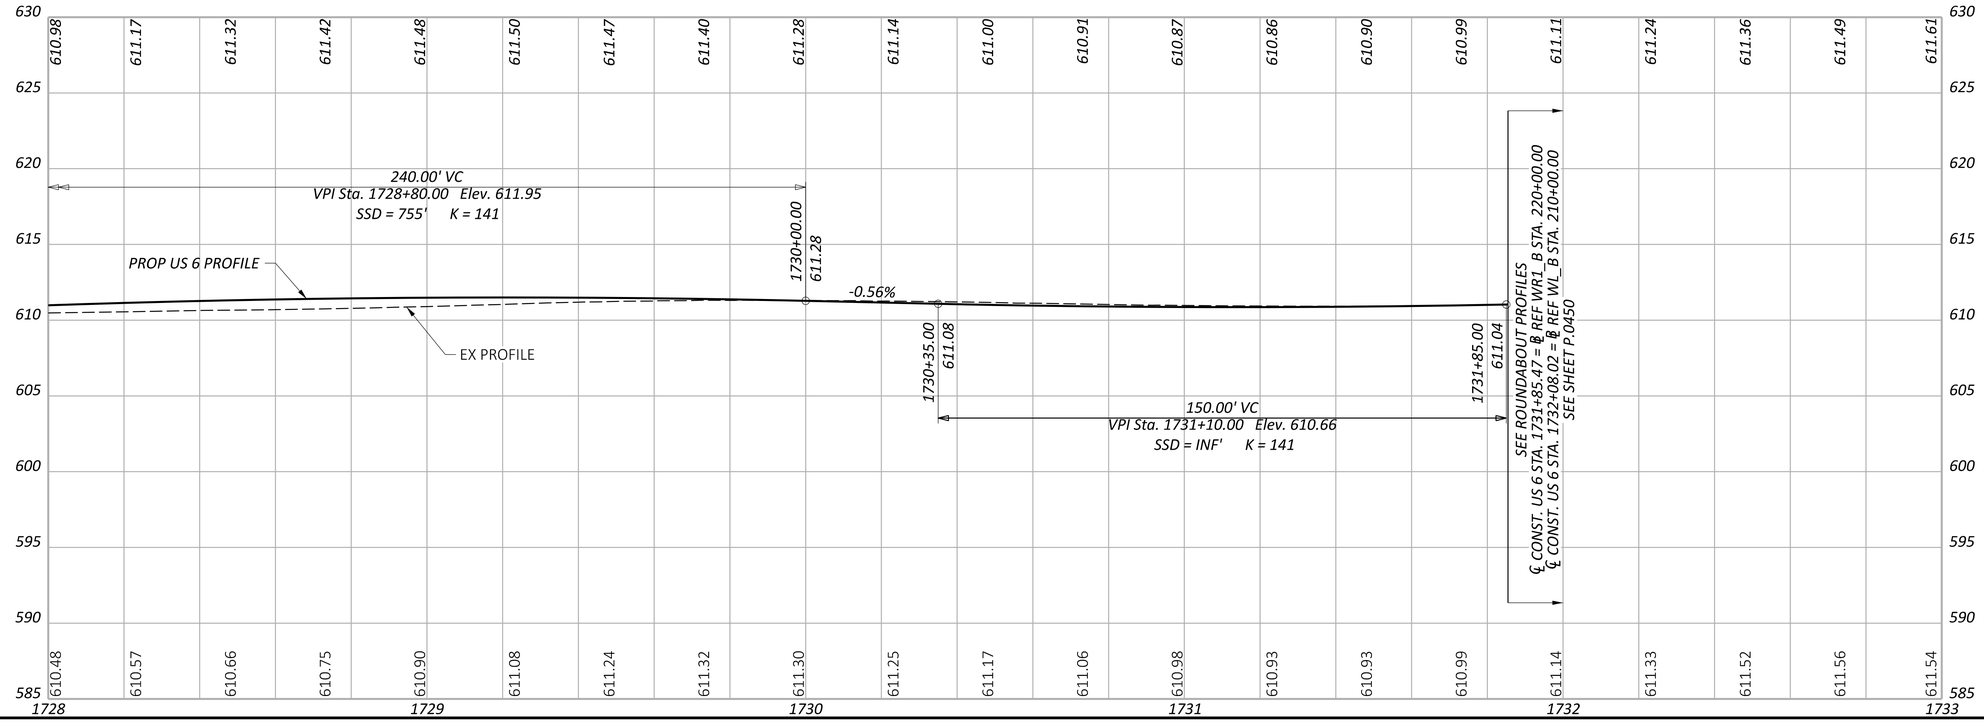

HORIZONTAL SCALE IN FEET
0 10 20 40

PLAN AND PROFILE - US 6
STA. 1728+00.00 TO STA. 1733+00.00

DESIGN AGENCY
OHM


DESIGNER	CLD
REVIEWER	SEO 10/27/25
PROJECT ID	116570
SHEET	P.0404
TOTAL	1106

ERI-US 0006-CONNECTIVITY CORRIDOR

MODEL: CLP_U006_CAMP-1 - Plan 2 [Sheet] PAPERSIZE: 34x22 (in.) DATE: 2/26/2026 TIME: 10:12:42 AM PLTDRV: OHDOT_PDF_Levels.pltcfg PENTBL: OHDOT_Pen.tbl USER: Brennon.Cain@ohm-advisors.com WORKSPACE: OHDOTCEv02 WORKSET: 116570 PRODUCT: OpenRoadsDesigner 24.00.00.205
pw:\\ohiodot-pw.bentley.com:ohiodot-pw-02\Documents\01 Active Projects\District 03\Erie\116570\403-Engineering_OHMAdvisors\Roadway\Sheets\116570_GP301.dgn

ERI-US 0006-CONNECTIVITY CORRIDOR

MODEL: CLP_PERKINS - Plan 1 [Sheet] PAPERSIZE: 34x22 (in.) DATE: 2/26/2026 TIME: 10:19:07 AM PLTDRV: OHDOT_PDF_Levels.pltcfg PENTBL: OHDOT_Pen.tbl USER: Brennon.Cain@ohm-advisors.com WORKSPACE: OHDOTCEv02 WORKSET: 116570 PRODUCT: OpenRoadsDesigner 24.00.00.205
pw:\\ohiodot-pw.bentley.com:ohiodot-pw-02\Documents\01 Active Projects\District 03\Erie\116570\403-Engineering_OHMAdvisors\Roadway\Sheets\116570_GP201.dgn

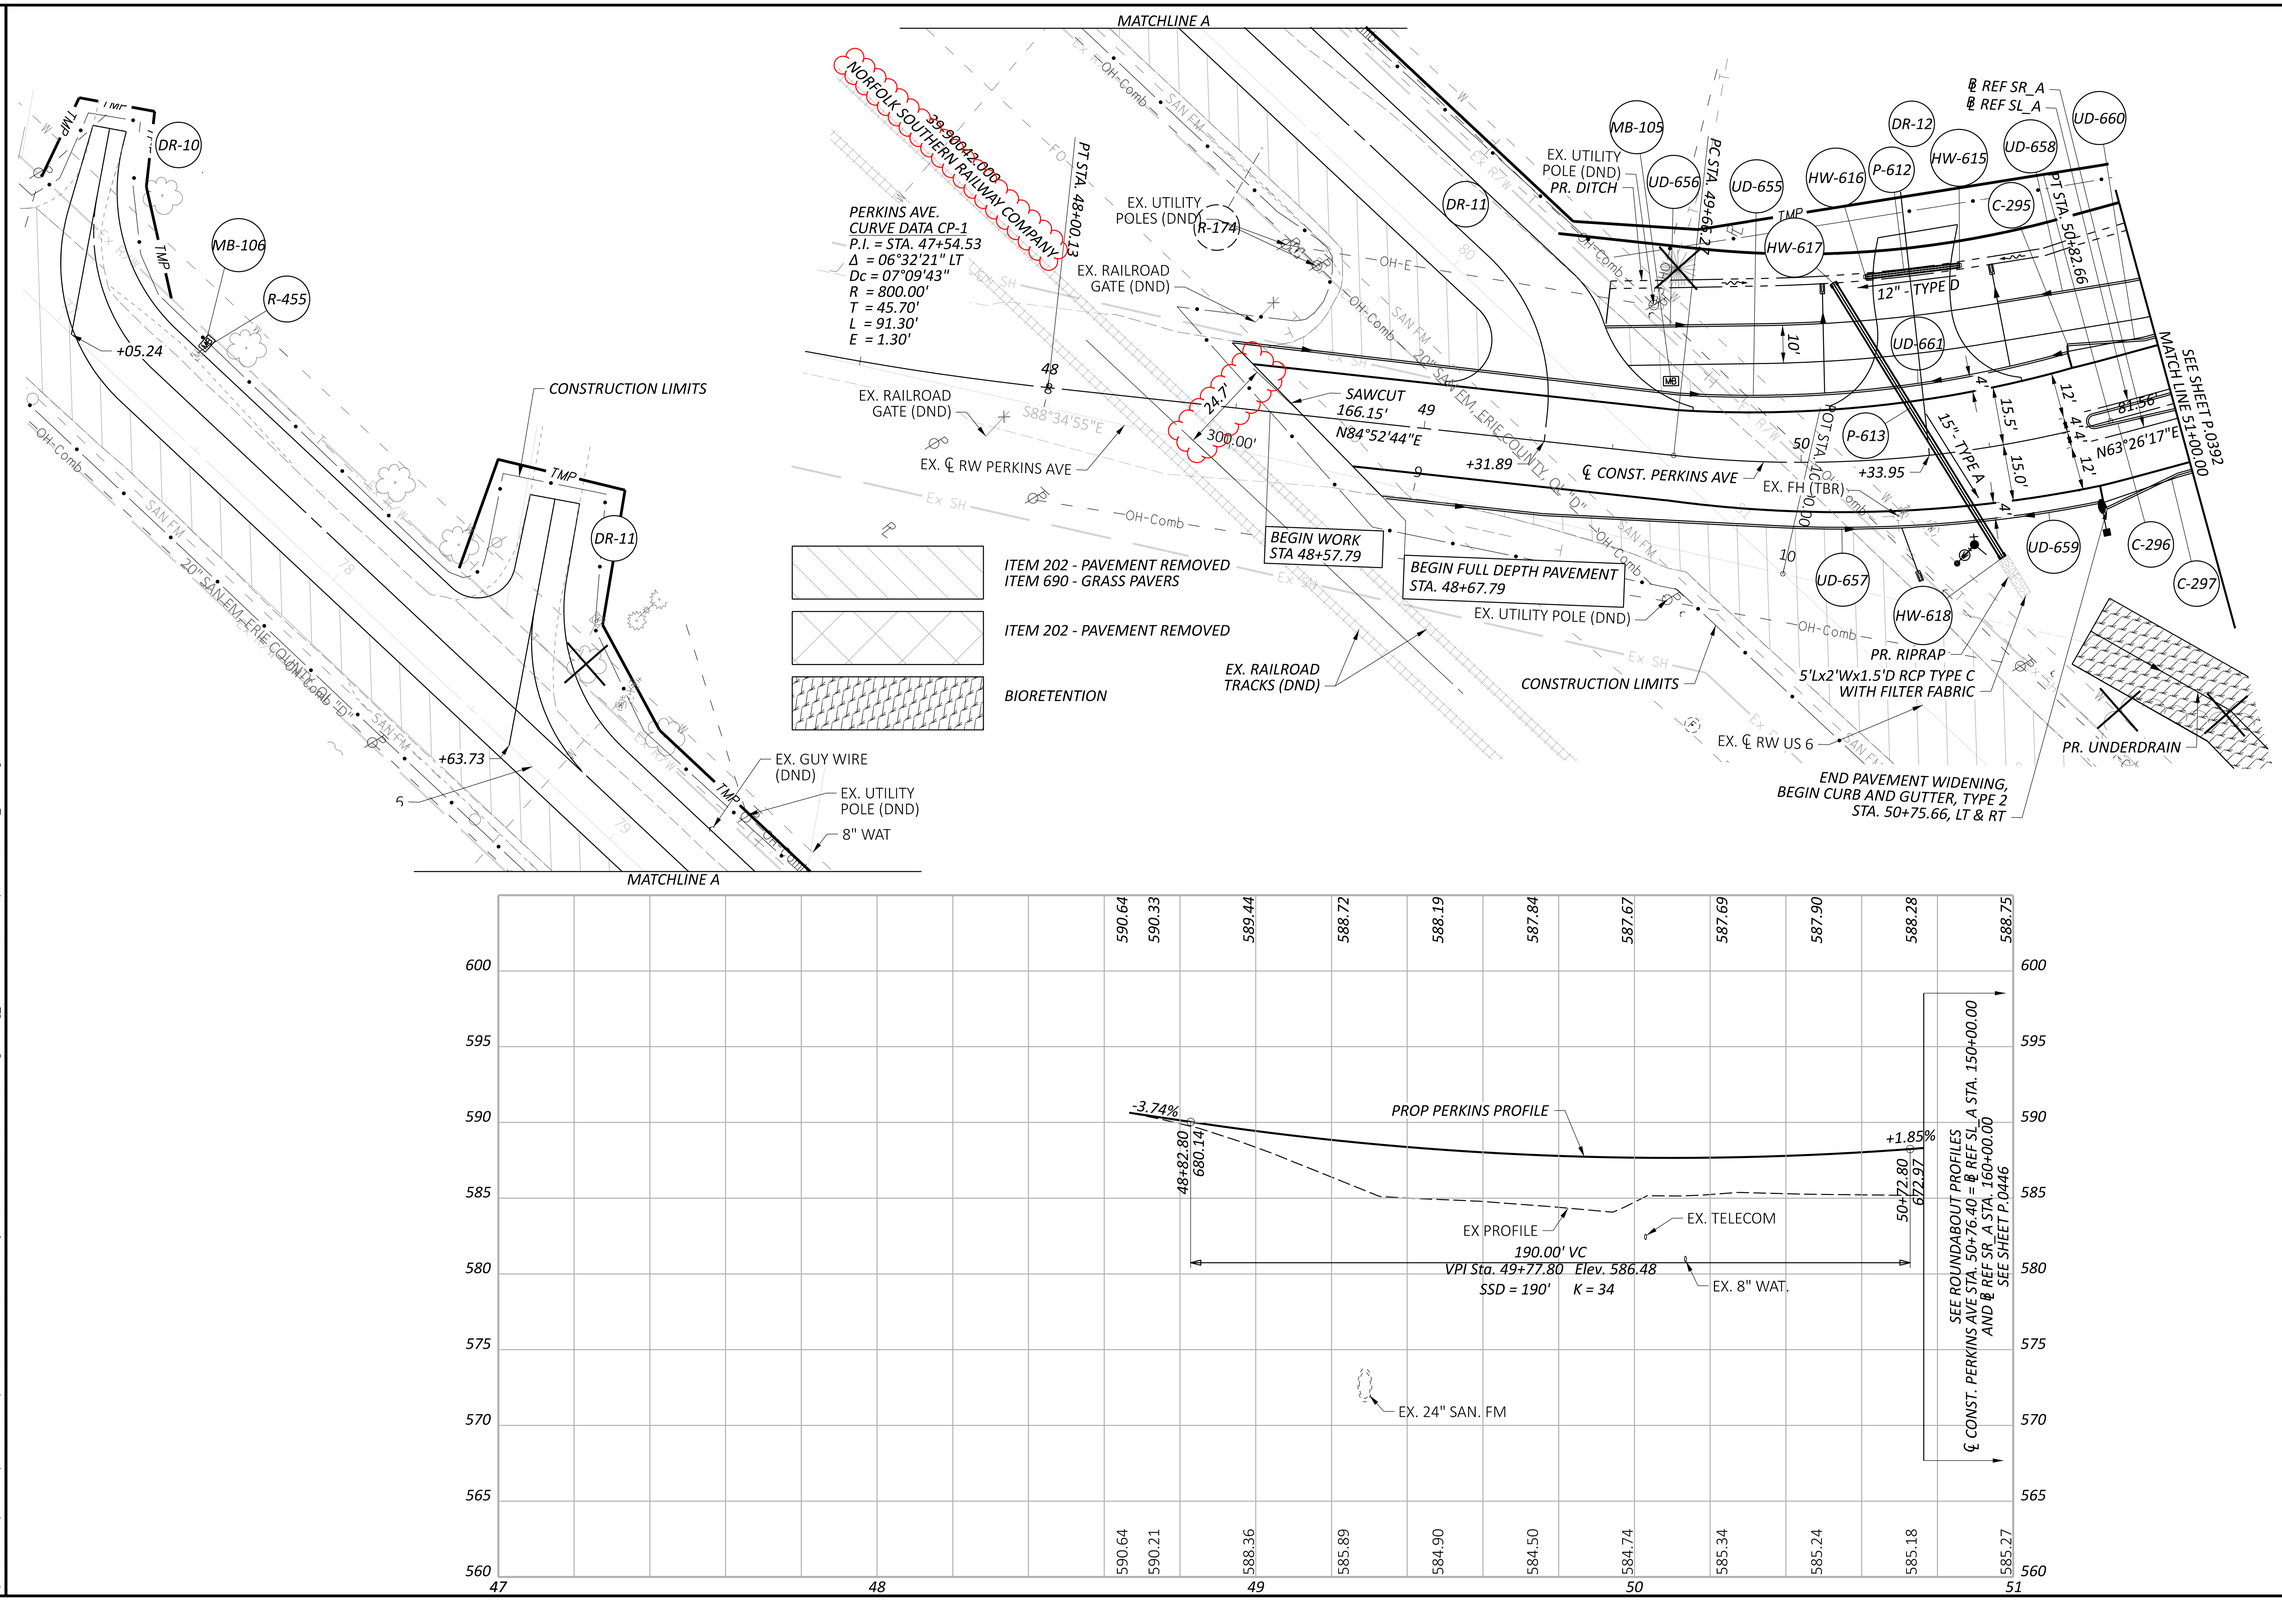


HORIZONTAL SCALE IN FEET
0 10 20 40

PLAN AND PROFILE - PERKINS AVE
BEGIN TO STA. 51+00.00

DESIGN AGENCY
OHM

DESIGNER	KAH
REVIEWER	SEO 10/27/25
PROJECT ID	116570
SHEET	P.0422
TOTAL	1106

MODEL: CLP_CAMP-1 - Plan & [Sheet] PAPERSIZE: 34x22 (in.) DATE: 2/26/2026 TIME: 10:19:19 AM PLTDRV: OHDOT_PDF_Levels.pltcfg PENTBL: OHDOT_Pen.tbl USER: Brennon.Cain@ohm-advisors.com WORKSPACE: OHDOTCivil02 WORKSET: 116570 PRODUCT: OpenRoads Designer 24.00.00.205
pw:\\ohiodot-pw.bentley.com:ohiodot-pw-02\Documents\01 Active Projects\District 03\Erie\116570\403-Engineering_OHMAdvisors\Roadway\Sheets\116570_GP301.dgn

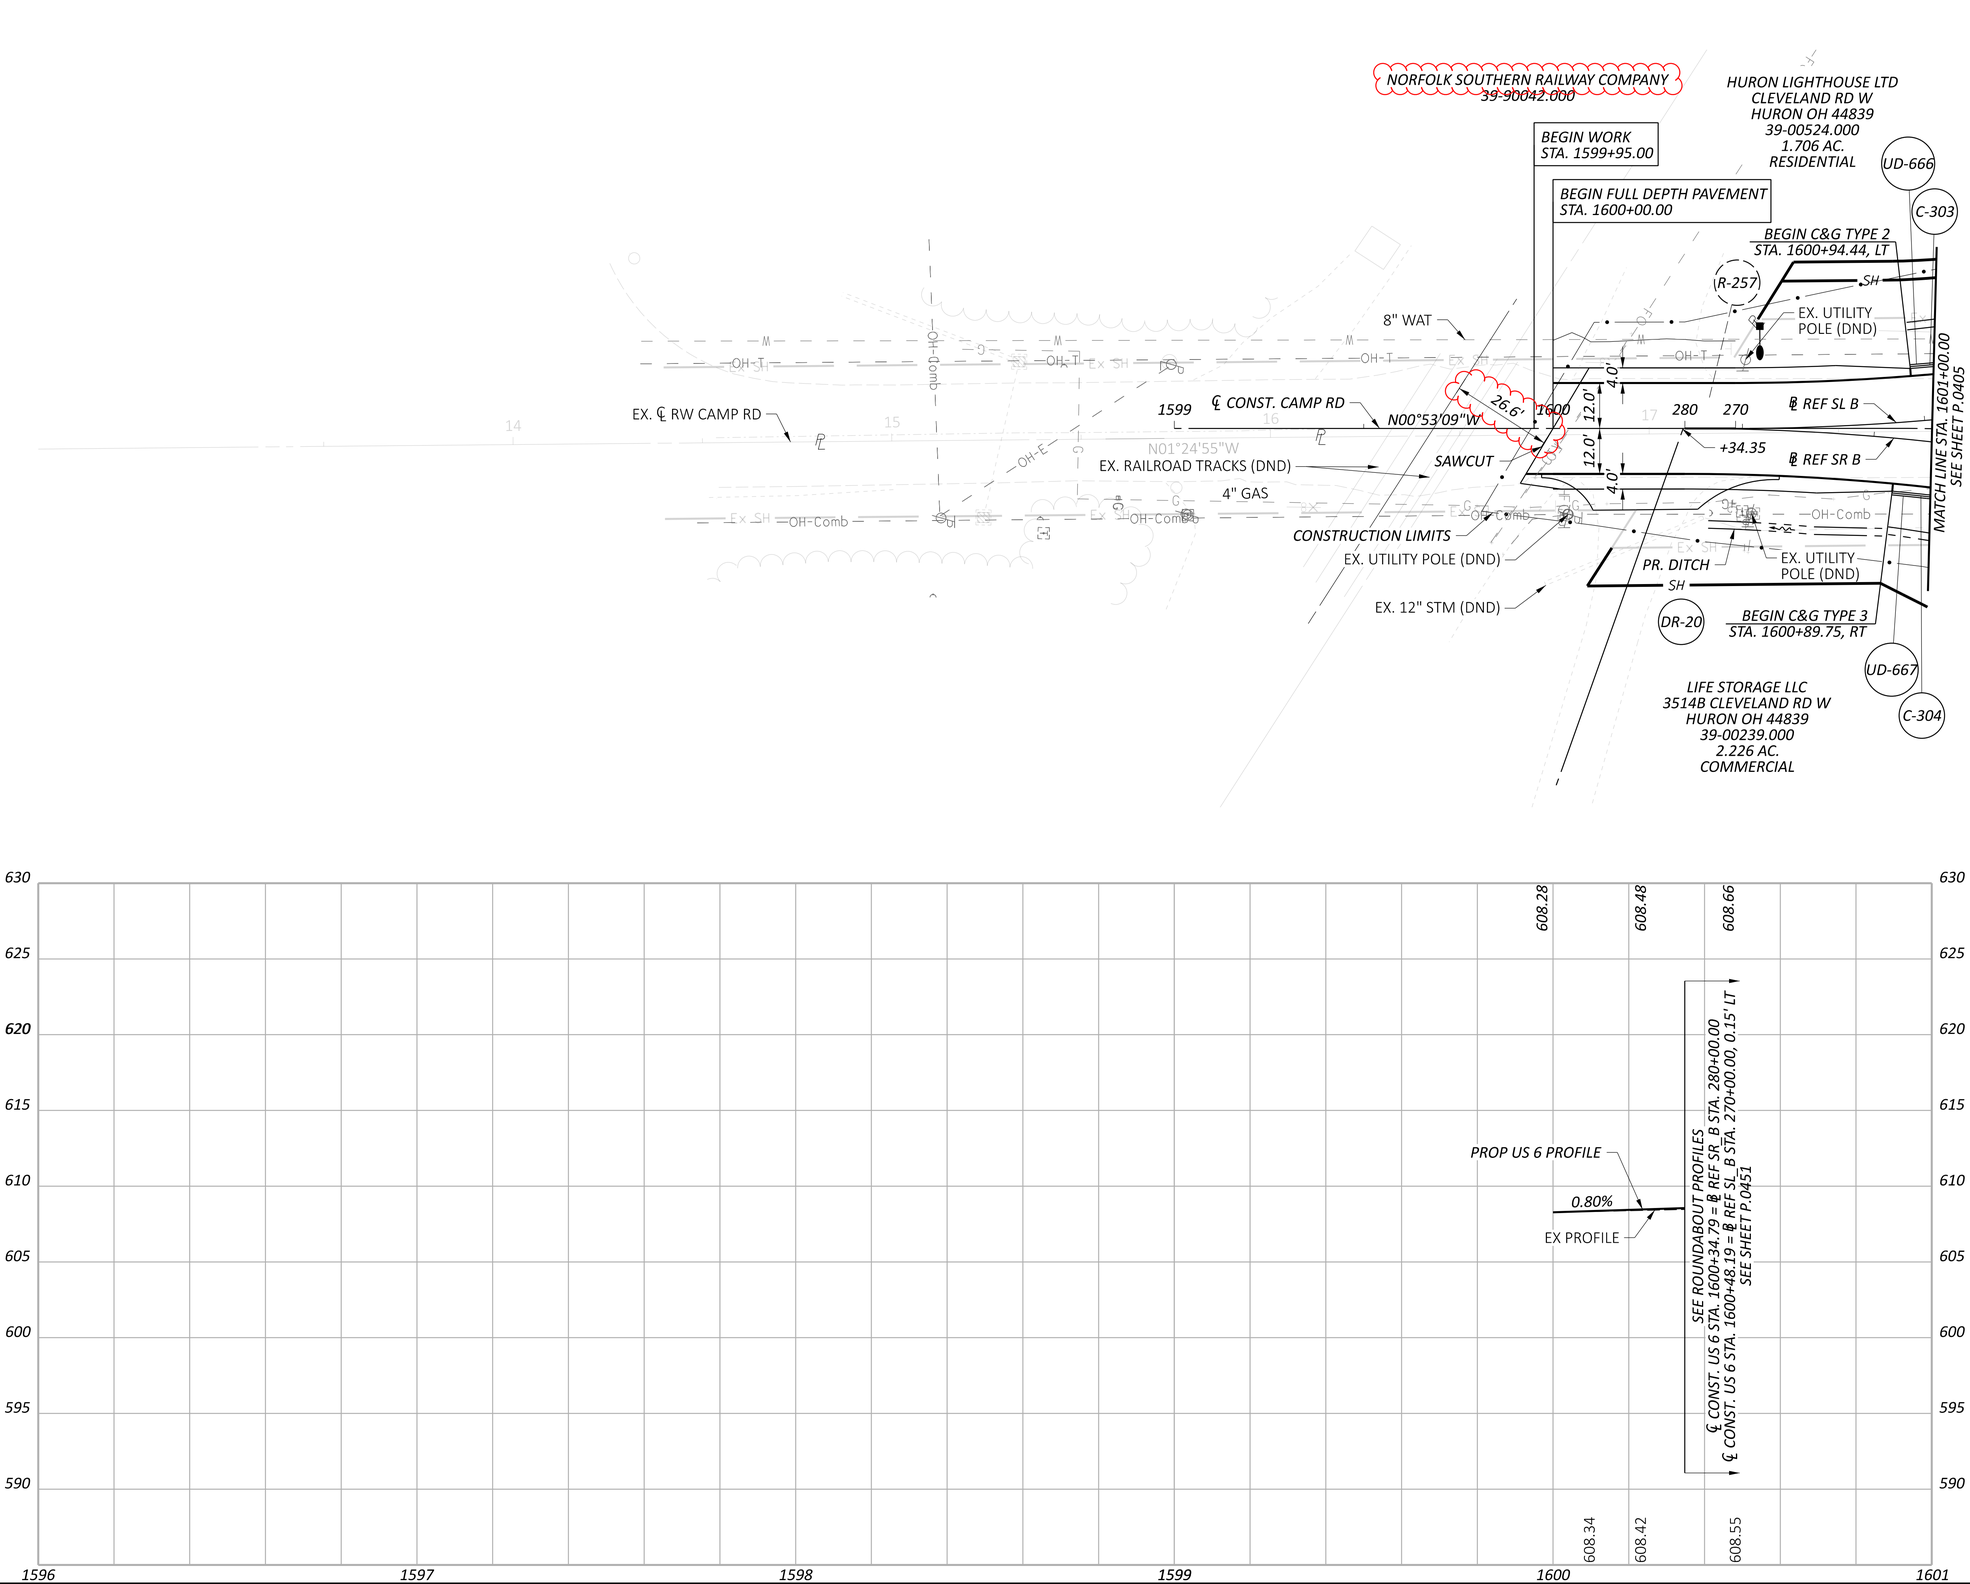

HORIZONTAL
SCALE IN FEET
0 10 20 40

PLAN AND PROFILE - CAMP RD
BEGIN TO STA. 1601+00.00

DESIGN AGENCY
OHM

DESIGNER	CLD
REVIEWER	SEO 10/27/25
PROJECT ID	116570
SHEET	P.0423
TOTAL	1106

AREA TO BE DESIGNED AND CONSTRUCTED BY NORFOLK SOUTHERN RAILWAY COMPANY

CURVE DATA CP-1
P.I. = STA. 35+45.56
Δ = 10°39'36" LT
Dc = 28°38'52"
R = 200.00'
T = 18.66'
L = 37.21'
E = 0.87'
e_{MAX} = NC
PC = STA. 34+60.37
PT = STA. 35+08.98

CURVE DATA CP-2
P.I. = STA. 36+06.45
Δ = 09°53'40" RT
Dc = 57°17'45"
R = 100.00'
T = 8.66'
L = 17.27'
E = .37'
e_{MAX} = .026
PC = STA. 36+01.80
PT = STA. 36+59.31

EX TREE (DND) ×5
Ex U
Ex SH
FO
MATCH LINE STA. 128+50.00
EX ℄ ROW & ℄ CONST. RYE BEACH ROAD
UD-183
HURON TOWNSHIP
CITY OF HURON
129
130
131
6"
4"
8"
22.1'±
23'±
10'
EX. FH (TBRL)
EX. WV (TBRL)
℄ CONST RYE BEACH ROAD SUP
33
34
35
Ex R/W
SH
CONSTRUCTION LIMITS
PC STA. 35+26.90
PT STA. 35+64.11
R-881
CP-1
CP-2
11'±
36
N12°26'54"W
EX. WV (ATG)
PC STA. 36+97.79
PT STA. 36+15.06
DR-93A
NCR-538
15'
N02°33'14"W
PI STA. 132+24.82
BEGIN C&G, TYPE 2
STA. 132+43.33
EX. WARNING DEVICE
132 (TBRO)
+54.98
C-564
4.25'
UD-183A
CONSTRUCTION LIMITS
PROP. WARNING DEVICE. SEE NOTE
END C&G, TYPE 2
STA. 132+68.33
STA. 36+69.79
OFF. 10.00' LT.
ELEV. 604.74
NORFOLK SOUTHERN RAILWAY COMPANY
PI STA. 36+89.00
133
22.0'
19.7'
8.5'
12.2'
14.7'
17.8'
37
4.8'
STA. 37+07.48
OFF. 10.00' LT.
ELEV. 604.64
MATCH LINE STA. 133+50.00
N02°40'56"W
R-883
EX. WARNING DEVICE (DND)
CONSTRUCTION LIMITS
12.0'
38.2'
STA. 36+63.06
OFF. 0.00' LT.
ELEV. 605.00
SUSPEND WORK
STA. 36+63.45
NCR-539
STA. 37+01.29
OFF. 0.00' RT.
ELEV. 604.74
RESUME WORK
STA. 37+01.70
UD-184
STA. 32+32.58
OFF. 33.27' RT.

NOTE:
WARNING DEVICE TO BE REMOVED AND RELOCATED BY NORFOLK SOUTHERN RAILWAY COMPANY

CURVE DATA CP-3
P.I. = STA. 41+29.53
Δ = 06°44'24" RT
Dc = 49°49'21"
R = 115.00'
T = 6.77'
L = 13.53'
E = .2'
e_{MAX} = NC
PC = STA. 41+25.08
PT = STA. 41+33.13

CURVE DATA CP-4
P.I. = STA. 41+63.32
Δ = 08°23'12" LT
Dc = 49°49'21"
R = 115.00'
T = 8.43'
L = 16.83'
E = 0.31'
e_{MAX} = NC
PC = STA. 41+57.34
PT = STA. 41+79.03

CURVE DATA CP-5
P.I. = STA. 42+22.42
Δ = 04°12'03" LT
Dc = 49°49'21"
R = 115.00'
T = 4.22'
L = 8.43'
E = 0.08'
e_{MAX} = NC
PC = STA. 42+20.69
PT = STA. 42+29.12

CURVE DATA CP-6
P.I. = STA. 42+50.92
Δ = 02°49'37" RT
Dc = 49°49'21"
R = 115.00'
T = 2.84'
L = 5.67'
E = .04'
e_{MAX} = NC
PC = STA. 42+48.17
PT = STA. 42+53.85

EX WV (DND)
EX. CB (DND)
12" PVC (DND)
EX. STORM CB
EX ℄ ROW RYE BEACH ROAD
EX FH (DND)
15" PVC (DND)
℄ CONST RYE BEACH ROAD
8"
4"
PI STA. 137+02.72
12" PVC (DND)
EX. CB (DND)
12" RCP (DND)
BEGIN C&G, TYPE 2
STA. 137+64.43
+90.73
END C&G, TYPE 2
STA. 138+17.27
MATCH LINE STA. 133+50.00
MATCH LINE STA. 138+50.00
SEE SHEET P.0431
134
135
136
137
138
HURON TOWNSHIP
CITY OF HURON
CONST. LIMITS
PI STA. 37+87.85
PI STA. 38+33.85
PI STA. 38+98.26
PI STA. 39+86.92
PI STA. 40+13.12
PI STA. 40+73.46
PI STA. 41+31.94
PI STA. 41+77.84
PI STA. 42+19.51
PI STA. 42+27.94
PI STA. 43+00.72
3'
7.8'
10'
38
39
40
41
42
N02°38'49"W
N04°05'55"E
N01°11'47"W
N01°13'47"E
N01°57'14"E
N00°55'13"W
N09°39'27"E
N01°09'03"W
N04°39'40"W
EX FH (ATG)
EX WV (ATG)
EX WATER METER (DND)
UD-184
R-883
R-884
R-885
R-686
NCR-540
NCR-541
R-701
R-688
CP-6
R-690
MB-559
C-565
R-687
CP-3
CP-4
UD-185
R-689
DR-93
CP-5
SAWMILL PARKWAY
TMP
47.1'
STA. 137+90.73
OFF. 48.34' RT.
12" HDPE (DND)
6" PVC (DND)
EX TREE (DND)

HORIZONTAL SCALE IN FEET
0 10 20 40

PLAN - RYE BEACH ROAD SUP
RYE BEACH RD. STA. 128+50.00 TO STA. 138+50.00


DESIGN AGENCY
TRANSYSTEMS
400 W. NATIONWIDE BLVD., STE 225
COLUMBUS, OHIO 43215


DESIGNER	TK
REVIEWER	GHM 10/27/25
PROJECT ID	116570
SHEET	P.0425
TOTAL	1106

ERI-US 0006-CONNECTIVITY CORRIDOR

MODEL: CLP_RyeBeach5 - Plan 2 [Sheet] PAPERSIZE: 34x22 (in.) DATE: 2/26/2026 TIME: 12:32:01 PM PLTDRV: OHDOT_PDF.pltcfg PENTBL: OHDOT_Pen.tbl USER: jcolon@gftinc.com WORKSPACE: OHDOTCtv02 WORKSET: 116570 PRODUCT: OpenRoadsDesigner 24.00.00.205
pw:\\ohiodot-pw.bentley.com:ohiodot-pw-02\Documents\01 Active Projects\District 03\Erie\116570\402-Engineering_TranSystems\Roadway\Sheets\116570_GP005.dgn

MODEL: CLK_RW_ORIG_US006 - Plan 1 [Sheet] PAPERSIZE: 34x22 (in.) DATE: 2/26/2026 TIME: 10:13:44 AM PLTDRV: OHDOT_PDF_Levels.pltcfg PENTBL: OHDOT_Pen.tbl USER: Brennon.Cain@ohm-advisors.com WORKSPACE: OHDOTCEv02 WORKSET: 116570 PRODUCT: OpenRoadsDesigner 24.00.00.205
pw:\\ohiodot-pw.bentley.com:ohiodot-pw-02\Documents\01 Active Projects\District 03\Erie\116570\403-Engineering_OHMAdvisors\Roadway\Sheets\116570_GP202.dgn

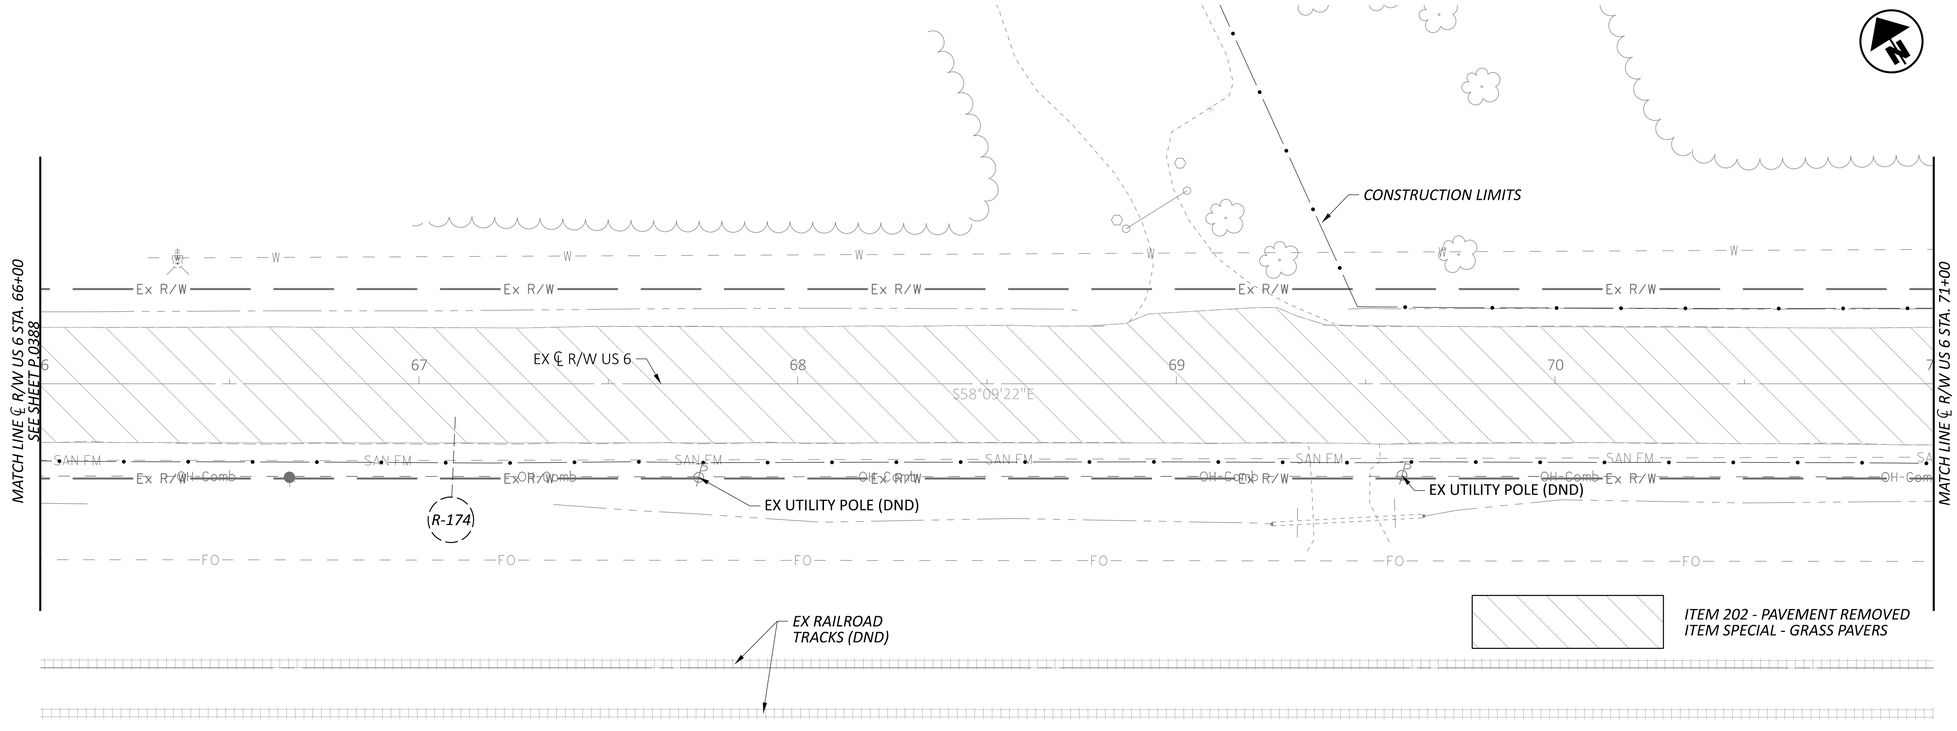

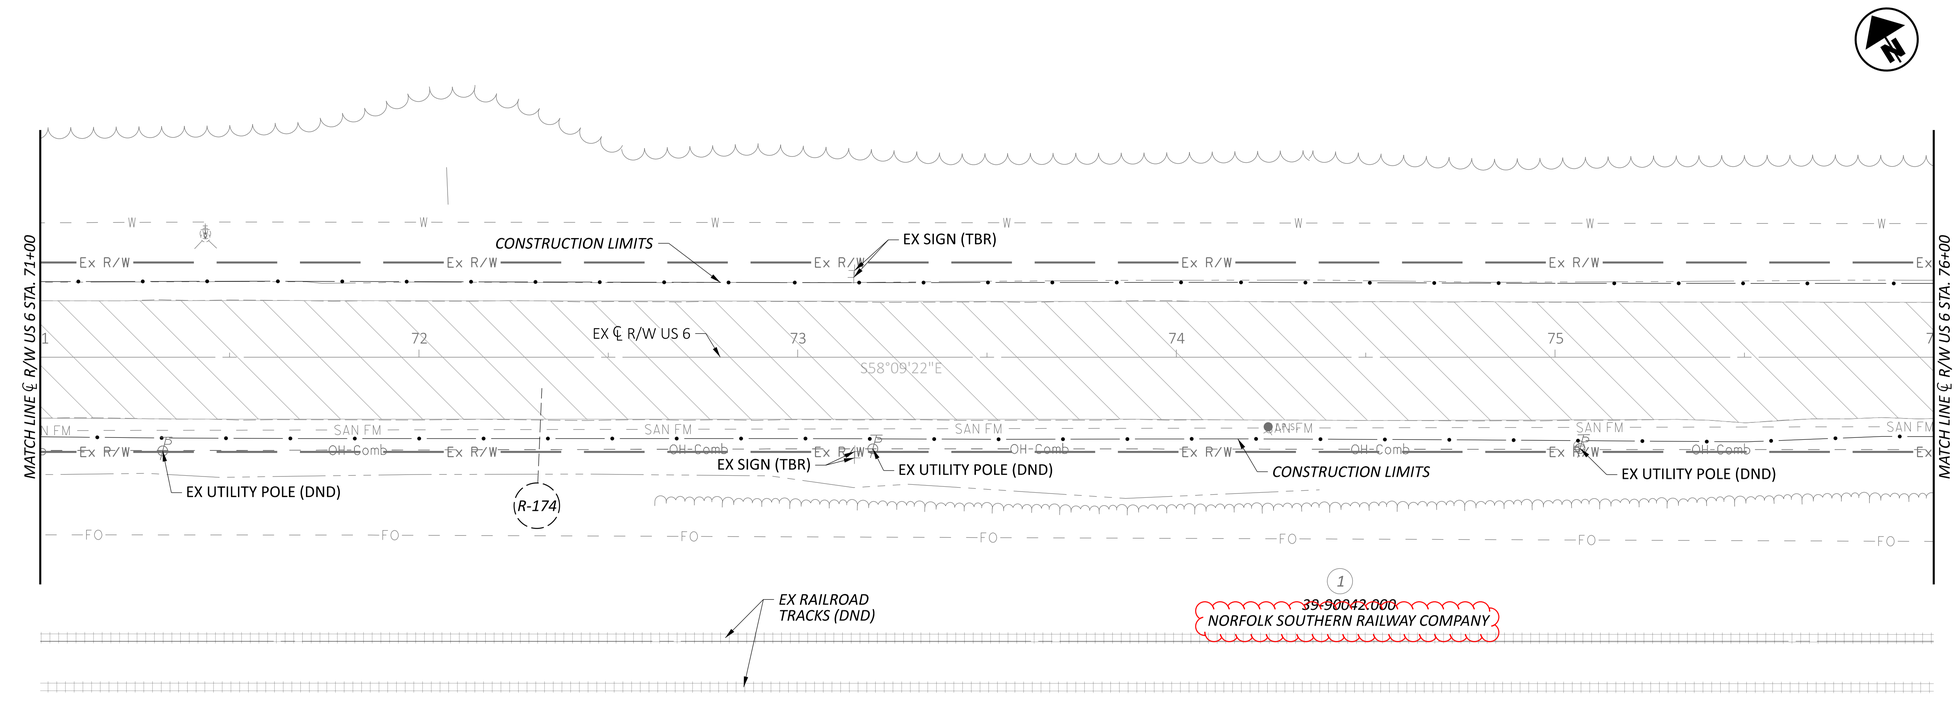


HORIZONTAL SCALE IN FEET
0 10 20 40

PAVEMENT REMOVAL PLAN
STA. 66+00.00 TO STA. 76+00.00

DESIGN AGENCY
OHM

DESIGNER	CLD
REVIEWER	SEO 10/27/25
PROJECT ID	116570
SHEET	P.0461
TOTAL	1106

MODEL: CLX_RW_ORIG_US006 - Plan 3 [Sheet] PAPERSIZE: 34x22 (in.) DATE: 2/26/2026 TIME: 10:13:46 AM PLTDRV: OHDOT_PDF_Levels.pltcfg PENTBL: OHDOT_Pen.tbl USER: Brennon.Cain@ohm-advisors.com WORKSPACE: OHDOTCEv02 WORKSET: 116570 PRODUCT: OpenRoadsDesigner 24.00.00.205
pw:\\ohiodot-pw.bentley.com:ohiodot-pw-02\Documents\01 Active Projects\District 03\Erie\116570\403-Engineering_OHMAdvisors\Roadway\Sheets\116570_GP202.dgn

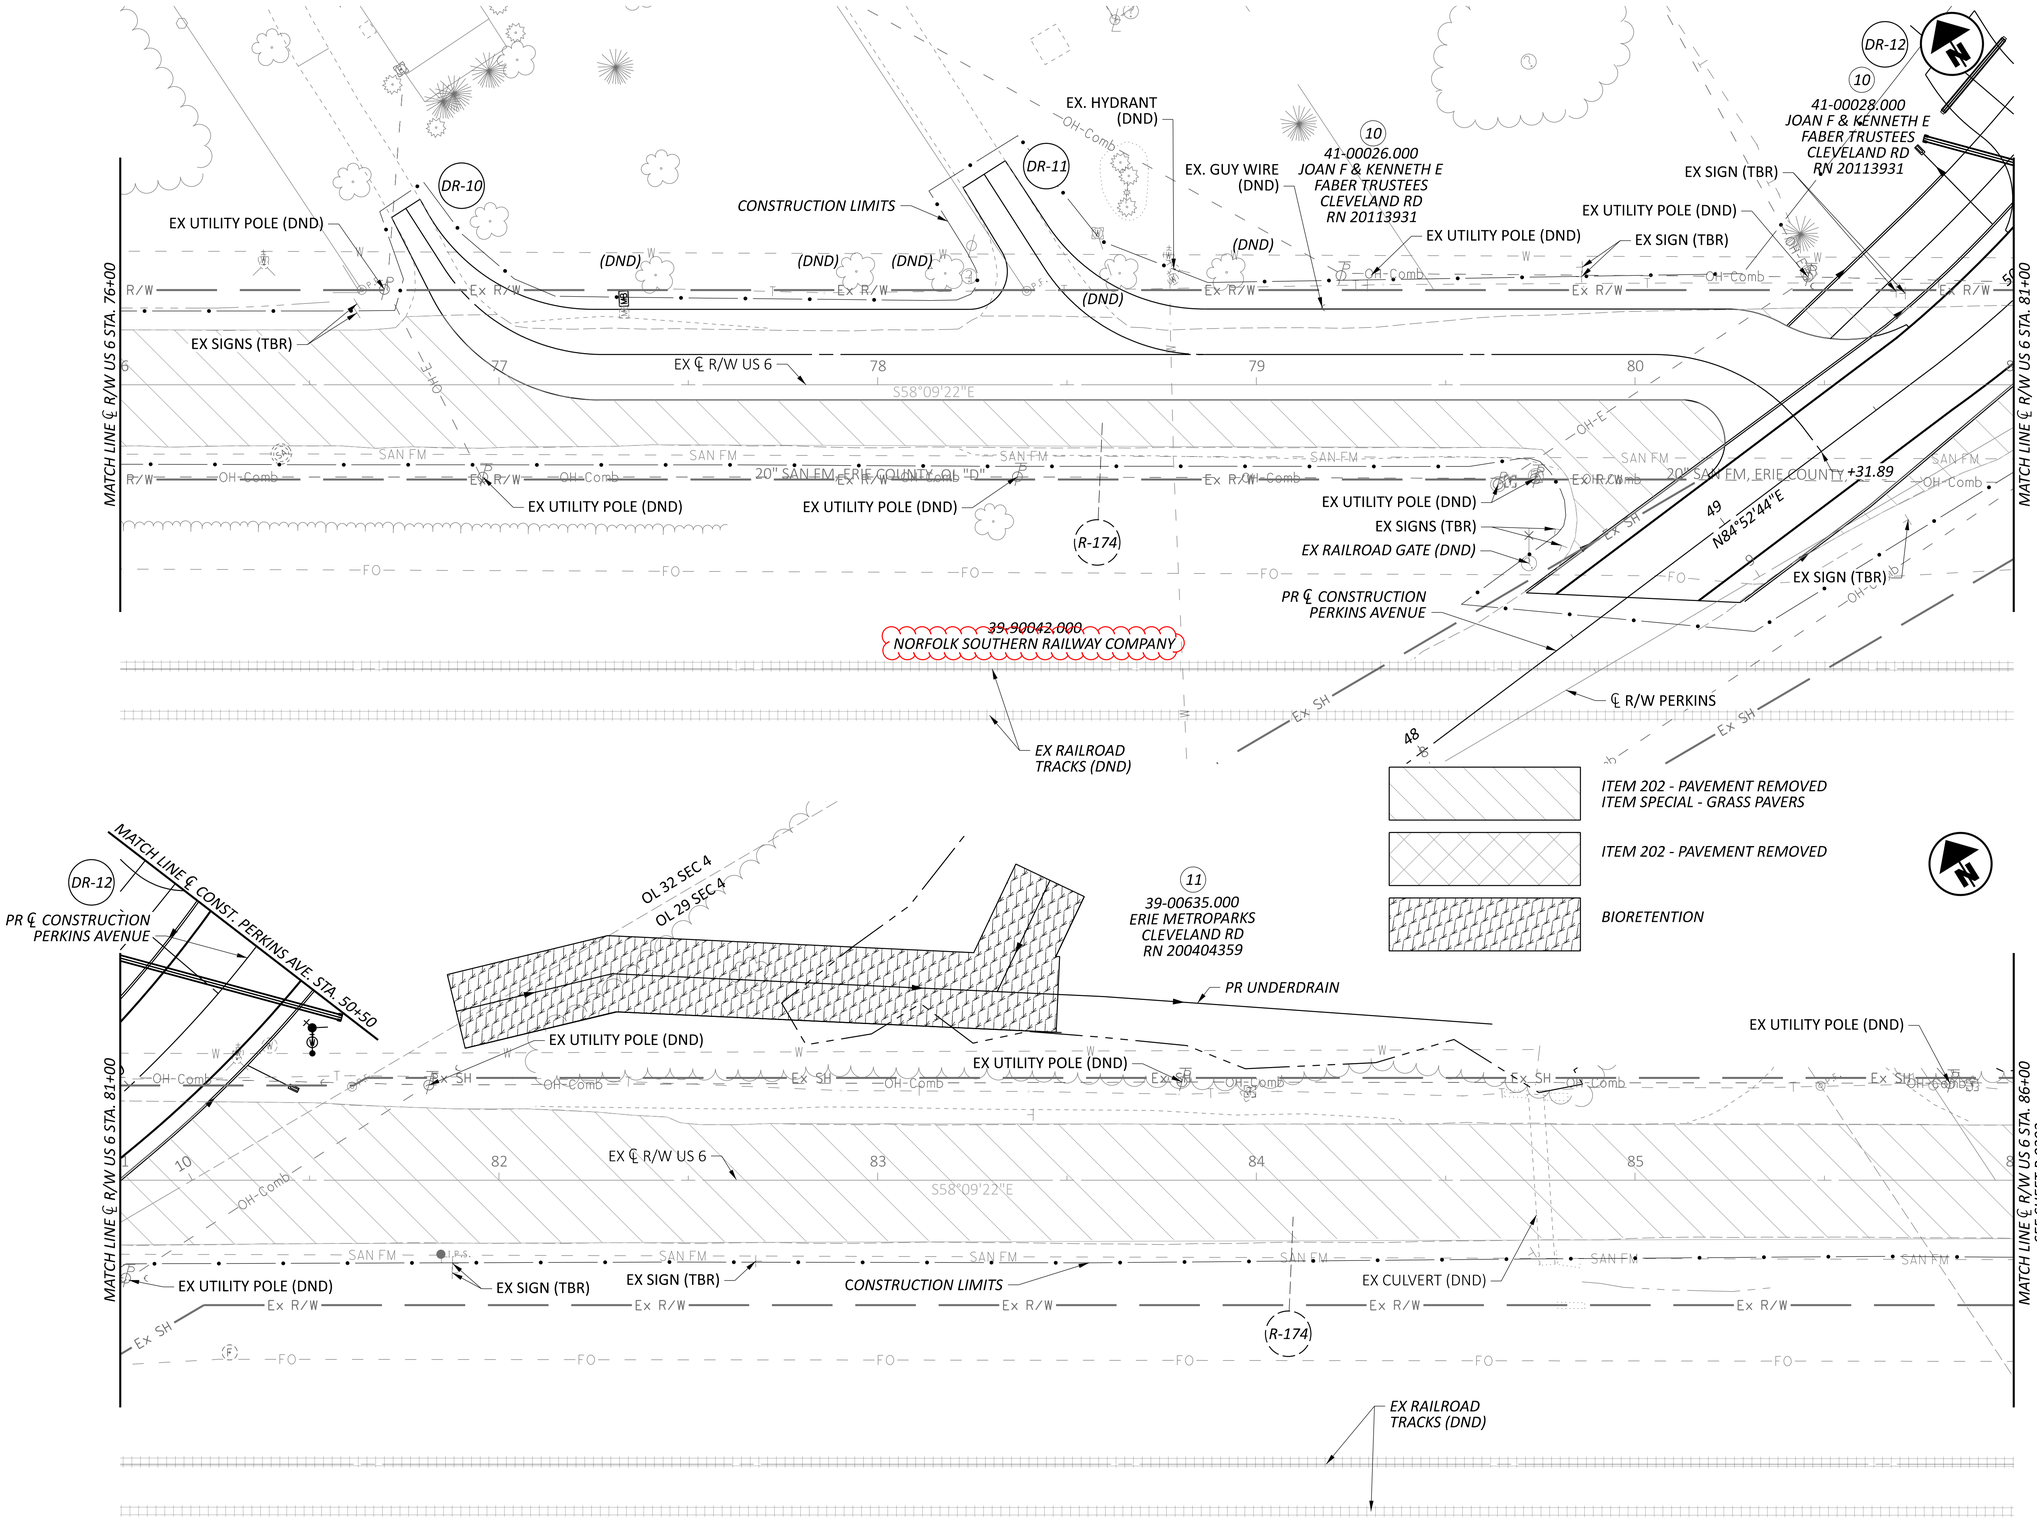

HORIZONTAL SCALE IN FEET
0 10 20 40

PAVEMENT REMOVAL PLAN
STA. 76+00.00 TO STA. 86+00.00

DESIGN AGENCY
OHM

DESIGNER	CLD
REVIEWER	SEO 10/27/25
PROJECT ID	116570
SHEET	P.0462
TOTAL	1106

SHEET NO.	REFRENCE NO.	STATION	SIDE	DRIVE TYPE	PAVEMENT TYPE	PART.	MAILBOX APPROACH (I=Integrated, S=Separate)	DRIVE ANGLE	APRON LENGTH "L"	WIDTH "W"	R1 (LEFT SIDE RADII OF DRIVE LOOKING FROM CL)	R2 (RIGHT SIDE RADII OF DRIVE LOOKING FROM CL)	CADD GENERATED SURFACE AREA	204 SUBGRADE COMPACTION	304 AGGREGATE BASE	441 ASPHALT CONCRETE SURFACE COURSE, TYPE 1, 449 (DRIVEWAYS)	441 ASPHALT CONCRETE INTERMEDIATE COURSE, TYPE 2, 449 (DRIVEWAYS)	452 6" NON-REINFORCED CONCRETE PAVEMENT, CLASS QC 1P	452 8" NON-REINFORCED CONCRETE PAVEMENT, CLASS QC 1P
								DEG.	FT.	FT.	FT	FT.	SQ. FT.	SY	CY	CY	CY	SY	SY
P.0419	DR-85	1803+60.95	RT	COMMERCIAL	ASPH	01	NO	88.05	32.18	32.02	30	15	1241.2	137.9	30.6	4.8	6.7		
P.0419	DR-86	1803+74.80	LT	COMMERCIAL	ASPH	01	NO	89.04	15.50	30.54	15	15	821.5	91.3	20.3	3.2	4.4		
P.0419	DR-87A	1804+30.93	RT	COMMERCIAL	CONC	01	NO	89.26	27.04	23.67	20	25	1118.8	124.3					124.3
P.0419	DR-87B	1804+30.93	RT	COMMERCIAL	ASPH	01	NO	89.26	27.04	23.67	20	25	1635.8	181.8	40.4	6.3	8.8		
P.0419	DR-88	1805+33.48	LT	COMMERCIAL	ASPH	01	NO	90.00	20.00	37.00	15	15	798.1	88.7	19.7	3.1	4.3		
P.0420	DR-89	1805+89.63	RT	COMMERCIAL	ASPH	01	NO	81.48	9.08	37.04	10	5	636.9	70.8	15.7	2.5	3.4		
P.0420	DR-90	1805+92.62	LT	COMMERCIAL	ASPH	01	NO	71.41	41.64	19.25	25	15	897.5	99.7	22.2	3.5	4.8		
P.0420	DR-91	1806+68.41	LT	COMMERCIAL	ASPH	01	NO	89.34	37.12	66.25	15	20	1482.8	164.8	36.6	5.7	8.0		
P.0421	DR-92	1810+68.15	LT	COMMERCIAL	ASPH	01	NO	83.52	8.72	78.85	10		900.9	100.1	22.2	3.5	4.9		
P.0421	DR-100	1811+58.76	RT	COMMERCIAL	ASPH	01	NO	89.50	20.25	54.26	10	10	847.4	94.2	20.9	3.3	4.6		
P.0425	DR-93A	132+54.98	RT	FIELD	AGGR	01	NO	56.04	32.23	14.54			386.8	43.0	9.6				
P.0425	DR-93	137+90.73	RT	COMMERCIAL	CONC	01	NO	90.00	20.99	47.09	10	10	743.6	82.6					82.6
P.0435	DR-94	158+04.53	RT	COMMERCIAL	ASPH	01	NO	82.44	52.16	30.12	25	10	3568.6	396.5	88.1	13.8	19.3		
P.0437	DR-95	161+98.86	RT	RESIDENTIAL	ASPH	01	NO	84.11	42.37	27.58	15	15	1252.9	139.2	23.2	7.7	6.8		
P.0437	DR-96	162+04.98	LT	COMMERCIAL	ASPH	01	NO	57.43	25.66	45.30	10	20	2637.1	293.0	65.1	10.2	14.2		
P.0437	DR-97	162+94.40	LT	COMMERCIAL	ASPH	01	NO	73.53	14.78	23.79	10	15	383.8	42.6	9.5	1.5	2.1		
P.0437	DR-98	163+05.70	RT	RESIDENTIAL	CONC	01	NO	85.34	29.83	34.92	15	15	962.8	107.0				107.0	
P.0437	DR-99	163+61.97	RT	RESIDENTIAL	AGGR	01	NO	85.03	19.99	9.8	15	15	245.2	27.2	6.1				
SPLIT. TOTALS FROM PREVIOUS SHEET																			
SUBTOTAL FOR PARTICIPATION 03/S50														2758.3	586.3	85.2	111.9	0.0	57.6
SPLIT. TOTALS FROM THIS SHEET																			
SUBTOTAL FOR PARTICIPATION 01/SAF														2284.6	430.2	68.9	92.4	107.0	206.9
TOTALS CARRIED TO GENERAL SUMMARY														5043	1016	154	204	107	265

DRIVE DETAILS SUBSUMMARY

ERI-US 0006-CONNECTIVITY CORRIDOR


DESIGN AGENCY
TRANSYSTEMS
400 W. NATIONWIDE BLVD., STE 225
COLUMBUS, OHIO 43215

DESIGNER: JIW
REVIEWER: GHM 10/27/25
PROJECT ID: 116570
SHEET: P.0768 | TOTAL: 1106


MODEL: Sheet 2 PAPERSIZE: 34x22 (in.) DATE: 2/25/2026 TIME: 3:39:27 PM PLTDRV: OHDOT_PDF.pltcfg PENTBL: OHDOT_Pen.tbl USER: jcolon@gftinc.com WORKSPACE: OHDOTCEv02 WORKSET: 116570 PRODUCT: OpenRoadsDesigner 24.00.00.205
pw:\\ohiodot-pw.bentley.com:ohiodot-pw-02\Documents\01 Active Projects\District 03\Erie\116570402-Engineering_TranSystems\Roadway\Sheets\116570_GD001.dgn




RYE BEACH ROAD STA 163+61.97 (RIGHT)

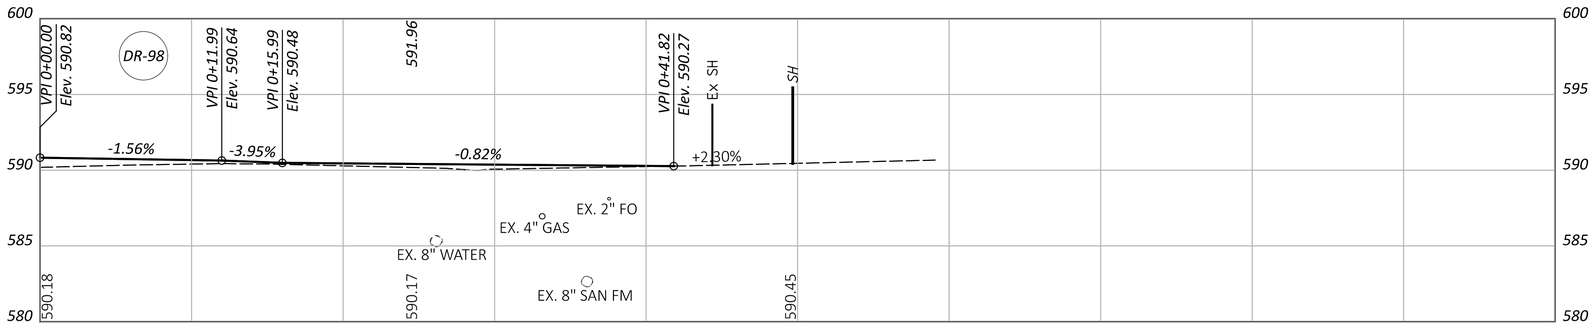

RYE BEACH ROAD STA 163+05.70 (RIGHT)

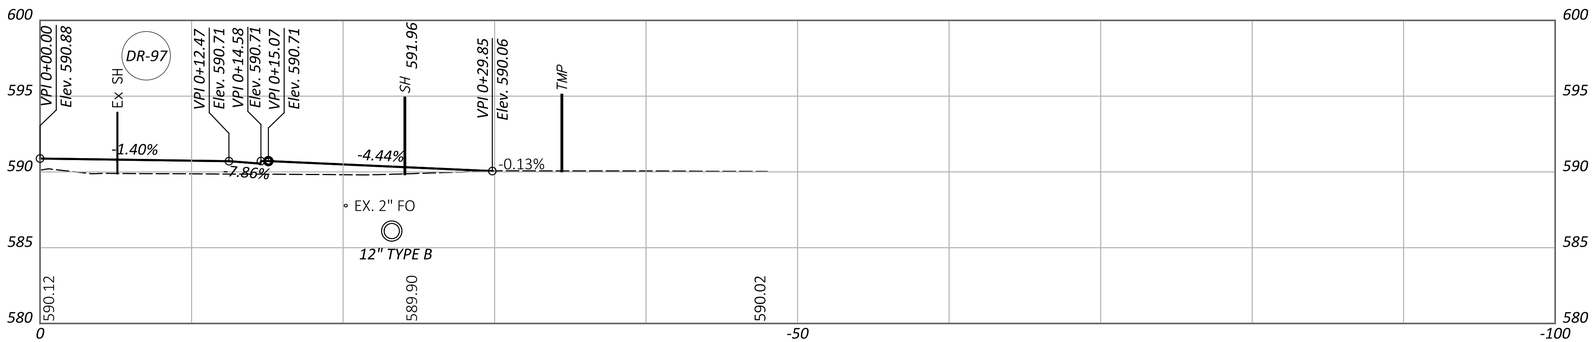

RYE BEACH ROAD STA 162+94.40 (LEFT)

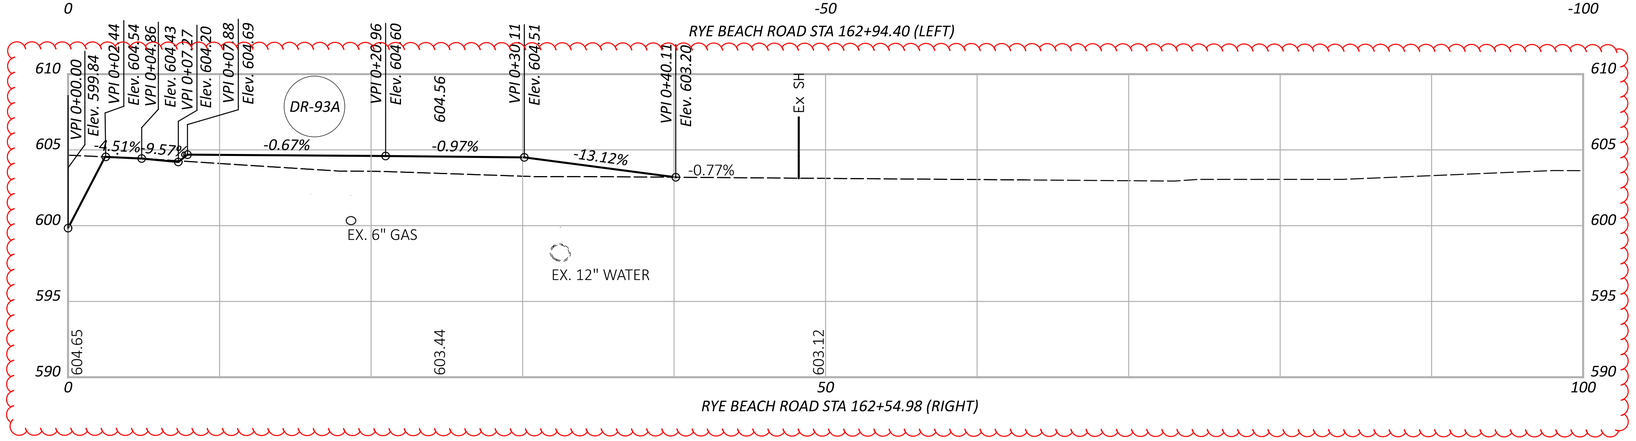

RYE BEACH ROAD STA 162+54.98 (RIGHT)

DRIVEWAY PROFILES
RYE BEACH ROAD

ERI-US 0006-CONNECTIVITY CORRIDOR

MODEL: CLP_Drive1 - DR-96 STA 162+04.98 LT [Sheet] PAPERSIZE: 34x22 (in.) DATE: 2/25/2026 TIME: 6:13:47 PM PLTDRV: OHDOT_PDF.pltcfg PENTBL: OHDOT_Pen.tbl USER: jcolon@gfinc.com WORKSPACE: OHDOTCEv02 WORKSET: 116570 PRODUCT: OpenRoadsDesigner 24.00.00.205
pw:\\ohiodot-pw.bentley.com:ohiodot-pw-02\Documents\01 Active Projects\District 03\Erie\116570\402-Engineering_TranSystems\Roadway\Sheets\116570_GF011.dgn
0_GF011.dgn

DESIGN AGENCY
TRANSYSTEMS
400 W. NATIONWIDE BLVD., STE 225
COLUMBUS, OHIO 43215

DESIGNER JIW


REVIEWER GHM 10/27/25

PROJECT ID 116570

SHEET P.0790 TOTAL 1106

MODEL: CLX_RW_US006A - Plan 13 |Sheet| PAPERSIZE: 34x22 (in.) DATE: 2/26/2026 TIME: 10:29:38 AM PLTDRV: OHDOT_PDF_Levels.pltcfg PENTBL: OHDOT_Pen.tbl USER: hrthornton@gftinc.com WORKSPACE: OHDOTCEv02 WORKSET: 116570 PRODUCT: OpenRoadsDesigner 24.00.02.25
pw:\\ohiodot-pw.bentley.com:ohiodot-pw-02\Documents\01 Active Projects\District 03\Erie\116570\402-Engineering_TranSystems\Lighting\Sheets\116570_LP001.dgn

ERI-US 0006-CONNECTIVITY CORRIDOR

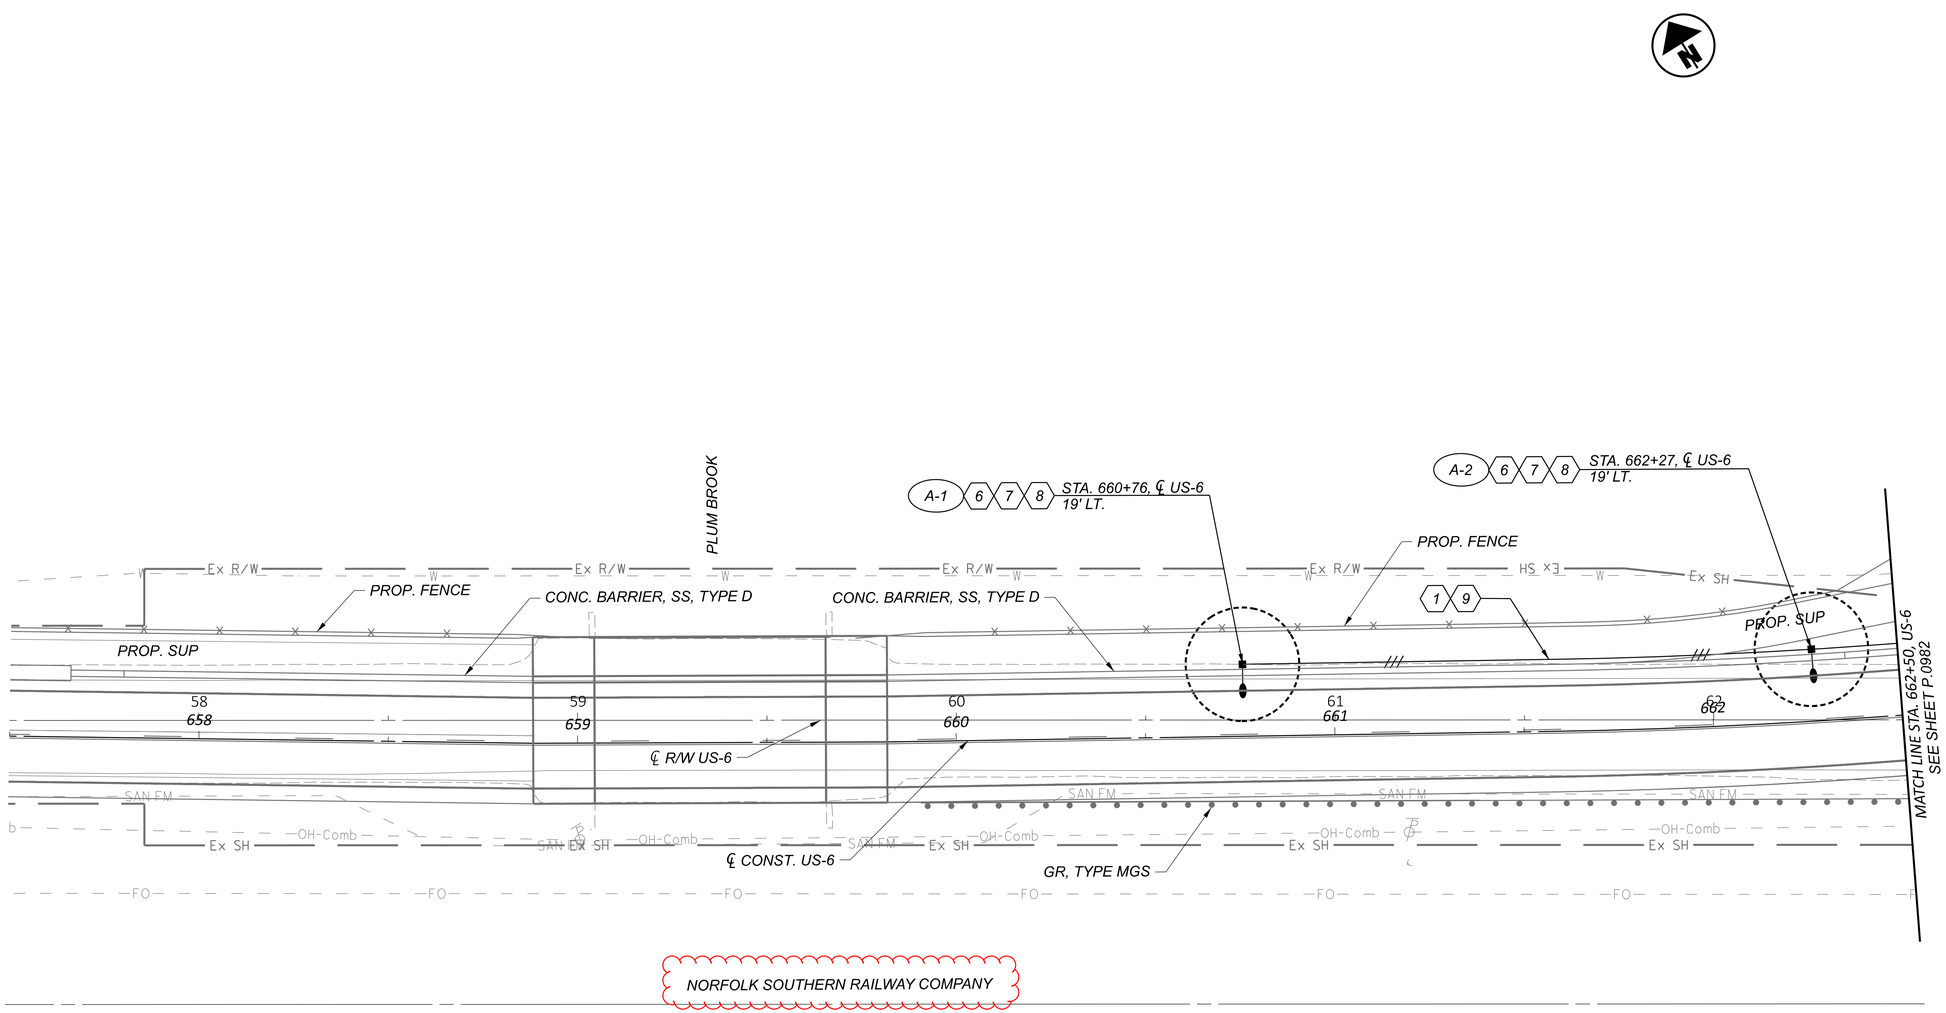

HORIZONTAL SCALE IN FEET
0 10 20 40

LIGHTING PLAN - US 6 (CLEVELAND RD W)
STA. 657+50.00 TO STA. 662+50.00

LEGEND

- AT10B30 LIGHT POLE W/ 10,000 - 24,000 LUMENS, TYPE III LED LUMINAIRE (LIGHT POLE DESIGN NUMBER PER SCD HL-10.11)
- XX-X STA. OFFSET
- PULL BOX, 725.08, 18", AS PER PLAN, UNLESS OTHERWISE NOTED
- PB PULL BOX IDENTIFICATION
- LA LIGHT POLE IDENTIFICATION
- CONDUIT, JACKED OR DRILLED (3", 725.04)
- CIRCUIT (3 WIRE, 2 CONDUCTOR, 120/240V, SINGLE PHASE) W/ GROUNDING CONDUCTOR
- POWER SERVICE & CONTROL CENTER
- POWER POLE
- TBRR TO BE REMOVED AND RELOCATED
- TBR TO BE REMOVED
- 15' RADIUS/CLEARANCE BUFFER TO EXISTING OVERHEAD UTILITY LINES(FOR INFORMATIONAL PURPOSE ONLY)

CODED NOTES

1. ITEM 625, CONDUIT, 725.04, 3"
2A. ITEM 625, PULL BOX, 725.08, 18"
2B. ITEM 625, PULL BOX, 725.08, 24"
3. ITEM 625, POWER SERVICE, AS PER PLAN, 120/240V
4. 3" CONDUIT, 725.04, JACKED OR DRILLED
5. CONTROL CENTER, COORDINATE WITH UTILITY COMPANY
6. ITEM 625, LUMINAIRE, CONVENTIONAL, SOLID STATE LED
7. ITEM 625, LIGHT POLE, CONVENTIONAL, 30', TRANSFORMER BASE
8. ITEM 625, LIGHT POLE FOUNDATION, 24" X 6' DEEP
9. ITEM 625, NO. 4 AWG 2400 VOLT DISTRIBUTION CABLE


NOTE:
OFFSETS TO LIGHT POLE ARE MEASURED FROM PROPOSED CENTERLINE UNLESS OTHERWISE INDICATED

DESIGN AGENCY
TRANSYSTEMS
400 W. NATIONWIDE BLVD., STE 225
COLUMBUS, OHIO 43215

DESIGNER SSA
REVIEWER SS 10/27/25
PROJECT ID 116570
SHEET P.0981 TOTAL 1106

MODEL: CLX_RW_US006A - Plan 14 [Sheet] PAPERSIZE: 34x22 (in.) DATE: 2/26/2026 TIME: 10:33:58 AM PLTDRV: OHDOT_PDF_Levels.plt(fg PENTBL: OHDOT_Pen.tbl USER: hrthornton@gftinc.com WORKSPACE: OHDOTCEv02 WORKSET: 116570 PRODUCT: OpenRoadsDesigner 24.00.02.25
pw:\\ohiodot-pw.bentley.com:ohiodot-pw-02\Documents\01 Active Projects\District 03\Erie\116570\402-Engineering_TranSystems\Lighting\Sheets\116570_LP001.dgn

ERI-US 0006-CONNECTIVITY CORRIDOR

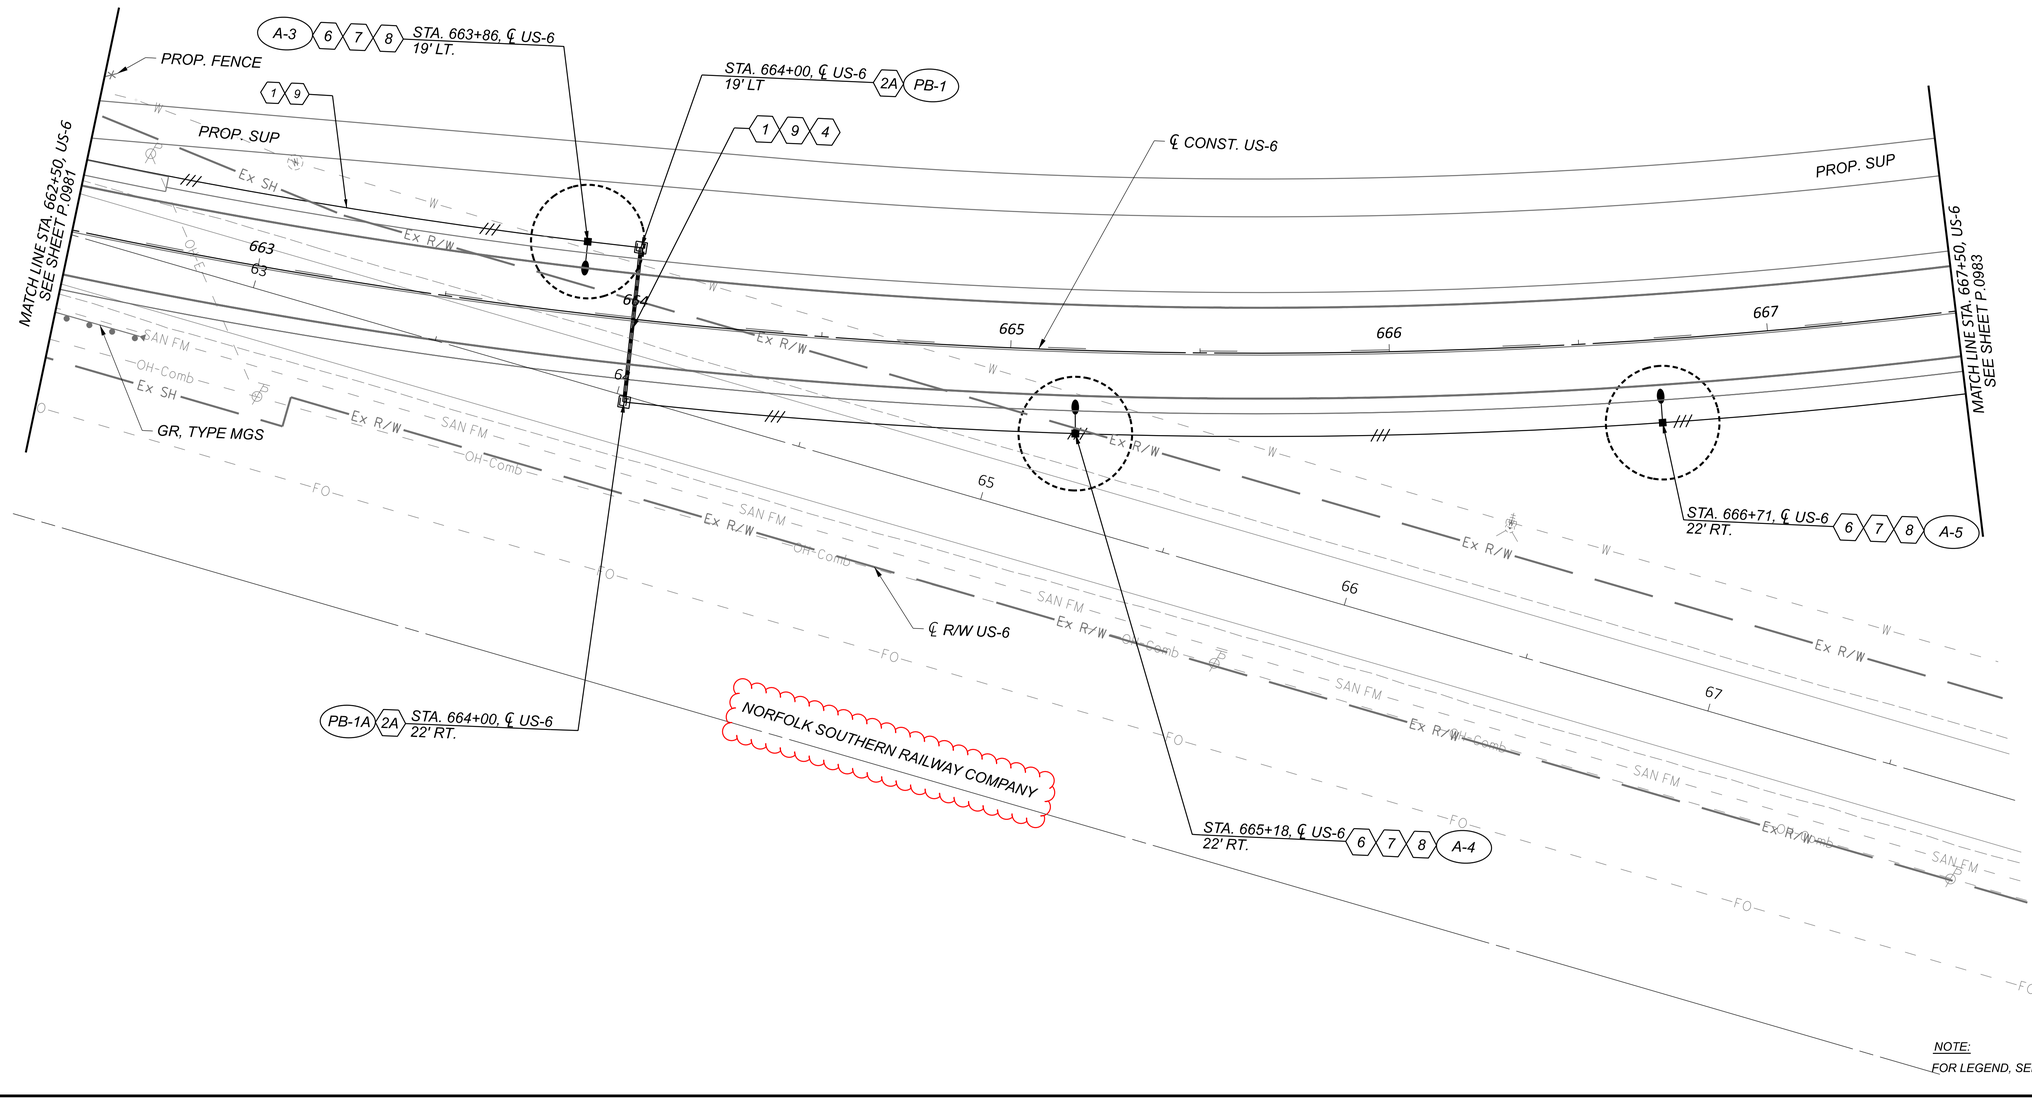

HORIZONTAL SCALE IN FEET
0 10 20 40

LIGHTING PLAN - US 6 (CLEVELAND RD W)
STA. 662+50.00 TO STA. 667+50.00

DESIGN AGENCY
TRANSYSTEMS
400 W. NATIONWIDE BLVD., STE 205
COLUMBUS, OHIO 43215

DESIGNER
SSA

REVIEWER
SS 10/27/25

PROJECT ID
116570

SHEET P.0982 | TOTAL 1106