


Neal Fauble

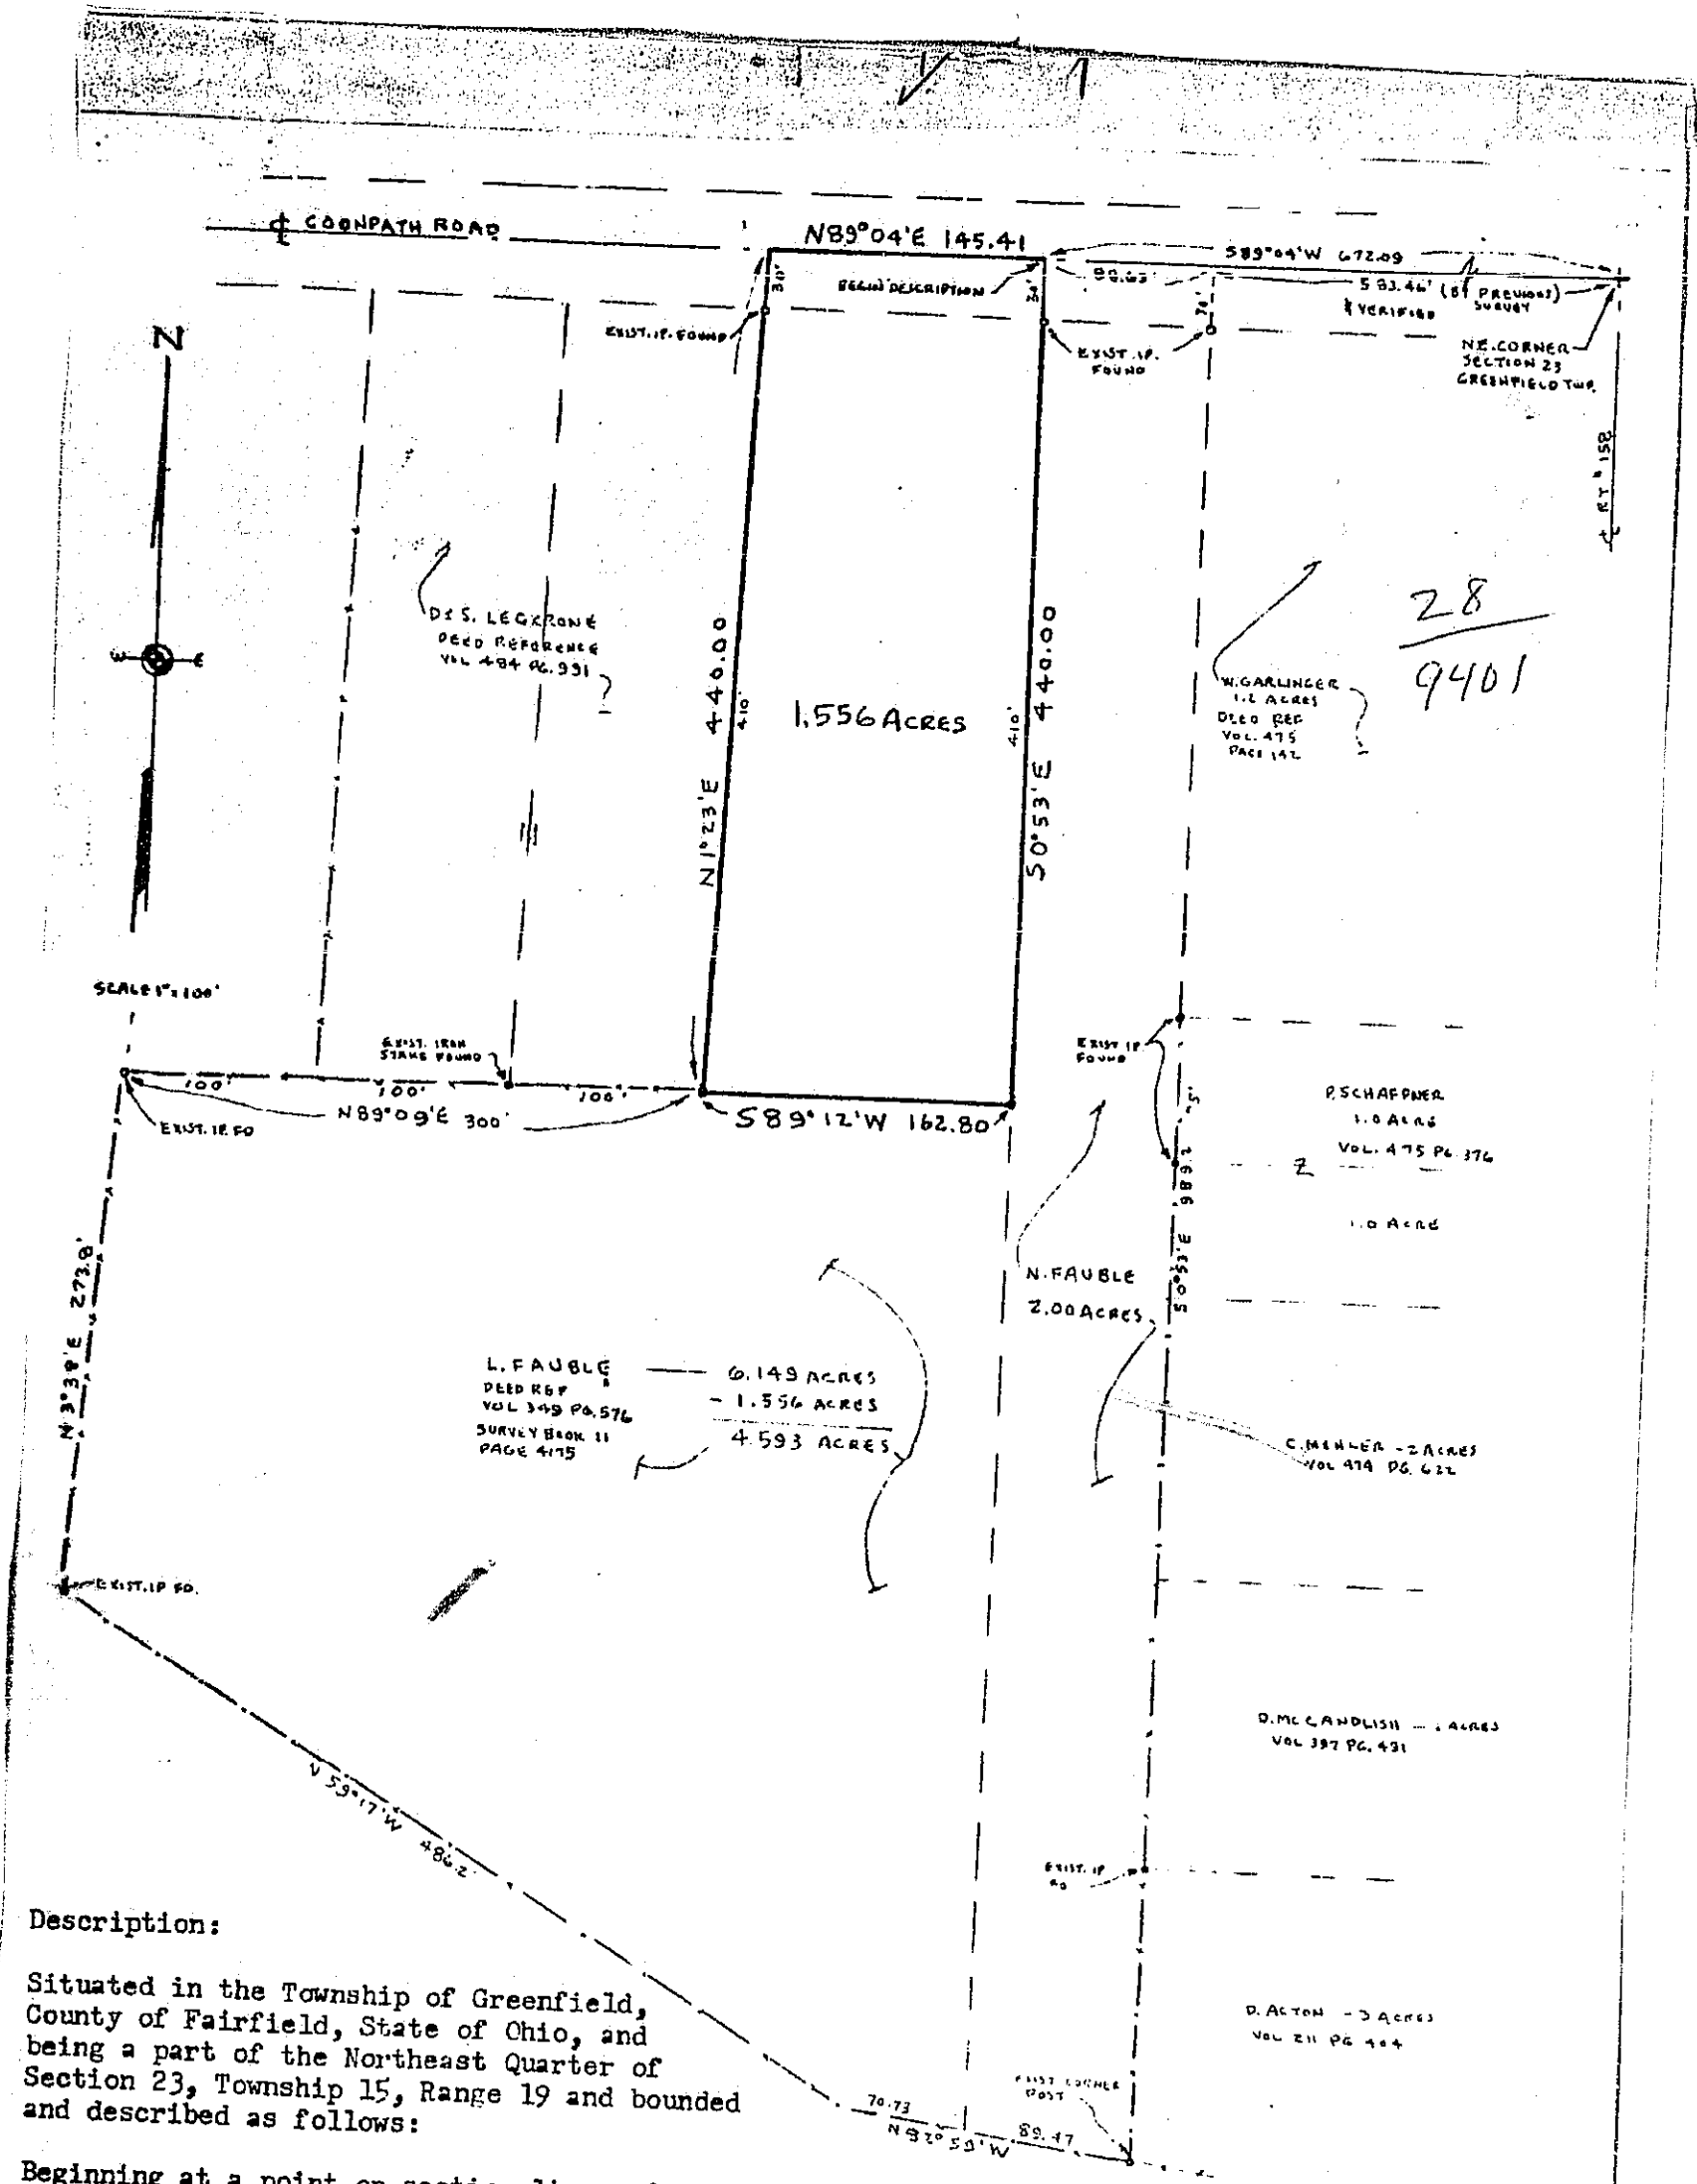


Description:
Situating in the Township of Greenfield,
County of Fairfield, State of Ohio, and
being a part of the Northeast Quarter of
Section 23, Township 15, Range 19 and bounded
and described as follows:

Beginning at a point on section line and in the center of Coonpath Road, said beginning point being (by previous survey) South 89°04' West 672.09 feet distant from the Northeast Corner of said Section 23; thence South 00°53' East 440.00 feet to an iron pipe (passing an iron pipe at 30.00 feet); thence South 89°12' West 162.80 feet to an iron pipe; thence North 1°23' East 440.00 feet to a point on section line and in the center of Coonpath Road (passing an iron pipe at 410.00 feet); thence with section line and the center of said Coonpath Road North 89°04' East 145.41 feet to the place of beginning containing 1.556 acres and subject to all legal rights-of-way and easements of record.

I do hereby certify that the plat shown hereon is correct as surveyed by me.

DATED: July 3, 1979
SIGNED: George A. Beiter
George A. Beiter
Registered Surveyor #5348
Baltimore, Ohio

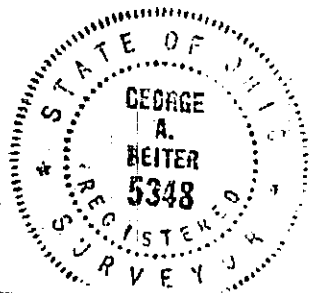

PLAT OF SURVEY
for
Neal & Glarabelle A. Fauble
in
Section 23 Greenfield Twp.
Fairfield County, Ohio