

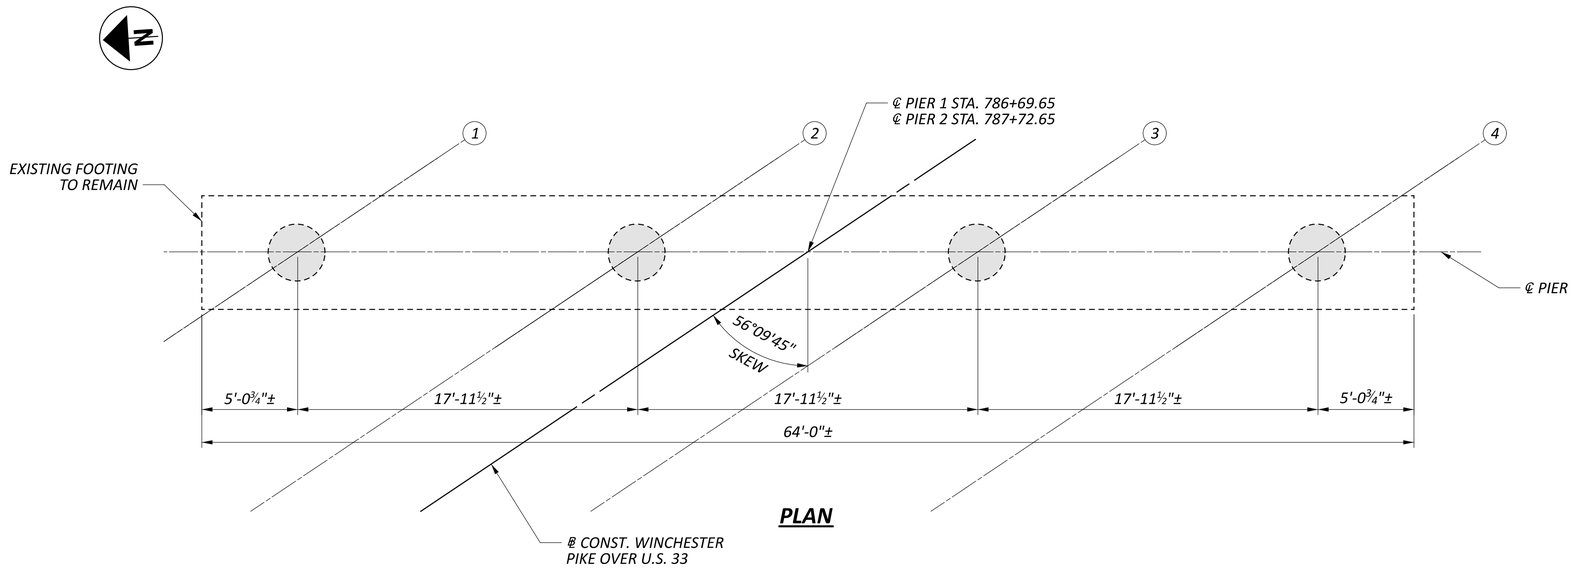



PLAN

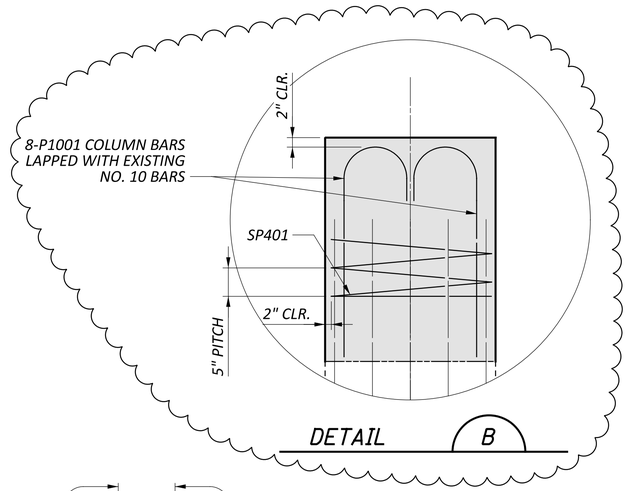

DETAIL B

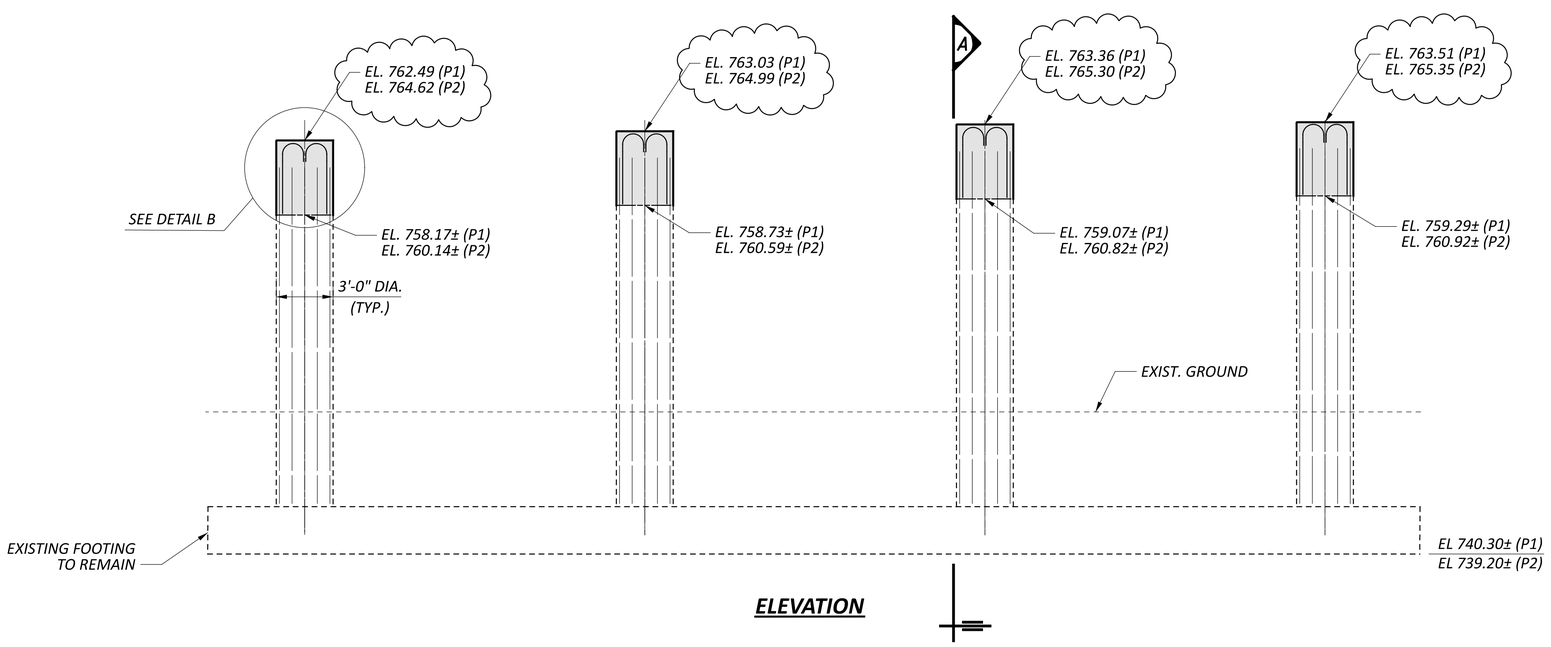

ELEVATION

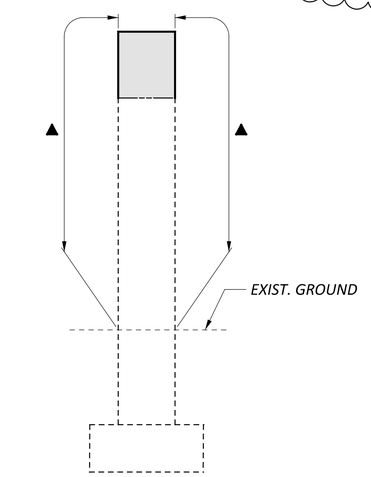

SECTION A

LEGEND:

▲ *INDICATES LIMITS OF ITEM 512 - SEALING OF CONCRETE SURFACES (EPOXY-URETHANE) (SEAL ALL AROUND EXISTING COLUMNS PLUS THE SIDES AND BOTTOMS OF THE NEW PIER CAPS). CONCRETE SEALER COLOR - FEDERAL COLOR STANDARD 17778 - LIGHT NATURAL*

PROPOSED PIER LIMITS

NOTE:

MINIMUM REINFORCING STEEL COMPRESSION LAP LENGTH: #10 BAR = 2'-5"

PROPOSED PIER DETAILS
BRIDGE NO. FRA-33-2276L
WINCHESTER PIKE OVER U.S. 33

SFN 2501805

DESIGN AGENCY

GPD GROUP

Copyright Glaus, Pyle, Schomer, Burns & DeHaven, Inc. 2022

DESIGNER	CHECKER
RSN	DJC

REVIEWER DGN 12/15/25

PROJECT ID 113744

SUBSET	TOTAL
12	29

SHEET	TOTAL
P.584	625

FRA-33-21.71

MODEL: Sheet View PAPERSIZE: 34x22 (in.) DATE: 11/11/2026 TIME: 3:21:50 PM USER: rng
O:\Public\OH\ODOT\2022\2022002\113744\400-Engineering\Structures\SFN_2501805\Sheets\113744_SFN_2501805_SI002.dgn

LAST REVISED: 11-12-26