WATER Plans

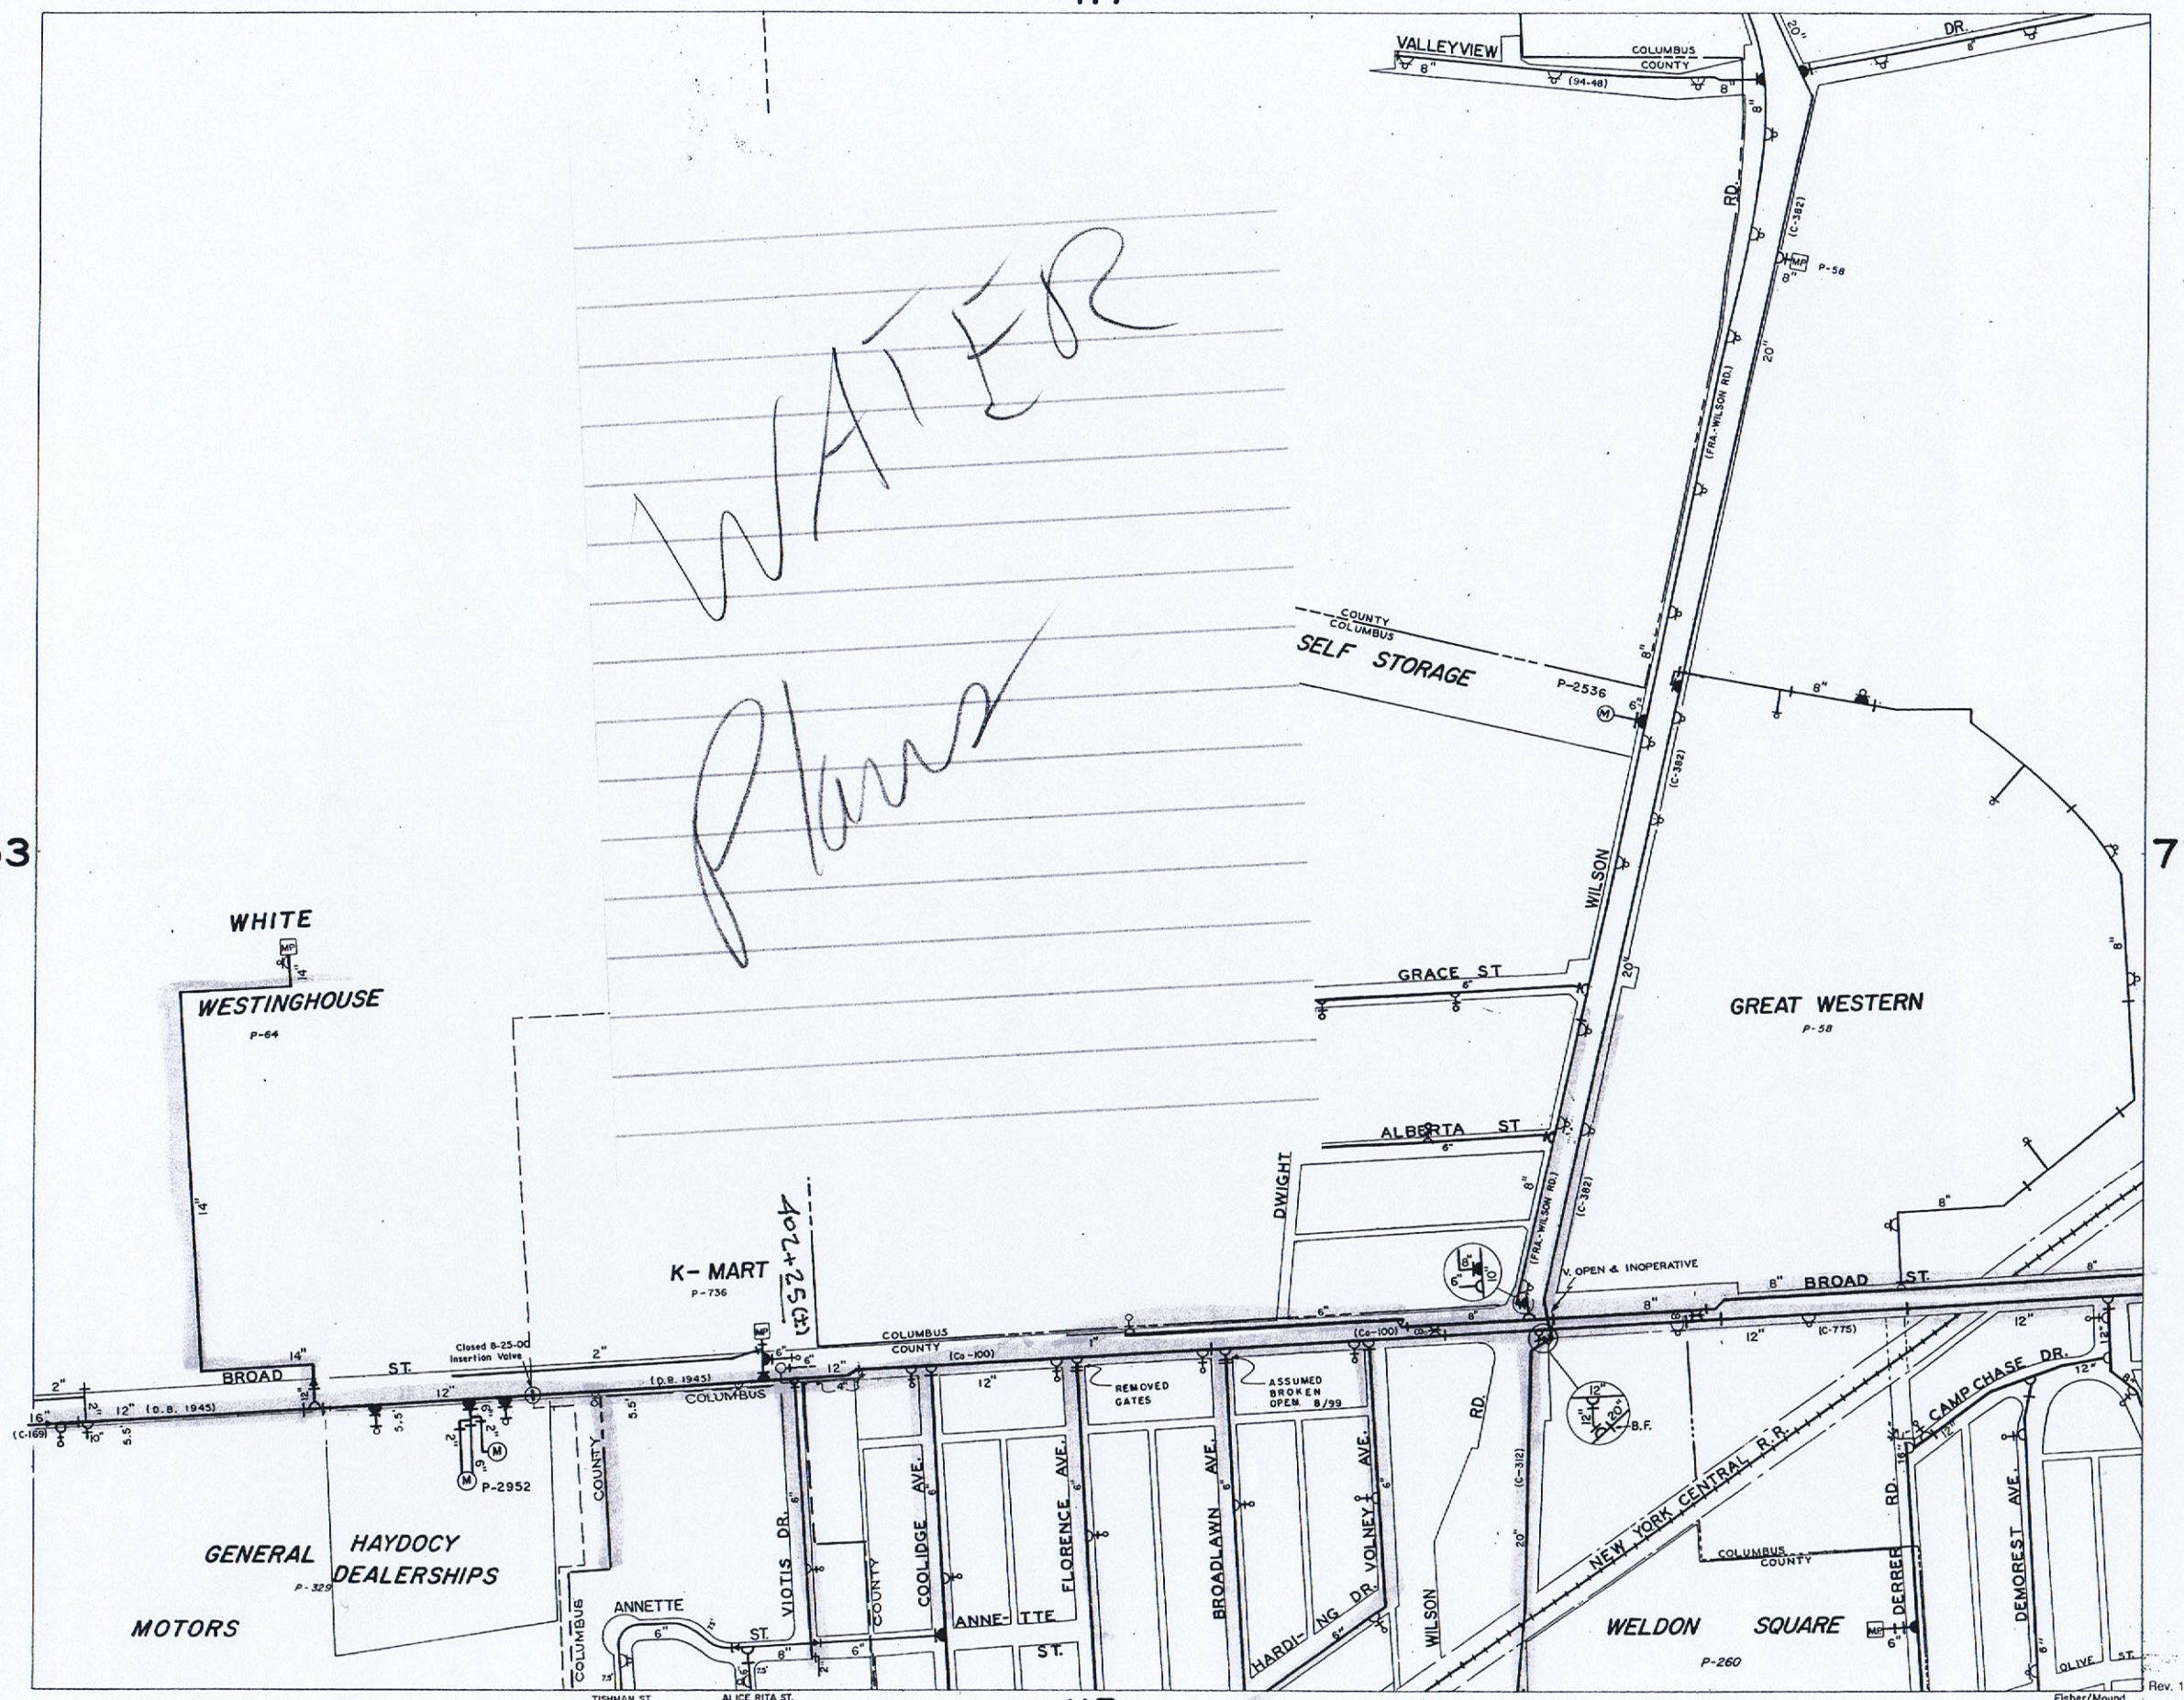
VALLEYVIEW
COLUMBUS COUNTY
(94-48)
DR.
RD.
(C-382)
P-58
(FRA.-WILSON RD.)
COUNTY COLUMBUS
SELF STORAGE
P-2536
WILSON
GRACE ST.
GREAT WESTERN
P-58
WHITE
WESTINGHOUSE
P-64
ALBERTA ST.
DWIGHT
K-MART
P-736
407+25 (±)
OPEN & INOPERATIVE
BROAD ST.
(C-775)
Closed 8-25-00 Insertion Valve
(D.B. 1943)
COLUMBUS COUNTY
(Co-100)
REMOVED GATES
ASSUMED BROKEN OPEN 8/99
B.F.
CAMP CHASE DR.
NEW YORK CENTRAL R.R.
P-2952
GENERAL MOTORS
HAYDOCY DEALERSHIPS
P-329
COLUMBUS COUNTY
ANNETTE ST.
VIOTIS DR.
COOLIDGE AVE.
FLORENCE AVE.
BROADLAWN AVE.
VOLNEY AVE.
HARDING DR.
(C-312)
WELDON SQUARE
P-260
DERBER RD.
DEMOREST AVE.
OLIVE ST.
TISHMAN ST.
ALICE RITA ST.
Fisher/Mound
Rev. 10/03

YARMOUTH LN.
WEYMOUTH LN.
CARILLA LN.
RD.
VILLAGE
OLD
BEACON HILL RD.
HALDY AVE.
AVE.
GREENER
GARDEN
HEIGHTS
INTERSTATE
270
JANITROL RD.
(N.R.-832)
(N.R.-707)
(N.R.-628)
(N.R.-628A)
(N.R.-628B)
(C-192)
8x6 R
PHILLIPI
SURFACE RD.
P-196
RESERVOIR
PUMPING STA.
Closed
BROAD ST.
(N.R.-950)
Easement
(No Record)
(N.R.448)
(N.R.698)
(N.R.779)
20" Vert. V.
By Pass V. East
(C-169)
BLOWOFF
WESTLAND SHOPPING CENTER
GEORGESVILLE RD.
(NR-863)
MIX AVE.
Fisher
Rev. 02/97

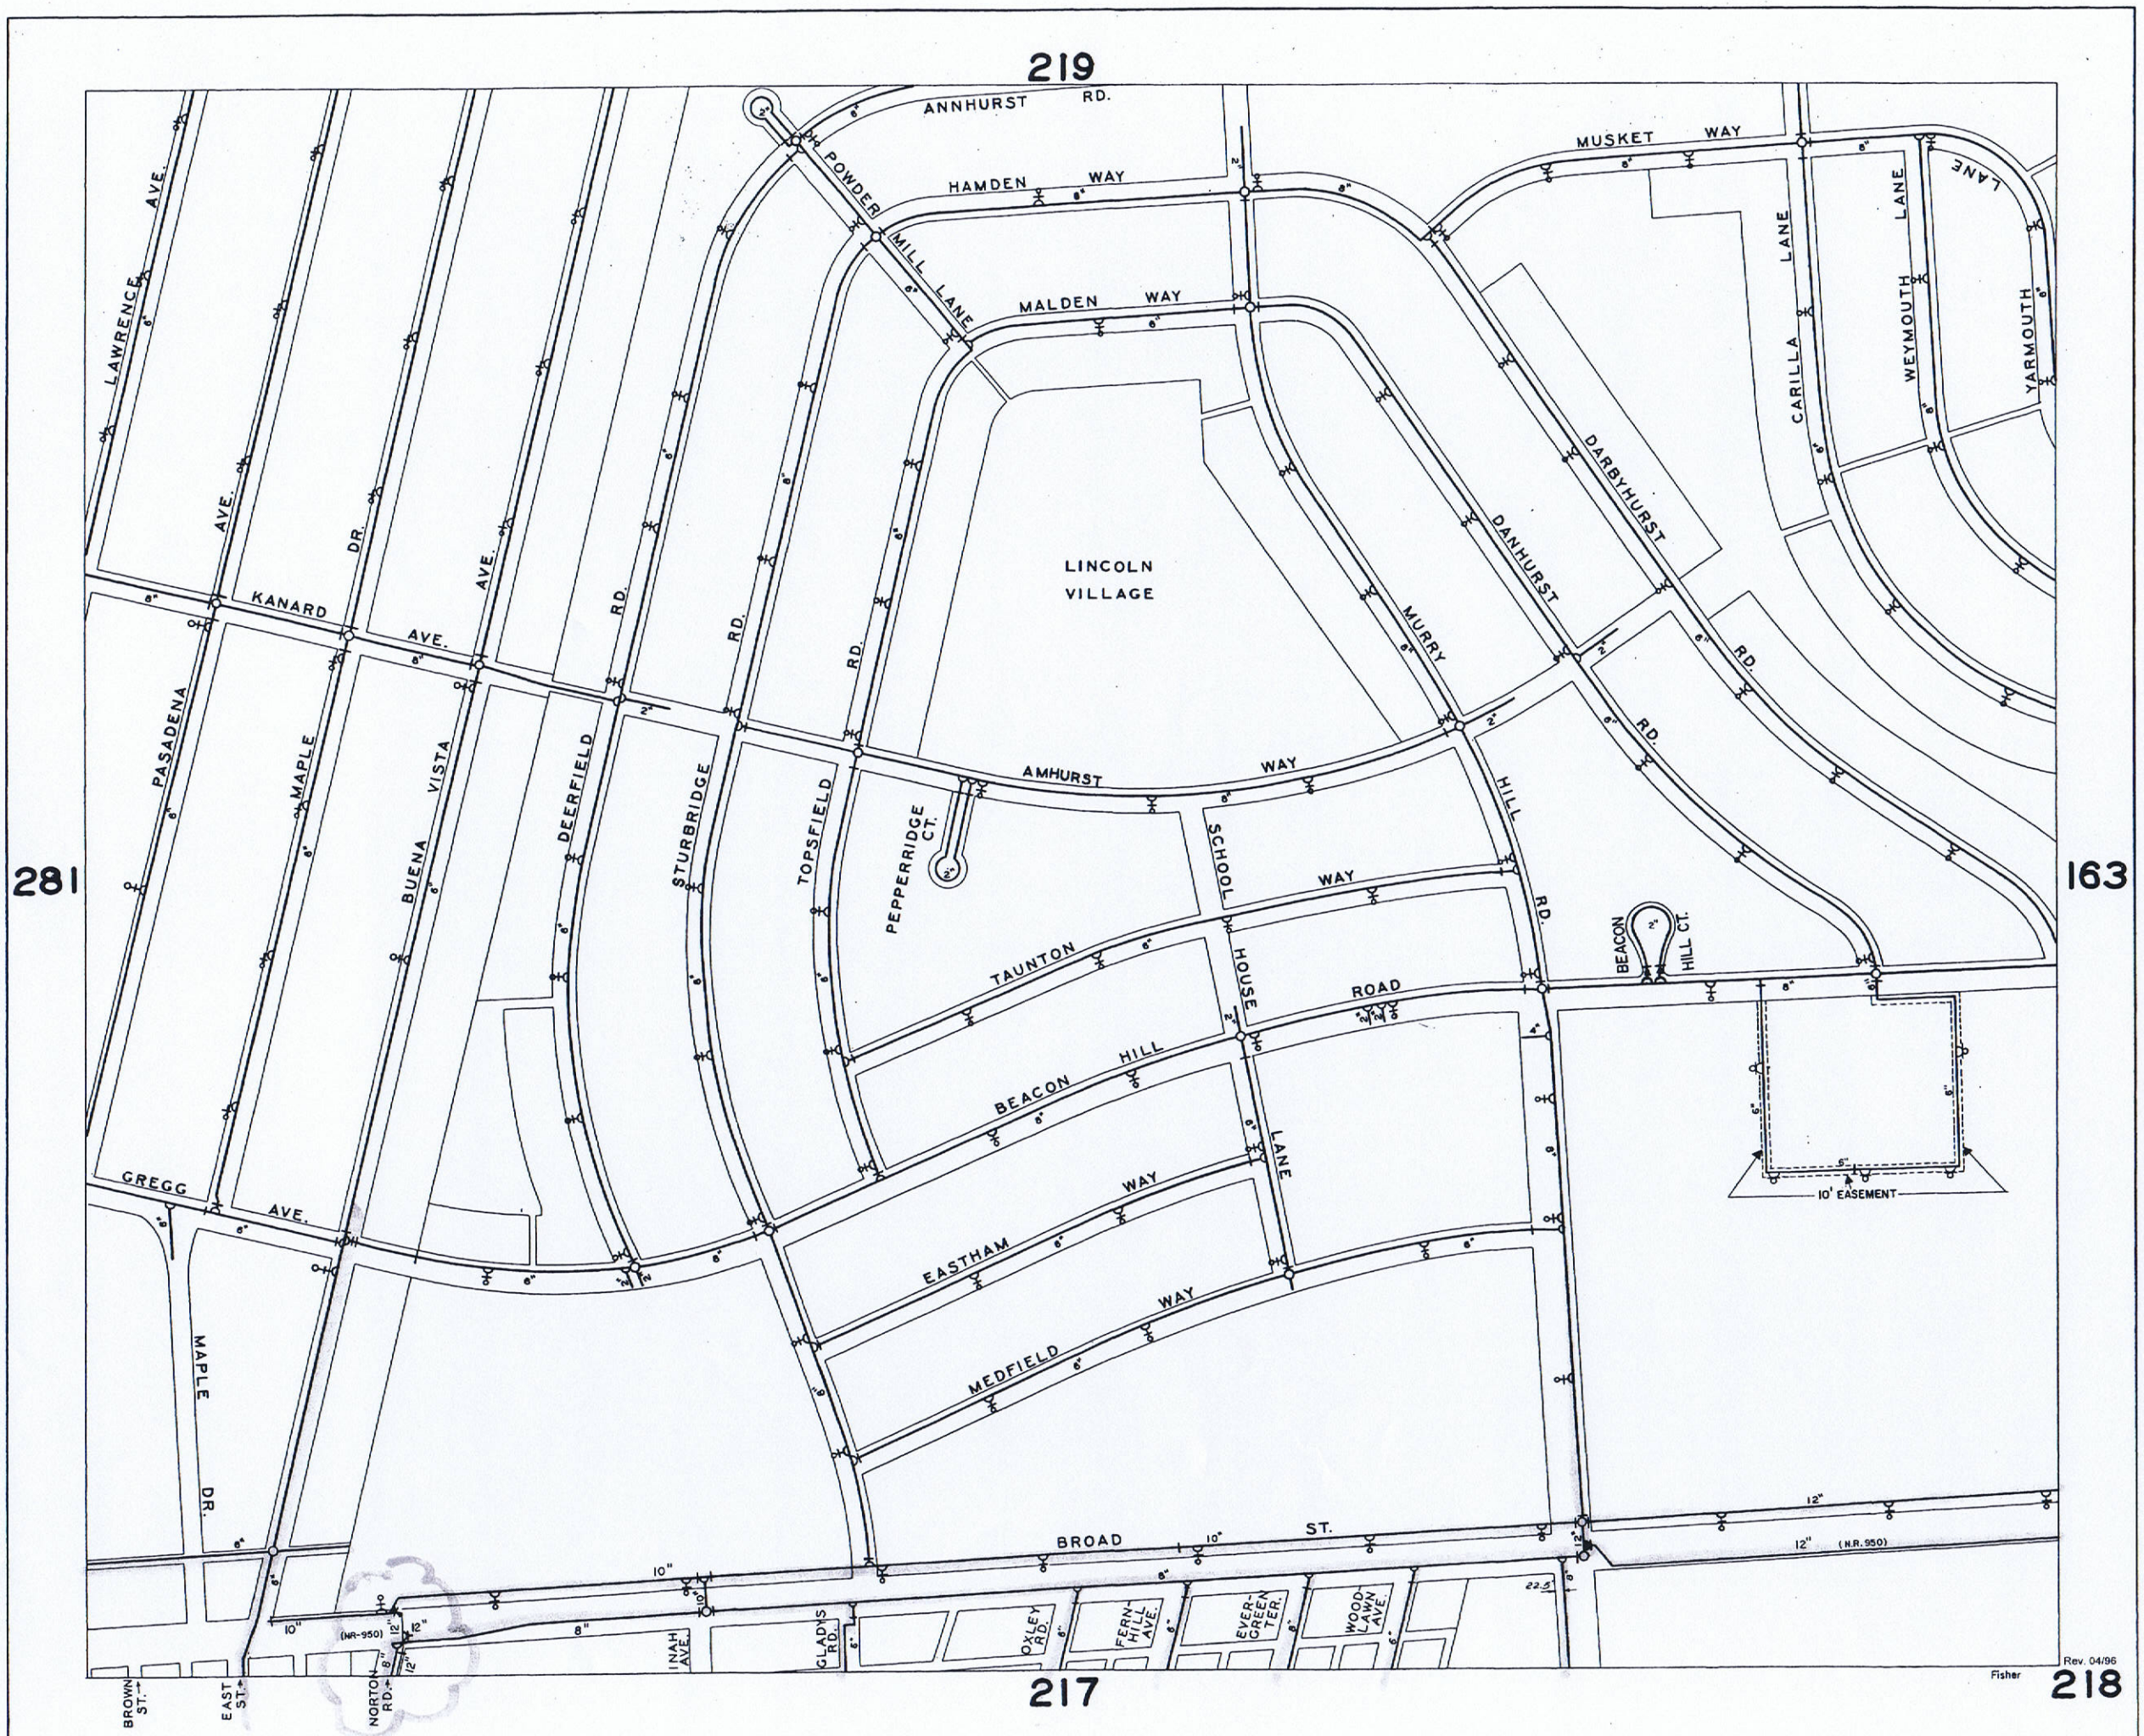
219
281
163
217
218
ANNHURST RD.
POWDER MILL LANE
HAMDEN WAY
MALDEN WAY
MUSKET WAY
LANE
CARILLA LANE
WEYMOUTH LANE
YARMOUTH
LAWRENCE AVE.
AVE.
DR.
AVE.
KANARD AVE.
PASADENA
MAPLE
BUENA VISTA
DEERFIELD
RD.
STURBRIDGE
TOPSFIELD
RD.
RD.
LINCOLN VILLAGE
MURRY
DANHURST
DARBYHURST
RD.
RD.
AMHURST WAY
PEPPERRIDGE CT.
SCHOOL HOUSE LANE
HILL
RD.
BEACON HILL CT.
TAUNTON WAY
BEACON HILL ROAD
EASTHAM WAY
MEDFIELD WAY
10' EASEMENT
GREGG AVE.
MAPLE DR.
BROAD ST.
12" (N.R. 950)
10"
8"
(NR-950)
BROWN ST.
EAST ST.
NORTON RD.
INAH AVE.
GLADYS RD.
OXLEY RD.
FERN-HILL AVE.
EVER-GREEN TER.
WOOD-LAWN AVE.
Fisher
Rev. 04/96

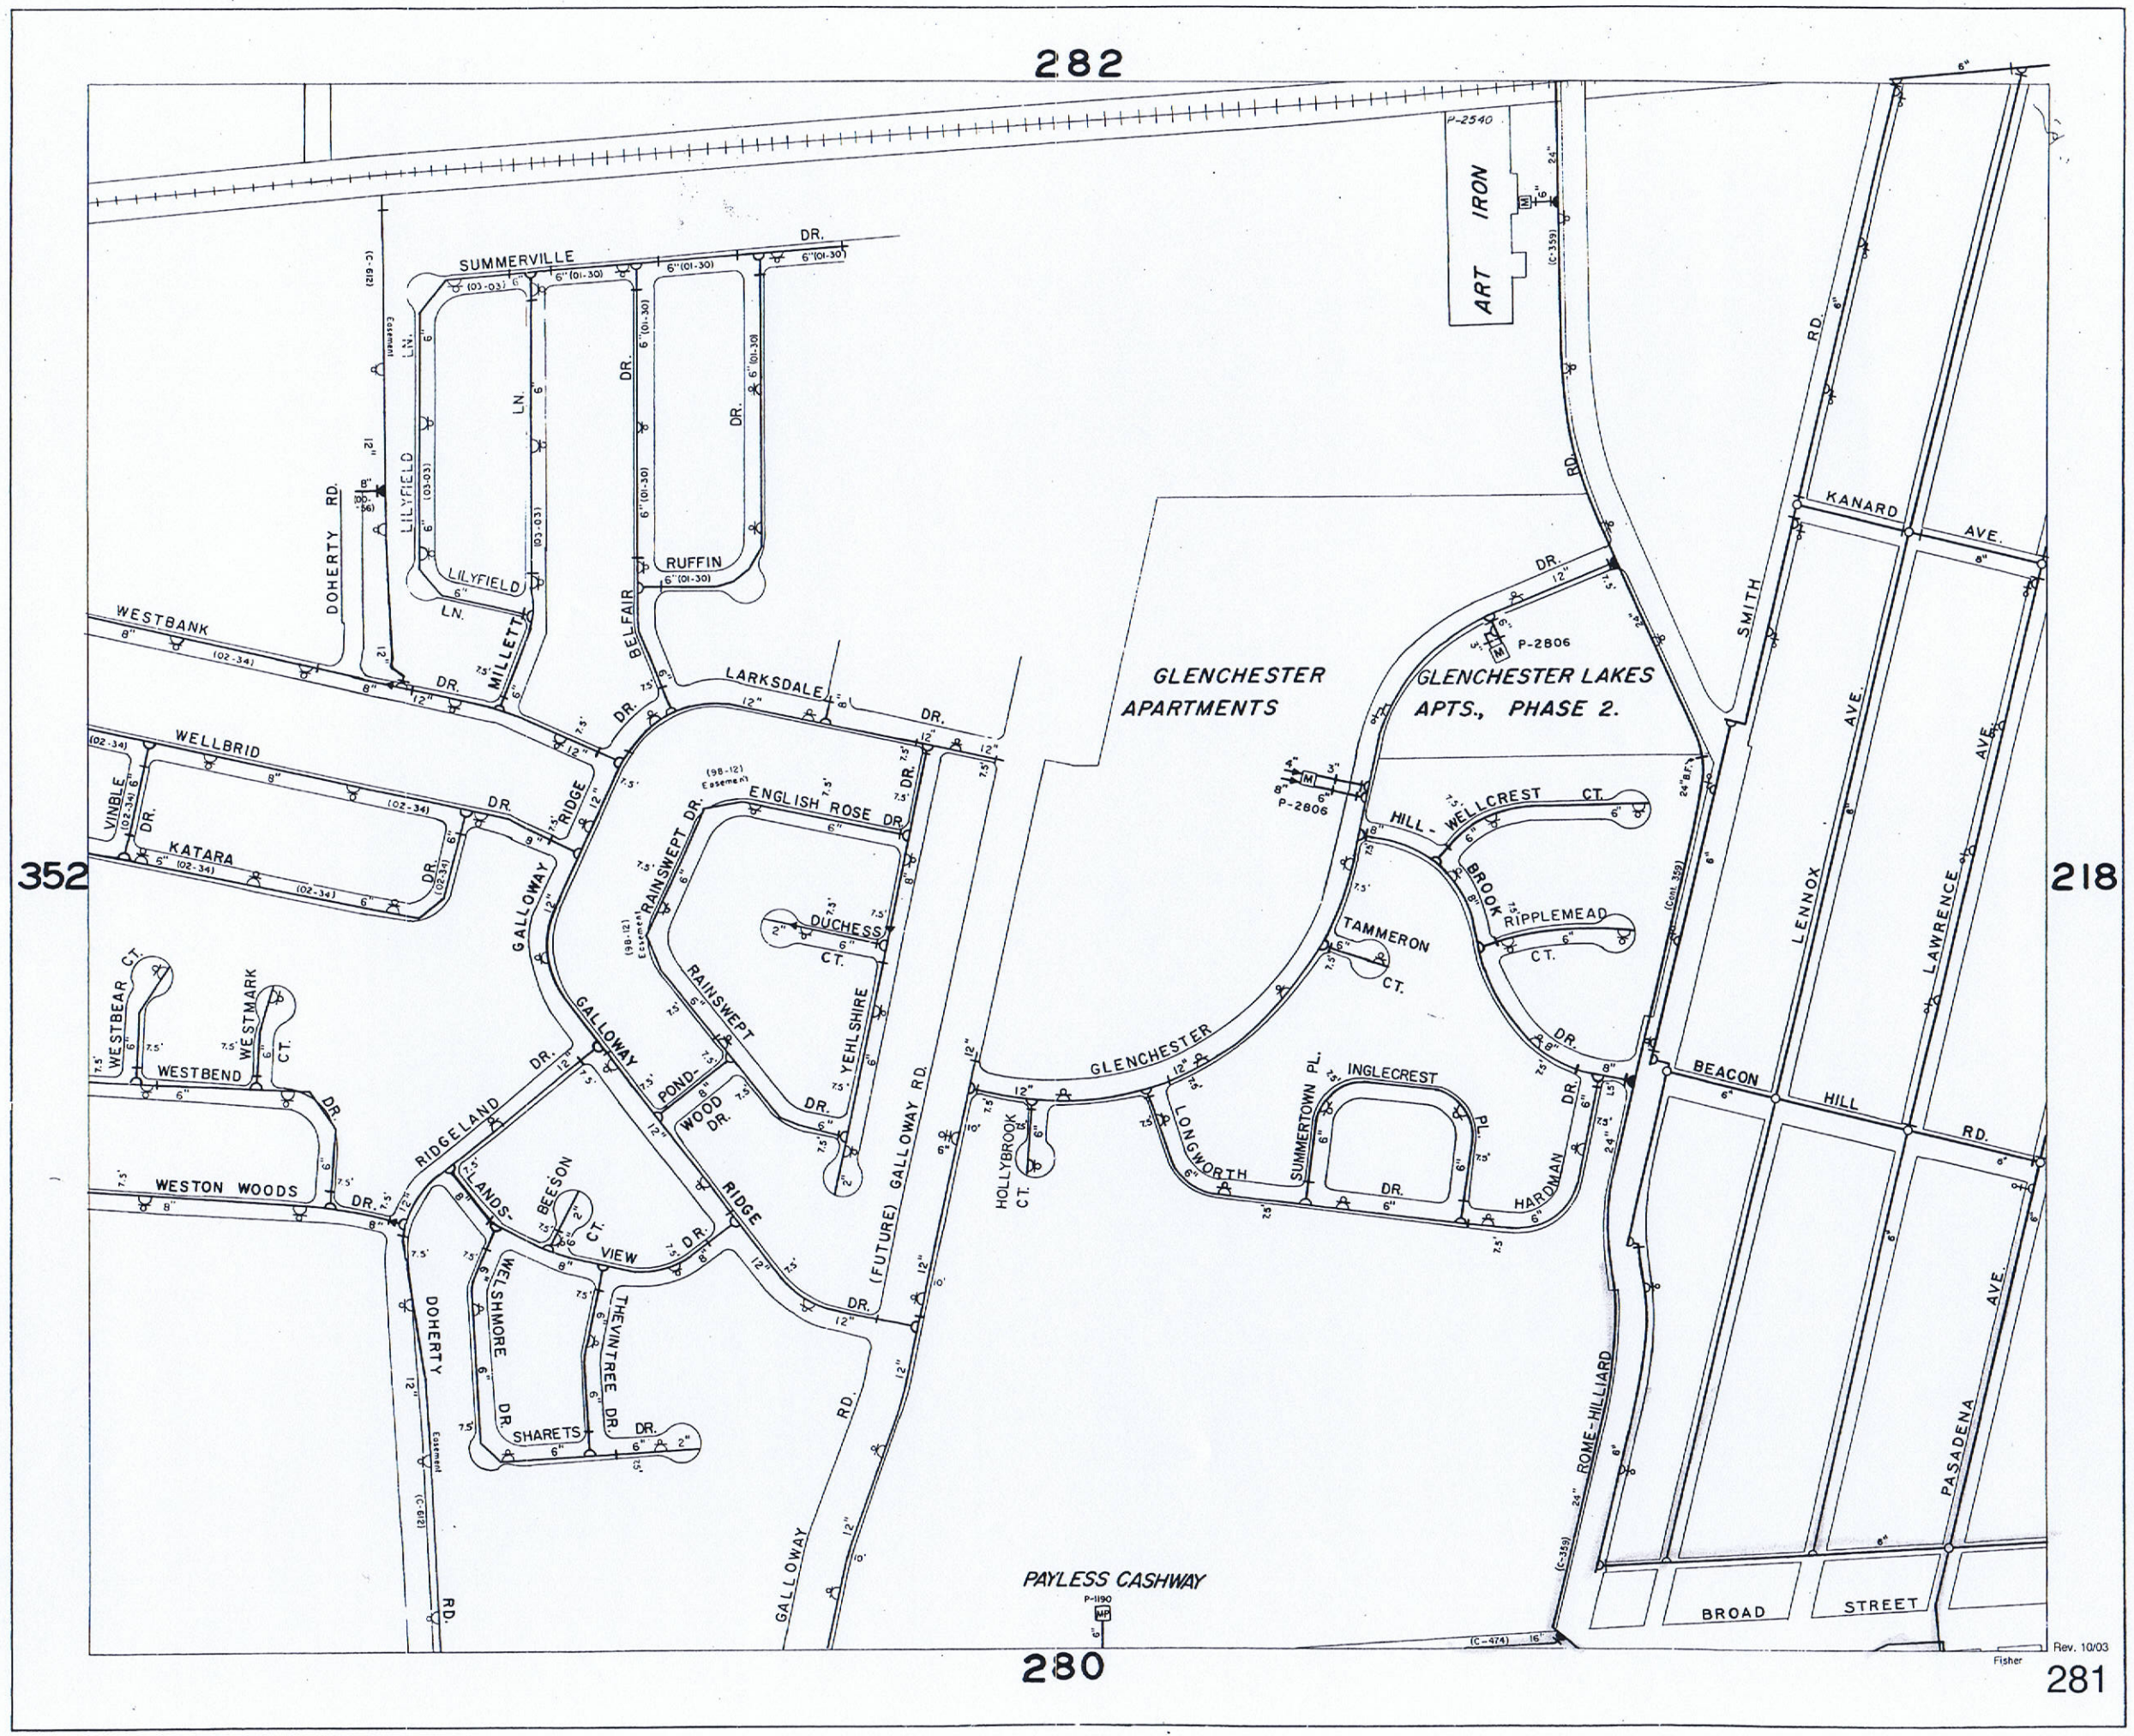
282
352
218
280
281
ART IRON
P-2540
SUMMERVILLE
DR.
LILYFIELD
LN.
DOHERTY RD.
WESTBANK
MILLETT
RELFAIR
RUFFIN
LARKSDALE
WELLBRID
VINBLE
KATARA
RIDGE
GALLOWAY
RAINSWEPT DR.
ENGLISH ROSE DR.
DUCHESS
CT.
YEHLSHIRE
WESTBEAR CT.
WESTMARK
WESTBEND
RIDGELAND
WESTON WOODS
LANDS-
BEESON
VIEW
WELSHMORE
THEVINTREE
SHARETS
(FUTURE) GALLOWAY RD.
GLENCHESTER
APARTMENTS
GLENCHESTER LAKES
APTS., PHASE 2.
P-2806
HILL-WELLCREST CT.
BROOK
RIPPLEMEAD
TAMMERON
HOLLYBROOK CT.
LONGWORTH
SUMMERTOWN PL.
INGLECREST
HARDMAN
SMITH
KANARD
AVE.
LENNOX
LAWRENCE
BEACON
HILL
ROME-HILLIARD
PASADENA
BROAD
STREET
PAYLESS CASHWAY
P-1190
Fisher
Rev. 10/03

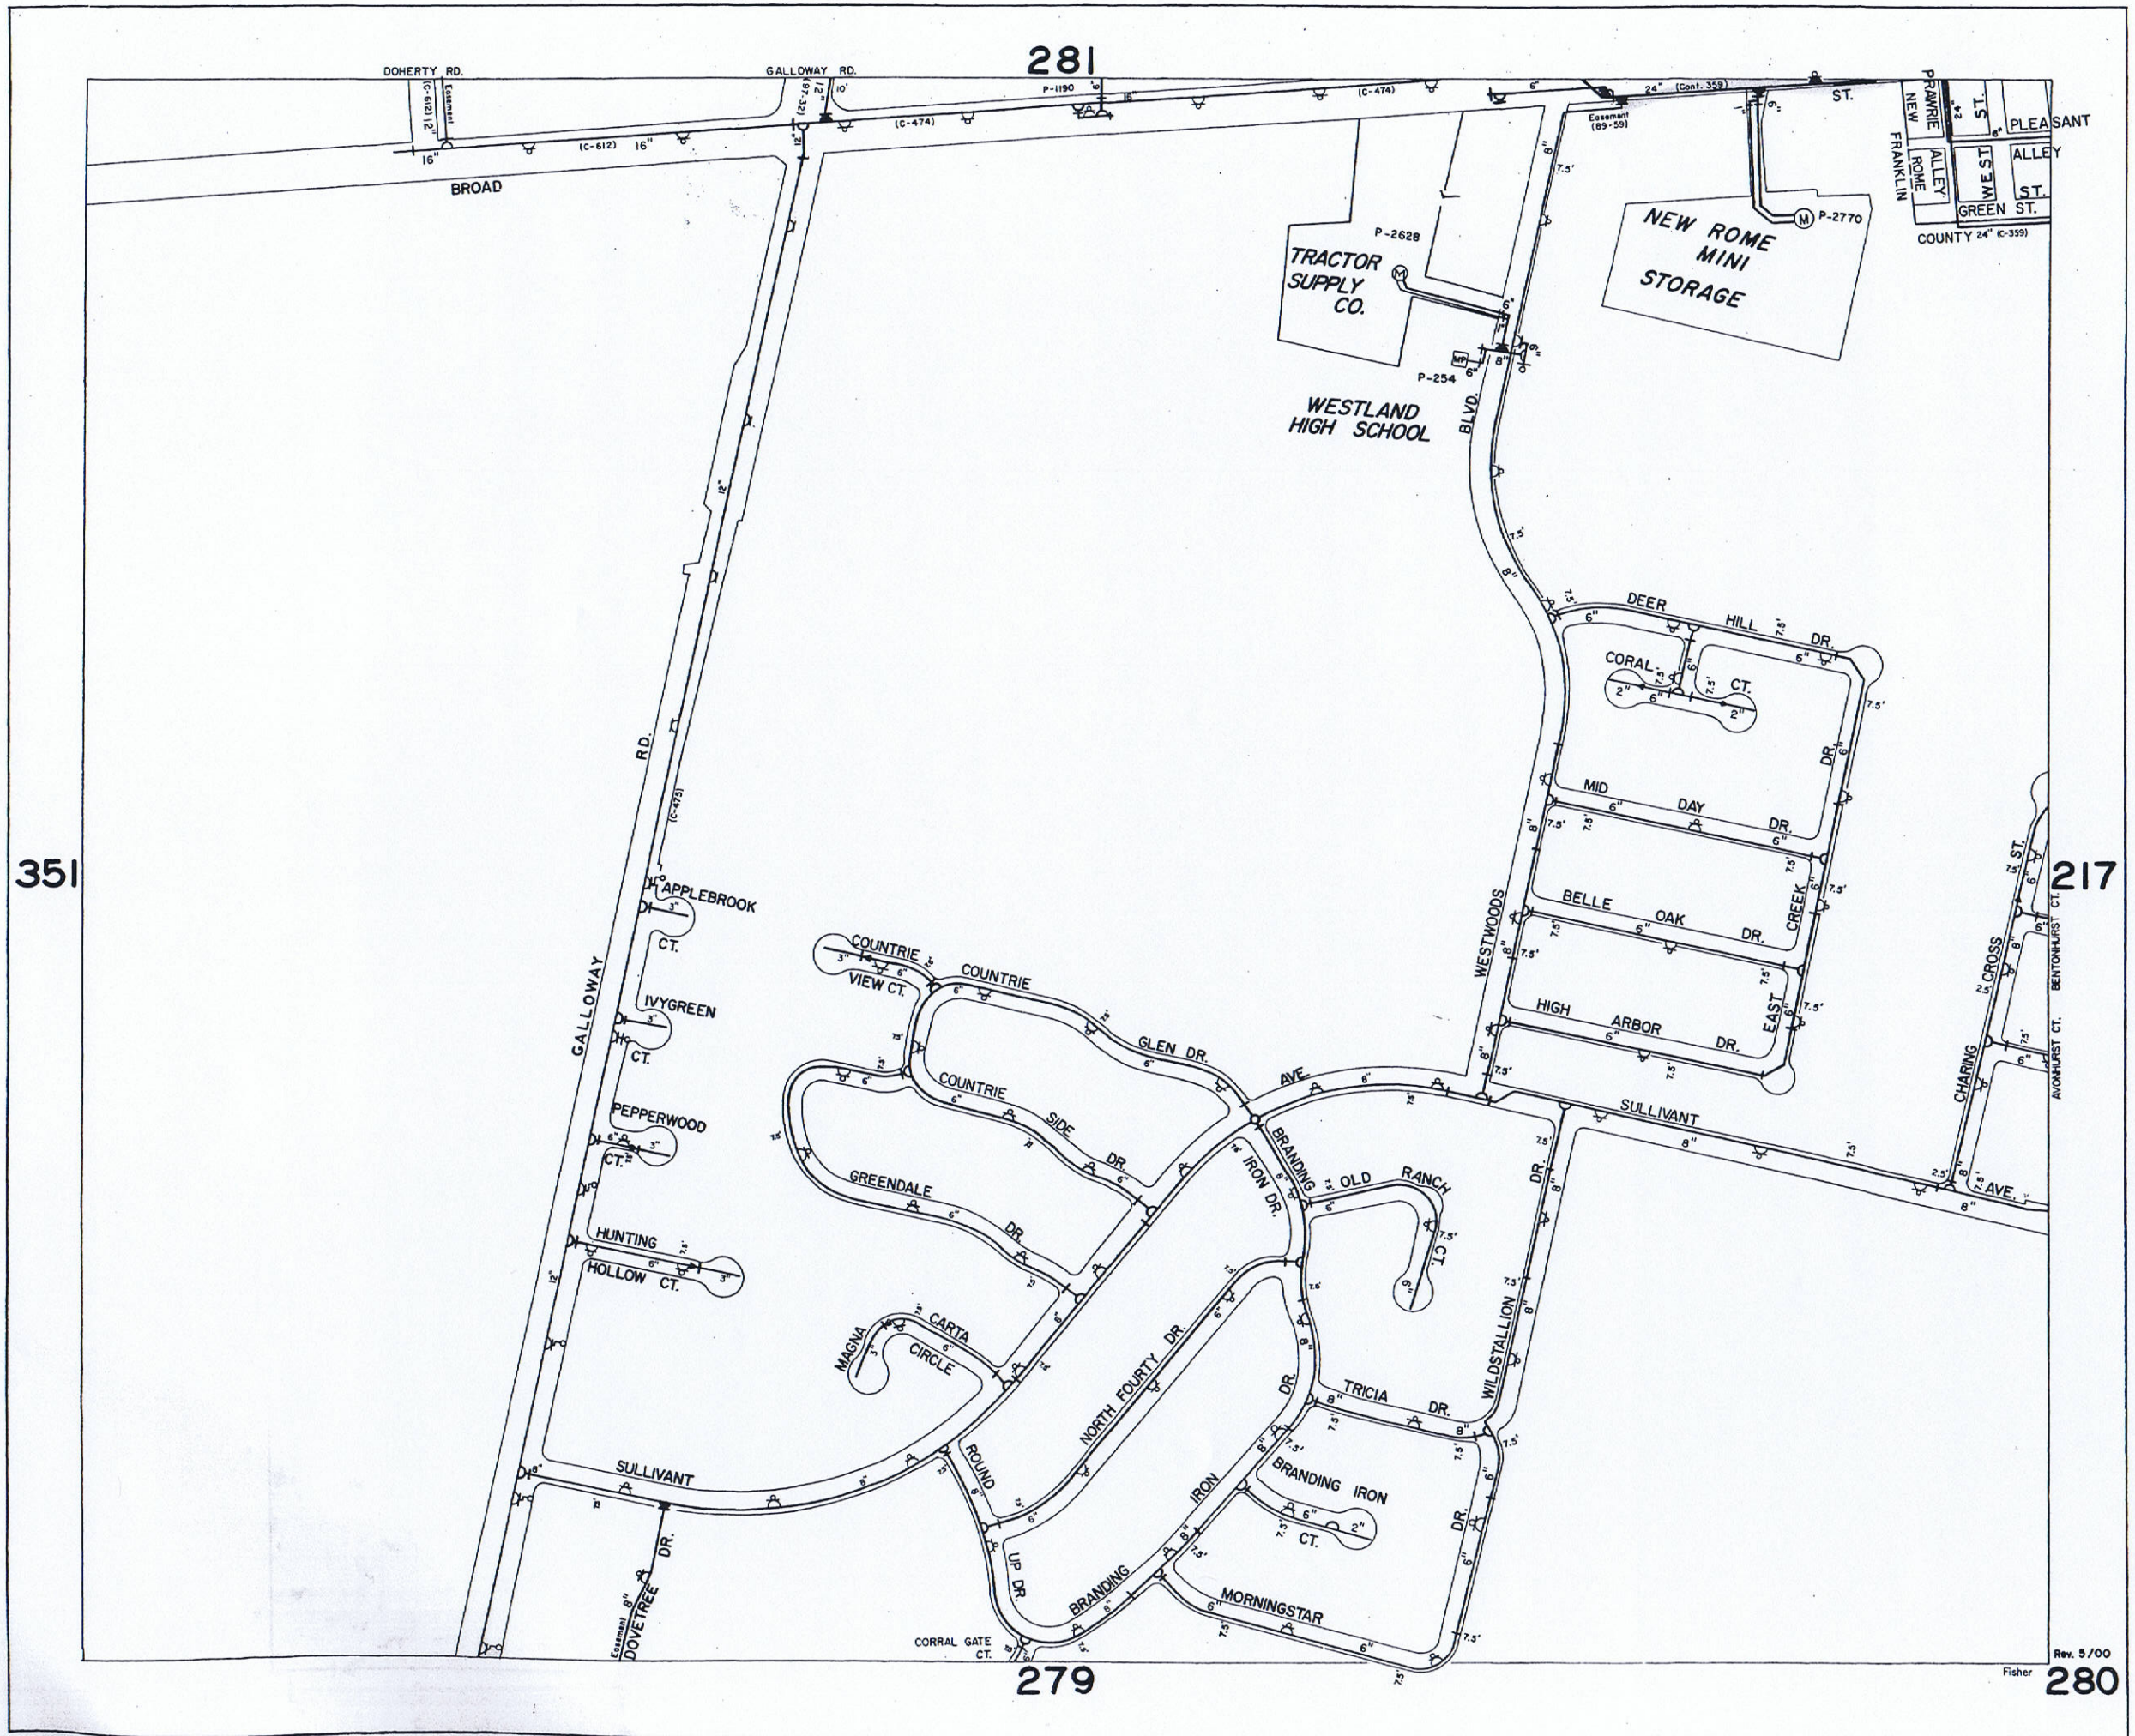
281
DOHERTY RD.
GALLOWAY RD.
BROAD
(C-612) 16"
(C-474)
P-1190
24" (Cont. 352)
Easement (85-59)
ST.
PRAIRIE
NEW ROME
FRANKLIN
ALLEY
WEST ST.
PLEASANT ALLEY
GREEN ST.
COUNTY 24" (C-359)
P-2628
TRACTOR SUPPLY CO.
P-2770
NEW ROME MINI STORAGE
P-254
WESTLAND HIGH SCHOOL
BLVD.
DEER HILL DR.
CORAL CT.
MID DAY DR.
BELLE OAK DR.
HIGH ARBOR DR.
EAST CREEK DR.
WESTWOODS DR.
CHARING CROSS
BENTONHURST CT.
AVONHURST CT.
SULLIVANT AVE.
OLD RANCH CT.
BRANDING IRON DR.
WILDSTALLION DR.
TRICIA DR.
BRANDING IRON CT.
MORNINGSTAR DR.
NORTH FOURTY DR.
ROUND UP DR.
MAGNA CARTA CIRCLE
GREENDALE DR.
COUNTRIE SIDE DR.
GLEN DR.
COUNTRIE VIEW CT.
COUNTRIE
GALLOWAY RD.
APPLEBROOK CT.
IVYGREEN CT.
PEPPERWOOD CT.
HUNTING HOLLOW CT.
DOVETREE DR.
CORRAL GATE CT.
351
217
279
280
Rev. 5/00
Fisher

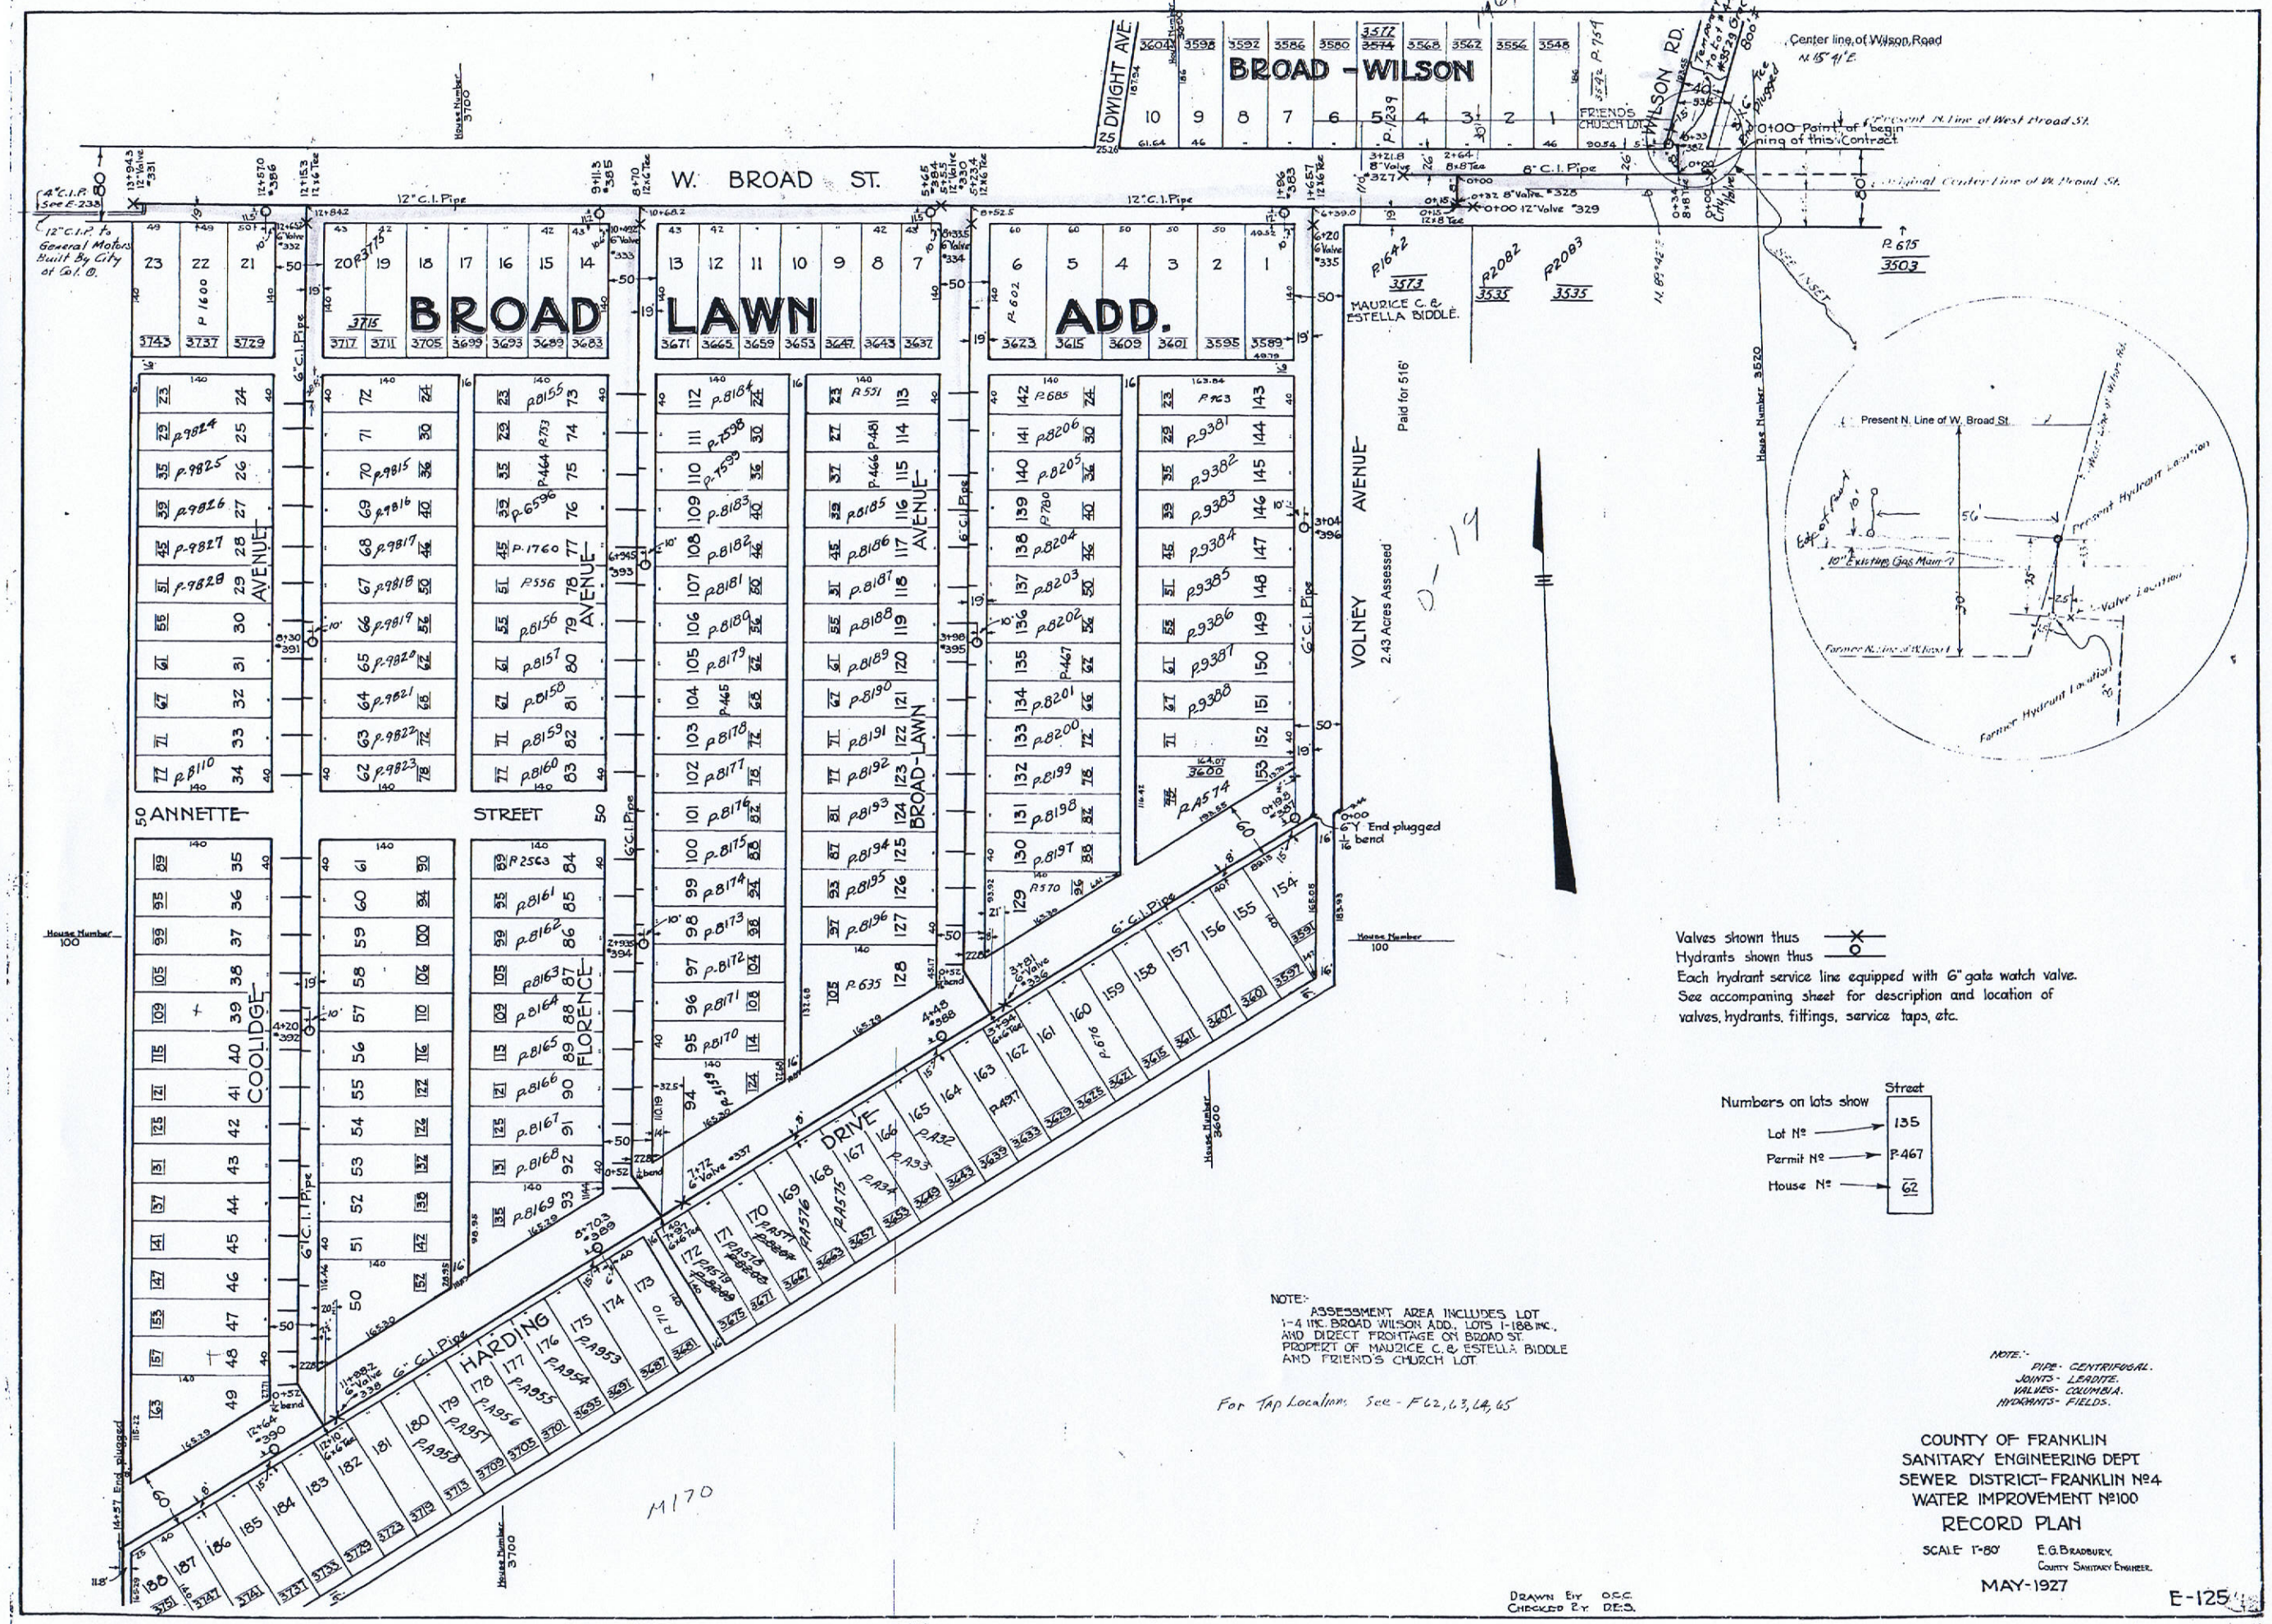
BROAD - WILSON
DWIGHT AVE
WILSON RD.
W. BROAD ST.
BROAD LAWN ADD.
ANNETTE STREET
COOLIDGE AVENUE
FLORENCE AVENUE
BROAD-LAWN AVENUE
VOLNEY AVENUE
HARDING DRIVE
Center line of Wilson Road
Present N. Line of West Broad St.
0+00 Point of beginning of this Contract
Original Center Line of W. Broad St.
12" C.I. Pipe
8" C.I. Pipe
6" C.I. Pipe
12" C.I.P. to General Motors Built By City of Col. O.
MAURICE C. & ESTELLA BIDDLE
2.43 Acres Assessed
Paid for 516'
FRIENDS CHURCH LOT
Present N. Line of W. Broad St.
Present Hydraulic Location
10" Existing Gas Main
Valve Location
Former N. Line of W. Broad St.
Former Hydraulic Location
House Number 3500
House Number 3520
House Number 3600
House Number 3700
House Number 100
Valves shown thus
Hydrants shown thus
Each hydrant service line equipped with 6" gate watch valve.
See accompanying sheet for description and location of valves, hydrants, fittings, service taps, etc.
Numbers on lots show
Lot No.
Permit No.
House No.
Street
NOTE:- ASSESSMENT AREA INCLUDES LOT 1-4 INC. BROAD WILSON ADD., LOTS 1-188 INC., AND DIRECT FRONTAGE ON BROAD ST. PROPERTY OF MAURICE C. & ESTELLA BIDDLE AND FRIEND'S CHURCH LOT.
For Tap Location, See - F 62, 63, 64, 65
NOTE:- PIPE - CENTRIFUGAL. JOINTS - LEADITE. VALVES - COLUMBIA. HYDRANTS - FIELDS.
COUNTY OF FRANKLIN
SANITARY ENGINEERING DEPT
SEWER DISTRICT - FRANKLIN No. 4
WATER IMPROVEMENT No. 100
RECORD PLAN
SCALE 1"-80'
E. G. BRADBURY, COUNTY SANITARY ENGINEER.
MAY-1927
DRAWN BY O.E.C.
CHECKED BY D.E.S.
E-125

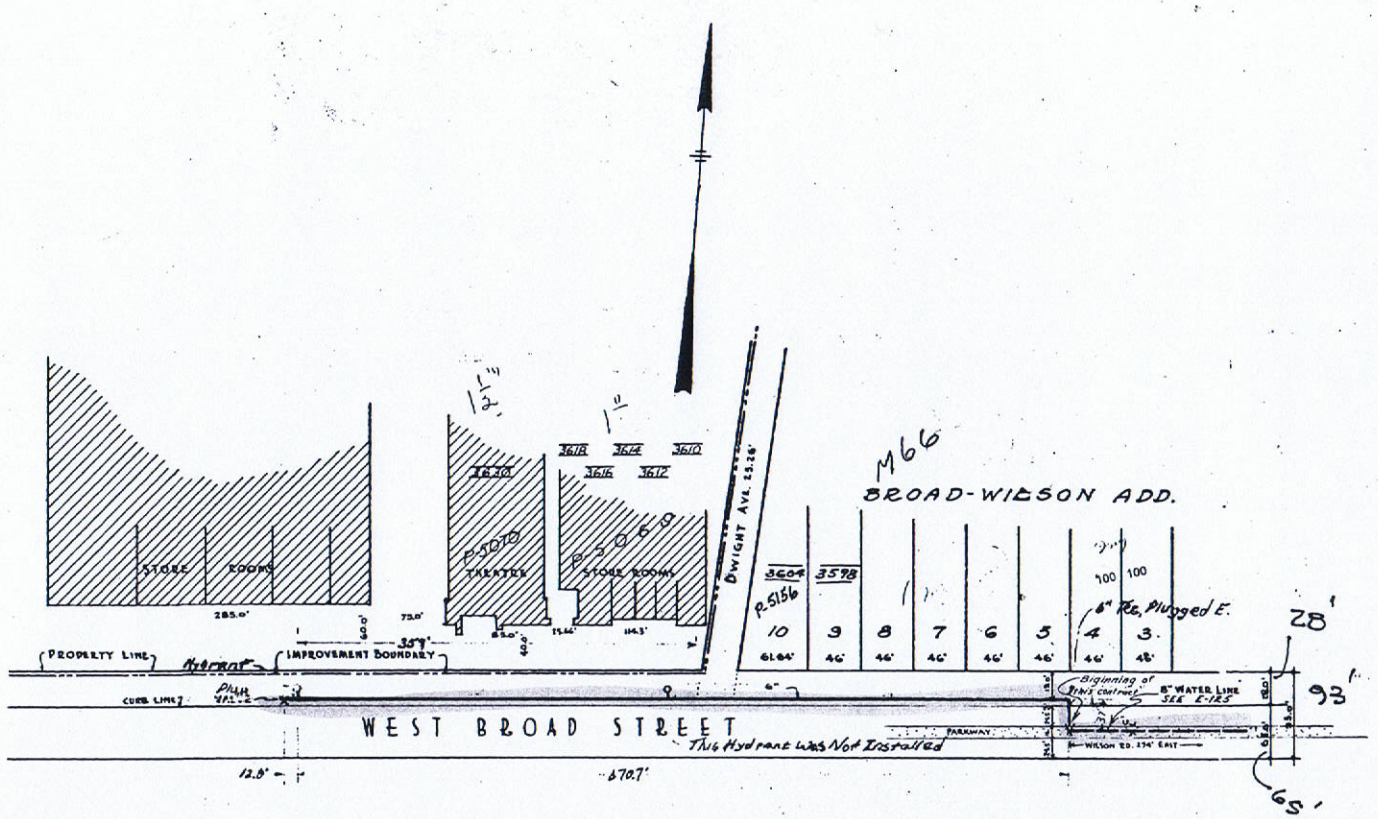

Valves shown thus
Hydrants shown thus
Each hydrant service line equipped with 6" gate match valve.
4"-5" From Water to Valve for Hydrant.
3"-4" From Water to Valve for Tee.

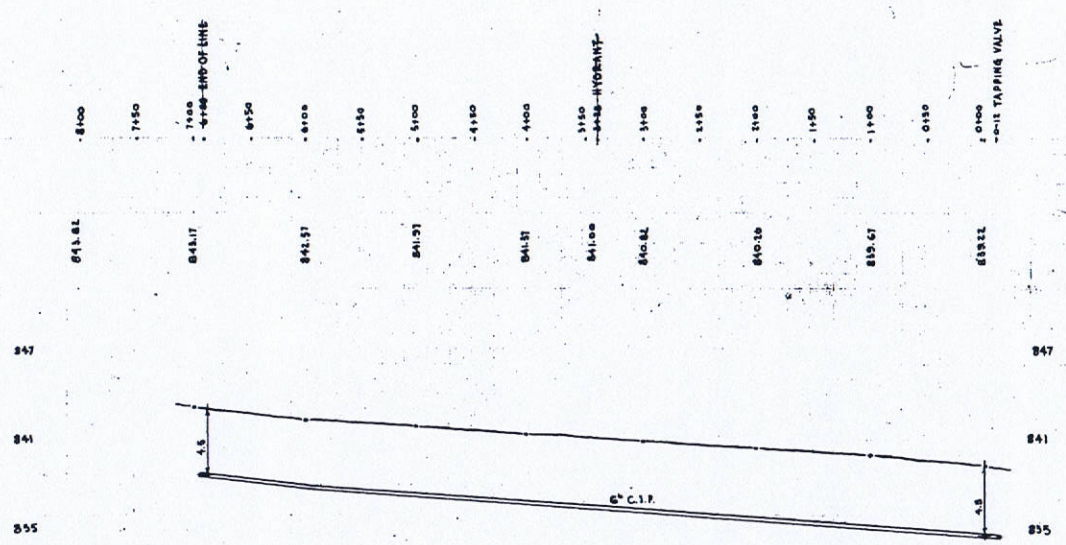

APPROVED THIS 30th DAY OF April 1948
G. H. Clements
COUNTY SANITARY ENGINEER

APPROVED THIS 8 DAY OF MAY 1948
Elmer A. Fuller
DIRECTOR OF PUBLIC SERVICE

APPROVED THIS 8 DAY OF May 1948
C B Hoover (adequacy of supply and pressure cannot be assured at all times for this locality)
SUPT. DIVISION OF WATER

APPROVED THIS 11 DAY OF MAY 1948
Henry T. Tedrow
George W. Whitson
COMMISSIONERS, FRANKLIN COUNTY

· COUNTY · OF · FRANKLIN ·
· SANITARY · ENGINEERING · DEPT. ·
· SEWER · DISTRICT · FRANKLIN · NO. · 4 ·
· PRIVATE · WATER · IMPROVEMENT · NO. · 251 ·

· PLAN · AND · PROFILE ·
· WEST · BROAD · STREET ·

SCALE: HORIZONTAL: 1" = 80.0'
VERTICAL: 1" = 6.0'

GROVER CLEMENTS
COUNTY SANITARY
ENGINEER

THE BUILDING SERVICE
328 EAST TOWN ST.
COLUMBUS, OHIO

APRIL 29, 1948

RECORD PLAN

M66
~~D 1049~~ E-427

INDEXED