


I:\ProjectData\HAM\10305\_HAM-75-7.85\_Demo2\Design\Roadway\Sheets\10305\_GP001.dgn Sheet 1/13/2020 10:50:02 AM sroth

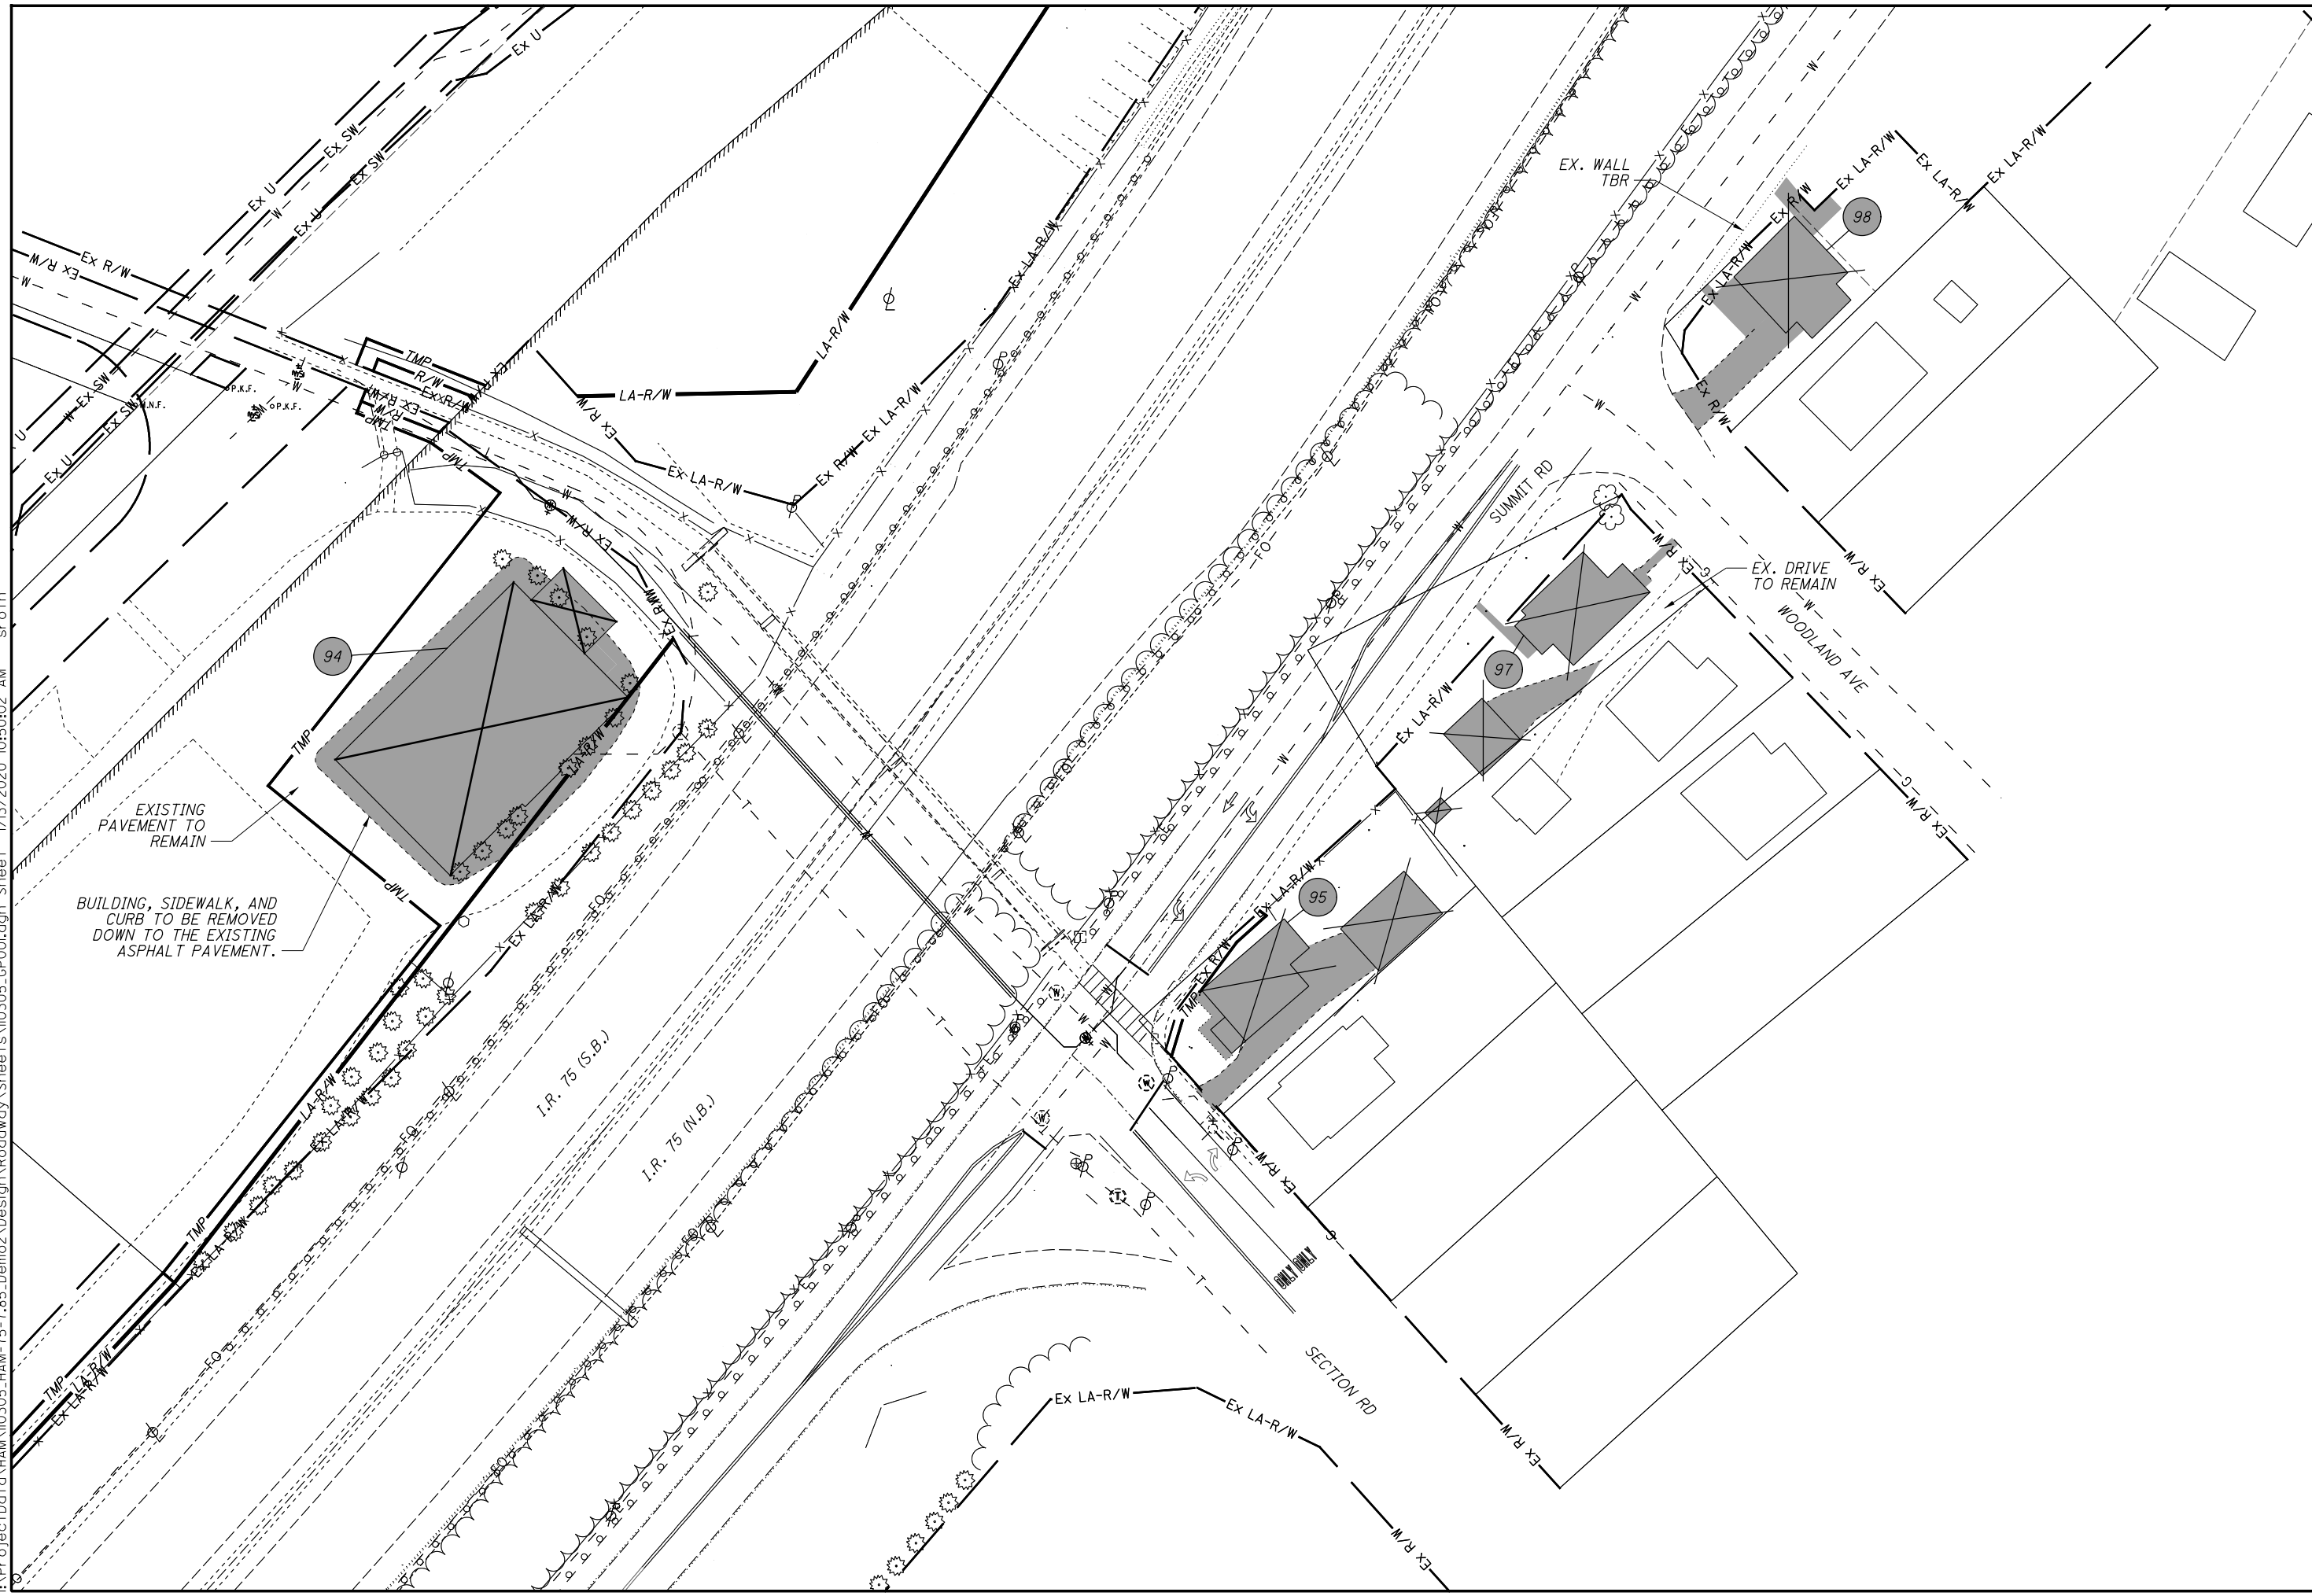

BUILDING, SIDEWALK, AND CURB TO BE REMOVED DOWN TO THE EXISTING ASPHALT PAVEMENT.

EXISTING PAVEMENT TO REMAIN

CALCULATED	NSR	CHECKED	SRR

0 30 60  
15  
HORIZONTAL SCALE IN FEET

PROPERTY MAP  
PARCEL 94, 95, 97 AND 98

HAM-75-7.85 DEMO 2

