
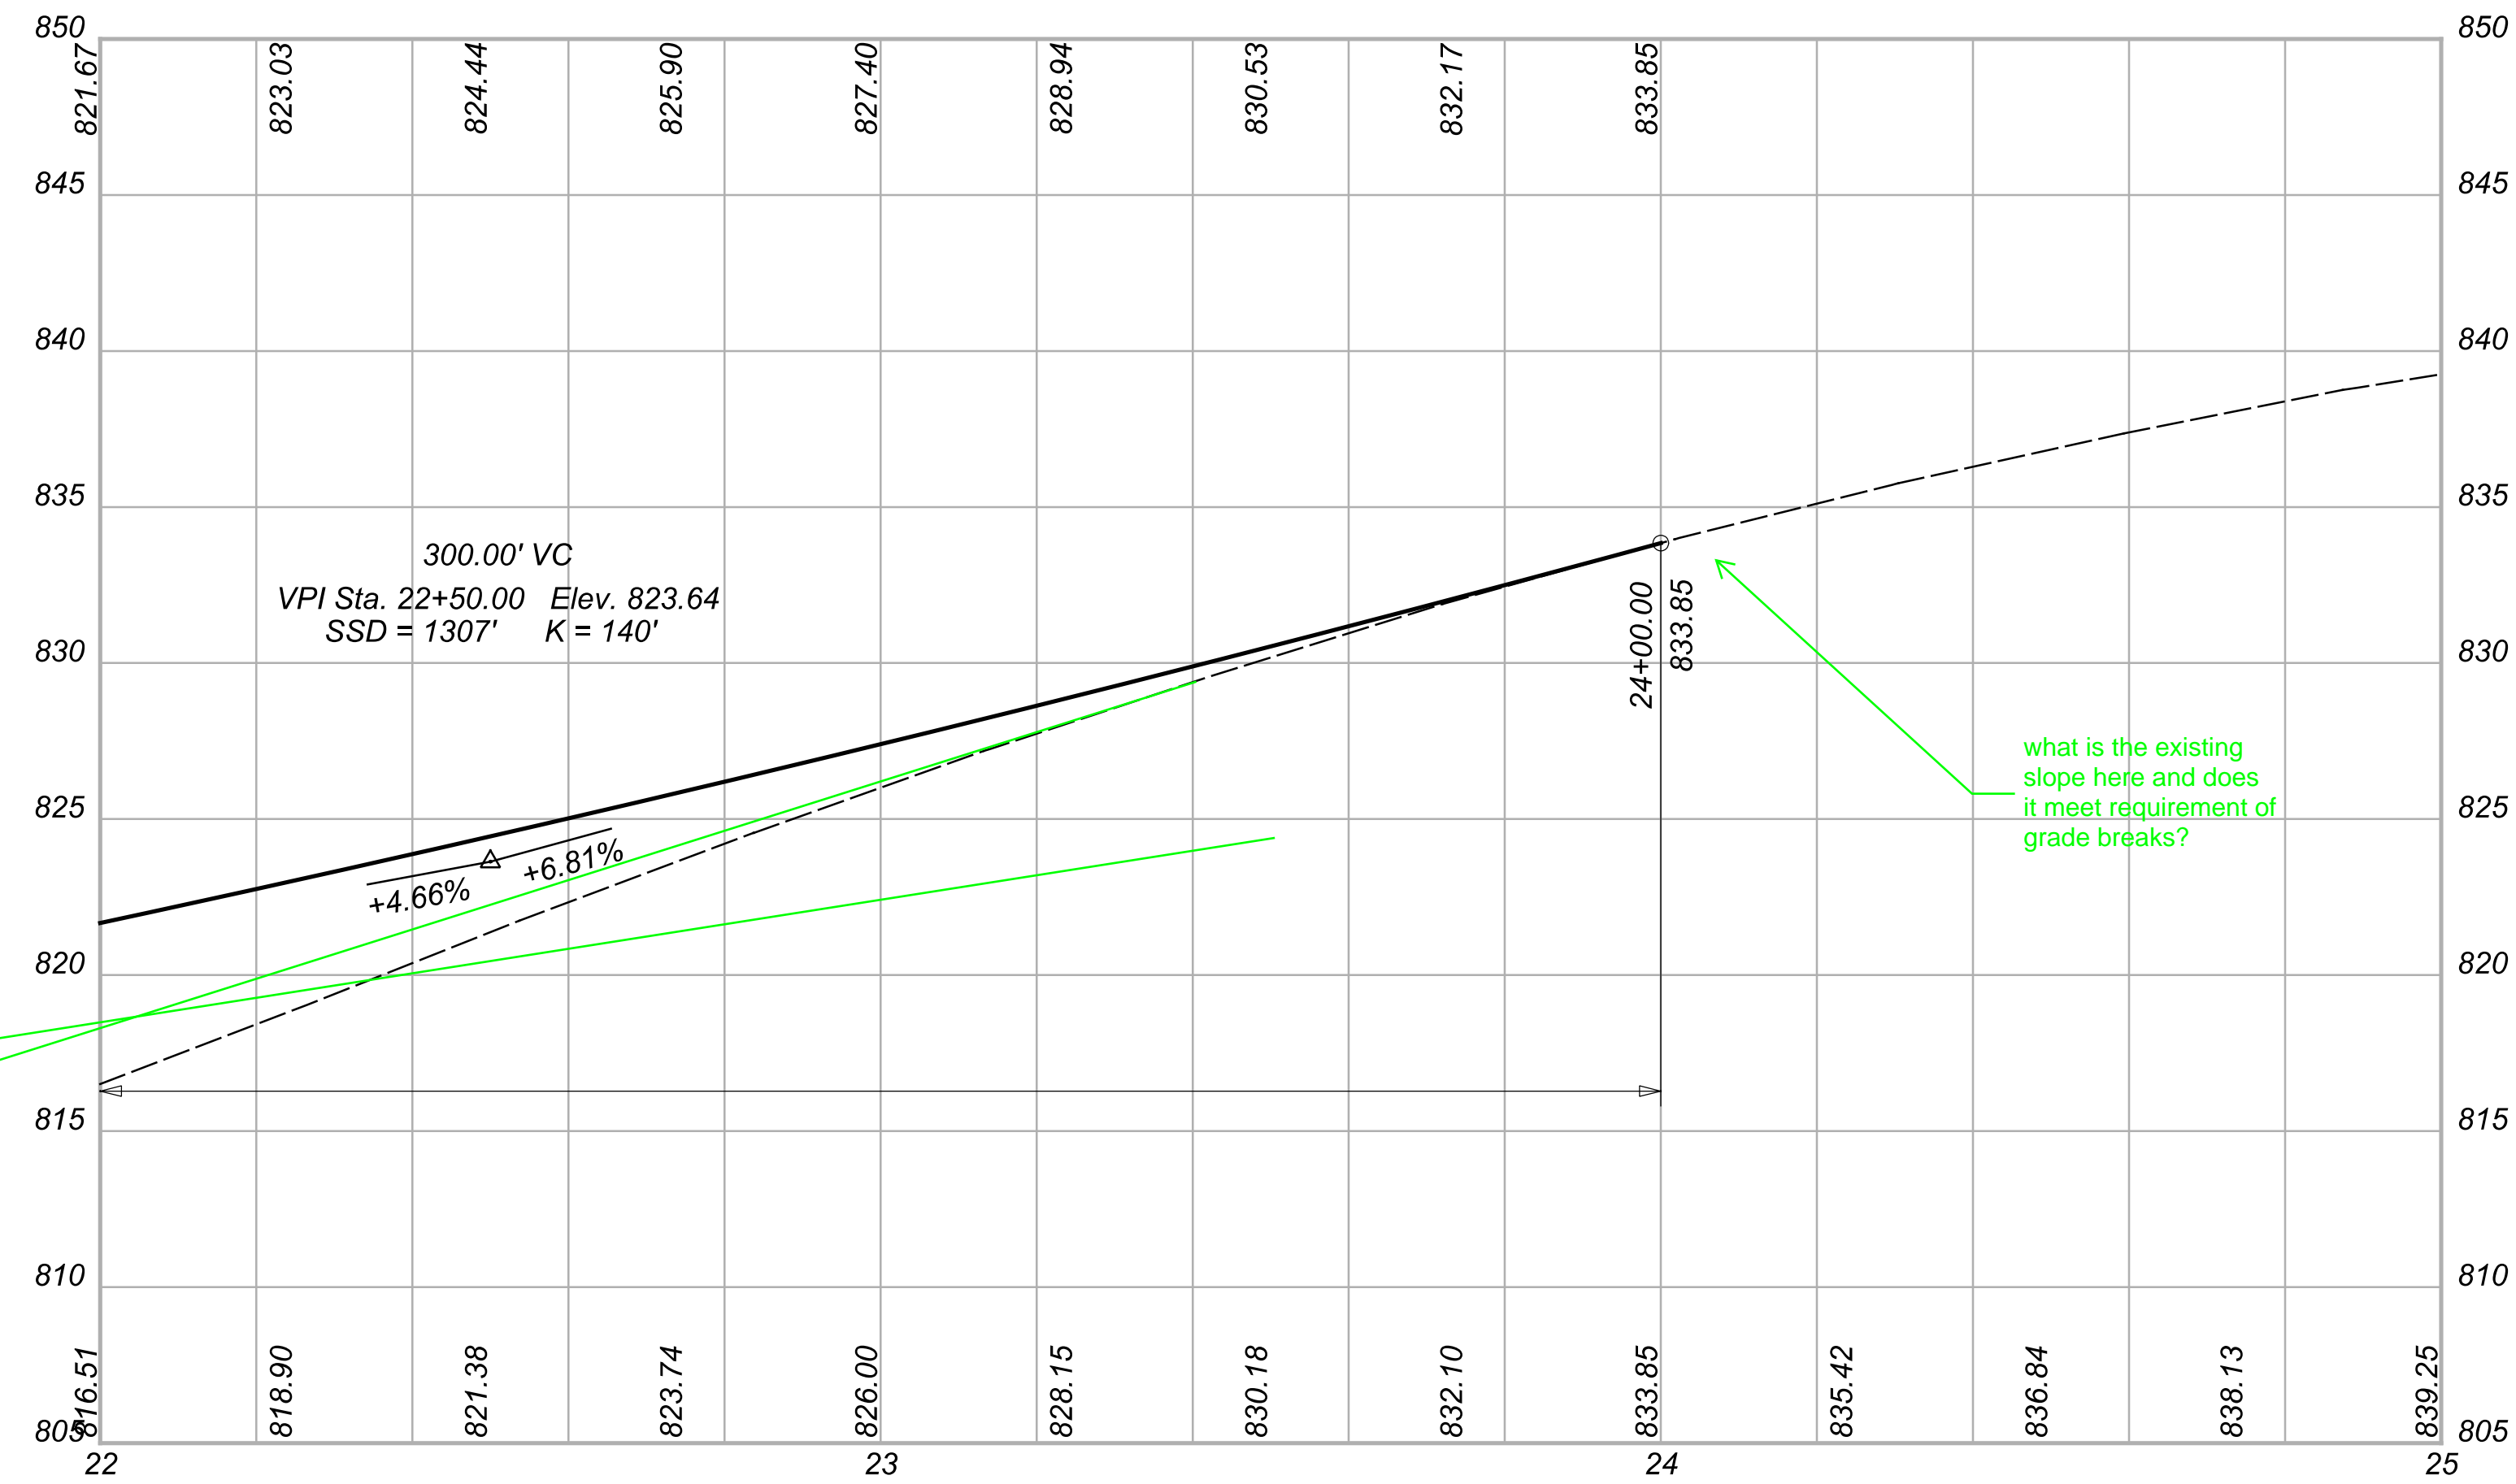





CTY-RTE-SECTION

MODEL: CLP_Race_Road - Profile [Sheet] PAPER SIZE: 34x22 (in.) DATE: 9/14/2022 TIME: 10:41:30 AM USER: jlight
 Z:\2022\220827\CAD\000T\10563-400-Engineer\Ing\Roadway\Sheets\Scratch\prof-prof sheets.dgn



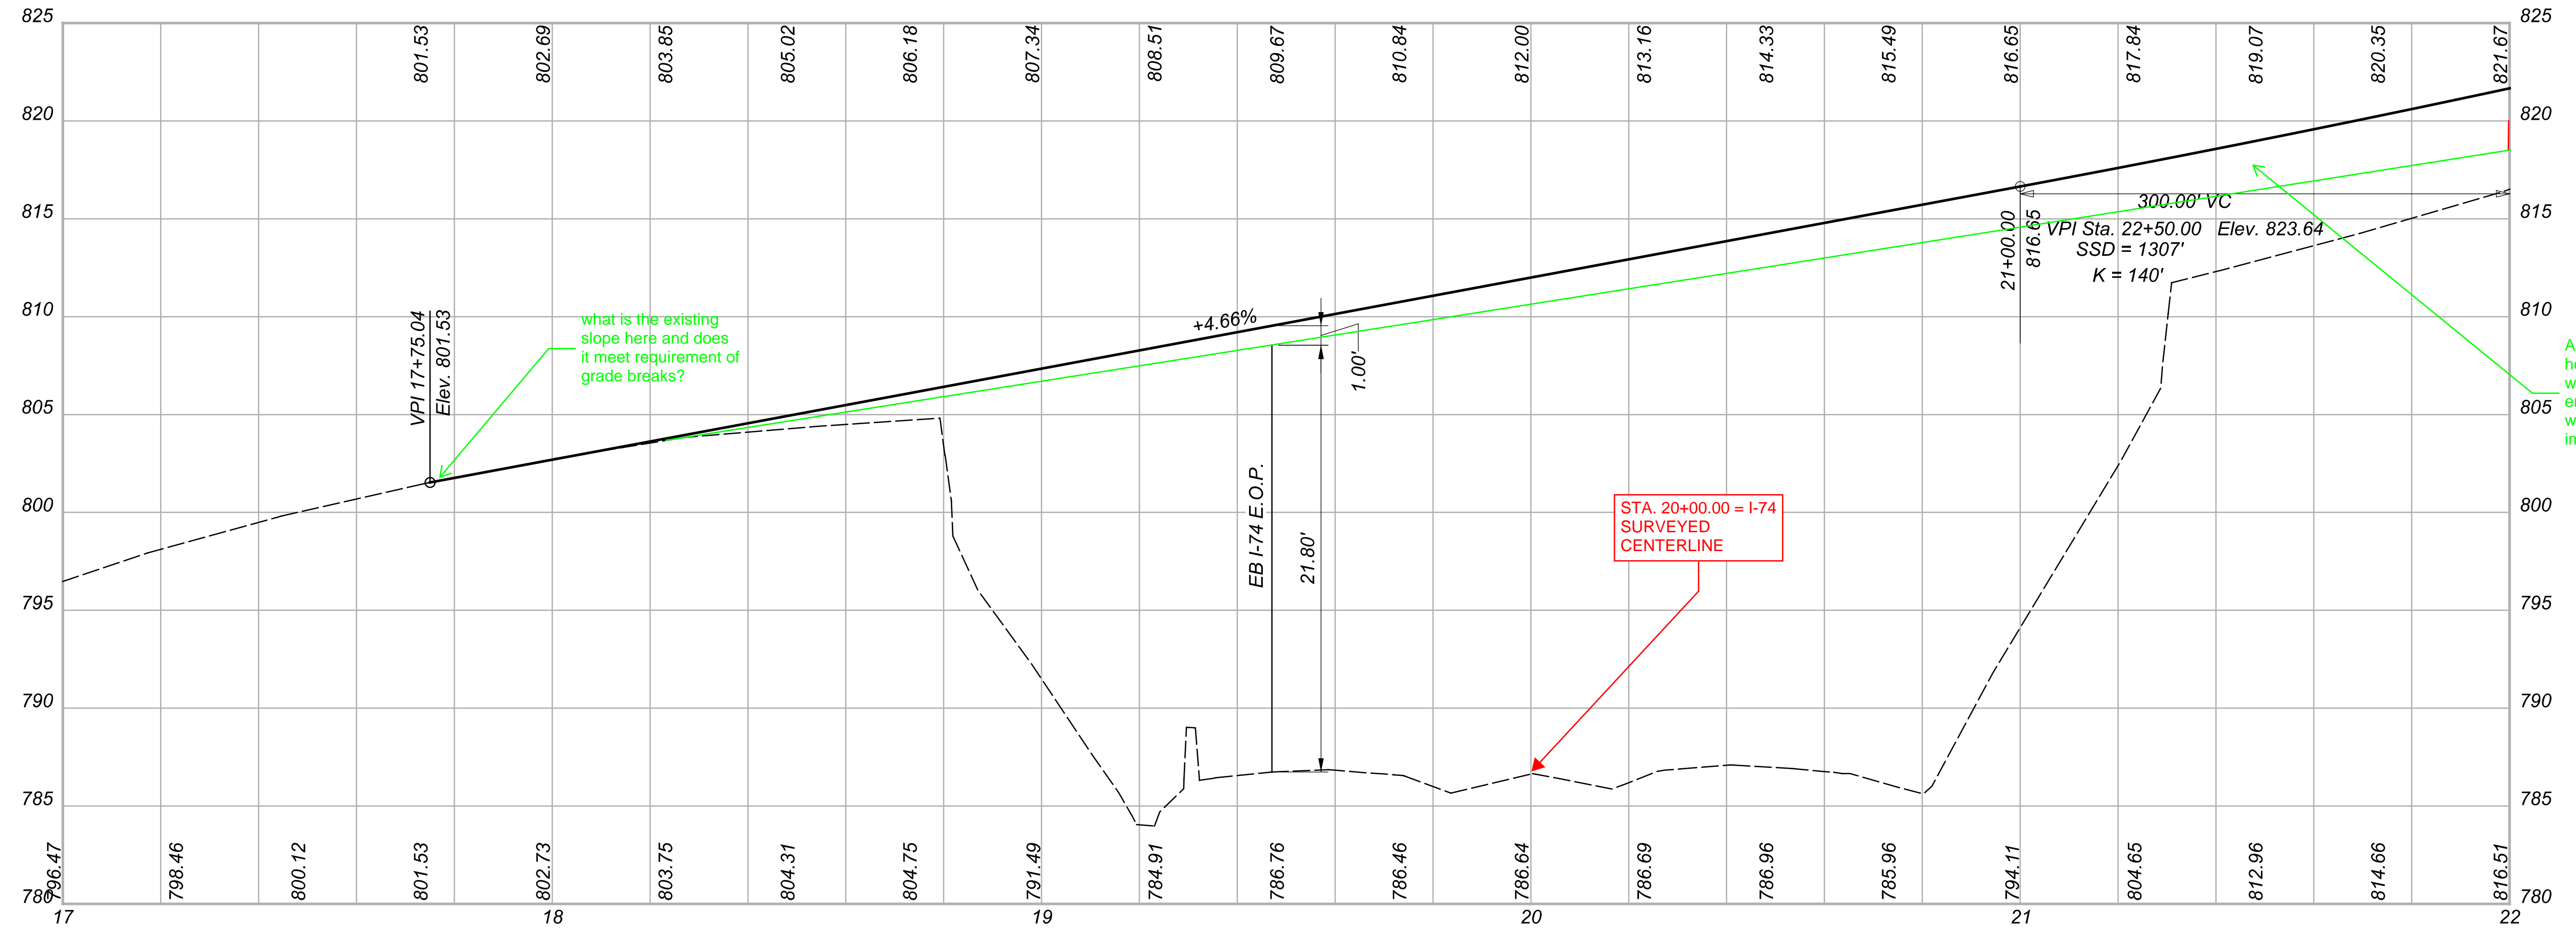


**PROFILE SHEET
SHEET SUB-TITLE**

DESIGN AGENCY	
DESIGNER	XXX
REVIEWER	XXX MM-DD-YY
PROJECT ID	0
SHEET	TOTAL
P.0	0

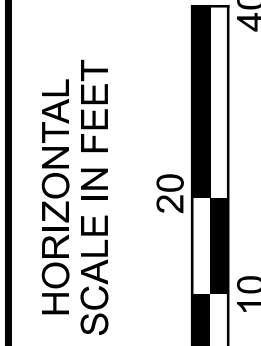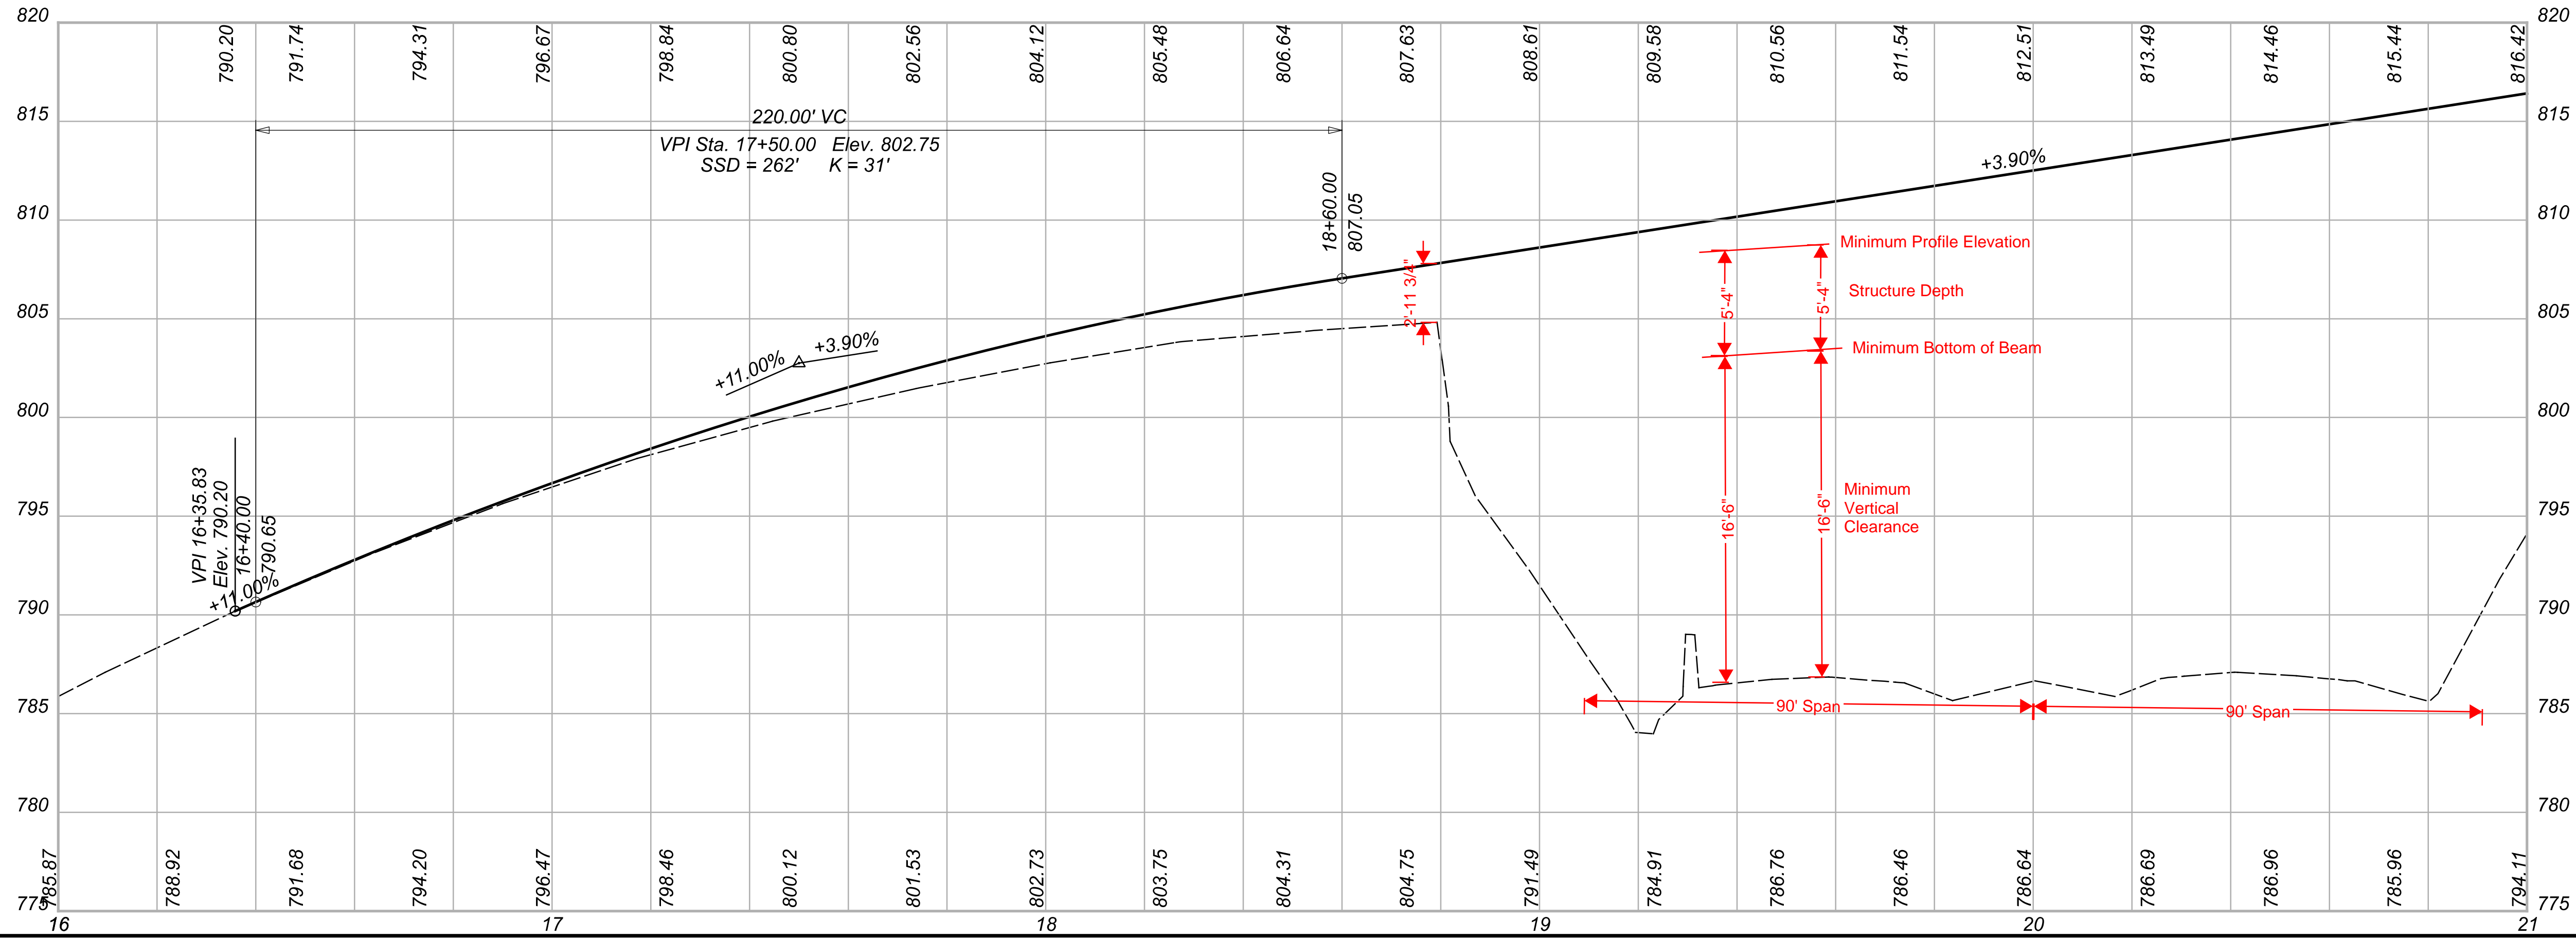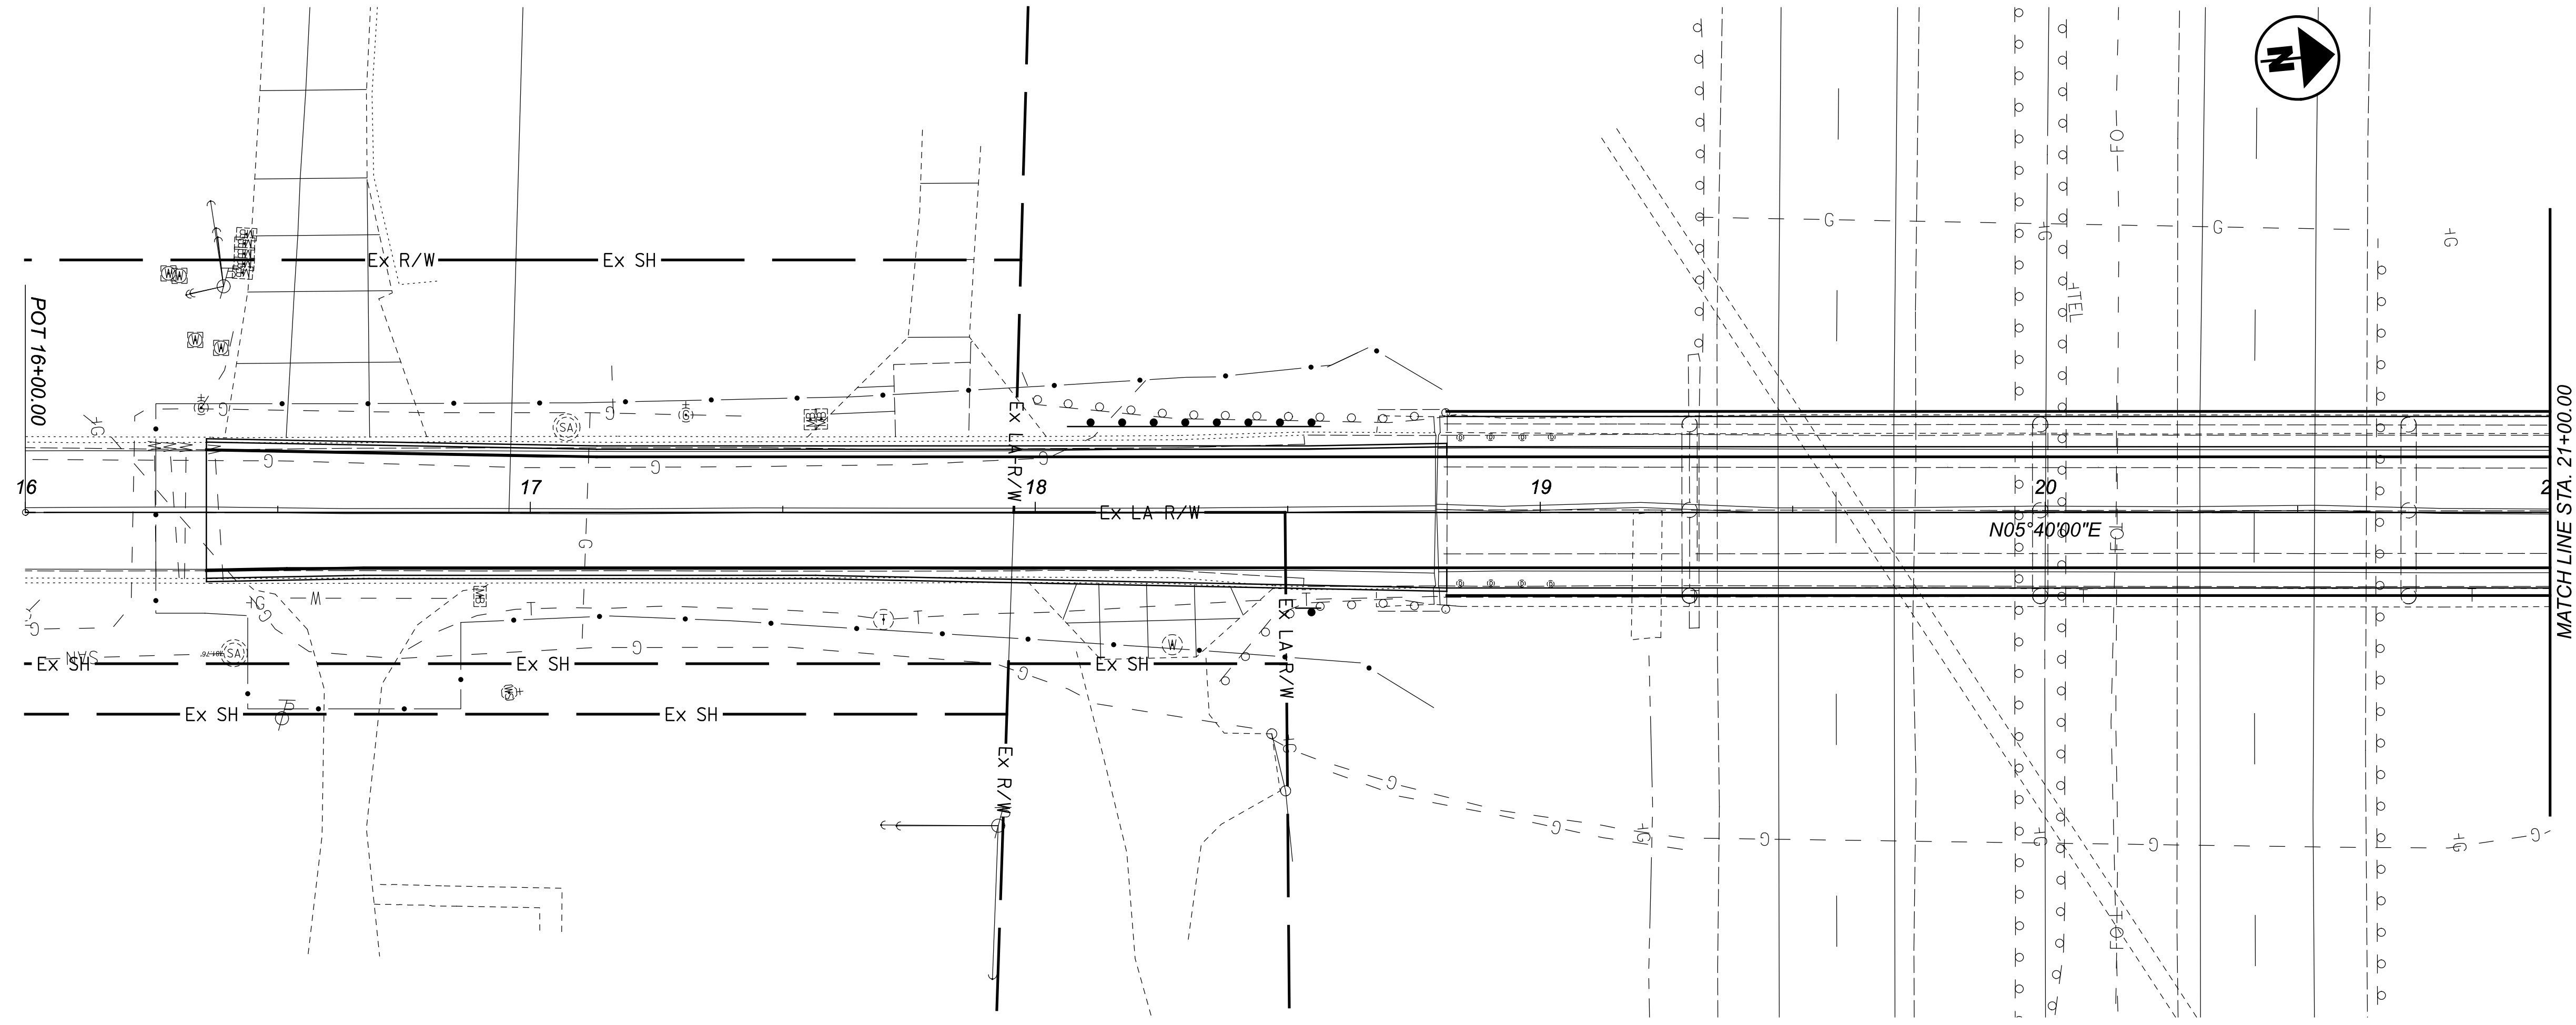

PLAN AND PROFILE
 BEGIN PROJECT TO STA. 21+00.00

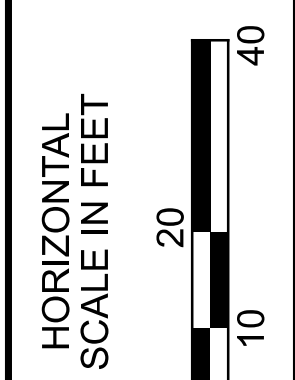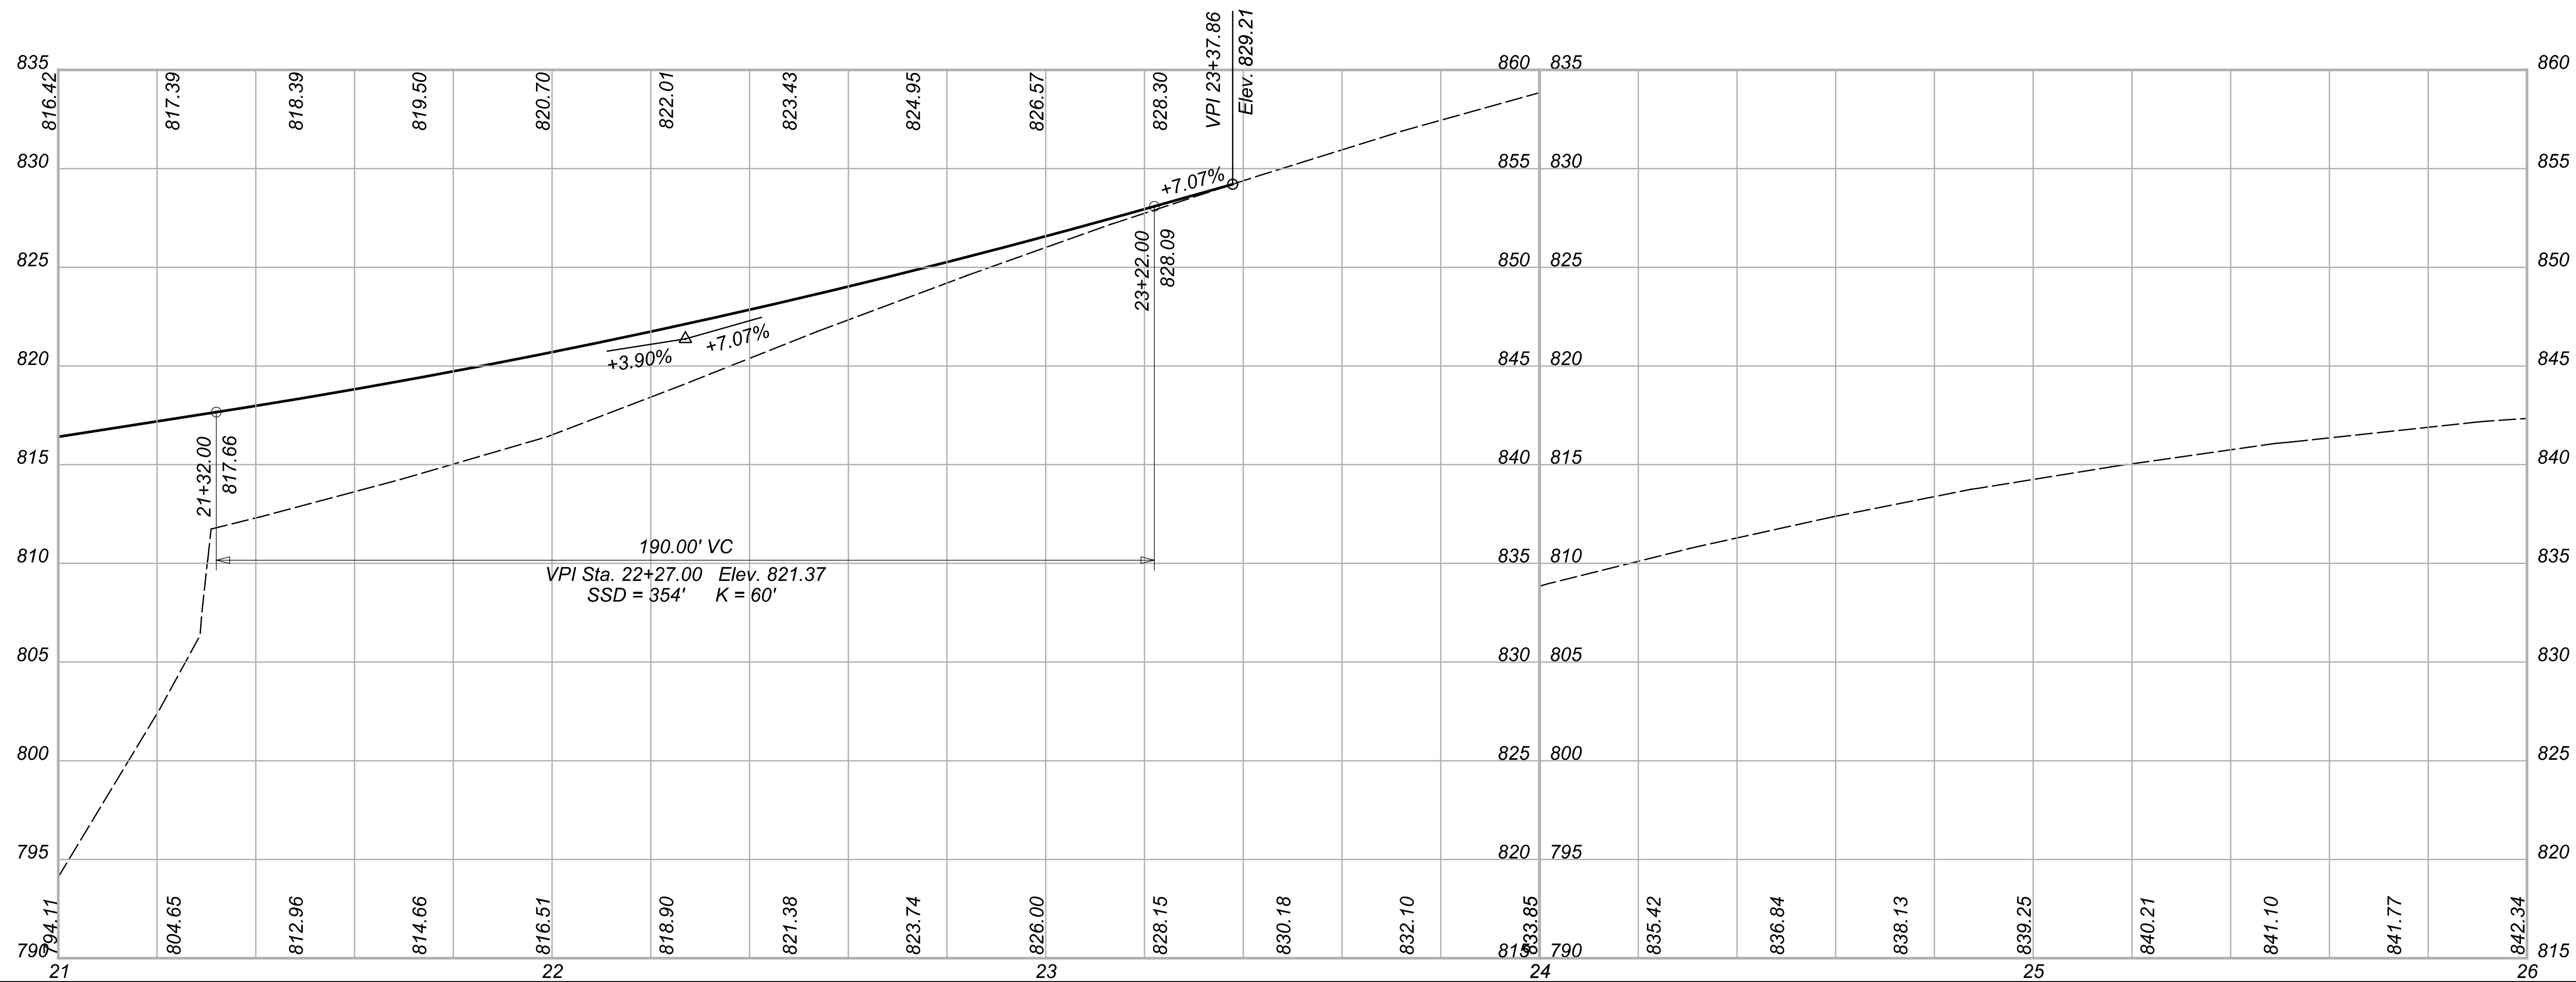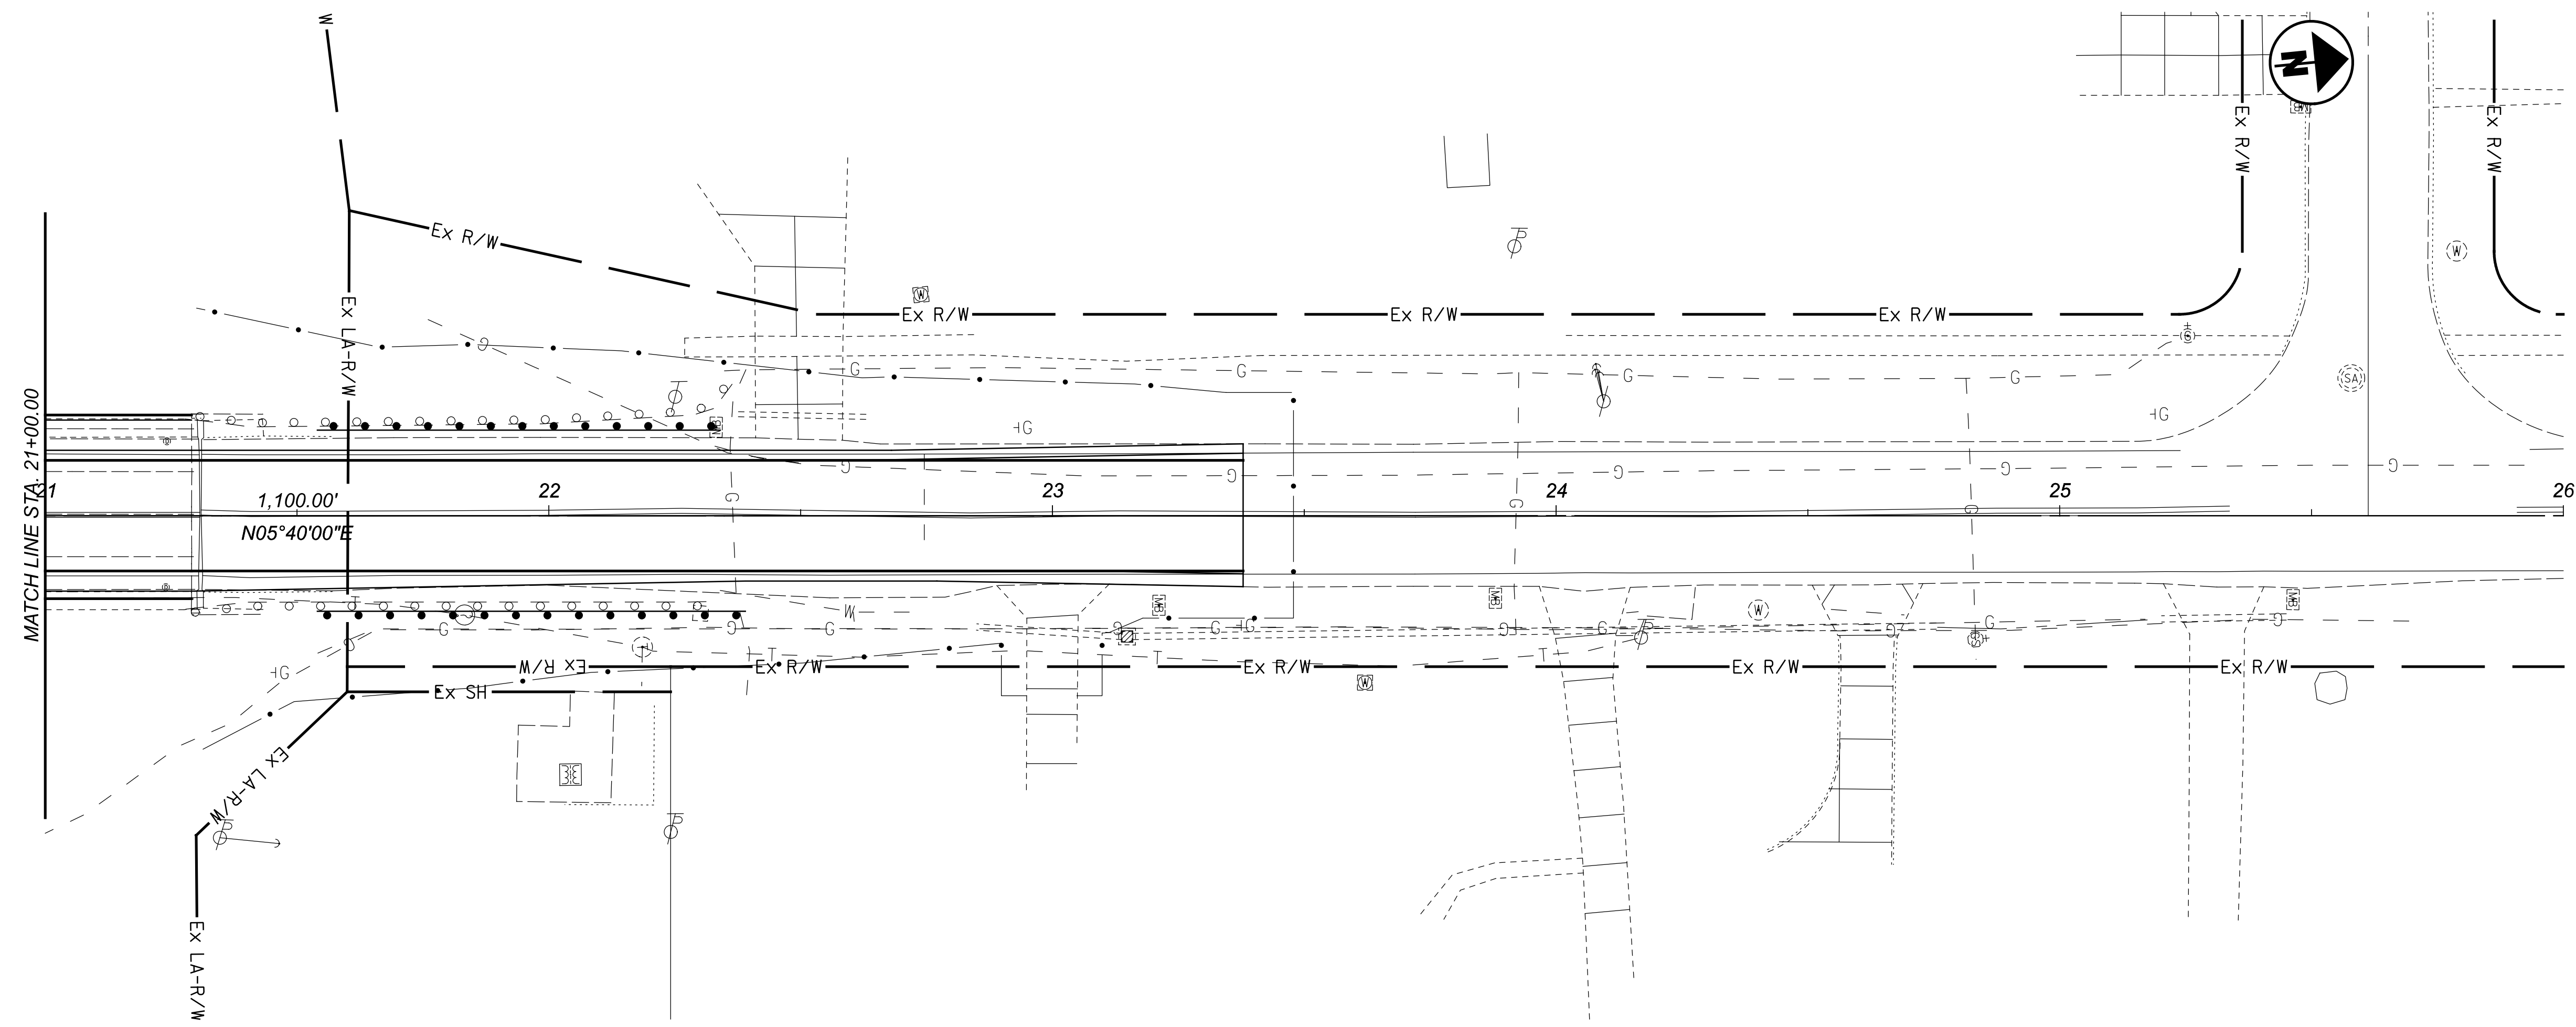

PLAN AND PROFILE
 STA. 21+00.00 TO END PROJECT

DESIGN AGENCY
fishbeck

DESIGNER
 JAL

REVIEWER
 XXX MM-DD-YY

PROJECT ID
 110563

SHEET TOTAL
 14 26