


SUMMARY OF ADDITIONAL R/W REQUIRED					
PARCEL No.	OWNERS NAME	AREA ACRES	BLDG. REMOVAL	SHEET No.	REMARKS
1	C.C.C. & S.L. RWY (NYC. RWY)	0.005	NO	1	

SECTION CORNER TIE DETAIL
Scale 1" = 200'

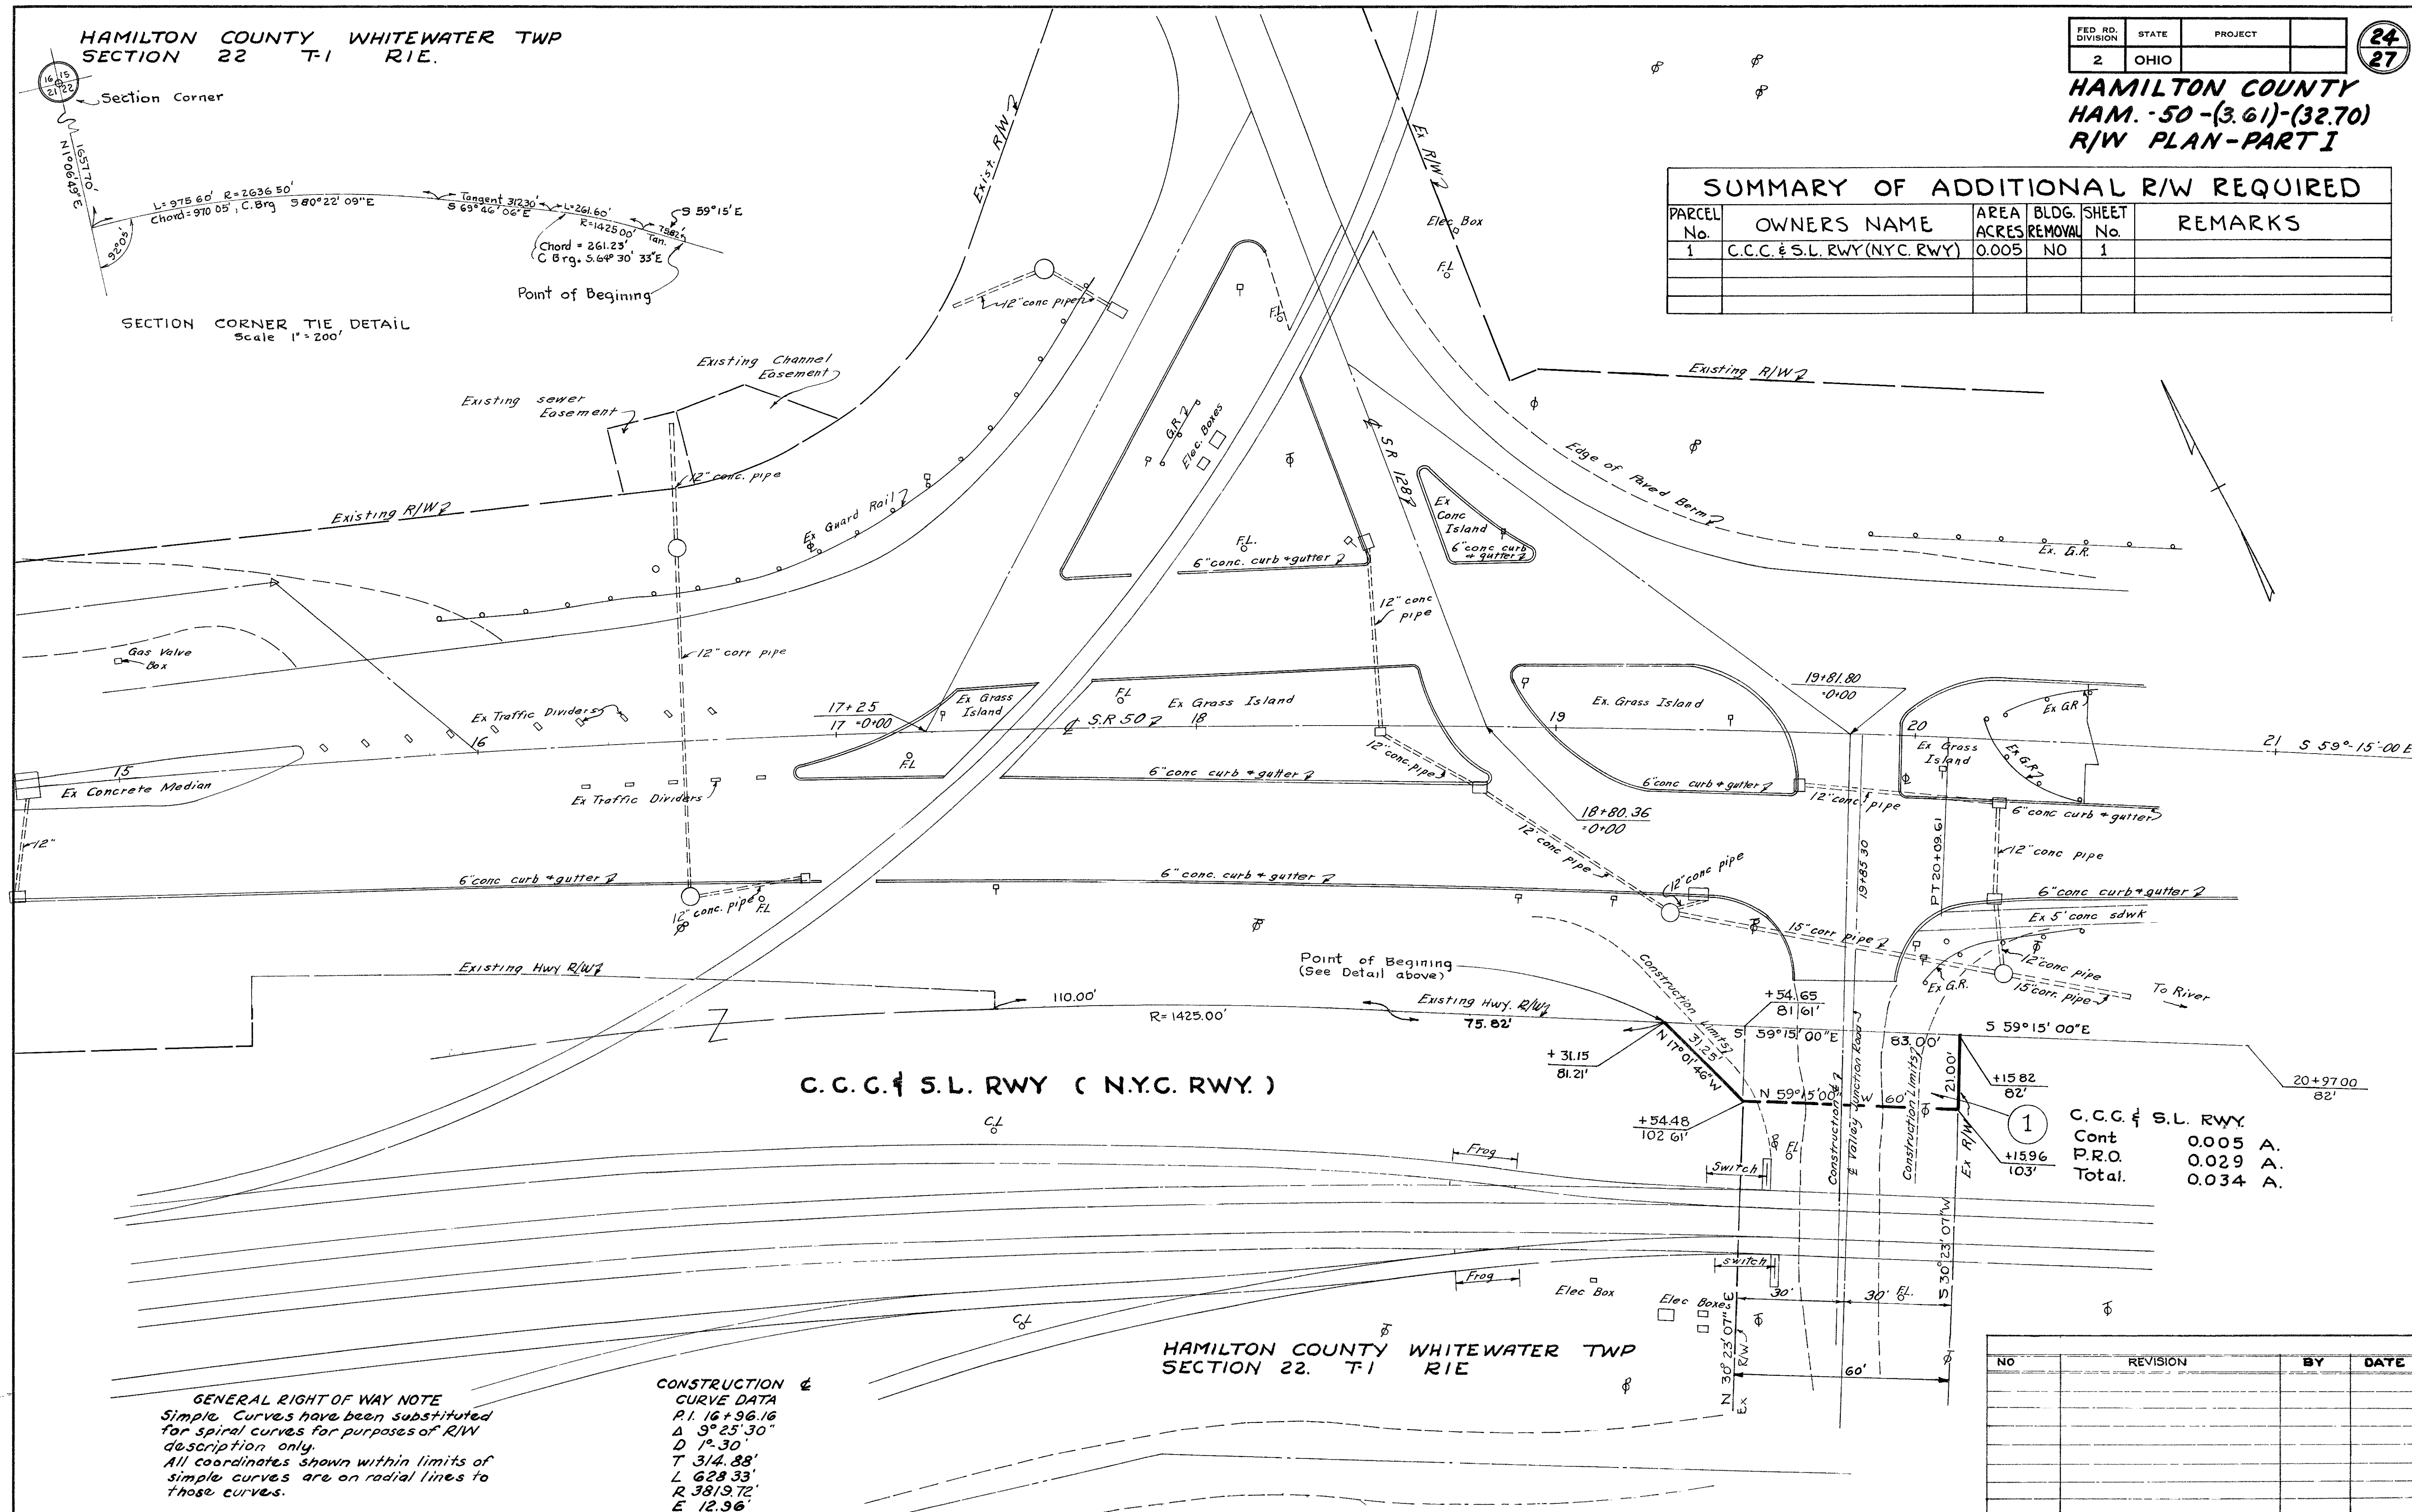

HAM-50-(3.61)-(32.70)-PART I R/W PLANS STA. 15+00 TO STA. 21+00

HAMILTON COUNTY
SECTION 3, TOWN 4, FR. RANGE 2
COLUMBIA TOWNSHIP


FED. RD. DIVISION	STATE	PROJECT
2	OHIO	

25
27

HAMILTON COUNTY
HAM-50-(3.61)-(32.70)
R/W PLANS - PART II

CURVE DATA
Δ 29°-38'
D 2°-00'
R 2864.79'
T 757.80'
L 1481.67'
E 98.52'

ELIZABETH S. WILLIAMS

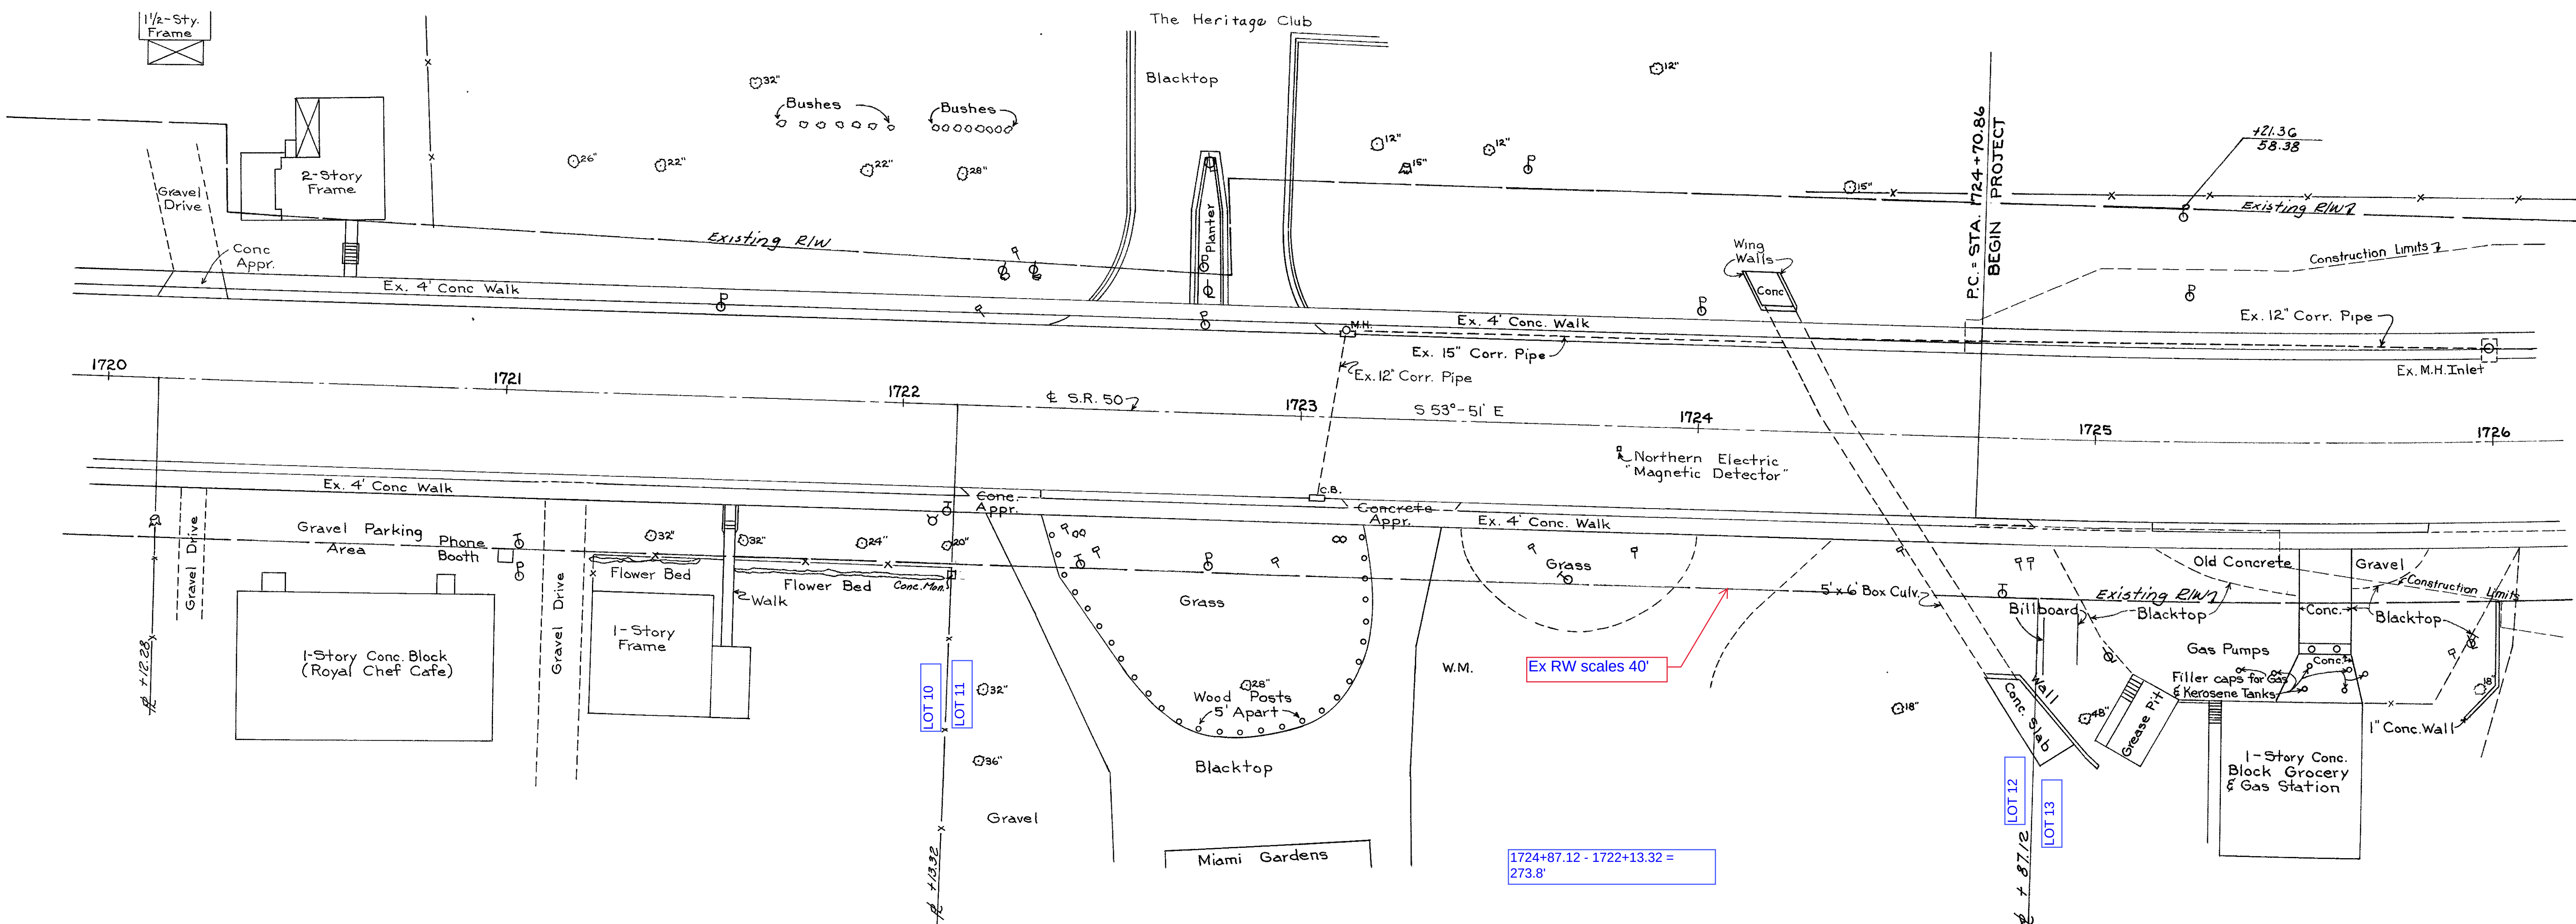

EMMA D. BROWN

SUMMARY OF ADDITIONAL R/W REQUIRED					
PARCEL NO.	OWNERS	NAME	AREA ACRES	BLDG. REMOVAL	SHEET NO.
1	EMMA D. BROWN		0.025	NO	2
1T	EMMA D. BROWN		0.063	NO	2

HAMILTON COUNTY
SECTION 3, TOWN 4, FR. RANGE 2
COLUMBIA TOWNSHIP

DATE	REVISION	NAME

ELIZABETH S. WILLIAMS


Δ 29°-38
 D 2°-00
 R 2864.79
 T 757.80
 L 1481.67
 E 98.53'

MATCHES
ham-50-31.95 (2004)

FED. RD. DIVISION	STATE	PROJECT	
2	OHIO		

HAMILTON COUNTY
HAM-50-(3.61)-(32.70)
R/W PLANS - PART II

26
27

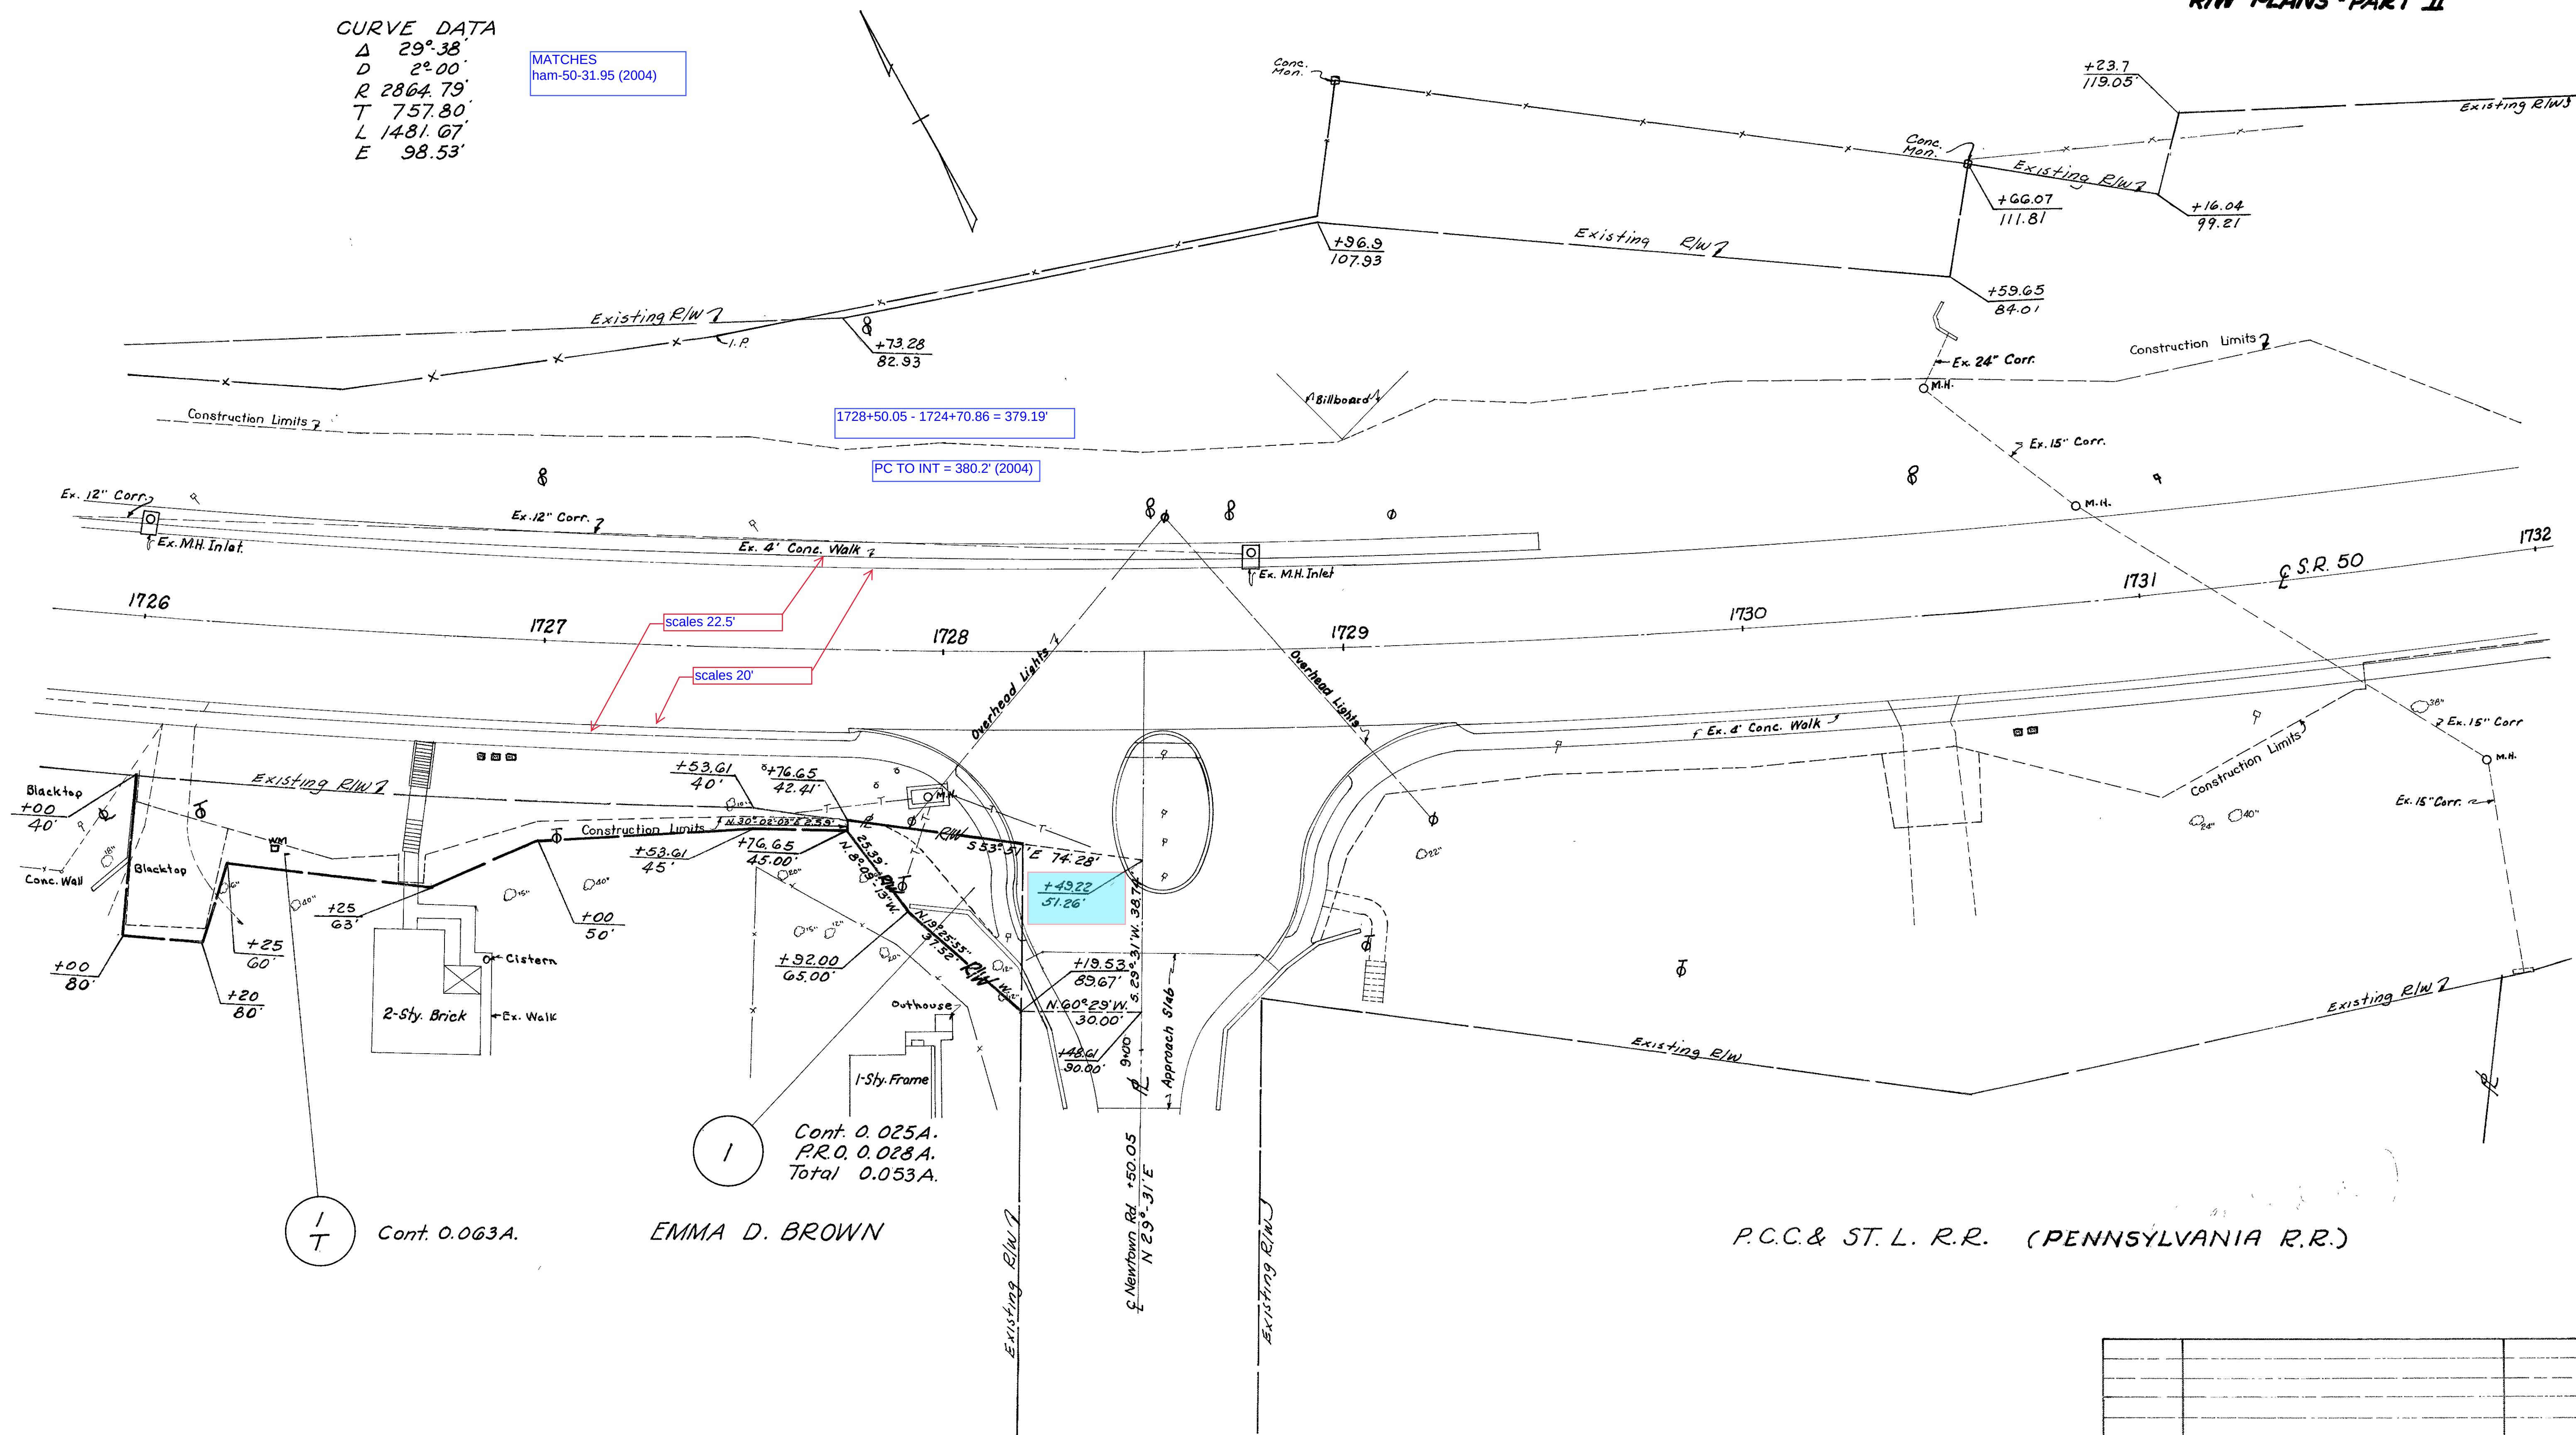

HAMILTON COUNTY
SECTION 3, TOWN 4, FR. RANGE 2
COLUMBIA TOWNSHIP

P.C.C. & ST. L. R.R. (PENNSYLVANIA R.R.)

[illegible]

HAM-50-(3.61)-(32.70)-PART II

R/W PLANS STA. 1726+00 TO STA. 1732+00

②


HAMILTON COUNTY
SECTION 3, TOWN 4, FR. RANGE 2
COLUMBIA TOWNSHIP

FED. RD. DIVISION	STATE	PROJECT	
2	OHIO		

27
27

HAMILTON COUNTY
HAM-50-(3.61)-(32.70)
RIW PLANS - PART - II

ELIZABETH S. WILLIAMS

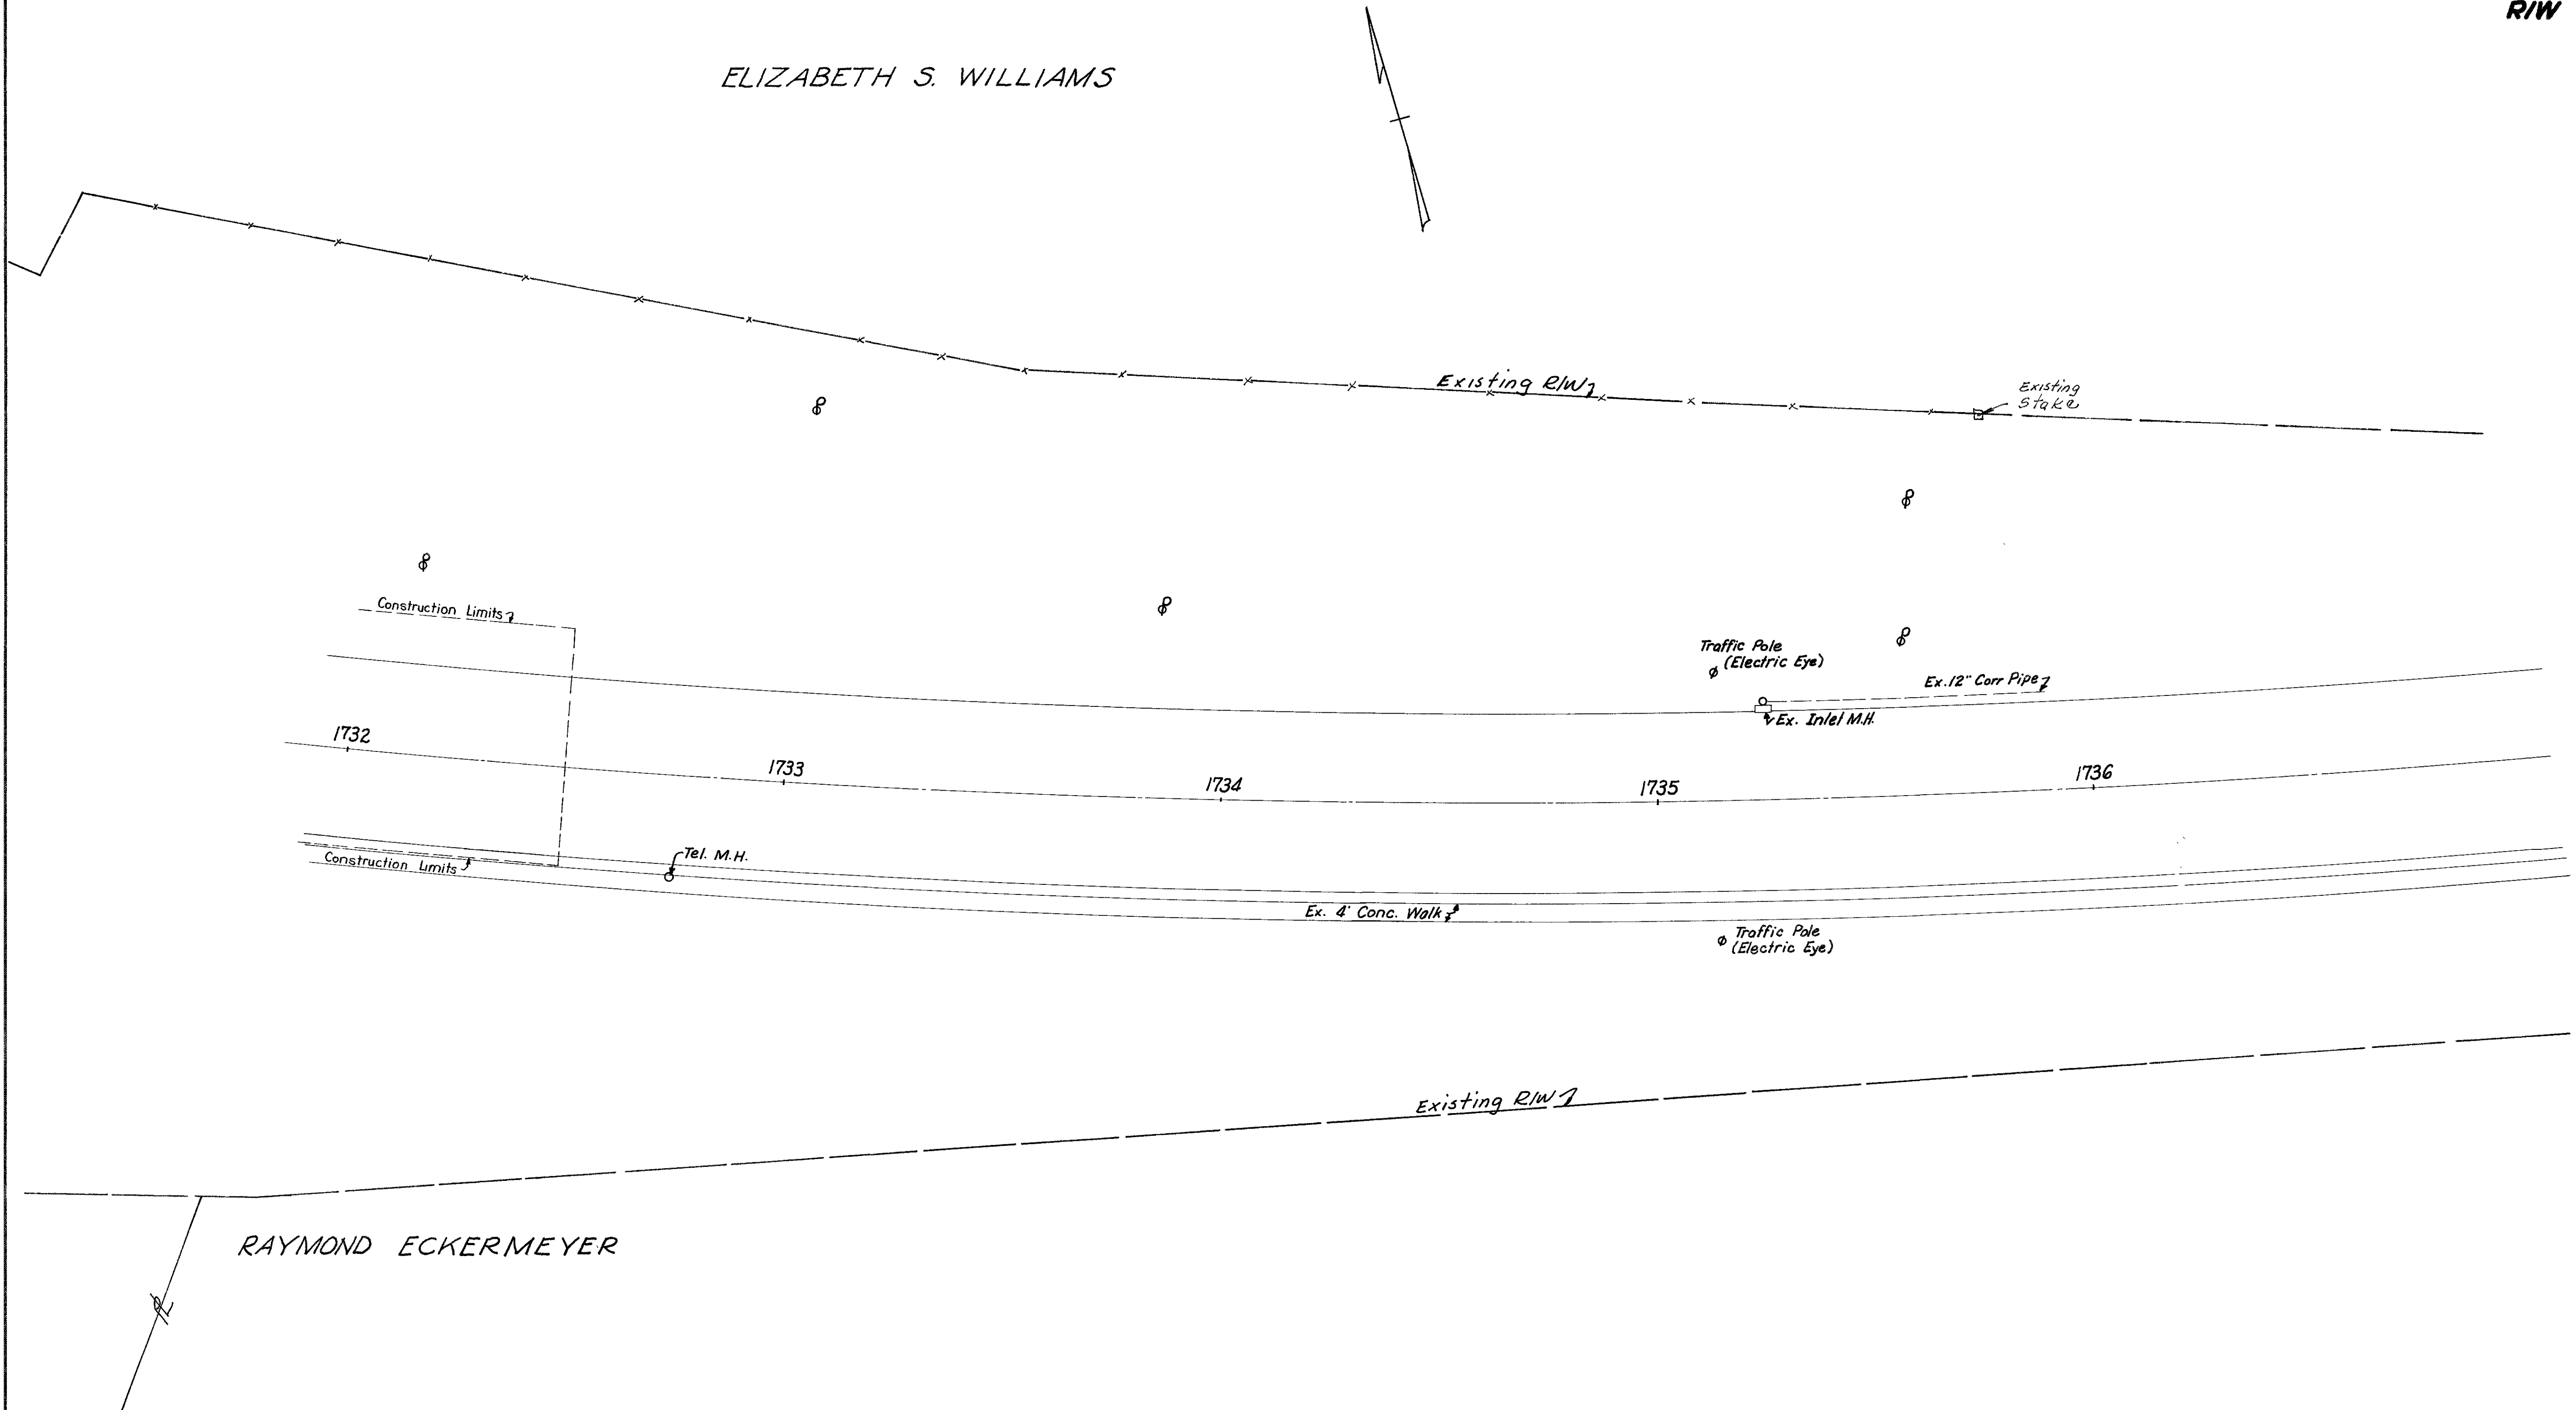

RAYMOND ECKERMEYER

HAMILTON COUNTY
SECTION 3, TOWN 4, FR. RANGE 2
COLUMBIA TOWNSHIP

DATE	REVISION	NAME

HAM-50-(3.61)-(32.70)-PART II RIW PLANS STA. 1732+00 TO STA. 1736+00

3